

24TH STREET

NORTH
BADGING
GATE


PEDESTRIAN
GATE

SECURITY

LAMBDA
BUILDING

OFFICE
BUILDING

CLASSIFIED
AREA

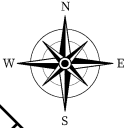

GATE



CONSTRUCTION
FENCE



TRUCK ROUTE



RESTRICTED ACCESS
(DURING PICK)

PEDESTRIAN
GATE

GREENSPACE

LINCOLN AVE

WASHINGTON DRIVE

GAMMA
BUILDING

CAFETERIA

SOUTH
DELIVERY
GATE

EAST
DELIVERY
GATE

LAYDOWN YARD

Equipment Truck

Crane

Loading
Platforms

Man Hoist

BETA
BUILDING


JOBSITE TRAILERS

25TH STREET

MOUNT OLYMPUS SCIENCE AND TECHNOLOGY CAMPUS MAP
AN OWEN & NER PROPERTY




SCALE: 1" = 70'

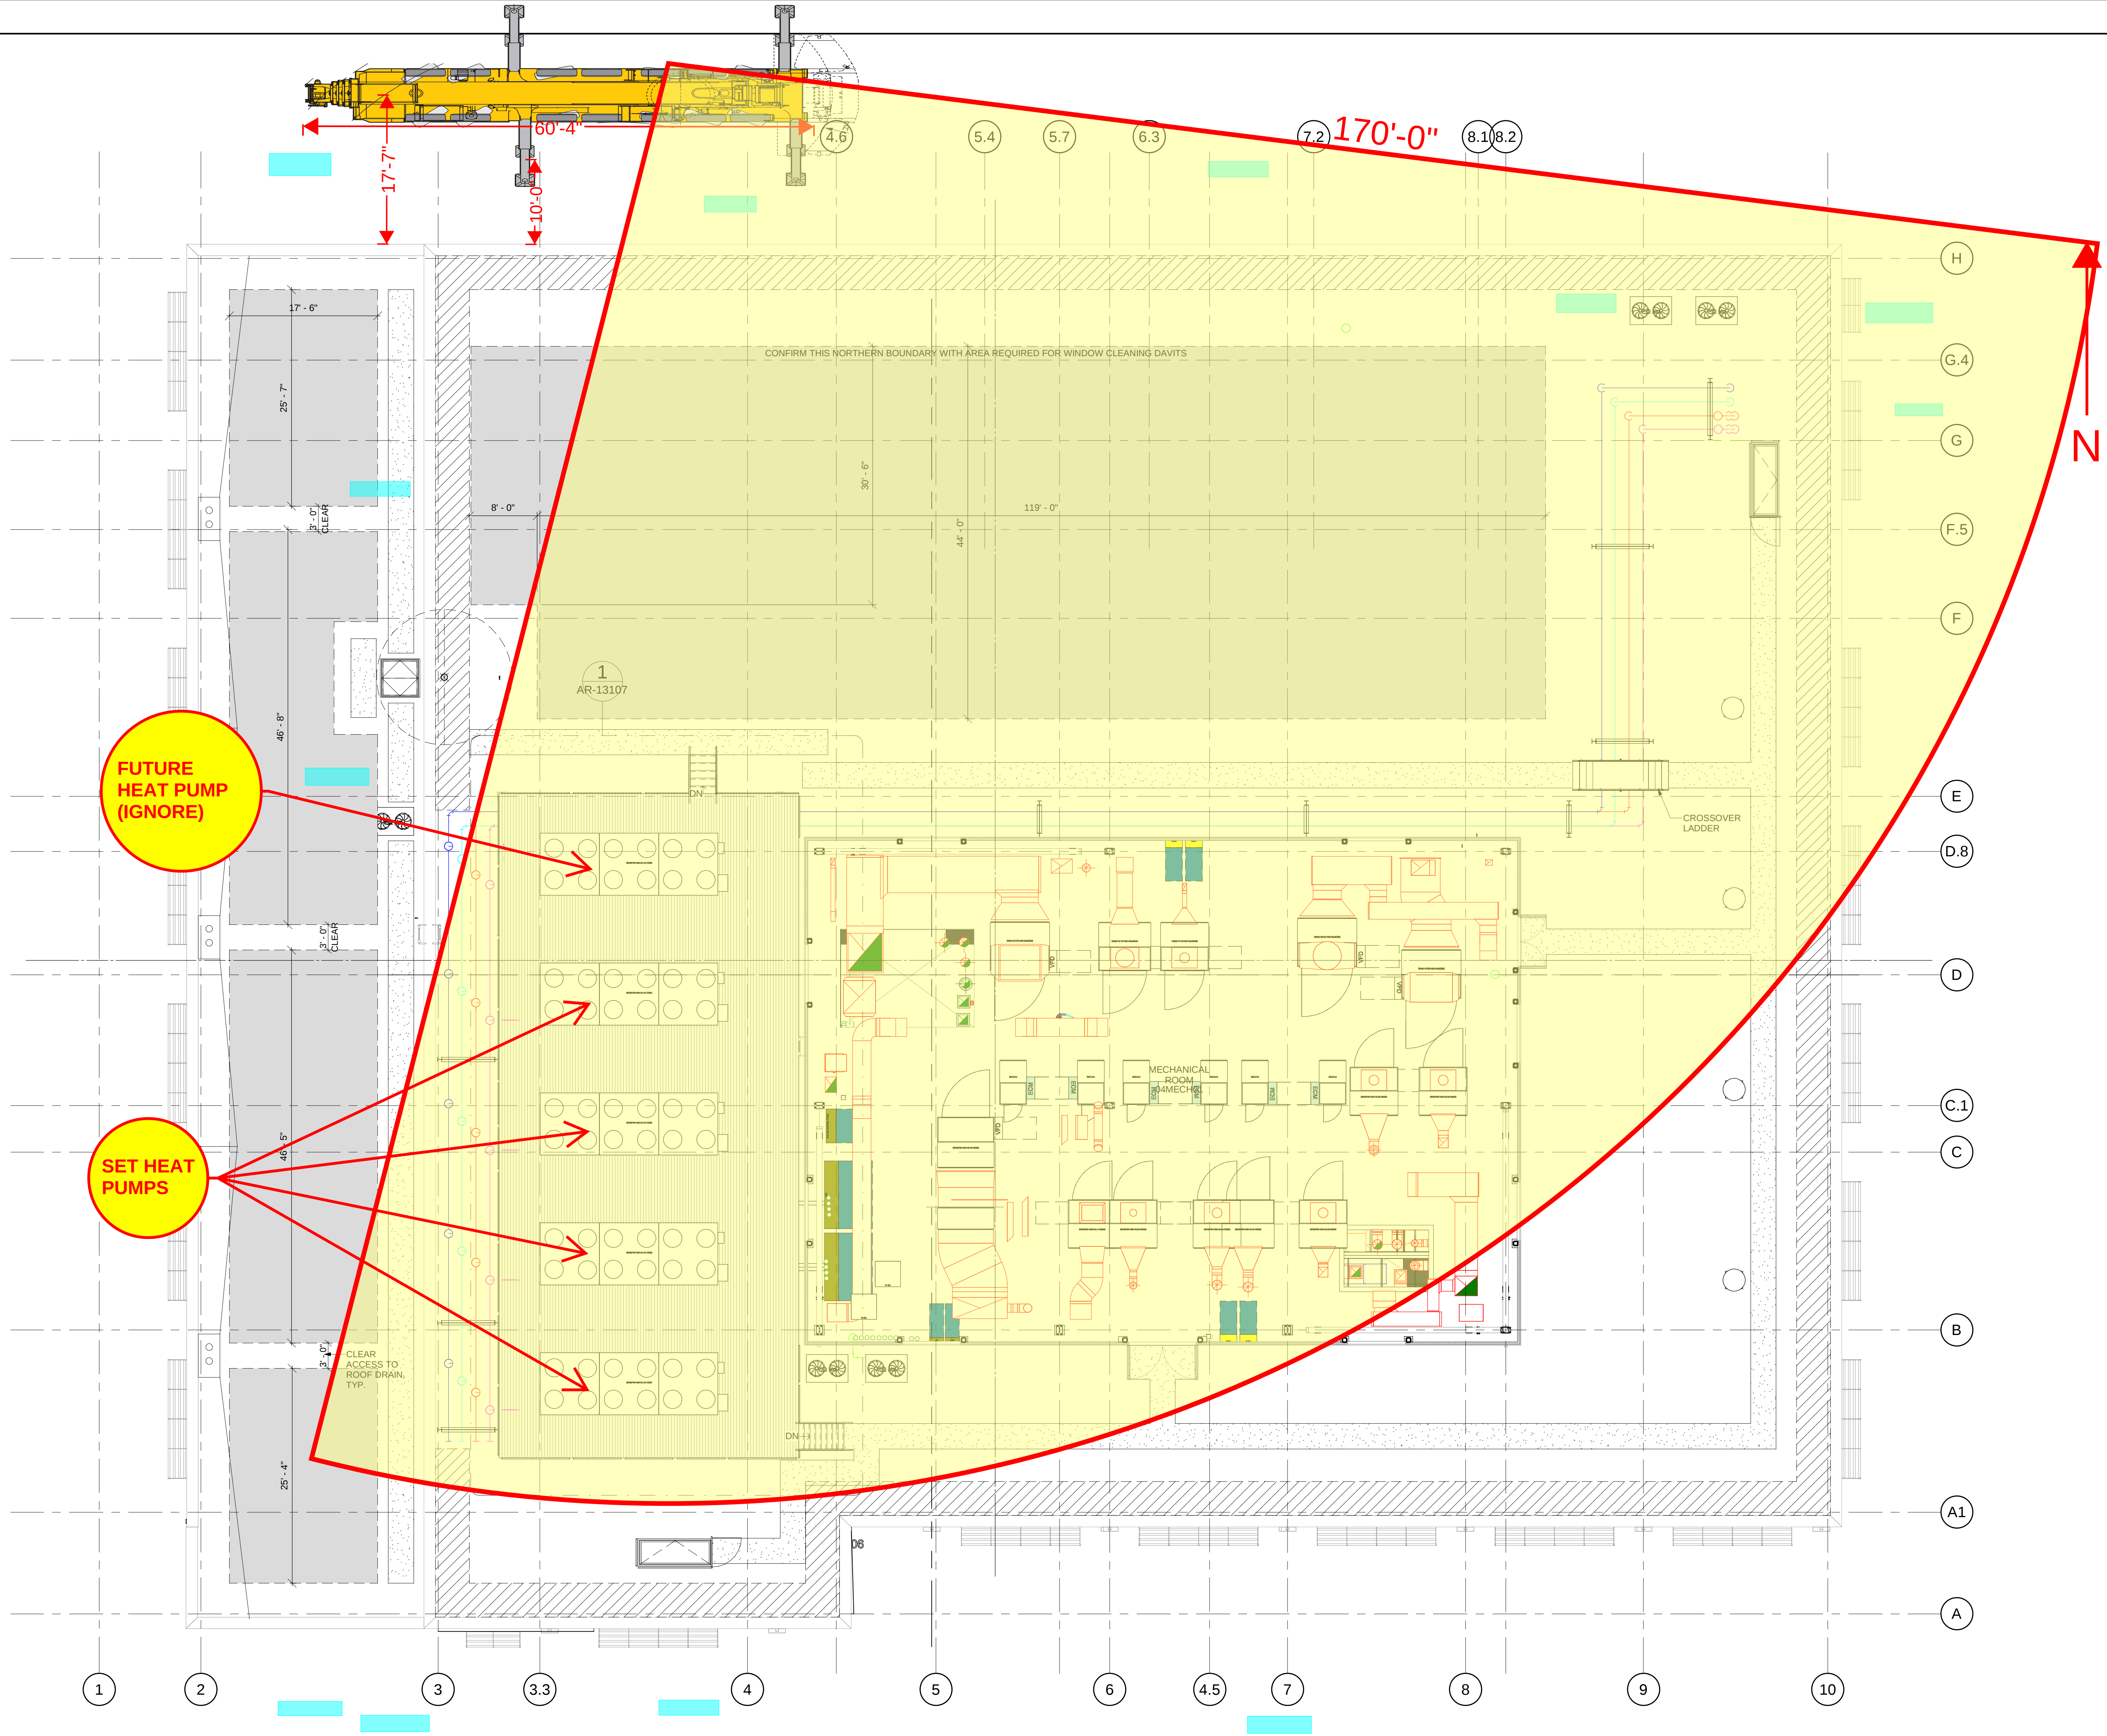

OVERALL PLAN - ROOF, PENTHOUSE
SCALE: 1/8" = 1'-0"


KEYPLAN

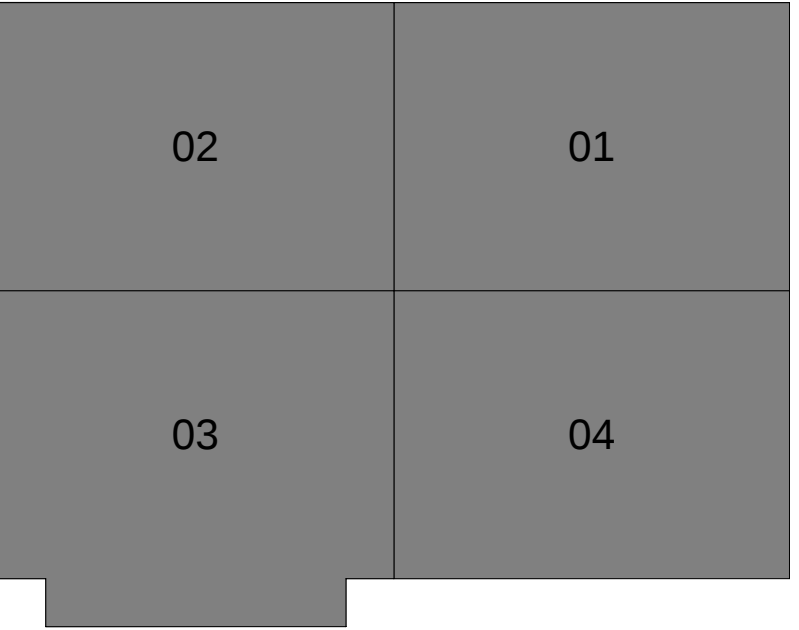

GENERAL NOTES

THIS SHEET IS PROVIDED FOR GENERAL INFORMATION ONLY.
SEE MECHANICAL DRAWINGS

LEGEND

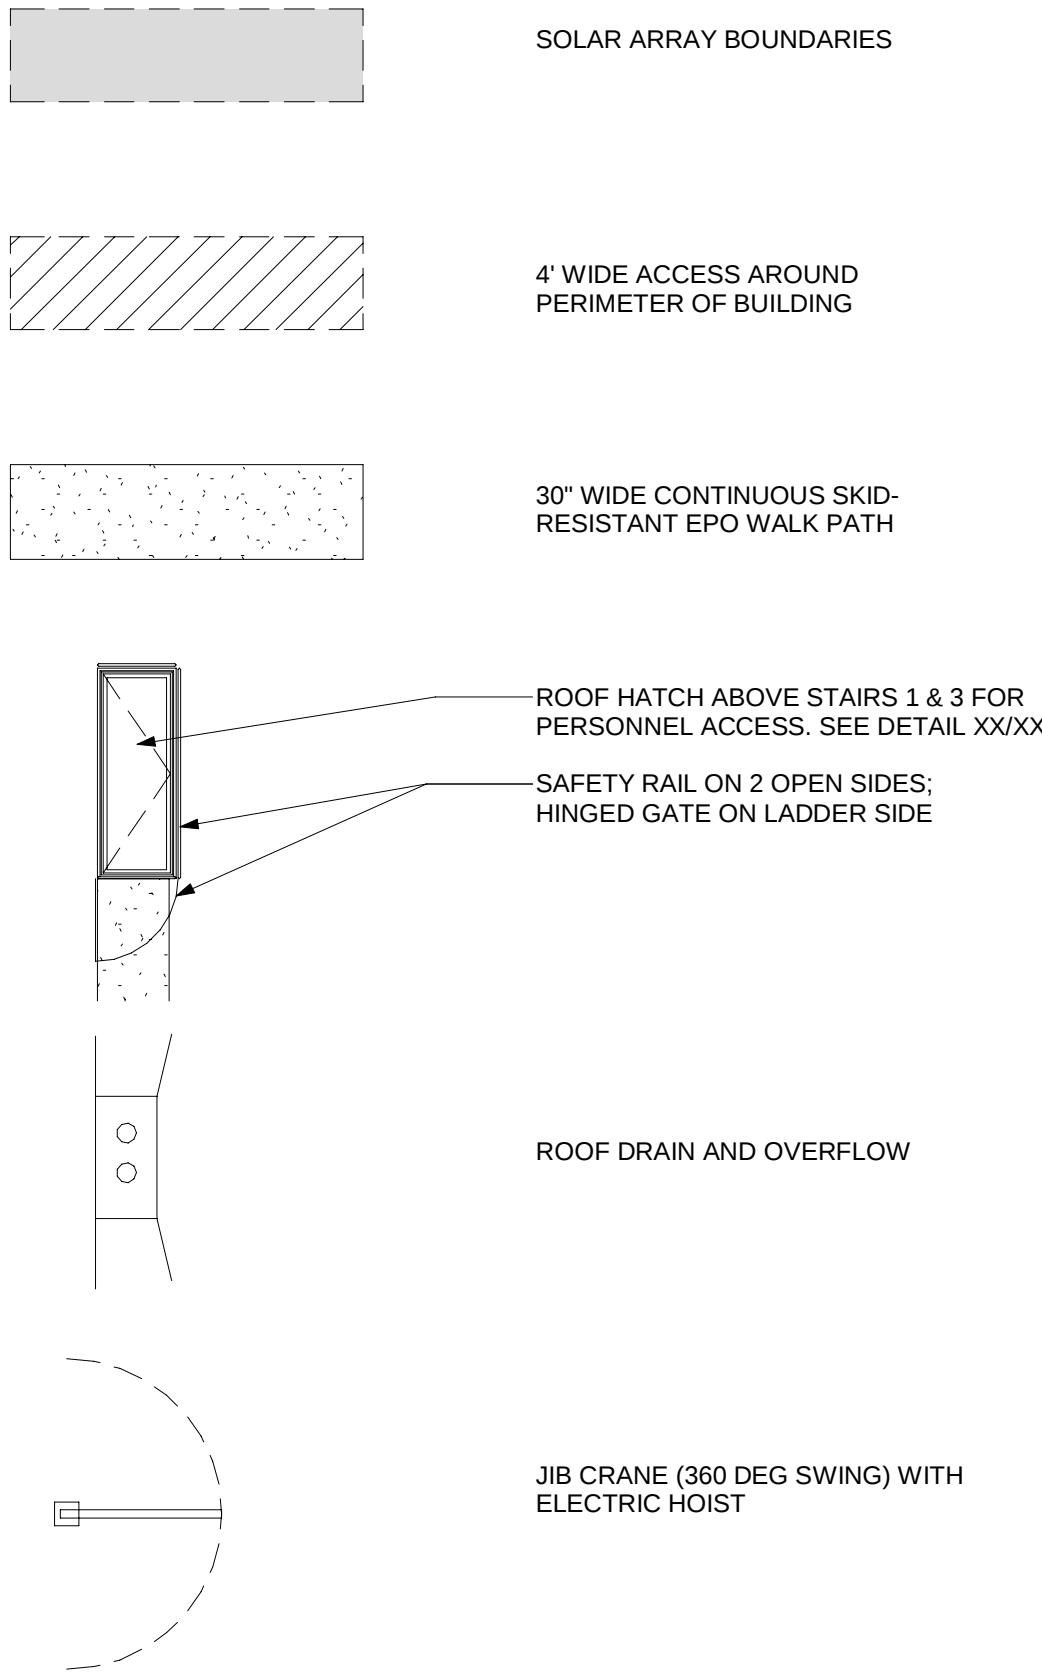

KEY PLAN NOTES

Title: ROOF AND PENTHOUSE PLAN - OVERALL ARCHITECTURAL FLOOR PLAN			
Drawing Number: ECM20 - 026 - BE69 - AR - 13073	As-Built	Project	B
Scale: 1 / 8 " = 1 ' - 0 "	Revision No.		