

IFC 11.20.17

A

---

Sheet Title

LEVEL 2  
LABORATORY  
FURNISHINGS  
FLOOR PLAN

Sheet No.

LF2.2



ALL IDEAS, DESIGNS AND ARRANGEMENTS INDICATED ON THESE DRAWINGS ARE THE PROPERTY OF THE ARCHITECT AND ARE TO BE USED IN CONNECTION WITH THIS SPECIFIC PROJECT AND SHALL NOT BE USED OTHERWISE WITHOUT THE EXPRESSED CONSENT OF THE ARCHITECT. THERE SHALL BE NO CHANGES OR DEVIATION FROM THE DRAWINGS OR ACCOMPANYING SPECIFICATION WITHOUT THE EXPRESSED CONSENT OF THE ARCHITECT.

Y2

COLD ROOM  
223  
641 SF

PC BULK  
STORAGE  
221  
600 SF

RFI 2-00234 Room  
221 RCP Shift

BUFFER  
ROOM  
219  
2185 SF

METRO SHELF  
RACK OFOI

PROVIDE DESICCANT  
DRYER ON SUPPLY  
AIR TO AVOID  
CONDENSATION

VESTIBULE  
251  
346 SF

33x72

EQUIP SPACE

FILTERED  
HW/CW  
A(100#)  
DI

E-2A

E-2B

E-2C

E-2D

METRO SHELF  
RACK OFOI

METRO SHELF  
RACK OFOI

STOCK RM.  
250  
278 SF

WEST  
CORRIDOR  
204  
2326 SF


UTILIT  
218

DRY CHEMICAL  
STORAGE

SS43

SS43

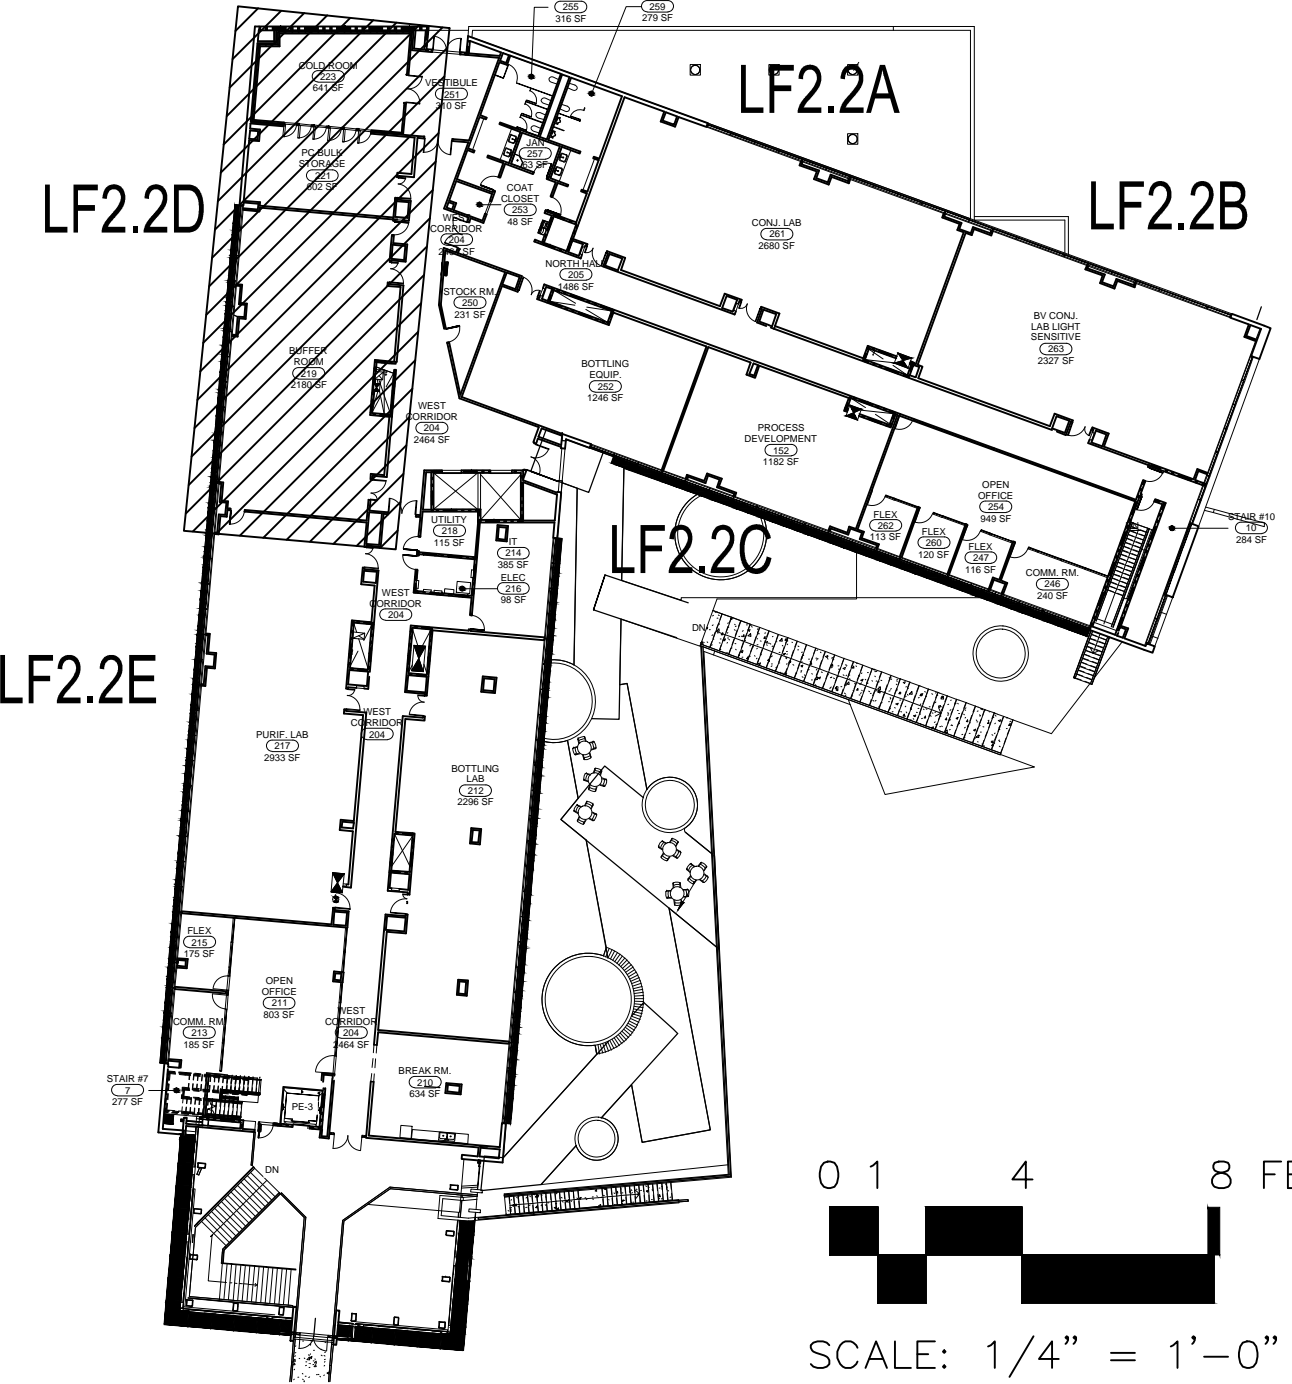SS43



CP-2  
VOLUME 2

PROJECT NO. 16141		
REV NO.	DATE ISSUED	REASON
04.25.17	DESIGN DEVELOPMENT	
08.08.17	CITY SUBMITTAL SET	
2.1	08.29.17	ADDENDUM #2.1
2.2	10.03.17	ADDENDUM 2.2
2.3	11.20.17	ASI 2.1/IFC

IFC 11.20.17

Sheet Title

LEVEL 2  
LABORATORY  
FURNISHINGS  
FLOOR PLAN

Sheet No.

LF2.2D



ALL IDEAS, DESIGNS AND ARRANGEMENTS INDICATED ON THESE DRAWINGS ARE THE PROPERTY OF THE ARCHITECT AND ARE TO BE USED IN CONNECTION WITH THIS SPECIFIC PROJECT AND SHALL NOT BE USED OTHERWISE WITHOUT THE EXPRESSED CONSENT OF THE ARCHITECT. THERE SHALL BE NO CHANGES OR DEVIATION FROM THE DRAWINGS OR ACCOMPANYING SPECIFICATION WITHOUT THE EXPRESSED CONSENT OF THE ARCHITECT.

GENERAL NOTES		LABORATORY SYMBOLS LEGEND		SAFETY SHOWER / EYE WASH COMBINATION UNIT (RECESSED)		
<div>1. ALL WALL BENCHTOPS AND MOVABLE TABLES SHALL BE 33" DEEP INCLUDING WALL BENCH BACK SPLASH (UNLESS OTHERWISE NOTED).</div> <div>2. ALL BENCHES AND TABLES SHALL BE 36" HIGH (UNLESS OTHERWISE NOTED).</div> <div>3. REFER TO FLOOR PLAN FOR WORK SURFACE MATERIAL.</div> <div>4. ALL BACK &amp; SIDE SPLASHES TO BE 4" HIGH &amp; 1" THICK EPOXY RESIN (UNLESS OTHERWISE NOTED).</div> <div>5. PROVIDE SIDE SPLASHES AT ALL BENCH TOPS AGAINST FUME HOODS AND/OR ADJACENT WALLS.</div> <div>6. OVERALL LENGTH OF BENCHTOPS SHALL BE DETERMINED BY CASEWORK SIZES AND DIMENSIONS AS INDICATED ON PLANS. TOPS SHALL OVERHANG 1/2" AT EACH END AND 1" FROM FRONT OF BASE CABINETS AND TABLES. WHEN OVERALL DEMENSIONS ARE GIVEN, 1/2" OVERHANG IS NOT INCLUDED.</div> <div>7. ALL CASEWORK, FUME HOODS AND ANY OTHER FURNISHINGS WITH EXPOSED-TO-VIEW BACKS AND SIDES SHALL BE FINISHED.</div> <div>8. INSTALL CLOSURE PANELS BETWEEN BACK OF CABINETS OR HOODS AND WALLS AT EXPOSED ENDS AND BETWEEN BASE CABINETS AND/OR HOODS THAT ARE SET BACK TO BACK.</div> <div>9. ALL PENETRATIONS THROUGH BENCHTOP SHALL BE SEALED WITH SEALANT.</div> <div>10. BACKS OF COUNTERTOPS AND SPLASHES AGAINST WALLS SHALL BE SEALED TO THE WALL WITH SEALANT.</div> <div>11. CONTRACTOR SHALL FIELD VERIFY ALL DIMENSIONS PRIOR TO FABRICATION.</div> <div>12. ARCHITECT TO SELECT COLORS FROM MANUFACTURERS STANDARD COLORS.</div> <div>13. FREE STANDING SHELVING AND CASEWORK LESS THAN 18" DEEP SHALL BE SECURED TO PREVENT TIPPING. SUBMIT SHOP DRAWINGS OF ATTACHMENT PRIOR TO INSTALLATION.</div> <div>14. FOR LABORATORY SERVICE FITTING TYPES, LOCATIONS AND ORDER, SEE LABORATORY FURNISHINGS PLANS. THESE FITTINGS SHALL BE PROVIDED UNDER DIVISION 12, FOR INSTALLATION UNDER DIVISION 22.</div> <div>15. ALL SNORKEL EXHAUST SHOWN ON THESE DRAWINGS SHALL BE PROVIDED UNDER DIVISION 12.</div> <div>16. LOCATION OF EQUIPMENT, SUCH AS FUME HOODS, OVERHEAD SERVICE CARRIERS, BRACES OR ANY OTHER ITEMS THAT MAY INTERFERE WITH LIGHTING, STRUCTURAL OR MECHANICAL SYSTEMS, SHALL BE CAREFULLY COORDINATED. NOTIFY G.C. OF DISCREPANCIES PRIOR TO PROCEEDING WITH WORK.</div> <div>17. UNLESS OTHERWISE NOTED, ALL MISCELLANEOUS CHANNELS, BRACKETS AND FITTINGS INDICATED ON ALL LABORATORY FURNISHINGS DRAWNGS SHALL BE SUPPLIED, INSTALLED AND PAINTED UNDER DIVISION 12.</div> <div>18. CONTRACTOR SHALL EXAMINE ALL LABORATORY FURNISHINGS PLANS AND COORDINATE WITH REFLECTED CEILING PLANS FOR PROPER CEILING HEIGHTS &amp; PIPE DROP ENCLOSURE HEIGHTS AND LOCATIONS.</div> <div>19. OVERHEAD SERVICE CARRIERS, HEAVY DUTY UNISTRUT AND OTHER STRUCTURALLY ANCHORED AND SUSPENDED DEVICES WHICH REQUIRE COORDINATION WITH OTHER TRADES SHALL BE THE RESPONSIBILITY OF THIS DIVISION (UNLESS OTHERWISE NOTED). ADDITIONAL FRAMING MAY BE REQUIRED TO ACCOMMODATE ANCHORAGE AROUND DUCTWORK OR OTHER OBSTRUCTIONS.</div> <div>20. SERVICE FITTINGS SHOWN ON THE "LF" PLAN DRAWINGS ARE FOR LOCATION ONLY. REFER TO SPECIFICATIONS AND DETAILS FOR ACTUAL FITTINGS.</div> <div>21. UNLESS OTHERWISE NOTED ALL ELECTRICAL RACEWAYS &amp; RECEPTACLES ARE TO BE MOUNTED AT +43" A.F.F. TO THE BOTTOM OF THE DEVICE.</div> <div>22. PAPER TOWEL DISPENSERS &amp; SOAP DISPENSERS ARE OWNER FURNISHED, OWNER INSTALLED.</div>			DESCRIPTION			
			-CHEMICAL FUME HOOD, REFER TO FLOOR PLANS FOR SIZE REFER TO FLOOR PLANS FOR SERVICES & BASE CABINETS BENEATH	<div>1 &amp; 2 LF4.1</div>	<div>EQUIP SPACE</div>	OWNER FURNISHED, OWNER INSTALLED EQUIPMENT
			-OFOI BIOLOGICAL SAFETY CABINET CLASS II, TYPE A-2 REFER TO FLOOR PLANS FOR SIZE -REFER TO FLOOR PLANS FOR SERVICES		SC24	<div>4 LF4.3</div>
			LABORATORY BENCH, REFER TO FLOOR PLANS FOR SIZE & TYPE	<div>1,2 &amp; 3 LF4.3</div>		DUPLEX RECEPTACLE
						DUPLEX RECEPTACLE ON EMERGENCY POWER
		<div>+36"</div>	FIXED LABORATORY BENCH			FLOOR DRAIN, SHOWN FOR LOCATION PURPOSES ONLY BY DIV. 22
						FLOOR SINK, SHOWN FOR LOCATION PURPOSES ONLY BY DIV. 22
		<div>+34"</div>	FIXED LABORATORY BENCH - ADA		HWCW	HOT WATER COLD WATER
					DI	DEIONIZED WATER
			METRO SHELF RACK OFOI		LV	LABORATORY VACUUM
					CO2	CARBON DIOXIDE
			MEDIUM AUTOCLAVE (ENCLOSED) 24"x24"x48" CHAMBER		A(100#)	COMPRESSED AIR (100 PSIG) PROVIDE REGULATOR
			MEDIUM AUTOCLAVE (RECESSED) 24"x24"x48" CHAMBER		EYE WASH	DECK MOUNTED EYE WASH
			LABORATORY GLASSWARE WASHER			
			CAGE & BOTTLE WASHER			
		<div>CS42</div>	CORROSIVE STORAGE CABINET			
		<div>SS43</div>	SOLVENT STORAGE CABINET			
		<div>VENTILATED RACK</div>	VENTILATED RACK, OWNER FURNISHED, OWNER INSTALLED			
		<div>1</div>	UMBILICAL (PIPE DROP ENCLOSURE)	<div>4,5 &amp; 6 LF4.1</div>		
		<div>2</div>	DRYING RACK	<div>6 LF4.2</div>		
		<div>3</div>	CYLINDER RESTRAINT	<div>2 LF4.4</div>		
		<div>4</div>	SLEEVE IN WORK SURFACE	<div>3 LF4.4</div>		
		<div>5</div>	LOCAL WATER POLISHER, OFOI			
		<div>6</div>	ST. STL. ENCLOSURE PANEL, REFER TO SPECIFICATIONS			
		<div>7</div>	(2) TIER ADJUSTABLE SHELVING	<div>5 LF4.2</div>		
		<div>8</div>	LABORATORY FUME EXTRACTOR	<div>3 LF4.1</div>		
			LABORATORY SINK REFER TO SINK SCHEDULE ON LF 1.2	<div>5 LF4.4</div>		
			HAND WASH SINK REFER TO SINK SCHEDULE ON LF1.2 & REFER TO SPECIFICATIONS			
			SQUILLERY SINK REFER TO FLOOR PLANS FOR SIZE & LABORATORY SINK SCHEDULE ON LF1.2	<div>2 LF5.3</div>		

WORK SURFACE SYMBOLS LEGEND

-ALL WORK SURFACES TO BE 1" THICK TRESPA  
-REFER TO SPECIFICATIONS

DETAIL & ELEVATION LEGEND

DETAIL NUMBER

SECTION NUMBER

ELEVATION NUMBER

SHEET NUMBER

SHEET NUMBER

SHEET NUMBER

SERVICE FIXTURE SPACING

DOOR/CASEWORK CLEARANCES

CUPSINK WALL CONDITION

CUPSINK ISLAND CONDITION

LAB SINK WALL & ISLAND CONDITIONS

FUME HOOD

5.55.5' 10" 10" 5.55.55.5'

5.55.5' 10" 10" 5.55.55.5'

CUPSINK WALL CONDITION

CUPSINK ISLAND CONDITION

5.5' 15" 9"

2.5'

A = 7" IF B < 21"

A = 9" IF B > 21"

LAB SINK WALL & ISLAND CONDITIONS

FUME HOOD

FOR ADA FUME HOODS ONLY: CENTERLINE OF TOPMOST VALVE TO BE A MAXIMUM OF 46" A.F.F.

LABORATORY CASEWORK (REFER TO SCHEDULE EQUIPMENT - 11.2)

12" MIN.

18" MIN. @ INTERIOR

24" MIN. @ EXTERIOR

DOORS

12"

4.5"

1

2

3

4

5

6

7

8

5

3

2

16148

REV NO.

DATE ISSUED

REASON

04.25.17

DESIGN DEVELOPMENT

08.08.17

CITY SUBMITTAL SET

2.1

08.29.17

ADDENDUM #2.1

2.2

10.03.17

ADDENDUM 2.2

2.3

11.20.17

ASI 2.1/IFC

IFC 11.20.17

Sheet Title

LABORATORY FURNISHINGS SYMBOLS & LEGENDS

Sheet No.


LF1.1

DPR Issued Sheet 2017-11-20

Link to the Sheet - 2G-002



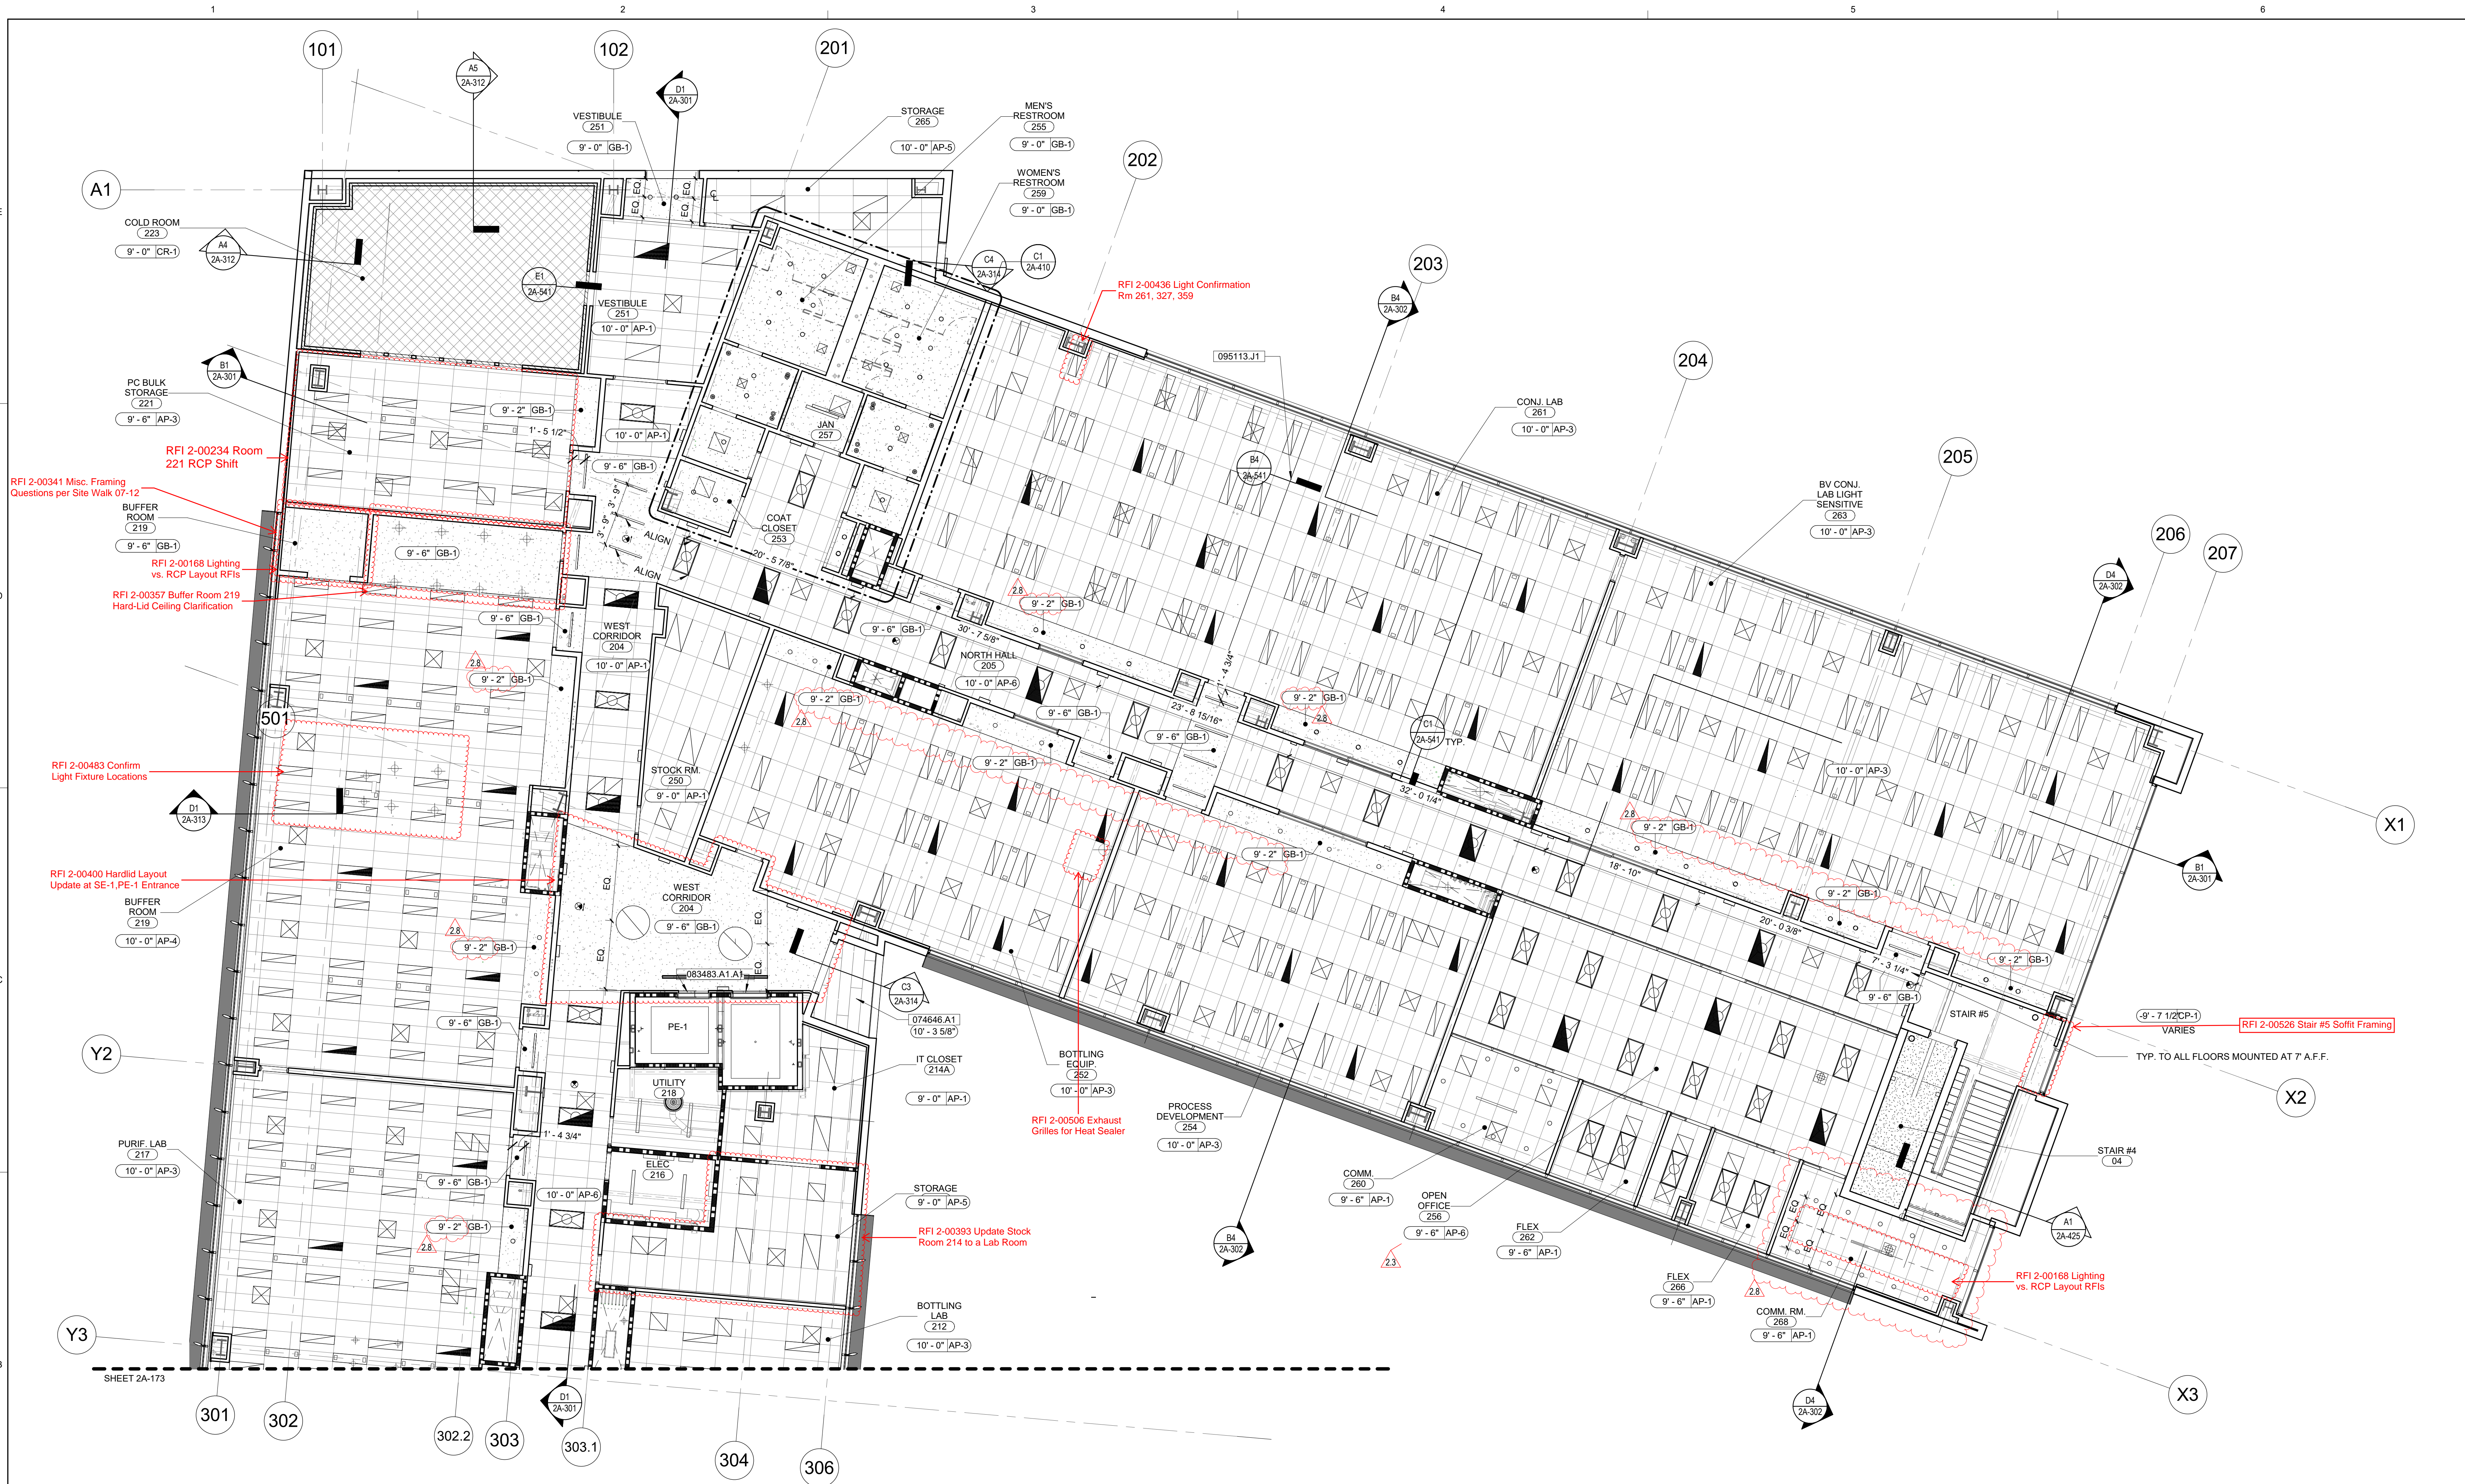2/27/2018 3:08:06 PM  
ALL IDEAS, DESIGNS AND ARRANGEMENTS INDICATED ON THESE DRAWINGS ARE THE PROPERTY OF THE ARCHITECT AND ARE TO BE USED IN CONNECTION WITH THIS SPECIFIC PROJECT AND SHALL NOT BE USED OTHERWISE WITHOUT THE EXPRESSED CONSENT OF THE ARCHITECT. THESE SHALL BE NO CHANGES OR DEVIATION FROM THE DRAWINGS OR ACCOMPANYING SPECIFICATION WITHOUT THE EXPRESSED CONSENT OF THE ARCHITECT.



## B1 LEVEL 02- RCP PART A

1/8" = 1'-0"

### LEGEND - RCP

	GYPSUM BOARD, PAINTED
	CEMENT PLASTER SOFFIT (EXTERIOR)
	ACOUSTICAL PANEL CEILING
	WOOD VENEER PANEL CEILING
	LINEAR METAL OR WOOD PANEL CEILING
	COLD ROOM CEILING BY MANUFACTURER
	3/4" THICK WHITE MELAMINE (HUMIDITY RESISTANT) PANEL INSERTED WITH POWER AND DATA, SEE ELECTRICAL DRAWINGS
	EXIT SIGN- SEE ELECTRICAL

### CEILING TYPES

TYPE MARK	DESCRIPTION
AP-1	2-HR RATED GYPSUM ASSEMBLY, PTD.
AP-3	2' X 4' ACOUSTIC PANEL CEILING (OPEN OFFICE AREAS)
AP-4	2' X 4' ACOUSTIC PANEL CEILING W/ 1" X 4" SERVICE TILE (LABS)
AP-5	2' X 4' ACOUSTIC PANEL CEILING (BUFFER ROOMS AND FOOD AREAS)
AP-6	2' X 4' ACOUSTIC PANEL CEILING (BACK OF HOUSE AREAS)
CP-1	2' X 4' ACOUSTIC PANEL CEILING (LABS)
CR-1	CEMENT PLASTER (EXTERIOR)
CR-1	COLD ROOM CEILING
FCS	FIBER CEMENT SOFFIT
GB-1	GYPSUM BOARD, PTD.
GB-2	2-HR RATED GYPSUM ASSEMBLY, PTD.
LM-1	LINEAR METAL CEILING - EXTERIOR
WD-1	WOOD VENEER PANELS
WP-1	WOOD PANEL CEILING
WP-3	WOOD PANEL CEILING
WP-4	WOOD PANEL CEILING
WP-5	WOOD PANEL CEILING

### SHEET KEYNOTES

NUMBER	KEYNOTE TEXT
--------	--------------

### REFERENCE KEYNOTES

NUMBER	KEYNOTE TEXT
074646.A1	FIBER-CEMENT SIDING SYSTEM
083483.A1	ELEVATOR DOOR SMOKE CONTAINMENT SYSTEM-2HR RATED
095113.J1	ACOUSTICAL PANEL CEILINGS SEISMIC JOINT

### GENERAL SHEET NOTES

- CONTRACTOR TO FIELD VERIFY ALL DIMENSIONS.
- SEE CEILING FRAMING DETAILS SEE SHEET 2A-541
- ALL SPRINKLER HEADS IN ATRIUM (INCLUDING ALL AREAS ADJACENT, SUCH AS UNDER BRIDGE AND ELEVATOR BALCONIES, ETC.), MAIN LEVEL 1 CORRIDOR, MULTIPURPOSE ROOM, LEVEL 2 LOUNGE OFF ROOF DECK, LEVEL 3 CONFERENCE ROOM AND LEVEL 4 BREAK ROOM, TO BE FULLY CONCEALED WITH HEAD COVERS PAINTED TO MATCH CEILING COLOR THEY ARE WITHIN.
- REFER TO FINISH SCHEDULE FOR CEILING TYPE MATERIAL INFORMATION AND PRODUCT SELECTIONS.
- PROVIDE ACCESS PANELS IN GYPSUM BOARD CEILINGS/SOFFITS WHETHER INDICATED OR NOT, TO PERMIT PROPER OPERATION AND MAINTENANCE OF EQUIPMENT ABOVE INACCESSIBLE CEILINGS. COORDINATE LOCATIONS OF ACCESS PANELS WITH MECHANICAL, PLUMBING, AND ELECTRICAL TRADES. CONTRACTOR TO PROVIDE ACCESS PANEL LOCATION SUBMITTAL FOR ARCHITECT'S REVIEW AND APPROVAL PRIOR TO INSTALLATION. SEE DETAIL C5 / 2A-541
- EXIT SIGNS REQUIRED AT ALL REQUIRED EXITS PER SECTION 1011 OF THE 2016 CBC.
- REFER TO ELECTRICAL DRAWINGS FOR ADDITIONAL LIGHTING INFORMATION.
- ALL COLD ROOMS AND FREEZER ROOMS TO BE G.F.C.I.
- ANY LAY-IN CEILING OVER 2,500 SF TO HAVE A SEISMIC JOINT.
- FOR WINDOW SHADE WALL-MOUNTED TYPICALLY, SEE DETAIL D1 / 2A-577.
- FOR WINDOW SHADE RECESSED IN CEILING SOFFIT AT MULTIPURPOSE ROOM AND SERVERY, SEE DETAIL C1 / 2A-578
- FOR CEILING DETAILS SEE SHEET 2A-541

PROJECT NO. 16148

REV NO.	DATE ISSUED	REASON
04	25.17	DESIGN DEVELOPMENT
08	08.17	CITY SUBMITTAL SET
2.2	10.03.17	ADDENDUM 2.2
2.3	11.20.17	ASI 2.1/FC
2.8	02.14.18	ASI 2.8

CP-2  
VOLUME 2

IFC 11.20.17

Sheet Title  
**SECOND LEVEL  
RCP- PART A**

Sheet No.  
**2A-172**



4/19/2018 8:34:42 PM  
ALL IDEAS, DESIGNS AND ARRANGEMENTS INDICATED ON THESE DRAWINGS ARE THE PROPERTY OF THE ARCHITECT AND ARE TO BE USED IN CONNECTION WITH THIS SPECIFIC PROJECT AND SHALL NOT BE USED OTHERWISE WITHOUT THE EXPRESSED CONSENT OF THE ARCHITECT. THESE SHALL BE NO CHANGES OR DEVIATION FROM THE DRAWINGS OR ACCOMPANYING SPECIFICATION WITHOUT THE EXPRESSED CONSENT OF THE ARCHITECT.



**A1** FINISH PLAN - LEVEL 02-Z2 - PART A

1/8" = 1'-0"

INTERIORS TOILET ACCESSORIES		
TYPE MARK	MFR.	DESCRIPTION
TA-1	BOBRICK	B-3803 TrimLine Series Recessed Combination Towel and Waste Unit
TA-2	BOBRICK	B-3577 Partition Mounted Combo Unit Double Sided Womens
TA-3	BOBRICK	B-2886 Surface Mounted Multi-roll Toilet Tissue Dispenser
TA-4	BOBRICK	B-270 Contura Series Surface Mounted Sanitary Napkin Disposal
TA-5	BOBRICK	B-221 Surface Mounted Seat Cover Dispenser
TA-6	BOBRICK	1 1/4" Diameter Stainless Steel Grab Bars with Snap Flange
TA-7	BOBRICK	1 1/4" Diameter Stainless Steel Grab Bars with Snap Flange
TA-8	SLOAN	ESD-500 Sensor Activated Soap Dispenser
TA-9	TO BID	VANITY MIRROR, 14'-0"W x 3'-9"H
TA-9.1	Restoration Hardware	23220115 CHR - Pivot Mirror
TA-9.2	TO BID	VANITY MIRROR, 4'-6"W x 3'-9"H
TA-9.3	TO BID	VANITY MIRROR, 6'-4"W x 4'-9"H
TA-10	BOBRICK	B-239 Utility Shelf with Rag Hooks and Broom Holders
TA-11	BOBRICK	B-672 Robe Hook
TA-13	ENMOTION	Recessed Automated Paper Towel Dispenser, MFG Part # 59466
TA-17	BOBRICK	B-3574 Classic Series Recessed Toilet Seat Cover Toilet Tissue Dispenser and Sanitary Napkin Disposal Unit
TA-18	BOBRICK	B-3474 Classic Series Recessed Single Compartment Combination Toilet Seat Cover and Tissue Dispenser
TA-21	BOBRICK	Bobrick 910615 Contura Series Surface Mounted Soap Dispenser
TA-22	BOBRICK	Bobrick B-262 Classic Series Surface Mounted Paper Towel Dispenser

**SHEET KEYNOTES**

NUMBER	KEYNOTE TEXT
--------	--------------

**REFERENCE KEYNOTES**

NUMBER	KEYNOTE TEXT
--------	--------------

**GENERAL NOTES - INTERIOR**

- CONTRACTOR TO FIELD VERIFY ALL DIMENSIONS.
- ALL WRITTEN DIMENSIONS TAKE PRECEDENCE. VERIFY IN FIELD PRIOR TO COMMENCEMENT AND REPORT ANY DISCREPANCIES TO THE ARCHITECT OR DESIGNER.
- REFER TO ARCHITECTURAL DRAWINGS FOR WALL TYPES.
- THE GENERAL CONTRACTOR TO PROVIDE ALL NECESSARY BLOCKING AND BACKING FOR WALL MOUNTED ACCESSORIES, EQUIPMENT, AND FIXTURES PER THE MANUFACTURER'S RECOMMENDATIONS.
- THE GENERAL CONTRACTOR TO SUBMIT FINISH SAMPLES AND PRODUCT DATA OF ALL MATERIALS FOR DESIGNER'S REVIEW AND APPROVAL PRIOR TO ORDERING AND FABRICATION.
- THE GENERAL CONTRACTOR TO SUBMIT SEAMING DIAGRAM AND TILE LAYOUT DRAWINGS FOR DESIGNER'S REVIEW AND APPROVAL PRIOR TO ORDERING AND FABRICATION. CONTRACTOR TO NOTIFY DESIGNER IF TILE LAYOUT WILL RESULT IN TILES LESS THAN 2" IN WIDTH.
- THE MILLWORK CONTRACTOR IS TO FIELD VERIFY ALL DIMENSIONS AND CONDITIONS AND SUBMIT SHOP DRAWINGS FOR DESIGNER'S REVIEW AND APPROVAL PRIOR TO ORDERING AND FABRICATION.
- ALL WALLS RECEIVING WALL COVERING TO HAVE A LEVEL 5 FINISH, U.N.O.
- ALL FINISHES TO BE OF CLASS A RATING PER CBC.
- ALL DIMENSIONS IN ELEVATIONS ARE FROM THE FINISHED FLOOR.
- SEE SHEET A1 / 2A-578 AND E1 / 2A-576 FOR MOUNTING HEIGHTS AND ALIGNMENTS OF LIGHT SWITCHES, THERMOSTATS, ETC.
- ALL MECHANICAL GRILLES AND DIFFUSERS LOCATED IN WALLS TO BE PAINTED TO MATCH THE ADJACENT SURFACE.
- SEE SHEET 2A-601 FOR FINISH LEGEND.
- THE GENERAL CONTRACTOR TO CONFIRM ALL SWITCHPLATES, THERMOSTATS, DIMMING CONTROL, ETC. COVER COLORS WITH INTERIORS PRIOR TO ORDERING AND INSTALLING.
- ALL WALL TO BE PAINTED P-1 U.O.N. ON PLANS.
- HAND-OPERATED METERING FAUCETS SHALL REMAIN OPEN FOR 10 SECONDS MINIMUM.

PROJECT NO. 16148

REV NO.	DATE ISSUED	REASON
04	25.17	DESIGN DEVELOPMENT
08	08.17	CITY SUBMITTAL SET
2.2	10.03.17	ADDENDUM 2.2
2.3	11.20.17	ASI 2.1/FC
2.5	01.26.18	ASI 2.3 BUFFER ROOM REVISIONS
2.9	03.29.18	ASI 2.9

IFC 11.20.17

Sheet Title

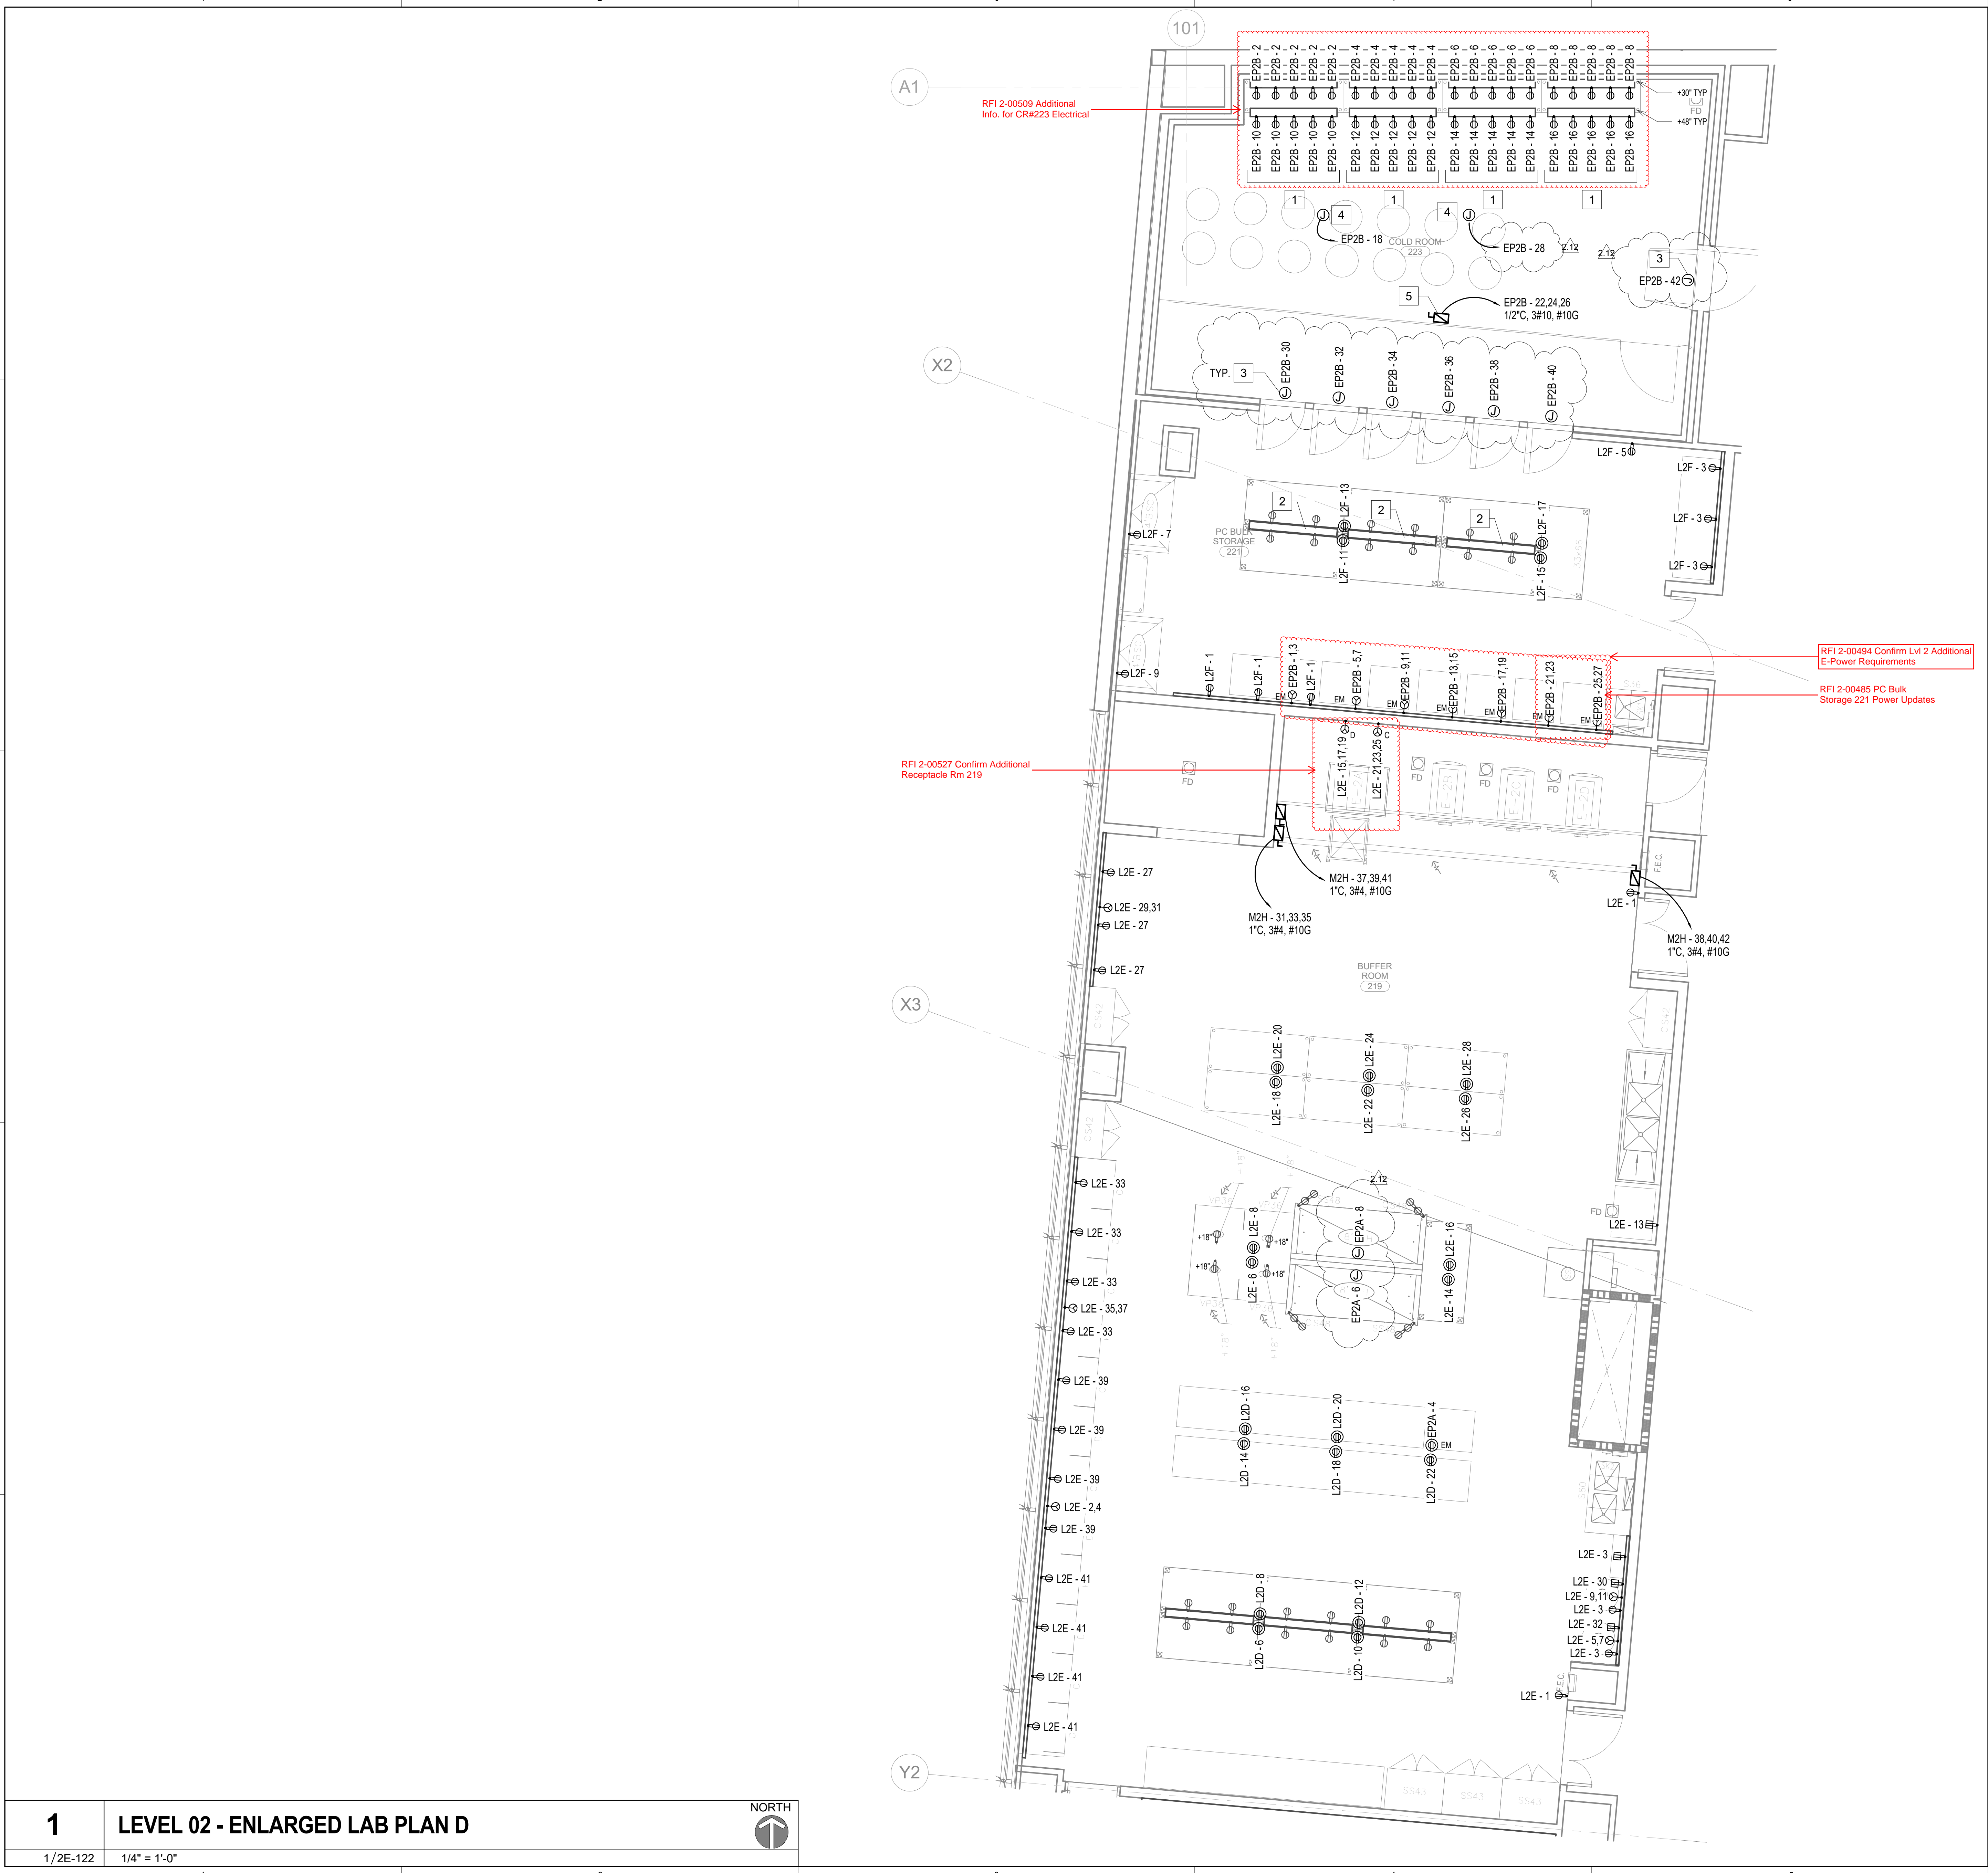
**SECOND LEVEL  
FINISH PLAN -  
PART A**

Sheet No.

**21-122**



6/2018 8:40:09 AM  
ALL DESIGNS AND ARRANGEMENTS INDICATED ON THESE DRAWINGS ARE THE PROPERTY OF THE ARCHITECT AND ARE TO BE USED IN CONNECTION WITH THIS SPECIFIC PROJECT AND SHALL NOT BE USED OTHERWISE WITHOUT THE EXPRESSED CONSENT OF THE ARCHITECT.




## SHEET GENERAL NOTES

- CONTRACTOR TO PROVIDE A WIRELESS DISTRIBUTED ANTENNA SYSTEM THROUGHT THE BUILDING. REFER TO SPECIFICATION SECTION 275319 FOR SYSTEM DESCRIPTION.
- PRIOR TO ROUGH-IN, COORDINATE CONDUIT AND PULL BOX LOCATIONS WITH MECHANICAL CONTRACTOR TO AVOID ANY PIPING, DUCTING, CONDUIT CONFLICT.
- NO PULL BOX SHALL BE LOCATED IN CORRIDORS.
- WALL MOUNTED RACEWAY TO BE DUAL CHANNEL LEGRAND AL4400 OR EQUAL, MOUNTED AT 48" AFF, TO TOP OF RACEWAY UNO. PROVIDE SPARE 1" CONDUIT AT MIDDLE OF RACEWAY LOCATED ON WALL, BACK TO ELECTRICAL PANEL FEEDING RACEWAY.
- BENCH MOUNTED RACEWAY TO BE SINGLE CHANNEL LEGRAND AL3000 OR EQUAL, MOUNTED AT 43" AFF TO TOP OF RACEWAY.
- SEE SHEET 2E-001 FOR SPECIAL RECEPTACLE TYPE DESIGNATIONS AND WIRE CALLOUTS.

## SHEET KEYNOTES

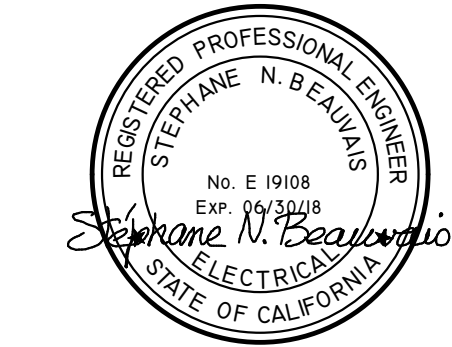NUMBER	KEYNOTE TEXT
1	PROVIDE (2) SINGLE CHANNEL PREASSEMBLED RACEWAYS PER RACK.
2	PROVIDE DEDICATED 120V CIRCUIT TO EACH SINGLE CHANNEL RACEWAY MOUNTED ON BENCH.
3	PROVIDE 120V POWER FOR DOOR FRAME AND WINDOW HEATERS.
4	PROVIDE 120V, 1PH POWER FOR COLD ROOM EVAPORATOR. COORDINATE LOCATION AND REQUIREMENTS WITH COLD ROOM MANUFACTURER PRIOR TO ROUGH-IN.
5	DEHUMIDIFIER LOCATED ON TOP OF COLD ROOM.



CP-2  
VOLUME: 3

PROJECT NO. 16148

REV NO.	DATE ISSUED	REASON
	04.25.17	DESIGN DEVELOPMENT
	08.08.17	CITY SUBMITTAL
2.2	10.03.17	ADDENDUM #2.2
2.5	01.26.18	ASI 2.3 BUFFER ROOM REVISIONS
2.12	06.05.18	ASI 2.12



IFC 11.20.17

Sheet Title  
**SECOND LEVEL  
- ENLARGED  
LAB PLAN D**

Sheet No.  
**2E-424**



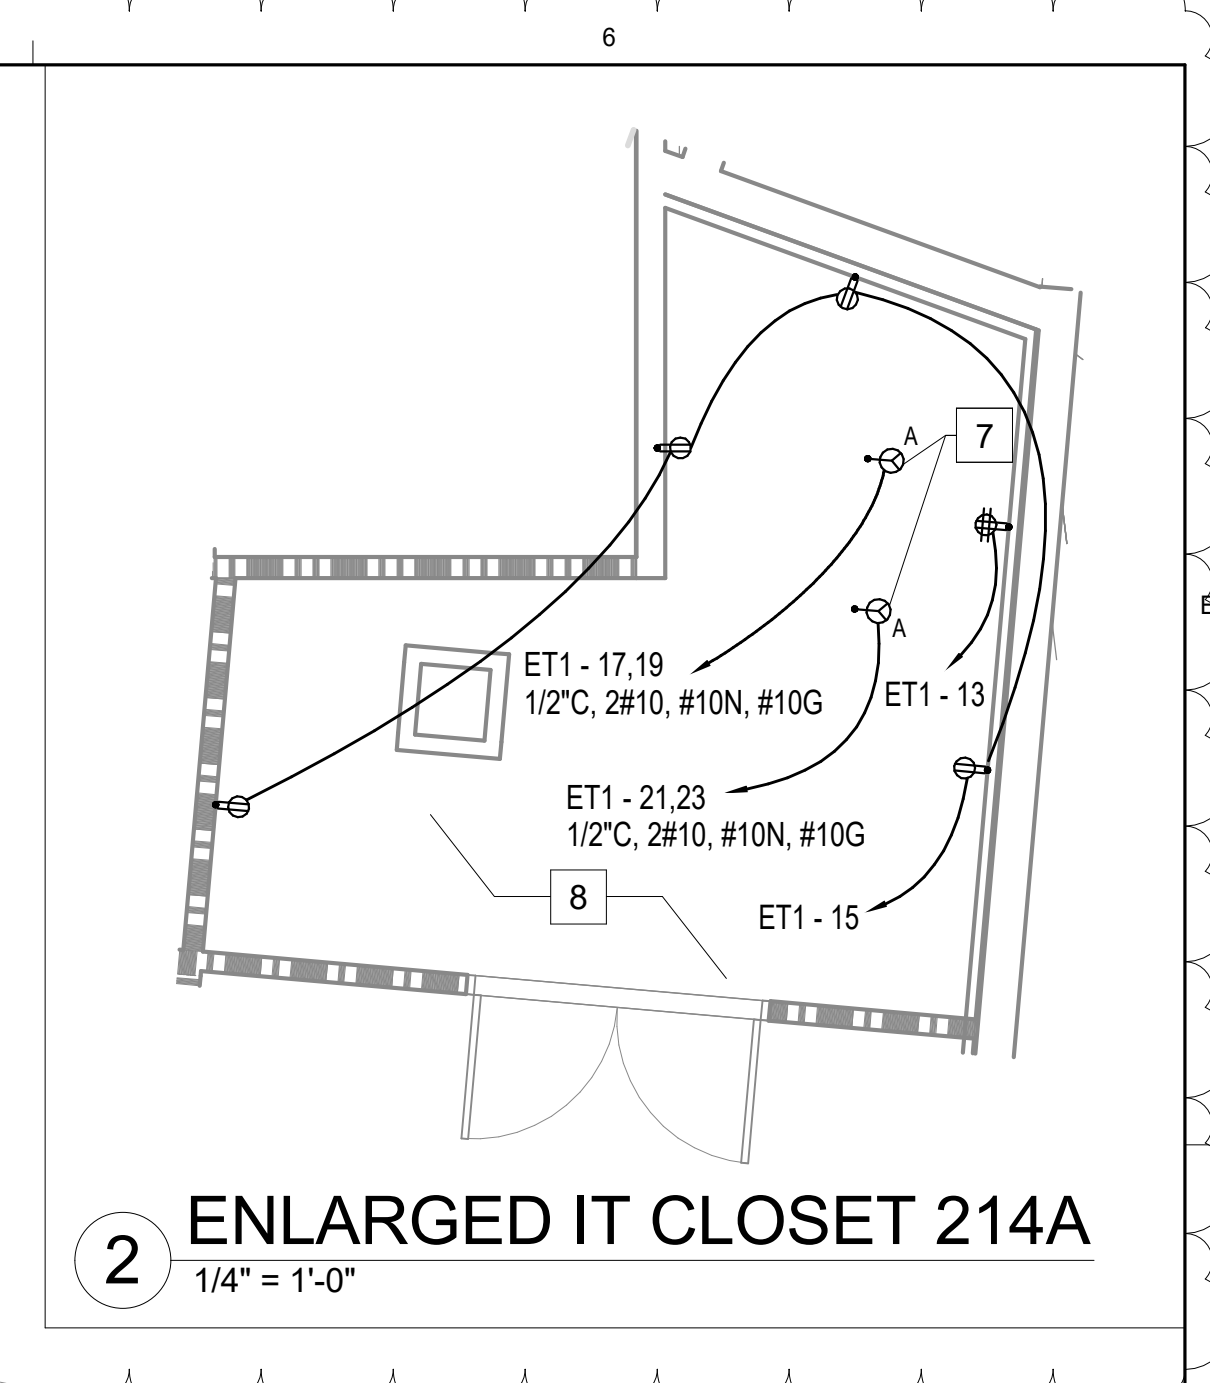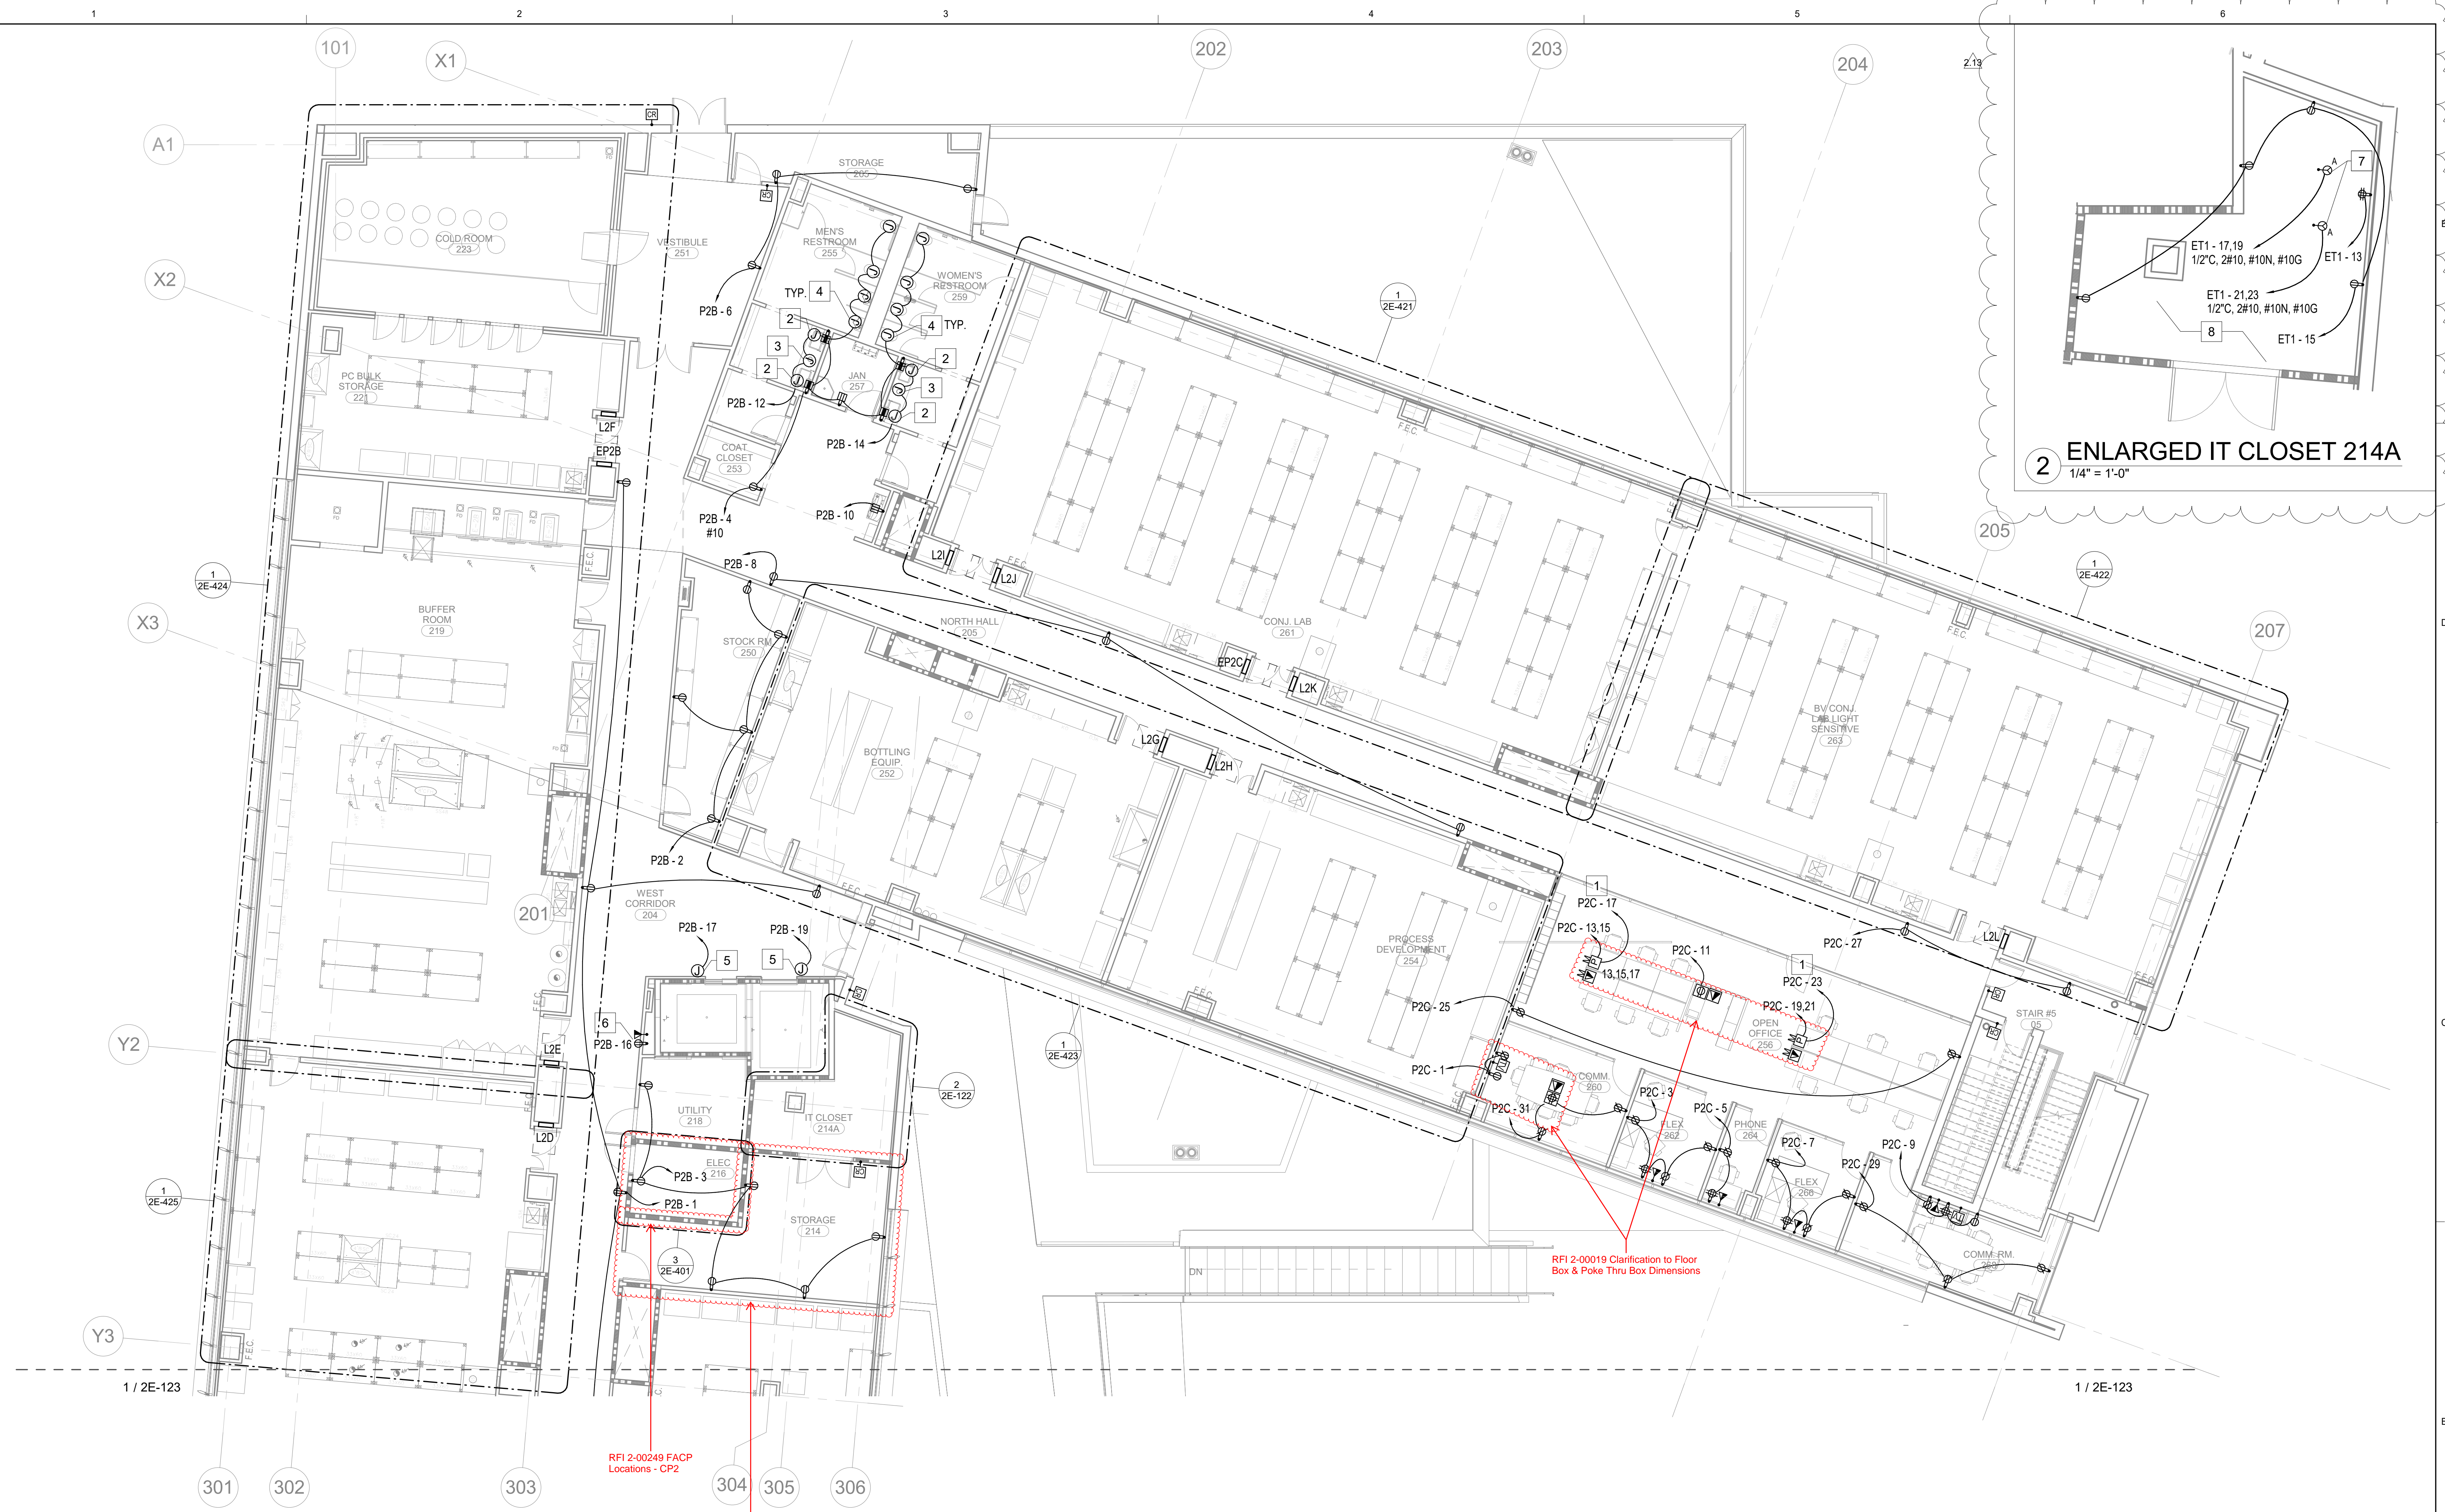7/26/2018 5:18:00 PM  
ALL IDEAS, DESIGNS AND ARRANGEMENTS INDICATED ON THESE DRAWINGS ARE THE PROPERTY OF THE ARCHITECT AND ARE TO BE USED IN CONNECTION WITH THIS SPECIFIC PROJECT AND SHALL NOT BE USED OTHERWISE WITHOUT THE EXPRESSED CONSENT OF THE ARCHITECT. THESE SHALL BE NO CHANGES OR DEVIATION FROM THE DRAWINGS OR ACCOMPANYING SPECIFICATION WITHOUT THE EXPRESSED CONSENT OF THE ARCHITECT.



CP-2  
VOLUME: 3

PROJECT NO. 16148		
REV NO.	DATE ISSUED	REASON
	04.25.17	DESIGN DEVELOPMENT
	08.08.17	CITY SUBMITTAL
2.1	08.29.17	ADDENDUM #2.1
2.2	10.03.17	ADDENDUM #2.2
2.6	01.19.18	ASI 2.4
2.12	06.05.18	ASI 2.12
2.13	07.27.18	ASI 2.13

# 1 LEVEL 02 - PART A - POWER

1/8" = 1'-0"

## SHEET GENERAL NOTES

- CONTRACTOR TO PROVIDE A WIRELESS DISTRIBUTED ANTENNA SYSTEM THROUGHOUT THE BUILDING. REFER TO SPECIFICATION SECTION 275319 FOR SYSTEM DESCRIPTION.
- PRIOR TO ROUGH-IN, COORDINATE CONDUIT AND PULL BOX LOCATIONS WITH MECHANICAL CONTRACTOR TO AVOID ANY PIPING, DUCTING, CONDUIT CONFLICT.
- NO PULL BOX SHALL BE LOCATED IN CORRIDORS. CIRCUIT EXTERIOR LIGHTING VIA ASTRONOMICAL TIME CLOCK.

## SHEET KEYNOTES

NUMBER	KEYNOTE TEXT
1	PROVIDE CONTROLLED CIRCUIT FOR FURNITURE RECEPTACLES.
2	PROVIDE 120V POWER FOR PAPER TOWEL DISPENSER. COORDINATE LOCATION AND REQUIREMENTS WITH INTERIORS CONSULTANT PRIOR TO ROUGH-IN.
3	PROVIDE 120V POWER FOR SOAP DISPENSERS AND SINK FAUCETS. COORDINATE LOCATION AND REQUIREMENTS WITH PLUMBING CONTRACTOR PRIOR TO ROUGH-IN.
4	PROVIDE 120V POWER FOR FLUSH VALVES. COORDINATE LOCATION AND REQUIREMENTS WITH PLUMBING CONTRACTOR PRIOR TO ROUGH-IN.
5	PROVIDE 120V, 20A, 1PH POWER FOR ELEVATOR SMOKE CURTAIN. COORDINATE LOCATION AND REQUIREMENTS WITH SMOKE CURTAIN MANUFACTURER PRIOR TO ROUGH-IN.
6	PROVIDE POWER FOR TIME CLOCK LOCATED IN NICHE 40" AFF. COORDINATE LOCATION WITH ARCHITECT PRIOR TO ROUGH-IN.

## SHEET KEYNOTES

NUMBER	KEYNOTE TEXT
7	MOUNT OUTLET FOR UPS TO LADDER RACK. OWNER TO PROVIDE RACK MOUNT UPS WITH 208V/1PH/30A CONNECTION.
8	COORDINATE LOCATION AND HEIGHTS OF ALL RECEPTACLES WITH IT FACILITIES PRIOR TO ROUGH-IN.

IFC 11.20.17

Sheet Title  
**SECOND LEVEL  
- PART A -  
POWER**

Sheet No.  
**2E-122**

DPR Issued Sheet 2018-07-27  
Link to the Sheet - 2G-002



11/22/2017 8:25:17 AM  
ALL IDEAS, DESIGNS AND ARRANGEMENTS INDICATED ON THESE DRAWINGS ARE THE PROPERTY OF THE ARCHITECT AND ARE TO BE USED IN CONNECTION WITH THIS SPECIFIC PROJECT AND SHALL NOT BE USED OTHERWISE WITHOUT THE EXPRESSED CONSENT OF THE ARCHITECT.

ELECTRICAL ABBREVIATIONS		LIGHTING LEGEND		GENERAL SYMBOLS LEGEND		POWER LEGEND		GENERAL NOTES	
A	AMPERES	(COORDINATE THE EXACT MOUNTING AND LOCATION OF ALL LIGHTING, SUPPORTS AND ALL CONDUITS WITH OTHER TRADES PRIOR TO ROUGH-IN. SEE ARCH PLANS FOR EXACT GRID, FLUSH AND SURFACE MOUNTING LOCATIONS.)		<div><div><div><div>1</div><div>SHEET NOTE REFERENCE</div></div><div><div><div>3</div><div>E1</div></div><div>DETAIL NUMBER DESIGNATION</div><div>SHEET ON WHICH DETAIL IS FOUND</div></div><div><div><div></div><div>CONDUIT STUBOUT</div></div><div><div></div><div>CONDUIT RISING UP</div></div><div><div></div><div>CONDUIT CONCEALED IN WALLS OR CEILING.</div></div><div><div></div><div>CONDUIT DROP DOWN</div></div><div><div></div><div>CONDUIT CONCEALED IN FLOOR, UNDERFLOOR, OR BELOW GRADE</div></div><div><div></div><div>CONDUIT RUN EXPOSED</div></div><div><div></div><div>FLEXIBLE CONDUIT</div></div><div><div><div></div><div>CROSSMARKS DENOTE QUANTITY OF NEUTRAL (LONG), PHASE (SHORT), AND GROUND (DOT) CONDUCTORS IN BRANCH CIRCUIT CONDUIT. NO CROSSMARKS DENOTES PHASE, NEUTRAL, AND GROUND WIRES. NUMBER ADJACENT TO CROSSMARKS DENOTES WIRE SIZE OTHER THAN #12 FOR ALL CONDUCTORS UNO.</div></div><div><div></div><div>HOMERUN TO PANEL AND CIRCUITS INDICATED.</div></div></div></div></div></div>		<div><div><div><div><div></div><div>DUPLEX RECEPTACLE, NON-LOCKING TYPE, GROUNDING, 120V - 20A. MOUNTED AT +18 AFF UNO. SHADED REPRESENTS ABOVE COUNTER OR +42" AFF.</div></div><div><div><div></div><div>QUAD RECEPTACLE, NON-LOCKING TYPE, GROUNDING, 120V - 20A. MOUNTED AT +18 AFF UNO. SHADED REPRESENTS ABOVE COUNTER OR +42" AFF.</div></div><div><div><div></div><div>DUPLEX RECEPTACLE WITH GFCI, NON-LOCKING TYPE, GROUNDING, 120V - 20A. MOUNTED AT +18 AFF UNO. SHADED REPRESENTS ABOVE COUNTER OR +42" AFF.</div></div><div><div><div></div><div>SPECIAL RECEPTACLE, TYPE AS NOTED. MOUNTED AT +18 AFF UNO.</div></div><div><div><div></div><div>SPECIAL RECEPTACLE, TYPE AS NOTED. CEILING MOUNTED.</div></div><div><div><div></div><div>TYPE DESIGNATORS</div><div>NONE = L6-20R: 1/2"C, 2#12, #12N, #12G</div><div>A = L6-30R: 1/2"C, 2#10, #10N, #10G</div><div>B = L6-50R: 3/4"C, 2#6, #6N, #10G</div><div>C = L15-30R: 3/4"C, 3#8, #10G</div><div>D = L15-60R: 1"C, 3#4, #8G</div></div><div><div><div></div><div>CEILING MOUNTED DUPLEX OR QUAD RECEPTACLE, NON-LOCKING TYPE, GROUNDING.</div></div><div><div><div></div><div>POWER FLOOR BOX.</div></div><div><div><div></div><div>CONTROLLED RECEPTACLE NON-LOCKING TYPE 120V-20A. TO BE LOCATED WITHIN 6" OF AN UNCONTROLLED RECEPTACLE. CONNECT SWITCH LEG BETWEEN RELAY POWER PACK AND OCCUPANCY CONTROLS FOR AUTOMATIC SHUT OFF. CONTROLLED RECEPTACLES SHALL HAVE PERMANENT MARKING TO DIFFERENTIATE THEM FROM UNCONTROLLED RECEPTACLES. (CEC TITLE 24 SECTION 130.5(D)). PROVIDE FACEPLATE PER NEC 406.3(E). QUAD RECEPTACLES TO HAVE ONE CONTROLLED DUPLEX AND ONE NON-CONTROLLED DUPLEX.</div></div></div></div></div><div><div><div></div><div>WALL OR FLOOR POWER CONNECTION TO MODULAR FURNITURE. VERIFY EXACT LOCATION WITH FURNITURE SUPPLIER.</div></div><div><div><div></div><div>JUNCTION BOX</div></div><div><div><div></div><div>TRANSFORMER</div></div><div><div><div></div><div>SWITCHBOARD OR MCC</div></div><div><div><div></div><div>PANEL BOARD (SURFACE)</div></div><div><div><div></div><div>PANEL BOARD (FLUSH)</div></div><div><div><div></div><div>LOW VOLTAGE PANEL</div></div><div><div><div></div><div>LIGHTING CONTROL PANEL</div></div><div><div><div></div><div>TELEPHONE BACKBOARD. 3/4" PLYWOOD, LENGTH AND WIDTH AS NOTED.</div></div></div></div></div></div></div></div></div></div></div></div></div></div></div></div></div></div></div>		<div><div><div><div><div></div><div>ALL ELECTRICAL SYSTEMS PER NEC.</div></div><div><div><div></div><div>ALL ELECTRICAL SYSTEMS PER CEC 2016.</div></div><div><div><div></div><div>ELECTRICAL CONTRACTOR TO VERIFY EXACT LOCATION OF RECEPTACLES IN TELECOM ROOMS PRIOR TO ROUGH-IN.</div></div><div><div><div></div><div>ALL EXTERIOR LIGHTING INSTALLATIONS AND LAMP TYPE SHALL COMPLY WITH CITY OF OUTDOOR LIGHTING REGULATIONS 142.0740.</div></div><div><div><div></div><div>THIS DRAWING SHALL BE READ IN CONJUNCTION WITH ALL OTHER DOCUMENTATION. COORDINATE WITH ALL OTHER TRADES FOR EQUIPMENT LOCATIONS.</div></div><div><div><div></div><div>COORDINATE WITH ARCHITECTURAL DRAWINGS FOR EXACT LOCATION AND MOUNTING HEIGHT OF ALL RECEPTACLES AND DEVICES.</div></div><div><div><div></div><div>COORDINATE WITH EQUIPMENT MANUFACTURER FOR LOCATIONS AND CONNECTIONS.</div></div><div><div><div></div><div>VERIFY ALL MECHANICAL EQUIPMENT LOCATIONS WITH MECHANICAL AND ARCHITECTURAL DRAWINGS PRIOR TO ROUGH-IN.</div></div><div><div><div></div><div>EACH BRANCH CIRCUIT THAT SUPPLIES NON-LINEAR LOADS INCLUDING COMPUTERS, COMMUNICATION RACKS, ETC. MUST HAVE A DEDICATED NEUTRAL.</div></div><div><div><div></div><div>MULTI-WIRE BRANCH CIRCUITS FOR GENERAL LOADS CAN INCLUDE UP TO THREE PHASE CONDUCTORS WITH A SHARED NEUTRAL IN A RACEWAY IF A MULTI-POLE BREAKER IS PROVIDED TO SIMULTANEOUSLY DISCONNECT ALL SINGLE POLE CIRCUIT BREAKERS THAT SUPPLY INDIVIDUAL PHASE CONDUCTORS OF THE MULTI-WIRE CIRCUIT.</div></div></div></div></div></div></div></div></div></div></div></div></div></div>	
ADA	AMERICANS WITH DISABILITIES ACT								
AFB	ABOVE FINISHED FLOOR	1,2,3 etc. = BRANCH CIRCUIT NUMBERS a,b,c etc. = SWITCH-LEG REFERENCE NL = NIGHT/SECURITY LIGHTING FIXTURE		<div><div><div><div></div><div>COMBINATION VOICE/DATA OUTLET MOUNTED AT 18" UNO.</div></div><div><div><div></div><div>WALL MOUNTED VOICE OUTLET AT +18" UNO.</div></div><div><div><div></div><div>WALL MOUNTED DATA OUTLET AT +18" UNO.</div></div><div><div><div></div><div>CEILING MOUNTED DATA OR VOICE/DATA OUTLET.</div></div><div><div><div></div><div>FLOOR DATA OR VOICE/DATA OUTLET.</div></div><div><div><div></div><div>WALL OR FLOOR VOICE/DATA CONNECTION TO MODULAR FURNITURE. VERIFY EXACT LOCATION WITH FURNITURE SUPPLIER.</div></div><div><div><div></div><div>WALL MOUNTED TELEVISION OUTLET.</div></div><div><div><div></div><div>WALL MOUNTED AUDIO/VISUAL OUTLET.</div></div><div><div><div></div><div>SPEAKER - CEILING MOUNTED.</div></div><div><div><div></div><div>12" WIDE MONO-TRAY, 4" DEEP (NOMINAL), 6" RUNG SPACING. TYPICAL UNO</div></div><div><div><div></div><div>12" WIDE CABLE TRAY, 4" DEEP (NOMINAL) TYPICAL UNO.</div></div></div></div></div><div>COORDINATE THE EXACT MOUNTING OF ALL CABLE TRAY SUPPORTS AND ALL CONDUITS WITH OTHER TRADES PRIOR TO ROUGH-IN.</div></div></div></div></div></div></div></div></div></div>		<div><div><div><div><div></div><div>GROUND</div></div><div><div><div></div><div>CIRCUIT BREAKER</div></div><div><div><div></div><div>CURRENT TRANSFORMERS</div></div><div><div><div></div><div>TRANSFORMER DELTA PRIMARY, WYE SECONDARY WITH KVA RATING</div></div><div><div><div></div><div>SPD</div><div>SURGE PROTECTION DEVICE</div></div><div><div><div></div><div>GFP</div><div>GROUND FAULT PROTECTION</div></div><div><div><div></div><div>CB</div><div>ENCLOSED CIRCUIT BREAKER</div></div><div><div><div></div><div>TC</div><div>TIME CLOCK</div></div><div><div><div></div><div>M</div><div>KILOWATT-HOUR METER</div></div><div><div><div></div><div>FUSED SWITCH</div></div><div><div><div></div><div>NON-FUSIBLE DISCONNECT SWITCH (RATINGS AS NOTED)</div></div><div><div><div></div><div>FUSIBLE DISCONNECT SWITCH (RATINGS AS NOTED)</div></div><div><div><div></div><div>2</div><div>MOTOR STARTER (NEMA SIZE AS NOTED)</div></div><div><div><div></div><div>2</div><div>COMBINATION FUSIBLE DISCONNECT SWITCH AND MOTOR STARTER, (NEMA SIZE AS NOTED), 3P, 600 VAC MAXIMUM RATING.</div></div><div><div><div></div><div>\$</div><div>T</div><div>TOGGLE TYPE FRACTIONAL HP MANUAL MOTOR STARTER WITH THERMAL OVERLOADS (DELETED IF FOR DISCONNECT USE ONLY) AND HANDLE GUARD/LOCK-OFF, 2 POLES (VERIFY WITH BRANCH CIRCUIT).</div></div><div><div><div></div><div>EPO</div><div>- EMERGENCY POWER OFF BUTTON</div></div><div><div><div></div><div>MOTOR</div></div><div><div><div></div><div>AUTOMATIC TRANSFER SWITCH</div></div><div><div><div></div><div>CIRCUIT BREAKER CALLOUT</div></div><div><div><div></div><div>225</div><div>-TRIP SIZE</div></div><div><div><div></div><div>3</div><div>-POLE</div></div><div><div><div></div><div>FUSE CALLOUT</div></div><div><div><div></div><div>150</div><div>-FUSE SIZE</div></div><div><div><div></div><div>3</div><div>-POLE</div></div></div></div></div></div></div></div></div></div></div></div></div></div></div></div></div></div></div></div></div></div></div></div></div></div></div></div>			
ALT.	ALTERNATE	EMERGENCY LIGHTING FIXTURES. EMERGENCY LIGHTING TO AUTOMATICALLY ILLUMINATE THE MEANS OF EGRESS FOR A DURATION OF NOT LESS THAN 90 MINUTES. SEE FIXTURE SCHEDULE FOR MODEL/PART NUMBERS AND ADDITIONAL DETAILS.		GENERAL SYMBOLS LEGEND		GENERAL NOTES			
ATS	AUTOMATIC TRANSFER SWITCH	LUMINAIRE(S) POLE MOUNTED WITH ARM. TYPE AS NOTED.		COMMUNICATION LEGEND		GENERAL NOTES			
C	CONDUIT	LUMINAIRE(S) POLE MOUNTED ON TOP. TYPE AS NOTED.		SINGLE LINE LEGEND		GENERAL NOTES			
CB	CIRCUIT BREAKER	SUBSCRIPT ADJACENT TO LIGHTING FIXTURE INDICATES:		SINGLE LINE LEGEND		GENERAL NOTES			
CFCI	CONTRACTOR FURNISHED, CONTRACTOR INSTALLED	1,2,3 etc. = BRANCH CIRCUIT NUMBERS a,b,c etc. = SWITCH-LEG REFERENCE NL = NIGHT/SECURITY LIGHTING FIXTURE		SINGLE LINE LEGEND		GENERAL NOTES			
CFL	COMPACT FLUORESCENT LAMP	EMERGENCY BUGEYE FIXTURE.		SINGLE LINE LEGEND		GENERAL NOTES			
CKT.	CIRCUIT	LIGHTED EXIT SIGN. TOP MOUNTED ON CEILING OR STEM MOUNTED. SHADED SIDE INDICATES FACE. PROVIDE ARROWS WHERE SHOWN TO INDICATE DIRECTION OF TRAVEL.		SINGLE LINE LEGEND		GENERAL NOTES			
C.O.	CONDUIT ONLY	DOUBLE SIDED EXIT SIGN. PROVIDE ARROWS WHERE SHOWN TO INDICATE DIRECTION OF TRAVEL.		SINGLE LINE LEGEND		GENERAL NOTES			
CONC.	CONCRETE	TOGGLE SWITCH. SEE BELOW FOR NOTATION.		SINGLE LINE LEGEND		GENERAL NOTES			
CU	COPPER	2 - DOUBLE POLE 3 - THREE WAY 4 - FOUR WAY D - DIMMER K - KEY SWITCH M - MOTION SENSOR a,b,c - INDICATES MULTIPLE SWITCHES IN GANGED BOX WITH COMMON COVERPLATE.		SINGLE LINE LEGEND		GENERAL NOTES			
DIST.	DISTRIBUTION	-LV		SINGLE LINE LEGEND		GENERAL NOTES			
DWG.	DRAWING	(M)		SINGLE LINE LEGEND		GENERAL NOTES			
EM	EMERGENCY SERVICE	(PC)		SINGLE LINE LEGEND		GENERAL NOTES			
ETC	EXEDRA	(DS)		SINGLE LINE LEGEND		GENERAL NOTES			
EG	EQUIPMENT GROUND	(DIM)		SINGLE LINE LEGEND		GENERAL NOTES			
EXIST.	EXISTING	SITE SYMBOLS LEGEND		SINGLE LINE LEGEND		GENERAL NOTES			
FA	FIRE ALARM	OHP		SINGLE LINE LEGEND		GENERAL NOTES			
FLA	FULL LOAD AMPS	OHP		SINGLE LINE LEGEND		GENERAL NOTES			
GFI	GROUND FAULT INTERRUPTER	OHP		SINGLE LINE LEGEND		GENERAL NOTES			
HORIZ.	HORIZONTALLY MOUNTED	OHP		SINGLE LINE LEGEND		GENERAL NOTES			
HP	HORSEPOWER	OHP		SINGLE LINE LEGEND		GENERAL NOTES			
KVA	KILOVOLT-AMPERES	OHP		SINGLE LINE LEGEND		GENERAL NOTES			
KW	KILOWATTS	OHP		SINGLE LINE LEGEND		GENERAL NOTES			
JB	JUNCTION BOX	OHP		SINGLE LINE LEGEND		GENERAL NOTES			
L	LOCKABLE	OHP		SINGLE LINE LEGEND		GENERAL NOTES			
LTG.	LIGHTING	OHP		SINGLE LINE LEGEND		GENERAL NOTES			
MCA	MINIMUM CIRCUIT AMPS	OHP		SINGLE LINE LEGEND		GENERAL NOTES			
MCC	MOTOR CONTROL CENTER	OHP		SINGLE LINE LEGEND		GENERAL NOTES			
MEP	MECHANICAL, ELECTRICAL, PLUMBING	OHP		SINGLE LINE LEGEND		GENERAL NOTES			
MOP	MAXIMUM OVERCURRENT PROTECTION	OHP		SINGLE LINE LEGEND		GENERAL NOTES			
MTD.	MOUNTED	OHP		SINGLE LINE LEGEND		GENERAL NOTES			
MTG. HT.	MOUNTING HEIGHT	OHP		SINGLE LINE LEGEND		GENERAL NOTES			
NIC	NOT IN CONTRACT	OHP		SINGLE LINE LEGEND		GENERAL NOTES			
NFPA	NATIONAL FIRE PROTECTION ASSOCIATION	OHP		SINGLE LINE LEGEND		GENERAL NOTES			
NL	NIGHT LIGHT	OHP		SINGLE LINE LEGEND		GENERAL NOTES			
NTS	NOT TO SCALE	OHP		SINGLE LINE LEGEND		GENERAL NOTES			
OC	ON CENTER	OHP		SINGLE LINE LEGEND		GENERAL NOTES			
OFCI	OWNER FURNISHED, CONTRACTOR INSTALLED	OHP		SINGLE LINE LEGEND		GENERAL NOTES			
P	POLE	OHP		SINGLE LINE LEGEND		GENERAL NOTES			
PB	PULL BOX	OHP		SINGLE LINE LEGEND		GENERAL NOTES			
PH	PHASE	OHP		SINGLE LINE LEGEND		GENERAL NOTES			
PNL	PANEL	OHP		SINGLE LINE LEGEND		GENERAL NOTES			
POC	POINT OF CONNECTION	OHP		SINGLE LINE LEGEND		GENERAL NOTES			
RCP	REFLECTED CEILING PLAN	OHP		SINGLE LINE LEGEND		GENERAL NOTES			
RECEPT	RECEPTACLE	OHP		SINGLE LINE LEGEND		GENERAL NOTES			
REQ'D	REQUIRED	OHP		SINGLE LINE LEGEND		GENERAL NOTES			
RGS	RIGID GALVANIZED STEEL	OHP		SINGLE LINE LEGEND		GENERAL NOTES			
SEC	SECURITY	OHP		SINGLE LINE LEGEND		GENERAL NOTES			
S.N.	SOLID NEUTRAL	OHP		SINGLE LINE LEGEND		GENERAL NOTES			
SWGR.	SWITCHGEAR	OHP		SINGLE LINE LEGEND		GENERAL NOTES			
TC	TERMINAL CABINET	OHP		SINGLE LINE LEGEND		GENERAL NOTES			
TEL.	TELEPHONE	OHP		SINGLE LINE LEGEND		GENERAL NOTES			
T.I.	TENANT IMPROVEMENT	OHP		SINGLE LINE LEGEND		GENERAL NOTES			
TR	TAMPER RESISTANT	OHP		SINGLE LINE LEGEND		GENERAL NOTES			
TYP	TYPICAL	OHP		SINGLE LINE LEGEND		GENERAL NOTES			
U.C.	UNDER COUNTER	OHP		SINGLE LINE LEGEND		GENERAL NOTES			
UL	UNDERWRITERS LABORATORY	OHP		SINGLE LINE LEGEND		GENERAL NOTES			
UNO	UNLESS NOTED OTHERWISE	OHP		SINGLE LINE LEGEND		GENERAL NOTES			
V	VOLTS	OHP		SINGLE LINE LEGEND		GENERAL NOTES			
WH	WATER HEATER	OHP		SINGLE LINE LEGEND		GENERAL NOTES			
W	WATTS	OHP		SINGLE LINE LEGEND		GENERAL NOTES			
WP	WEATHERPROOF	OHP		SINGLE LINE LEGEND		GENERAL NOTES			
XFMR	TRANSFORMER	OHP		SINGLE LINE LEGEND		GENERAL NOTES			
X	EXISTING TO REMAIN	OHP		SINGLE LINE LEGEND		GENERAL NOTES			
XD	EXISTING TO BE DEMOLISHED	OHP		SINGLE LINE LEGEND		GENERAL NOTES			
XR	EXISTING TO BE RELOCATED	OHP		SINGLE LINE LEGEND		GENERAL NOTES			
XL	NEW LOCATION OF EXISTING ITEM	OHP		SINGLE LINE LEGEND		GENERAL NOTES			

LUMINAIRE(S) POLE MOUNTED WITH ARM. TYPE AS NOTED.

LUMINAIRE(S) POLE MOUNTED ON TOP. TYPE AS NOTED.

SUBSCRIPT ADJACENT TO LIGHTING FIXTURE INDICATES:

1,2,3 etc. = BRANCH CIRCUIT NUMBERS

a,b,c etc. = SWITCH-LEG REFERENCE

NL = NIGHT/SECURITY LIGHTING FIXTURE

EMERGENCY BUGEYE FIXTURE.

LIGHTED EXIT SIGN. TOP MOUNTED ON CEILING OR STEM MOUNTED. SHADED SIDE INDICATES FACE. PROVIDE ARROWS WHERE SHOWN TO INDICATE DIRECTION OF TRAVEL.

DOUBLE SIDED EXIT SIGN. PROVIDE ARROWS WHERE SHOWN TO INDICATE DIRECTION OF TRAVEL.

TOGGLE SWITCH. SEE BELOW FOR NOTATION.

2 - DOUBLE POLE

3 - THREE WAY

4 - FOUR WAY

D - DIMMER

K - KEY SWITCH

M - MOTION SENSOR

a,b,c - INDICATES MULTIPLE SWITCHES IN GANGED BOX WITH COMMON COVERPLATE.

LOW VOLTAGE OVERRIDE SWITCH

MOTION SENSOR - CEILING MOUNTED.

PHOTOCELL - CEILING MOUNTED.

DAYLIGHT SENSOR - CEILING MOUNTED.

COMBINATION DAYLIGHT/MOTION SENSOR - CEILING MOUNTED.

OHP

NEW CONDUIT AND/OR CONDUCTOR LINE. SEE BELOW FOR TYPICAL DESIGNATIONS

X-OHP

EXISTING TO BE DEMOLISHED CONDUIT AND/OR CONDUCTOR. SEE BELOW FOR TYPICAL DESIGNATIONS

OHP

EXISTING CONDUIT AND/OR CONDUCTOR LINE TO REMAIN. SEE BELOW FOR TYPICAL DESIGNATIONS

UP

- UNDERGROUND PRIMARY

US

- UNDERGROUND SECONDARY

UC

- UNDERGROUND COMMUNICATIONS

USL

- UNDERGROUND STREET LIGHTING

OHP

- OVERHEAD PRIMARY

OHS

- OVERHEAD SECONDARY

OHC

- OVERHEAD COMMUNICATIONS

NEW MANHOLE

EXISTING MANHOLE

NEW HANDHOLE

EXISTING HANDHOLE

NEW TRANSFORMER

EXISTING TRANSFORMER

NEW MV SWITCH

EXISTING MV SWITCH

NEW OH POLE

EXISTING OH POLE

NEW GUY

EXISTING GUY

NEW OH XFMR

EXISTING OH XFMR



10/25/2016 11:10:12 AM  
ALL DESIGNS AND ARRANGEMENTS INDICATED ON THESE DRAWINGS ARE THE PROPERTY OF THE ARCHITECT AND ARE TO BE USED IN CONNECTION WITH THIS SPECIFIC PROJECT AND SHALL NOT BE USED OTHERWISE WITHOUT THE EXPRESSED CONSENT OF THE ARCHITECT. THESE SHALL BE NO CHANGES OR DEVIATION FROM THE DRAWINGS OR ACCOMPANYING SPECIFICATION WITHOUT THE EXPRESSED CONSENT OF THE ARCHITECT.

VOLTAGE DROP SCHEDULE						
DEVICE	FEEDER		BRANCH CIRCUIT			
	VOLTAGE DROP	WIRE SIZE	MAX VOLTAGE DROP	CIRCUIT	LENGTH	WIRE SIZE
G2	0.00%	(3)600kcmil				
GSB	0.00%	(5)600kcmil				
MSB	0.19%	(10)600kcmil	1.38%	21	269'	#4
ATS-EL	0.32%	#4				
ELH1	0.33%	#1	1.27%	10	304'	#12
ELH2	0.55%	#4	1.45%	2	118'	#12
ELH3	0.58%	#4	1.04%	2	116'	#12
ELH4	0.60%	#4	1.09%	2	111'	#12
T-EL	0.34%	#6				
ELL	0.02%	#1	5.22%	11	261'	#12
ATS-EP	0.39%	(4)600kcmil				
EPH	0.43%	(4)600kcmil				
EPHWL	0.44%	#1	1.37%	2	157'	#12
EPHWM	0.44%	(2)350kcmil	1.39%	31,33,35	136'	#10
EPHWMA	0.46%	4/0	1.12%	14,16,18	128'	#8
EPM4H	1.01%	(2)350kcmil	0.94%	13,15,17	161'	#4
T-EP	0.48%	500kcmil				
EPDP	0.23%	(3)300kcmil				
EP1	0.45%	3/0	1.82%	8	91'	#12
EP2A	0.70%	3/0	2.91%	8	87'	#12
EP2B	1.37%	3/0	1.52%	2	61'	#12
EP2C	0.52%	3/0	1.93%	37,39	120'	#10
EP3A	1.14%	3/0	1.66%	29	60'	#12
EP3B	0.97%	3/0	2.19%	34,36	82'	#12
EP3C	0.87%	3/0	0.88%	29,31	33'	#12
EP3D	1.11%	3/0	2.34%	35	84'	#12
EP4A	1.29%	3/0	1.90%	20,22	63'	#12
EP4B	0.88%	3/0	0.87%	20	58'	#12
EP4C	1.94%	3/0	0.95%	29,31	33'	#6
EP4D	0.60%	3/0	1.89%	12,14	105'	#10
EP4E	0.45%	3/0	0.99%	41	89'	#12
ET1	0.25%	#1	0.13%	1	13'	#12
ET3	0.37%	#1	0.53%	5	36'	#12
T-EPM	0.60%	2/0				
EPM	0.22%	600kcmil	1.91%	7	62'	#10
EPM4L	2.18%	4/0	2.85%	9,11	139'	#8
EPM4LA	2.05%	250kcmil	3.04%	25	106'	#8
T-EPW	0.47%	1/0				
EPLW	0.06%	4/0	3.64%	34	183'	#12
LT1	0.46%	1/0	1.97%	8	274'	#12
LT2	1.33%	#1	2.66%	1	193'	#12
LT3	1.44%	#1	2.86%	1	175'	#12
LT4	1.51%	#1	2.45%	2	160'	#12
M1H	0.23%	600kcmil	1.36%	37,39,41	189'	#12
T-M1	0.25%	1/0				
M1L	0.04%	3/0	2.83%	6,8	218'	#10
M2H	0.46%	600kcmil	0.56%	37,39,41	113'	#4
T-M2	0.49%	1/0				
M2L	0.08%	4/0	2.81%	25,27	103'	#12
M3L	0.30%	#1	3.00%	18,20	102'	#12
M3H	0.44%	3/0	0.71%	37,39,41	144'	#4
M4H	1.10%	(3)300kcmil	1.40%	31,33,35	172'	#8
M4HA	1.14%	3/0	1.47%	8,10,12	185'	#12
M4HB	1.20%	3/0	1.52%	13,15	173'	#12
M4HC	1.21%	3/0	1.19%	25,27,29	136'	#12
T-M4	1.16%	#4				
M4L	0.11%	1/0	2.95%	18,20	184'	#12
T-DP1P	0.25%	(2)4/0				
DP1P	0.04%	(3)400kcmil				

VOLTAGE DROP SCHEDULE						
DEVICE	FEEDER		BRANCH CIRCUIT			
	VOLTAGE DROP	WIRE SIZE	MAX VOLTAGE DROP	CIRCUIT	LENGTH	WIRE SIZE
P1A	0.09%	#1	2.88%	12	240'	#10
P1B	0.89%	1/0	3.01%	10	120'	#12
P1C	0.72%	1/0	2.60%	23	130'	#12
P1D	1.06%	3-3/0	2.48%	22	57'	#12
P1E	0.21%	#1	1.91%	33	55'	#12
P2A	0.75%	1/0	2.75%	12	124'	#12
P2B	0.70%	1/0	2.91%	11	145'	#12
P2C	0.56%	1/0	3.08%	21	154'	#12
PM	0.08%	#1	2.69%	5	90'	#12
T-DP2L	0.65%	500kcmil				
DP2L	0.09%	(3)300kcmil				
L2A	0.21%	3/0	2.08%	37	83'	#12
L2B	0.37%	3/0	1.09%	4,6	28'	#12
L2C	0.61%	3/0	2.97%	8,10	77'	#12
L2D	0.18%	3/0	2.16%	19,21	56'	#12
L2E	0.36%	3/0	1.29%	21,23,25	80'	#8
L2F	0.21%	3/0	0.59%	9	42'	#12
L2G	0.41%	3/0	0.81%	37	54'	#12
L2H	0.40%	3/0	1.27%	31	64'	#12
L2I	0.38%	3/0	1.32%	33	66'	#12
L2J	0.40%	3/0	2.04%	11	82'	#12
L2K	0.49%	3/0	1.55%	29	78'	#12
L2L	0.57%	3/0	1.22%	5	49'	#12
T-DP3L	0.48%	500kcmil				
DP3L	0.08%	(3)300kcmil				
L3A	0.24%	3/0	1.03%	23,25	27'	#12
L3B	0.30%	3/0	0.98%	12	39'	#12
L3C	0.26%	3/0	3.00%	8,10	67'	#12
L3D	0.26%	3/0	0.97%	24	49'	#12
L3E	0.33%	3/0	0.91%	32	60'	#12
L3F	0.30%	3/0	0.73%	25	37'	#12
L3G	0.49%	3/0	1.02%	31	68'	#12
L3H	0.37%	3/0	0.98%	7	49'	#12
L3I	0.33%	3/0	1.13%	7	75'	#12
L3J	0.44%	3/0	1.09%	1	44'	#12
L3K	0.66%	3/0	1.45%	1	58'	#12
T-DP3P	0.34%	500kcmil				
DP3P	0.03%	(3)300kcmil				
P3A	0.09%	1/0	2.73%	11	109'	#12
P3B	0.06%	1/0	3.44%	6	115'	#12
P3C	0.07%	1/0	2.93%	17	147'	#12
P4A	0.18%	1/0	2.90%	1	145'	#12
P4B	0.12%	1/0	2.98%	4	119'	#12
P4C	0.17%	1/0	3.01%	9	150'	#12
T-DP4L	0.55%	500kcmil				
DP4L	0.06%	(3)300kcmil				
L4A	0.28%	3/0	1.41%	2	51'	#12
L4B	0.42%	3/0	1.79%	15	120'	#10
L4C	0.25%	3/0	0.62%	26	56'	#12
L4D	0.18%	3/0	1.08%	12	54'	#12
L4E	0.31%	3/0	1.88%	29	75'	#12
L4F	0.17%	3/0	1.08%	10	43'	#12
L4G	0.27%	3/0	0.90%	37	60'	#12
L4H	0.50%	3/0	2.46%	32,34	55'	#12
L4I	0.44%	3/0	1.69%	31,33	44'	#12
L4J	0.49%	3/0	1.56%	22,24	35'	#12
L4K	0.43%	3/0	0.99%	7	49'	#12

FAULT CURRENT SCHEDULE								
DEVICE	FAULT AT DEVICE	AIC RATING	VOLTAGE	FEEDER		TRANSFORMER		
				SIZE	LENGTH	KVA	Z%	FAULT AT PRIMARY
G2	45,000	65,000	480V	(3)600kcmil				
GSB	42,582	65,000	480V	(5)600kcmil	41'			
MSB	65,000	100,000	480V	(10)600kcmil	55'			
ATS-EL	13,198	30,000	480V	#4	60'			
ELH1	12,418	30,000	480V	#1	8'-5"			
ELH2	3,461	10,000	480V	#4	185'			
ELH3	2,998	10,000	480V	#4	39'			
ELH4	2,585	10,000	480V	#4	47'			
T-EL	4,260	22,000	480V	#6	15'	30	1.75	9,427
ELL	4,052	10,000	208V	#1	14'			
ATS-EP	56,018	65,000	480V	(4)600kcmil	63'			
EPH	54,377	65,000	480V	(4)600kcmil	14'			
EPHWL	44,602	65,000	480V	#1	10'-10"			
EPHWM	53,629	65,000	480V	(2)350kcmil	2'-10"			
EPHWMA	51,174	65,000	480V	4/0	4'-3"			
EPM4H	26,725	42,000	480V	(2)350kcmil	201'			
EVR	3,766	14,000	480V	#1	154'	75	1.75	10,123
ECPW	3,666	14,000	480V	1/0	21'			
T-EP	24,291	42,000	480V	500kcmil	18'	225	2	46,869
EPDP	22,268	42,000	208V	(3)300kcmil	26'			
EP1	7,092	10,000	208V	3/0	145'			
EP2A	5,227	10,000	208V	3/0	215'			
EP2B	5,593	10,000	208V	3/0	197'			
EP2C	8,606	14,000	208V	3/0	110'			
EP3A	4,925	10,000	208V	3/0	231'			
EP3B	6,242	10,000	208V	3/0	171'			
EP3C	4,960	10,000	208V	3/0	229'			
EP3D	7,005	10,000	208V	3/0	147'			
EP4A	4,321	10,000	208V	3/0	270'			
EP4B	5,426	10,000	208V	3/0	205'			
EP4C	4,977	10,000	208V	3/0	228'			
EP4D	6,694	10,000	208V	3/0	156'			
EP4E	7,267	10,000	208V	3/0	140'			
ET1	5,019	10,000	208V	#1	131'			
ET3	3,520	10,000	208V	#1	197'			
T-EPM	13,376	22,000	480V	2/0	28'	112.5	2	37,328
EPM	11,633	22,000	208V	600kcmil	31'			
EPM4L	4,821	14,000	208V	4/0	216'			
EPM4LA	5,078	14,000	208V	250kcmil	218'			
T-EPW	10,744	22,000	480V	1/0	10'-8"	75	1.75	46,059
EPLW	10,368	22,000	208V	4/0	7'-5"			
EPLW1	9,460	14,000	208V	#1	12'			
LT1	27,417	65,000	480V	1/0	55'			
LT2	7,198	10,000	480V	#1	185'			
LT3	6,290	10,000	480V	#1	36'			
LT4	5,415	10,000	480V	#1	46'			
M1H	41,939	65,000	480V	600kcmil	53'			
T-M1	10,385	14,000	480V	1/0	19'	75	1.75	33,122
M1L	9,529	14,000	208V	3/0	17'			
M2H	22,316	30,000	480V	600kcmil	183'			
T-M2	9,522	14,000	480V	1/0	18'	75	1.75	19,579
M2L	8,845	10,000	208V	4/0	17'			
M3L	6,980	10,000	208V	#1	34'			
M3H	13,265	22,000	480V	3/0	202'			
M4H	33,141	42,000	480V	(3)300kcmil	222'			
M4HA	30,514	42,000	480V	3/0	9'-5"			
M4HB	28,237	42,000	480V	3/0	19'			
M4HC	27,771	30,000	480V	3/0	21'			

FAULT CURRENT SCHEDULE								
DEVICE	FAULT AT DEVICE	AIC RATING	VOLTAGE	FEEDER		TRANSFORMER		
				SIZE	LENGTH	KVA	Z%	FAULT AT PRIMARY
T-M4	6,425	10,000	480V	#4	17'	45	1.75	22,242
M4L	5,999	10,000	208V	1/0	17'			
T-DP1P	30,830	42,000	480V	(2)4/0	42'	300	2	50,233
DP1P	29,148	30,000	208V	(3)400kcmil	14'			



11/17/2017 4:31:35 PM  
ALL IDEAS, DESIGNS AND ARRANGEMENTS INDICATED ON THESE DRAWINGS ARE THE PROPERTY OF THE ARCHITECT AND ARE TO BE USED IN CONNECTION WITH THIS SPECIFIC PROJECT AND SHALL NOT BE USED OTHERWISE WITHOUT THE EXPRESSED CONSENT OF THE ARCHITECT. THESE SHALL BE NO CHANGES OR DEVIATION FROM THE DRAWINGS OR ACCOMPANYING SPECIFICATION WITHOUT THE EXPRESSED CONSENT OF THE ARCHITECT.

## SHEET KEYED NOTES:

- 1 PROVIDE PROVISIONS FOR SPLIT BUS PANEL PER CEC TITLE 24 REQUIREMENTS.

Branch Panel: M1H											
Location: Supply From: MSB Mounting: Surface Enclosure: Type 1				Volts: 480/277 Wye Phases: 3 Wires: 4				A.I.C. Rating: 65,000 Mains Type: MLO Mains Rating: 400 A			
Notes:											
CKT	Circuit Description	Trip	Poles	A	B	C	Poles	Trip	Circuit Description	CKT	
1	DI-1	20 A	3	2495... 6133...	2495... 4974...	2495... 4768...	3	125 A	T-M1	2	
3	--	--	--	--	--	--	--	--	--	4	
5	--	--	--	--	--	--	--	--	--	6	
7	VAC-1	60 A	3	7649... 0 VA	7649... 0 VA	7649... 0 VA	--	--	Bussed Space	8	
9	--	--	--	--	--	--	--	--	Bussed Space	10	
11	--	--	--	--	--	--	--	--	Bussed Space	12	
13	AC-1	35 A	3	3575... 0 VA	3575... 0 VA	3575... 0 VA	--	--	Bussed Space	14	
15	--	--	--	--	--	--	--	--	Bussed Space	16	
17	--	--	--	--	--	--	--	--	Bussed Space	18	
19	Bussed Space	--	--	0 VA	0 VA	0 VA	--	--	Bussed Space	20	
21	Bussed Space	--	--	--	0 VA	0 VA	--	--	Bussed Space	22	
23	Bussed Space	--	--	--	--	0 VA	0 VA	--	Bussed Space	24	
25	Bussed Space	--	--	0 VA	0 VA	--	--	--	Bussed Space	26	
27	Bussed Space	--	--	--	0 VA	0 VA	--	--	Bussed Space	28	
29	Bussed Space	--	--	--	--	0 VA	0 VA	--	Bussed Space	30	
31	Bussed Space	--	--	0 VA	600 VA	--	--	2	20 A	Receptacle	32
33	Bussed Space	--	--	--	0 VA	600 VA	--	--	--	--	34
35	Bussed Space	--	--	--	--	0 VA	1000...	2	30 A	Receptacle	36
37	CAGE & BOTTLE WASHER	20 A	3	2772... 1000...	2772... 1500...	2772... 1500...	2	50 A	Receptacle	38	
39	--	--	--	--	--	--	--	--	--	--	40
41	--	--	--	--	--	--	--	--	--	--	42
		Total Load:		24224 VA		23565 VA		23759 VA			
		Total Amps:		88 A		85 A		86 A			
Load Classification		Connected Load		Demand Factor		Estimated Demand		Panel Totals			
Receptacle		6200 VA		100.00%		6200 VA		Total Conn. Load: 71548 VA			
Power		65348 VA		100.00%		65348 VA		Total Est. Demand: 71548 VA			
								Total Conn.: 86 A			
								Total Est. Demand: 86 A			

RFI 2-00503 Electrical  
Req. for Bottle Washer

Branch Panel: M2H													
Location: Supply From: MSB Mounting: Surface Enclosure: Type 1				Volts: 480/277 Wye Phases: 3 Wires: 4				A.I.C. Rating: 30,000 Mains Type: MCB Mains Rating: 400 A MCB Rating: 400 A					
Notes:													
RFI 2-00527 Confirm Additional Receptacle Rm 219													
CKT	Circuit Description	Trip	Poles	A	B	C	Poles	Trip	Circuit Description	CKT			
1	T-M2	125 A	3	1229...	0 VA			--	--	Bussed Space	2		
3	--	--	--	--	1171...	0 VA		--	--	Bussed Space	4		
5	--	--	--	--		9598...	0 VA	--	--	Bussed Space	6		
7	Bussed Space	--	--	0 VA	0 VA			--	--	Bussed Space	8		
9	Bussed Space	--	--	--	0 VA	0 VA		--	--	Bussed Space	10		
11	Bussed Space	--	--	--	--	0 VA	0 VA	--	--	Bussed Space	12		
13	Bussed Space	--	--	0 VA	0 VA			--	--	Bussed Space	14		
15	Bussed Space	--	--	--	0 VA	0 VA		--	--	Bussed Space	16		
17	Bussed Space	--	--	--	--	0 VA	0 VA	--	--	Bussed Space	18		
19	Bussed Space	--	--	0 VA	0 VA			--	--	Bussed Space	20		
21	Bussed Space	--	--	--	0 VA	0 VA		--	--	Bussed Space	22		
23	Bussed Space	--	--	--	--	0 VA	0 VA	--	--	Bussed Space	24		
25	Bussed Space	--	--	0 VA	0 VA			--	--	Bussed Space	26		
27	Bussed Space	--	--	--	0 VA	0 VA		--	--	Bussed Space	28		
29	Bussed Space	--	--	--	--	0 VA	0 VA	--	--	Bussed Space	30		
31	AUTOCLAVE	60 A	3	1219...	0 VA			--	--	Bussed Space	32		
33	--	--	--	--	1219...	0 VA		--	--	Bussed Space	34		
35	--	--	--	--	--	1219...	0 VA	--	--	Bussed Space	36		
37	AUTOCLAVE	60 A	3	1219...	1219...			3	60 A	AUTOCLAVE	38		
39	--	--	--	--	1219...	1219...		--	--	Bussed Space	40		
41	--	--	--	--	1219...	1219...		--	--	Bussed Space	42		
Total Load:				48876 VA		48296 VA		46180 VA					
Total Amps:				178 A		176 A		167 A					
Load Classification		Connected Load		Demand Factor		Estimated Demand		Panel Totals					
Receptacle		3300 VA		100.00%		3300 VA		Total Conn. Load: 143352 VA					
Power		140052 VA		100.00%		140052 VA		Total Est. Demand: 143352 VA					
								Total Conn.: 172 A					
								Total Est. Demand: 172 A					

Branch Panel: M4HA												
Location: Supply From: M4H Mounting: Surface Enclosure: Type 1				Volts: 480/277 Wye Phases: 3 Wires: 4				A.I.C. Rating: 42,000 Mains Type: MCB Mains Rating: 200 A MCB Rating: 200 A				
Notes:												
CKT	Circuit Description			Trip	Poles	A	B	C	Poles	Trip	Circuit Description	CKT
1	EF-2A			45 A	3	5820... 3049...			3	20 A	EF-5A	2
3	--	--	--	--	--		5820... 3049...		--	--	--	4
5	--	--	--	--	--			5820... 3049...	--	--	--	6
7	EF-2B			45 A	3	5820... 3049...			3	20 A	EF-5B	8
9	--	--	--	--	--		5820... 3049...		--	--	--	10
11	--	--	--	--	--			5820... 3049...	--	--	--	12
13	EF-3A			35 A	3	3880... 0 VA			--	--	Bussed Space	14
15	--	--	--	--	--		3880... 0 VA		--	--	Bussed Space	16
17	--	--	--	--	--			3880... 0 VA	--	--	Bussed Space	18
19	EF-3B			35 A	3	3880... 0 VA			--	--	Bussed Space	20
21	--	--	--	--	--		3880... 0 VA		--	--	Bussed Space	22
23	--	--	--	--	--			3880... 0 VA	--	--	Bussed Space	24
25	Bussed Space			--	--	0 VA 0 VA			--	--	Bussed Space	26
27	Bussed Space			--	--		0 VA 0 VA		--	--	Bussed Space	28
29	Bussed Space			--	--			0 VA 0 VA	--	--	Bussed Space	30
31	Bussed Space			--	--	0 VA 0 VA			--	--	Bussed Space	32
33	Bussed Space			--	--		0 VA 0 VA		--	--	Bussed Space	34
35	Bussed Space			--	--			0 VA 0 VA	--	--	Bussed Space	36
37	AUTOCLAVE			60 A	3	1219... 0 VA			--	--	Bussed Space	38
39	--	--	--	--	--		1219... 0 VA		--	--	Bussed Space	40
41	--	--	--	--	--			1219... 0 VA	--	--	Bussed Space	42
Total Load:						37692 VA	37692 VA	37692 VA				
Total Amps:						136 A	136 A	136 A				
Load Classification		Connected Load		Demand Factor		Estimated Demand		Panel Totals				
Power		113076 VA		100.00%		113076 VA		Total Conn. Load: 113076 VA				
								Total Est. Demand: 113076 VA				
								Total Conn.: 136 A				
								Total Est. Demand: 136 A				

Branch Panel: M1L													
Location: Supply From: T-M1 Mounting: Surface Enclosure: Type 1				Volts: 120/208 Wye Phases: 3 Wires: 4				A.I.C. Rating: 14,000 Mains Type: MCB Mains Rating: 200 A MCB Rating: 200 A					
Notes:													
CKT	Circuit Description	Trip	Poles	A	B	C	Poles	Trip	Circuit Description	CKT			
1	DI-1 BOOSTER PUMP	20 A	1	840 VA 441 VA			2	20 A	BS-1.01, FC-1.08, FC-1.09	2			
3	WS-1	20 A	1		300 VA 441 VA		--	--		4			
5	B-1	20 A	1			180 VA 674 VA	2	20 A	FC-1.05, FC-1.06, FC-1.07	6			
7	CD-1	20 A	1	360 VA 674 VA			--	--		8			
9	B-2	20 A	1		180 VA 483 VA		2	20 A	BS-1.02, FC-1.04, FC-1.10	10			
11	CD-1	20 A	1			540 VA 483 VA	--	--		12			
13	WH-3	20 A	1	180 VA 799 VA			2	20 A	FC-1.01, FC-1.02, FC-1.03	14			
15	SP-1 CONTROL PANEL	20 A	1		180 VA 799 VA		--	--		16			
17	SP-1	20 A	3			577 VA 466 VA	2	20 A	FC-2.10, FC-2.11	18			
19	--	--	--	577 VA 466 VA			--	--		20			
21	--	--	--		577 VA 707 VA		2	20 A	FC-2.06, FC-2.08, FC-2.12	22			
23	FC-2.02, FC-2.03	20 A	2			374 VA 707 VA	--	--		24			
25	--	--	--	374 VA 707 VA			2	20 A	FC-2.01, FC-2.05, FC-2.13	26			
27	CP-3	20 A	1		600 VA 707 VA		--	--		28			
29	EF-9	20 A	1			52 VA 715 VA	2	20 A	FC-2.04, FC-2.07, FC-2.09	30			
31	Bussed Space	--	--	0 VA 715 VA			--	--		32			
33	Bussed Space	--	--		0 VA 0 VA		--	--	Bussed Space	34			
35	Bussed Space	--	--			0 VA 0 VA	--	--	Bussed Space	36			
37	Bussed Space	--	--	0 VA 0 VA			--	--	Bussed Space	38			
39	Bussed Space	--	--		0 VA 0 VA		--	--	Bussed Space	40			
41	Bussed Space	--	--			0 VA 0 VA	--	--	Bussed Space	42			
Total Load:				6133 VA	4974 VA	4768 VA							
Total Amps:				51 A	42 A	40 A							
Load Classification		Connected Load		Demand Factor		Estimated Demand		Panel Totals					
Power		15875 VA		100.00%		15875 VA							
								Total Conn. Load: 15875 VA					
								Total Est. Demand: 15875 VA					
								Total Conn.: 44 A					
								Total Est. Demand: 44 A					



SEE TABLE 24 CALCULATION FORMS ENV-3-C FOR INSULATION AND MATERIAL ASSEMBLY OF WALL, ROOF AND FLOOR. SEE ARCHITECTURAL DRAWINGS FOR MATERIAL ASSEMBLY SECTIONS ON PLANS.

ALL INSULATION MATERIAL SHALL COMPLY WITH THE UMC SECTION 602.2. FLAME SPREAD-RATINGS OR 25 OR LESS AND A SMOKE DEVELOPED RATING OF 50 OR LESS.

HVAC PIPING AND DUCTWORK SYSTEMS SHALL BE INSULATED CONSISTENT WITH THE REQUIREMENTS OF SECTIONS 110.8, 120.3, 120.4 AND 120.4.5. THE CALIFORNIA ENERGY EFFICIENCY STANDARDS, 2016 CALIFORNIA MECHANICAL CODE (CMC) CHAPTER 6, TABLE 6-0. FLAME SPREAD RATING OF 25 OR LESS AND A SMOKE DEVELOPED RATING OF 50 OR LESS.

ALL HVAC EQUIPMENT AND APPLIANCES SHALL MEET THE REQUIREMENTS PER SECTIONS 110.1-110.3, 110.5 AND 120.1-120.9 OF THE CALIFORNIA ENERGY EFFICIENCY STANDARDS.

HVAC SYSTEMS AUTOMATIC CONTROLS SHALL COMPLY WITH THE CONTROL REQUIREMENTS PER SECTIONS 110.2 AND 120.2 OF THE CALIFORNIA ENERGY EFFICIENCY STANDARDS.

ALL MATERIALS EXPOSED WITHIN DUCTS OR PLENUMS, FLEXIBLE DUCTS AND DUCT INSULATION SHALL COMPLY WITH UMC SECTION 602.2 AND SHALL HAVE A FLAME SPREAD RATING OF NOT MORE THAN 25 AND A SMOKE DEVELOPED RATING OF NOT MORE THAN 50.

ALL DOORS AND WINDOWS SHALL MEET THE MINIMUM INFILTRATION REQUIREMENTS OF THE CALIFORNIA ENERGY EFFICIENCY STANDARDS.

AT THE TIME OF PERMIT ISSUANCE, THE PERMITEE WILL PROVIDE AN APPROVED COPY OF THE CERTIFICATE OF COMPLIANCE (MECH-1) TO THE JURISDICTION FOR FILING.

PROVIDE SMOKE DETECTORS ON AIR MOVING SYSTEMS EXCEEDING 2000 CFM AT SUPPLY AIR DUCTS. (2016 CMC 608.1)

FIRE AND/OR SMOKE DAMPER ASSEMBLIES, INCLUDING SLEEVES, AND INSTALLATION PROCEDURES SHALL BE APPROVED BY THE BUILDING INSPECTOR PRIOR TO INSTALLATION.

ATTICS OR SIMILAR CONCEALED SPACE MUST BE PARTITIONED BY DRAFT STOPS INTO AREAS NOT EXCEEDING 3000 SQ. FT. IN AREA AND 60 FT. IN LENGTH (EVERY 900 SQ. FT. AND 100 FT. IN SMOKED BUILDINGS).

ALL WATER HEATERS/BOILERS SHALL BE STRAPPED OR ANCHORED PER SEC. 510.5 OF THE CPC TO RESIST HORIZONTAL DISJUNCTION DUE TO EARTHQUAKE MOTION.

AIR FILTERS SHALL BE A STATE FIRE MARSHALL APPROVED AND LISTED TYPE, PRE-FORMED FILTERS HAVING COMBUSTIBLE FRAMING SHALL BE TESTED AS A COMPLETE ASSEMBLY. AIR FILTERS IN ALL OCCUPANCIES SHALL BE CLASS 1 OR 2/AS SHOWN IN THE STATE FIRE MARSHALL LISTING; AIR FILTERS SHALL BE ACCESSIBLE FOR CLEANING OR REPLACEMENT. (305.0 OF CMC)

CERTIFICATE OF ACCEPTANCE, AND ALL RELATED ACCEPTANCE DOCUMENTS SHALL BE SUBMITTED WITH THE PERMIT. THE FIELD INSPECTOR OR DURING CONSTRUCTION, CERTIFICATE OF OCCUPANCY WILL NOT BE ISSUED UNTIL THESE FORMS ARE REVIEWED AND APPROVED.

PENETRATIONS IN FIRE-RESISTIVE WALLS, PARTITIONS AND FLOORS WHERE PROTECTED OPENINGS ARE REQUIRED SHALL BE FIRE STOPPED USING APPROVED MATERIALS, SECURELY INSTALLED AND CAPABLE OF MAINTAINING THEIR INTEGRITY AND PREVENTING THE MOVEMENT OF HOT FLAMES OR GASES THROUGH THE VOID SPACES BETWEEN PENETRATING MATERIALS AND WALLS, PARTITIONS AND FLOORS WHEN TESTED IN ACCORDANCE WITH ASTM STANDARD E-814 OR UL STANDARD 1479 (UBC SECTIONS 4300.4(a), 4306(a) & 4306(b)). PROVIDE DESIGN DETAILS ON DRAWINGS DEPICTING APPROVED (LISTED) METHODS AND MATERIALS USED TO PROTECT PENETRATIONS IN WALLS, PARTITIONS AND FLOORS.

PROVIDE DESIGN DETAILS ON DRAWINGS DEPICTING APPROVED (LISTED) METHODS AND MATERIALS USED TO PROTECT PENETRATIONS IN WALLS, PARTITIONS AND FLOORS.

ENVIRONMENTAL AND/OR PRODUCT CONVEYING DUCT SYSTEMS SHALL NOT EXTEND INTO OR THROUGH DUCTS OR PLENUMS. UMC SECTIONS 504.1 & 505.1.

ELECTRICAL WIRING METHODS SHALL BE INSTALLED IN THE PLENUM AREAS SHALL COMPLY WITH NEC 900-220(C1), CMC 602.2.

NONMETALLIC PLASTIC TUBING MUST BE LISTED AND LABELED FOR USE IN PLENUM AREAS. CMC 602.2

RECESSED SPEAKER ENCLOSURES AND LIGHT FIXTURES SHALL BE LISTED AND LABELED FOR USE IN PLENUM LOCATIONS. CMC 602.2

ROOF ACCESS LADDER SHALL COMPLY WITH SECTION 304. CMC.

DUCTS CONVEYING EXPLOSIVES OR FLAMMABLE VAPORS, FUMES OR DUSTS SHALL EXTEND DIRECTLY TO THE EXTERIOR OF THE BUILDING WITHOUT ENTERING OTHER SPACES AND SHALL NOT EXTEND INTO OR THROUGH DUCTS AND PLENUMS (SECTION 505.1, CMC 2016).

PROVIDE EXPANSION TANK FOR BOILERS PER SECTION 1005.0 CMC 2016.

ROUTING AND TERMINATION OF FLUE FOR EACH BOILER SHALL COMPLY WITH CH. 8, CMC 2016 AND WITH MANUFACTURERS SPECIFICATIONS AND INSTALLATION INSTRUCTIONS.

BOILERS SHALL COMPLY WITH ALL THE REQUIREMENTS OF CHAPTER 10 OF CMC 2016

COMBUSTION AIR INTAKE FOR EACH BOILER SHALL COMPLY WITH CH. 7, CMC 2016 AND WITH MANUFACTURERS SPECIFICATIONS AND INSTALLATION INSTRUCTIONS.

AT THE TIME OF ROUGH INSTALLATION AND DURING STORAGE ON THE CONSTRUCTION SITE THE EXTERIOR SURFACE OF THE HEATING, COOLING AND VENTILATING EQUIPMENT, ALL DUCT AND OTHER RELATED AIR DISTRIBUTION COMPONENT OPENINGS SHALL BE COVERED WITH TAPE, PLASTIC, SHEET METAL OR OTHER METHODS ACCEPTABLE TO THE ENFORCING TO THE PERMITS OFFICIALS TO REDUCE THE AMOUNT OF DUST, WATER AND DEBRIS WHICH MAY ENTER THE SYSTEM. (ALL GREEN SECTION 5.604.3)

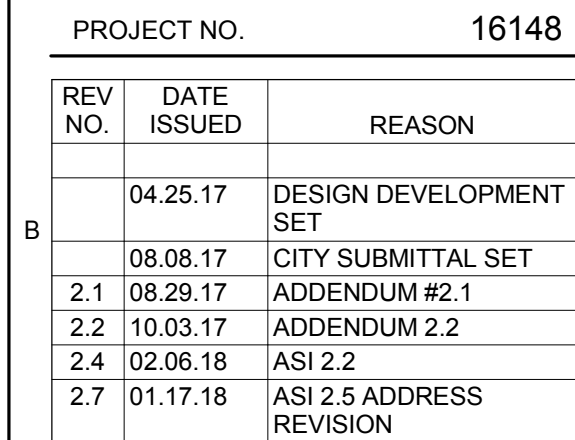
IN MECHANICALLY VENTILATED BUILDINGS, REGULARLY OCCUPIED AREAS OF THE BUILDING SHALL BE PROVIDED WITH AIR FILTRATION MEDIA FOR OUTSIDE AND RETURN AIR THAT PROVIDES AT LEAST A MINIMUM EFFICIENCY REPORTING VALUE (MERV) OF 8. MERV 8 FILTERS SHALL BE INSTALLED IN THE OPERATION AND MAINTENANCE MANUAL. (ALL GREEN SECTION: 5.604.5)

INSTALLATIONS OF HVAC, REFRIGERATION AND FIRE SUPPRESSION EQUIPMENT SHALL COMPLY WITH SECTIONS 5.508.11 AND 5.508.12 HVAC, REFRIGERATION, AND FIRE SUPPRESSION EQUIPMENT SHALL NOT CONTAIN CHLOROFLOUROCARBONS (CFCs) AND ALL SHALL NOT CONTAIN HALONS (SECTION 5.508.1)

IN ADDITION TO TESTING, AND ADJUSTING, BEFORE A NEW SPACE-CONDITIONING SYSTEM SERVING A BUILDING OR ITS SPACE IS OPERATED FOR NORMAL USE, BALANCE THE SYSTEM IN ACCORDANCE WITH THE PRECEDESSED PROCEDURES FOR TESTING, ADJUSTING AND BALANCING BUREAU NATIONAL STANDARDS, THE NATURAL ENVIRONMENTAL, BALANCE BUREAU PROCEDURES STANDARDS, OR ASSOCIATED AIR BALANCE COUNCIL NATIONAL STANDARDS.

PROVIDE THE BUILDING OWNER OR REPRESENTATIVE WITH DETAILED OPERATING AND MAINTENANCE INSTRUCTIONS AND COPIES OF GUARANTEES/WARRANTIES FOR EACH SYSTEM. THE SYSTEM SHALL BE OPERATED AND MAINTAINED IN ACCORDANCE WITH THE TITLE 8, SECTION 5142, AND OTHER RELATED REGULATIONS.

1. CONTRACTOR SHALL CAREFULLY REVIEW THESE PLANS AND SPECIFICATIONS PRIOR TO BID. CONTRACTOR SHALL ALSO REVIEW PLANS AND SPECIFICATIONS OF OTHER RELATED TRADES (INCLUDING MECHANICAL, STRUCTURAL, AND ELECTRICAL) PRIOR TO BID TO ENSURE AN ACCURATE UNDERSTANDING OF EXACT SCOPE OF WORK. ANY ITEMS REQUIRING CLARIFICATION SHALL BE BROUGHT TO THE ATTENTION OF THE ARCHITECT IN SUFFICIENT TIME TO BE INCORPORATED INTO THE BID.
2. CONTRACTOR SHALL VERIFY ALL EQUIPMENT MODEL NUMBERS, CAPACITIES, SIZES, VOLTAGES, AND ALL OTHER SPECIFICATIONS SHALL COMPLY WITH ALL OTHER APPLICABLE TRADES AND WITH THE MANUFACTURER PRIOR TO INSTALLATION.
3. CONTRACTOR SHALL VERIFY ALL LOCATIONS, SIZES, P.O.C.'S, AND AVAILABILITY OF ALL EXISTING ITEMS (I.E. OUTSIDE AIR, CWS & CWR, EXHAUST ETC.) PRIOR TO INSTALLATION OF ANY MATERIAL OR EQUIPMENT.
4. THESE DRAWINGS ARE ESSENTIALLY DIAGRAMMATIC AND ARE NOT INTENDED TO INDICATE ALL NECESSARY OFFSETS OF DUCTWORK AND PIPING. THE CONTRACTOR SHALL INSTALL MATERIALS AND EQUIPMENT IN A MANNER AS TO CONFORM TO STRUCTURE, AVOID OBSTRUCTIONS, AND PROVIDE CLEARANCES AND KEEP OPENINGS AND PASSAGeways CLEAR. ALL INSTALLATIONS SHALL BE CONSISTENT WITH NORMALLY ACCEPTABLE INDUSTRY STANDARDS. THE CONTRACTOR SHALL NOTIFY THE ARCHITECT IN WRITING OF ANY DISCREPANCIES OR CONFLICTS THAT WOULD AFFECT THE INSTALLATION SYSTEM PERFORMANCE OR WHICH WOULD INCREASE ADDITIONAL COSTS. THIS NOTIFICATION SHALL BE MADE PRIOR TO THE INSTALLATION OF THE ITEMS CONCERNED.
5. NEW AND/OR EXISTING EQUIPMENT INDICATED ON THIS DRAWING IS SHOWN IN APPROXIMATE POSITION(S). CONTRACTOR SHALL FIELD VERIFY ALL EXISTING CONDITIONS INCLUDING EQUIPMENT LOCATIONS, P.O.C.'S AND STRUCTURAL MEMBERS PRIOR TO INSTALLATION. IN ALL CASES, CONTRACTOR SHALL FOLLOW MANUFACTURER'S RECOMMENDATIONS AND CODES OF COMPLIANCE) FOR MAINTENANCE AND REPLACEMENT OF EQUIPMENT SHALL BE PROVIDED.
6. ALL WORK SHALL BE DONE IN ACCORDANCE WITH ALL APPLICABLE CODES. NOTHING SHOWN IN THE PLANS OR STATED IN THE SPECIFICATIONS IS INTENDED TO INDICATE THAT THE INSTALLATION OF CONNECTIONS OF ANY ITEM OR DEVICE SHOULD BE DONE CONTRARY TO THE MANUFACTURER'S INSTRUCTIONS AND ALL APPLICABLE CODES AND REGULATIONS. THE CONTRACTOR IS RESPONSIBLE TO ENSURE THAT THE INSTALLATION AND CONNECTIONS OF ALL ITEMS AND DEVICES CONFORM TO MANUFACTURER'S INSTRUCTIONS AND TO ALL APPLICABLE CODES AND REGULATIONS.
7. ALL HVAC EQUIPMENT, MATERIAL, AND ALL CONNECTION THERETO SHALL BE INSTALLED IN ACCORDANCE WITH MANUFACTURER'S INSTRUCTIONS TO PROVIDE A COMPLETE AND FULLY OPERATIONAL SYSTEM.
8. DUCT SIZES INDICATED ON DRAWINGS ARE INSIDE NET CLEARANCE DIMENSIONS.
9. CONTRACTOR MAY, AT HIS OPTION, REVISE DUCTWORK SIZING AND ROUTING TO ALLOW FOR INSTALLATION IN THE AVAILABLE SPACE. DUCTWORK THAT IS RESIZED MUST MAINTAIN THE SAME CROSS-SECTIONAL AREA.
10. FLEX DUCT IS LIMITED TO A MAXIMUM OF 7' AT EACH REGISTER.
11. ALL NEW SUPPLY, RETURN, AND EXHAUST (AIR DISTRIBUTION) GRILLES, REGISTERS, AND DIFFUSERS SHALL MATCH (IF APPLICABLE) EXISTING, AND BE APPROVED BY ARCHITECT. THE MAXIMUM NOISE LEVEL SHALL BE 39.
12. ALL SUPPLY, RETURN, AND EXHAUST REGISTER CONNECTIONS TO DUCTWORK SHALL BE PROVIDED WITH ACCESSIBLE MANUAL VOLUME DAMPERS. ALTERNATIVELY, ACCESSIBLE MANUAL VOLUME DAMPERS MAY BE PROVIDED IN DUCT WORK FEEDER LINES SERVING INDIVIDUAL REGISTERS.
13. SUBSTITUTION OF HVAC EQUIPMENT WITH EFFICIENCIES LOWER THAN THOSE INDICATED ON THE PLANS MAY REQUIRE RECALCULATION OF TITLE 24 DOCUMENTS. IF THE CONTRACTOR CHOOSES TO SUBSTITUTE EQUIPMENT WITH LOWER EFFICIENCIES, THE CONTRACTOR SHALL BE RESPONSIBLE FOR THE RECALCULATION AND JURISDICTIONAL APPROVAL OF TITLE 24 DOCUMENTS.
14. IF THE CONTRACTOR'S USE OF SUBSTITUTE MATERIALS, EQUIPMENT, OR METHODS OF INSTALLATION REQUIRES ANY CHANGES IN OTHER TRADES' WORK FROM THAT SHOWN ON THE DRAWINGS, THE EXTRA COST OF THE OTHER TRADES WORK SHALL BE THE RESPONSIBILITY OF THE CONTRACTOR INITIATING THE SUBSTITUTION.
15. SUBMITTALS: APPROVAL OF SUBMITTALS MUST NOT REUSE THE CONTRACTOR FROM PREVIOUS SUBMITTALS. SUBMITTALS MUST COMPLY WITH ALL REQUIREMENTS OF THE CONSTRUCTION DOCUMENTS OR APPLICABLE CODE REGULATIONS.
16. WHERE NONMETALLIC PIPING PENETRATES AREA SEPARATION WALLS, THE PIPE SECTION PASSING THROUGH THE WALLS AND THE FIXTURE CONNECTIONS THERETO SHALL BE OF METAL ONLY.
17. NO RANGE HOODS, DRYER VENTS, COMBUSTION VENTS, OR HEATING DUCTS ARE PERMITTED IN AREA SEPARATION WALLS.
18. A. CONTRACTOR TO VERIFY LOCATION OF FIRE AND FIRE/SMOKE BARRIER WALLS WITH ARCHITECT PRIOR TO FIRE AND/OR SMOKE DAMPER, DETECTOR AND ACTUATOR INSTALLATION.
- B. ALL CEILING FIRE DAMPERS TO BE ONE (1) HOUR U.L. AND C.S.F.M. APPROVED.
- C. ALL FIRE RATED WALLS SHALL BE PROVIDED WITH U.L. AND C.S.F.M. APPROVED SMOKE/FIRE DAMPERS (EQUAL TO WALL RATING), MOTOR, ACTUATOR, AND SMOKE DETECTOR.
- D. ALL SMOKE BARRIER WALLS SHALL BE PROVIDED WITH U.L. AND C.S.F.M. APPROVED SMOKE/FIRE DAMPERS (EQUAL TO WALL RATING), MOTOR, ACTUATOR, AND SMOKE DETECTOR.
- E. ALL PENETRATIONS OF ONE (1) HOUR CORRIDOR WALLS AND CEILINGS THAT WOULD REQUIRE INSTALLATION OF FIRE DAMPER SHALL BE APPROVED BY ARCHITECT AND HAVE AN APPROVED COMBINATION SMOKE/FIRE DAMPER (EQUAL TO WALL RATING), MOTOR, ACTUATOR, AND SMOKE DETECTOR.
- F. PROVIDE ALL FIRE & SMOKE DAMPERS WITH ACCESS DOORS AS NECESSARY.

[illegible]

IFC 11.20.17

Sheet Title

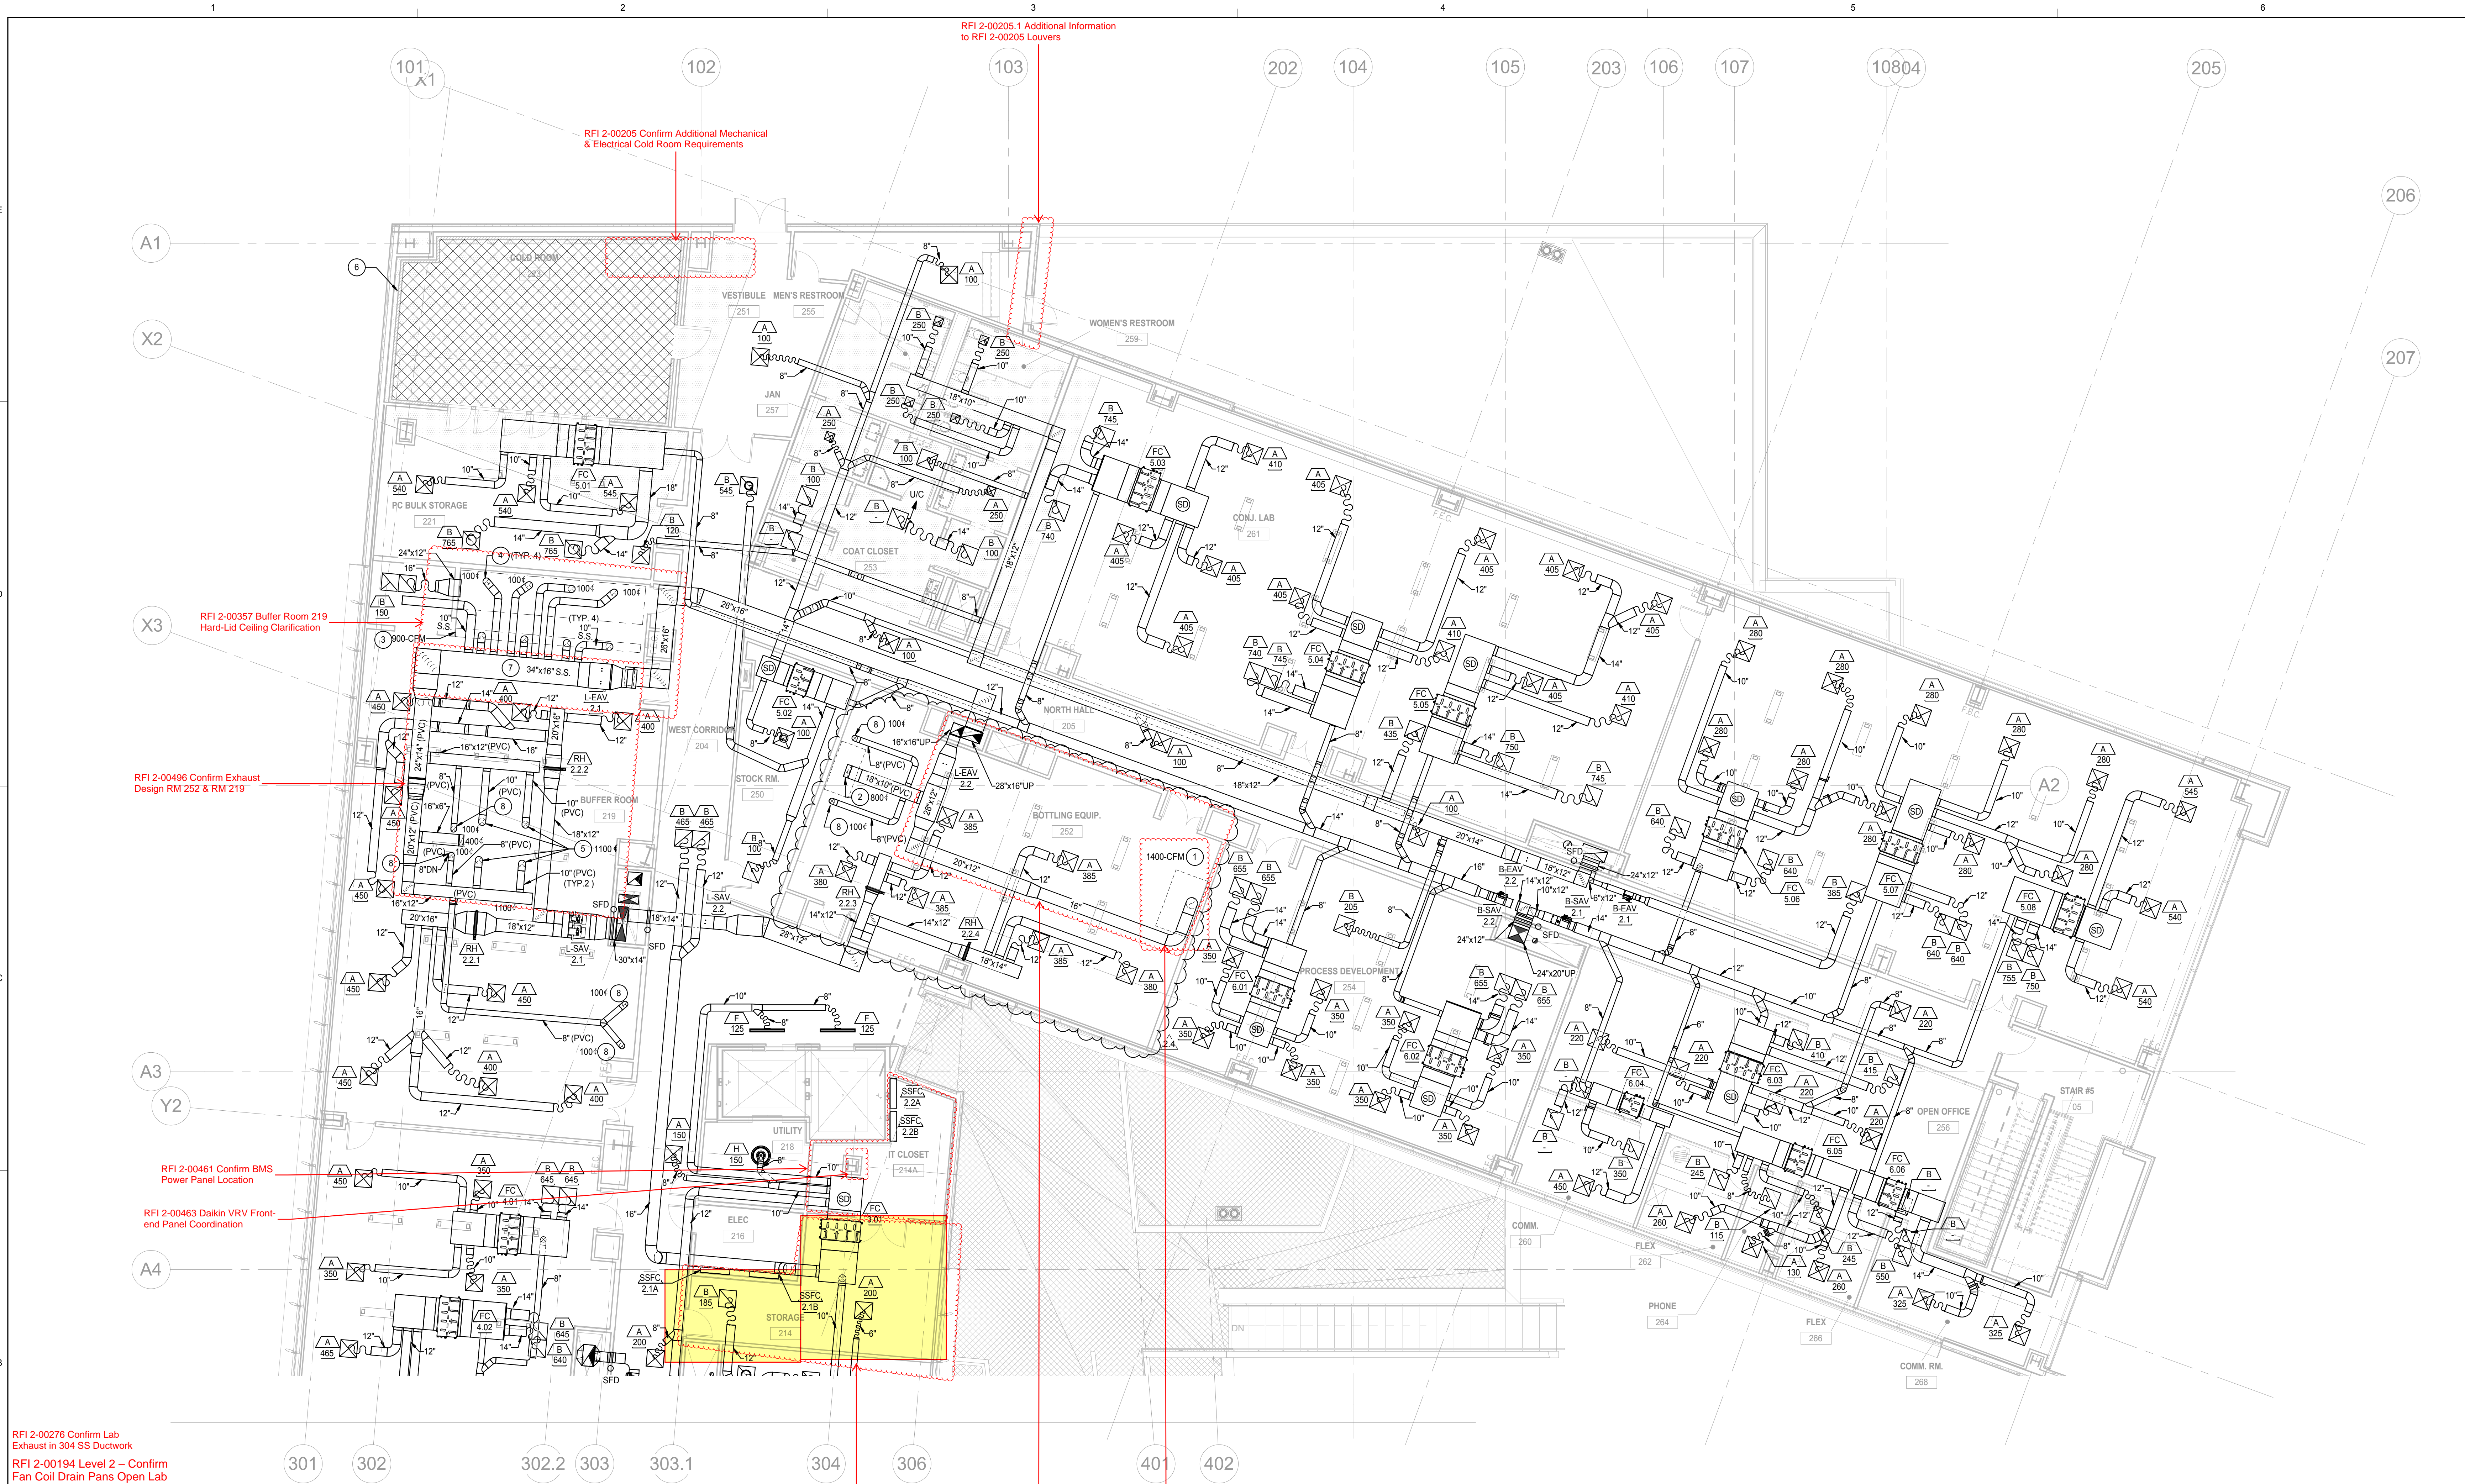
Sheet No.  
**2M-001**

Sheet No.

2M-001



2/8/2018 7:51:01 AM  
ALL IDEAS, DESIGNS AND ARRANGEMENTS INDICATED ON THESE DRAWINGS ARE THE PROPERTY OF THE ARCHITECT AND ARE TO BE USED IN CONNECTION WITH THIS SPECIFIC PROJECT AND SHALL NOT BE USED OTHERWISE WITHOUT THE EXPRESSED CONSENT OF THE ARCHITECT. THESE SHALL BE NO CHANGES OR DEVIATION FROM THE DRAWINGS OR ACCOMPANYING SPECIFICATION WITHOUT THE EXPRESSED CONSENT OF THE ARCHITECT.



## CP 2 VOLUME: 3

PROJECT NO. 16148

REV NO.	DATE ISSUED	REASON
04.25.17	04.25.17	DESIGN DEVELOPMENT SET
08.08.17	08.08.17	CITY SUBMITTAL SET
2.1	08.29.17	ADDENDUM #2.1
2.2	10.03.17	ADDENDUM 2.2
2.3	11.20.17	ASI 2.1/FC
2.4	02.06.18	ASI 2.2
2.5	01.26.18	ASI 2.3 BUFFER ROOM REVISIONS
2.7	01.17.18	ASI 2.5 ADDRESS REVISION

## 1 MECHANICAL FLOOR PLAN - LEVEL 02-Z2 - PART A - DUCTWORK

1/2M-121 1/8" = 1'-0"

### SHEET NOTES

- 1 PROVIDE GALVANIZED STEEL CAPTURE HOOD.
- 2 PROVIDE 6'-0" FUME HOOD WITH 12" PVC-COATED EXHAUST AIR DUCT DOWN TO FUME HOOD CONNECTION.
- 3 PROVIDE 304 STAINLESS STEEL WELDED STEAM EXHAUST CANOPY FOR AUTOCLAVES. SLOPE 1/4" PER LINEAR FOOT.
- 4 PROVIDE ENCLOSED STEAM EQUIPMENT WITH FIXED FIELD FABRICATED EXHAUST AIR DUCTS DOWN TO SNORKEL CONNECTIONS. (TYP 3)
- 5 PROVIDE 8'-0" FUME HOOD WITH 12" PVC-COATED EXHAUST AIR DUCT DOWN TO FUME HOOD CONNECTION. (TYP 2)
- 6 COLD ROOM BY OTHERS.
- 7 ALL DUCTWORK CONNECTED TO AUTOCLAVE EXHAUST SYSTEM TO BE 304 STAINLESS STEEL WELDED. SLOPE 1/4" PER LINEAR FOOT.
- 8 8" PVC TO SNORKEL. REFER TO ARCHITECTURAL PLANS FOR DETAILS.
- 9 14"x4" PVC DUCT DOWN WALL TO EXHAUST GRILLE IN WALL. REFER TO ARCHITECTURAL PLANS FOR MOUNTING REQUIREMENTS.

### GENERAL NOTES

1. DRAWINGS ARE ESSENTIALLY DIAGRAMMATIC AND AS SUCH DOES NOT DETAIL ALL REQUIRED OFFSETS AND TRANSITIONS NEEDED. CONTRACTOR SHALL DEVELOP FULLY COORDINATED SHOP DRAWINGS WITH ALL TRADES.
2. REFER TO ARCHITECTURAL PLANS FOR HVAC PAINTING REQUIREMENTS.
3. PROVIDE INSULATED DUCTWORK WHEN LOCATED ABOVE ARCHITECTURAL CEILINGS. DUCTWORK LOCATED IN OPEN CEILING AREAS SHALL NOT BE INSULATED.
4. THERMOSTAT LOCATIONS SHOWN ON MECHANICAL ZONING PLANS FOR DRAWING CLARITY. CONTRACTOR SHALL REFER TO ARCHITECTURAL INTERIOR ELEVATIONS FOR EXACT MOUNTING PLACEMENT. THERMOSTAT GENERAL PLACEMENT DETAIL SHOWN ON ARCHITECTURAL SHEETS.
5. CONTRACTOR SHALL PROVIDE REMOTE BALANCING DAMPERS FOR ALL BALANCING DAMPERS LOCATED OVER HARD LID CEILINGS OR WHERE THE DAMPER IS INACCESSIBLE.
6. EQUIPMENT ACCESS AND CONNECTION LOCATIONS AS SHOWN ON PLANS ARE DIAGRAMMATIC. CONTRACTOR SHALL REVIEW COORDINATED SHOP DRAWINGS AND PROVIDE EQUIPMENT WITH ACCESS AND CONNECTIONS AS NECESSARY.
7. MECHANICAL CONTRACTOR SHALL COORDINATE SHOP DRAWINGS WITH GENERAL AND FIRE-LIFE SAFETY CONTRACTOR FOR ALL REQUIRED SPRINKLER MAIN MODIFICATIONS NEEDED FOR DUCT AND PIPE ROUTING.
8. MECHANICAL CONTRACTOR SHALL PROVIDE DUCT AND PIPING SEISMIC PACKAGE FROM MASON INDUSTRIES (OR EQUAL). SEISMIC PACKAGE SHALL BE STAMPED AND SIGNED BY STRUCTURAL ENGINEER.
9. MANUAL VOLUME DAMPERS SHALL BE PROVIDED AT ALL BRACH DUCT LOCATIONS AND DUCT INLET/OUTLET LOCATIONS WHERE MEASURED AIRFLOW IS REQUIRED. REFER TO SPECIFICATION FOR REQUIREMENTS.

### EXHAUST SYSTEM NOTES

1. PRODUCT-CONVEYING HOOD AND DUCT MATERIALS SHALL BE SUITABLE FOR THE INTENDED USE AS PER SECTIONS 505.1 AND 506.1 CMC 2016.
2. PRODUCT-CONVEYING DUCTS THAT ARE SERVED BY A COMMON EXHAUST SYSTEM SHALL HANDLE COMPATIBLE MATERIALS AND SEPARATE AND DISTINCT SYSTEMS SHALL BE PROVIDED FOR INCOMPATIBLE MATERIALS. (CMC 2016 SECTION 505.0)
3. DUCTS CONVEYING EXPLOSIVE OR FLAMMABLE VAPORS, FUMES, OR DUSTS SHALL EXTEND DIRECTLY TO THE EXTERIOR OF THE BUILDING WITHOUT ENTERING OTHER SPACES AND SHALL NOT EXTEND INTO OR THROUGH DUCTS AND PLENUMS.

### DUCT MATERIAL SCHEDULE

APPLICATION	MATERIAL	NOTES
GENERAL SUPPLY (LOW AND MEDIUM PRESSURE)	GALVANIZED (G90) SHEET METAL	1
GENERAL RETURN (LOW AND MEDIUM PRESSURE)	GALVANIZED (G90) SHEET METAL	1
GENERAL BUILDING EXHAUST/RELIEF (LOW AND MEDIUM PRESSURE)	GALVANIZED (G90) SHEET METAL	1
FUME HOOD EXHAUST (LOW AND MEDIUM PRESSURE)	PVC COATED GALVANIZED (G90) SHEET METAL	1
SNORKEL/POINT OF USE EXHAUST (LOW AND MEDIUM PRESSURE)	PVC COATED GALVANIZED (G90) SHEET METAL	1
STEAM CAPTURE DUCT/HOOD	WELDED STAINLESS STEEL 304 (SS-304)	1 2
SUPPLY UNDERGROUND DUCT	HIGH-DENSITY POLYETHYLENE (HDPE)	1

#### NOTES:

1. REFER TO SPECIFICATIONS FOR COMPLETE DUCT MATERIAL REQUIREMENTS.
2. WET EXHAUST SYSTEMS SHALL BE SLOPED TOWARD INTAKE HOOD/GRILLE/OPENING. WHERE LOW POINTS ARE CREATED IN DUCTWORK DRAINS SHALL BE ADDED AND ROUTED TO AN APPROVED RECEPTOR.
3. WET EXHAUST DUCT SYSTEMS SHALL BE PROVIDED WITH BOTTOM JUSTIFIED ECCENTRIC DUCT FITTINGS AND SLOPED PER NOTE 2 ABOVE.

IFC 11.20.17


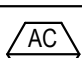












Sheet Title

## MECHANICAL FLOOR PLAN - LEVEL 02 - PART A - DUCTWORK 2M-122

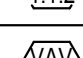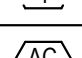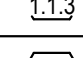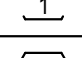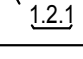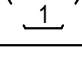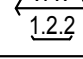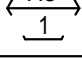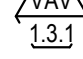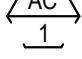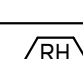
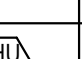
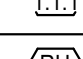
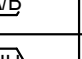
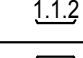
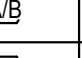
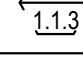
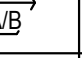
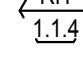
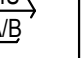
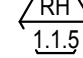

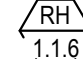

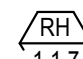

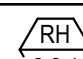
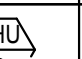
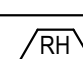

















2/8/2018 7:50:02 AM  
ALL OSA's, DESIGNS AND ARRANGEMENTS INDICATED ON THESE DRAWINGS ARE THE PROPERTY OF THE ARCHITECT AND ARE TO BE USED IN CONNECTION WITH THIS SPECIFIC PROJECT AND SHALL NOT BE USED OTHERWISE WITHOUT THE EXPRESSED CONSENT OF THE ARCHITECT.









### VARIABLE AIR VOLUME TERMINAL SCHEDULE

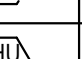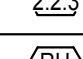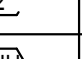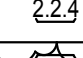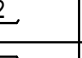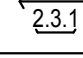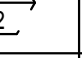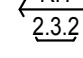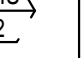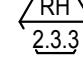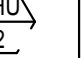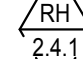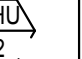MARK	MANUFACTURER & MODEL NO.	ROOMS SERVED	AIR HANDLER	INLET SIZE (DIA)	AIRFLOW (CFM)		HTG. CAP. (MBH)	MAX HTG AIRFLOW	FLOWRATE (GPM)	REHEAT COIL				CONTROL VALVE			CONTROL POWER (E-POWER)	REMARKS	
					MAX.	MIN.				E.A.T. (DEG.F)	E.W.T. (DEG.F)	L.W.T. (DEG.F)	A.P.D. (IN WC)	W.P.D. (FT HD)	MANUFACTURER	MODEL			MIN AUTH.
	TITUS DESV	ATRIUM UNDERGROUND		24x16	2500	500	50	1250	3.6	55	140	110	0.4	1.0	VICTAULIC	TCM	0.25	NO	(1) (2)
	TITUS DESV	ATRIUM 1ST FLOOR		24x16	3200	640	90	1600	9.9	55	140	110	0.4	1.0	VICTAULIC	TCM	0.25	NO	(1) (2)
	TITUS DESV	1ST FLOOR RECEPTION		10	600	120	5	120	0.9	55	140	110	0.4	1.0	VICTAULIC	TCM	0.25	NO	(1) (2)
	TITUS DESV	ATRIUM 2ND FLOOR		24x16	5300	1060	90	2650	9.2	55	140	110	0.4	1.0	VICTAULIC	TCM	0.25	NO	(1) (2)
	TITUS DESV	2ND FLOOR LOBBY		10	600	120	10	200	1.3	55	140	110	0.4	1.0	VICTAULIC	7 MP	0.25	NO	(1) (2)
	TITUS DESV	ATRIUM 3RD FLOOR		24x16	3200	640	90	1600	9.9	55	140	110	0.4	1.0	VICTAULIC	TCM	0.25	NO	(1) (2)
	TITUS DESV	3RD FLOOR LOBBY		10	600	120	10	200	1.3	55	140	110	0.4	1.0	VICTAULIC	7 MP	0.25	NO	(1) (2)
REMARKS:																			
(1) PROVIDE WITH DDC CONTROLLER. REFER TO CONTROLS PLANS FOR OPERATION AND REQUIRED COMPONENTS.																			
(2) BASIS OF DESIGN FOR SYSTEM HEATING HOT WATER LOOP DESIGNED WITH VICTAULIC COMBINATION BALANCING AND CONTROL VALVES. SYSTEM DESIGNED WITH A COMBINATION OF PRESSURE INDEPENDENT BALANCING VALVES (P.I.B.V.) AND MANUAL/AUTOFLOW BALANCING VALVES (A.B.V.) AT THE TERMINALS AS WELL AS PRESSURE INDEPENDENT BALANCING VALVES AT SELECT LOOP BRANCHES TO ACHIEVE MINIMUM VALVE AUTHORITIES NO LESS THAN 0.25 AT EACH TERMINAL. CONTRACTOR AT THEIR OPTION MAY SUBSTITUTE THE PROPOSED MANUFACTURER BUT SHALL SUBMIT ENGINEERED VALVE SYSTEM PLANS INDICATING THE MINIMUM AUTHORITY AT EACH TERMINAL.																			

### REHEAT COIL SCHEDULE

MARK	MANUFACTURER AND MODEL	SYSTEM SERVED	SERVICE	AIRFLOW (CFM)	MAX COIL FACE AIRFLOW VELOCITY (FPM)	MAX A.P.D. (IN. WC)	COIL FACE SIZE		E.A.T. (DEG. F)	MINIMUM CAPACITY (NBH)	HEATING HOT WATER					REMARKS		
							WIDTH (IN.)	HEIGHT (IN.)			E.W.T. (DEG. F)	L.W.T. (DEG. F)	FLOW (GPM)	MAX COIL WPD (FT. WC)	(2) CONTROL VALVE			
															MANUFACTURER		TYPE	MIN AUTH.
	RAE CORP		WASH AREA 139	440	700	0.1	10	10	38	22.3	140	110	1.3	3.0	VICTAULIC	TCM	0.25	(1) (2)
	RAE CORP		133 VESTIBULE 143	980	700	0.1	16	14	38	67.3	140	110	2.8	3.0	VICTAULIC	TCM	0.25	(1) (2)
	RAE CORP		PROCEDURE 137	440	700	0.1	10	10	38	22.3	140	110	1.3	3.0	VICTAULIC	TCM	0.25	(1) (2)
	RAE CORP		HOLDING 135	400	700	0.1	10	10	38	20.3	140	110	1.2	3.0	VICTAULIC	7 MP	0.25	(1) (2)
	RAE CORP		BREEDING 129B	215	700	0.1	8	6	38	10.9	140	110	0.6	3.0	VICTAULIC	TCM	0.25	(1) (2)
	RAE CORP		BREEDING 129A	240	700	0.1	8	8	38	12.2	140	110	0.7	3.0	VICTAULIC	TCM	0.25	(1) (2)
	RAE CORP		HOLDING 131	285	700	0.1	8	8	38	12.3	140	110	0.8	3.0	VICTAULIC	TCM	0.25	(1) (2)
	RAE CORP		BUFFER 206	2250	700	0.1	26	20	38	105	140	110	7	3.0	VICTAULIC	TCM	0.25	(1) (2)
	RAE CORP		BUFFER 206	2250	700	0.1	26	20	38	105	140	110	7	3.0	VICTAULIC	TCM	0.25	(1) (2)
	RAE CORP		BOTTLING EQUIP 252	1150	700	0.1	16	14	38	53.3	140	110	3.8	3.0	VICTAULIC	TCM	0.25	(1) (2)
	RAE CORP		BOTTLING EQUIP 252	1150	700	0.1	16	14	38	53.3	140	110	3.8	3.0	VICTAULIC	TCM	0.25	(1) (2)
	RAE CORP		BUFFER 359	2100	700	0.1	24	18	38	106.6	140	110	7.1	3.0	VICTAULIC	TCM	0.25	(1) (2)
	RAE CORP		CRYO BSL2 367	500	700	0.1	12	10	38	25.4	140	110	1.7	3.0	VICTAULIC	TCM	0.25	(1) (2)
	RAE CORP		CRYO BSL1 327	900	700	0.1	14	14	38	45.7	140	110	3.0	3.0	VICTAULIC	7 MP	0.25	(1) (2)
	RAE CORP		BUFFER 471	2100	700	0.1	22	20	38	106.6	140	110	7.1	3.0	VICTAULIC	TCM	0.25	(1) (2)
	RAE CORP		CRYO ROOM 419	400	700	0.1	10	8	38	20.3	140	110	1.4	3.0	VICTAULIC	TCM	0.25	(1) (2)
	RAE CORP		IFPD-QC 454	1200	700	0.1	16	16	38	60.9	140	110	4.1	3.0	VICTAULIC	TCM	0.25	(1) (2)
REMARKS:																		
(1) BASIS OF DESIGN FOR SYSTEM HEATING HOT WATER LOOP DESIGNED WITH VICTAULIC COMBINATION BALANCING AND CONTROL VALVES. SYSTEM DESIGNED WITH A COMBINATION OF PRESSURE INDEPENDENT BALANCING VALVES (P.I.B.V.) AND MANUAL/AUTOFLOW BALANCING VALVES (A.B.V.) AT THE TERMINALS AS WELL AS PRESSURE INDEPENDENT BALANCING VALVES AT SELECT LOOP BRANCHES TO ACHIEVE MINIMUM VALVE AUTHORITIES NO LESS THAN 0.25 AT EACH TERMINAL. CONTRACTOR AT THEIR OPTION MAY SUBSTITUTE THE PROPOSED MANUFACTURER BUT SHALL SUBMIT ENGINEERED VALVE SYSTEM PLANS INDICATING THE MINIMUM AUTHORITY AT EACH TERMINAL.																		
(2) REHEAT COIL MATERIAL: COPPER FIN/ COPPER TUBE																		



























### LABORATORY AIR VALVE SCHEDULE (SUPPLY)

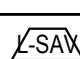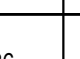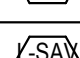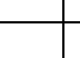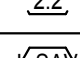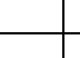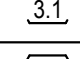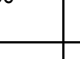MARK	MANUFACTURER AND MODEL	INLET SIZE	SUPPLY SYSTEM	SERVICE	AIRFLOW			TYPE OF CONTROL	CONTROL POWER E-POWER	REMARKS
					MAX. (CFM)	MIN (CFM)	MAX APD (IN WC)			
	ACCUTROL	12x36		2ND FLOOR BUFFER 219	4,300	0	0.3	CONSTANT	YES	(1)
	ACCUTROL	12x24		2ND FLOOR BOTTLING 252	2,300	0	0.3	CONSTANT	YES	(1)
	ACCUTROL	12x36		3RD FLOOR LABS	3,500	0	0.3	CONSTANT	YES	(1)
	ACCUTROL	12x36		4TH FLOOR LABS	3,700	0	0.3	CONSTANT	YES	(1)

REMARKS:

(1) PROVIDE WITH DDC CONTROLLER. REFER TO CONTROLS PLANS FOR OPERATION AND REQUIRED COMPONENTS.

### BUILDING OSA AIR VALVE SCHEDULE

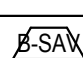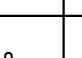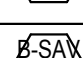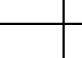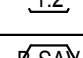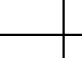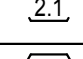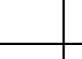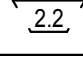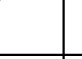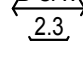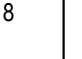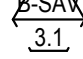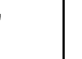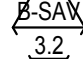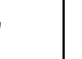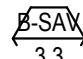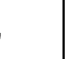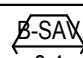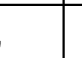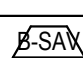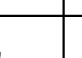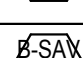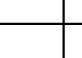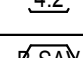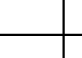MARK	MANUFACTURER AND MODEL	INLET SIZE	SUPPLY SYSTEM	SERVICE	AIRFLOW			TYPE OF CONTROL	CONTROL POWER E-POWER	REMARKS
					MAX. (CFM)	MIN (CFM)	MAX APD (IN WC)			
	ACCUTROL	12x48		1ST FLOOR EAST WING OSA	1520	0	0.3	CONSTANT	0.25	(1)
	ACCUTROL	12x36		1ST FLOOR WEST WING OSA	3680	0	0.3	CONSTANT	0.25	(1)
	ACCUTROL	12"		2ND FLOOR EAST WING OSA	880	0	0.3	CONSTANT	0.25	(1)
	ACCUTROL	12"		2ND FLOOR EAST WING OSA	1140	0	0.3	CONSTANT	0.25	(1)
	ACCUTROL	12x18		2ND FLOOR WEST WING OSA	1780	0	0.3	CONSTANT	0.25	(1)
	ACCUTROL	12"		3RD FLOOR EAST WING OSA	1170	0	0.3	CONSTANT	0.25	(1)
	ACCUTROL	14"		3RD FLOOR EAST WING OSA	1445	0	0.3	CONSTANT	0.25	(1)
	ACCUTROL	10"		3RD FLOOR WEST WING OSA	700	0	0.3	CONSTANT	0.25	(1)
	ACCUTROL	10"		3RD FLOOR WEST WING OSA	775	0	0.3	CONSTANT	0.25	(1)
	ACCUTROL	10"		4TH FLOOR EAST WING OSA	915	0	0.3	CONSTANT	0.25	(1)
	ACCUTROL	12"		4TH FLOOR EAST WING OSA	1245	0	0.3	CONSTANT	0.25	(1)
	ACCUTROL	8"		4TH FLOOR WEST WING OSA	485	0	0.3	CONSTANT	0.25	(1)
	ACCUTROL	12"		4TH FLOOR WEST WING OSA	1235	0	0.3	CONSTANT	0.25	(1)
REMARKS:										
(1) PROVIDE WITH DDC CONTROLLER. REFER TO CONTROLS PLANS FOR OPERATION AND REQUIRED COMPONENTS.										

### BUILDING RELIEF AIR VALVE SCHEDULE

MARK	MANUFACTURER AND MODEL	INLET SIZE	SUPPLY SYSTEM	SERVICE	AIRFLOW			TYPE OF CONTROL	CONTROL POWER E-POWER	REMARKS
					MAX (CFM)	MIN (CFM)	MAX APD (IN WC)			
<u>BEAN</u> <u>1.1</u>	ACCUTROL	12x48	<u>DOAS</u> <u>1</u>	1ST FLOOR EAST WING OSA	1520	0	0.3	CONSTANT	NO	<u>1</u>
<u>BEAN</u> <u>1.2</u>	ACCUTROL	12x36	<u>DOAS</u> <u>2</u>	1ST FLOOR WEST WING OSA	4605	0	0.3	CONSTANT	NO	<u>1</u>
<u>BEAN</u> <u>2.1</u>	ACCUTROL	8"	<u>DOAS</u> <u>1</u>	2ND FLOOR EAST WING OSA	385	0	0.3	CONSTANT	NO	<u>1</u>
<u>BEAN</u> <u>2.2</u>	ACCUTROL	12x18	<u>DOAS</u> <u>1</u>	2ND FLOOR EAST WING OSA	1860	0	0.3	CONSTANT	NO	<u>1</u>
<u>BEAN</u> <u>2.3</u>	ACCUTROL	14"	<u>DOAS</u> <u>2</u>	2ND FLOOR WEST WING OSA	1300	0	0.3	CONSTANT	NO	<u>1</u>
<u>BEAN</u> <u>3.1</u>	ACCUTROL	10"	<u>DOAS</u> <u>1</u>	3RD FLOOR EAST WING OSA	675	0	0.3	CONSTANT	NO	<u>1</u>
<u>BEAN</u> <u>3.2</u>	ACCUTROL	14"	<u>DOAS</u> <u>1</u>	3RD FLOOR EAST WING OSA	1340	0	0.3	CONSTANT	NO	<u>1</u>
<u>BEAN</u> <u>3.3</u>	ACCUTROL	8"	<u>DOAS</u> <u>2</u>	3RD FLOOR WEST WING OSA	350	0	0.3	CONSTANT	NO	<u>1</u>
<u>BEAN</u> <u>3.4</u>	ACCUTROL	12"	<u>DOAS</u> <u>2</u>	3RD FLOOR WEST WING OSA	1125	0	0.3	CONSTANT	NO	<u>1</u>
<u>BEAN</u> <u>4.1</u>	ACCUTROL	10"	<u>DOAS</u> <u>1</u>	4TH FLOOR EAST WING OSA	640	0	0.3	CONSTANT	NO	<u>1</u>
<u>BEAN</u> <u>4.2</u>	ACCUTROL	12x18	<u>DOAS</u> <u>1</u>	4TH FLOOR EAST WING OSA	1795	0	0.3	CONSTANT	NO	<u>1</u>
<u>BEAN</u> <u>4.3</u>	ACCUTROL	8"	<u>DOAS</u> <u>2</u>	4TH FLOOR WEST WING OSA	495	0	0.3	CONSTANT	NO	<u>1</u>
<u>BEAN</u> <u>4.4</u>	ACCUTROL	10"	<u>DOAS</u> <u>2</u>	4TH FLOOR WEST WING OSA	685	0	0.3	CONSTANT	NO	<u>1</u>
REMARKS:										
<u>1</u> PROVIDE WITH DDC CONTROLLER. REFER TO CONTROLS PLANS FOR OPERATION AND REQUIRED COMPONENTS.										



2/6/2018 10:01:38 AM  
ALL IDEAS, DESIGNS AND ARRANGEMENTS INDICATED ON THESE DRAWINGS ARE THE PROPERTY OF THE ARCHITECT AND ARE TO BE USED IN CONNECTION WITH THIS SPECIFIC PROJECT AND SHALL NOT BE USED OTHERWISE WITHOUT THE EXPRESSED CONSENT OF THE ARCHITECT.

## PIPE MATERIALS SCHEDULE

### DOMESTIC WATER PIPING ABOVE & BELOW GRADE, INSIDE BUILDING:

- TYPE "L" COPPER TUBING, HARD DRAWN CONFORMING TO ASTM B 88, WITH WROUGHT COPPER SOLDER SWEAT FITTINGS CONFORMING TO ASTM B 16.22.
- ANY WATER PIPING LOCATED BELOW GRADE SHALL BE TYPE "K" COPPER TUBING ANNEALED, WITH BRAZED JOINTS WRAPPED IN PE FILM.

### CONDENSATE PIPING:

- FOR COOLING COILS: TYPE "M" COPPER CONFORMING TO ASTM B 88M, TYPE C WITH WROUGHT COPPER FITTINGS CONFORMING TO ASTM B 16.22M. PROVIDE INSULATION ON ALL CONDENSATE PIPING WITHIN AND ON EXTERIOR OF BUILDING.
- FOR CONDENSING FLUES: CPVC PIPE AND FITTINGS CONFORMING TO ASTM F 2618. ALL PIPE FITTINGS AND CEMENT SHALL BE LISTED BY NSF INTERNATIONAL FOR CHEMICAL WASTE SERVICE AND BEAR THE MARK "NSF-CW".

### SEWER WASTE & STORM DRAIN PIPING BELOW GRADE:

- SOLID-WALL PVC PIPE, ASTM D 2665, DRAIN, WASTE AND VENT PIPING, PVC SOCKET FITTINGS CONFORMING TO ASTM D 2665, SOCKET TYPE, MADE TO ASTM D 3311 DRAIN, WASTE, AND VENT PATTERNS, INSTALL BELOW SLAB/GRADE PVC PIPING PER ASTM D 2321.

### SEWER WASTE & STORM DRAIN PIPING ABOVE GRADE:

- CAST IRON "NO-HUB" CONFORMING TO CISPI 301 AND ASTM A 888 WITH NEOPRENE GASKET AND 300 SERIES STAINLESS STEEL CLAMPING DEVICE CONFORMING TO CISPI 310.
  - DRAIN PIPING: HEAVY DUTY, SHIELDED, STAINLESS-STEEL COUPLINGS: WITH STAINLESS-STEEL SHIELD, STAINLESS-STEEL BANDS AND TIGHTENING DEVICES, AND ASTM C 564, RUBBER SLEEVE.
  - VENT PIPING: STANDARD, SHIELDED, CISPI 310 STAINLESS-STEEL COUPLINGS: WITH STAINLESS-STEEL SHIELD, STAINLESS-STEEL BANDS AND TIGHTENING DEVICES, AND ASTM C 564, RUBBER SLEEVE.
- COPPER DWV TUBE: ASTM B 306, DRAINAGE TUBE, DRAWN TEMPER, WITH ASME B16.23, CAST COPPER OR ASME B16.29, WROUGHT COPPER, SOLDER JOINT FITTINGS.

### NATURAL GAS PIPING:

- SCHEDULE 40 BLACK STEEL, CONFORMING TO ASTM A53 WITH 150 PSIG MALLEABLE IRON THREADED FITTINGS CONFORMING TO ANSI/ASME B16.3
- BELOW GRADE/SLAB : PE PIPE CONFORMING TO ASTM D 2513, SDR 11, AND PE FITTINGS CONFORMING TO ASTM D-2683, SOCKET-FUSION TYPE OR ASTM D-3261, WITH DIMENSIONS MATCHING PE PIPE. PE TRANSITION FITTINGS, FACTORY-FABRICATED FITTINGS WITH PE COMPLYING WITH ASTM D 2513, SDR 11, PROTECTIVE COATING FOR UNDERGROUND PIPING, FACTORY APPLIED, THREE-LAYER COATING OF EPOXY, ADHESIVE, AND PE.

## LAB PIPE MATERIALS SCHEDULE

### INDUSTRIAL WATER PIPING INSIDE BUILDING:

- TYPE "L" COPPER TUBING, HARD DRAWN CONFORMING TO ASTM B 88, WITH WROUGHT COPPER SOLDER SWEAT FITTINGS CONFORMING TO ASTM B 16.22.

### DEIONIZED WATER PIPING INSIDE BUILDING:

- POLYPROPYLENE (PP) SHALL BE TYPE I, GRADE I, PP NATURAL OR WHITE MANUFACTURED CONFORMING TO ASTM D792 TO SDR RATIO CONFORMING TO ASTM F714. BUTT FUSION WELDS AND PURITY REQUIREMENTS PER THE MFG. RECOMMENDATIONS.

### INDUSTRIAL WASTE PIPING INSIDE BUILDING:

- POLYPROPYLENE DRAINAGE PIPE AND FITTINGS CONFORMING TO ASTM F 1412 WITH FIRE RETARDANT ADDITIVE COMPLYING WITH ASTM D 44101, PIPE AND EXTRUDED FITTINGS CONFORMING TO ASTM 23447 AND ASTM D331. BUTT FUSION JOINT ENDS.

EXCEPTION: PIPE AND FITTINGS MADE FROM PP RESIN WITHOUT FIRE-RETARDANT ADDITIVE MAY BE USED FOR UNDERGROUND INSTALLATION.

### COMPRESSED DRY AIR PIPING:

- TYPE "L" COPPER TUBING, HARD DRAWN CONFORMING TO ASTM B 88, WITH WROUGHT COPPER BRAZED JOINTS UNDER CONTINUOUS NITROGEN PURGE CONFORMING TO AWS A5.8 & MSS SP-73.

### LABORATORY VACUUM AIR PIPING:

- TYPE "L" COPPER TUBING, HARD DRAWN CONFORMING TO ASTM B 88, WITH WROUGHT COPPER BRAZED JOINTS UNDER CONTINUOUS NITROGEN PURGE CONFORMING TO AWS A5.8 & MSS SP-73.

### CO2 PIPING:

- TYPE "L" COPPER TUBING, HARD DRAWN CONFORMING TO ASTM B 88, WITH WROUGHT COPPER BRAZED JOINTS UNDER CONTINUOUS NITROGEN PURGE CONFORMING TO AWS A5.8 & MSS SP-73.

## PLUMBING GENERAL NOTES

- CONTRACTOR SHALL CAREFULLY REVIEW THESE PLANS AND SPECIFICATIONS PRIOR TO BID. CONTRACTOR SHALL ALSO REVIEW PLANS AND SPECIFICATIONS OF OTHER RELATED TRADES (INCLUDING CIVIL, STRUCTURAL, AND ELECTRICAL) PRIOR TO BID TO INSURE AN ACCURATE UNDERSTANDING OF EXACT SCOPE OF WORK. ANY ITEMS REQUIRING CLARIFICATION SHALL BE BROUGHT TO THE ATTENTION OF THE ARCHITECT IN SUFFICIENT TIME TO BE INCORPORATED INTO THE BID.
- CONTRACTOR SHALL VERIFY ALL EQUIPMENT MODEL NUMBERS, CAPACITIES, SIZES, TRADES, AND ALL OTHER SCHEDULED INFORMATION WITH OTHER APPLICABLE TRAVEL AND WITH THE MANUFACTURER PRIOR TO INSTALLATION.
- CONTRACTOR SHALL VERIFY ALL LOCATIONS, SIZES, POCs, INVERT ELEVATIONS, AND AVAILABILITY OF ALL EXISTING UTILITIES PRIOR TO INSTALLATION OF ANY MATERIAL OR EQUIPMENT.
- THESE DRAWINGS ARE ESSENTIALLY DIAGRAMMATIC AND ARE NOT INTENDED TO INDICATE ALL DETAILS AND NECESSARY OFFSETS OF PIPING. THE CONTRACTOR SHALL INSTALL MATERIAL AND EQUIPMENT IN A MANNER AS TO CONFORM TO STRUCTURE, AVOID OBSTRUCTIONS, PRESERVE HEADROOM, AND KEEP OPENINGS AND PASSAGEWAYS CLEAR. ALL INSTALLATIONS SHALL BE CONSISTENT WITH NORMALLY ACCEPTABLE INDUSTRY STANDARDS.
- THE CONTRACTOR SHALL NOTIFY THE ARCHITECT IN WRITING OF ANY DISCREPANCIES OR CONFLICTS THAT WOULD EFFECT THE SYSTEM PERFORMANCE OR INCUR ADDITIONAL COSTS. THIS NOTIFICATION SHALL BE SUBMITTED PRIOR TO INSTALLATION OF THE ITEMS CONCERNED.
- NEW AND/OR EXISTING EQUIPMENT INDICATED ON THIS DRAWING IS SHOWN IN APPROXIMATE POSITIONS. CONTRACTOR SHALL FIELD VERIFY ALL EXISTING CONDITIONS INCLUDING EQUIPMENT LOCATIONS, POC'S AND STRUCTURAL MEMBERS PRIOR TO INSTALLATION. IN ALL CASES, ADEQUATE ACCESS (PER MANUFACTURERS RECOMMENDATIONS AND CODE COMPLIANCE) FOR MAINTENANCE AND REPLACEMENT OF EQUIPMENT SHALL BE PROVIDED.
- ALL WORK SHALL BE DONE IN ACCORDANCE WITH ALL APPLICABLE CODES. NOTHING SHOWN ON THE PLANS OR STATED IN THE SPECIFICATIONS IS INTENDED TO INDICATE THAT THE INSTALLATIONS OR CONNECTIONS OF ANY ITEM OR DEVICE SHOULD BE DONE CONTRARY TO MANUFACTURERS INSTRUCTIONS AND ALL APPLICABLE CODES AND REGULATIONS.
- THE CONTRACTOR IS RESPONSIBLE TO INSURE THAT THE INSTALLATIONS AND CONNECTIONS OF ALL ITEMS AND DEVICES CONFORMS TO MANUFACTURERS INSTRUCTIONS AND TO ALL APPLICABLE CODES AND REGULATIONS.
- SUBSTITUTION OF PLUMBING EQUIPMENT WITH EFFICIENCIES LOWER THAN THOSE INDICATED ON THE PLANS MAY REQUIRE RE-CALCULATION OF TITLE 24 DOCUMENTS. IF THE CONTRACTOR CHOOSES TO UTILIZE SUCH EQUIPMENT, HE ASSUMES FULL RESPONSIBILITY FOR THE RE-CALCULATION AND JURISDICTIONAL APPROVAL OF TITLE 24 DOCUMENTS.
- IF THE CONTRACTORS USE OF SUBSTITUTE MATERIALS, EQUIPMENT OR METHODS OF INSTALLATION REQUIRES ANY CHANGES IN OTHER TRADES WORK FROM THAT SHOWN ON THE DRAWINGS, THE EXTRA COST OF THE OTHER TRADES WORK SHALL BE THE RESPONSIBILITY OF THE CONTRACTOR INITIATING THE SUBSTITUTION.
- SUBMITTALS: APPROVAL OF THE SUBMITTALS DOES NOT RELEASE THE CONTRACTOR FROM OBLIGATIONS TO FULLY COMPLY WITH ALL REQUIREMENTS OF THE CONSTRUCTION DOCUMENTS OR APPLICABLE CODE REGULATIONS.
- ALL PLUMBING EQUIPMENT, MATERIAL, AND ALL CONNECTIONS THERETO SHALL BE INSTALLED COMPLETE PER MANUFACTURERS INSTRUCTIONS TO PROVIDE A COMPLETE AND FULLY OPERATIONAL SYSTEM.
- PLUMBING EQUIPMENT SHALL BE CERTIFIED BY AND COMPLY WITH THE STATE OF CALIFORNIA ENERGY CONSERVATION STANDARDS (E.E.S.) SECTION 113. COMPLIANCE CERTIFICATES SHALL BE PROVIDED WITH EQUIPMENT SUBMITTALS.
- WHERE NON-METALLIC PIPING PENETRATES AREA SEPARATION, 1 HOUR, OR 2 HOUR WALLS, THE PIPE SECTION PASSING THROUGH THE WALLS AND EXTENDING A DISTANCE OF 5 FEET ON EITHER SIDE THERE-OF SHALL BE OF METAL ONLY.
- CONDENSATE DRAIN PIPING FROM EQUIPMENT WITHIN BUILDING SHALL BE INSULATED A MINIMUM DISTANCE OF 20 (TWENTY) FEET FROM SAID EQUIPMENT.
- ALL INSULATING MATERIALS INSTALLED MUST BE CERTIFIED BY CALIFORNIA ENERGY COMMISSION TO MEET C.E.C. ENERGY EFFICIENCY STANDARDS (E.E.S.) SECTION 118, 123 AND 124.
- PILOTLESS IGNITION OF GAS APPLIANCES SHALL COMPLY WITH BUILDING ENERGY EFFICIENCY STANDARDS (E.E.S.) SECTION 115.
- WATER HEATERS FOR DOMESTIC HOT WATER SHALL COMPLY WITH THE STATE OF CALIFORNIA ENERGY EFFICIENCY STANDARDS (E.E.S.) SECTION 113, AND 114.
- ALL NATURAL GAS PIPING LOCATED EXPOSED ABOVE GRADE, SHALL BE INSTALLED SO THAT THE INVERT ELEVATION OF SUCH PIPING SHALL BE KEPT AT LEAST 6" ABOVE GRADE OR STRUCTURE.
- ALL HOSE BIBBS INSTALLED SHALL BE EQUIPPED WITH VACUUM BREAKERS.
- LAVATORY FAUCETS IN ALL TOILET ROOMS SHALL BE THE SELF CLOSING TYPE.
- SOIL, SEWER AND WASTE PIPING SHALL SLOPE AT 1/4" PER FOOT MINIMUM.
- ALL PLUMBING SOLDER SHALL BE LEAD FREE.
- ALL COMPONENTS OF POTABLE WATER SYSTEM, INCLUDING SHUT OFF VALVES, ANGLE STOPS, AND PLUMBING FIXTURE SHALL COMPLY WITH CALIFORNIA LAW AB 1953 AND SECTION 116875 OF THE CALIFORNIA HEALTH AND SAFETY CODE.
- BUILDING DRAIN AND VENT PIPING MATERIALS SHALL COMPLY WITH SECTIONS 701.0 AND 903.0 OF THE CALIFORNIA PLUMBING CODE.
- ALL SANITARY SYSTEM MATERIALS SHALL BE LISTED BY AN APPROVED LISTING AGENCY.
- EACH VENT SHALL RISE VERTICALLY TO A POINT NOT LESS THAN SIX (6) INCHES ABOVE THE FLOOD-LEVEL RIM OF THE FIXTURE SERVED BEFORE OFF-SETTING HORIZONTALLY OR BEFORE BEING CONNECTED TO ANY OTHER VENT.
- PLUMBING FIXTURES AND FITTINGS SHALL COMPLY WITH ALL THE REQUIREMENTS IN SECTION 5.303 IN THE 2016 CALIFORNIA GREEN BUILDING CODE.
- WATER HEATER SHALL BE ANCHORED OR STRAPPED TO RESIST HORIZONTAL DISPLACEMENT DUE TO EARTHQUAKE MOTION PER SECTION 507.2 CPC.
- WALL CLEANOUTS SHALL BE PROVIDED AT ALL URINALS & SINKS (I.E. LAB SINKS, BREAKROOM SINKS AND WELLNESS ROOM SINKS)

## LEGEND

SYMBOL	ABBR.	DESCRIPTION	SYMBOL	ABBR.	DESCRIPTION
		SITE UTILITY CONNECTION	A/C		ABOVE CEILING
	POC	POINT OF CONNECTION	A/C		AT CEILING OR STRUCTURE
	POD	POINT OF DISCONNECTION	AB		ANCHOR BOLT
	(E)	EXISTING PIPING - SEE PLANS FOR TYPE	AD		AREA DRAIN
		REMOVE EXIST. EQUIP. OR PIPES SHOWN HATCHED	AFF		ABOVE FINISHED FLOOR
	S OR W	SEWER OR WASTE BELOW FLOOR OR GRADE	AFG		ABOVE FINISHED GRADE
	S OR W	SEWER OR WASTE ABOVE FLOOR OR GRADE	AP		ACCESS PANEL
	IW	INDUSTRIAL WASTE	ABV		ABOVE
	IV	INDUSTRIAL VENT	ARCH		ARCHITECT OR ARCHITECTURAL
	CD	CONDENSATE DRAIN	B/G		BELOW GRADE
	V	SANITARY VENT	B/F		BELOW FLOOR
	CW	COLD WATER (DOMESTIC)	B/S		BELOW SLAB
	HW	HOT WATER (DOMESTIC)	BEL		BELOW
	HWR	HOT WATER RETURN	CI		CAST-IRON
	CO2	CARBON DIOXIDE	CLG		CEILING
	LV	LABORATORY VACUUM	CLR		CLEAR
	LA	LAB AIR	CONC		CONCRETE
	LN2	LIQUID NITROGEN	CONN		CONNECT OR CONNECTION
	DI	DIONIZED WATER	CONT		CONTINUATION
	DIR	DIONIZED WATER RETURN	CONTR		CONTRACTOR
	G	LOW PRESSURE NATURAL GAS	DIA		DIAMETER
	MPG	MEDIUM PRESSURE NATURAL GAS (5 PSI)	DN		DOWN
	SD	STORM DRAIN	DWGS		DRAWINGS
	OD	OVERFLOW STORM DRAIN	ELECT		ELECTRICAL
	BP	BACKFLOW PREVENTER (REDUCED PRESS. TYPE)	ELEV		ELEVATION
	GV	GATE VALVE	EXIST		EXISTING
	BV	BALL VALVE	F		DEGREES FAHRENHEIT
	CV	CHECK VALVE	FFE		FINISH FLOOR ELEVATION
	GC	GAS COOK	FFM		FEET PER MINUTE
	PRV	PRESSURE REDUCING VALVE	FN		FINISH OR FINISHED
	T&P	TEMPERATURE & PRESSURE RELIEF VALVE	FLR		FLOOR
	STR.	STRAINER	FT		FEET OR FOOT
	COTG	CLEAN-OUT TO GRADE	GPM		GALLONS PER MINUTE
	FCO	FLOOR CLEAN OUT	HDR		HEADER
	WCO	WALL CLEAN-OUT OR CLEAN-OUT BELOW FLOOR	HDP		HORSEPOWER
	CL	CAPPED LINE	HVAC		HEATING VENTILATION, & AIR CONDITIONING
		DOWN OR DROP	I.E.		INVERT ELEVATION
		UP OR RISE	INV		INVERT
	FC	FLEXIBLE CONNECTION (PIPE)	I.V.R.		INDUSTRIAL VENT THROUGH ROOF
	HB	HOSE BIBB	I.W.		IN WALL
	PG	PRESSURE GAUGE WITH GAUGE COCK	MAX		MAXIMUM
		TEE" BRANCH	MECH		MECHANICAL
		VALVE ON RISE OR DROP	MFR		MANUFACTURER
	TP	TRAP PRIMER	MIN		MINIMUM
	TH	THERMOMETER	MNTD		MOUNTED
	U	UNION	N.C.		NORMALLY CLOSED
	WHA	WATER HAMMER ARRESTOR (P.D.I. SIZE)	N.I.C.		NOT IN CONTRACT
		DIRECTION OF FLOW	NTS		NOT TO SCALE
		REDUCER	NO		NUMBER
	FS	FLOOR SINK	N.O.		NORMALLY OPEN
	FD	FLOOR DRAIN	OPER		OPERATING
	RD/OD	ROOF DRAIN / OVERFLOW DRAIN	PD		PRESSURE DROP
	AD/DD	AREA DRAIN / DECK DRAIN	PSI		POUNDS PER SQUARE INCH
			PSIG		POUNDS PER SQUARE INCH GAUGE
			PLBS		PLUMBING
			QTY		QUANTITY
			SHT		SHEET
			SOV		SHUT OFF VALVE
			ST STL		STAINLESS STEEL
			SPEC		SPECIFICATION
			SO FT		SQUARE FEET OR SQUARE FOOT
			STRUCT		STRUCTURAL
			TEMP		TEMPERATURE
			TYP		TYPICAL
			UNO		UNLESS NOTED OTHERWISE
			VTR		VENT THROUGH ROOF
			W.C.		INCHES WATER COLUMN

## PLUMBING PLAN CHECK NOTES

- WHERE PLUMBING PENETRATES THE FIRE RESISTIVE WALLS (AREA SEPARATION AND OCCUPANCY SEPARATION), THE SECTION PASSING THROUGH THE WALL SURFACE, AND THE FIXTURE CONNECTIONS ATTACHED THERETO, SHALL MEET CBC, FIRE AND TEMPERATURE RATING.
- ALL WATER HEATERS SHALL BE LISTED IN THE CEC LIST OF APPROVED WATER HEATERS.
- ALL PLUMBING FIXTURES, FAUCETS AND SHOWER HEADS SHALL COMPLY WITH CALIFORNIA GREEN BUILDING CODE MAXIMUM FLOW REQUIREMENTS PER MINUTE.
- SOIL, SEWER, AND WASTE PIPING SHALL SLOPE AT 1/4" PER FOOT MINIMUM UNLESS NOTED OTHERWISE.
- ALL SERVICE HOT WATER PIPING SHALL BE INSULATED IN ACCORDANCE WITH CEC T-24, LATEST VERSION
- STATE HEALTH & SAFETY CODE SEC. 17921.9 BANS THE USE OF CHLORINATED POLYVINYL CHLORIDE (CPVC) FOR INTERIOR WATER SUPPLY PIPING.
- VALVES, FIXTURES AND ALL OTHER APPURTENANCES SHALL CONFORM TO THE REQUIREMENTS OF CALIFORNIA ASSEMBLY BILL AB1953, LOW LEAD CONTENT AS APPLICABLE.
- PLUMBING FIXTURES AND FITTINGS SHALL MEET THE STANDARDS REFERENCED IN TABLE 5.503.6 OF DIVISION 5.3 OF THE 2016 GREEN CODE.
- EACH KITCHEN FAUCET SHALL NOT EXCEED A WATER FLOW OF 1.8 GPM.
- PROVIDE EXPANSION TANK OR OTHER APPROVED METHOD OF RELIEVING PRESSURE PER SECTION 608.3 CPC.
- INSTALLATION OF SOIL OR DRAIN PIPES IN FOOD HANDLING ESTABLISHMENTS WILL COMPLY WITH SECTION 317.0 CPC.
- BACKWATER VALVE SHALL BE INSTALLED ON THE DOWNSTREAM OF PLUMBING FIXTURES THAT ARE LOCATED ON A FLOOR LEVEL THAT IS LOWER THAN THE NEXT UPSTREAM MANHOLE COVER OF THE PUBLIC OR PRIVATE SEWER SYSTEM PER SECTION 701.1 CPC AND SUBJECT TO FIELD INSPECTION APPROVAL.
- LABEL MEDIUM PRESSURE GAS EVERY FIVE FEET.

CP-2  
VOLUME: 2

PROJECT NO. 16148

REV NO.	DATE ISSUED	REASON
	04.25.17	DESIGN DEVELOPMENT
	08.08.17	CITY SUBMITTAL SET
2.1	08.29.17	ADDENDUM #2.1
2.2	10.03.17	ADDENDUM 2.2
2.4	02.06.18	ASI 2.2
2.7	01.17.18	ASI 2.6 ADDRESS REVISION

IFC 11.20.17

Sheet Title

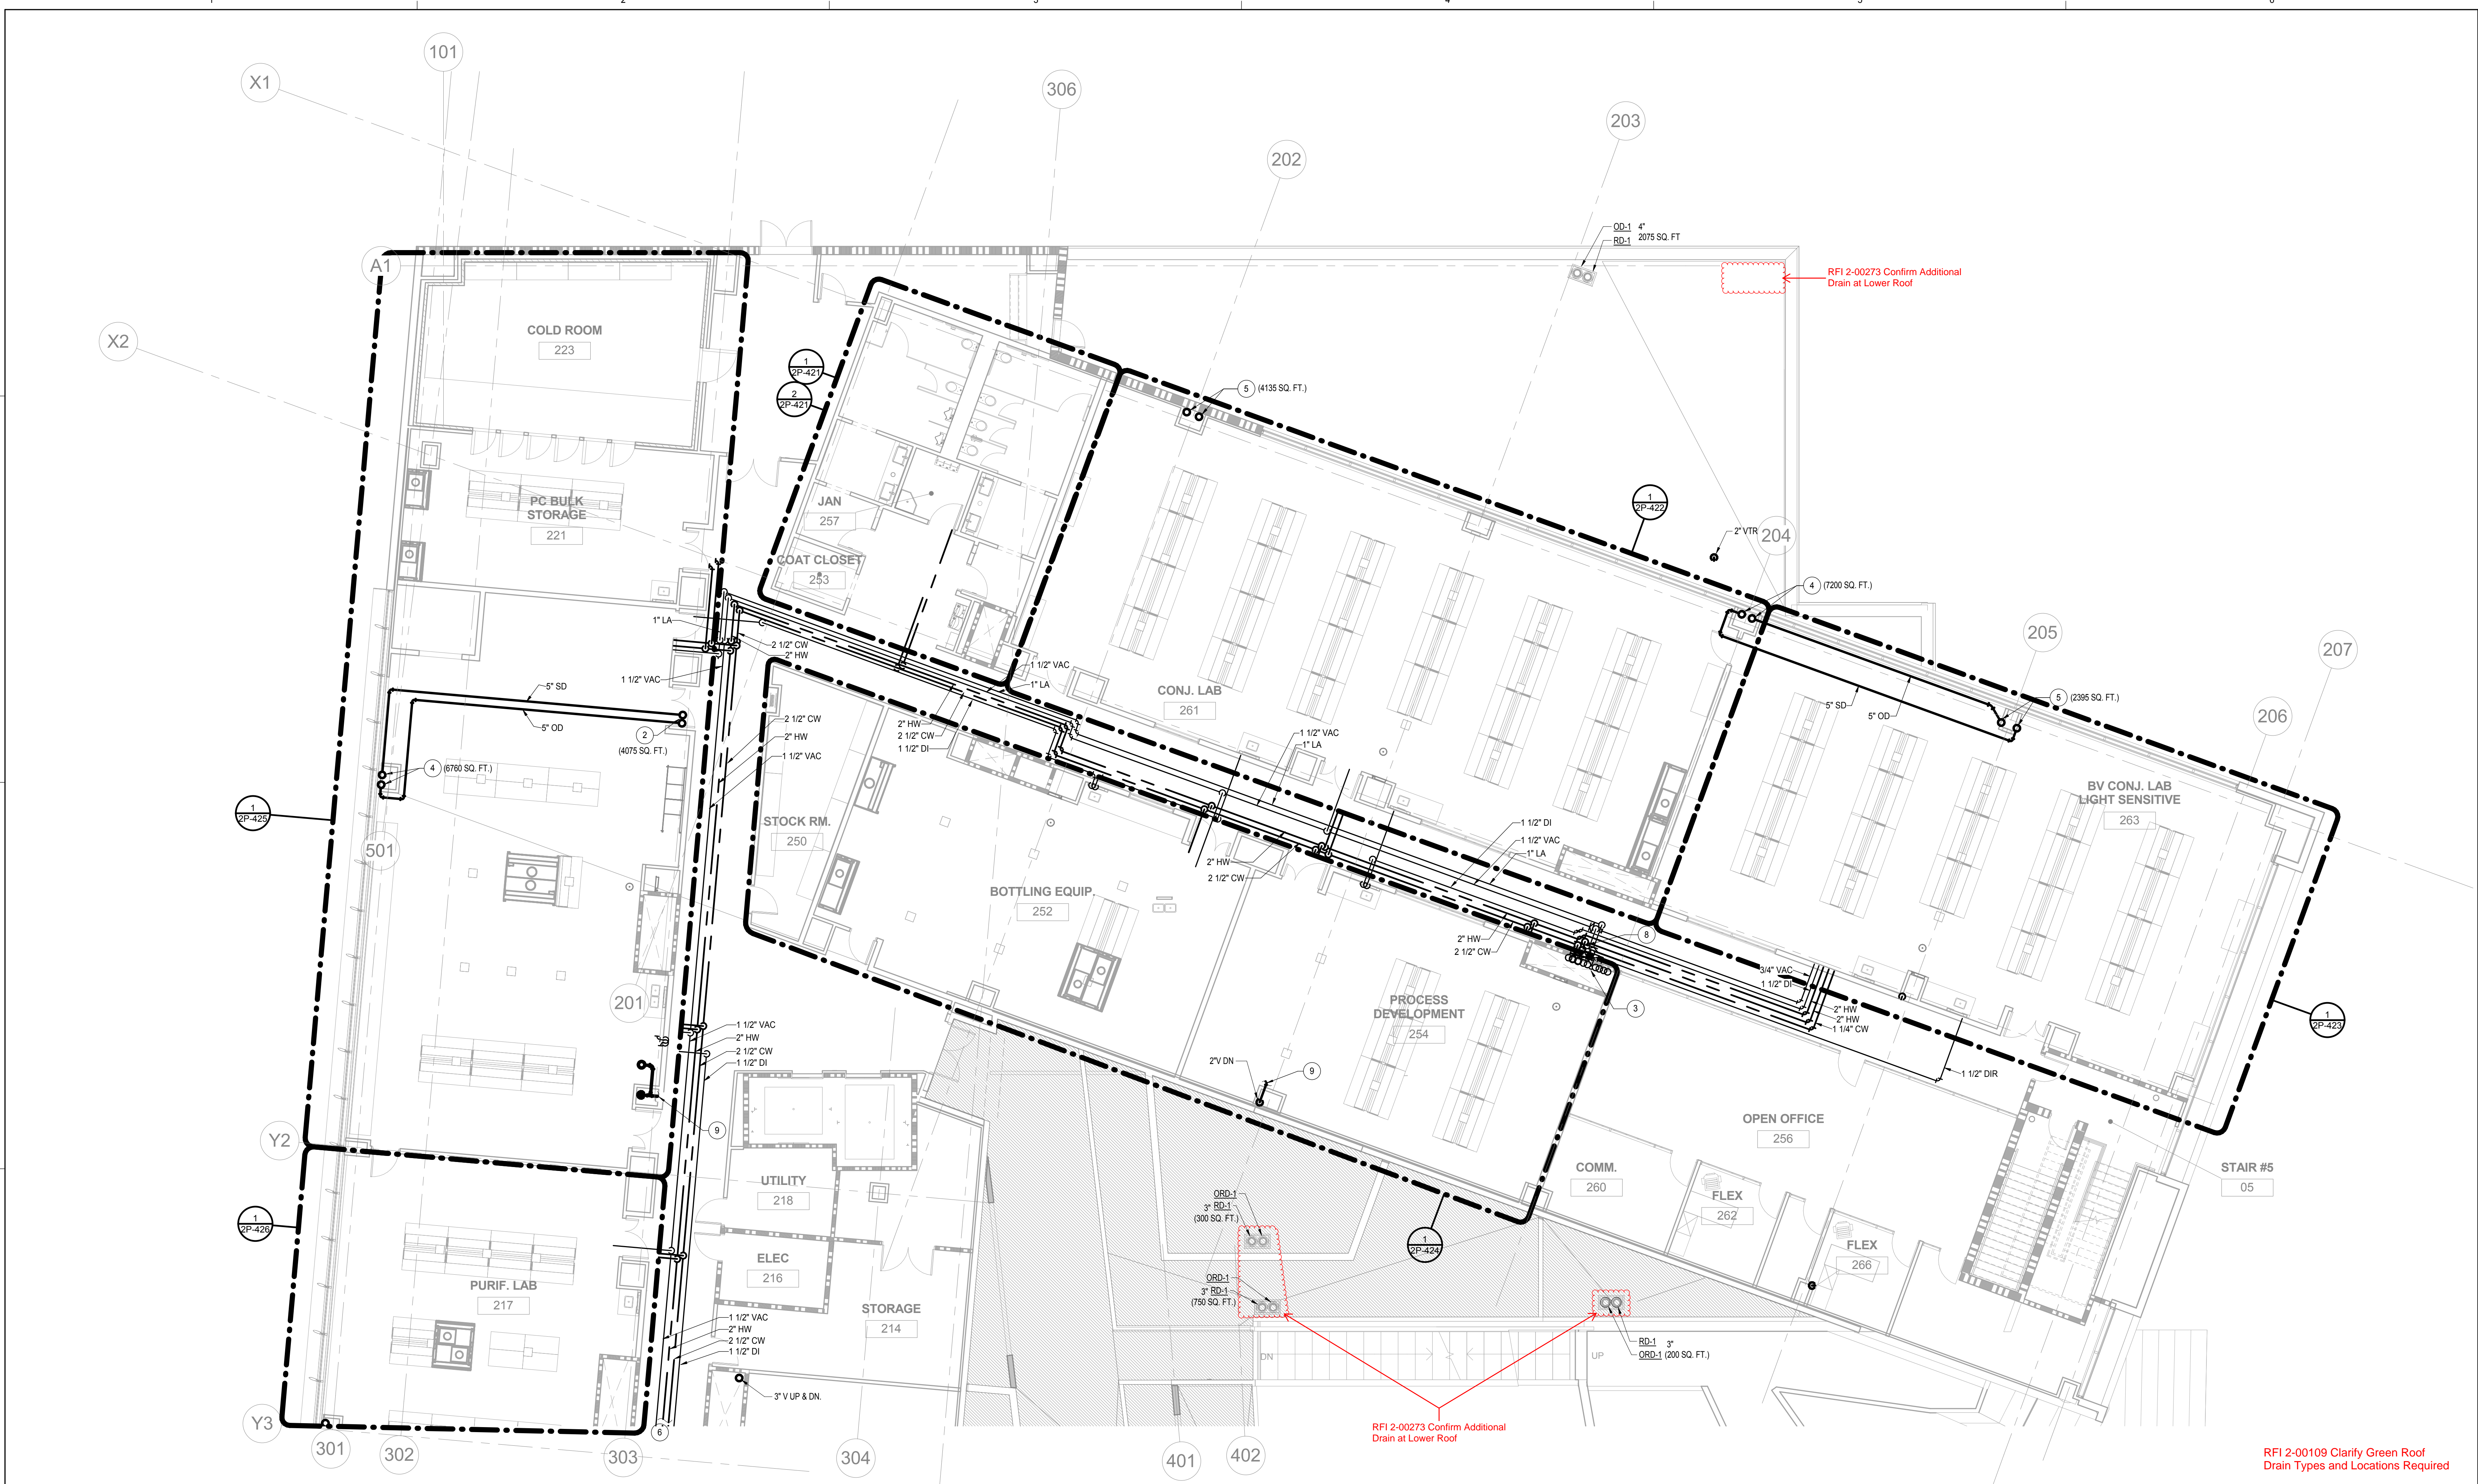
PLUMBING  
LEGEND AND  
NOTES

Sheet No.

2P-101



2/8/2018 10:02:38 AM  
ALL IDEAS, DESIGNS AND ARRANGEMENTS INDICATED ON THESE DRAWINGS ARE THE PROPERTY OF THE ARCHITECT AND ARE TO BE USED IN CONNECTION WITH THIS SPECIFIC PROJECT AND SHALL NOT BE USED OTHERWISE WITHOUT THE EXPRESSED CONSENT OF THE ARCHITECT. THESE SHALL BE NO CHANGES OR DEVIATION FROM THE DRAWINGS OR ACCOMPANYING SPECIFICATION WITHOUT THE EXPRESSED CONSENT OF THE ARCHITECT.



CP-2  
VOLUME: 2

PROJECT NO. 16148

REV NO.	DATE ISSUED	REASON
04.25.17	04.25.17	DESIGN DEVELOPMENT
08.08.17	08.08.17	CITY SUBMITTAL SET
2.1	08.29.17	ADDENDUM #2.1
2.2	10.03.17	ADDENDUM 2.2
2.3	11.20.17	ASI 2.1/IFC
2.4	02.08.18	ASI 2.2
2.7	01.17.18	ASI 2.5 ADDRESS REVISION

RFI 2-00109 Clarify Green Roof  
Drain Types and Locations Required

## 1 PLUMBING FLOOR PLAN - LEVEL 02 - PART A

1/2P-121 1/8" = 1'-0"

### SHEET NOTES

- 4" INDUSTRIAL WASTE DOWN TO FLOOR BELOW.
- 5" SD AND OD UP.
- 4" CW, 3" HW, 1-1/2" DI, 1-1/2" DIR, 3" LV & 1" LA PIPING RISERS.
- 5" SD AND OD UP & DOWN.
- 4" SD AND OD UP.
- FOR CONTINUATION SEE SHEET 2P-123.
- 2" INDUSTRIAL WASTE UP TO FLOOR ABOVE.
- 2" CW, 2" HW, 3" LV, 3/4" LA, 3/4" CO2 CAPPED AT SHAFT & 1-1/2" DIS & DIR.
- FOR CONTINUATION, SEE CP-6.

### GENERAL NOTES

- XXX

IFC 11.20.17

Sheet Title

PLUMBING  
FLOOR PLAN -  
LEVEL 02 -  
PART A

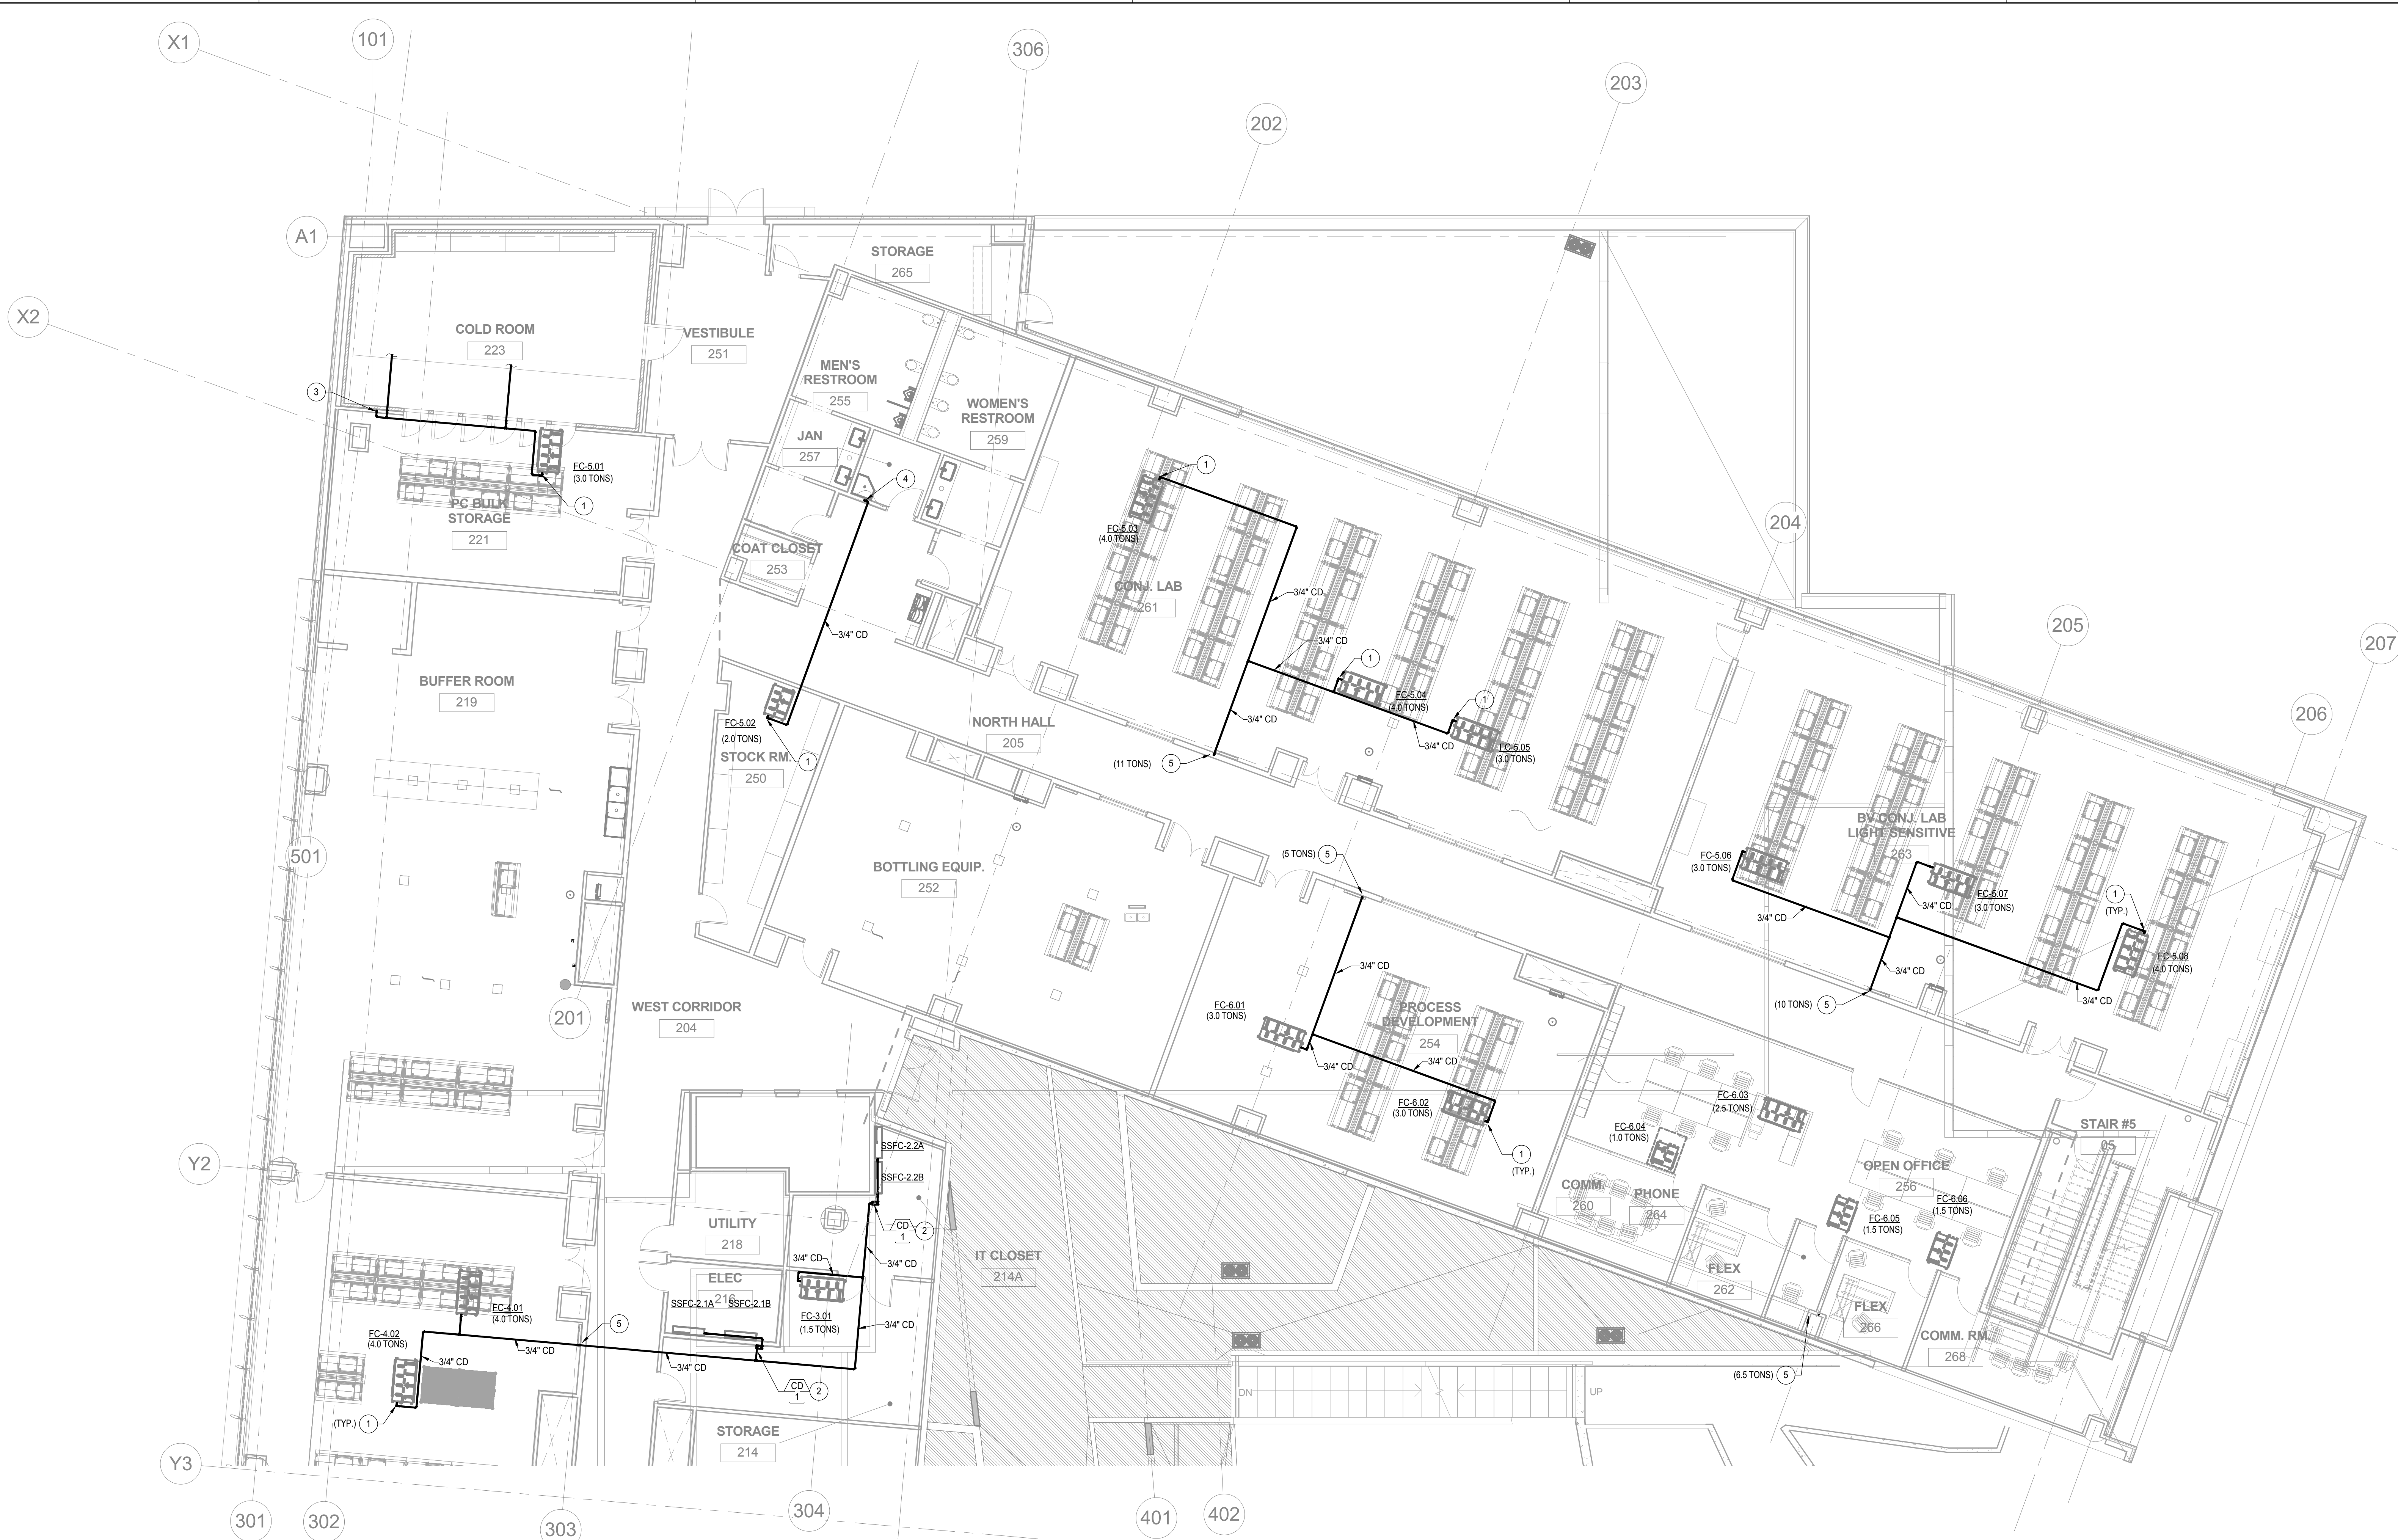
Sheet No.

2P-122



2/8/2018 10:03:08 AM  
ALL IDEAS, DESIGNS AND ARRANGEMENTS INDICATED ON THESE DRAWINGS ARE THE PROPERTY OF THE ARCHITECT AND ARE TO BE USED IN CONNECTION WITH THIS SPECIFIC PROJECT AND SHALL NOT BE USED OTHERWISE WITHOUT THE EXPRESSED CONSENT OF THE ARCHITECT. THESE SHALL BE NO CHANGES OR DEVIATION FROM THE DRAWINGS OR ACCOMPANYING SPECIFICATION WITHOUT THE EXPRESSED CONSENT OF THE ARCHITECT.

1 2 3 4 5 6



CP-2  
VOLUME: 2

PROJECT NO. 16148

REV NO.	DATE ISSUED	REASON
04.25.17	04.25.17	DESIGN DEVELOPMENT
08.08.17	08.08.17	CITY SUBMITTAL SET
2.1	08.29.17	ADDENDUM #2.1
2.2	10.03.17	ADDENDUM 2.2
2.4	02.06.18	ASI 2.2
2.7	01.17.18	ASI 2.5 ADDRESS REVISION

1

## PLUMBING CONDENSATE FLOOR PLAN - LEVEL 02 - PART A

1/8" = 1'-0"

### SHEET NOTES

- 1 PROVIDE TRAP & VENT AT FAN COIL CONDENSATE DRAIN CONNECTION.
- 2 PUMP CONDENSATE TO HIGHEST POINT.
- 3 3/4" CONDENSATE DOWN IN WALL & DISCHARGE INTO FLOOR SINK. PROVIDE AIR GAP AT TERMINATION.
- 4 CONDENSATE DOWN IN WALL & DISCHARGE INTO MOP SINK. PROVIDE AIR GAP AT TERMINATION.
- 5 CONDENSATE DOWN IN UMBILICAL AND CONNECT TO LAB SINK TAIL PIECE.
- 6 CONDENSATE DOWN TIGHT TO COLUMN TO FLOOR BELOW.

### GENERAL NOTES

1. XXX




IFC 11.20.17

Sheet Title

PLUMBING  
CONDENSATE  
FLOOR PLAN -  
LEVEL 02 -  
PART A  
2P-124



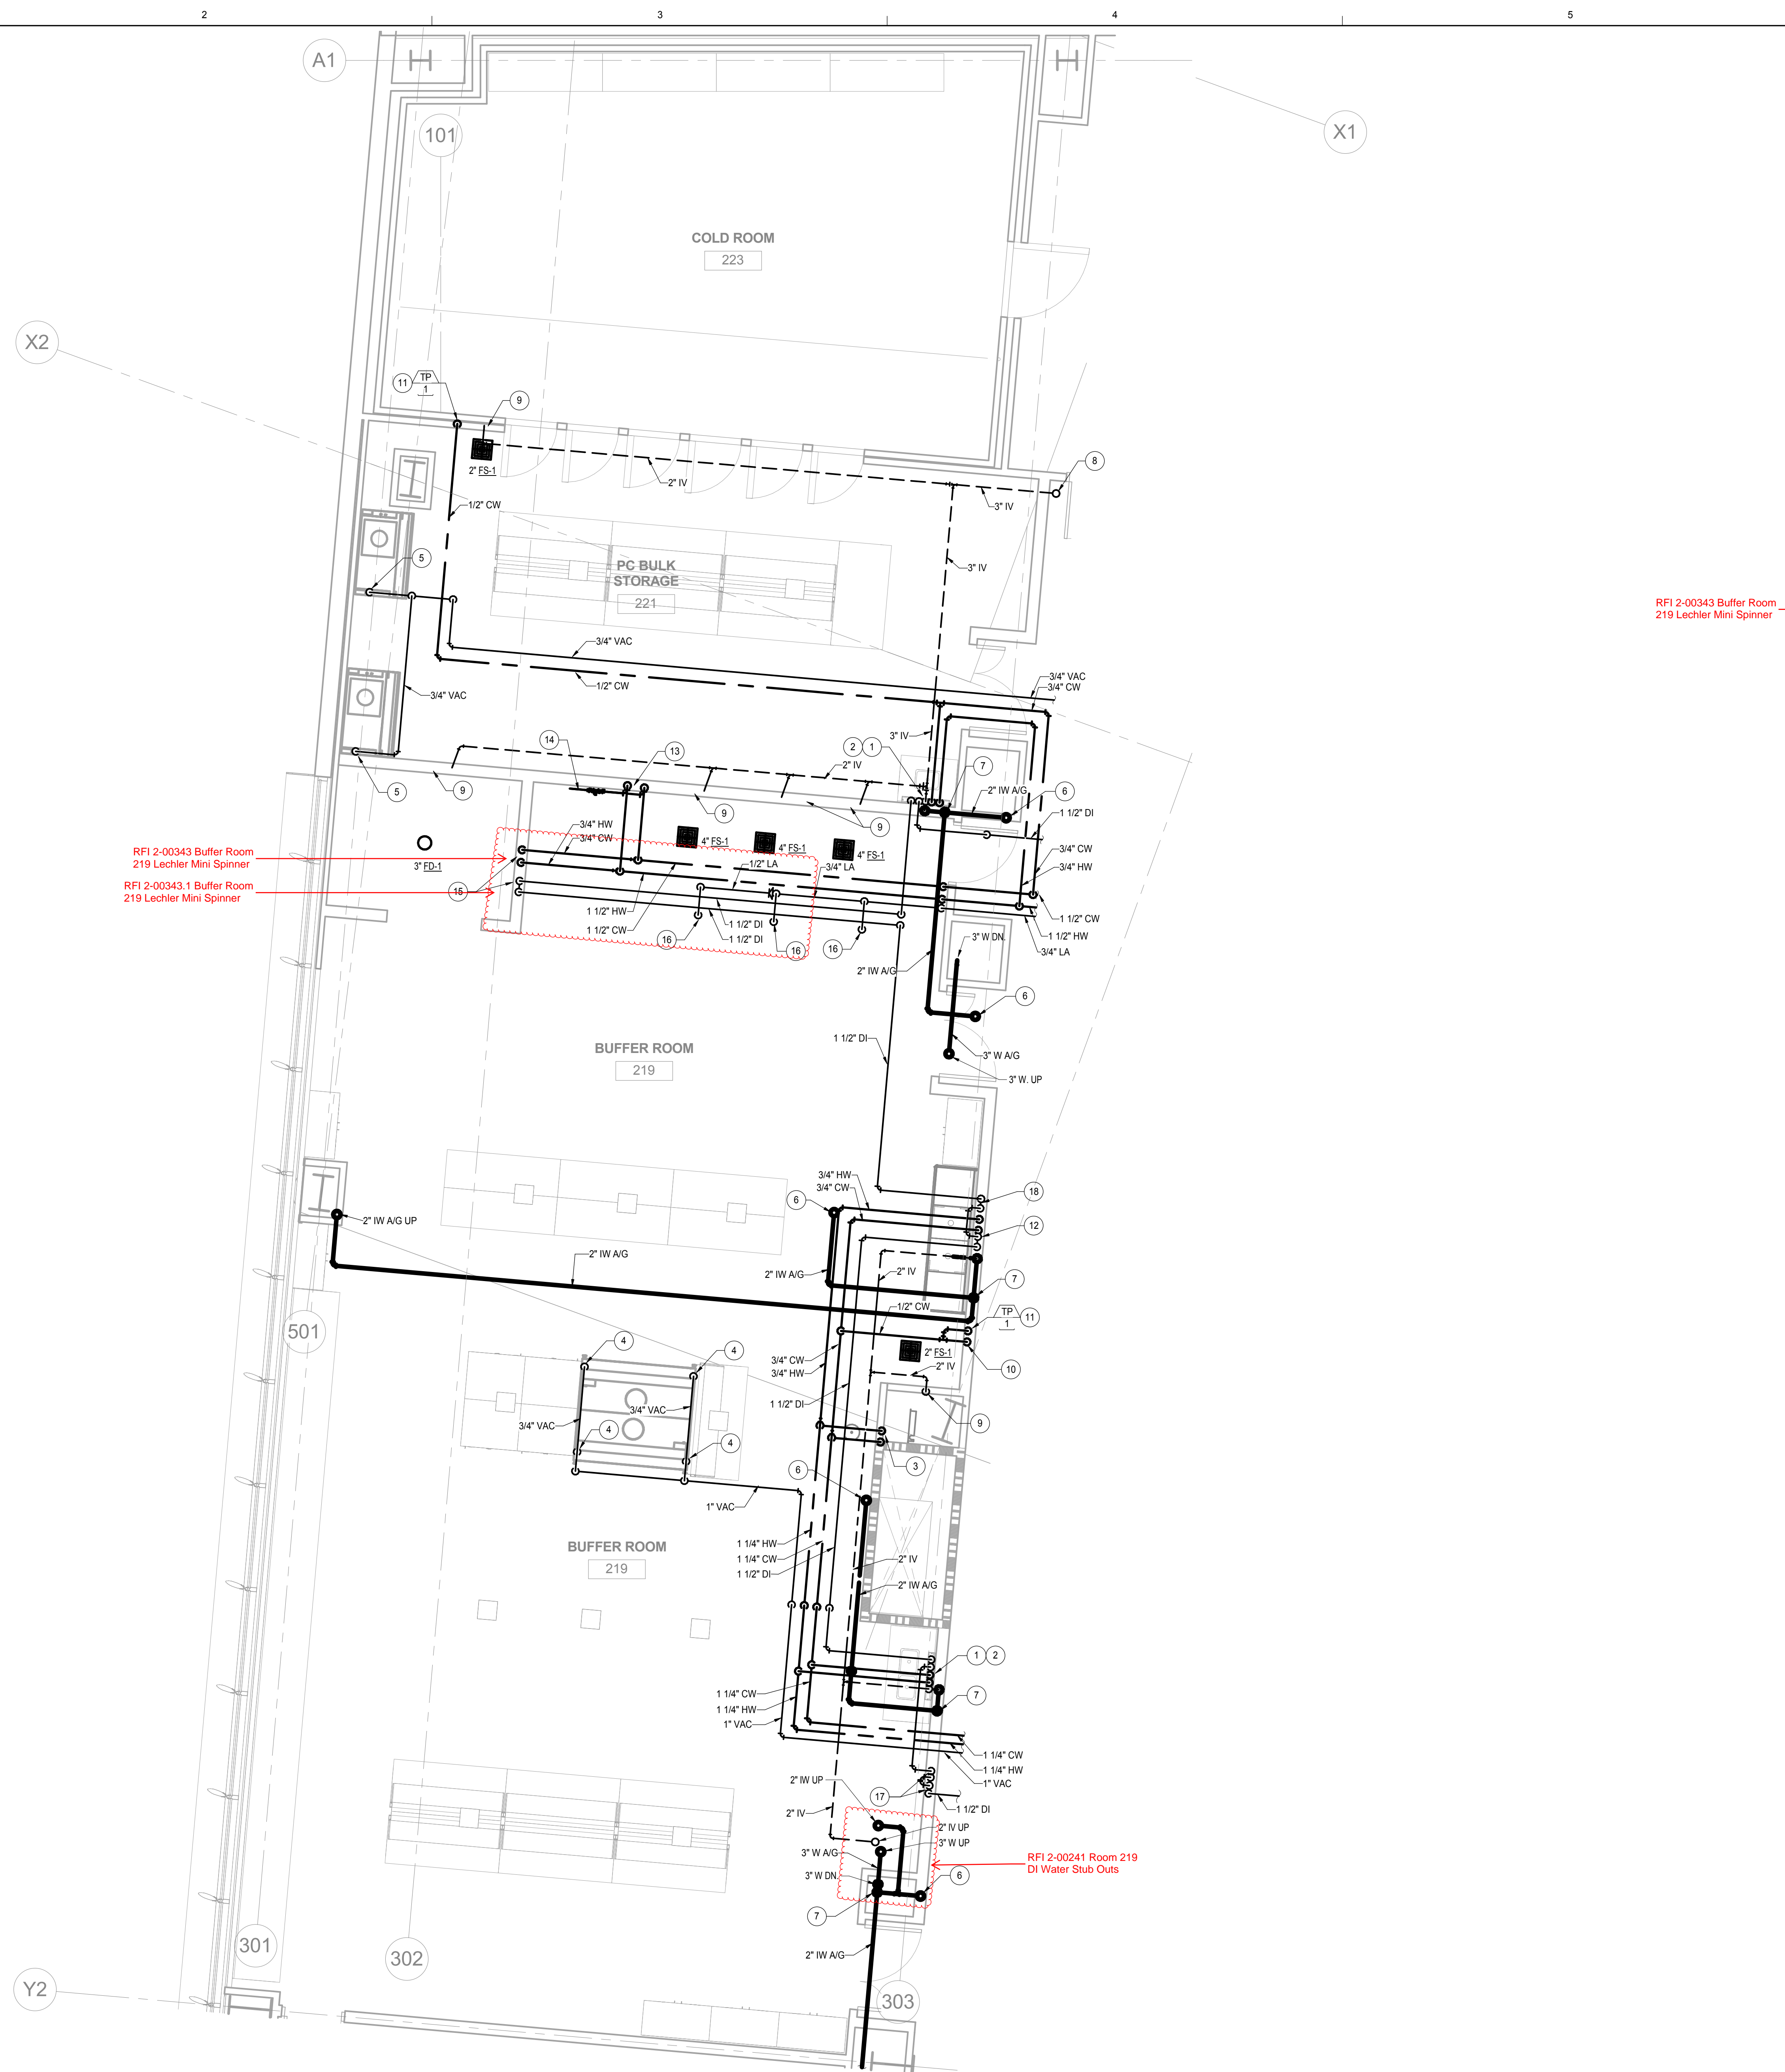2/8/2018 10:05:46 AM  
ALL DESIGNS AND ARRANGEMENTS INDICATED ON THESE DRAWINGS ARE THE PROPERTY OF THE ARCHITECT AND ARE TO BE USED IN CONNECTION WITH THIS SPECIFIC PROJECT AND SHALL NOT BE USED OTHERWISE WITHOUT THE EXPRESSED CONSENT OF THE ARCHITECT.



# SHEET NOTES

- 2" IW DOWN, 2" IV UP.
- 3/4" CW, HW, 1-1/2" DI & 1-1/2" DIR DOWN IN UMBILICAL TO LAB FIXTURE.
- 1-1/4" CW & 1-1/4" HW DOWN TO EMERGENCY SHOWER COMBO. MIXING VALVE AND SHUT-OFF VALVES TO BE LOCATED ABOVE CEILING.
- 3/4" VAC DOWN TO FUME HOOD UTILITY CONNECTION.
- 3/4" VAC DOWN IN WALL AND STUB-OUT W/ SHUT-OFF VALVE AT 20" ABOVE FINISH FLOOR. COORDINATE EXACT LOCATION OF BIO SAFETY CABINET W/ LAB FURNISHING PLAN.
- 2" IW UP TO LAB SINK.
- 2" IW DOWN TO FLOOR BELOW.
- 3" IV UP TO FLOOR ABOVE.
- 2" IV DOWN.
- 1/2" CW DOWN TO ICE MAKER BOX.
- 1/2" CW DOWN IN WALL TO TRAP PRIMER. PROVIDE ACCESS PANEL. SEE DETAIL 92P-501.
- 3/4" CW, HW, 1-1/2" DI & 1-1/2" DIR DOWN IN WALL TO LAB FIXTURE.
- 1-1/2" CW & 1-1/2" HW DOWN TO BACKFLOW PREVENTOR.
- 1-1/2" CW AND 1-1/2" HW SUPPLY TO AUTOCLAVE. PROVIDE WATER HAMMER ARRESTORS AT INLET SUPPLIES FOR GLASSWARE WASHER AND AUTOCLAVES.
- 3/4" CW, HW, 1-1/2" DI AND 1-1/2" DIR DOWN IN WALL TO CAN WASH SUPPLY. PROVIDE LECHLER SERIES SMI "MINI SPINNER" ROTATING CLEANING NOZZLE.
- 1/2" LA DOWN TO AUTOCLAVE CONNECTION.
- 1-1/2" DI & 1-1/2" DIR DOWN IN WALL TO EXPOSED 50mm x 25mm ZERO STATIC VALVE. COORDINATE EXACT LOCATION OF ZERO STATIC VALVE WITH LAB FURNISHING PLAN.
- 1-1/2" DI & 1-1/2" DIR DOWN IN WALL TO DI FAUCET.

RFI 2-00343 Buffer Room  
219 Lechler Mini Spinner

RFI 2-00343 Buffer Room  
219 Lechler Mini Spinner

RFI 2-00241 Room 219  
DI Water Stub Outs

# GENERAL NOTES

- REFER TO LAB FURNISHING PLANS FOR ALL LAB FIXTURES & EQUIPMENT UTILITY CONNECTIONS.




CP-2  
VOLUME: 2

PROJECT NO. 16148		
REV NO.	DATE ISSUED	REASON
	04.25.17	DESIGN DEVELOPMENT
	08.08.17	CITY SUBMITTAL SET
2.1	08.29.17	ADDENDUM #2.1
2.2	10.03.17	ADDENDUM 2.2
2.3	11.20.17	ASI 2.1/IFC
2.4	02.08.18	ASI 2.2
2.5	01.26.18	ASI 2.3 BUFFER ROOM REVISIONS
2.7	01.17.18	ASI 2.5 ADDRESS REVISION

IFC 11.20.17

Sheet Title  
**PLUMBING  
ENLARGED  
FLOOR PLAN -  
LEVEL 02**

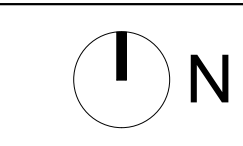Sheet No.  
**2P-425**





7/27/2018 10:08:38 AM  
ALL IDEAS, DESIGNS AND ARRANGEMENTS INDICATED ON THESE DRAWINGS ARE THE PROPERTY OF THE ARCHITECT AND ARE TO BE USED IN CONNECTION WITH THIS SPECIFIC PROJECT AND SHALL NOT BE USED OTHERWISE WITHOUT THE EXPRESSED CONSENT OF THE ARCHITECT.  
THE ARCHITECT

INTERIOR FINISH KEY SCHEDULE										
CODE	MATERIAL NAME	MANUFACTURER	MATERIAL COLLECTION	MATERIAL PRODUCT NUMBER	MATERIAL COLOR	MATERIAL SIZE	MATERIAL LOCATION	INSTALLATION NOTES	MATERIAL COMMENTS	CONTACT
AWP-1	ACOUSTIC WALL PANEL	SUSTAINABLE MATERIALS	MURATTO ORGANIC BLOCKS	BEEHIVE	YELLOW	9 7/8" x 7 1/8" x 7/8"	LEVEL 2 ATRIUM SEATING AREA	WAKOL LOBA D3540 WATER BASED CONTACT CEMENT	FOLLOW MANUFACTURERS INSTALLATION INSTRUCTIONS	LINDA SMITH - 949 244 7827
FAB-1	FABRIC	MAHARAM - KVADRAT	HALLINGDAL BY KVADRAT	460760	702	51" WIDTH	LOBBY STAIR - BENCH CUSHION		PROVIDE ALTA HEALTHCARE TREATMENT TO FABRIC	MONICA GIBE - 619 314 0138
05700	- DECORATIVE METAL									
MT-1	STAINLESS STEEL	FORMS AND SURFACES	ECO-ETCH	SEQUENCE	SATIN	3/16"	LEVEL 1 ELEVATOR DOOR AND WALL			
09771	- FABRIC WRAPPED PANELS									
AF-1	FABRIC WRAPPED PANELS	CARNEGIE	XOREL	6603 21	DASH	4' X 8' X 1"	MULTI PURPOSE ROOM WALLS PER ELEVATION, AND OPERABLE PARTITIONS	UNBACKED ON 1" FABRITRACK W/BEVELED EDGES.	USE 6-7#FIBERGLASS CORE W/ NRC RATING 0.80 AT WALLS	
033000	CAST IN PLACE CONCRETE									
CF-1	SEALED CONCRETE						REFER TO FINISH PLANS			
064023	- INT. ARCHITECTURAL WOODWORK									
PL-1	PLASTIC LAMINATE	WILSONART	PREMIUM	7952K-18	ASIAN SAND		TYPICAL BREAKROOM MILLWORK			
PL-2	PLASTIC LAMINATE	WILSONART	STANDARD	7995-38	STEELING ASH		TYPICAL BREAKROOM CUBBIES			
PL-3	PLASTIC LAMINATE	WILSONART	PREMIUM	8211K-28	PHANTOM PEARL		TYPICAL RESTROOM PARTITIONS		SOLID PHENOLIC	
PL-4	PLASTIC LAMINATE	WILSONART	PREMIUM	8210K-28	PORTICO TEAK		TYPICAL RESTROOM VANITY			
PL-5	PLASTIC LAMINATE	FORMICA	PREMIUM	8208K-16	FAWN CYPRESS	CASUAL RUSTIC W/ AEON	WELLNESS ROOM			
WD-1	WOOD				BLACK OAK		STAIRS, RECEPTION DESK, LOBBY, MPR AND AROUND CONF ROOM 302	STAIR TREADS & RISERS TO BE SOLID WOOD,	RECEPTION DESK, UNDERSIDE & SIDES OF STAIRS TO BE VENEER	
081416	- SOLID WOOD DOOR FINISH									
WD-3	WOOD	EGGERS INDUSTRIES	VENEER	110116WA	PLAIN SLICED WALNUT			01 - CLEAR		
093013	- INTERIOR CERAMIC TILING									
T-1	CERAMIC TILE	MOSA TILE	GLOBAL COLLECTION	16900	WHITE	6" X 12" X 3/16"	TYPICAL RESTROOM WALLS - USE MATCHING CORNER PIECES AND FINISHED EDGE TILES		1/8" GROUT - LATICRETE 90 LIGHT PEWTER	JEANNETTE J. 714 4312731
T-2	CERAMIC TILE	MOSA TILE	GLOBAL COLLECTION	16920	LIGHT YELLOW	6" X 6" X 1/8"	WAREHOUSE RESTROOM WALL ACCENT		1/8" GROUT - LATICRETE 90 LIGHT PEWTER	JEANNETTE J. 714 4312731
T-3	CERAMIC TILE	MOSA TILE	GLOBAL COLLECTION	17950	DARK YELLOW	6" X 6" X 1/8"	WAREHOUSE RESTROOM WALL ACCENT		1/8" GROUT - LATICRETE 90 LIGHT PEWTER	JEANNETTE J. 714 4312731
T-4	CERAMIC TILE	MOSA TILE	GLOBAL COLLECTION	17930	LIGHT PURPLE	6" X 6" X 1/8"	LEVEL 1 WOMENMEN - RESTROOM WALL ACCENT		1/8" GROUT - LATICRETE 90 LIGHT PEWTER	JEANNETTE J. 714 4312731
T-5	CERAMIC TILE	MOSA TILE	GLOBAL COLLECTION	17920	DARK PURPLE	6" X 6" X 1/8"	LEVEL 1 WOMENMEN - RESTROOM WALL ACCENT		1/8" GROUT - LATICRETE 90 LIGHT PEWTER	JEANNETTE J. 714 4312731
T-6	CERAMIC TILE	MOSA TILE	GLOBAL COLLECTION	17970	LIGHT RED	6" X 6" X 1/8"	LEVEL 2 WOMEN/ MEN - RESTROOM WALL ACCENT		1/8" GROUT - LATICRETE 90 LIGHT PEWTER	JEANNETTE J. 714 4312731
T-7	CERAMIC TILE	MOSA TILE	GLOBAL COLLECTION	19970	DARK RED	6" X 6" X 1/8"	LEVEL 2 WOMEN/ MEN - RESTROOM WALL ACCENT		1/8" GROUT - LATICRETE 90 LIGHT PEWTER	JEANNETTE J. 714 4312731
T-8	CERAMIC TILE	MOSA TILE	GLOBAL COLLECTION	17900	LIGHT GREEN	6" X 6" X 1/8"	LEVEL 3 WOMEN/ MEN - RESTROOM WALL ACCENT		1/8" GROUT - LATICRETE 90 LIGHT PEWTER	JEANNETTE J. 714 4312731
T-9	CERAMIC TILE	MOSA TILE	GLOBAL COLLECTION	16930	DARK GREEN	6" X 6" X 1/8"	LEVEL 3 WOMEN/ MEN - RESTROOM WALL ACCENT		1/8" GROUT - LATICRETE 90 LIGHT PEWTER	JEANNETTE J. 714 4312731
T-10	CERAMIC TILE	MOSA TILE	GLOBAL COLLECTION	16990	LIGHT BLUE	6" X 6" X 1/8"	LEVEL 4 WOMEN/ MEN - RESTROOM WALL ACCENT		1/8" GROUT - LATICRETE 90 LIGHT PEWTER	JEANNETTE J. 714 4312731
T-11	CERAMIC TILE	MOSA TILE	GLOBAL COLLECTION	16940	DARK BLUE	6" X 6" X 1/8"	LEVEL 4 WOMEN/ MEN - RESTROOM WALL ACCENT		1/8" GROUT - LATICRETE 90 LIGHT PEWTER	JEANNETTE J. 714 4312731
T-12	CERAMIC TILE	MOSA TILE	GLOBAL COLLECTION	15010	MATTE WHITE	6" X 12" X 3/16"	TYPICAL BREAKROOM BACKSPLASH	POWDER MATTE FINISH	CUSTOM COLOR 1/4" GROUT PER ELEVATION	JEANNETTE J. 714 4312731
T-18	CERAMIC TILE	MOSA TILE	GLOBAL COLLECTION	75620V	SMALL SPECKLED LIGHT GREY	12" X 12" X 3/16"	RESTROOM FLOOR		1/8" GROUT/LATICRETE 24 NATURAL GREY, ANTIMICROBIAL GROUT	JEANNETTE J. 714 4312731
T-18.1	CERAMIC TILE	MOSA TILE	GLOBAL COLLECTION	75620SP015015	SMALL SPECKLED LIGHT GREY	6" X 6" X 3/16"	RESTROOM COVE BASE		1/8" GROUT/LATICRETE 24 NATURAL GREY, ANTIMICROBIAL GROUT	JEANNETTE J. 714 4312731
T-19.1	PORCELAIN TILE	SPEC CERAMIC- ERGON	WOODTALK	289E1R	BEIGE DIGUE	9" X 36" X 3/8"	SERVERY AND DISH DROP AREA FLOOR	USE SCHLUTER COVE DILEX - AHK inTSSG (stone grey)	1/8" GROUT/LATICRETE 24 NATURAL GREY, ANTIMICROBIAL GROUT	BEN FRIESEN
T-20	CONCRETE TILE	CONCRETE COLLABORATIVE IRIS / VERSATILE	POLISHED CONCRETE TILE	LAGUNA	ALABASTER	48" X 48" X 3/4"	LOBBY, STEPS, PUBLIC AREAS	USE MATCHING 4" X 4" BASE	1/8" GROUT/LATICRETE 24 NATURAL GREY	SALLY SMITHWICK 917 439 8059
T-21	PORCELAIN TILE		ECOCRETE	IRG1836130	SAGE	18" X 36" X 3/8"	MULTI PURPOSE ROOM		1/8" GROUT/LATICRETE 24 NATURAL GREY	ASHA PARKER 858 586 1446
T-22	CERAMIC TILE	SPEC CERAMIC	ORNAMENTA MISERIA E NOBILITA		GREGGIO FELICE	24" X 24" X 10 MM	SEVERY WALLS	USE SCHLUTER JOLLY TSBG	1/16" GROUT/LATICRETE 90 LIGHT PEWTER	BEN FRIESEN
T-23	CERAMIC TILE	SPEC CERMAIC - MIRAGE	TRANSITION	FADE TR 01-03, TR-01, TR-03		24" X 24" X 3/8"	DISH DROP OFF AREA WALLS	SEE ELEVATIONS FOR TILE PATTERN	1/16" GROUT/LATICRETE 90 LIGHT PEWTER	BEN FRIESEN
T-25	CERAMIC TILE	DALTILE	STUDIO D	ETERNAL WALL TILE	EM 10 WHITE SEGMENTS	6" X 6" X 1/8"	SERVERY ACCENT WALL TILE		1/8" GROUT - LATICRETE 44 BRIGHT WHITE	KYLEE MIDURA 858 344 0019
T-26	PORCELAIN TILE	EMSER TILE	EXPANSE	V54EXPAIN59 118H	ISLA NATURA HONED	59" X 118" X 6MM	RECEPTION DESK WALLS	USE SCHLUTER JOLLY TSI	1/16" GROUT/LATICRETE 17 MARBLE BEIGE	DANIELLE VOMBAUR 858 740 7681
095113	- ACOUSTICAL PANEL CEILINGS									
AP-1	ACOUSTIC PANEL CEILING	ARMSTRONG	ULTIMA HIGH NRC	1945	WHITE	2' X 4'	OPEN OFFICE AREAS		GRID: SUPRAFINE 9/16"	DAI-NEE TAN 949 275 8169
AP-2	ACOUSTIC PANEL CEILING	ARMSTRONG	CALLA HIGH TOTAL ACOUSTICS	2824	WHITE	2' X 2'	CONFERENCE ROOMS		GRID: SUPRAFINE 9/16"	DAI-NEE TAN 949 275 8169
AP-3	ACOUSTIC PANEL CEILING	ARMSTRONG	ULTIMA	1913	WHITE	2' X 4'	LABS	W/ 1'X4' SERVICE PNL.	GRID: PRELUDE 15/16"	DAI-NEE TAN 949 275 8169
AP-4	ACOUSTIC PANEL CEILING	ARMSTRONG	ULTIMA HEALTH ZONE	1938	WHITE	2' X 4'	BUFFER ROOMS (W/ 1'X4' SERVICE PNL.) AND KITCHEN		GRID: 15/16" CLEAN ROOM	DAI-NEE TAN 949 275 8169
AP-5	ACOUSTIC PANEL CEILING	ARMSTRONG	FINE FISSURED	1729	WHITE	2' X 4'	BACK OF HOUSE (MECH / ELEC, STORAGE)		GRID: PRELUDE 15/16"	DAI-NEE TAN 949 275 8169
AP-6	ACOUSTIC PANEL CEILING	ARMSTRONG	ULTIMA	1913	WHITE	2' X 4'	SOME LABS AND LAB CORRIDORS	USE SINGLE SPAN PRELUDE 730098HRC ON CORRIDORS	GRID: PRELUDE 15/16"	DAI-NEE TAN 949 275 8169
WP-1	ACOUSTIC PANEL CEILING	HUNTER DOUGLAS	TECHSTYLE WOOD	OAK WOOD	MEDIUM BROWN	4' X 6' + CUSTOM	FIRST FLOOR MULTI-PURPOSE RM.	SWING DOWN	USE MID SPAN SUPPORT AT 6' LENGTHS.	GORDON GRANT 858 560 1070
WP-3	WOOD PANEL CEILING	ARMSTRONG	WOODWORKS GRILLE TEGULAR	663112 GWN	WALNUT	24" X 48" X 2"	BREAKROOMS LEVEL 2, 3 and 4 - 1/2" X 1 1/2", 12 VERTICAL	USE #5823, BLACK ABOVE	15/16" HEAVY DUTY PRELUDE XL IN BLACK	DAI-NEE TAN 949 275 8169
WP-4	WOOD PANEL CEILING	ARMSTRONG	WOODWORKS GRILLE	7265 BO GWN	WALNUT	5/8" X 2-1/4" 6'H	SERVERY, WITH WOODWORKS SOLID WOOD TRIM 6'H	USE #5823, BLACK ABOVE	15/16" HEAVY DUTY PRELUDE XL IN BLACK	DAI-NEE TAN 949 275 8169
WP-5	WOOD PANEL CEILING	ARMSTRONG	WOODWORKS LINEAR	6440WIDC	WALNUT	96" X 3 3/4" X 3/4"	CONFERENCE LEVEL 3, W/ MATCHING WOODWORKS TRIM 6'H	USE #5823, BLACK ABOVE	15/16" HEAVY DUTY PRELUDE XL IN BLACK	DAI-NEE TAN 949 275 8169
095423	- LINEAR METAL CEILINGS									
LM-1	ACOUSTIC PANEL CEILING	HUNTER DOUGLAS	WOODWRIGHT EXTERIOR BOX	DEEP BOX 6	WALNUT	6" X 1"X CUSTOM	EXTERIOR SOFFIT	SEE DRAWING		GORDON GRANT 858 560 1070
096513	- RESILIENT BASE									
B-1	BASE	JOHNSONITE		32	PEBBLE WG	4"	GENERAL OFFICE		USE W/ INTERFACE DUO TRIO	CARMELA LURIE 619 985 9319
B-2	BASE	JOHNSONITE		29	MOON ROCK WG	4"	FLEX ROOM AND COMM. ROOM AND WITH CF-1 FLOOR		USE W/ INTERFACE URBAN RETREAT	CARMELA LURIE 619 985 9319
B-3	BASE	JOHNSONITE		55	SILVER GREY	4"	TYPICAL LAB FLOOR AND IT ROOM		USE W/ LAB VCT	CARMELA LURIE 619 985 9319
B-4	BASE	JOHNSONITE		280	SHORELINE	4"	TYPICAL LAB CORRIDOR AND WELLNESS AND BREAKROOM		USE W/ CORRIDOR VCT	CARMELA LURIE 619 985 9319
B-6	WOOD BASE		PT GRADE WD BASE		WALL COLOR	4"	MPR			

INTERIOR FINISH KEY SCHEDULE										
CODE	MATERIAL NAME	MANUFACTURER	MATERIAL COLLECTION	MATERIAL PRODUCT NUMBER	MATERIAL COLOR	MATERIAL SIZE	MATERIAL LOCATION	INSTALLATION NOTES	MATERIAL COMMENTS	CONTACT
096516 - RESILIENT SHEET FLOORING										
RS-1	SHEET FLOORING	JOHNSONITE	IQ NATURAL	273	NIMBUS CG	66" ROLL	GMP LAB	SELF COVE		CARMELA LURIE 619 985 9319
096519 - RESILIENT TILE FLOORING										
LVT-1	LUXURY VINYL TILE	USF CONTRACT	STRATUM 700 WIDE PLANK	50DLV704	MONTEREY OAK	7 1/8" X 48" X 8mm	WELLNESS ROOMS AND BREAKROOM LEVEL 4	GLUE DOWN	USE ADHESIVE 30GT400	KIM MCVAY 562 900 2583
LVT-2	LUXURY VINYL TILE	INTERFACE	LEVEL SET COLLECTION	A00406	ANTIQUE LIGHT OAK	25CM X 1M	BREAKROOMS LEVEL 2 AND 3	TACK TILES	TEXTURED WOOD GRAINS	MATT PROBST 619 857 4179
VCT-1	VINYL COMPOSITION TILE	ARMSTRONG	STANDARD EXCELON-IMP TEXT	51861	SOFT WARM GRAY	12" X 12"	LAB FLOORS	GLUE DOWN	3 COATS OF FLOOR WAX	PAULA HABERKERN 619 756 3698
VCT-2	VINYL COMPOSITION TILE	ARMSTRONG	STANDARD EXCELON-RAVE	57515	HOT LIPS	12" X 12"	SECOND FLOOR - LIGHT RED ACCENT	GLUE DOWN	3 COATS OF FLOOR WAX	PAULA HABERKERN 619 756 3698
VCT-3	VINYL COMPOSITION TILE	ARMSTRONG	STANDARD EXCELON-IMP. TEXT.	51816	CHERRY RED	12" X 12"	SECOND FLOOR - DARK RED ACCENT	GLUE DOWN	3 COATS OF FLOOR WAX	PAULA HABERKERN 619 756 3698
VCT-4	VINYL COMPOSITION TILE	ARMSTRONG	STANDARD EXCELON-RAVE	57510	KICKIN KIWI	12" X 12"	THIRD FLOOR - LIGHT GREEN ACCENT	GLUE DOWN	3 COATS OF FLOOR WAX	PAULA HABERKERN 619 756 3698
VCT-5	VINYL COMPOSITION TILE	ARMSTRONG	STANDARD EXCELON-IMP. TEXT.	51824	SEA GREEN	12" X 12"	THIRD FLOOR - DARK GREEN ACCENT	GLUE DOWN	3 COATS OF FLOOR WAX	PAULA HABERKERN 619 756 3698
VCT-6	VINYL COMPOSITION TILE	ARMSTRONG	STANDARD EXCELON-RAVE	57512	BIKINI BLUE	12" X 12"	FOURTH FLOOR - LIGHT BLUE ACCENT	GLUE DOWN	3 COATS OF FLOOR WAX	PAULA HABERKERN 619 756 3698
VCT-7	VINYL COMPOSITION TILE	ARMSTRONG	STANDARD EXCELON-IMP. TEXT.	51821	CARIBBEAN BLUE	12" X 12"	FOURTH FLOOR - DARK BLUE ACCENT	GLUE DOWN	3 COATS OF FLOOR WAX	PAULA HABERKERN 619 756 3698
VCT-8	VINYL COMPOSITION TILE	ARMSTRONG	MIGRATIONS BBT	T3509	MUSHROOM BEIGE	12" X 12"	LAB CORRIDORS	GLUE DOWN	3 COATS OF FLOOR WAX	PAULA HABERKERN 619 756 3698
096566 - STATIC CONTROL RESILIENT FLOORING										
SCT-1	STATIC CONTROL	FORBO	CLOREX VINYL TILE	SD 150207	QUARTZ	24" X 24"	IT ROOMS	GLUE DOWN	USE B-3	NICOLE RIVERIA 619 213 7232
096723 - RESINOUS FLOORING										
RF-1	EPOXY	STONHARD	STONETECK	TRF	SANTA CRUZ		W/ INTEGRAL COVE BASE			GEREMY 619-8864265
RF-2	EPOXY	STONHARD	STONESHIELD	HR-1	DRIFTWOOD		BUFFER ROOM W/ INTEGRAL COVE BASE			GEREMY 619-8864265
RF-3	EPOXY	STONHARD	STONECLAD	UT	PEWTER		KITCHE W/ INTEGRAL COVE BASE			GEREMY 619-8864265
096813 - CARPET TILE										
CP-1	CARPET TILE	INTERFACE	DUO TRIO	D-103870, T-103878	D-ASH, T-LINEN ASH	25CM X 1M	OPEN OFFICE	ASHLAR, TACK TILES	100% RECYCLED CONTENT TYPE 6 NYLON	MATT PROBST 619 857 4179
CP-2	CARPET TILE	INTERFACE	URBAN RETREAT	102996	STONE	50 CM X 50 CM	FLEX ROOM, TELE ROOM, COMM ROOM	TACK TILES	100% RECYCLED SOLUTION DYED NYLON	MATT PROBST 619 857 4179
CP-3	CARPET TILE	INTERFACE FLOOR	URBAN NATURE	URBAN NATURE	STONE GRASS	50 CM X 50 CM	FLEX ROOM, TELE ROOM, COMM ROOM	TACK TILES	100% RECYCLED SOLUTION DYED NYLON	MATT PROBST 619 857 4179
CP-4	CARPET TILE	INTERFACE	URBAN RETREAT	100641	GRASS	50 CM X 50 CM	FLEX ROOM, TELE ROOM, COMM ROOM	TACK TILES	100% RECYCLED SOLUTION DYED NYLON	MATT PROBST 619 857 4179
CP-5	CARPET TILE	SHAW CONTRACT	CONFIGURE	5T161	59991 - BRILLIANT	24.9"H X 28.8 DIA	MPR, PER PLAN	LOKDOTS	ECOSOLUTION Q W/ ECOWORKS BACKING	CATHY MILLER
CP-6	CARPET TILE	SHAW CONTRACT	CONFIGURE	5T160	59518 - BRILLIANT PROPORTION	24.9"H X 28.8 DIA	MPR, PER PLAN	LOKDOTS	ECOSOLUTION Q W/ ECOWORKS BACKING	CATHY MILLER
CP-7	CARPET TILE	SHAW CONTRACT	CONFIGURE	5T159	59518 - PROPORTION	24.9"H X 28.8 DIA	MPR, CORRIDOR, PER PLAN	LOKDOTS	ECOSOLUTION Q W/ ECOWORKS BACKING	CATHY MILLER
CP-8	CARPET TILE	SHAW CONTRACT	CONFIGURE	5T161	59615 - SOCIAL	24.9"H X 28.8 DIA	MPR, PER PLAN	LOKDOTS	ECOSOLUTION Q W/ ECOWORKS BACKING	CATHY MILLER
CP-9	CARPET TILE	SHAW CONTRACT	CONFIGURE	5T160	59596 - SOCIAL DIALOGUE	24.9"H X 28.8 DIA	MPR, PER PLAN	LOKDOTS	ECOSOLUTION Q W/ ECOWORKS BACKING	CATHY MILLER
CP-10	CARPET TILE	SHAW CONTRACT	CONFIGURE	5T159	59596 - DIALOGUE	24.9"H X 28.8 DIA	MPR, CORRIDOR, PER PLAN	LOKDOTS	ECOSOLUTION Q W/ ECOWORKS BACKING	CATHY MILLER
CP-11	CARPET TILE	SHAW CONTRACT	CONFIGURE	5T161	59325 - SUBLIME	24.9"H X 28.8 DIA	MPR, PER PLAN	LOKDOTS	ECOSOLUTION Q W/ ECOWORKS BACKING	CATHY MILLER
CP-12	CARPET TILE	SHAW CONTRACT	CONFIGURE	5T160	59104 - SUBLIME SHIFT	24.9"H X 28.8 DIA	MPR, PER PLAN	LOKDOTS	ECOSOLUTION Q W/ ECOWORKS BACKING	CATHY MILLER
CP-14	CARPET TILE	INTERFACE	HUMAN NATURE	HN 840	SHALE -104226	25CM X 1M	CONFERENCE ROOM LEVEL 3	ASHLAR, TACK TILES	100% RECYCLED CONTENT TYPE 6 NYLON	MATT PROBST 619 857 4179
CP-15	CARPET TILE	INTERFACE	HUMAN NATURE	HN 850	SHALE - 104210	25CM X 1M	CONFERENCE ROOM LEVEL 3 BORDER	ASHLAR, TACK TILES	100% RECYCLED CONTENT TYPE 6 NYLON	MATT PROBST 619 857 4179
CP-20	CARPET TILE	INTERFACE	ON LINE	#138700AK00	103801 POPPY	25CM X 1M	ACCENT CARPET LEVEL 2	TACK TILES	100% RECYCLED CONTENT TYPE 6 NYLON	MATT PROBST 619 857 4179
CP-21	CARPET TILE	INTERFACE	ON LINE	#138700AK00	103798 LIME	25CM X 1M	ACCENT CARPET LEVEL 3	TACK TILES	100% RECYCLED CONTENT TYPE 6 NYLON	MATT PROBST 619 857 4179
CP-22	CARPET TILE	INTERFACE	ON LINE	#138700AK00	103799 LAPIS	25CM X 1M	ACCENT CARPET LEVEL 4	TACK TILES	100% RECYCLED CONTENT TYPE 6 NYLON	MATT PROBST 619 857 4179
WMT-1	WALK OFF MAT	CS- ENTRANCE FLOOR	GRID LINE 2 W/ SLIP NOT	G6P(SN)(3/4")	TBD	PER PLAN	AT ATRIUM, RECESSED			
097200 - WALL COVERINGS										
WC-1	WALLCOVERING	TRIKES	LANARK - RIO	LSC.RO. 03	SILVER FIR	54" WIDE ROLL	ELEVATOR LOBBY L2, L3 AND L4		100% VYNIL CLASS A	
WC-2	WALLCOVERING	BLEND	CUSTOM	CUSTOM	CUSTOM	54" WIDE ROLL	REFER TO FINISH PLANS	CUSTOM IMAGE	100% VYNIL CLASS A	RON LEWIS 858 9527 611
WC-3	WALLCOVERING	KOROSEAL	ARBOR WOOD WALLCOVERING	RECON HAVANA	AA5611HAV		LOBBY NICHE AND L3 MEETING ROOM		VENEER	SHARLENE M. 858-449-4546
097720 - DECORATIVE FIBERGLASS REINFORCED WALL PANELS										
FRP-1	FIBERGLASS REINF.	MARLITE	PEBBLED SURFACE	P 440N	BISCUIT	4' x 10' x 3/32"	WASH RM AND BUFFER RM (WASH)			
099123 - INTERIOR PAINTING										
P-1	PAINT	SHERWIN WILLIAMS		SW 7042	SHOJI WHITE		TYPICAL WALL COLOR	SATIN FINISH		
P-2	PAINT	SHERWIN WILLIAMS		SW 7004	SNOWBOUND		TYPICAL CEILING COLOR	FLAT FINISH		
P-3	PAINT	SHERWIN WILLIAMS		SW 7015	REPOSE GRAY		TYPICAL RESTROOM WALLS + DOORS AND DOOR FRAME	SATIN FINISH		
P-4	PAINT	SHERWIN WILLIAMS		SW 6314	LUXURIOUS RED		DARK RED LEVEL 2 ACCENT PAINT	SATIN FINISH		
P-5	PAINT	BENJAMIN MOORE		2003-20	STRAWBERRY RED		LIGHT RED LEVEL 2 ACCENT PAINT	SATIN FINISH		
P-6	PAINT	BENJAMIN MOORE		2041-20	FIDDLEHEAD GREEN		DARK GREEN LEVEL 3 ACCENT PAINT	SATIN FINISH		
P-7	PAINT	SHERWIN WILLIAMS		SW 9030	LIMON FRESCO		LIGHT GREEN LEVEL 3 ACCENT PAINT	SATIN FINISH		
P-8	PAINT	DUNN EDWARDS		DE5839	INK BLOTCH		DARK BLUE LEVEL 4 ACCENT PAINT	SATIN FINISH		
P-9	PAINT	SHERWIN WILLIAMS		SW 6788	CAPRI		LIGHT BLUE LEVEL 4 ACCENT PAINT	SATIN FINISH		
P-10	PAINT	SHERWIN WILLIAMS		SW 6983	FULLY PURPLE		DARK PURPLE LEVEL 1 ACCENT PAINT	SATIN FINISH		
P-11	PAINT	SHERWIN WILLIAMS		SW 6831	CLEMATIS		LIGHT PURPLE LEVEL 1 ACCENT PAINT	SATIN FINISH		
P-12	PAINT	SHERWIN WILLIAMS		SW 6914	EYE CATCHING		YELLOW LEVEL 1 ACCENT PAINT	SATIN FINISH		
P-13	PAINT	SHERWIN WILLIAMS		SW 7073	NETWORK GRAY		DARK GREY ACCENT PAINT	SATIN FINISH		
P-14	PAINT	SHERWIN WILLIAMS		SW 7037	BALANCED BEIGE		ATRIUM RECEPTION DOOR PAINT	SATIN FINISH		
P-DE	PAINT	SHERWIN WILLIAMS	DRY ERASE				REFER TO FINISH PLANS			
122413 - ROLLER WINDOW SHADES										
RWS-1	ROLLER WINDOW SHADE	LUTRON	SHEER LITE	SHL-212-5	CHARCOAL GREY	5'-6" W	5% NORTH WINDOWS, PER PLAN			DENISE JENKINS 858 254 9047
RWS-2	ROLLER WINDOW SHADE	LUTRON	SHEER LITE	SHL-212-3	CHARCOAL GREY	5'-6" W	3% SOUTH, WEST, AND EAST WINDOWS, PER PLAN			DENISE JENKINS 858 254 9047
RWS-3	ROLLER WINDOW SHADE	LUTRON	BLACKOUT		CHARCOAL GREY	5'-6" W	ROOM 263			DENISE JENKINS 858 254 9047



2/10/2018 1:51:20 PM  
ALL IDEAS, DESIGNS AND ARRANGEMENTS INDICATED ON THESE DRAWINGS ARE THE PROPERTY OF THE ARCHITECT AND ARE TO BE USED IN CONNECTION WITH THIS SPECIFIC PROJECT AND SHALL NOT BE USED OTHERWISE WITHOUT THE EXPRESSED CONSENT OF THE ARCHITECT. THESE SHALL BE NO CHANGES OR DEVIATION FROM THE DRAWINGS OR ACCOMPANYING SPECIFICATION WITHOUT THE EXPRESSED CONSENT OF THE ARCHITECT.

1

SECOND LEVEL FRAMING PLAN - PART A

RFI 2-00007 Clarification for Missing Tie-in Dimensions

RFI 2-00007.1 Clarification for Missing Tie-in Dimensions Revision

RFI 2-00059 Sequence 1 Steel Missing Dimensions

RFI 2-00066 Clarification to EOS Locations & Dimensions

RFI 2-00112.1 Confirm Framing Infill for Lvl 1 Overhead SFD

1/8" = 1'-0"

0 4' 8' 16'  
SCALE: 1/8" = 1'

N

2

FRAMING PLAN AT STEPPED GREEN ROOF

1/8" = 1'-0"

FLOOR FRAMING NOTES:

- FOR FRAMING NOTES AND LEGENDS, SEE SHEET 2S-121.
- DETAILS 8/2S-553 AND 13/2S-553 CONFORM TO THE CONFINEMENT DETAIL AS REQUIRED BY CONDITION #2 ON CITY OF LOS ANGELES REPORT HBR-25746 (TILE TECH PAVERS PEDESTAL SYSTEM) AND PROVIDES SEISMIC STABILITY AS REQUIRED THEREON.

RFI 2-00212 Stepped Green Roof Vertical Bent Plate

PROJECT NO. 16148

REV NO.	DATE ISSUED	REASON
04.25.17	04.25.17	DESIGN DEVELOPMENT
07.10.17	07.10.17	STRUCT. STEEL BID SET
08.08.17	08.08.17	CITY SUBMITTAL SET
2.1	08.29.17	ADDENDUM #2.1
2.2	10.03.17	ADDENDUM #2.2
2.3	11.20.17	ASI 2.1/IFC
2.8	02.14.18	ASI 2.8

IFC 11.20.17

SHEET TITLE  
SECOND LEVEL FRAMING PLAN - PART A

SHEET NO.

2S-122



CP-2  
VOLUME 1

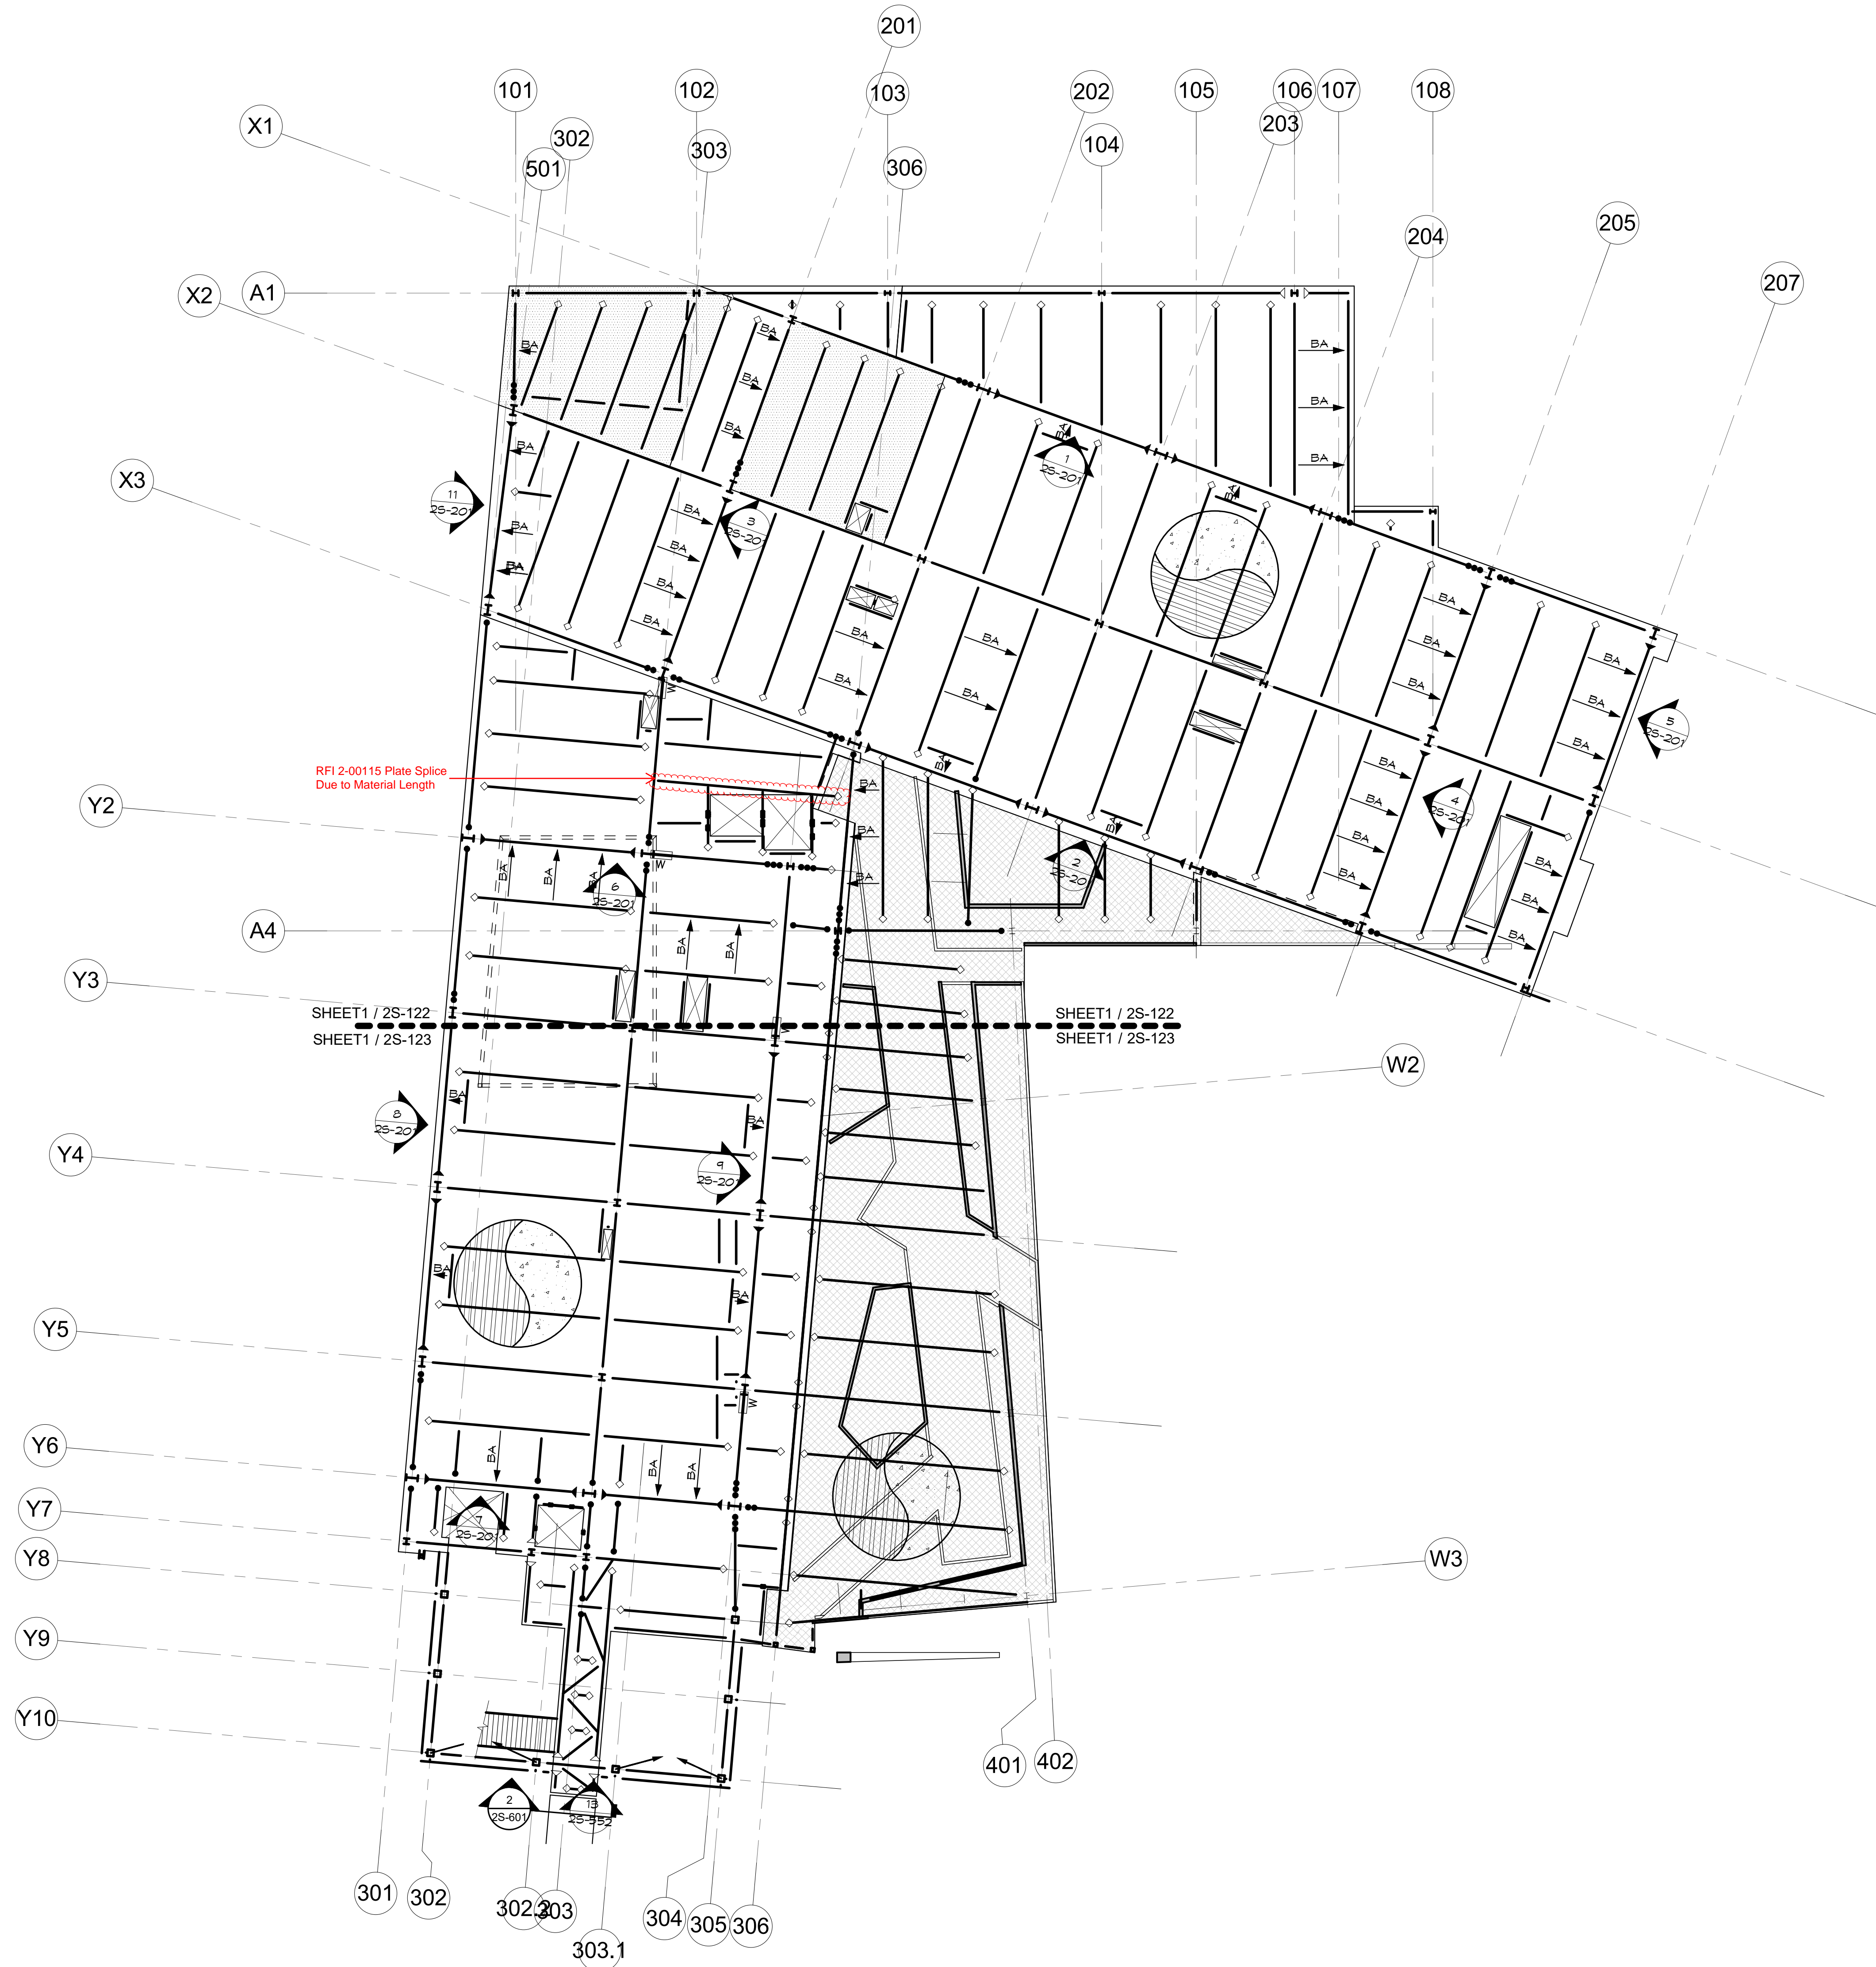
8

B

A



11/17/2017 11:39:52 AM  
ALL IDEAS, DESIGNS AND ARRANGEMENTS INDICATED ON THESE DRAWINGS ARE THE PROPERTY OF THE ARCHITECT AND ARE TO BE USED IN CONNECTION WITH THIS SPECIFIC PROJECT AND SHALL NOT BE USED OTHERWISE WITHOUT THE EXPRESSED CONSENT OF THE ARCHITECT.



### FLOOR FRAMING NOTES:

- TOP OF STEEL ELEVATION = 22'-1 3/4" U.O.N.
  - TOP OF CONCRETE ELEVATION = 22'-0" U.O.N.
  - WHERE SPACING OF BEAMS NOT INDICATED, PROVIDE EQUAL SPACINGS WITHIN EACH BAY.
  - WHERE 8" STEEL FLOOR DECK WITH CONCRETE FILL IS INDICATED, STEEL DECK SHALL BE 20 GA. VERGO PLUS FORMLOCK VENTED AND GALVANIZED (APMO UES ER-2217) OR APPROVED EQUAL, U.O.N., MAX. SPAN = 11'-6" (MIN. 2 SPAN) OR 10'-6" (SINGLE SPAN).
  - WHERE 1 1/2" STEEL FLOOR DECK WITH CONCRETE FILL IS INDICATED, STEEL DECK SHALL BE 18 GA. VERGO PLUS FORMLOCK VENTED AND GALVANIZED (APMO UES ER-2217) OR APPROVED EQUAL, U.O.N., MAX. SPAN = 9'-6" (MIN. 2 SPAN) OR 8'-6" (SINGLE SPAN).
  - THE CONCRETE FLOOR THICKNESS SHALL BE PLACED AND MONITORED PER 4 XS-014
  - FOR SIZE AND LOCATIONS OF CURBS AND SLAB OPENINGS, REFER TO ARCH. DWGS.
  - WHERE FLOOR FINISHES HAVE MORE STRINGENT REQUIREMENTS FOR LEVELNESS, FLATNESS OR MOISTURE BARRIER MAY BE APPLIED. THE DESIGN OF THE FLOOR ACCOUNTS FOR AN AVERAGE THICKNESS OF 3/8" AND A MAXIMUM OF 3/4" OF LEVELING AGENT.
  - SEE GENERAL NOTES AND TYP. DETAILS FOR INFO NOT REFERENCED. TYPICAL DETAILS SHALL BE FOLLOWED WHERE APPLICABLE WHETHER OR NOT THEY ARE REFERENCED ON PLAN.
  - SEE ARCHITECTURAL DRAWINGS FOR:  
A) SLAB EDGE DIMENSION  
B) OPENING SIZES AND LOCATIONS  
C) SLOPES AND DEPRESSION SIZES AND LOCATIONS  
D) SLAB ELEVATIONS  
E) CURB LOCATIONS
- COLUMNS ARE CENTERED ON GRID LINES UNLESS DIMENSIONED OTHERWISE.

- ANCHORAGE OF NON-STRUCTURAL COMPONENTS SHALL BE BOLTED, WELDED OR OTHERWISE POSITIVELY FASTENED WITHOUT THE CONSIDERATION OF THE FRICTIONAL RESISTANCE PRODUCED BY THE EFFECT OF GRAVITY.

### FLOOR FRAMING LEGEND:

- H MOMENT FRAME CONNECTION PER FRAME ELEVATIONS.
- W18X50 [30] BEAM SIZE AND STUD COUNT, U.O.N., STUDS ARE TO BE DISTRIBUTED UNIFORMLY OVER ENTIRE LENGTH OF BEAM. IF DECK CELL LAYOUT IS SUCH THAT UNIFORM DISTRIBUTION IS NOT POSSIBLE, PLACE EXTRA CONNECTORS TOWARD EACH END OF BEAM STUD LENGTH PER 5 XS-014
- (±1") UPWARD CAMBER AT MIDSPAN
- (-6") TOP OF STEEL (RELATIVE TO TYPICAL STEEL ELEVATION)
- BA BRACE ANGLE PER 3 XS-013
- BOTT. FLANGE CONNECTION
- MOMENT JOINT BRACE ANGLE PER 3 XS-013  
SPACING PER 24 XS-202
- FULL HEIGHT STIFFENER PLATE PER 2 XS-013
- USE OF A325SC (SLIP CRITICAL) BOLTS AT BEAM CONNECTION, PER 1 XS-202
- INDICATES SLAB DEPRESSION PER 13 XS-55  
COORDINATE WITH ARCH. DWGS.
- INDICATES STEP IN CONCRETE/STEEL DECK PER 10 XS-55
- WELDED DRAG CONNECTION PER 2 XS-202



CP-2  
VOLUME 1

PROJECT NO. 16148

REV NO.	DATE ISSUED	REASON
04.25.17	DESIGN DEVELOPMENT	
07.10.17	STRUCT. STEEL BID SET	
08.08.17	CITY SUBMITTAL SET	
2.1	08.29.17	ADDENDUM #2.1
2.3	11.20.17	ASI 2.1/IFC

CITY SUBMITTAL SET  
08.08.17

Sheet Title  
**OVERALL  
SECOND LEVEL  
FRAMING PLAN**

Sheet No.  
**2S-121**

## 1 OVERALL SECOND LEVEL FRAMING PLAN

1/16" = 1'-0"

0 6' 16' 32'  
SCALE: 1/16" = 1'





ALL DISCREPANCIES AND ARRANGEMENTS INDICATED ON THESE DRAWINGS ARE THE PROPERTY OF THE ARCHITECT AND ARE TO BE USED IN CONNECTION WITH THIS SPECIFIC PROJECT AND SHALL NOT BE USED OTHERWISE WITHOUT THE EXPRESSED CONSENT OF THE ARCHITECT. THESE DRAWINGS OR ACCOMPANYING SPECIFICATION WITHOUT THE EXPRESSED CONSENT OF THE ARCHITECT.

O. STRUCTURAL STEEL:

- STRUCTURAL STEEL WORK SHALL BE PERFORMED IN ACCORDANCE WITH CHAPTER 22 OF THE BUILDING CODE, AISI 360 "SPECIFICATION FOR STRUCTURAL STEEL BUILDINGS" AND AISI 309 "CODE OF STANDARD PRACTICE FOR STEEL BUILDINGS AND BRIDGES".
- SPECIAL INSPECTION AND TESTING IS REQUIRED IN ACCORDANCE WITH SECTIONS 1704 AND 1705 OF THE BUILDING CODE AND THE "STATEMENT OF SPECIAL INSPECTIONS" ON THESE CONSTRUCTION DOCUMENTS.
- FOR SPECIAL MOMENT FRAME STEEL REQUIREMENTS, SEE SHEET 25-202.
- STRUCTURAL STEEL STRENGTHS AND GRADES SHALL BE AS FOLLOWS, U.O.N.

DESCRIPTION	YIELD Fy,ksi	ASTM GRADE
W8 AND W10 SHAPES	50 ksi	A992, GR 50
OTHER ROLLED SHAPES	50 ksi	A36
RECTANGULAR HSS SECTIONS	46 ksi	A500, GR B/C
ROUND HSS SECTIONS	42 ksi	A500, GR B
STRUCTURAL PIPE SECTIONS	35 ksi	A53, GR B
PLATES IN FRAMES	50 ksi	A572, GR 50
BASE PLATES IN FRAMES GREATER THAN 4 INCHES	42 ksi	A572, GR 42
OTHER PLATES	36 ksi	A36
- HOLLOW STRUCTURAL STEEL (HSS) MEMBERS SHALL BE SEAL WELDED IN DRY CONDITION IN THE SHOP. PROVIDE WELD HOLES AT THE LOW END OF ALL HOLLOW MEMBERS IN EXTERIOR CONDITIONS, AND SEAL WELD AROUND ALL MATING SURFACES IN EXTERIOR CONDITIONS WHETHER COVERED OR OPEN. CONCEAL WELD SEAM FROM VIEW WHERE PRACTICAL.
- ANCHOR RODS SHALL CONFORM TO ASTM F 1954, GRADE 36, UNLESS OTHERWISE NOTED. NUTS FOR ANCHOR RODS SHALL CONFORM TO ASTM A 563, GRADE A HEX (HEAVY) HEX WHERE ANCHOR ROD DIAMETER IS GREATER THAN 1 1/2".
- MAIN MEMBERS SHALL HAVE HIGH STRENGTH BOLTS CONFORMING TO AISI SPECS FOR ASTM A 325N BOLTS, U.O.N. OTHER BOLTS SHALL CONFORM TO ASTM A 307. NUTS FOR HIGH STRENGTH BOLTS SHALL BE HEAVY HEX GRADE C CONFORMING TO ASTM A 563.
- TIGHTEN ASTM A 325N BOLTS TO "SNUG-TIGHT" CONDITION PER AISI SPECIFICATION FOR STRUCTURAL JOINTS. TEST ASTM A 325N BOLTS WITH A CALIBRATED WRENCH UNLESS LOAD INDICATOR BOLTS ARE USED.
- EXTERIOR STRUCTURAL STEEL PERMANENTLY EXPOSED TO THE WEATHER SHALL BE HOT-DIP GALVANIZED AFTER FABRICATION IN ACCORDANCE WITH ASTM A 123, 660 U.O.N. GALVANIZED SURFACES DAMAGED BY SUBSEQUENT WELDING AND OTHER WORK SHALL BE REPAIRED IN ACCORDANCE WITH ASTM A 780.
- FIRE PROTECTION FOR STRUCTURAL STEEL SHALL BE AS REQUIRED BY CHAPTER 6 OF THE BUILDING CODE. SPRAY-APPLIED FIRE PROTECTION ON STRUCTURAL STEEL SHALL BE MONOKOTE MK6/HY AS MANUFACTURED BY GCP APPLIED TECHNOLOGIES, INC. (UL HEB 4394-02).
- STEEL, INDICATED AS "AESS" SHALL MEET THE REQUIREMENTS FOR ARCHITECTURALLY EXPOSED STRUCTURAL STEEL IN THE AISI CODE OF STANDARD PRACTICE.

P. STEEL STAIRS:

- STEEL COMPONENTS SHALL COMPLY WITH THE APPLICABLE NOTES UNDER "STRUCTURAL STEEL."
- WELDING SHALL COMPLY WITH THE APPLICABLE NOTES UNDER "WELDING."
- POST-INSTALLED ANCHORS SHALL COMPLY WITH THE APPLICABLE NOTES UNDER "POST-INSTALLED MECHANICAL ANCHORS" OR "POST-INSTALLED ADHESIVE ANCHORS."
- SPECIAL INSPECTION AND TESTING IS REQUIRED IN ACCORDANCE WITH SECTIONS 1704 AND 1705 OF THE BUILDING CODE AND THE "STATEMENT OF SPECIAL INSPECTIONS" ON THESE CONSTRUCTION DOCUMENTS.
- MEMBER SIZES INDICATED ARE THE MINIMUM SIZES THAT SHALL BE USED FOR CONSTRUCTION. MEMBER SIZES USED SHALL BE OF THE SAME NOMINAL SHAPE AND DIMENSION INDICATED.
- VERTICAL AND HORIZONTAL DIMENSIONS SHALL BE VERIFIED WITH THE ARCHITECTURAL DRAWINGS AND EXISTING CONDITIONS PRIOR TO FABRICATION. THE ARCHITECT SHALL BE NOTIFIED OF ANY FIELD CONDITIONS NOT COVERED BY THE CONTRACT DOCUMENTS PRIOR TO FABRICATION.
- CONNECTIONS TO THE STRUCTURE SHALL INCLUDE STABILIZING ELEMENTS SUCH AS BRACES, STIFFENER PLATES, ETC., SO AS TO NOT IMPOSE ECCENTRIC LOADINGS, TWISTING, OR WARPING TO STRUCTURAL MEMBERS. PROVIDE MATERIAL AND INSTALL STABILIZING ELEMENTS. NECESSARY STABILIZING ELEMENTS SHALL BE INSTALLED AT NO ADDITIONAL COST TO THE OWNER.

Q. STEEL STAIRS, (DEFERRED APPROVAL):

- STEEL STAIRS SHALL BE DEFERRED APPROVAL EXCEPT WHERE SPECIFICALLY DETAILED ON THE STRUCTURAL DRAWINGS. DEFERRED APPROVAL STEEL STAIRS SHALL COMPLY WITH ANY DETAILS PROVIDED. NOTES BELOW APPLY TO DEFERRED APPROVAL STEEL STAIRS ONLY.
- DESIGN OF STAIRS, INCLUDING FRAMING MEMBERS, CONNECTIONS (INCLUDING THOSE TO BUILDING STRUCTURE), CHECKERED PLATES, STEPS, HANDRAILS, ETC., SHALL PROVIDE FOR LATERAL RESTRAINT AND COMPLY WITH THE CONTRACT DOCUMENTS AND THE BUILDING CODE.
- CALCULATIONS SHALL CLEARLY IDENTIFY LOADS IMPOSED ON THE BUILDING STRUCTURE.
- STEEL COMPONENTS SHALL COMPLY WITH THE APPLICABLE NOTES UNDER "STRUCTURAL STEEL."
- WELDING SHALL COMPLY WITH THE APPLICABLE NOTES UNDER "WELDING."
- POST-INSTALLED ANCHORS SHALL COMPLY WITH THE APPLICABLE NOTES UNDER "POST-INSTALLED MECHANICAL ANCHORS" OR "POST-INSTALLED ADHESIVE ANCHORS."
- SPECIAL INSPECTION AND TESTING IS REQUIRED IN ACCORDANCE WITH SECTIONS 1704 AND 1705 OF THE BUILDING CODE AND THE "STATEMENT OF SPECIAL INSPECTIONS" ON THESE CONSTRUCTION DOCUMENTS.
- VERTICAL AND HORIZONTAL DIMENSIONS SHALL BE VERIFIED WITH THE ARCHITECTURAL DRAWINGS AND EXISTING CONDITIONS PRIOR TO FABRICATION. THE ARCHITECT SHALL BE NOTIFIED OF ANY FIELD CONDITIONS NOT COVERED BY THE CONTRACT DOCUMENTS PRIOR TO FABRICATION.
- CONNECTIONS TO THE STRUCTURE SHALL INCLUDE STABILIZING ELEMENTS SUCH AS BRACES, STIFFENER PLATES, ETC., SO AS TO NOT IMPOSE ECCENTRIC LOADINGS, TWISTING, OR WARPING TO STRUCTURAL MEMBERS. PROVIDE MATERIAL AND INSTALL STABILIZING ELEMENTS. NECESSARY STABILIZING ELEMENTS SHALL BE INSTALLED AT NO ADDITIONAL COST TO THE OWNER.

- CONCRETE FOR ELEVATED SLABS EXPOSED TO DIRECT RAINFALL SHALL CONTAIN FIBROUS FIBRILLATED POLYPROPYLENE REINFORCEMENT. FIBROUS FIBRILLATED POLYPROPYLENE CONCRETE REINFORCEMENT SHALL BE MANUFACTURED BY KIRK GRACE OR FIBERWEBS COMPANY. ALTERNATE PRODUCTS SHALL BE APPROVED BY THE ENGINEER IN WRITING PRIOR TO SUBMISSION OF THE MIX DESIGN. THE VOLUME PER CUBIC YARD SHALL BE A MINIMUM OF 0.1% (1.5 POUNDS). FIBERS SHALL BE DISPERSED UNIFORMLY THROUGHOUT THE CONCRETE IN ACCORDANCE WITH ASTM C1116.

L. CONCRETE SLAB-ON-GRADE:

- CONSTRUCTION OR CONTROL JOINTS IN SLAB-ON-GRADE SHALL BE PROVIDED AS INDICATED. THE LOCATIONS OF JOINTS NOT SPECIFICALLY INDICATED SHALL BE REVIEWED BY THE ENGINEER AND APPROVED BY THE ARCHITECT. JOINTS SHALL ALIGN WITH RE-ENTRANT CORNERS OF THE SLAB.
- THE CONCRETE SLAB-ON-GRADE THICKNESS SHOWN IS THE MINIMUM REQUIRED THICKNESS. FLOORS SHALL BE MONITORED BY TRANSIT LEVEL OR LASER DURING PLACEMENT TO MAINTAIN LEVEL FLOOR.

M. CONCRETE FILL OVER COLD-FORMED STEEL DECK:

- CONDUIT, PIPES OR DUCTS SHALL NOT BE PLACED IN CONCRETE TOPPING FILL UNLESS SPECIFICALLY INDICATED ON THE STRUCTURAL DRAWINGS OR APPROVED IN WRITING BY THE ENGINEER.
- THE CONCRETE TOPPING FILL THICKNESS SHOWN IS THE MINIMUM REQUIRED THICKNESS. FLOORS SHALL BE MONITORED BY TRANSIT LEVEL OR LASER DURING PLACEMENT TO MAINTAIN LEVEL FLOOR.
- THE CONCRETE TOPPING SURFACE SHALL BE FINISHED SUCH THAT A GAP AT ANY POINT BETWEEN THE SURFACE AND AN UNLEVELLED, FREESTANDING 10-FOOT LONG STRAIGHT EDGE DOES NOT EXCEED 1/8 INCH WHEN THE STRAIGHT EDGE IS RESTING ON TWO HIGH POINTS.

- IN FLOOR AREAS WHERE OCCUPANT PERCEPTION OR THE APPLICATION OF FINISHES DICTATES MORE STRINGENT PROFILES, A FLOOR-LEVELING AGENT MAY BE APPLIED (AVERAGE ALLOWABLE THICKNESS = 1/8 INCH; MAXIMUM ALLOWABLE LOCAL THICKNESS = 1/8 INCHES).

N. REINFORCED CONCRETE MASONRY (CMU):

- MASONRY CONSTRUCTION SHALL CONFORM TO CHAPTER 21 OF THE BUILDING CODE AND ACI 530.1.
- SPECIAL INSPECTION AND TESTING IS REQUIRED IN ACCORDANCE WITH SECTIONS 1704 AND 1705 OF THE BUILDING CODE AND THE "STATEMENT OF SPECIAL INSPECTIONS" ON THESE CONSTRUCTION DOCUMENTS.
- CONCRETE MASONRY CONSTRUCTION SHALL HAVE A MINIMUM 28 DAY COMPRESSIVE STRENGTH OF F'm 2,000 PSI, U.O.N.
- CONCRETE MASONRY UNITS SHALL CONFORM TO ASTM C 90, MEDIUM WEIGHT, SINGLE OPEN-END UNITS, U.O.N.
- MORTAR SHALL CONFORM TO ASTM C 270, TYPE "S".
- GROUT SHALL CONFORM TO ASTM C 476. GROUT MIXES SHALL BE DESIGNED BY A QUALIFIED TESTING LABORATORY AND APPROVED BY THE ENGINEER.
- AD MIXTURES IN GROUT SHALL BE APPROVED IN ADVANCE. AD MIXTURES CONTAINING CHLORIDE OR CHLORIDE SALTS SHALL NOT BE USED EXCEPT WHERE APPROVED IN WRITING BY THE ENGINEER.
- STRENGTH VERIFICATION OF MASONRY SHALL BE BY THE UNIT STRENGTH METHOD IN ACCORDANCE WITH ACI 530.1, SECTION 1.4B.2.b. WHERE THE UNIT STRENGTH METHOD IS USED, MASONRY COMPONENTS SHALL HAVE THE FOLLOWING STRENGTHS:

	F'm = 2,000 psi	F'm = 3,000 psi
MINIMUM COMPRESSIVE STRENGTH	2,000 psi	4,500 psi
MASONRY UNITS	2,000 psi	3,000 psi
GROUT		
- ALTERNATIVELY, STRENGTH VERIFICATION OF MASONRY PRIOR TO AND DURING CONSTRUCTION MAY BE BY THE PRISM TEST METHOD IN ACCORDANCE WITH ACI 530.1, SECTION 1.4B.3. WHERE THE PRISM TEST METHOD IS USED, MASONRY COMPONENTS SHALL BE OF SUFFICIENT STRENGTH SUCH THAT THE COMPLETED MASONRY WORK MEETS THE SPECIFIED MINIMUM COMPRESSIVE STRENGTH.
- VERTICAL BARS IN WALLS SHALL BE PLACED IN THE CENTER OF THE WALL UNLESS OTHERWISE INDICATED. VERTICAL BARS SHALL BE TIED OR OTHERWISE FIXED IN POSITION AT THE TOP AND BOTTOM AND AT INTERVALS OF NOT MORE THAN 200 BAR DIAMETERS.
- HORIZONTAL BARS SHALL BE PLACED IN BOND BEAM UNITS.

- CONDUITS OR PIPES SHALL NOT OCCUR IN SAME CELL AS REINFORCING BARS.
- MASONRY UNITS SHALL BE PLACED IN A RUNNING BOND PATTERN, U.O.N.
- CONSTRUCTION OR CONTROL JOINTS IN CONCRETE MASONRY SHALL BE PROVIDED AS INDICATED. THE LOCATIONS OF JOINTS NOT SPECIFICALLY INDICATED SHALL BE REVIEWED BY THE ENGINEER AND APPROVED BY THE ARCHITECT.
- MASONRY CELLS SHALL BE SOLID GROUTED, U.O.N.

- A GROUT POUR SHALL BE THE TOTAL HEIGHT OF MASONRY THAT IS GROUTED PRIOR TO THE ERECTION OF ADDITIONAL MASONRY. A GROUT POUR SHALL NOT EXCEED THE HEIGHT LIMITS GIVEN IN ACI 530.1, TABLE 1 AND MAY CONSIST OF ONE OR MORE GROUT LIFTS.
- A GROUT LIFT SHALL BE THE HEIGHT OF GROUT THAT IS PLACED IN A SINGLE, CONTINUOUS OPERATION BEFORE CONSOLIDATION OF GROUT. GROUT LIFTS SHALL NOT EXCEED 5'-4" IN HEIGHT UNLESS THE FOLLOWING CONDITIONS ARE MET:
  - MASONRY IS ALLOWED TO CURE FOR A MINIMUM OF 4 HOURS PRIOR TO GROUTING.
  - GROUT SLUMP IS MAINTAINED BETWEEN 10 AND 11 INCHES AS VERIFIED BY TESTING.
  - LIFTS ARE LIMITED TO A HEIGHT BETWEEN HORIZONTAL BOND BEAMS, OR A MAXIMUM OF 12'-6".
- GROUT SHALL BE CONSOLIDATED BY MECHANICAL VIBRATION, WHERE LIFTS EXCEED 12 INCHES. GROUT SHALL BE RE-CONSOLIDATED BY MECHANICAL VIBRATION AFTER INITIAL WATER LOSS AND SETTLEMENT.
- INSPECTION AND CLEAN OUT HOLES SHALL BE PROVIDED AT THE BASE OF GROUTED CELLS WHERE A GROUT POUR EXCEEDS 5'-4" IN HEIGHT. HOLED SPACING SHALL NOT EXCEED 32 INCHES ON CENTER.
- WHEN GROUTING IS STOPPED FOR ONE HOUR OR LONGER, HORIZONTAL CONSTRUCTION JOINTS SHALL BE FORMED BY STOPPING THE GROUT POUR 1'-1/2" BELOW TOP OF THE UPPERMOST UNIT.

- #3 SPACER TIES SHALL BE INSTALLED AT 30" ON CENTER IN BEAMS AND FOOTINGS TO SECURE REINFORCING BARS IN PLACE, U.O.N.
- REINFORCEMENT SUPPORTS SHALL BE MANUFACTURED OF NONCORROSIVE MATERIAL.

J. REINFORCED CONCRETE - GENERAL:

- CONCRETE CONSTRUCTION SHALL CONFORM WITH CHAPTER 19 OF THE BUILDING CODE AND TO THE PROVISIONS OF ACI 318.
- SPECIAL INSPECTION AND TESTING IS REQUIRED IN ACCORDANCE WITH SECTIONS 1704 AND 1705 OF THE BUILDING CODE AND THE "STATEMENT OF SPECIAL INSPECTIONS" ON THESE CONSTRUCTION DOCUMENTS.
- WATER MAY BE ADDED TO CONCRETE ON-SITE TO OBTAIN SPECIFIED SLUMPS PROVIDED THAT IT IS ADDED WITHIN ONE HOUR OF BATCHING AND SITE-ADDED WATER IS SPECIFIED ON THE BATCH REPORT. SITE-ADDED WATER SHALL NOT COMPROMISE THE STRENGTH OR SLUMP OF THE CONCRETE.
- CONCRETE SHALL NOT BE PLACED BEYOND 1-1/2 HOURS FOLLOWING BATCHING.
- PROJECTING CORNERS OF SLABS, BEAMS, WALLS, COLUMNS, ETC., SHALL BE FORMED WITH A 3/4" CHAMFER U.O.N.
- CONSTRUCTION JOINTS IN STRUCTURAL MEMBERS THAT ARE NOT INDICATED ON THE STRUCTURAL DRAWINGS SHALL BE APPROVED BY THE ENGINEER PRIOR TO CONSTRUCTION. LONGITUDINAL REINFORCEMENT SHALL CONTINUE UNINTERRUPTED THROUGH CONSTRUCTION JOINTS. KEYWAYS SHALL BE PROVIDED PERPENDICULAR TO THE DIRECTION OF LOAD IN CONSTRUCTION JOINTS.
- WHERE CONCRETE IS PLACED AGAINST EXISTING CONCRETE SURFACES, THE EXISTING CONCRETE SURFACES SHALL BE THOROUGHLY CLEANED AND ROUGHENED TO A MINIMUM AMPLITUDE OF 1/4-INCH. A CONCRETE BONDING AGENT SHALL BE APPLIED TO THE EXISTING CONCRETE SURFACE.
- CONDUIT, PIPES OR DUCTS SHALL NOT BE PLACED IN CONCRETE COLUMNS, WALLS OR SLABS UNLESS SPECIFICALLY INDICATED ON THE STRUCTURAL DRAWINGS OR APPROVED IN WRITING BY THE ENGINEER. SLEEVES FOR OPENINGS IN CONCRETE SHALL BE INSTALLED BEFORE PLACING REINFORCING (WHICH MAY CONFLICT SHALL NOT BE CUT UNLESS APPROVED IN WRITING BY THE ENGINEER).
- FORMWORK FOR COLUMNS SHALL NOT BE REMOVED UNTIL THE COLUMN CONCRETE HAS REACHED A MINIMUM STRENGTH OF 1500 PSI.
- FORMWORK FOR SLABS SHALL NOT BE REMOVED UNTIL SLAB CONCRETE HAS REACHED A MINIMUM OF 75% OF THE SPECIFIED STRENGTH. SLABS SHALL BE RESHORED IMMEDIATELY AFTER FORMWORK REMOVAL UNTIL CONCRETE HAS REACHED DESIGN STRENGTH AND RE-SHORE ARE NO LONGER REQUIRED TO CARRY CONSTRUCTION LOADS ABOVE. THE SHORING REMOVAL AND RESHORING PROCEDURE SHALL BE DESIGNED IN ACCORDANCE WITH THE RECOMMENDATIONS OF ACI 347.2R. ALTERNATE DESIGN PROCEDURES SHALL DEMONSTRATE A MINIMUM HISTORY OF 10 YEARS OF SUCCESSFUL USE AND SHALL BE APPROVED FOR USE BY THE ENGINEER IN WRITING PRIOR TO SUBMITTAL.
- CONCRETE COLUMNS SHALL ACHIEVE A MINIMUM OF 75 PERCENT OF THE DESIGN STRENGTH INDICATED PRIOR TO POURING ELEVATED CONCRETE SLABS.
- CONCRETE SHALL BE MAINTAINED IN A MOIST CONDITION FOR A MINIMUM OF 7 DAYS AFTER ITS PLACEMENT. APPROVED CURING COMPOUNDS MAY BE USED IN LIEU OF MOIST CURING.

K. CONCRETE MIX REQUIREMENTS: RFI 2-00065 Concrete Mix Design for Walls

- READY MIX CONCRETE SHALL BE MIXED AND DELIVERED IN ACCORDANCE WITH ASTM C 94.
- CEMENT SHALL CONFORM TO ASTM C 150 TYPE I OR II, LOW ALKALI.
- FLYASH SHALL CONFORM TO ASTM C 618, CLASS F. FLYASH SHALL BE LIMITED TO NO MORE THAN THE FOLLOWING PERCENTAGES OF THE TOTAL WEIGHT OF CEMENTITIOUS MATERIALS IN THE CONCRETE, U.O.N.

	SUSPENDED SLABS, BEAMS AND GIRDER COLUMNS AND WALLS	FOUNDATIONS	SLABS ON GRADE
	15%	20%	20%
- CEMENT FOR SHRINKAGE-COMPENSATING CONCRETE SHALL CONFORM TO ASTM C 845. ALTERNATIVELY, WHEN APPROVED IN WRITING BY THE ENGINEER, SHRINKAGE COMPENSATING CONCRETE MAY BE ACHIEVED BY USE OF A SHRINKAGE-REDUCING CHEMICAL AD MIXTURE.
- AGGREGATES FOR NORMAL WEIGHT CONCRETE SHALL CONFORM TO ASTM C 33.
- NORMAL WEIGHT CONCRETE SHALL HAVE A MAXIMUM DRY DENSITY OF 150 pcf.
- AGGREGATE FOR LIGHTWEIGHT CONCRETE SHALL BE EXPANDED SHALE TYPE AND CONFORM TO ASTM C 330.
- LIGHT-WEIGHT CONCRETE SHALL HAVE A MAXIMUM DRY DENSITY OF 115 pcf.
- CONCRETE MIXES SHALL BE DESIGNED BY A QUALIFIED TESTING LABORATORY AND APPROVED BY THE ENGINEER. MIX DESIGN IN ACCORDANCE WITH ACI 301, ARTICLE 4.2.3 SHALL BE USED TO PROPORTION CONCRETE.
- MINIMUM CONCRETE COMPRESSIVE STRENGTHS AT 28 DAYS, MAXIMUM SLUMPS, AND MAXIMUM WATER/CEMENT RATIOS SHALL BE AS FOLLOWS:

DESCRIPTION	MIN 28 DAY F'c	SLUMP	MAX W/C RATIO
SHALLOW FOUNDATIONS, CAST-IN-PLACE DEEP FOUNDATIONS	4.0 KSI	4" +/- 1"	0.52
SLAB ON GRADE	3.5 KSI	4" +/- 1"	0.45
LONG COLUMNS	5.0 KSI	4" +/- 1"	0.45
ELEVATED SLABS	5.0 KSI	4" +/- 1"	0.45
LIGHT WEIGHT FILL ON COLD-FORMED STEEL DECK	4.0 KSI	4" +/- 1"	0.48
NORMAL WEIGHT FILL ON COLD-FORMED STEEL DECK	4.0 KSI	4" +/- 1"	0.48
OTHER CONCRETE	3.5 KSI	4" +/- 1"	0.50
- AD MIXTURES SHALL BE APPROVED IN ADVANCE. AD MIXTURES CONTAINING CHLORIDE OR CHLORIDE SALTS SHALL NOT BE USED EXCEPT WHERE APPROVED IN WRITING BY THE ENGINEER.
- SLUMPS INDICATED ARE PRIOR TO PLASTICIZER ADDITIVES.
- DRYING SHRINKAGE OF CONCRETE IN ELEVATED SLABS, AND COLUMNS SHALL BE LIMITED TO 0.05 PERCENT AS VERIFIED BY TEST IN ACCORDANCE WITH ASTM C 157. THE PROCEDURES OF ASTM C 157 SHALL BE MODIFIED AS FOLLOWS (BASED ON SEAC SUPPLEMENTARY RECOMMENDATIONS):
  - THE CURING PERIOD SHALL BE 7 DAYS.
  - FOLLOWING CURING, SPECIMENS SHALL BE AIR-STORED.
  - COMPARATIVE MEASUREMENTS OF SPECIMENS SHALL BE MADE AFTER 4, 7, 14, 21 AND 28 DAYS OF AIR-STORED.
- CONCRETE EXPOSED TO WEATHER SHALL BE AIR ENTRAINED.

G. FOUNDATION:

- THE RECOMMENDATIONS PROVIDED IN THE GEOTECHNICAL INVESTIGATION REPORT SHALL BE FOLLOWED:
  - CONCRETE MIX DESIGNS.
  - REINFORCING STEEL DRAWINGS.
  - CONTROL JOINT/CONSTRUCTION JOINT LOCATIONS.
  - PENETRATIONS THROUGH STRUCTURAL MEMBERS, INCLUDING SIZES AND LOCATIONS OF SLEEVES, FOR THE FIRE SUPPRESSION SYSTEM (AND OTHER UTILITY SYSTEMS).
  - MASONRY GROUT MIX DESIGNS.
  - MASONRY UNIT CERTIFICATES.
  - STRUCTURAL STEEL DRAWINGS.
  - STEEL STAIRS DRAWINGS.
- DEVIATIONS IN GEOTECHNICAL CONDITIONS FROM THOSE DESCRIBED IN THE GEOTECHNICAL REPORT SHALL BE REPORTED TO THE STRUCTURAL AND GEOTECHNICAL ENGINEERS IN A TIMELY MANNER.
- SPECIAL INSPECTION AND TESTING IS REQUIRED IN ACCORDANCE WITH SECTIONS 1704 AND 1705 OF THE BUILDING CODE AND THE "STATEMENT OF SPECIAL INSPECTIONS" ON THESE CONSTRUCTION DOCUMENTS.
- RAMMED AGGREGATE PIER SYSTEM IS TO BE INSTALLED AT THE BUILDING FOUNDATIONS WHERE REQUIRED IN ACCORDANCE TO THE GEOTECHNICAL RECOMMENDATIONS.
- THE MAXIMUM ALLOWABLE SOIL BEARING PRESSURE SHALL BE 7000 psf ON FORMATIONAL MATERIAL OR WHERE RAMMED AGGREGATE PIER SYSTEM HAS BEEN INSTALLED. AT OTHER LOCATIONS, THE MAXIMUM SOIL BEARING PRESSURE SHALL BE 3,000 psf. THE RESULTING ALLOWABLE BEARING VALUE MAY BE INCREASED BY 1/3 FOR WIND AND SEISMIC LOAD CASES.
- THE EXPANSION INDEX HAS BEEN DETERMINED TO BE 50 OR LESS AND NO SPECIAL DESIGN RECOMMENDATIONS ARE REQUIRED.
- FOOTINGS AND UTILITY TRENCH BACKFILL SHALL BE MECHANICALLY COMPACTED IN LAYERS SUBJECT TO THE APPROVAL OF THE GEOTECHNICAL ENGINEER. FLOODING WILL NOT BE PERMITTED.
- LOOSE SOIL AND FILL MATERIAL SHALL BE COMPACTED ACCORDING TO THE REQUIREMENTS OF THE SOILS REPORT.
- COMPACTION TEST REPORTS FOR FILL BY A QUALIFIED TESTING LAB SHALL BE SUBMITTED TO THE STRUCTURAL ENGINEER, GEOTECHNICAL ENGINEER AND BUILDING OFFICIAL PRIOR TO REQUESTING FOUNDATION INSPECTION.
- FOOTING DEPTHS INDICATED ON THE STRUCTURAL DRAWINGS ARE BELIEVED TO BE IN SUITABLE BEARING MATERIALS AND ARE INDICATED FOR COST ESTIMATING PURPOSES ONLY. THE GEOTECHNICAL ENGINEER MAY REQUIRE FOUNDATION DEPTHS TO BE INCREASED. THE RESPONSIBILITY FOR CONFORMING TO THE GEOTECHNICAL REPORT RECOMMENDATIONS REGARDING DEPTH OF FOOTINGS SHALL BEAR ON THE CONTRACTOR.
- FOOTING ELEVATIONS SHALL BE LOCATED SUCH THAT THEIR BEARING IS A MINIMUM HORIZONTAL DISTANCE OF 12 FEET FROM THE DAYLIGHT OF AN ADJACENT SLOPE OR AS RECOMMENDED WITHIN THE GEOTECHNICAL REPORT.
- ANCHOR BOLTS, DOVELS AND HOLD-DOWN ANCHORS SHALL BE TIED IN PLACE PRIOR TO FOUNDATION INSPECTION.
- WALLS RETAINING EARTH SHALL BE DRAINED AND BACKFILLED ACCORDING TO THE RECOMMENDATIONS WITHIN THE GEOTECHNICAL REPORT.
- BACKFILLING BEHIND RETAINING WALLS SHALL NOT BEGIN UNTIL WALLS HAVE BEEN CURED FOR A MINIMUM OF 14 DAYS.
- SLABS ON GRADE THAT RESTRAIN THE BOTTOM OF RETAINING WALLS SHALL BE IN PLACE PRIOR TO BACKFILLING OF THE WALLS.

H. WELDING:

- WELDING OF STRUCTURAL STEEL SHALL BE PERFORMED BY CERTIFIED WELDERS IN ACCORDANCE WITH THE PROVISIONS OF THE AMERICAN WELDING SOCIETY (AWS) D1.1. ELECTRODE FILLER MATERIAL SHALL BE A MINIMUM OF E70XX U.O.N.
- WELDING OF COLD-FORMED STEEL DECK AND COLD-FORMED FRAMING SHALL BE PERFORMED BY WELDERS CERTIFIED FOR SHEET STEEL IN ACCORDANCE WITH THE PROVISIONS OF THE AMERICAN WELDING SOCIETY (AWS) D1.3. E60XX ELECTRODES SHALL BE USED FOR WELDING OF COLD-FORMED STEEL DECK AND COLD-FORMED FRAMING.
- SPECIAL INSPECTION AND TESTING IS REQUIRED IN ACCORDANCE WITH SECTIONS 1704 AND 1705 OF THE BUILDING CODE AND THE "STATEMENT OF SPECIAL INSPECTIONS" ON THESE CONSTRUCTION DOCUMENTS.
- WELDING ELECTRODES FOR THE SHIELDED METAL-ARC WELDING (SMAW) PROCESS AND WELDING ELECTRODES SHALL CONFORM TO AWS A5.1 "SPECIFICATION FOR CARBON STEEL ELECTRODES FOR SHIELDED METAL ARC WELDING."
- WELDING ELECTRODES FOR THE FLUX CORED ARC WELDING (FCAW) PROCESS AND WELDING ELECTRODES SHALL CONFORM TO AWS A5.20 "SPECIFICATION FOR CARBON STEEL ELECTRODES FOR FLUX CORED ARC WELDING."
- WELDS SHALL HAVE A WELD CONTROLLED SEQUENCE AND TECHNIQUE IN ORDER TO MINIMIZE SHRINKAGE STRESSES AND DISTORTION.
- FOR SPECIAL STEEL MOMENT RESISTING FRAME WELDING REQUIREMENTS, SEE SHEET 25-202.

I. REINFORCING STEEL:

- DETAILING, FABRICATION AND ERECTION OF REINFORCING BARS SHALL BE PERFORMED IN ACCORDANCE WITH ACI 318, "DETAILS AND DETAILING OF CONCRETE REINFORCEMENT."
- SPECIAL INSPECTION AND TESTING IS REQUIRED IN ACCORDANCE WITH SECTIONS 1704 AND 1705 OF THE BUILDING CODE AND THE "STATEMENT OF SPECIAL INSPECTIONS" ON THESE CONSTRUCTION DOCUMENTS.
- REINFORCING BARS SHALL CONFORM TO ASTM A 615, GRADE 60, U.O.N.
- WELDED WIRE FABRIC SHALL CONFORM TO ASTM A 185. MINIMUM LAP OF WWP SHALL BE ONE FULL MESE + 2".
- REINFORCING BAR LAP SPLICES SHALL BE CLASS B (18" MIN.) FOR CONCRETE, U.O.N. 65 BAR DIA. (24" MIN.) FOR MASONRY, U.O.N.
- DETAILS OF REINFORCEMENT SHALL COMPLY WITH ACI 318, CHAPTER 7.
- WHERE HOOKS ARE ILLUSTRATED AS 90-DEGREE HOOKS, 180-DEGREE HOOKS MAY BE USED IN LIEU OF 90-DEGREE HOOKS.
- REINFORCING BARS FOR CONCRETE SHALL BE PROVIDED WITH THE FOLLOWING MINIMUM COVER:

FORMED CONC. EXPOSED TO EARTH/WEATHER	3"
95 OR SMALLER	1-1/2"
10 OR LARGER	3/4"
SLABS (11" AND SMALLER)	1-1/2"
COLUMN TIES	3/4"
- VERTICAL WALL BARS SHALL BE ACCURATELY POSITIONED AT THE CENTER OF THE WALL, U.O.N., AND SHALL BE TIED IN PLACE AT THE TOP AND BOTTOM.
- WHERE CONVENTIONAL STIRRUPS, TIES, HOOPS OR CROSS-TIES ARE ILLUSTRATED, MACHINE-PRESS-EMBED, RESISTANCE-WELDED TRANSVERSE REINFORCEMENT MAY BE SUBSTITUTED, PROVIDED THAT:
  - THE RESULTING CONFIGURATION PROVIDES FOR PROPER CONSOLIDATION OF CONCRETE.
  - ASTM A 706 REINFORCING IS USED FOR TRANSVERSE REINFORCING, AND
  - 1/4 INCH ASSEMBLY WIRES ARE USED, CONFORMING TO ASTM A96.

D. SUBMITTALS:

- THE CONTRACTOR SHALL MAKE SUBMITTALS PRIOR TO FABRICATION AS REQUIRED BY THE WRITTEN SPECIFICATIONS AND SHALL INCLUDE AS A MINIMUM THE FOLLOWING SUBMITTALS:
  - CONCRETE MIX DESIGNS.
  - REINFORCING STEEL DRAWINGS.
  - CONTROL JOINT/CONSTRUCTION JOINT LOCATIONS.
  - PENETRATIONS THROUGH STRUCTURAL MEMBERS, INCLUDING SIZES AND LOCATIONS OF SLEEVES, FOR THE FIRE SUPPRESSION SYSTEM (AND OTHER UTILITY SYSTEMS).
  - MASONRY GROUT MIX DESIGNS.
  - MASONRY UNIT CERTIFICATES.
  - STRUCTURAL STEEL DRAWINGS.
  - STEEL STAIRS DRAWINGS.
- DEFERRED APPROVAL STEEL STAIRS DRAWINGS AND CALCULATIONS (SIGNED BY A CALIFORNIA-REGISTERED CIVIL ENGINEER).
- COLD-FORMED STEEL DECK DRAWINGS.
- DEFERRED APPROVAL COLD-FORMED STEEL FRAMING DRAWINGS AND CALCULATIONS (SIGNED BY A CALIFORNIA-REGISTERED CIVIL ENGINEER).
- GLAZED CURTAIN WALL DRAWINGS AND CALCULATIONS (SIGNED BY A CALIFORNIA-REGISTERED CIVIL ENGINEER).
- MANUFACTURER'S CERTIFICATES OF COMPLIANCE FOR DESIGNATED SEISMIC EQUIPMENT SYSTEMS IN ACCORDANCE WITH SECTION 1705.5 OF THE BUILDING CODE, PRIOR TO INSTALLATION.
- THE FOLLOWING SUBMITTALS ARE NOT REQUIRED FOR STRUCTURAL REVIEW:
  - SHORING AND BRACING.
  - PICK-UP INSERTS.
  - WIND-ORILLIONS.
  - UNSPECIFIED REBAR AT SLAB-ON-GRADE AND FOOTINGS.
  - FORMWORK.
  - STRUCTURAL STEEL MILL REPORTS.
  - WELDER CERTIFICATION.
  - WVF FOR CONCRETE OVER STEEL DECK.
- STEEL REINFORCING LISTS AND QUANTITIES AND LENGTHS OF ALL MATERIALS SHALL BE THE RESPONSIBILITY OF THE CONTRACTOR TO ASSURE COMPLIANCE WITH THE PLANS. ENGINEER WILL NOT REVIEW.
- SUBMITTALS MADE TO THE ENGINEER FOR REVIEW SHALL BE STAMPED AND SIGNED BY THE CONTRACTOR INDICATING THE CONTRACTORS PRIOR REVIEW AND THAT THE SUBMITTAL IS IN ACCORDANCE WITH THE CONTRACT DOCUMENTS.
- SUBMITTALS SHALL BE MADE IN ELECTRONIC (PDF) FORMAT. SUBMITTALS WILL BE PROCESSED AND RETURNED ELECTRONICALLY.

E. GENERAL:

- SPECIFIC NOTES AND DETAILS ON THE STRUCTURAL DRAWINGS SHALL TAKE PRECEDENCE OVER GENERAL NOTES AND TYPICAL DETAILS.
- THE REQUIREMENTS ON THE STRUCTURAL DRAWINGS SHALL TAKE PRECEDENCE OVER THE STRUCTURAL BUILDING INFORMATION MODEL. THE STRUCTURAL BUILDING INFORMATION MODEL SHALL NOT BE RELIED ON FOR UNDERSTANDING CONSTRUCTION REQUIREMENTS.
- WHERE NO DETAILS ARE SHOWN, OR NOTED IN ANY PART OF THE WORK THE DETAILS FOR OTHER SIMILAR WORK SHALL APPLY.
- DETAILS IDENTIFIED AS TYPICAL, SHALL APPLY IN ESTIMATING AND CONSTRUCTION TO EVERY LIKE CONDITION WHETHER OR NOT THE REFERENCE IS REPEATED.
- THE STRUCTURAL DRAWINGS AND STRUCTURAL BUILDING INFORMATION MODEL SHALL NOT BE SCALED. COORDINATE DIMENSION, ELEVATION, SLOPE AND DRAINAGE REQUIREMENTS WITH THE ARCHITECTURAL DRAWINGS.
- STANDARDS REFERENCED ON THE STRUCTURAL DRAWINGS REFER TO THE EDITION APPLICABLE UNDER THE APPLICABLE BUILDING CODE.
- THE RESPONSIBILITY FOR THE REVIEW AND COORDINATION OF DRAWINGS AND SPECIFICATIONS PRIOR TO THE START OF RELATED CONSTRUCTION SHALL BEAR ON THE CONTRACTOR. DISCREPANCIES THAT EXIST SHALL BE BROUGHT TO THE ATTENTION OF THE ENGINEER IN A TIMELY MANNER, PRIOR TO START OF RELATED CONSTRUCTION.
- WORK PERFORMED IN CONFLICT WITH THE STRUCTURAL DRAWINGS OR APPLICABLE BUILDING CODE REQUIREMENTS SHALL BE CORRECTED AT THE EXPENSE OF THE CONTRACTOR.
- EXISTING CONDITIONS SHALL BE VERIFIED BEFORE STARTING RELATED WORK. EXISTING CONDITIONS THAT ARE NOT REFLECTED ON THE STRUCTURAL DRAWINGS OR THAT DEVIATE FROM THE MAXIMUM OR MINIMUM DIMENSIONS INDICATED SHALL BE BROUGHT TO THE ATTENTION OF THE ENGINEER IN A TIMELY MANNER. SUCH CONDITIONS MAY INCLUDE CONFLICT IN GRADES, ADVERSE SOIL CONDITIONS, PRESENCE OF GROUND WATER, UNCOVERED OR UNEXPECTED EXISTING CONSTRUCTION CONFIGURATIONS, ETC.
- MATERIALS AND WORKMANSHIP SHALL CONFORM TO REQUIREMENTS OF APPLICABLE REGULATIONS AND THE BUILDING CODE AS AMENDED AND ADOPTED BY THE BUILDING OFFICIAL.
- LOADS TO THE BUILDING EXCEEDING THE LOADS INDICATED ON THE PLANS, OR ANY LOADS EXCEEDING 400 POUNDS THAT ARE NOT INDICATED ON THE STRUCTURAL DRAWINGS SHALL BE REPORTED TO THE ENGINEER.

F. TEMPORARY WORK AND SITE SAFETY:

- THE STRUCTURAL DRAWINGS SHOW THE REQUIREMENTS FOR THE COMPLETED STRUCTURE ONLY. TEMPORARY WORKS REQUIRED TO COMPLETE THE CONSTRUCTION PROCESS SHALL BE THE RESPONSIBILITY OF THE CONTRACTOR. THE STRUCTURAL ENGINEER SHALL NOT BE RESPONSIBLE FOR THE DESIGN OR FIELD VERIFICATION OF TEMPORARY AND ANGLIARY WORK.
- THE RESPONSIBILITY FOR SAFETY IN AND AROUND THE JOBSITE SHALL BEAR ON THE CONTRACTOR. PROPER AND SAFE METHODS OF CONSTRUCTION SHALL BE EMPLOYED AT ALL TIMES INCLUDING THE STABILIZING OF INCOMPLETE STRUCTURES, FORMWORK, SHORING, RESHORING, FALSEWORK, PLATFORMS, SCAFFOLDING, BARRIERS, WALKWAYS, ETC. AND INCLUDING CONTROL OF THE INTENSITY, DURATION AND LOCATION OF CONSTRUCTION LOADS.
- THE RESPONSIBILITY FOR THE DESIGN AND INSTALLATION OF SHORING, SHIELDING, UNDERPINNING, AND SHORING REQUIRED TO SAFELY RETAIN ALL GRADES AND STRUCTURES SHALL BEAR ON THE CONTRACTOR.
- CONSTRUCTION MATERIALS SHALL BE SPREAD OUT IF PLACED ON A STRUCTURE. LOADS SHALL NOT EXCEED THE DESIGN LIVE LOAD INDICATED. WHERE THE STRUCTURE HAS NOT ATTAINED FINAL DESIGN STRENGTH, ADEQUATE SHORING AND OR BRACING SHALL BE INSTALLED.

A. BASIS OF DESIGN:

- THE STRUCTURAL DESIGN HAS BEEN PERFORMED IN ACCORDANCE WITH THE 2016 CALIFORNIA BUILDING CODE (CBC).
- LIVE LOADS (MAY BE REDUCED IN ACCORDANCE WITH THE BUILDING CODE)

ROOF		20 psf
FLOOR		125 psf
EXITS AND STAIRS		100 psf
ASSEMBLY AREAS		100 psf
MEZZANINE		250 psf
WALKABLE CEILING		20 psf
- SEISMIC DESIGN DATA

RISK CATEGORY	II
SEISMIC IMPORTANCE FACTOR	I <sub>s</sub> = 1.0
MAPPED SPECTRAL ACCELERATION	S <sub>s</sub> = 0.488
MAPPED SPECTRAL ACCELERATION	S <sub>1</sub> = 0.380
SITE CLASS	C
SITE COEFFICIENT	F <sub>a</sub> = 1.005
SITE COEFFICIENT	F <sub>v</sub> = 1.420
DESIGN SPECTRAL ACCELERATION	S <sub>DS</sub> = 0.662
DESIGN SPECTRAL ACCELERATION	S <sub>1S</sub> = 0.380
SEISMIC DESIGN CATEGORY	D
PARTITION LOADING AT FLOORS	10 psf
PARTITION LOADING AT ROOFS	5 psf
MODAL RESPONSE SPECTRUM (SEE NOTE 4)	
- FOR LONGITUDINAL & TRANSVERSE DIRECTION

SEISMIC FORCE RESISTING SYSTEM	STEEL SPECIAL MOMENT FRAMES
RESPONSE MODIFICATION FACTOR	R = 8
SYSTEM OVERSTRENGTH FACTOR	Ω = 3
DEFLECTION AMPLIFICATION FACTOR	C <sub>d</sub> = 5.5
REUNDANCY FACTOR	ρ = 1.3
SEISMIC RESPONSE COEFFICIENT	C <sub>s</sub> = 0.08
DESIGN BASE SHEAR	V = 540 kips
- THE MODAL RESPONSE SPECTRUM ANALYSIS IS BASED ON THE DESIGN RESPONSE SPECTRUM IN ASCE 7, FIGURE 11.4-1.
- WIND DESIGN DATA

RISK CATEGORY	II
BASIC WIND SPEED	V = 110 mph
EXPOSURE CATEGORY	C
NORTH QUADRANT	C
EAST QUADRANT	C
SOUTH QUADRANT	C
WEST QUADRANT	C
ENCLOSURE CATEGORY	ENCLOSED
GUST INTERNAL PRESSURE COEFF	GCF <sub>i</sub> = 0.18
DIRECTIONALITY FACTOR	K <sub>d</sub> = 0.85
TOPOGRAPHIC FACTOR	K <sub>z</sub> = 1.00
TOPOGRAPHIC FACTOR	K <sub>1</sub> = 0.00
TOPOGRAPHIC FACTOR	K <sub>2</sub> = 0.00
TOPOGRAPHIC FACTOR	K <sub>3</sub> = 0.00

B. DEFERRED APPROVALS:

- THE FOLLOWING COMPONENTS REQUIRE DEFERRED APPROVAL BY THE BUILDING OFFICIAL. STRUCTURAL CALCULATIONS AND DRAWINGS SIGNED AND SEALED BY A CALIFORNIA REGISTERED CIVIL ENGINEER SHALL BE SUBMITTED BY THE CONTRACTOR TO THE ENGINEER FOR REVIEW AND TO THE BUILDING OFFICIAL FOR PERMIT.
  - AS INDICATED ON SHEET 25-001
- IN ADDITION TO THE SEAL OF THE RESPONSIBLE ENGINEER, DEFERRED SUBMITTAL PACKAGES SHALL BEAR THE SHOP DRAWING APPROVAL STAMPS OF THE ARCHITECT, ENGINEER AND THE GENERAL CONTRACTOR PRIOR TO BUILDING DEPARTMENT SUBMITTAL.
- PLANS FOR DEFERRED SUBMITTAL ITEMS SHALL BE SUBMITTED IN A TIMELY MANNER THAT ALLOWS A MINIMUM OF 30 WORKING DAYS FOR INITIAL PLAN REVIEW BY THE BUILDING OFFICIAL. ALL COMMENTS RELATED TO THE DEFERRED SUBMITTAL MUST BE ADDRESSED TO THE SATISFACTION OF THE PLAN CHECK DIVISION PRIOR TO PERMIT APPROVAL OF THE SUBMITTAL ITEMS.
- DEFERRED SUBMITTAL ITEMS SHALL NOT BE FABRICATED PRIOR TO APPROVAL BY THE BUILDING OFFICIAL OF THE CALCULATIONS AND DRAWINGS.

C. PRE-ENGINEERED ELEMENTS TO BE ANCHORED TO THE BUILDING:

- PRE-ENGINEERED STRUCTURAL AND NONSTRUCTURAL ELEMENTS AND THEIR ATTACHMENTS SUPPORTED BY THE BUILDINGS WHICH ARE NOT DETAILED ON THESE DRAWINGS SHALL BE DESIGNED BY OTHER RESPONSIBLE PARTIES.
- SPECIAL INSPECTION AND TESTING IS REQUIRED IN ACCORDANCE WITH SECTIONS 1704 AND 1705 OF THE BUILDING CODE AND THE "STATEMENT OF SPECIAL INSPECTIONS" ON THESE CONSTRUCTION DOCUMENTS.
- DESIGN CALCULATIONS AND DRAWINGS, SIGNED AND SEALED BY A CALIFORNIA REGISTERED CIVIL ENGINEER, SHALL BE SUBMITTED TO THE ENGINEER FOR REVIEW AND TO THE BUILDING OFFICIAL FOR PERMIT, PRIOR TO FABRICATION AND INSTALLATION. CALCULATIONS SHALL CLEARLY IDENTIFY LOADS IMPOSED ON THE BUILDING STRUCTURE.
- SUCH ELEMENTS AND THEIR ATTACHMENTS SHALL BE DESIGNED IN ACCORDANCE WITH ASCE 7, CHAPTER 13, SECTIONS OF THE AISI



