



SSH JV

# Milpitas Station Design Unit 023 Readiness for Construction Structural

SVBX C700

Wednesday, July 10, 2013

HALF SIZE  
COPY



**TYLIN** INTERNATIONAL  
engineers | planners | scientists



NOTES FOR STATION BUILDING

1. GENERAL
- A. ALL MATERIALS AND WORKMANSHIP SHALL CONFORM TO THE CALIFORNIA BUILDING CODE (CBC) 2010 AND TO BART FACILITIES STANDARDS (BFS) DESIGN CRITERIA AND SPECIFICATION, WHICHEVER IS MORE STRINGENT.

B. INTENT: IF CERTAIN FEATURES ARE NOT FULLY SHOWN OR CALLED FOR ON THE DRAWINGS OR SPECIFICATIONS, THEIR CONSTRUCTION SHALL BE OF SAME CHARACTER AS FOR SIMILAR CONDITIONS THAT ARE SHOWN OR CALLED FOR.

C. NO BACKFILL AT/OR BELOW GRADE WALLS UNTIL TOP AND BOTTOM SLABS AS REQUIRED HAVE BEEN POURED AND ACHIEVED THEIR DESIGN STRENGTH. OTHERWISE, WALLS SHALL BE SECURELY BRACED TO CARRY CONSTRUCTION LOADS. RETAIN LICENSED PROFESSIONAL ENGINEER FOR THE DESIGN OF SUCH REQUIRED BRACING.

D. DO NOT USE SCALED DIMENSIONS. USE WRITTEN DIMENSIONS OR WHERE NO DIMENSION IS PROVIDED, CONSULT WITH THE CONSTRUCTION MANAGER FOR CLARIFICATION BEFORE PROCEEDING WITH THE WORK.

E. SITE VISITS BY THE STRUCTURAL ENGINEER, SHALL NOT BE CONSTRUED AS SPECIAL INSPECTIONS, AS DEFINED BY THE 2010 CBC.

F. COORDINATE ALL INFORMATION RELATED TO EDGE OF SLAB, CURBS AND DEPRESSIONS WITH ARCHITECTURAL AND CIVIL DRAWINGS. SEE DRAWINGS OTHER THAN STRUCTURAL FOR KINDS OF FLOOR FINISH AND THEIR LOCATION, FOR DEPRESSIONS IN FLOOR SLABS, FOR OPENINGS IN WALLS AND FLOORS REQUIRED BY ARCHITECTURAL AND MECHANICAL, CIVIL FEATURES, WALKS, RAMPS, STAIRS, CURBS, ETC. TYPICAL EDGE OF STRUCTURE SLAB IS SHOWN STRUCTURAL DRAWINGS. COORDINATE LOCATIONS, DIMENSIONS AND ON THE ELEVATIONS WITH EXTERIOR SKIN DETAILS. FOR DETAILS, LOCATIONS AND QUANTITIES OF MISC. INSERTS AND OTHER EMBEDDED ITEMS CAST IN THE WALLS AND SLABS REFER TO ARCHITECTURAL, MECHANICAL, PLUMBING & ELECTRICAL DRAWINGS.

G. COORDINATE ALL ELEVATOR, STAIR OPENINGS WITH ARCHITECTURAL DRAWINGS. COORDINATE ALL ELEVATOR DETAILS WITH REQUIREMENTS OF ELEVATOR SUPPLIER'S DRAWINGS. PROVIDE ALL SEPARATOR BEAMS, MACHINE ROOM BEAMS, MACHINE ROOM EQUIPMENT SUPPORT BEAMS, EMBEDDED ITEMS SHOWN ON THESE PLANS AND LOCATE IN COORDINATION WITH ELEVATOR SUPPLIER'S DRAWINGS.

H. IN CASE OF CONFLICT AMONG STRUCTURAL DRAWINGS OR BETWEEN STRUCTURAL DRAWINGS AND SPECIFICATIONS, THE MOST STRINGENT REQUIREMENT GOVERNS.
2. BASIS OF DESIGN
- A. BART FACILITIES STANDARDS, RELEASE 2.1

B. BART FACILITIES DESIGN CRITERIA, RELEASE 2.1

C. BART STANDARD PLANS, RELEASE 2.1

D. BART FACILITIES SPECIFICATIONS, RELEASE 2.1

E. CALTRANS BRIDGE DESIGN SPECIFICATION MANUAL, APRIL 2000 (WITH UPDATES THROUGH MAY 2004)

F. CALIFORNIA BUILDING CODE, 2010 AND ASCE 7-05

G. AMERICAN CONCRETE INSTITUTE, BUILDING CODE AND COMMENTARY, 318-08

H. AMERICAN INSTITUTE OF STEEL CONSTRUCTION, MANUAL OF STEEL CONSTRUCTION, 13th EDITION.

I. AMERICAN WELDING SOCIETY: ANSI/AWS D1.1:2010 AND D1.3:2008

J. AMERICAN CONCRETE INSTITUTE, CODE REQUIREMENTS FOR ENVIRONMENT ENGINEERING CONCRETE STRUCTURE (ACI 350-06)
3. EXISTING CONDITIONS

FIELD VERIFY EXISTING CONDITIONS PERTINENT TO THE WORK PRIOR TO MATERIAL FABRICATION AND/OR CONSTRUCTION. FIELD CONDITIONS DIFFERENT FROM THOSE NOTED ON THE CONSTRUCTION DRAWINGS SHALL BE PROMPTLY BROUGHT TO THE ATTENTION OF THE VTA. ITEMS TO BE FIELD VERIFIED INCLUDE BUT ARE NOT LIMITED TO:

- A. LOCATION, DIMENSIONS, AND ELEVATIONS OF EXISTING STRUCTURES, STRUCTURAL ELEMENTS, EQUIPMENT AND UTILITIES, WHICH HAVE BEEN SHOWN AS REFERENCE ON THE DRAWINGS AND MAY AFFECT NEW CONSTRUCTION.
- B. HORIZONTAL AND VERTICAL CLEARANCES.
- C. HORIZONTAL AND VERTICAL TIE-IN POINTS.

4. DESIGN LOADS
- A. LIVE LOAD- CONCOURSE (NO REDUCTION ALLOWED)

1. 100 PSF STATION CONCOURSE PUBLIC AREAS [CASH CARTS]-350 POUNDS PER WHEEL

2. 150 PSF TRAIN CONTROL/COMM ROOM & STAIRS

3. 350 PSF TRANSFORMER ROOM AND EMERGENCY GENERATOR ROOM

4. 150 PSF ELECTRICAL EQUIPMENT, TRASH, HVAC, TC/C BATTERY, TELCOMM, BATTERY & VALVE ROOMS

5. 150 PSF SMOKE CONTROL FAN ROOM

6. 100 PSF STORAGE (LIGHT)

7. MAINTENANCE VEHICLE LOADING: TWO 1500 LBS LOADS 3 FEET APART

B. LIVE LOAD- MILPITAS BLVD. EXTENSION BRIDGE

1. ASHTO HS 20-44

C. LIVE LOAD-PLATFORM (NO REDUCTION ALLOWED)

1. 100 PSF STATION PLATFORM PUBLIC AREAS, STAIRS AND STORAGE ROOMS.

2. 150 PSF ESCALATOR CONTROL ROOM.

3. 350 PSF ELECTRICAL, MECHANICAL AND ELEVATOR MACHINE ROOMS.

4. MAINTENANCE VEHICLE LOADING: TWO 1500 LBS LOADS 3 FEET APART

D. LIVE LOAD- ROOF (REDUCIBLE PER PROVISIONS OF CBC)

1. 20 PSF STATION ROOF AND ENTRANCE ROOF

2. 1000 LBS LOAD ANYWHERE ON ROOF MEMBER

E. LATERAL LOAD-SEISMIC PER CBC 2010/ASCE 7-05: SITE LOCATION IS AT LATITUDE = 37.4° N, LONGITUDE = 121.9° W. SITE CLASS IS D.

$V = C_s \cdot W$

SEISMIC DESIGN CATEGORY D

STEEL SPECIAL CONCENTRICALLY BRACED FRAME

$C_s=0.25$

$S_s=1.5$

$S_1=0.60$

$S_d=1.00$

$S_d1=0.60$

$R=6.0$

$I=1.50$

$V = C_s \cdot W$

SEISMIC DESIGN CATEGORY D

STEEL SPECIAL MOMENT FRAMES

$C_s=0.25$

$S_s=1.50$

$S_1=0.60$

$S_d=1.00$

$S_d1=0.60$

$R=8$

$I=1.50$
- F. LATERAL LOAD-WIND PER CBC 2010/ASCE 7-05
- $P = qGC_p - q_i(GC_{pi})$

BASIC WIND SPEED 85 MPH

EXPOSURE C  $I_w = 1.15$
- G. ACCELERATED RESPONSE SPECTRUM CURVE 2005 MODIFIED WAS USED IN PERFORMING DYNAMIC ANALYSIS FOR THE SUPERSTRUCTURE. MODAL RESPONSE SPECTRUM ANALYSIS PER ASCE 7-05, SECTION 12.9

FOUNDATIONS

1. REFER TO GEOTECHNICAL INVESTIGATION REPORT PREPARED BY PARIKH CONSULTANTS, INC. DATED MARCH 25, 2013 FOR DESIGN SOIL PROPERTIES, DESIGN RECOMMENDATIONS, FIELD DATA, SITE PREPARATION, AND LABORATORY TESTS OF THE SOILS. GEOTECHNICAL CONSULTANT SHALL OBSERVE ALL SITE WORK & FOUNDATION PHASES OF CONSTRUCTION FOR CONFORMANCE TO CONDITIONS & RECOMMENDATIONS CONTAINED WITHIN THE SOIL REPORT.
2. SOIL BEARING CAPACITIES
- DEAD AND LIVE LOADS 1750 PSF FOR SPREAD FOOTING PSF FOR MAT FOUNDATION

TOTAL LOADS INCLUDING WIND OR SEISMIC LOADS 2333 PSF FOR SPREAD FOOTING PSF FOR MAT FOUNDATION

COEFFICIENT OF FRICTION 0.35 BETWEEN FIRM SOIL AND CONCRETE FOOTINGS

3. LATERAL EARTH PRESSURES

RETAINING WALL CONDITION	PRESSURE ABOVE GROUNDWATER PCF	PRESSURE BELOW GROUNDWATER PCF
EQUIVALENT FLUID PRESSURE FOR UNRESTRAINED RETAINING WALLS	46	23
EQUIVALENT FLUID PRESSURE FOR RESTRAINED RETAINING WALLS	89	46

4. SHORE ALL EXCAVATIONS AS REQUIRED TO PREVENT SUBSIDENCE OR DAMAGE TO ADJACENT EXISTING STRUCTURES, STREETS, UTILITIES, ETC. RETAIN PROFESSIONAL ENGINEERING CONSULTANTS FOR THE DESIGN OF ALL SHORING.
5. UTILITY OR PLUMBING LINES SHALL NOT BE PLACED THROUGH OR BELOW MAT SLAB OR FOOTING FOUNDATIONS WITHOUT THE EOR'S APPROVAL.
6. DYNAMIC SOIL STRUCTURE INTERACTION ANALYSIS, "RACKING ANALYSIS" WAS PERFORMED BASED ON REPORT BY M2 CONSULTANTS, INC. DATED 4.30.2013 PREPARED FOR PARIKH CONSULTANTS, INC.

CONCRETE

1. PER 2010 CBC, CHAPTER 19, GENERAL, SECTION 1901.2 GENERAL REQUIREMENTS, ALL CONCRETE STRUCTURES SHALL BE DESIGNED AND CONSTRUCTED IN ACCORDANCE WITH THE REQUIREMENTS PER CHAPTER 19 AND THE ADDITIONAL REQUIREMENTS IN ACI 318 AS AMENDED IN SECTION 1908. ACI 350-06 REQUIREMENTS SHALL BE APPLICABLE TO RETAINING WALLS & MAT FOUNDATION.
2. ALL CAST-IN-PLACE CONCRETE SHALL HAVE A MINIMUM 28-DAY COMPRESSIVE STRENGTH  $f'_c$  AS FOLLOW U.N.O.:
- MAT FOUNDATION, WALLS 4,500 PSI

- SLABS, BEAMS 4,000 PSI

- COLUMNS 5,000 PSI
- REFER TO SPECIFICATION SECTION 03 30 00. THE CONCRETE MIX SHALL BE PROPORTIONED AND DOCUMENTED IN ACCORDANCE WITH SPECIFIED REQUIREMENTS.
3. CEMENT SHALL BE PORTLAND CEMENT, ASTM C150 AND SHALL BE COMPOSED OF APPROVED MIX DESIGN WITH TYPE II/V CEMENT & A WATER/CEMENT RATIO < 0.40
4. REINFORCING STEEL SHALL BE DEFORMED BARS CONFORMING TO ASTM A706, GRADE 60. WELDED WIRE FABRIC SHALL CONFORM TO ASTM A185. SUBMIT A REPORT OF MATERIAL PROPERTIES NECESSARY TO CONFORM TO SPECIFICATION REQUIREMENTS.
5. ALL REINFORCING LAP SPLICES SHALL CONFORM TO ACI CLASS B SPLICES. REFER TO 1/DB-S773 FOR LAPS SPLICE LENGTHS. STAGGER ALL LAP SPLICES IN ADJACENT BARS MINIMUM OF 24" OR ONE LAP LENGTH.
6. ALL MECHANICAL SPLICE COUPLER SHALL BE PER SPECIFICATION 03 20 00
7. TYPICAL CONCRETE FINISHES: SEE SPECIFICATION SECTION 03 35 00 AND ARCHITECTURAL DRAWINGS.
8. MINIMUM CONCRETE COVER OVER REINFORCEMENT STEEL SHALL BE PER ACI 318-08 EXCEPT FOR THE MAT FOUNDATION & RETAINING WALLS CONCRETE COVER SHALL BE PER ACI 350-06.
9. ADMIXTURES TO BE USED IN CONCRETE SHALL BE PER SPECIFICATION SECTION 03 05 15
10. CONCRETE SHALL BE PROPORTIONED TO PROVIDE REQUIRED AVERAGE COMPRESSIVE STRENGTH  $f'_c$  AS PRESCRIBED IN NOTE 2 ABOVE. CONCRETE SHALL BE PER SPECIFICATION SECTION 03 05 15
11. BACKFILL SLURRY PER SPEC SECTION 31 23 25
12. CONCRETE DENSITY SHALL BE A MINIMUM OF 150 PCF EXCEPT FOR THE MAT FOUNDATION (INVERT SLAB), RETAINING WALL, PLATFORM FRAMING, CONCOURSE FRAMING, CONCRETE STAIRS NUMBERS 1 & 2, CONCRETE COLUMNS BELOW CONCOURSE LEVEL
13. REFER TO MASS CONCRETE REQUIREMENTS IN SPECIFICATION 03 05 15.

CONCRETE FORMWORK

1. CONCRETE FORMWORK SHALL COMPLY WITH SPECIFICATIONS 03 11 14 "CONCRETE FORMWORK"

STRUCTURAL STEEL

1. PER 2010 CBC, STRUCTURAL STEEL SHALL BE IN ACCORDANCE WITH THE REQUIREMENTS OF SECTION 2205.1 AND 2205.2
2. ALL BEAMS (W SHAPES) SHALL BE ASTM A992 GRADE 50.
3. ALL COLUMNS (W SHAPES) SHALL BE ASTM A992 GRADE 50, UNLESS OTHERWISE NOTED.
4. STRUCTURAL STEEL OTHER THAN BEAMS AND COLUMNS SHALL CONFORM TO ASTM A572, GRADE 50 UNLESS NOTED OTHERWISE. RECTANGULAR HOLLOW STRUCTURAL SECTIONS (HSS) SHALL CONFORM TO ASTM A500 GRADE B,  $F_y=46$  KSI. ROUND HSS SHALL CONFORM TO ASTM A500, GRADE B,  $F_y=42$  KSI. ALL PIPE SECTIONS SHALL CONFORM TO ASTM A53, GRADE B,  $F_y=35$  KSI. SCHEDULE 40 DESIGNATES STANDARD PIPE, SCHEDULE 80 DESIGNATES EXTRA STRONG PIPE.
5. ALL CONNECTING AND HORIZONTAL STIFFENER PLATES AT BEAM-TO-COLUMN CONNECTIONS, GUSSET AND STIFFENER PLATES ON GRADE 50 BEAMS AND COLUMN BASE PLATES SHALL BE ASTM A572 GRADE 50.
6. ALL STRUCTURAL STEEL SHALL BE FABRICATED AND ERECTED IN CONFORMANCE WITH THE AISC MANUAL OF STEEL CONSTRUCTION ALLOWABLE STRESS DESIGN 13TH EDITION.
7. UNLESS NOTED OTHERWISE, ALL BOLTS SHALL BE 7/8" DIAMETER HIGH STRENGTH BOLTS. ALL A325 BOLTS SHALL BE TYPE 3. THE BOLT TIGHTENING FOR ALL A325 BOLTS IN ALL BEAM TO COLUMN AND BEAM TO BEAM CONNECTIONS SHALL PROVIDE BOLT TENSIONING AS PRETENSIONED JOINT. ALL BOLTS IN MOMENT AND BRACE CONNECTIONS SHALL HAVE MINIMUM CLASS A FAYING SURFACE. ASTM A325 TYPE 3 BOLTS MAY BE REPLACED WITH ASTM F1852 TYPE 3 BOLTS.MACHINE BOLTS (MB) SHALL CONFORM TO ASTM A307.
8. ALL WELDS SHALL CONFORM TO SPECIFICATION SECTION 05 05 22.
9. FOR SURFACE PREPARATION OF SLIP CRITICAL BOLTED CONNECTION (FAYING SURFACE CLASS A OR BETTER) AND STEEL MEMBERS ENCASED IN CONCRETE, SEE SPEC SECTION 05 12 00 ARTICLE 2.04
10. ALL ANCHOR BOLTS (AB) SHALL CONFORM TO ASTM F1554 GRADE 36 U.N.O., SEE PLANS & DETAILS. NUTS AND WASHERS SHALL BE PER ASTM A563 GRADE A AND F436 TYPE 1, RESPECTIVELY.
11. STRUCTURAL STEEL SHOP DRAWINGS SHALL BE SUBMITTED TO THE ENGINEER OF RECORD FOR REVIEW PRIOR TO FABRICATION.
12. SHOP DRAWINGS ARE AN AID FOR FIELD PLACEMENT AND ARE SUPERSEDED BY THE APPROVED STRUCTURAL DRAWINGS, IT SHALL BE CERTAIN THAT ALL CONSTRUCTION IS IN FULL AGREEMENT WITH THE LATEST APPROVED STRUCTURAL DRAWINGS.
13. ALL BEAMS SHALL BE MANUFACTURED WITHIN THE CAMBER, SWEEP, DEPTH, AND WIDTH TOLERANCE PERMITTED BY A.I.S.C. SPECIFICATION FOR STANDARD MILL TOLERANCE.
14. DRILLING (CUTTING. PUNCHING, ETC.) OF HOLES IN BEAM FLANGES IS NOT PERMITTED FOR ANY PURPOSE. SUPPORT METHOD FOR SUSPENDED EQUIPMENT (INCLUDING MECHANICAL EQUIPMENT, ETC.) SHALL BE APPROVED BY THE STRUCTURAL ENGINEER.
15. PENETRATION THROUGH WEBS OF COLUMNS, BEAMS, OR BRACES OF BRACED FRAMES IS NOT PERMITTED, WITHOUT WRITTEN PERMIT APPROVAL BY STRUCTURAL EOR.

STEEL DECKING

1. METAL DECK SHALL BE PER SPECIFICATION SECTION 05 30 00
2. ROOF DECKING MARK D1 SHALL BE CONSOLIDATED SYSTEMS, INC OR APPROVED EQUAL,  $F_y=40$  KSI PROPERTIES OF METAL DECK SHALL BE AS GIVEN IN ICC REPORT NRO ESR-2657 DATED MARCH 1, 2013.
3. ROOF DECKING MARK D2 & FLOOR DECKING MARK D3 SHALL BE VERCO OR APPROVED EQUAL & SHALL BE GALVANIZED,  $F_y=38$  KSI, DECK SHALL BE AS GIVEN IN ICC REPORT NRO ESR-1735P DATED MARCH 1, 2011.
4. ALL SHORING OF METAL DECK SHALL BE PER MANUFACTURER'S REQUIREMENT.
5. STEEL DECK SUPPORT SHALL BE AS FOLLOWS: SEE SCHEDULE A/DB-S781
6. THE STEEL DECK SHALL BE CONTINUOUS FOR 3 SPANS MINIMUM, WHENEVER POSSIBLE.
7. SEE SPECIFICATION SECTION 05 30 00 FOR COATING OF METAL DECK.
8. DECKS SHALL HAVE A MINIMUM BEARING OF 2" AT ALL SUPPORTS.
9. ALL SCREWS ATTACHING ELEMENTS TO ROOF METAL DECK, SHALL BE LOCATED IN THE UPPER PROFILE OF THE METAL DECK, IN ORDER TO MINIMIZE THE VISUAL IMPACT OF SCREWS.

04-02 Jul 05, 2013 - 1:47pm P:\BART Berryessa Extension Line\5 - STRUCTURAL MILPITAS WORK\6-10-2012\0700-S-DB-S001X.dwg

					DESIGNED BY J. REBER, S.E.
					DRAWN BY P. DIAZ
					CHECKED BY M. TARAZI
					IN CHARGE M. TARAZI
					DATE 20130710
REV	DATE	BY	SUB	APP	DESCRIPTION
0	20130710				READINESS FOR CONSTRUCTION
0	20130531				READINESS FOR CONSTRUCTION
					REPLACED C700-S-DB-S001 REV P.



Skanska  
Shimmick  
Herzog

1436 California Circle  
Milpitas, California 95035  
A Joint Venture

MFT CONSULTING ENGINEERS, Inc. Anil Verma Associates, Inc.  
1773 San Pablo Ave., Suite A3 (510) 222-4100  
Pinole, CA 94664 Fax (510) 223-8410

Submitted

Leonwood, Andrews  
& Newman, Inc.  
A LEAD & BALLY COMPANY

T-Y-LIN INTERNATIONAL

Approved

BART  
SILICON VALLEY

BART SILICON VALLEY BERRYESSA EXTENSION

LINE, TRACK, STATIONS AND SYSTEMS  
DESIGN UNIT 023  
MILPITAS STATION  
STRUCTURAL GENERAL NOTES

SHEET 1 OF 3

CADD FILENAME C700-S-DB-S001X.dwg	
SIZE SCALE D NONE	
CONTRACT NO. C700	REV. 0
AREA CODE DB	SHEET NO. S001X
	PAGE NO. 0134



MASONRY

1. MASONRY UNITS TO CONFORM TO ASTM C90 GRADE N, TYPE I, LIGHT WEIGHT UNITS. DESIGN COMPRESSIVE STRENGTH OF MASONRY f'm=1500 PSI, TYP.
2. MORTAR TO CONFORM TO ASTM C270, TYPE S AND 2010 CBC REQUIREMENTS WITH MINIMUM COMPRESSIVE STRENGTH OF 1800 PSI. DO NOT USE PLASTIC CEMENT AND DO NOT USE MASONRY CEMENT IN THE MORTAR MIXTURE.
3. GROUT TO CONFORM TO ASTM C476 AND 2010 CBC REQUIREMENTS WITH A MINIMUM COMPRESSIVE STRENGTH EQUAL TO OR GREATER THAN THE CONCRETE MASONRY UNIT STRENGTH, BUT NOT LESS THAN 2500 PSI.
4. ALL MASONRY UNITS TO BE GROUTED SOLID.
5. REFER TO SPECIFICATION 04 22 00 FOR OTHER REQUIREMENTS.

SPECIAL INSPECTIONS: (SEE ALSO DB-S003X)

1. GENERAL: IN ADDITION TO THE INSPECTIONS REQUIRED BY SECTION 108.4.4, OF THE 2010 CBC TITLE 24, PART 2, VOLUME 1 OF 2 THE OWNER SHALL EMPLOY PROJECT INSPECTOR AND/OR ONE OR MORE SPECIAL INSPECTORS WHO SHALL PROVIDE INSPECTIONS DURING CONSTRUCTION ON THE TYPES OF WORK LISTED UNDER SECTION 1704 OF THE 2010 CBC.
2. SPECIAL INSPECTOR: THE SPECIAL INSPECTORS SHALL BE QUALIFIED PERSONS WHO SHALL DEMONSTRATE COMPETENCE, FOR INSPECTION OF A PARTICULAR TYPE OF CONSTRUCTION OR OPERATION REQUIRING SPECIAL INSPECTION.
3. DUTIES AND RESPONSIBILITIES OF THE SPECIAL INSPECTORS: THE SPECIAL INSPECTORS SHALL OBSERVE THE WORK ASSIGNED FOR CONFORMANCE TO THE APPROVED DESIGN DRAWINGS AND SPECIFICATIONS.
- THE SPECIAL INSPECTORS SHALL SUBMIT INSPECTION REPORTS TO, THE ENGINEER OR ARCHITECT OF RECORD, AND OTHER DESIGNATED PERSONS. ALL DISCREPANCIES SHALL BE BROUGHT TO THE IMMEDIATE ATTENTION OF THE CONTRACTOR FOR CORRECTION, THEN, IF UNCORRECTED, TO THE PROPER DESIGN AUTHORITY.
- THE SPECIAL INSPECTOR SHALL SUBMIT A FINAL SIGNED REPORT STATING WHETHER THE WORK REQUIRING SPECIAL INSPECTION WAS, TO THE BEST OF THE INSPECTOR'S KNOWLEDGE, IN CONFORMANCE TO THE APPROVED PLANS AND SPECIFICATIONS AND THE APPLICABLE WORKMANSHIP PROVISIONS OF THIS CODE.
4. STANDARDS OF QUALITY: THE REFERENCED STANDARDS LISTED IN CHAPTER 35, PART 2 AND ARE PART OF THIS CODE.
5. EXCEPT AS PROVIDED IN SECTION 1704, THE TYPES OF WORK LISTED BELOW, SHALL BE INSPECTED BY A SPECIAL INSPECTOR/PROJECT INSPECTOR.
- a. CONCRETE: DURING THE TAKING OF TEST SPECIMENS AND PLACING OF REINFORCED CONCRETE.
- b. BOLTS INSTALLED IN CONCRETE SHALL BE PER REQUIREMENTS OF SECTIONS 1911 AND 1912 OR TABLE 1911.2
- c. STRUCTURAL WELDING: SPECIAL INSPECTOR REQUIRED.
- d. REINFORCING STEEL: SPECIAL INSPECTOR REQUIRED.
- DURING PLACING OF REINFORCING STEEL FOR ALL CONCRETE REQUIRED TO HAVE SPECIAL INSPECTION BY ITEM 1.

POWER ACTUATED FASTENERS

1. POWER ACTUATED FASTENERS SHALL BE OF THE TYPE AND SIZE CALLED FOR ON THE DRAWINGS AND IN THE SPECIFICATIONS.
2. POWER ACTUATED FASTENERS SHALL BE PLACED A MINIMUM OF 3" FROM ANY CONCRETE EDGE AND 1/2" FROM ANY STEEL EDGE. MINIMUM SPACING SHALL BE 4" IN CONCRETE AND 1/2" IN STEEL.
3. WHEN USED TO CONNECT ELEMENT TO STEEL MEMBERS, THE POINT OF THE POWER ACTUATED FASTENERS SHALL COMPLETELY PENETRATE THE THICKNESS OF THE BASE METAL.
4. POWER ACTUATED FASTENERS SHALL BE INSTALLED WITH STRICT ADHERENCE TO ALL MANUFACTURERS SPECIFIATIONS.
5. USE ICC EVALUATION REPORT #2269 FOR POWER ACTUATED FASTENERS.
6. POWER ACTUATED FASTENERS SHALL BE USED ONLY FOR CONNECTION NON-STRUCTURAL ELEMENTS AND NON-LOAD BEARING STUD WALLS.

DEFERRED SUBMITTALS:

CONNECTION CALCULATIONS AND DRAWINGS OF MECHANICAL EQUIPMENT TO SUPPORTS SHALL BE SUBMITTED TO THE ENGINEER OF RECORD FOR APPROVAL PRIOR TO INSTALLATION. CALCULATIONS AND DRAWINGS SHALL BE STAMPED AND SIGNED BY A CALIFORNIA REGISTERED CIVIL/STRUCTURAL ENGINEER.

SUBMITTALS

1. SHOP DRAWINGS, INCLUDING CONCRETE MIX DESIGNS, REQUIRED BY THE SPECIFICATIONS SHALL BE SUBMITTED TO THE STRUCTURAL ENGINEER OF RECORD (EOR) FOR REVIEW PRIOR TO FABRICATION OF THE ITEMS. A SCHEDULE FOR SUBMITTAL OF SHOP DRAWINGS SHALL BE PREPARED AND REVIEWED BY THE ARCHITECT AND STRUCTURAL EOR PRIOR TO THE START OF FABRICATION. THE SCHEDULE SHALL PROPORTION THE QUANTITY OF SHOP DRAWINGS TO BE REVIEWED IN EACH SUBMITTAL TO ALLOW SUFFICIENT TIME, AS DEEMED REASONABLE IN THE PROFESSIONAL JUDGEMENT OF THE ARCHITECT AND STRUCTURAL ENGINEER, TO PERMIT ADEQUATE REVIEW.
2. SHOP DRAWINGS SHALL INDICATE THE DATE OR REVISION(S) FROM WHICH THE DRAWINGS WERE PREPARED. SUBMITTALS THAT DO NOT IDENTIFY THE LATEST DATE OR REVISION SHALL BE RETURNED WITHOUT REVIEW. ONLY SHOP DRAWINGS THAT ARE COMPLETE WILL BE ACCEPTED FOR REVIEW.
3. SHOP DRAWINGS AND CONCRETE MIX DESIGNS WILL NOT BE ACCEPTED DIRECTLY FROM SUBCONTRACTORS. SHOP DRAWINGS AND CONCRETE MIX DESIGNS WILL BE ACCEPTED ONLY AFTER BEING REVIEWED AND SIGNED BY THE CONTRACTOR QUALITY CONTROL, INDICATING COMPLIANCE WITH THE REQUIREMENTS OF THE CONSTRUCTION DOCUMENTS. SHOP DRAWINGS AND CONCRETE MIX DESIGNS NOT COMPLYING WITH THE REQUIREMENTS NOTED ABOVE OR IN THE SPECIFICATIONS WILL BE RETURNED WITHOUT REVIEW.
4. SUBMIT TWO (2) SETS OF 11x17 SHOP DRAWINGS. ONE SET WILL BE RETURNED AFTER STRUCTURAL REVIEW.
5. IF, AFTER REVIEW, THE SHOP DRAWINGS ARE NOTED AS REVISE AND RESUBMIT, THE RESUBMITTED SHOP DRAWINGS SHALL IDENTIFY EACH REVISION AND/OR ADDITION BY CLOUD OR OTHER MEANS TO ASSURE PROPER REVIEW.

STRUCTURAL ABBREVIATIONS:

@	AT	MIN	MINIMUM
APPROX	APPROXIMATE	MISC	MISCELLANEOUS
ARCH	ARCHITECTURAL	MTL	METAL
BM	BEAM	NS	NEAR SIDE
BOT	BOTTOM	N-S	NORTH-SOUTH
B/O	BOTTOM OF	NO/#	NUMBER
BFS	BART FACILITY STANDARDS	OC	ON CENTER
BLS	BLUE LIGHT STATION	OH	OPPOSITE HAND
BTW	BETWEEN	OPNG	OPENING
CIP	CAST-IN-PLACE	OPP	OPPOSITE
CL	CENTERLINE	PL	PLATE
CLG	CEILING	PJF	PREFORMED JOINT FILLER
CLR	CLEAR	PSI	POUNDS PER SQUARE INCH
CJ	CONTROL JOINT	PCF	POUNDS PER CUBIC FOOT
CMU	CONCRETE MASONRY UNIT	PSF	POUNDS PER SQUARE FOOT
COL	COLUMN	POC	PEDESTRIAN OVER CROSSING
CONC	CONCRETE	P/S	PRESTRESSED
CONN	CONNECTION	RA	RADIUS
CONT	CONTINUOUS	REF	REFERENCE
DBA	DEFORMED BAR ANCHOR	REINF	REINFORCED
DET	DETAIL	REQ'D	REQUIRED
DIA	DIAMETER	REV	REVISIONS
ø	DIAMETER	SF	SCHEDULE
DIAG	DIAGONAL	SCHED	SQUARED FEET
DIM	DIMENSION	SOG	SLAB ON GRADE
DWG	DRAWING	SAD	SEE ARCHITECTURE DRAWINGS
(E)	EXISTING	SIM	SIMILAR
EA	EACH	SMS	SHEET METAL SCREW
EF	EACH FACE	SPEC	SPECIFICATION
E-W	EAST-WEST	STL	STEEL
EMBED	EMBEDMENT	STIFF	STIFFENER
EOR	ENGINEER OF RECORD	TEMP	TEMPERATURE
EJ	EXPANSION JOINT	THK	THICK
ELEV	ELEVATOR	T/O	TOP OF
EQ	EQUAL	TOC	TOP OF CONCRETE
EQPT	EQUIPMENT	TOS	TOP OF STEEL
E/S	EACH SIDE	TYP	TYPICAL
ESC	ESCALATOR	UON	UNLESS OTHERWISE NOTED
EW	EACH WAY	VERT	VERTICAL
EXT	EXTERIOR	VSH	VERTICAL SLOTTED HOLES
FOM	FACE OF MASONRY	W	WIDE FLANGE
FOC	FACE OF CONCRETE	W/	WITH
FTG	FOOTING	WGT	WEIGHT
FS	FAR SIDE	WP	WORK POINT
GA	GAUGE	WPF	WATERPROOF
GALV	GALVANIZED	f'c	SPECIFIED COMPRESSIVE STRENGTH OF STRUCTURAL CONCRETE AT 28 DAYS
HORIZ	HORIZONTAL	fy	SPECIFIED YIELD STRENGTH OF REINFORCEMENT
HSS	HOLLOW STRUCT SECTION	f'g	SPECIFIED COMPRESSIVE STRENGTH OF CMU GROUT
INFO	INFORMATION	fu	ULTIMATE STRENGTH OF STEEL
JT(S)	JOINT(S)	f'c	SPECIFIED COMPRESSIVE STRENGTH OF MASONRY AT 28 DAYS
KSI	KIPS PER SQUARE INCH	f'm	
LBS	POUNDS		
MAX	MAXIMUM		
MECH	MECHANICAL		
MET	METAL		
MFR	MANUFACTURER		

STRUCTURAL LEGEND

	INDICATES OPENING
	INDICATES BLOCKOUT
	INDICATES GRADE BREAK
	INDICATES CMU WALL
	INDICATES ONE-WAY SLAB
	INDICATES TWO-WAY SLAB SPAN
	INDICATES CROSS SLOPE
	INDICATES SLOPED SURFACE
	INDICATES BRACED FRAME
W24x	INDICATES STRUCTURAL STEEL WIDE FLANGE BEAM AND SIZE
COL	INDICATES STRUCTURAL STEEL COLUMN
	INDICATES BRACE DIRECTION
L3x3x	INDICATES STRUCTURAL STEEL ANGLE AND SIZE
DO	INDICATES BEAM SIZE IDENTICAL TO ADJACENT MEMBER
	STEEL MOMENT CONNECTION
±	INDICATES AN APPROXIMATE DIMENSION OR ELEVATION. VERIFY INFORMATION AS REQUIRED TO COMPLETE CONSTRUCTION.
	INDICATES CONCRETE WALL
	INDICATES LIGHT GAGE METAL STUD BEARING WALL, SEE ARCHITECTURAL DRAWINGS

FOUNDATION AND CONCOURSE LEVEL NOTES

1. TOP OF CONCOURSE LEVEL FINISH FLOOR ELEVATION = 0'-0" TYP, UNO
2. VERIFY ALL OPENINGS AND DIMENSIONS WITH ARCHITECTURAL DRAWINGS AND OTHER DISCIPLINES.
3. REFER TO GENERAL NOTES DB-S001X.
4. CONTROL JOINTS FOR SLAB ON GRADE ARE TO BE INSTALLED @ 20' OC MAX IN 8" SLAB, 12' OC MAX IN 5" SLAB OR AS SHOWN ON PLAN. CONTROL JOINTS SHALL BE MADE BY SAWCUTTING SLAB AS SOON AS THE SURFACE IS FIRM ENOUGH SO THAT IT WILL NOT BE DAMAGED BY THE BLADE, USUALLY WITHIN 4 TO 12 HOURS AFTER THE CONCRETE HARDENS (NO LATER THAN 24 HOURS AFTER PLACEMENT). SAWCUT DEPTH SHALL BE 1 1/2". CONSTRUCTION JOINTS MAY BE INSTALLED AT THE CONTRACTOR'S OPTION.
5. VERIFY THE LOCATIONS OF ALL EXISTING UTILITIES IN THE FIELD. ALL CONTRACTORS SHALL CALL U.S.A., (CA. 1-800-227-2600) 48 HOURS BEFORE DIGGING. EXCAVATION FOR UNDER-GROUND FACILITIES SHALL NOT BE PERMITTED PRIOR TO UNDERGROUND SERVICE ALERT'S IDENTIFICATION OF EXISTING UTILITIES.
6. THE SIZE & LOCATION OF ALL FOOTING AND SLAB PENETRATIONS SHALL BE SUBMITTED TO EOR FOR REVIEW PRIOR TO INSTALLATION.
7. CONTRACTOR IS RESPONSIBLE FOR THE PLACEMENT OF ALL EMBEDDED ITEMS.
8. ALL DIMENSIONS ARE TO CENTERLINE OF COLUMNS OR FACE OF CONCRETE, TYP UNLESS NOTED OTHERWISE.

04-02 Jul 05, 2013 - 1:47pm P:\BART Berryessa Extension Line\AS - STRUCTURAL MILPITAS WORK\_6-10-2012\C700-S-DB-S002X.dwg

					DESIGNED BY J. REBER, S.E.
					DRAWN BY P. DIAZ
0	20130710				CHECKED BY M. TARAZI
0	20130531				IN CHARGE M. TARAZI
REV	DATE	BY	SUB	APP	DESCRIPTION
					20130710



Skanska  
Shimmick  
Herzog

1436 California Circle  
Milpitas, California 95035  
A Joint Venture

MFT CONSULTING ENGINEERS, Inc. Anil Verma Associates, Inc.  
1773 San Pablo Ave., Suite A3 (510) 222-4100  
Palo Alto, CA 94304 Fax (510) 222-8410

Leonwood, Andrews & Newman, Inc.  
A LEO A DALY COMPANY

T-Y-LIN INTERNATIONAL

SUBMITTED

APPROVED

BART SILICON VALLEY BERRYESSA EXTENSION

LINE, TRACK, STATIONS AND SYSTEMS			CADD FILENAME C700-S-DB-S002X.dwg		
DESIGN UNIT 023			SIZE SCALE D NONE		
MILPITAS STATION			CONTRACT NO. C700		
STRUCTURAL GENERAL NOTES			REV. 0		
			AREA CODE SHEET NO. PAGE NO. DB S002X 0135		



THE SSH SHALL EMPLOY A TESTING LAB & SPECIAL INSPECTOR DURING CONSTRUCTION PER THE REQUIREMENTS ON THE FOLLOWING TYPES OF WORK:

- CONTINUOUSLY INSPECT THE PLACEMENT OF ALL CONCRETE EXCEPT PERIODIC INSPECTION MAY BE PROVIDED FOR THE PLACEMENT OF CONCRETE FOR:
- 1. FOUNDATIONS WITH  $f'_c$  EQUAL TO 2500 PSI OR LESS.
- 2. NON-STRUCTURAL SLABS ON GRADE.
- SAMPLE CONCRETE: ASTM C172, EXCEPT SLUMP SHALL COMPLY WITH ASTM C94.
- TEST SLUMP: ASTM C143, ONE TEST AT POINT OF TRUCK DISCHARGE FOR 50 CY OR FRACTION THEREOF FOR EACH TYPE OF CONCRETE. ADDITIONAL TESTS REQUIRED WHEN CONCRETE CONSISTENCY SEEMS TO HAVE CHANGED.
- TEST AIR CONTENT: ASTM C173, VOLUMETRIC METHOD FOR LIGHTWEIGHT OR NORMAL WEIGHT CONCRETE, ONE FOR EACH 50 CY PLACED OR FRACTION THERE OF FOR EACH TYPE OF AIR-ENTRAINED CONCRETE.
- TEST CONCRETE TEMPERATURE:
  - TEST HOURLY WHEN AIR TEMPERATURE IS 50 DEGREE F. (10 DEGREES C.) AND BELOW, AND WHEN 85 DEGREES F. (29 DEGREES C.) AND ABOVE; AND EACH TIME A SET OF COMPRESSION TEST SPECIMENS ARE MADE.
- TAKE COMPRESSION TEST SPECIMENS: ASTM C31, TAKE ONE SET OF 3 STANDARD CYLINDERS FOR EACH 50 CY OF CONCRETE OR 5000 SQ. FT SLABS & WALLS OR FRACTION THEREOF FOR EACH TYPE OF CONCRETE TAKEN EACH DAY. MOLD AND STORE CYLINDERS FOR LABORATORY CURED TEST SPECIMENS EXCEPT WHEN FIELD-CURE TEST SPECIMENS ARE REQUIRED.
- TEST COMPRESSIVE STRENGTH: ASTM C39; ONE SPECIMEN TESTED AT 7 DAYS, 14 DAYS AND AT 28 DAYS.

- VERIFY THAT MILLS CERTIFICATES SHOW REINFORCING STEEL IS IN COMPLIANCE WITH PROJECT SPECIFICATIONS. TAKE A 5' LONG SAMPLE OF EACH BAR SIZE FROM EACH HEAT FOR EACH TYPE OF REINFORCING STEEL SHALL BE TESTED FOR ULTIMATE STRENGTH, YIELD STRESS, MODULUS OF ELASTICITY AND PERCENT ELONGATION AT RUPTURE.
- PERIODICALLY INSPECT THE PLACEMENT OF REINFORCING STEEL FOR SHOTCRETE AND FOR CONCRETE WHICH IS REQUIRED TO HAVE CONTINUOUS INSPECTION.
- CONTINUOUSLY INSPECT THE INSTALLATION OF ALL MECHANICAL COUPLING DEVICES.

- TAKE TEST SPECIMENS AND CONTINUOUSLY INSPECT THE PLACEMENT OF NON-SHRINK/EXPANSIVE GROUT. SEE SPECIFICATIONS 03 61 11.

WHEN DRILLED-IN EXPANSION ANCHORS OR OTHER POST-INSTALLED ANCHORS ACCEPTABLE TO THE ENFORCEMENT AGENCY ARE USED IN LIEU OF CAST IN-PLACE BOLTS, THE ALLOWABLE SHEAR AND TENSION VALUES AND INSTALLATION VERIFICATION TEST LOADS SHALL BE ACCEPTABLE TO ENGINEER OF RECORD, (EOR), ARCHITECT OF RECORD (AOR), & OWNER.

WHEN EXPANSION-TYPE ANCHORS ARE USED FOR NON-STRUCTURAL APPLICATIONS SUCH AS EQUIPMENT ANCHORAGE, 50 PERCENT OR ALTERNATE BOLTS IN A GROUP, INCLUDING AT LEAST ONE-HALF THE ANCHORS IN EACH GROUP, SHALL BE TENSION TESTED.

IF ANY ANCHOR FAILS TESTING, TEST ALL ANCHORS OF THE SAME TYPE, NOT PREVIOUSLY TESTED UNTIL TWENTY (20) CONSECUTIVE ANCHORS PASS, THEN RESUME THE INITIAL TEST FREQUENCY. IF THE ANCHORS ARE USED FOR THE SUPPORT AND BRACING OF NON-STRUCTURAL COMPONENTS (PIPE, DUCT OR CONDUIT), THE TWENTY (20) SHALL BE ONLY THOSE ANCHORS INSTALLED BY THE SAME TRADE.

- PERIODICALLY INSPECT INSTALLATION OF BOLTS AND CONTINUOUSLY INSPECT PLACEMENT OF CONCRETE AROUND SUCH BOLTS.

THE SPECIAL INSPECTOR SHALL VERIFY THE FOLLOWING AND RECORD THE INFORMATION IN THE INSPECTION REPORT:

- ANCHOR TYPE, SIZE AND DIMENSIONS
- HOLE DIMENSIONS AND CLEANLINESS
- ANCHOR SPACING
- EDGE DISTANCES
- ANCHOR EMBEDMENT
- TORQUE VALUE

TORQUE SHALL BE VERIFIED BY EITHER CONTINUOUS INSPECTION DURING TORQUING OR BY TESTING THE ANCHORS AS FOLLOWS:

50% OF ANCHORS SHALL BE TESTED USING A TORQUE-CALIBRATED WRENCH TO A MINIMUM OF TORQUE AS SPECIFIED IN THE ICC REPORT FOR THE ANCHOR. IF ANY ANCHOR FAILS TESTING, THIS PROCESS SHALL CONTINUE UNTIL 20 CONSECUTIVE ANCHORS PASS. TESTING ON THE REMAINDER OF THE ANCHORS SHALL CONTINUE AT ORIGINAL FREQUENCY.

- VERIFY THAT MILL CERTIFICATES SHOW STRUCTURAL STEEL AND MISCELLANEOUS IRON IS IN COMPLIANCE WITH PROJECT SPECIFICATIONS.

- VERIFY WELDER CERTIFICATIONS, COMPLIANCE WITH WELDING PROCEDURE SPECIFICATIONS AND PQR (IF APPLICABLE)
- CONTINUOUSLY INSPECT ALL STRUCTURAL WELDING, INCLUDING WELDING OF REINFORCING STEEL.

**By:** \_\_\_\_\_ **Date:** \_\_\_\_\_

1. FLOOR AND ROOF DECK WELDING MAY HAVE PERIODIC INSPECTION.
2. WELDED STUDS USED FOR DIAPHRAGM OR COMPOSITE CONSTRUCTION MAY HAVE PERIODIC INSPECTION,
3. WELDED SHEET STEEL FOR COLD FORMED STEEL FRAMING MAY HAVE PERIODIC INSPECTION
4. WELDING OF STAIRS AND RAILING SYSTEMS MAY HAVE PERIODIC INSPECTION.

ALL COMPLETE JOINT PENETRATION WELDS ON MATERIALS 5/16" THICK AND GREATER REQUIRE ULTRASONIC TESTING.  
PARTIAL JOINT PENETRATION WELDS WITH EFFECTIVE THROAT THICKNESS OF 3/4" OR GREATER REQUIRE ULTRASONIC TESTING.  
WELDS ON BASE METAL THICKER THAN 1 1/2" REQUIRE ULTRASONIC TESTING

- VERIFY THAT MILL CERTIFICATES SHOW THAT BOLTS, NUTS AND WASHERS COMPLY WITH THE PROJECT SPECIFICATIONS.
- VERIFY THAT THE METHODS OF TIGHTENING TO BE USED BY THE CONTRACTOR COMPLY WITH AISC "SPECIFICATIONS FOR STRUCTURAL JOINTS USING ASTM A325 OR A490 BOLTS", CURRENT EDITION APPROVED BY THE RESEARCH COUNCIL ON STRUCTURAL CONNECTIONS OF THE ENGINEERING FOUNDATION (RCSC) AND ENDORSED BY AISC.
- PERFORM TENSION CALIBRATION TESTS WITH THE CONTRACTOR'S TOOLS ON 3 BOLT ASSEMBLIES FOR EACH DIAMETER, LENGTH, GRADE, PRODUCTION LOT AND TIGHTENING METHOD TO BE USED ON THE PROJECT INCLUDING PRETENSIONED ANCHOR RODS. TEST SHALL BE PER RCSC SPECIFICATIONS.
- INSPECT THE FAYING SURFACES OF EACH BOLTED CONNECTION FOR COMPLIANCE WITH RCSC SPECIFICATIONS.

- VERIFY THAT ALL PLIES OF CONNECTED MATERIAL HAVE BEEN DRAWN TOGETHER TO A SNUG CONDITION AS DEFINED PER RCSC SPECIFICATIONS BEFORE FINAL TIGHTENING.
- VERIFY PLACEMENT OF MATCH-MARKS OR WRENCH CALIBRATION AS REQUIRED.
- CONTINUOUSLY INSPECT FINAL TIGHTENING OPERATIONS PER RCSC SPECIFICATIONS.

THE SPECIAL INNSPECTOR NEED NOT BE PRESENT DURING ALL FINAL TIGHTENING OPERATIONS PROVIDED IT CAN BE VERIFIED THAT PROPER PROCEDURES WERE FOLLOWED (I.E. THE USE OF "TWIST-OFF" TYPE BOLTS).


 
- THE SPECIAL INSPECTOR SHALL BE A QUALIFIED PERSON WHO SHALL DEMONSTRATE HIS COMPETENCE, TO EOR, AOR & OWNER, FOR INSPECTION OF A PARTICULAR TYPE OF CONSTRUCTION OR OPERATION REQUIRING SPECIAL INSPECTION.
- TESTING AND INSPECTIONS WILL BE PERFORMED BY AN INDEPENDENT TESTING LABORATORY SELECTED AND EMPLOYED BY OWNER

PROCEDURAL AND ACCEPTANCE CRITERIA ARE SET FORTH IN THE 2010 CALIFORNIA BUILDING CODE.


- THE SPECIAL INSPECTOR SHALL OBSERVE THE WORK ASSIGNED FOR CONFORMANCE WITH THE APPLICABLE PROJECT DRAWINGS AND SPECIFICATIONS.
- MATERIAL REQUIRED TO BE TESTED WILL BE SELECTED BY THE TESTING LAB AND NOT BY THE CONTRACTOR.
- THE SPECIAL INSPECTOR SHALL FURNISH INSPECTION REPORTS TO THE ARCHITECT OR MANAGER, THE STRUCTURAL ENGINEER OF RECORD AND THE CONTRACTOR. ALL DISCREPANCIES SHALL BE BROUGHT IMMEDIATELY FOR CORRECTION. THEN IF UNCORRECTED, TO THE PROPER DESIGN AUTHORITY AND TO THE BUILDING OFFICIAL. TEST REPORTS SHALL BE SIGNED BY A REGISTERED CIVIL ENGINEER LICENSED IN THE STATE OF CALIFORNIA.
- THE SPECIAL INSPECTOR SHALL SUBMIT A FINAL SIGNED VERIFIED REPORT STATING WHETHER THE WORK REQUIRING SPECIAL INSPECTION WAS, TO THE BEST OF THE INSPECTOR'S KNOWLEDGE, IN CONFORMANCE WITH THE PROJECT PLANS AND SPECIFICATIONS AND THE APPLICABLE WORKMANSHIP PROVISIONS OF THE CBC.

Jul 05, 2013 - 1:47pm P:\BART Berrysso Extension Line\S - STRUCTURAL MILPITAS\WORK\_6-10-2012\C700-S-S-DB-S003X.dwg



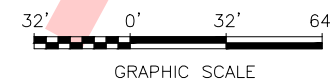

DESIGNED BY J. REBER, S.E.
DRAWN BY P. DIAZ
CHECKED BY M. TARAIZI
IN CHARGE M. TARAIZI
DATE 20130531

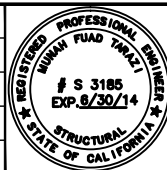

Skanska  
Shimmick  
Herzog

1436 California Circle  
Milpitas, California 95035  
A Joint Venture

**LAN** Lockwood, And  
& Newnam, Inc.

APPROVED

T-Y-LIN INTERNATIONAL

APPROVED \_\_\_\_\_



BART SILICON VALLEY BERRYESSA EXTENSIO


LINE, TRACK, STATIONS AND SYSTEMS  
DESIGN UNIT 023  
MILPITAS STATION  
MAT FOUNDATION  
KEY PLAN

CADD FILENAME C700-S-DB-S070.dwg		
SIZE D	SCALE 1/32" = 1'-0"	
CONTRACT NO. C700		REV. C
AREA CODE DB	SHEET NO. S070	PAGE NO. 0137





Jul 05, 2013 1:48pm P:\BART Berryessa Extension Line\AS - STRUCTURAL MILPITAS WORK\6-10-2012\0700-S-DB-S071.dwg

04-02

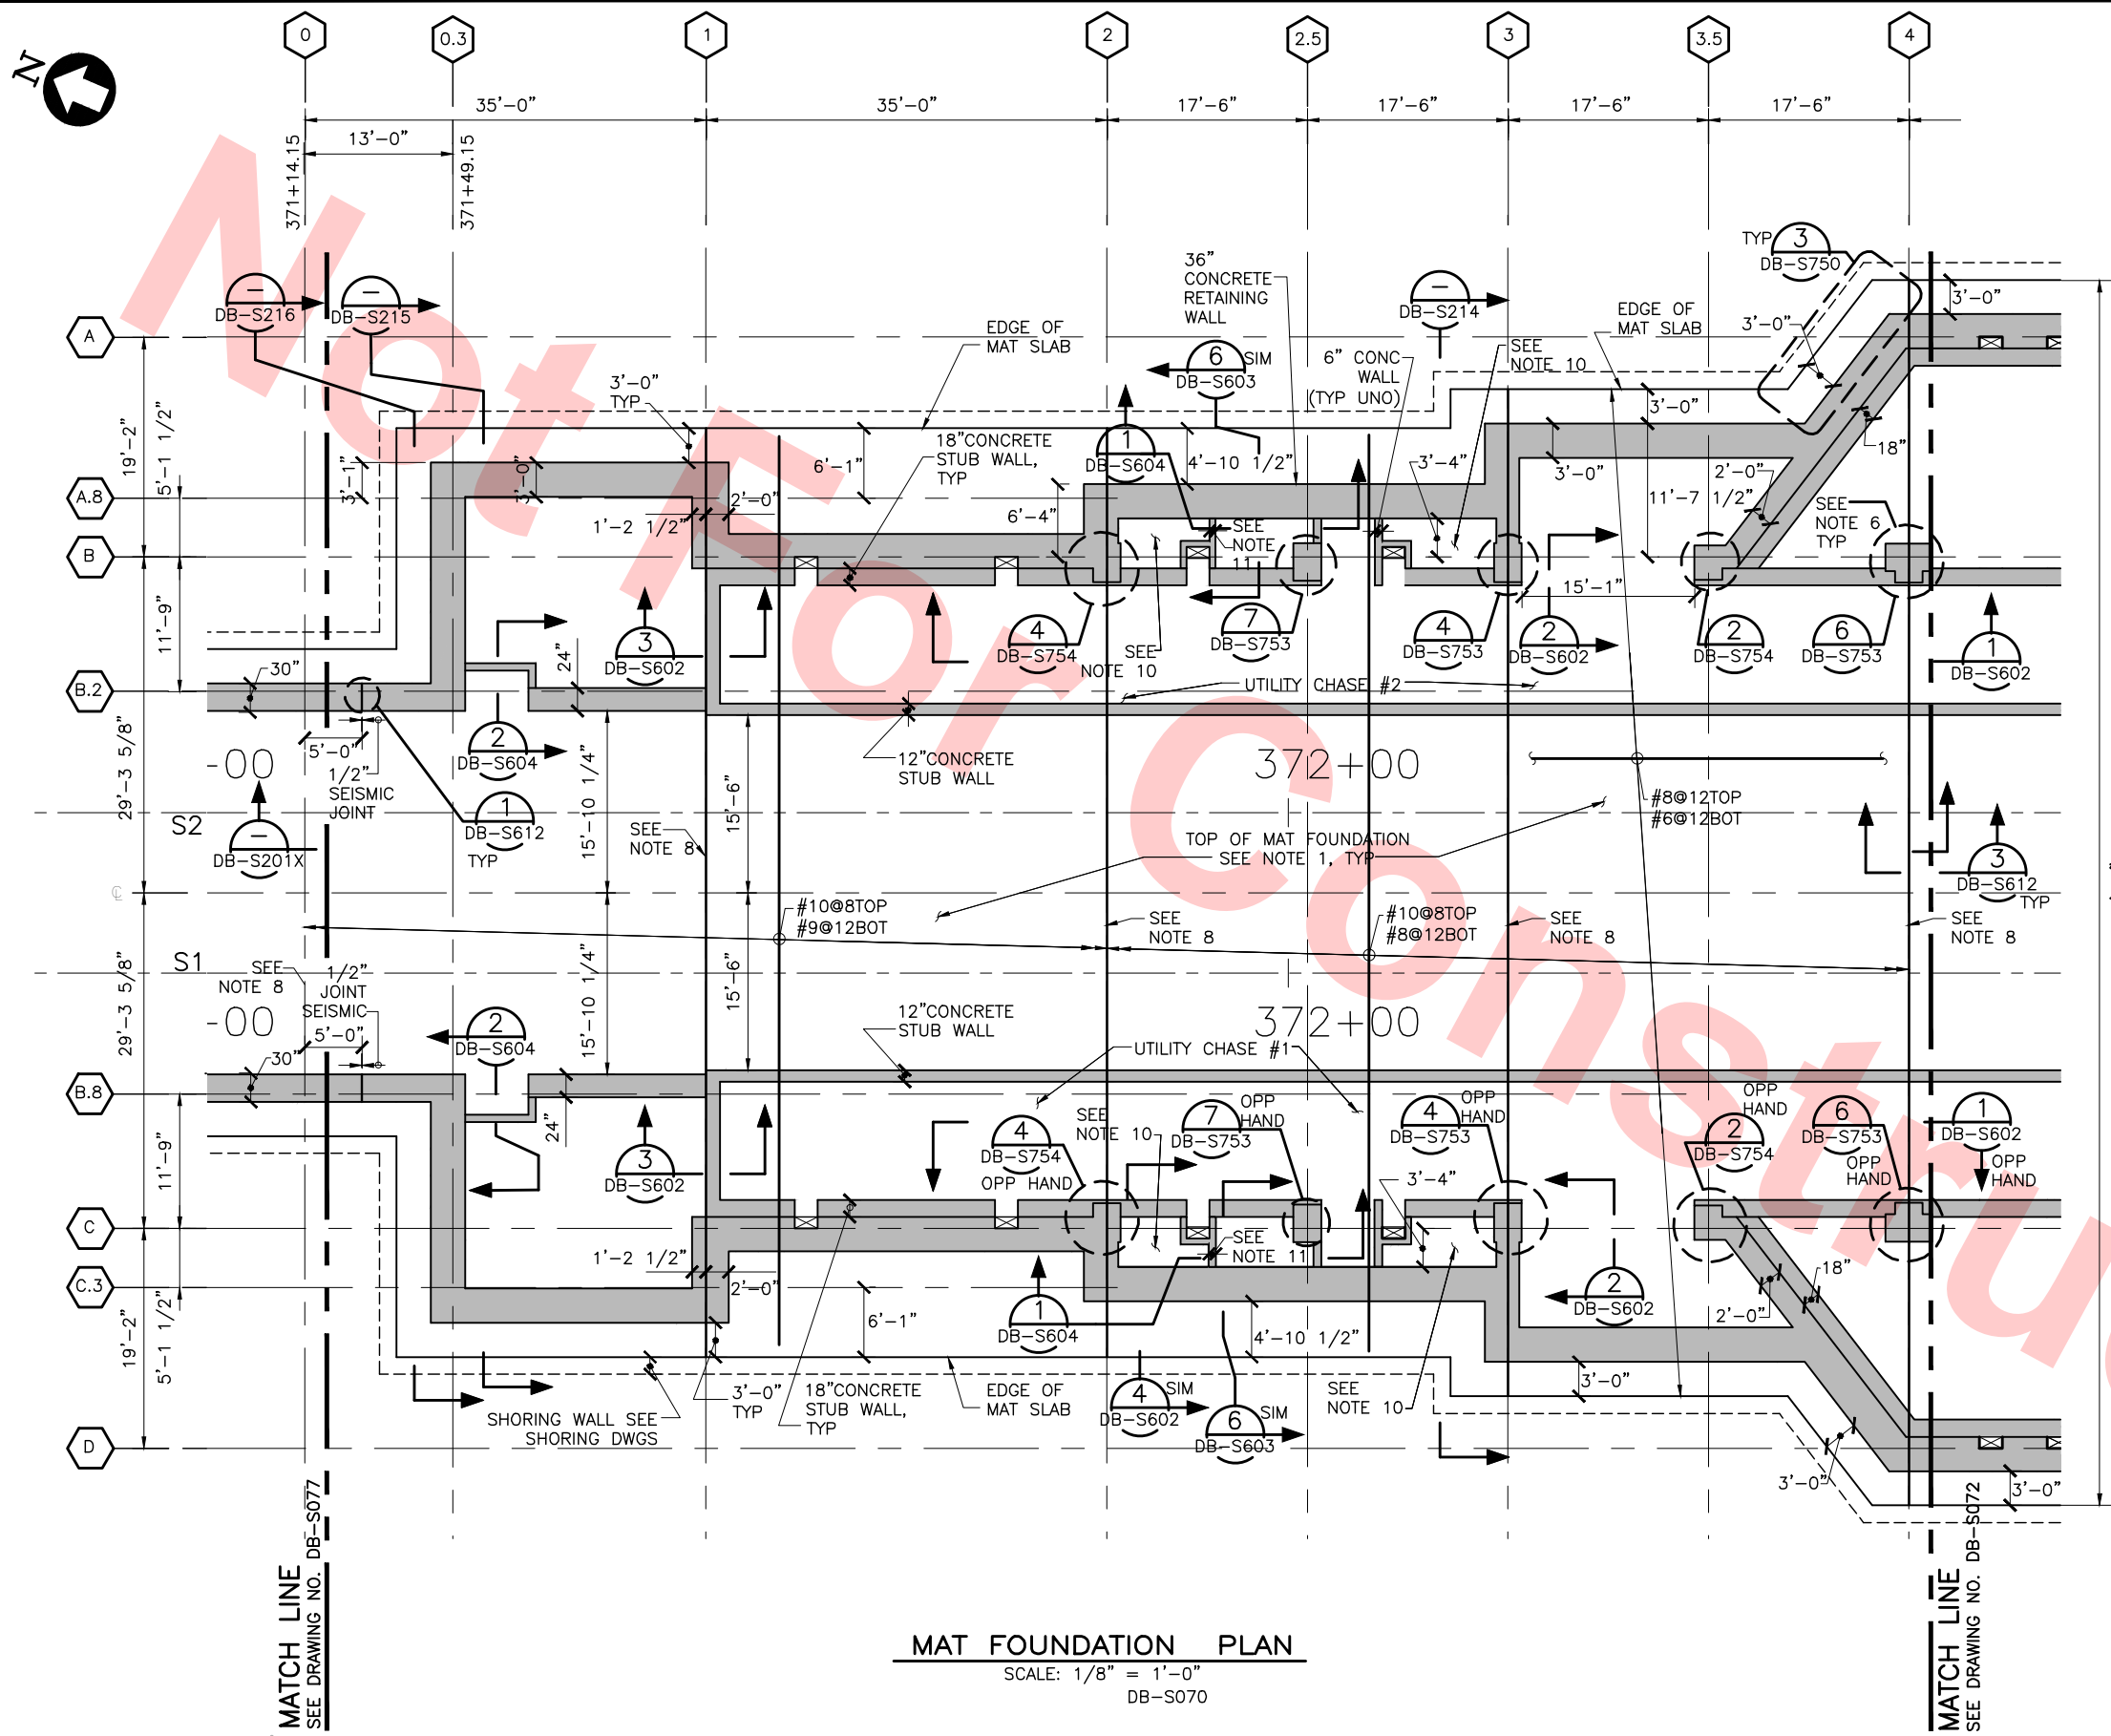

- NOTES:**
1. TOP OF MAT FOUNDATION ELEVATION VARIES. COORDINATE WITH TOP OF RAIL PROFILE SEE (2) DB-S200 AND WITH DRAWING LS-Z227.
  2. VERIFY ALL OPENINGS AND DIMENSIONS WITH ARCHITECTURAL DRAWINGS.
  3. THE SIZE & LOCATION OF ALL MAT FOUNDATION PENETRATIONS SHALL BE SUBMITTED TO THE EOR FOR REVIEW PRIOR TO INSTALLATION. SEE DRAWINGS (9) DB-S771
  4. COORDINATE AND INSTALL ALL EMBEDDED ITEMS IN CONCRETE AS CALLED OUT ON THE DRAWINGS
  5. ALL DIMENSIONS ARE TO CENTERLINE OF COLUMNS OR FACE OF CONCRETE, TYP UNLESS NOTED OTHERWISE.
  6. FOR ALL COLUMN SIZES AND REINFORCING STEEL SEE DRAWING DB-S751X AND DB-S752X.
  7. REFER TO GENERAL NOTES, LEGEND, AND ABBREVIATIONS ON DRAWINGS DB-S001X, DB-S002X, AND DB-S003X.
  8. CONSTRUCTION JOINT PER DRAWING (3) DB-S612
  9. ALL RETAINING WALL SHALL BE 36" THICK, UNO.
  10. NO SLURRY CONC IN THESE AREAS, COORDINATE W/ ARCH DRAWINGS.
  11. 8" CONCRETE WALL
  12. FOR LOCATION OF CATCH BASIN AND DRAINAGE PIPE EMBEDDED IN THE MAT FOUNDATION, COORDINATE WITH DRAWINGS LS-C427 AND LS-C428.
  13. FOR LOCATION OF CONDUITS EMBEDDED IN THE MAT FOUNDATION, COORDINATE WITH DRAWINGS DB-E021X TO DB-E026X. PLACE CONDUITS BELOW TOP LAYER REINFORCEMENT STEEL. DO NOT CUT ANY REINFORCEMENT

FOR REFERENCE ONLY AND NOT FOR REVIEW.  
THIS DRAWING WAS ALREADY SUBMITTED UNDER  
DU23-WP08 RFC TRENCH PACKAGE.

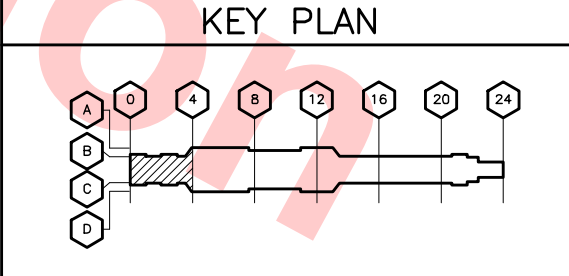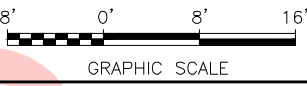

**MAT FOUNDATION PLAN**  
SCALE: 1/8" = 1'-0"  
DB-S070

REV	DATE	BY	SUB	APP	DESCRIPTION
0	20130531				READINESS FOR CONSTRUCTION

DESIGNED BY  
J. REBER, S.E.  
DRAWN BY  
P. DIAZ  
CHECKED BY  
M. TARAZI  
IN CHARGE  
M. TARAZI  
DATE  
20130531



**Skanska  
Shimmick  
Herzog**  
1436 California Circle  
Milpitas, California 95035  
A Joint Venture  
MFT CONSULTING ENGINEERS, Inc. Anil Verma Associates, Inc.  
1773 San Pablo Ave., Suite A3 (510) 222-4166  
Pinole, CA 94664 Fax (510) 222-6419

**Loonwood, Andrews  
& Newman, Inc.**  
A LEO A DALY COMPANY  
**T-Y-LIN INTERNATIONAL**



**LINE, TRACK, STATIONS AND SYSTEMS  
DESIGN UNIT 023  
MILPITAS STATION  
MAT FOUNDATION PLAN**  
SHEET 1 OF 7

CADD FILENAME C700-S-DB-S071.dwg	REV. 0
SIZE SCALE D 1/8" = 1'-0"	AREA CODE SHEET NO. DB S071
CONTRACT NO. C700	PAGE NO. 0138



Jul 05, 2013 1:48pm P:\BART Berryessa Extension Line\AS - STRUCTURAL MILPITAS WORK\6-10-2012\0700-S-DB-S072.dwg

FOR REFERENCE ONLY AND NOT FOR REVIEW.  
THIS DRAWING WAS ALREADY SUBMITTED UNDER  
DU23-WP08 RFC TRENCH PACKAGE

REV	DATE	BY	SUB	APP	DESCRIPTION
0	20130531				READINESS FOR CONSTRUCTION

DESIGNED BY  
J. REBER, S.E.  
DRAWN BY  
P. DIAZ  
CHECKED BY  
M. TARAZI  
IN CHARGE  
M. TARAZI  
DATE  
20130531




Skanska  
Shimmick  
Herzog  
1436 California Circle  
Milpitas, California 95035  
A Joint Venture  
MFT CONSULTING ENGINEERS, Inc. Anil Verma Associates, Inc.  
1773 San Pablo Ave., Suite A3 (510) 222-4166  
Pinole, CA 94664 Fax (510) 222-6419

Lealwood, Andrews  
& Newman, Inc.  
A LEO A DALY COMPANY  
T-Y-LIN INTERNATIONAL  
APPROVED





LINE, TRACK, STATIONS AND SYSTEMS  
DESIGN UNIT 023  
MILPITAS STATION  
MAT FOUNDATION PLAN  
SHEET 2 OF 7

CADD FILENAME C700-S-DB-S072.dwg	REV. 0
SIZE D	SCALE 1/8" = 1'-0"
CONTRACT NO. C700	SHEET NO. S072
AREA CODE DB	PAGE NO. 0139

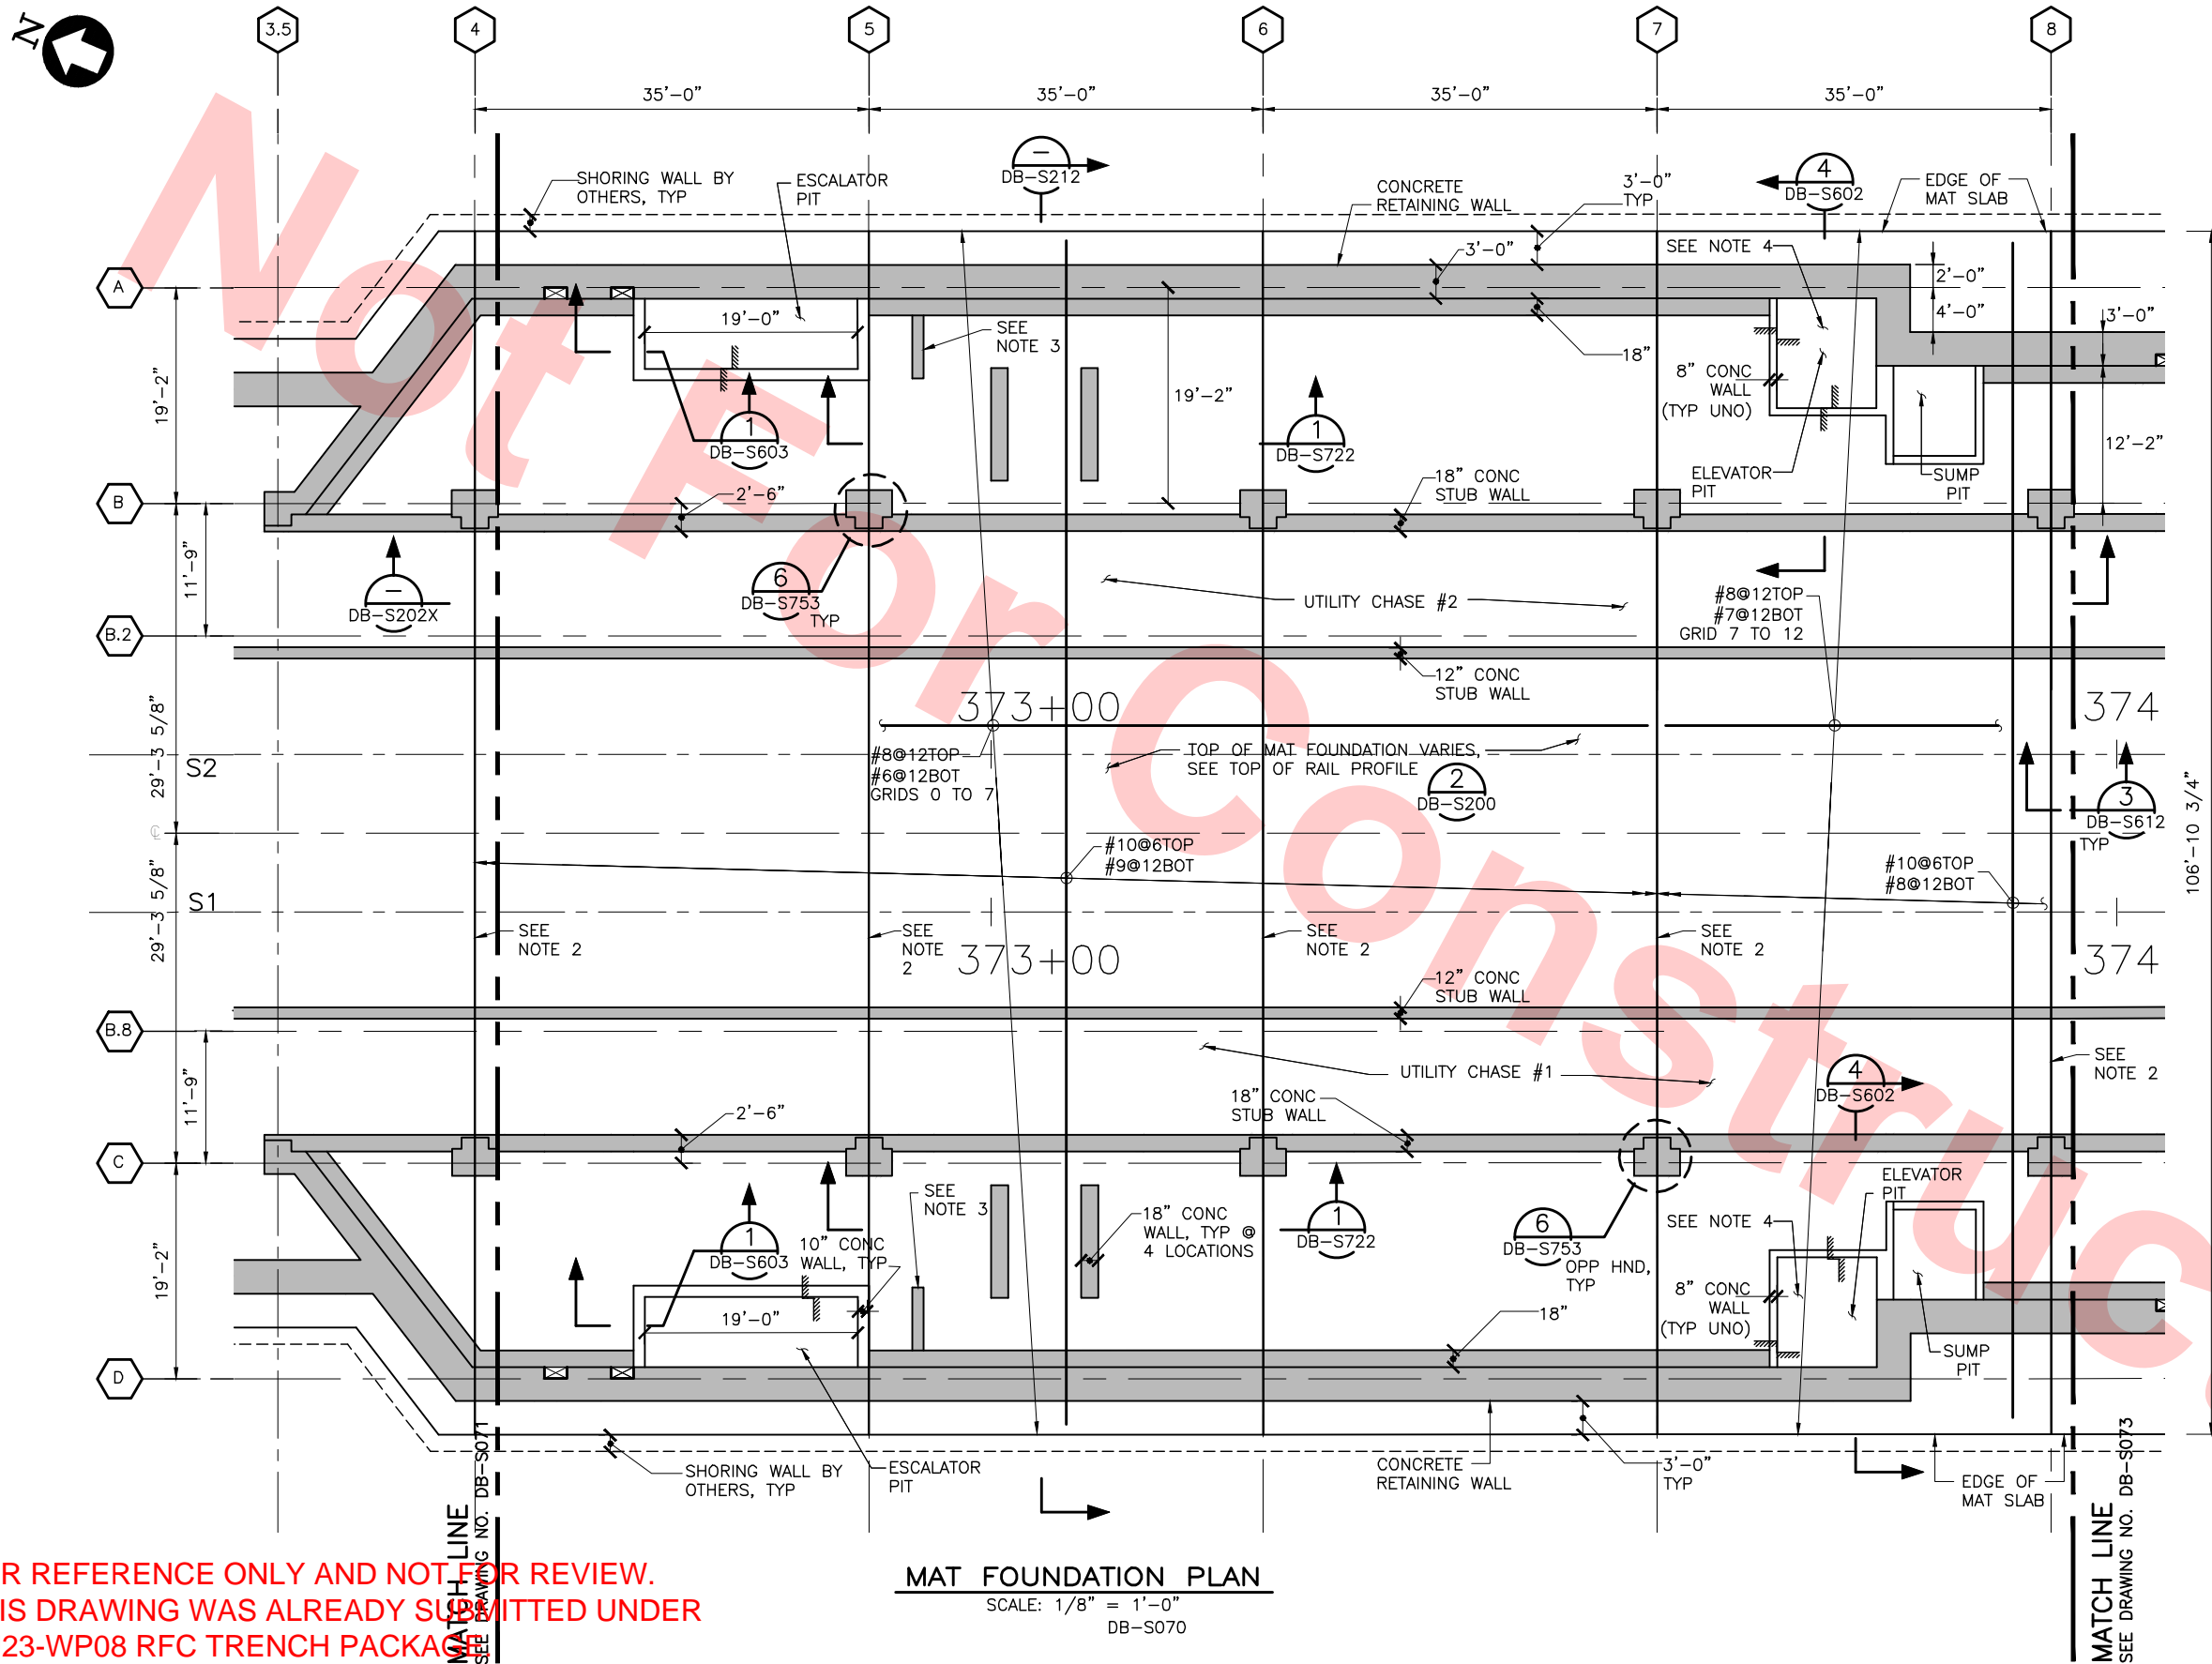


**MAT FOUNDATION PLAN**  
SCALE: 1/8" = 1'-0"  
DB-S070



- NOTES:**
- FOR MAT FOUNDATION NOTES, SEE DWG NO DB-S071.
  - CONSTRUCTION JOINT PER DRAWING DB-S612
  - 12" CONCRETE STUBWALL FOR ESCALATOR SUPPORT. COORDINATE LOCATION AND HEIGHT WITH ESCALATOR DRAWINGS.
  - AT ELEVATOR PIT, REFER TO ELEVATOR DRAWINGS FOR LOCATION AND ELEVATION SHAFT AND PISTON

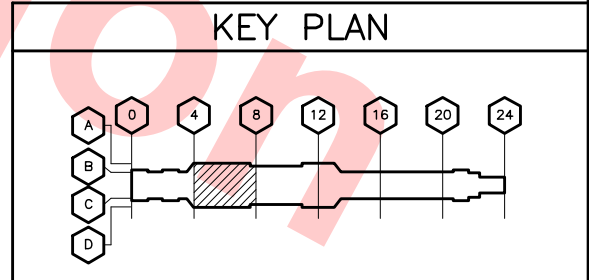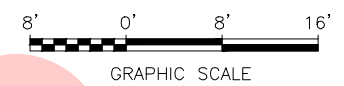



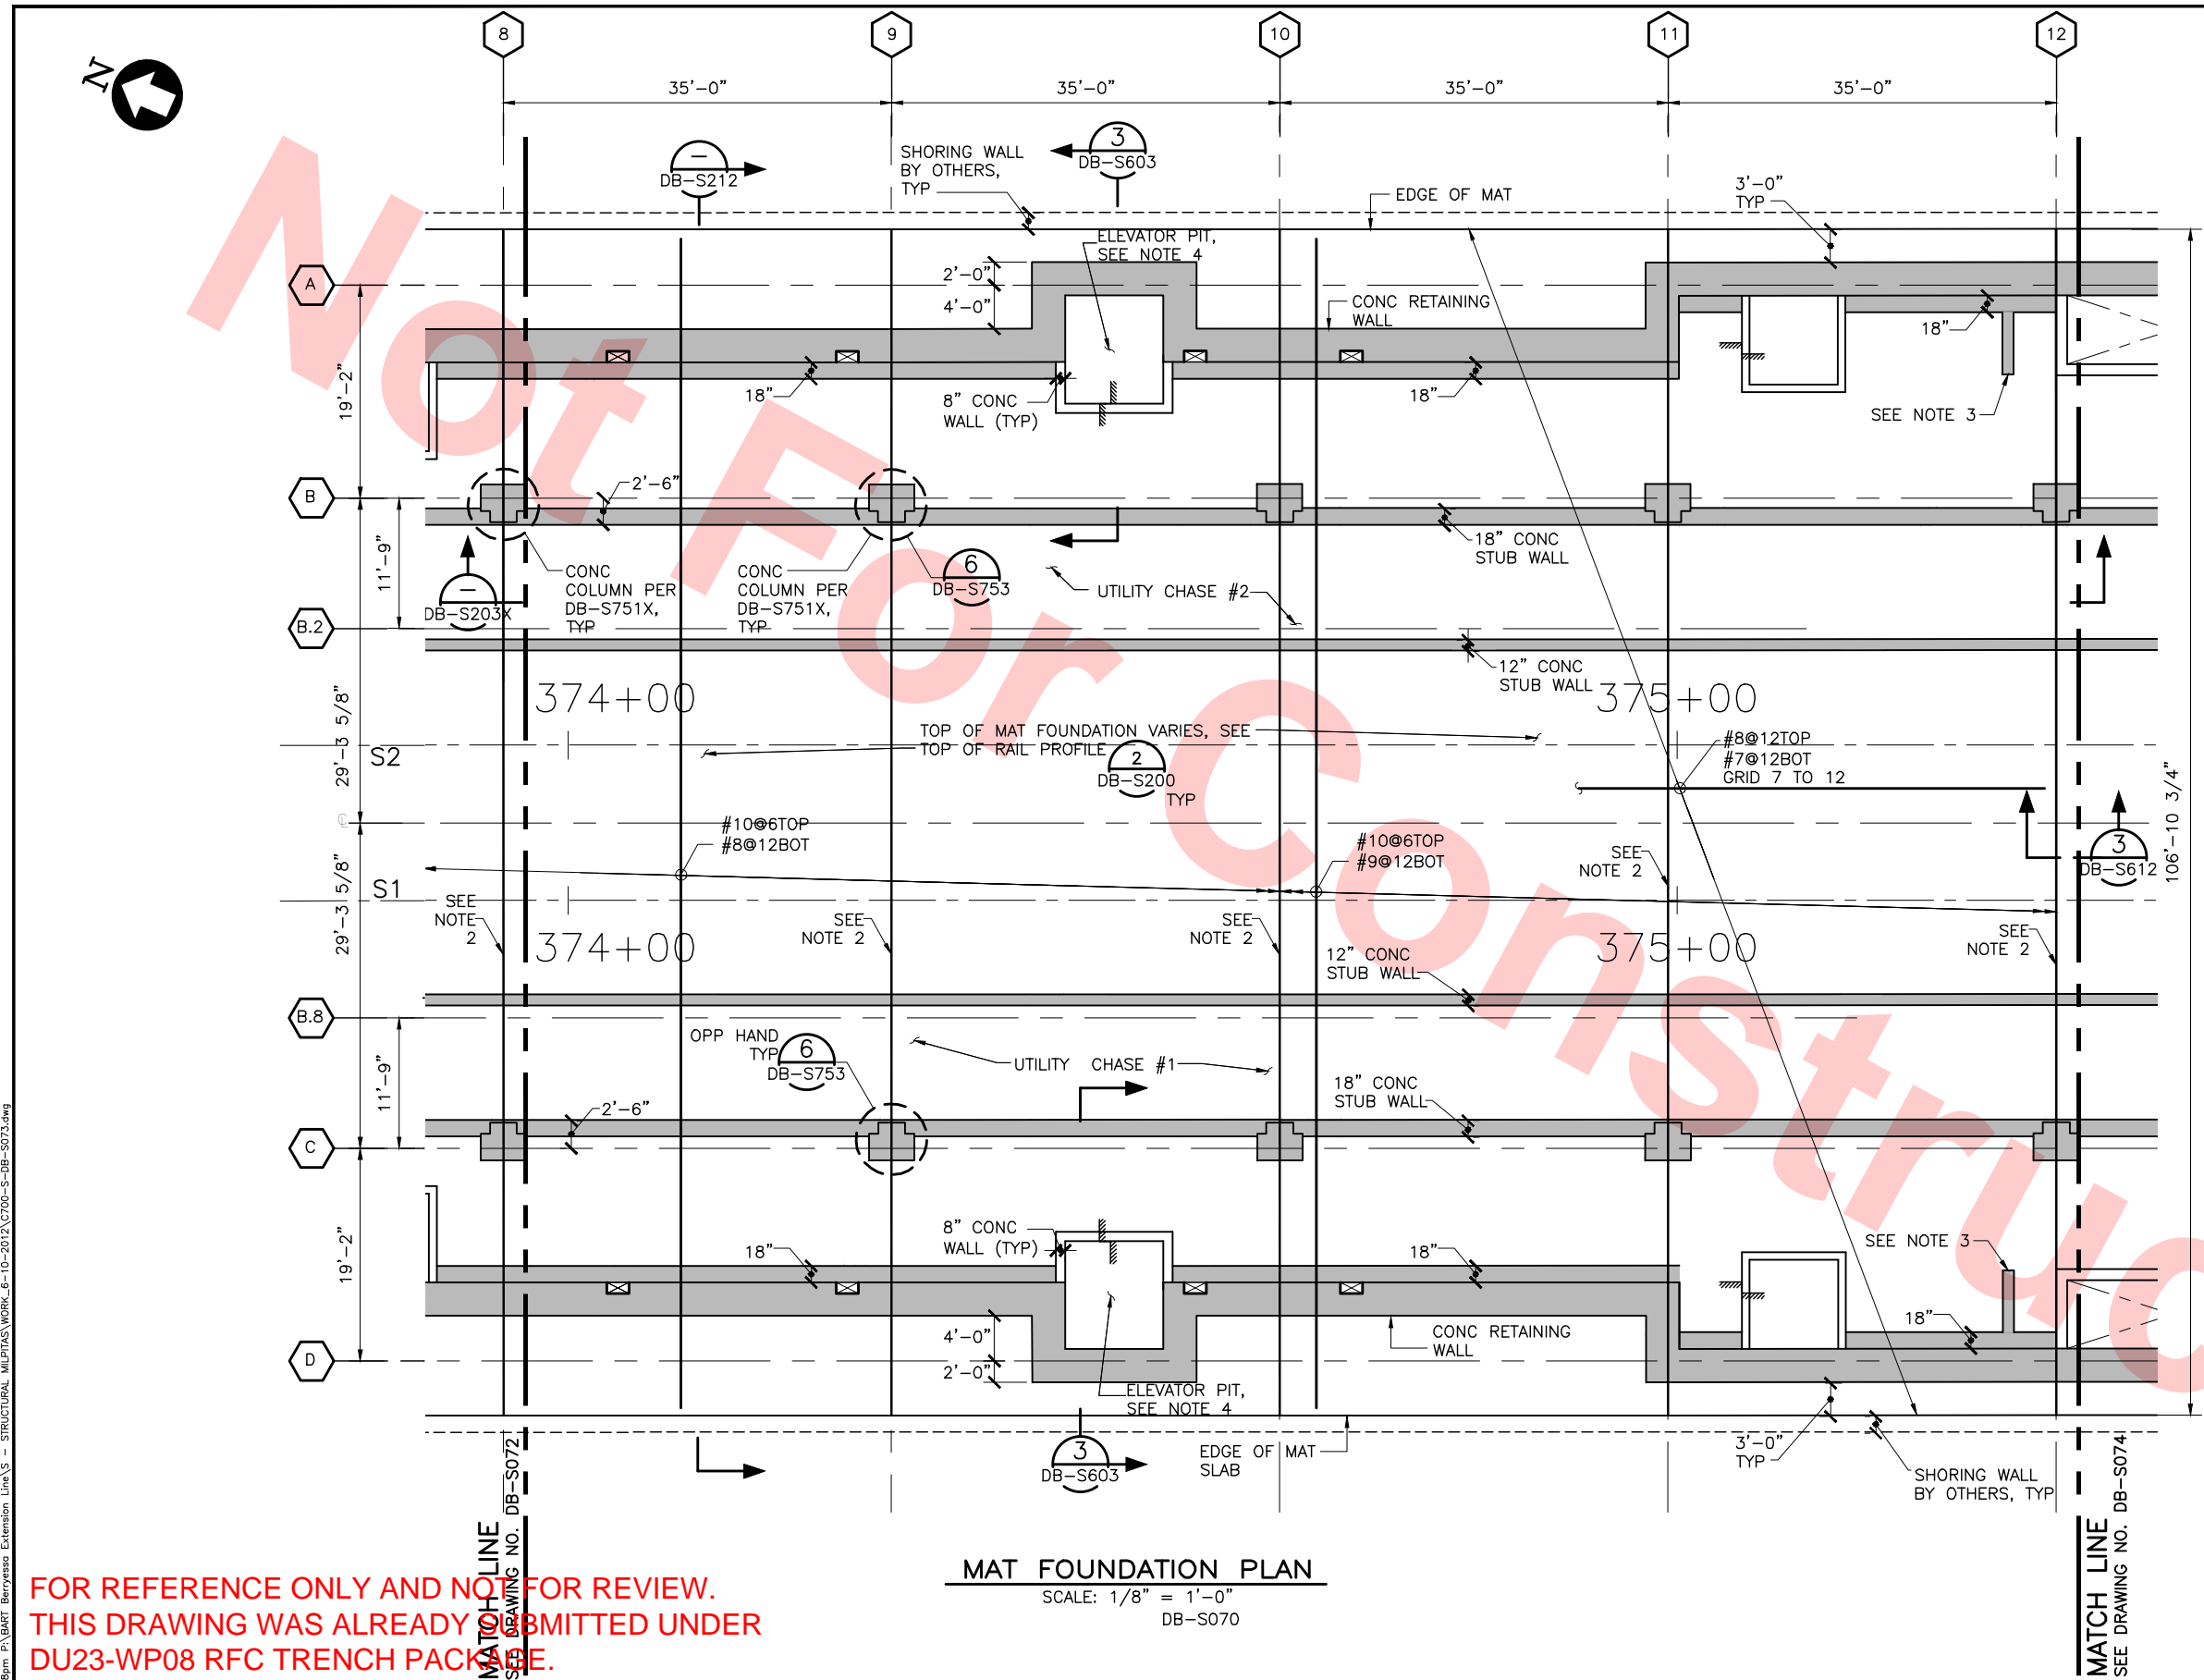


- NOTES:
- 1. FOR MAT FOUNDATION NOTES, SEE DWG NO DB-S071.
  - 2. CONSTRUCTION JOINT PER DRAWINGS DB-S612
  - 3. 12" CONCRETE STUBWALL FOR ESCALATOR SUPPORT. COORDINATE LOCATION AND HEIGHT WITH ESCALATOR DRAWINGS.
  - 4. AT ELEVATOR PIT, REFER TO ELEVATOR DRAWINGS FOR LOCATION AND ELEVATION SHAFT AND PISTON

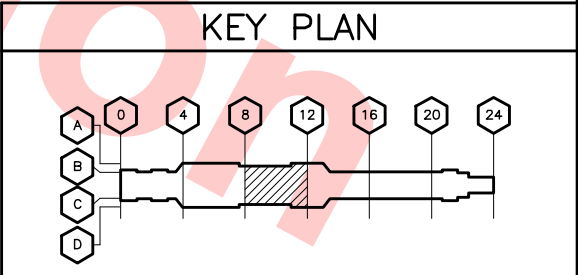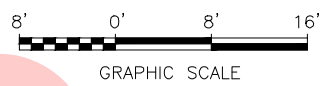

FOR REFERENCE ONLY AND NOT FOR REVIEW.  
THIS DRAWING WAS ALREADY SUBMITTED UNDER  
DU23-WP08 RFC TRENCH PACKAGE.

REV	DATE	BY	SUB	APP	DESCRIPTION
0	20130531				READINESS FOR CONSTRUCTION

DESIGNED BY  
J. REBER, S.E.  
DRAWN BY  
P. DIAZ  
CHECKED BY  
M. TARAZI  
IN CHARGE  
M. TARAZI  
DATE  
20130531

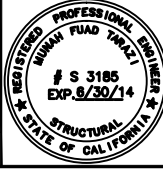

Skanska  
Shimmick  
Herzog  
1436 California Circle  
Milpitas, California 95035  
A Joint Venture  
MFT CONSULTING ENGINEERS, INC. Anil Verma Associates, Inc.  
1773 San Pablo Ave., Suite A3 (510) 222-4166  
Palo Alto, CA 94304 Fax (510) 222-6418

Lealwood, Andrews  
& Newman, Inc.  
A LEO A DALY COMPANY  
T-Y-LIN INTERNATIONAL  
APPROVED





LINE, TRACK, STATIONS AND SYSTEMS  
DESIGN UNIT 023  
MILPITAS STATION  
MAT FOUNDATION PLAN  
SHEET 3 OF 7

CADD FILENAME C700-S-DB-S073.dwg	REV. 0
SIZE D	SCALE 1/8" = 1'-0"
CONTRACT NO. C700	PAGE NO. 0140
AREA CODE DB	SHEET NO. S073



Jul 05, 2013 1:48pm P:\BART Berryessa Extension Line\AS - STRUCTURAL MILPITAS WORK\6-10-2012\0700-S-DB-S074.dwg

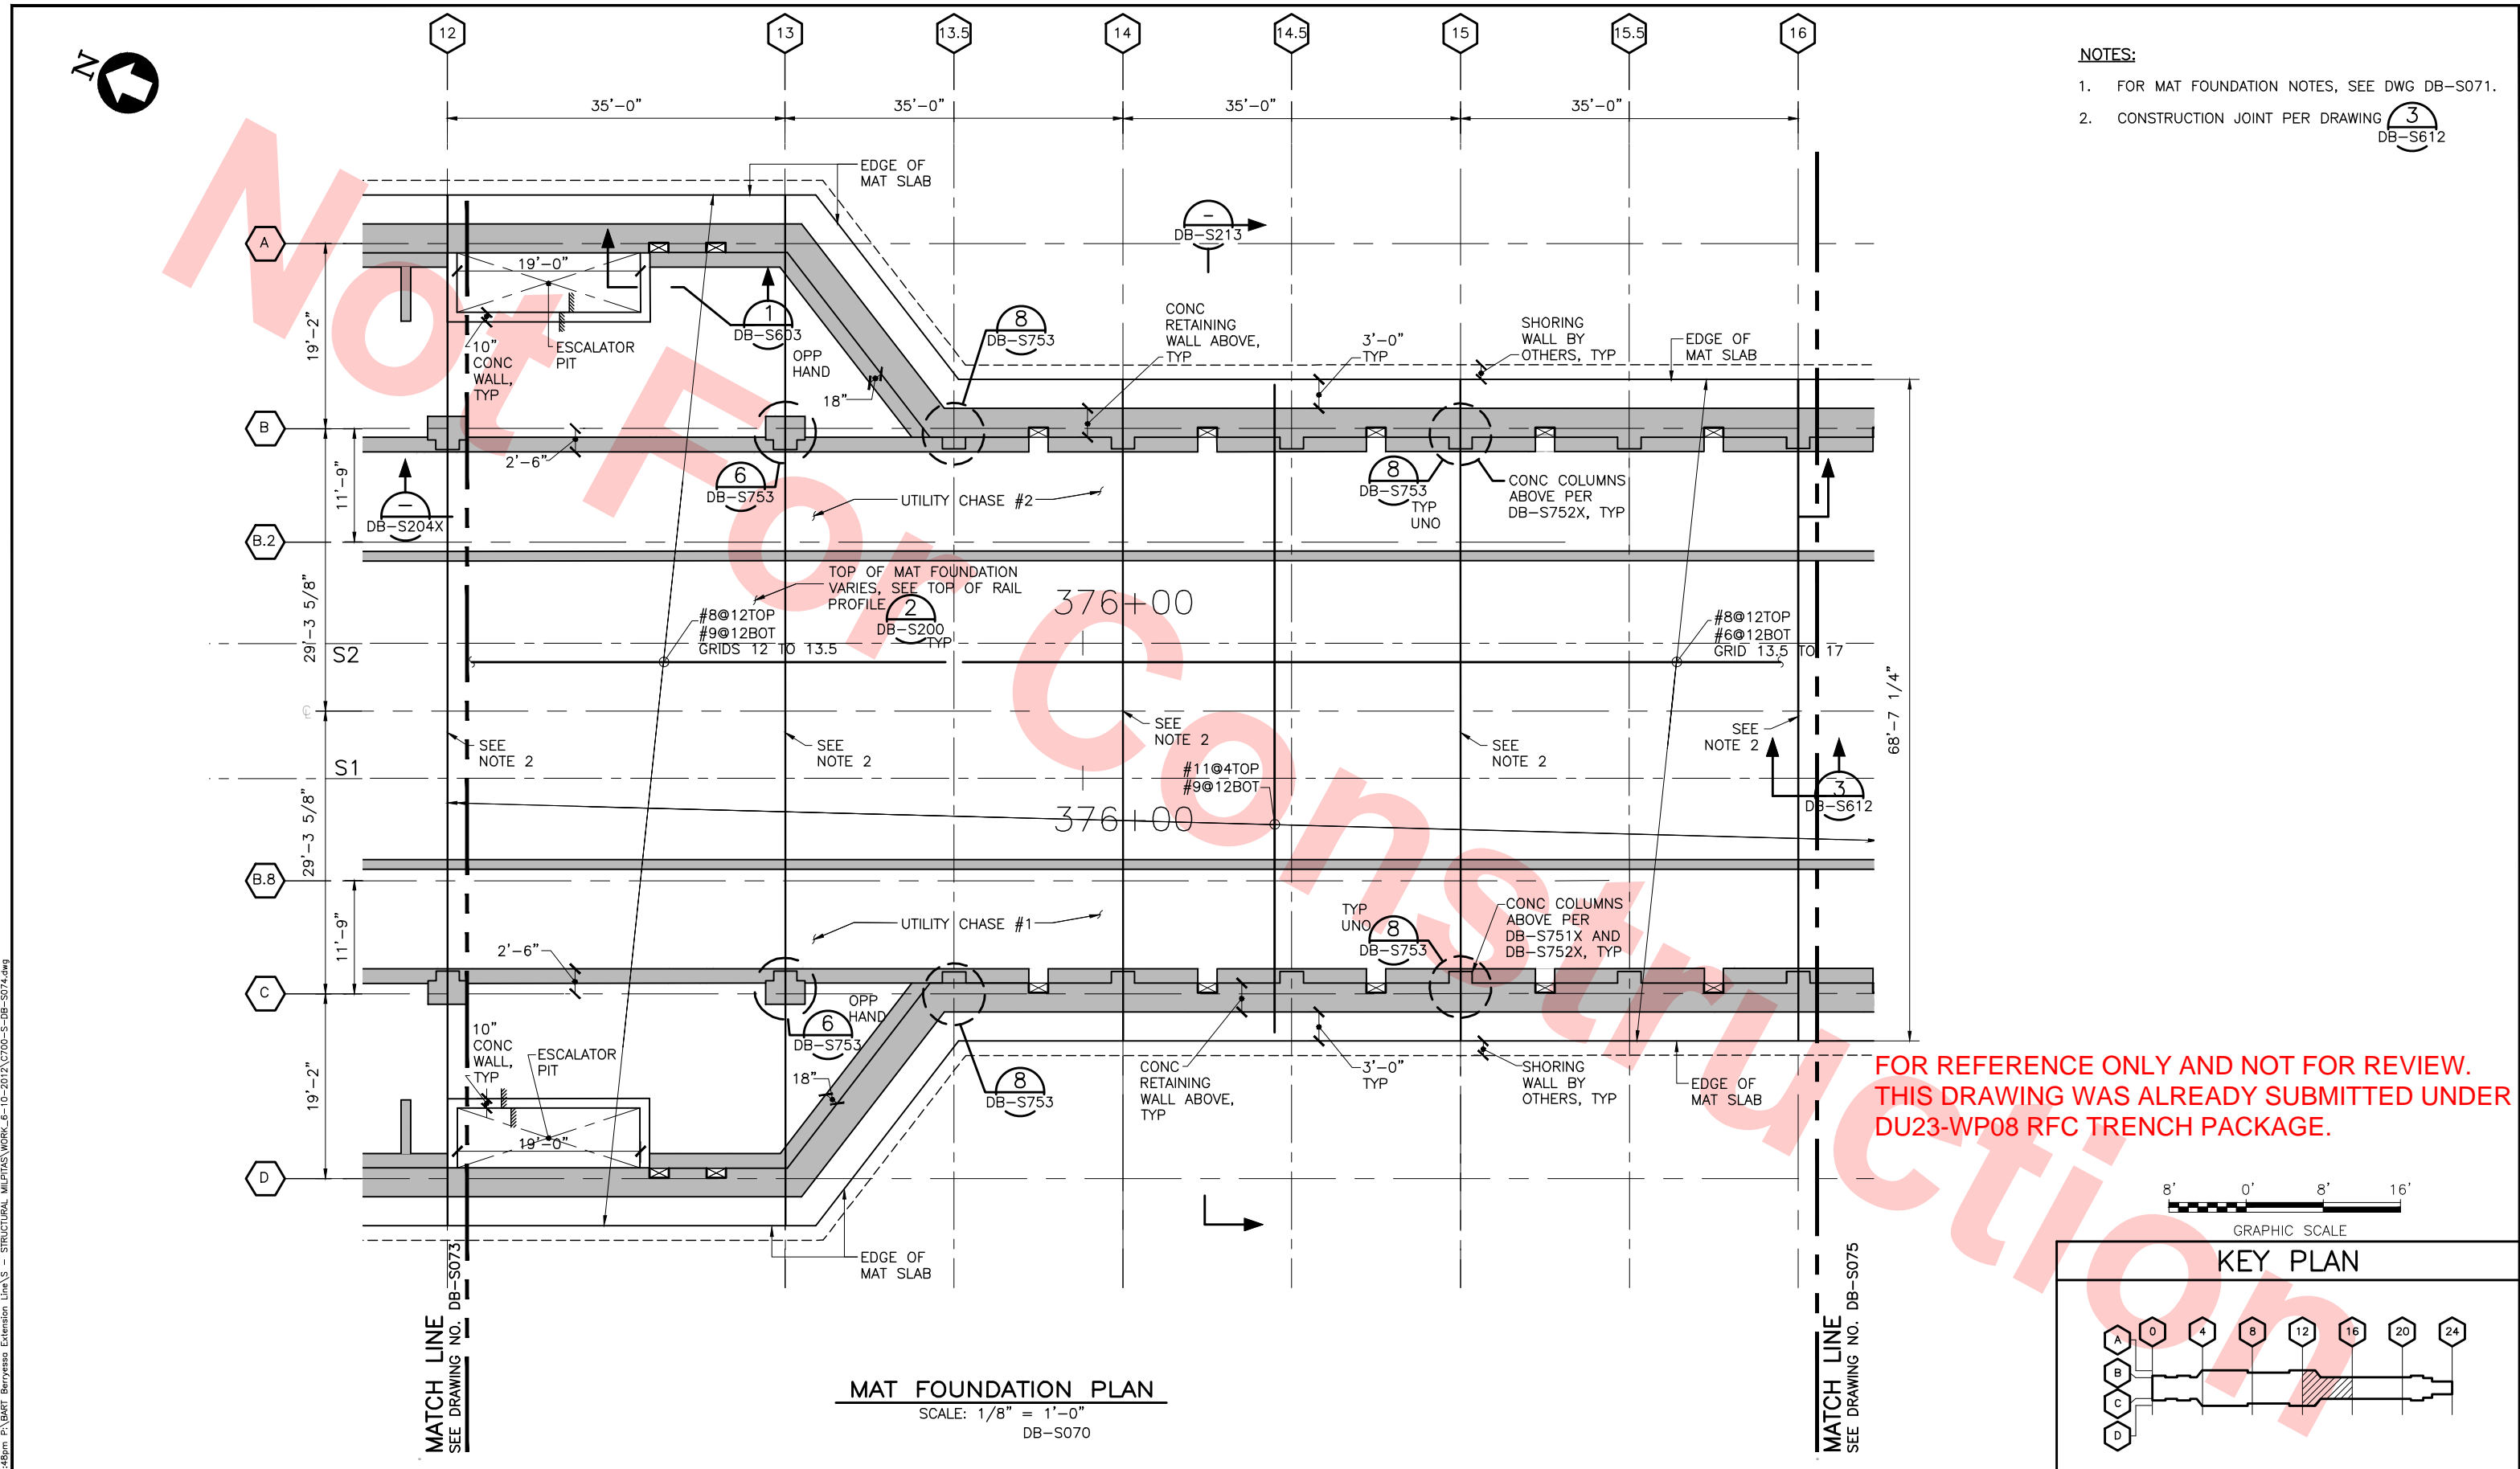

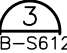- NOTES:
- FOR MAT FOUNDATION NOTES, SEE DWG DB-S071.
  - CONSTRUCTION JOINT PER DRAWING  DB-S612

FOR REFERENCE ONLY AND NOT FOR REVIEW.  
THIS DRAWING WAS ALREADY SUBMITTED UNDER  
DU23-WP08 RFC TRENCH PACKAGE.

																																																																																																																																																																																																																																																																																																																																																																																																																																																																																																																																																																																																																																																																																																																																																																																																																																																																																																																																																																																																																																																																																																																																																																																																																																																																																																																																																																																																																																																																													</
--	--	----





04-02 Jul 05, 2013 1:48pm P:\BART Berryessa Extension Line\AS - STRUCTURAL MILPITAS WORK\_8-10-2012\0700-S-DB-S075.dwg




NOTES:

- FOR MAT FOUNDATION NOTES, SEE DWG DB-S071.
- CONSTRUCTION JOINT PER DRAWING 3 DB-S612

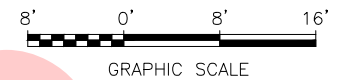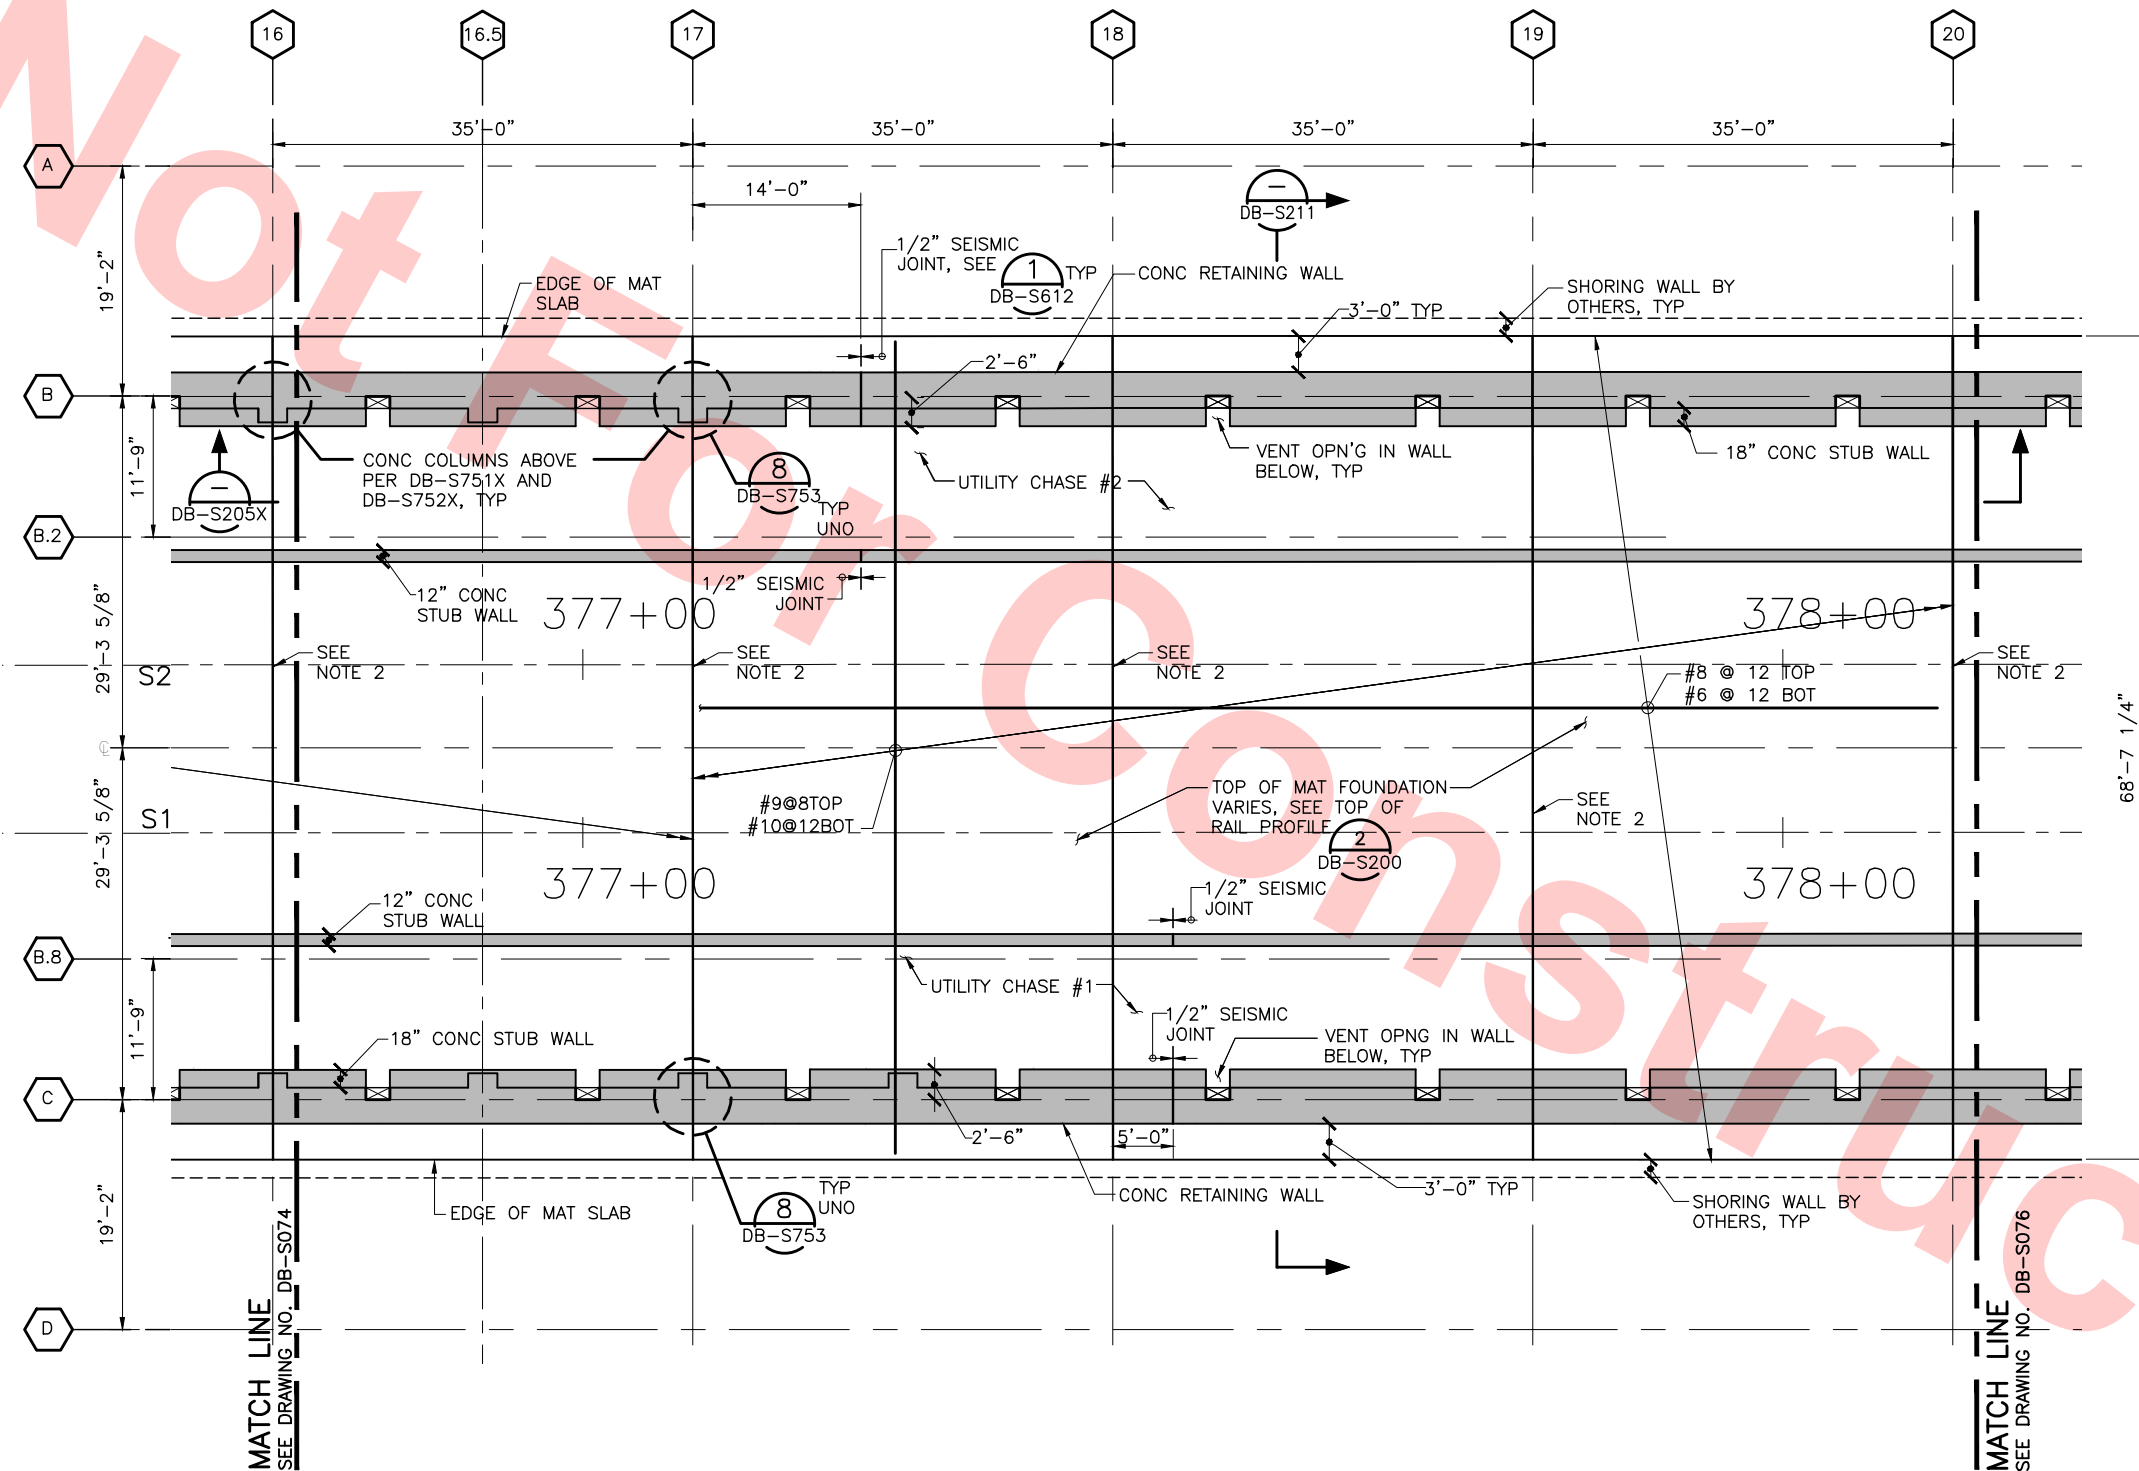

KEY PLAN

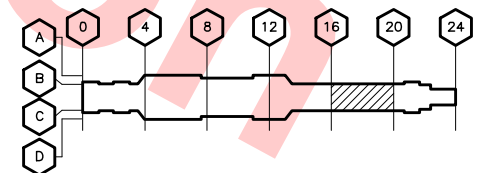


FOR REFERENCE ONLY AND NOT FOR REVIEW.  
THIS DRAWING WAS ALREADY SUBMITTED UNDER  
DU23-WP08 RFC TRENCH PACKAGE.

**MAT FOUNDATION PLAN**  
SCALE: 1/8" = 1'-0"  
DB-S070

DESIGNED BY J. REBER, S.E.	
DRAWN BY P. DIAZ	
CHECKED BY M. TARAZI	
IN CHARGE M. TARAZI	
DATE 20130531	

REV	DATE	BY	SUB	APP	DESCRIPTION
0	20130531				READINESS FOR CONSTRUCTION

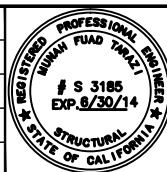

**Skanska Shimmick Herzog**

1436 California Circle  
Milpitas, California 95035  
A Joint Venture

**MFT CONSULTING ENGINEERS, INC.** Anil Verma Associates, Inc.  
1773 San Pablo Ave., Suite A3 (510) 222-4166  
Pinole, CA 94664 Fax (510) 222-6418

**Lealwood, Andrews & Newman, Inc.**  
A LEAD & RALLY COMPANY

**T-Y-LIN INTERNATIONAL**

APPROVED \_\_\_\_\_



LINE, TRACK, STATIONS AND SYSTEMS  
DESIGN UNIT 023  
MILPITAS STATION  
MAT FOUNDATION PLAN

SHEET 5 OF 7

CADD FILENAME C700-S-DB-S075.dwg	
SIZE SCALE D 1/8" = 1'-0"	
CONTRACT NO. C700	REV. 0
AREA CODE DB	SHEET NO. S075
	PAGE NO. 0142



Jul 05, 2013 1:48pm P:\BART Berryessa Extension Line\A3 - STRUCTURAL MILPITAS WORK\6-10-2012\0700-S-DB-S076.dwg

FOR REFERENCE ONLY AND NOT FOR REVIEW.  
THIS DRAWING WAS ALREADY SUBMITTED UNDER  
DU23-WP08 RFC TRENCH PACKAGE.

REV	DATE	BY	SUB	APP	DESCRIPTION
0	20130531				READINESS FOR CONSTRUCTION

DESIGNED BY  
J. REBER, S.E.  
DRAWN BY  
P. DIAZ  
CHECKED BY  
M. TARAZI  
IN CHARGE  
M. TARAZI  
DATE  
20130531




Skanska  
Shimmick  
Herzog  
1436 California Circle  
Milpitas, California 95035  
A Joint Venture  
MFT CONSULTING ENGINEERS, INC. Anil Verma Associates, Inc.  
1773 San Pablo Ave., Suite A3 (510) 222-4166  
Palo Alto, CA 94304 Fax (510) 222-6419

Leidos  
Leidoswood, Andrews  
& Newman, Inc.  
T-Y-LIN INTERNATIONAL  
APPROVED



LINE, TRACK, STATIONS AND SYSTEMS  
DESIGN UNIT 023  
MILPITAS STATION  
MAT FOUNDATION PLAN  
SHEET 6 OF 7

CADD FILENAME C700-S-DB-S076.dwg	CONTRACT NO. C700	REV. 0
SIZE D	SCALE 1/8" = 1'-0"	AREA CODE DB
SHEET NO. S076	PAGE NO. 0143	

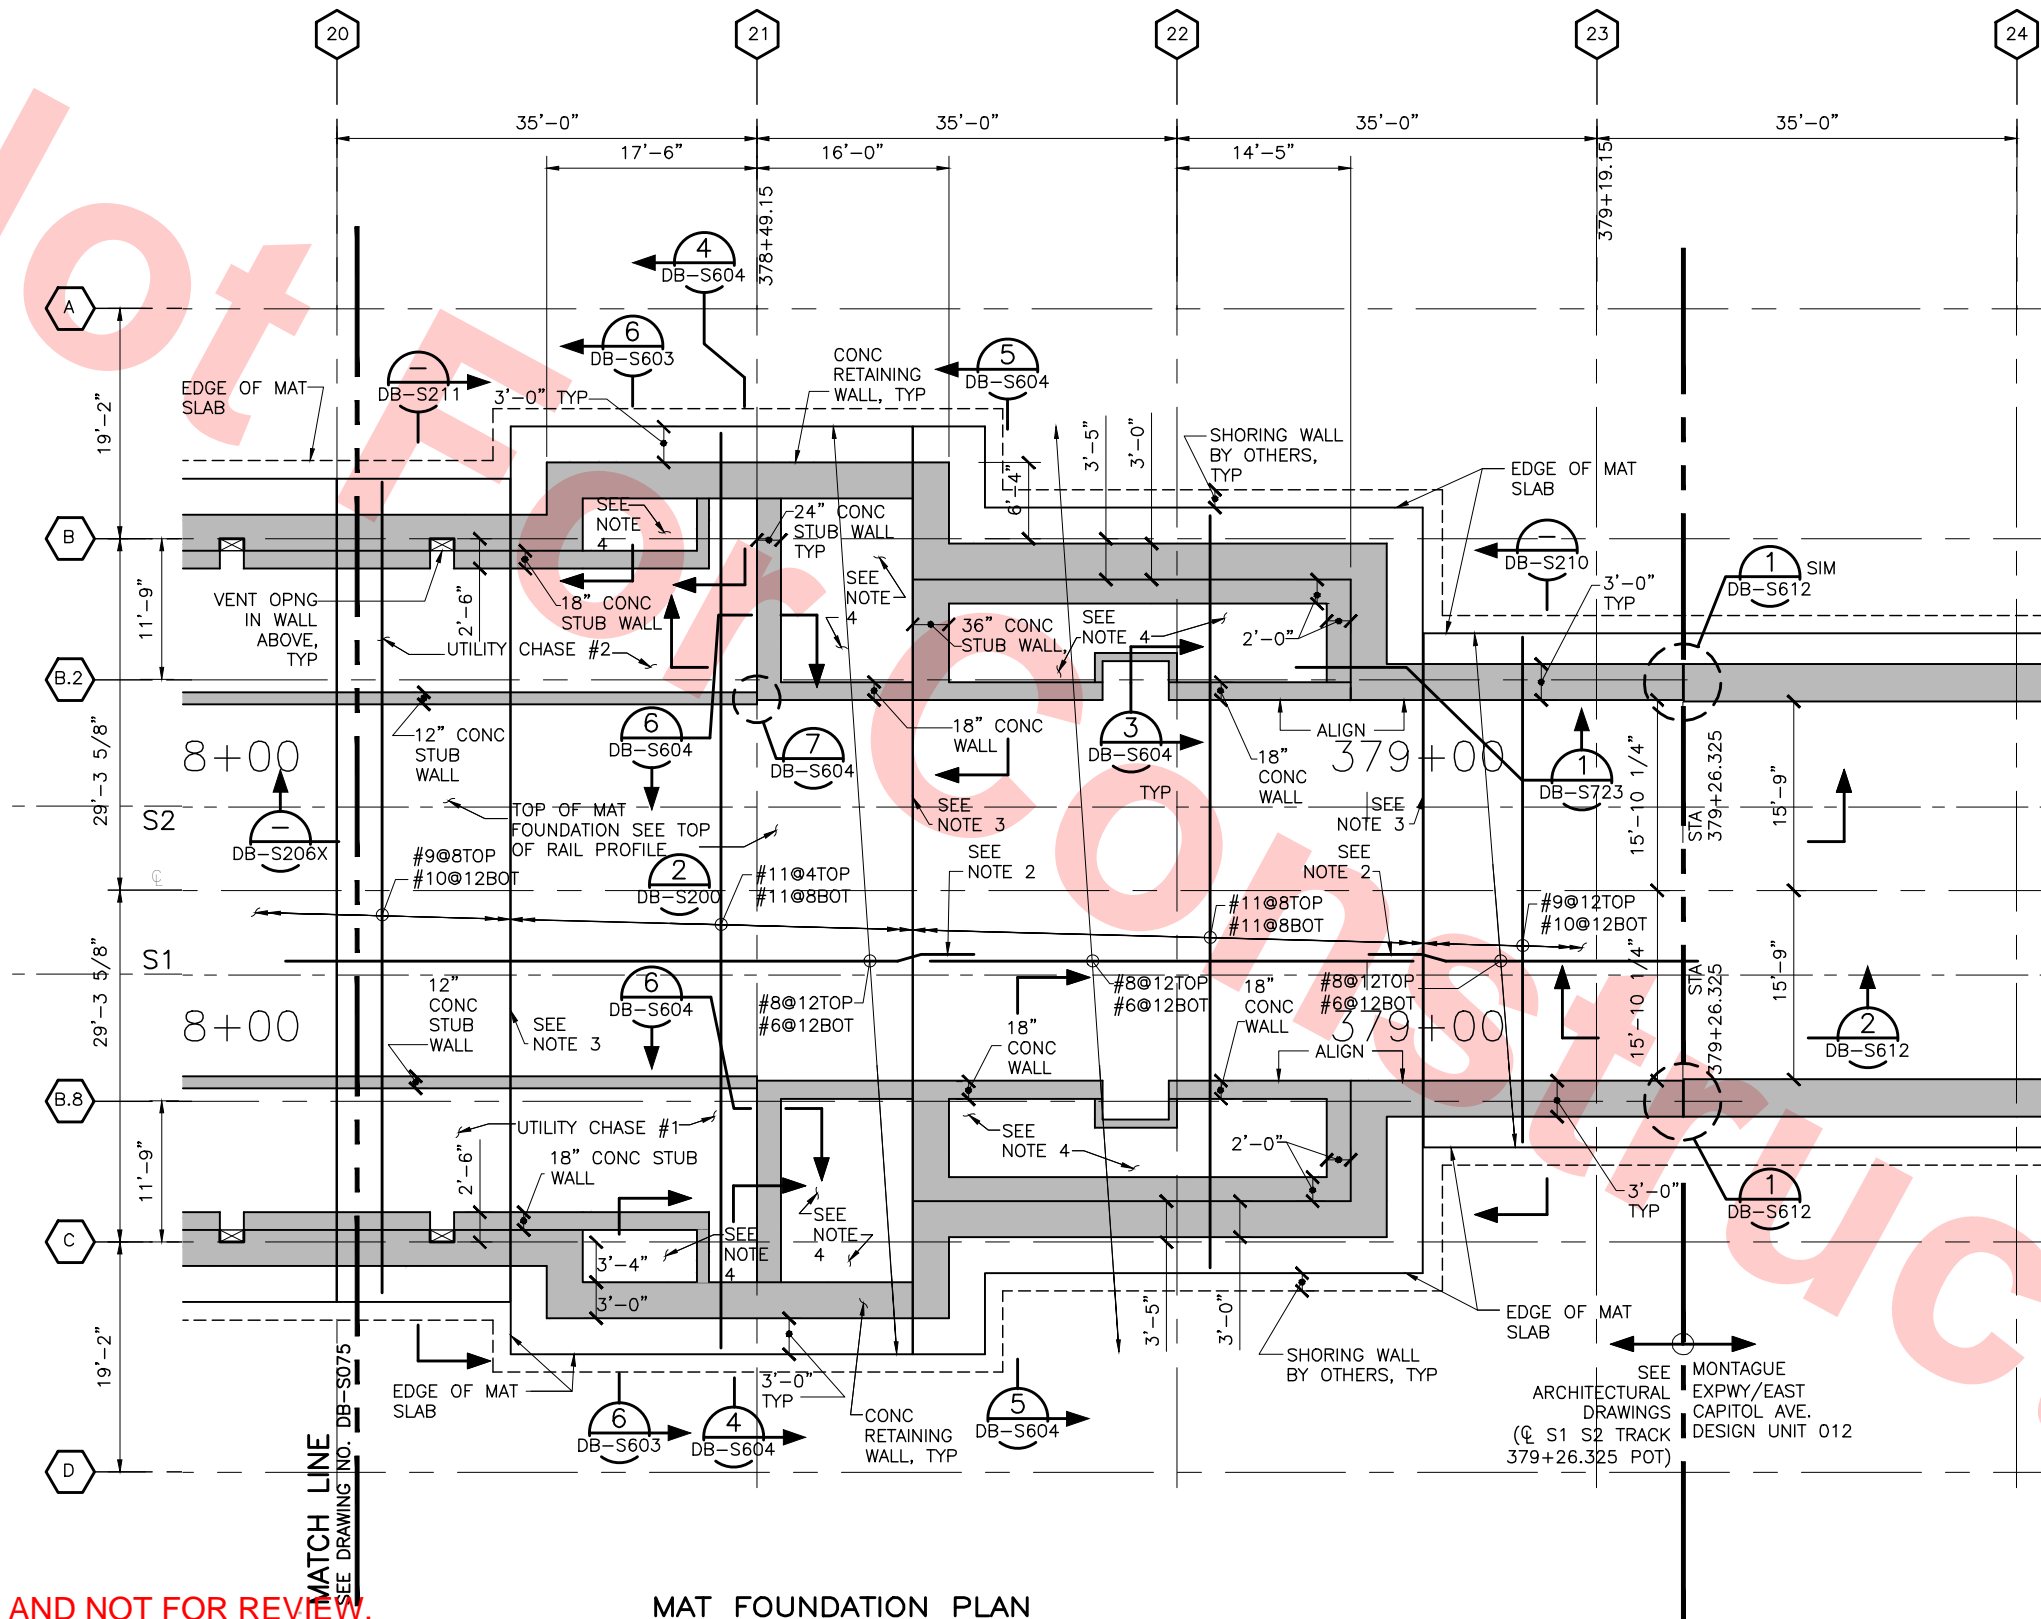


MAT FOUNDATION PLAN  
SCALE: 1/8"=1'-0"  
DB-S070

NOTES:

- FOR MAT FOUNDATION NOTES, SEE DWG DB-S071.
- LAP SPLICE SHALL BE PER SCHEDULE DB-S612
- CONSTRUCTION JOINT PER DRAWING DB-S612
- PROVIDE SLURRY CONCRETE UP TO BOTTOM OF PLATFORM SLAB





KEY PLAN

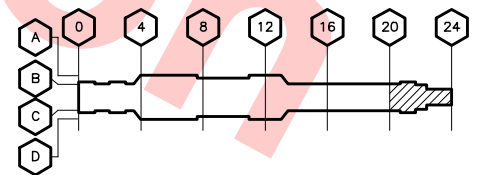





Jul 05, 2013 1:48pm P:\BART Berryessa Extension Line\AS - STRUCTURAL MILPITAS WORK\_E-10-2012\0700-S-DB-S077.dwg

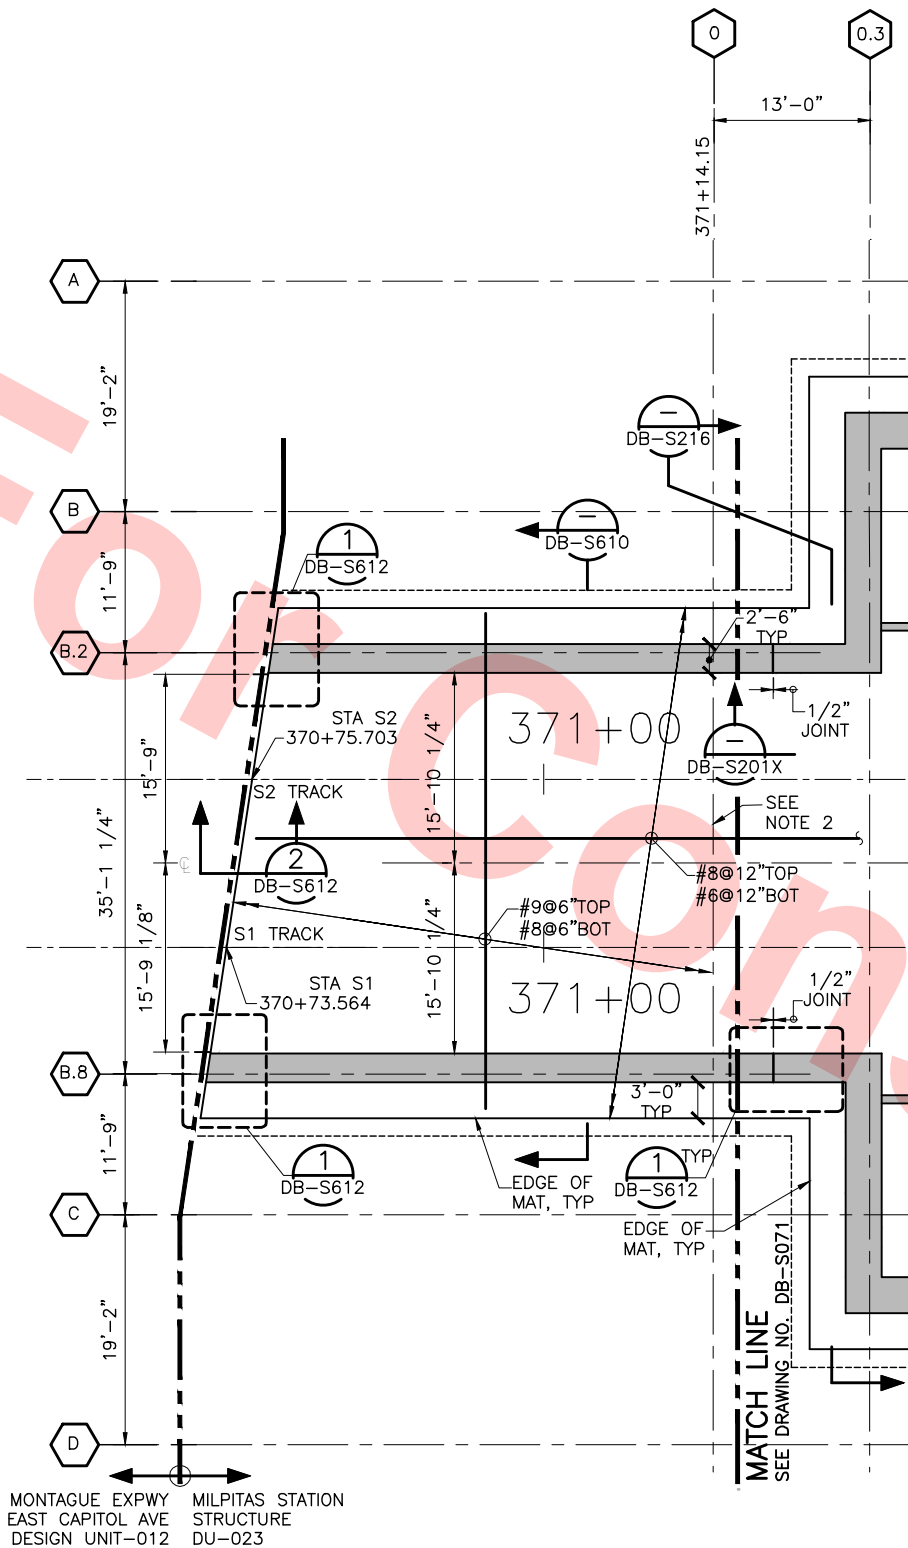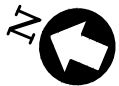

MAT FOUNDATION PLAN  
SCALE: 1/8" = 1'-0"  
DB-S070

- NOTES:
- FOR MAT FOUNDATION NOTES, SEE DWG NO DB-S071
  - CONSTRUCTION JOINT PER DWG NO 3  
DB-S612

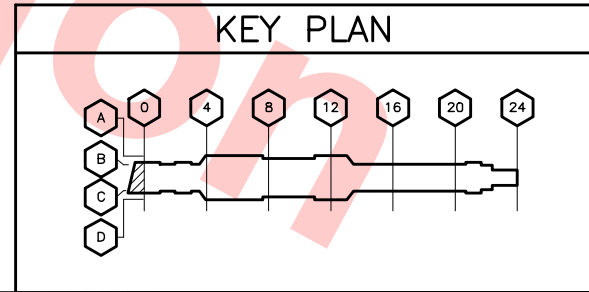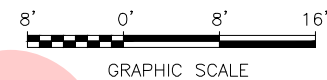

FOR REFERENCE ONLY AND NOT FOR REVIEW.  
THIS DRAWING WAS ALREADY SUBMITTED UNDER  
DU23-WP08 RFC TRENCH PACKAGE.

DESIGNED BY J. REBER, S.E.	
DRAWN BY P. DIAZ	
CHECKED BY M. TARAZI	
IN CHARGE M. TARAZI	
DATE 20130531	

REV	DATE	BY	SUB	APP	DESCRIPTION
0	20130531				READINESS FOR CONSTRUCTION



Skanska  
Shimmick  
Herzog

1436 California Circle  
Milpitas, California 95035  
A Joint Venture

MFT CONSULTING ENGINEERS, Inc. Anil Verma Associates, Inc.  
1773 San Pablo Ave., Suite A3 (510) 222-4166  
Palo Alto, CA 94304 Fax (510) 222-6418

Loeblwood, Andrews  
& Newman, Inc.  
A LEO A DALY COMPANY

T-Y-LIN INTERNATIONAL




LINE, TRACK, STATIONS AND SYSTEMS  
DESIGN UNIT 023  
MILPITAS STATION  
MAT FOUNDATION PLAN  
SHEET 7 OF 7

CADD FILENAME C700-S-DB-S077.dwg	
SIZE D	SCALE 1/8" = 1'-0"
CONTRACT NO. C700	REV. 0
AREA CODE DB	SHEET NO. S077
	PAGE NO. 0144



Jul 05, 2013 1:48pm P:\BART Berryessa Extension Line\AS - STRUCTURAL MILPITAS WORK\_E-10-2012\C700-S-DB-S110.dwg  
cod-02

FOR REFERENCE ONLY AND NOT FOR REVIEW.  
THIS DRAWING WAS ALREADY SUBMITTED UNDER  
DU23-WP08 RFC TRENCH PACKAGE.

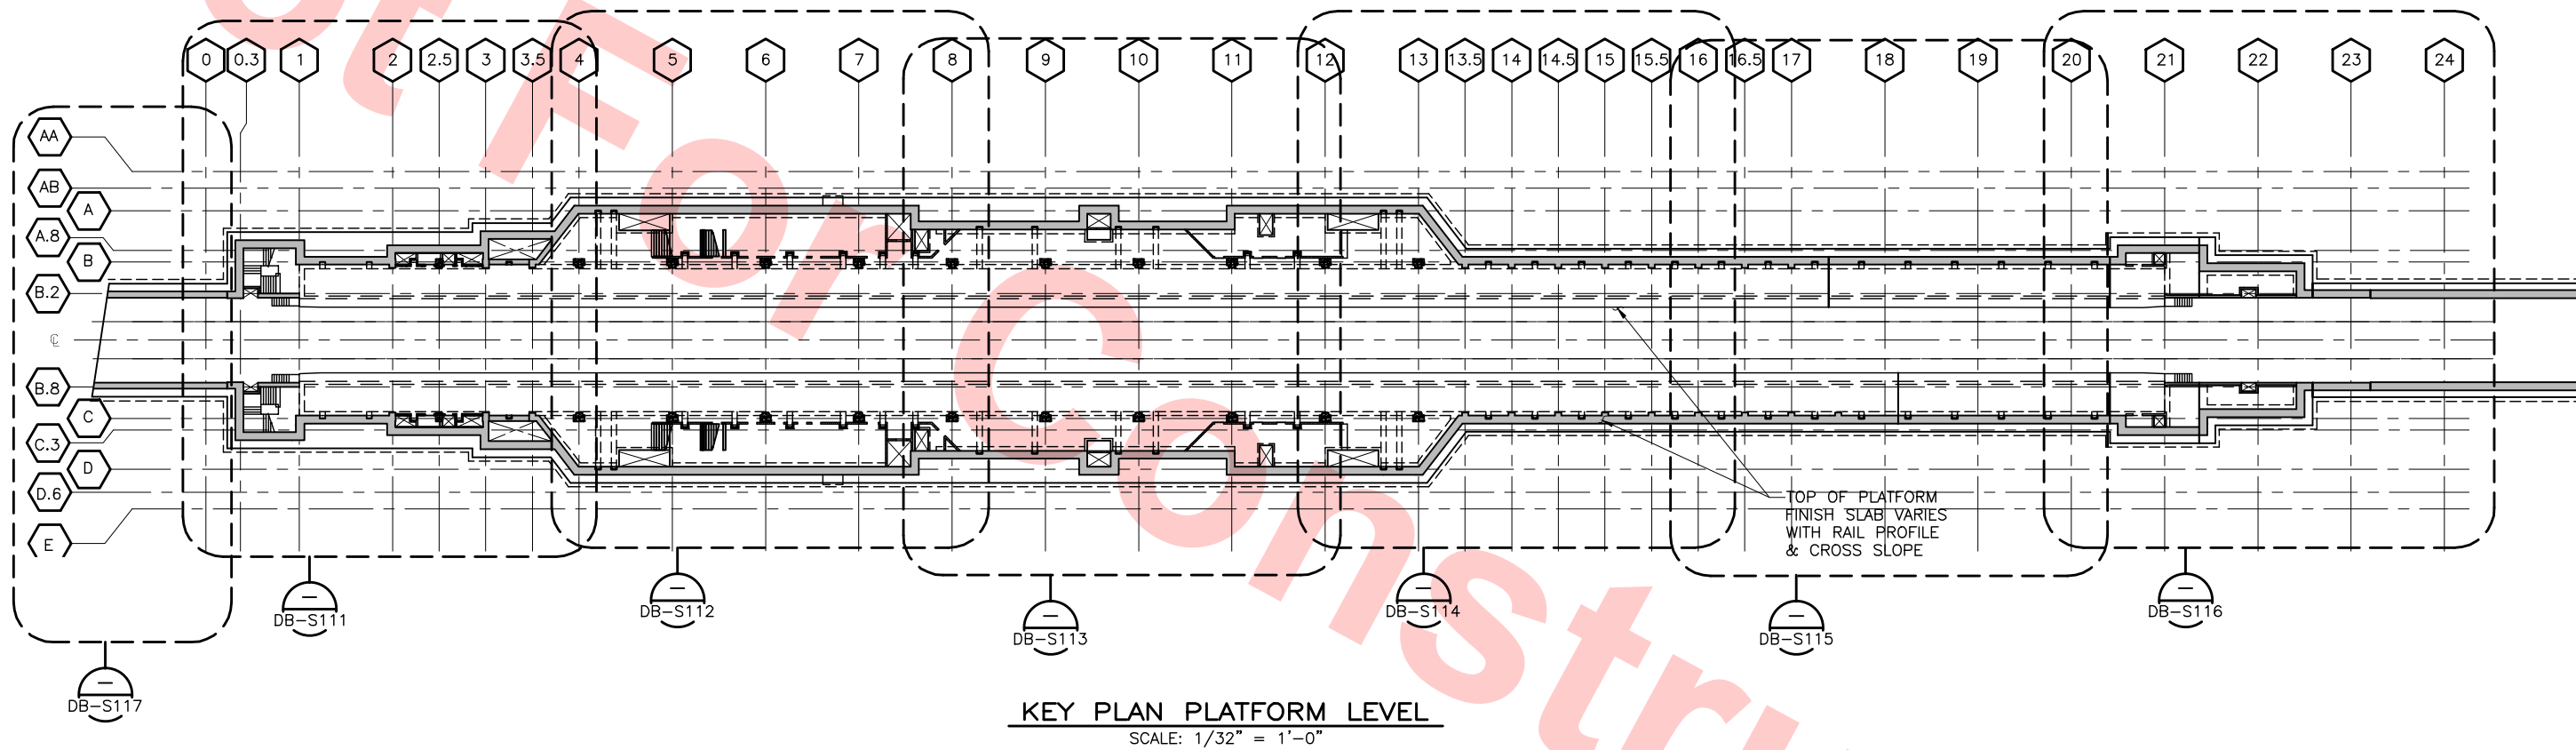

REV	DATE	BY	SUB	APP	DESCRIPTION
0	20130531				READINESS FOR CONSTRUCTION REPLACED C700-S-DB-S100 REV P.

DESIGNED BY  
J. REBER, S.E.  
DRAWN BY  
P. DIAZ  
CHECKED BY  
M. TARAZI  
IN CHARGE  
M. TARAZI  
DATE  
20130531



**Skanska Shimmick Herzog**

1436 California Circle  
Milpitas, California 95035  
A Joint Venture

**MFT CONSULTING ENGINEERS, Inc.** Anil Verma Associates, Inc.  
1773 San Pablo Ave., Suite A3 (510) 222-4106  
Pinole, CA 94664 Fax (510) 222-6419

**Lealwood, Andrews & Newman, Inc.**  
A LEO A DALY COMPANY


**T-Y-LIN INTERNATIONAL**




LINE, TRACK, STATIONS AND SYSTEMS  
DESIGN UNIT 023  
MILPITAS STATION  
PLATFORM LEVEL  
KEY PLAN

CADD FILENAME C700-S-DB-S110.dwg	REV. 0
SIZE D	SCALE 1/32" = 1'-0"
CONTRACT NO. C700	SHEET NO. S110
AREA CODE DB	PAGE NO. 0145



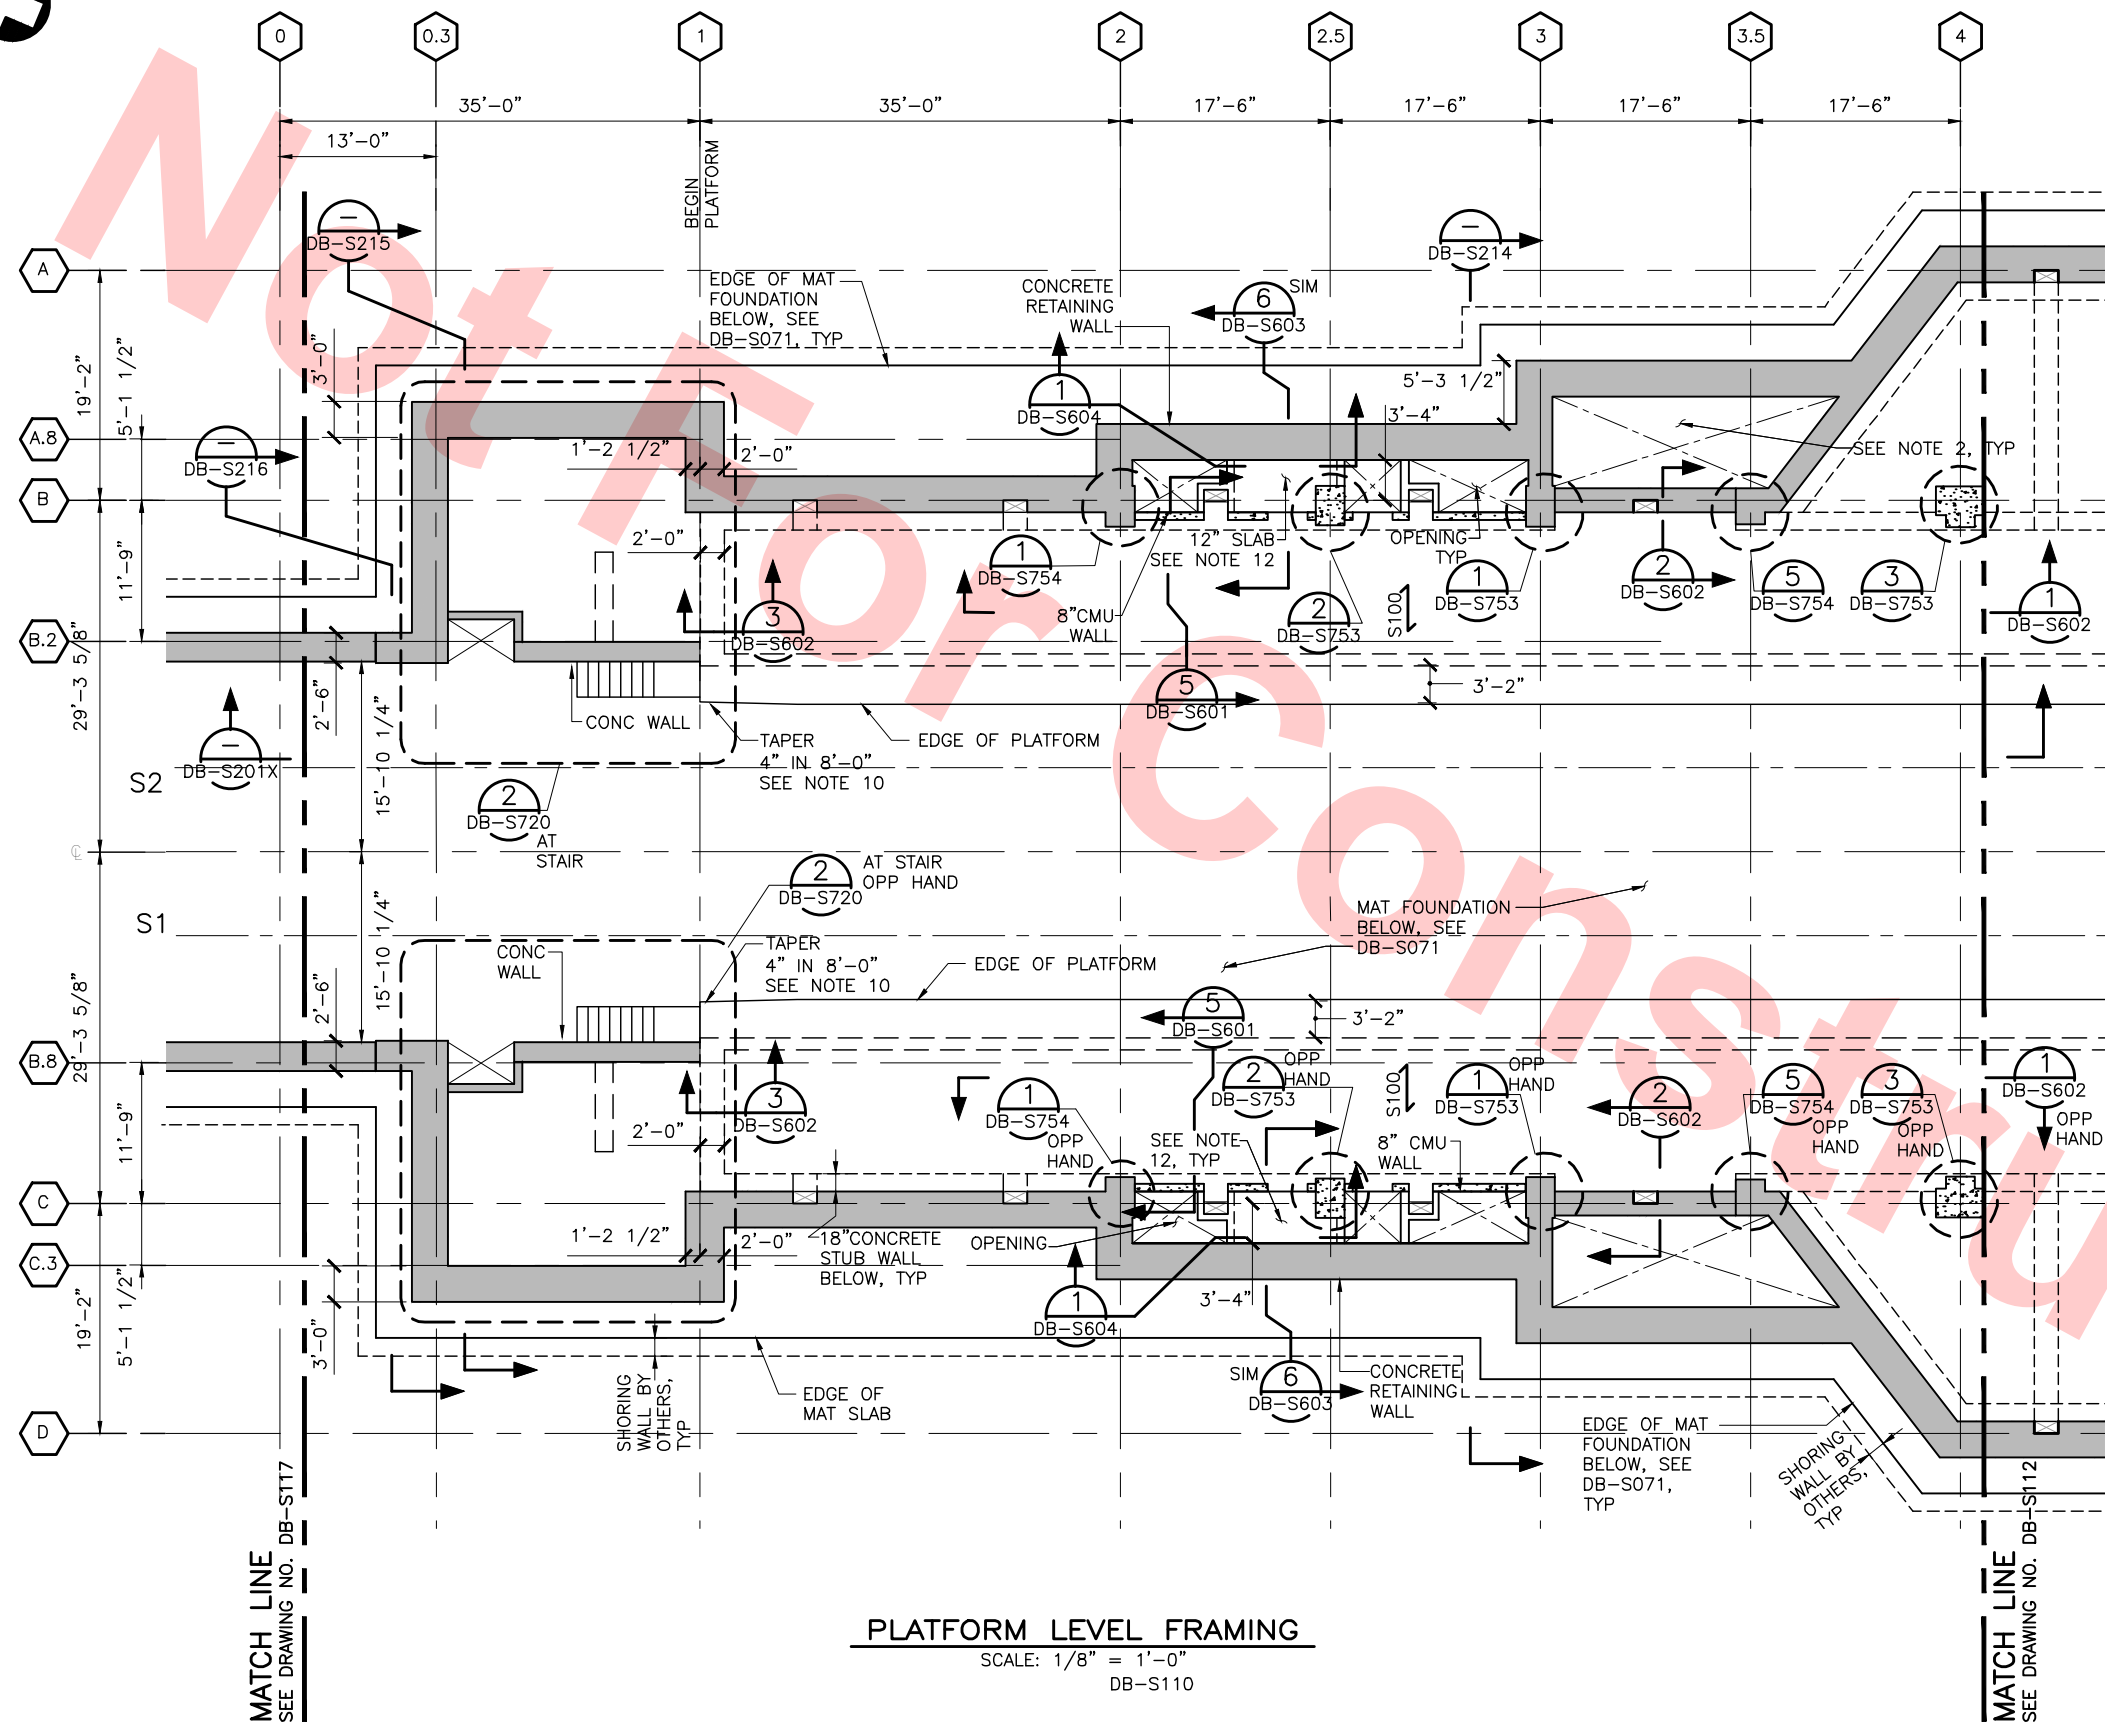


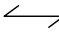1. TOP OF PLATFORM LEVEL FINISH FLOOR ELEVATION VARIES WITH TOP OF PROFILE AND CROSS SLOPE.
2. VERIFY ALL OPENINGS AND DIMENSIONS WITH ARCHITECTURAL DRAWINGS.
3. REFER TO GENERAL NOTES, LEGEND, AND ABBREVIATIONS ON DRAWINGS DB-S001X, DB-S002X, AND DB-S003X
4. CONTROL JOINTS ARE TO BE INSTALLED @ 20' OC MAX IN 8" SLAB, 12' OC MAX IN 5" SLAB OR AS SHOWN ON PLAN. CONTROL JOINTS SHALL BE MADE BY SAWCUTTING SLAB AS SOON AS THE SURFACE IS FIRM ENOUGH SO THAT IT WILL NOT BE DAMAGED BY THE BLADE, USUALLY WITHIN 4 TO 12 HOURS AFTER THE CONCRETE HARDENS (NO LATER THAN 24 HOURS AFTER PLACEMENT). SAWCUT DEPTH SHALL BE 1 1/2". CONSTRUCTION JOINTS MAY BE INSTALLED AT THE CONTRACTOR'S OPTION.
5. THE SIZE & LOCATION OF ALL FOOTING AND SLAB PENETRATIONS SHALL BE SUBMITTED TO THE EOR FOR REVIEW PRIOR TO INSTALLATION.
6. CONTRACTOR IS RESPONSIBLE FOR THE PLACEMENT OF ALL EMBEDDED ITEMS.
7. ALL DIMENSIONS ARE TO CENTERLINE OF COLUMNS OR FACE OF CONCRETE, TYP UNLESS NOTED OTHERWISE.
8. FOR FOOTINGS, DENOTED SEE SCHEDULE AND DETAILS ON DRAWING DB-S750.
9. FOR SUPPORTED SLABS, DENOTED  SEE SCHEDULE & DETAILS ON DRAWINGS DB-S761, DB-S762 & DB-S763. THE SYMBOL INDICATES THE DIRECTION OF THE MAIN REINFORCING.
10. SEE BART STANDARD DETAIL 5/AS42
11. 12" NORMAL WEIGHT CONC SLAB W/#4@16"OC TOP & BOT, EA WAY.
12. 12" CONC SLAB REINF W/#6@12" OC EACH WAY
13. FOR ALL CONCRETE COLUMNS: SIZE AND REINFORCEMENT SEE DB-751X AND DB-752X TYPICAL FOR ALL SHEETS


A horizontal graphic scale bar with four segments. The first segment is hatched and labeled '8'' above it. The second segment is solid black and labeled '0'' above it. The third segment is solid black and labeled '8'' above it. The fourth segment is white with a black outline and labeled '16'' above it.

GRAPHIC SCALE

## KEY PLAN

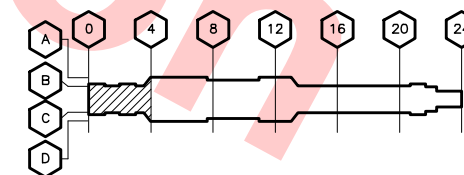

SCALE: 1/8" = 1'-0"



Skanska  
Shimmick  
Herzog

1436 California Circle  
Milpitas, California 95035  
A Joint Venture

**MFT CONSULTING ENGINEERS, INC.** Anil Verma Associates, Inc.  
1773 San Pablo Ave., Suite A3 (510) 222-4106  
Pinole, CA 94564 Fax (510) 222-6418

**LAN** Lookwood, Andrews & Newnam, Inc. **T-Y-LIN INTERNATIONAL**



BART SILICON VALLEY BERRYESSA EXTENSION

LINE, TRACK, STATIONS AND SYSTEMS  
DESIGN UNIT 023  
MILPITAS STATION  
PLATFORM LEVEL  
FRAMING PLAN  
SHEET 1 OF 7


CADD FILENAME C700-S-DB-S111.dwg		
SIZE D	SCALE 1/8" = 1'-0"	
CONTRACT NO. <b>C700</b>		REV. C
AREA CODE <b>DB</b>	SHEET NO. <b>S111</b>	PAGE NO. <b>0146</b>







Jul 05, 2013 - 1:49pm P:\BART Berryessa Extension Line\S - STRUCTURAL MILPITAS WORK\6-10-2012\0700-S-DB-S113.dwg  
c04-02

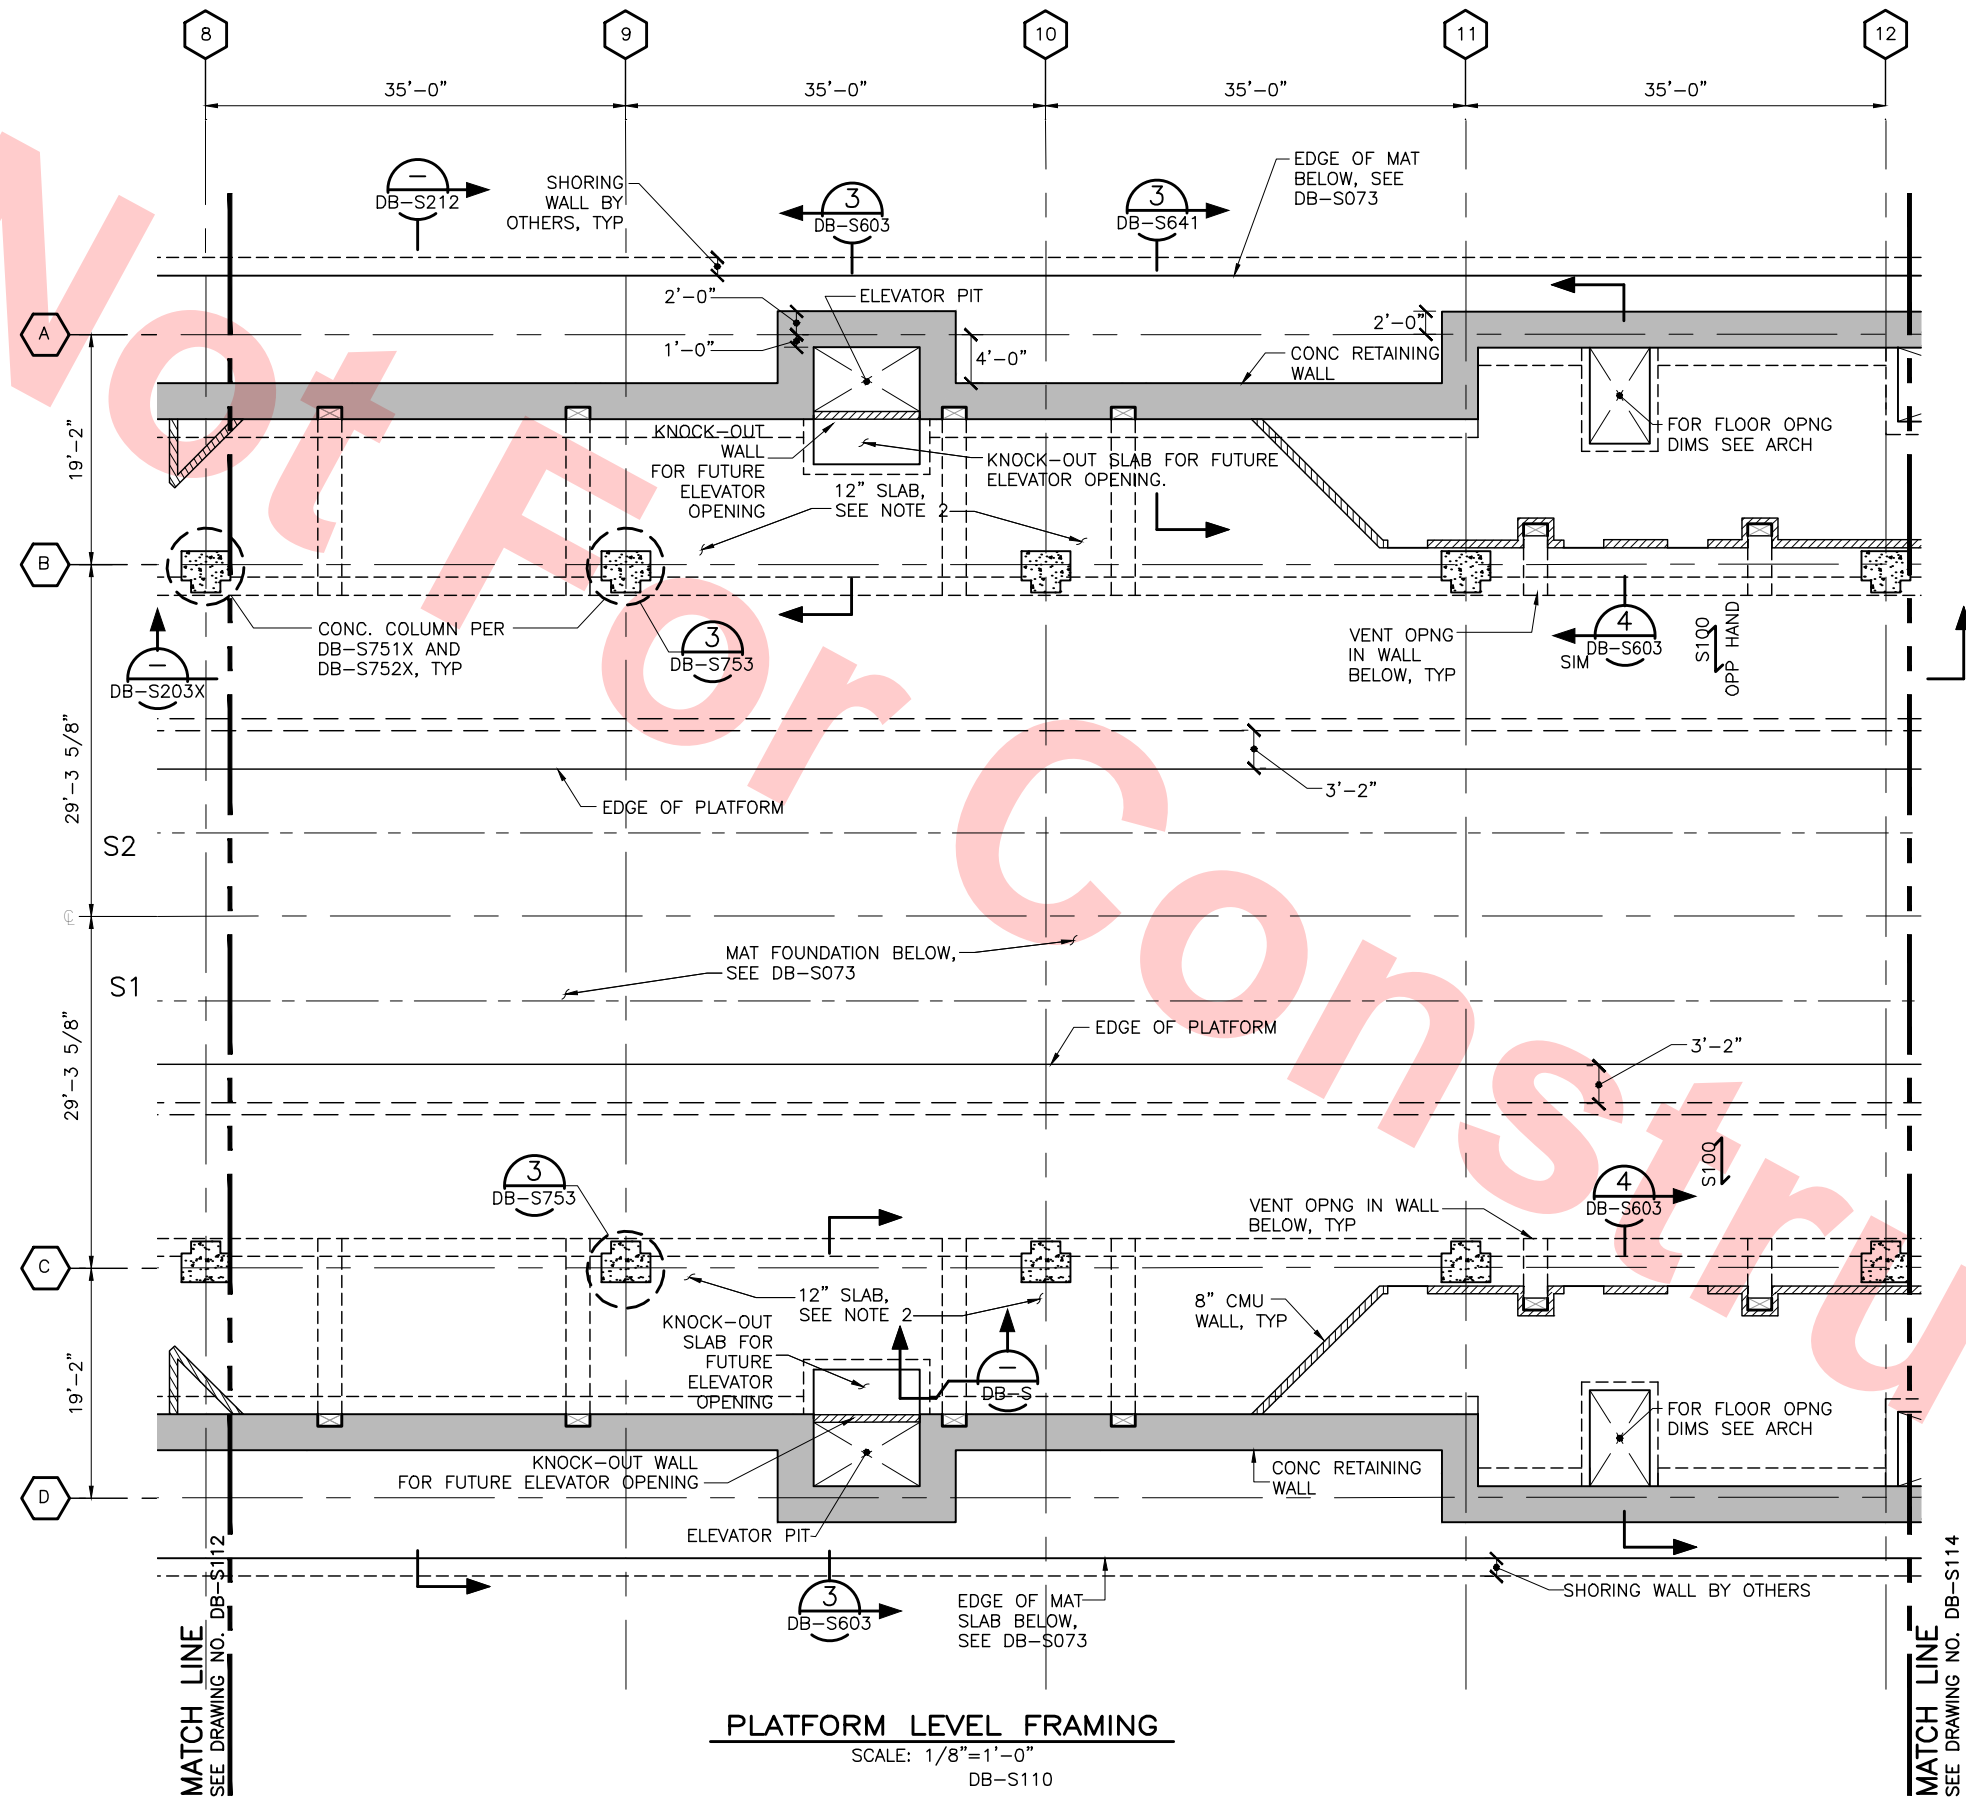


**NOTES:**

1. FOR PLATFORM LEVEL FRAMING NOTES, SEE DWG DB-S111.
2. 12" NORMAL WEIGHT CONC SLAB W/#4@16"OC TOP & BOT, EA WAY

FOR REFERENCE ONLY AND NOT FOR REVIEW.  
THIS DRAWING WAS ALREADY SUBMITTED UNDER  
DU23-WP08 RFC TRENCH PACKAGE.




**KEY PLAN**

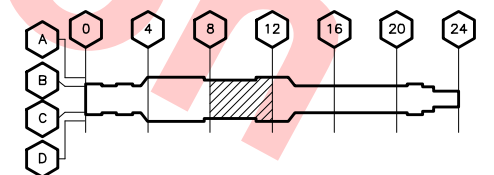


REV	DATE	BY	SUB	APP	DESCRIPTION
0	20130531				READINESS FOR CONSTRUCTION REPLACED C700-S-DB-S103 REV P.

DESIGNED BY  
J. REBER, S.E.  
DRAWN BY  
P. DIAZ  
CHECKED BY  
M. TARAZI  
IN CHARGE  
M. TARAZI  
DATE  
20130531

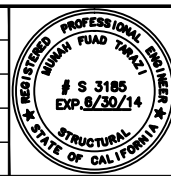

Skanska  
Shimmick  
Herzog  
1436 California Circle  
Milpitas, California 95035  
A Joint Venture  
MFT CONSULTING ENGINEERS, Inc. Anil Verma Associates, Inc.  
1773 San Pablo Ave., Suite A3 (510) 222-4106  
Pinole, CA 94664 Fax (510) 222-6419

Lealwood, Andrews  
& Newman, Inc.  
A LEO A DALY COMPANY  
T-Y-LIN INTERNATIONAL

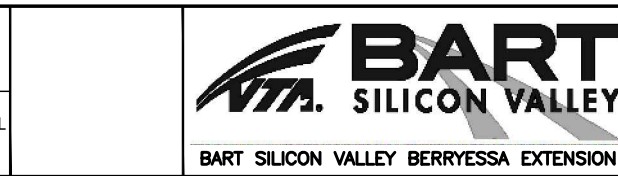

LINE, TRACK, STATIONS AND SYSTEMS DESIGN UNIT 023 MILPITAS STATION PLATFORM LEVEL FRAMING PLAN SHEET 3 OF 7				CADD FILENAME C700-S-DB-S113.dwg	
SIZE D		SCALE 1/8" = 1'-0"		CONTRACT NO. C700	
AREA CODE DB		SHEET NO. S113		REV. 0	
				PAGE NO. 0148	












NOTES:  
1. FOR PLATFORM LEVEL FRAMING NOTES, SEE DWG DB-S111.

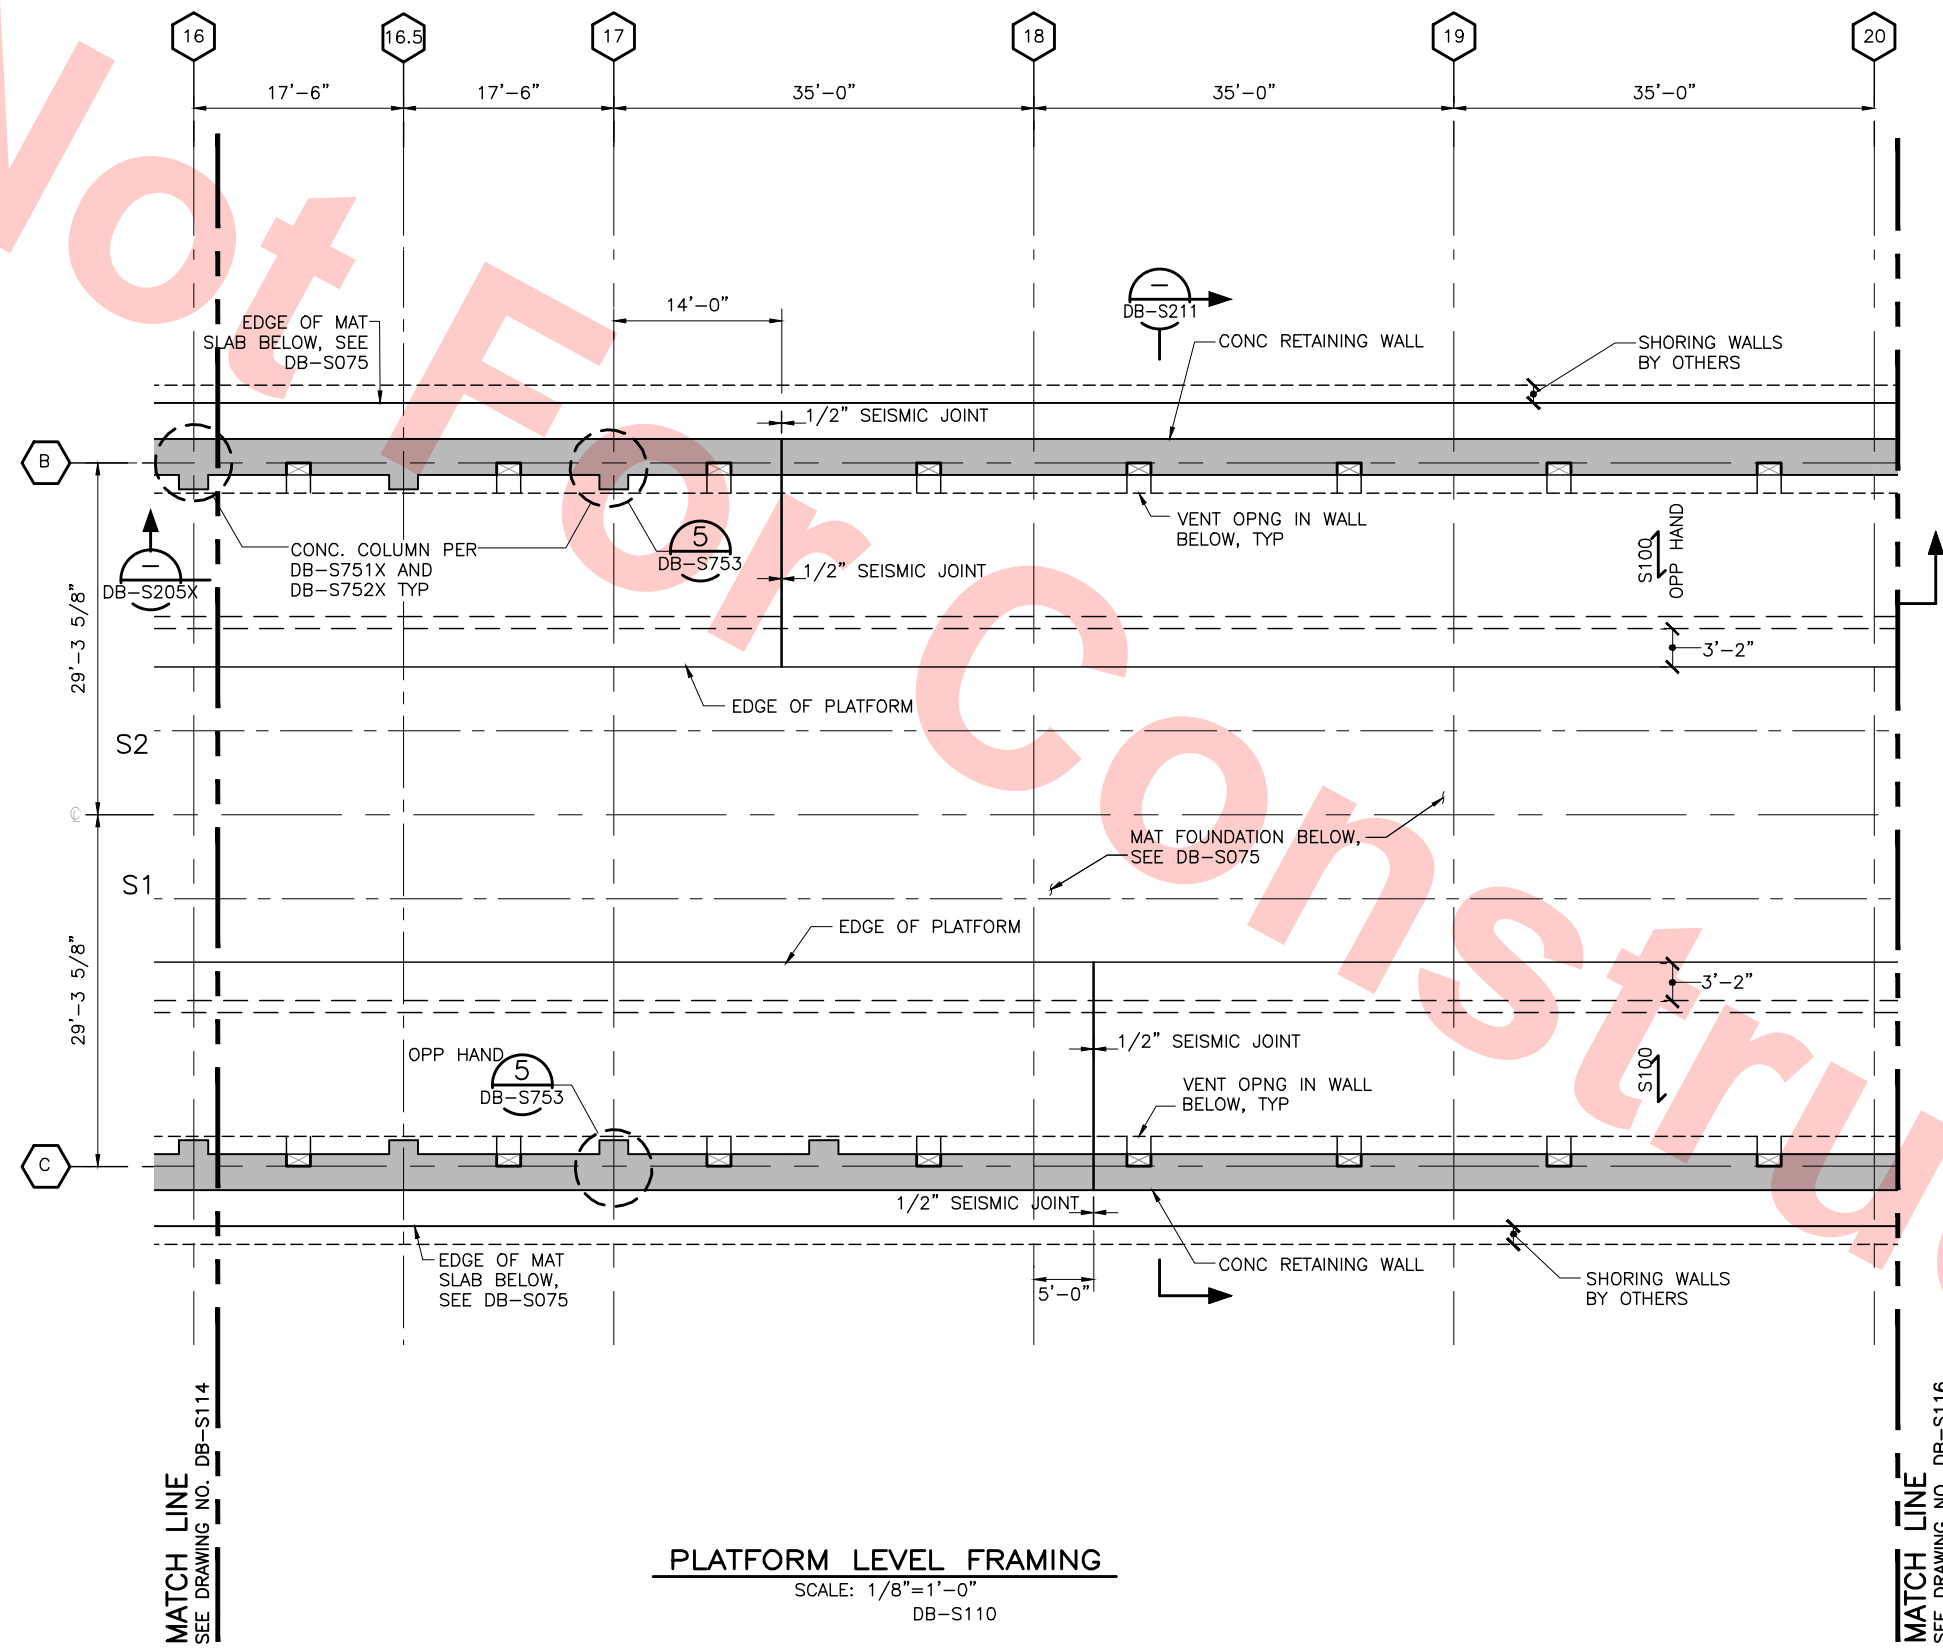

FOR REFERENCE ONLY AND NOT FOR REVIEW.  
THIS DRAWING WAS ALREADY SUBMITTED UNDER  
DU23-WP08 RFC TRENCH PACKAGE.

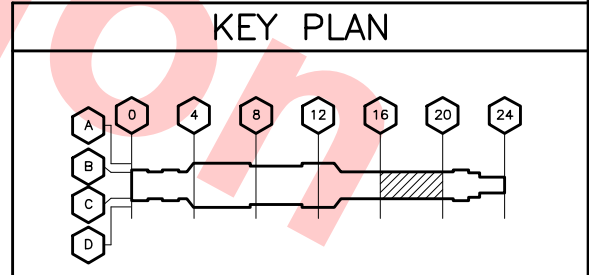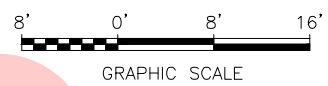


PLATFORM LEVEL FRAMING  
SCALE: 1/8"=1'-0"  
DB-S110

Jul 05, 2013 1:49pm P:\BART Berryessa Extension Line\A-S - STRUCTURAL MILPITAS WORK\6-10-2012\C700-S-DB-S115.dwg

REV	DATE	BY	SUB	APP	DESCRIPTION
0	20130531				READINESS FOR CONSTRUCTION REPLACED C700-S-DB-S105 REV P.

DESIGNED BY  
J. REBER, S.E.  
DRAWN BY  
P. DIAZ  
CHECKED BY  
M. TARAZI  
IN CHARGE  
M. TARAZI  
DATE  
20130531

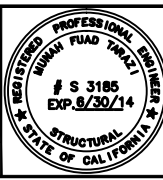

Skanska  
Shimmick  
Herzog  
1436 California Circle  
Milpitas, California 95035  
A Joint Venture  
MFT CONSULTING ENGINEERS, INC. Anil Verma Associates, Inc.  
1773 San Pablo Ave., Suite A3 (510) 222-4166  
Palo Alto, CA 94304 Fax (510) 222-6419


Lealwood, Andrews  
& Newman, Inc.  
A LEO A DALY COMPANY  
T-Y-LIN INTERNATIONAL  
APPROVED



LINE, TRACK, STATIONS AND SYSTEMS  
DESIGN UNIT 023  
MILPITAS STATION  
PLATFORM LEVEL  
FRAMING PLAN  
SHEET 5 OF 7

CADD FILENAME C700-S-DB-S115.dwg	REV. 0
SIZE D	SCALE 1/8" = 1'-0"
CONTRACT NO. C700	SHEET NO. S115
AREA CODE DB	PAGE NO. 0150



 


GRAPHIC SCALE

<b>LINE, TRACK, STATIONS AND SYSTEMS</b> <b>DESIGN UNIT 023</b> MILPITAS STATION PLATFORM LEVEL FRAMING PLAN SHEET 6 OF 7			CADD FILENAME C700-S-DB-S116.dwg	
SIZE D	SCALE 1/8" = 1'-0"			
CONTRACT NO.			C700	0
AREA CODE DB	SHEET NO. S116	PAGE NO. 0151		




Jul 05, 2013 - 1:49pm P:\BART Berryessa Extension Line\AS - STRUCTURAL MILPITAS WORK\_6-10-2012\C700-S-DB-S117.dwg


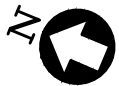


NOTES:

1. FOR MAT FOUNDATION NOTES, SEE DWG NO DB-S111

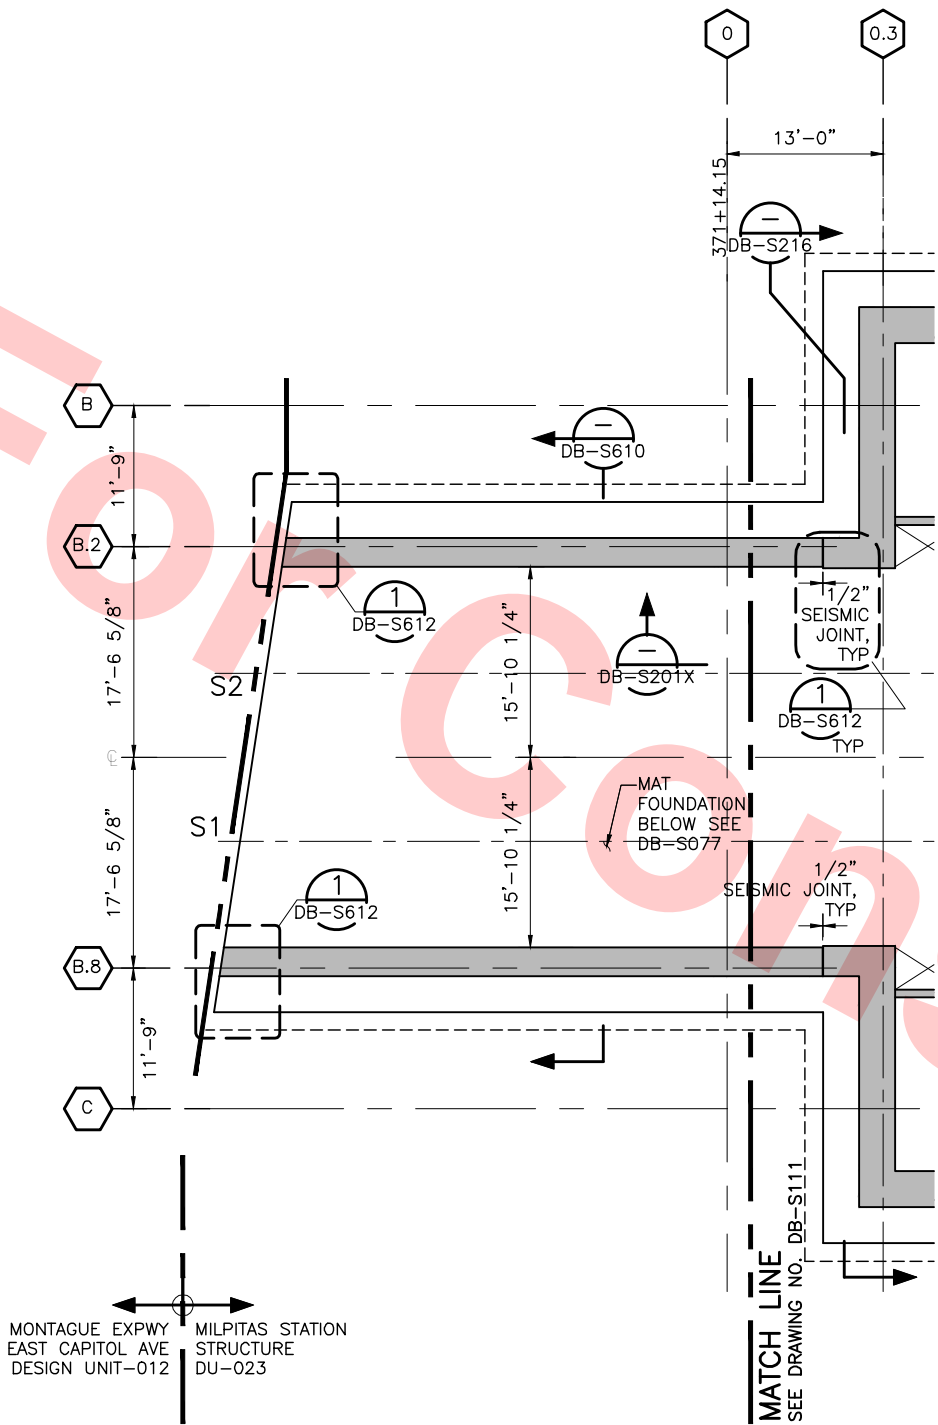

PLATFORM LEVEL FRAMING  
SCALE: 1/8"=1'-0"  
DB-S110

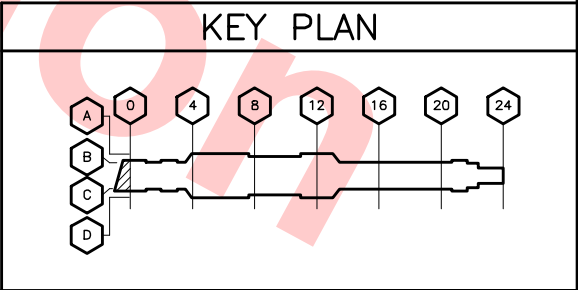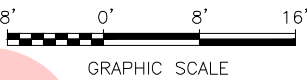

FOR REFERENCE ONLY AND NOT FOR REVIEW.  
THIS DRAWING WAS ALREADY SUBMITTED UNDER  
DU23-WP08 RFC TRENCH PACKAGE.

REV	DATE	BY	SUB	APP	DESCRIPTION
0	20130531				READINESS FOR CONSTRUCTION



**Skanska Shimmick Herzog**  
1436 California Circle  
Milpitas, California 95035  
A Joint Venture

**MFT CONSULTING ENGINEERS, INC.**  
1773 San Pablo Ave., Suite A3  
Pinole, CA 94664  
(910) 222-4106  
Fax (910) 222-6419

**Lealwood, Andrews & Newman, Inc.**  
A LEO A DALY COMPANY


**T-Y-LIN INTERNATIONAL**



LINE, TRACK, STATIONS AND SYSTEMS DESIGN UNIT 023 MILPITAS STATION PLATFORM LEVEL FRAMING PLAN SHEET 7 OF 7				CADD FILENAME C700-S-DB-S117.dwg	
SIZE D		SCALE 1/8" = 1'-0"		CONTRACT NO. C700	
AREA CODE DB		SHEET NO. S117		REV. 0	
				PAGE NO. 0152	



Jul 05, 2013 1:49pm P:\BART Berryessa Extension Line\AS - STRUCTURAL MILPITAS WORK\6-10-2012\C700-S-DB-S120.dwg

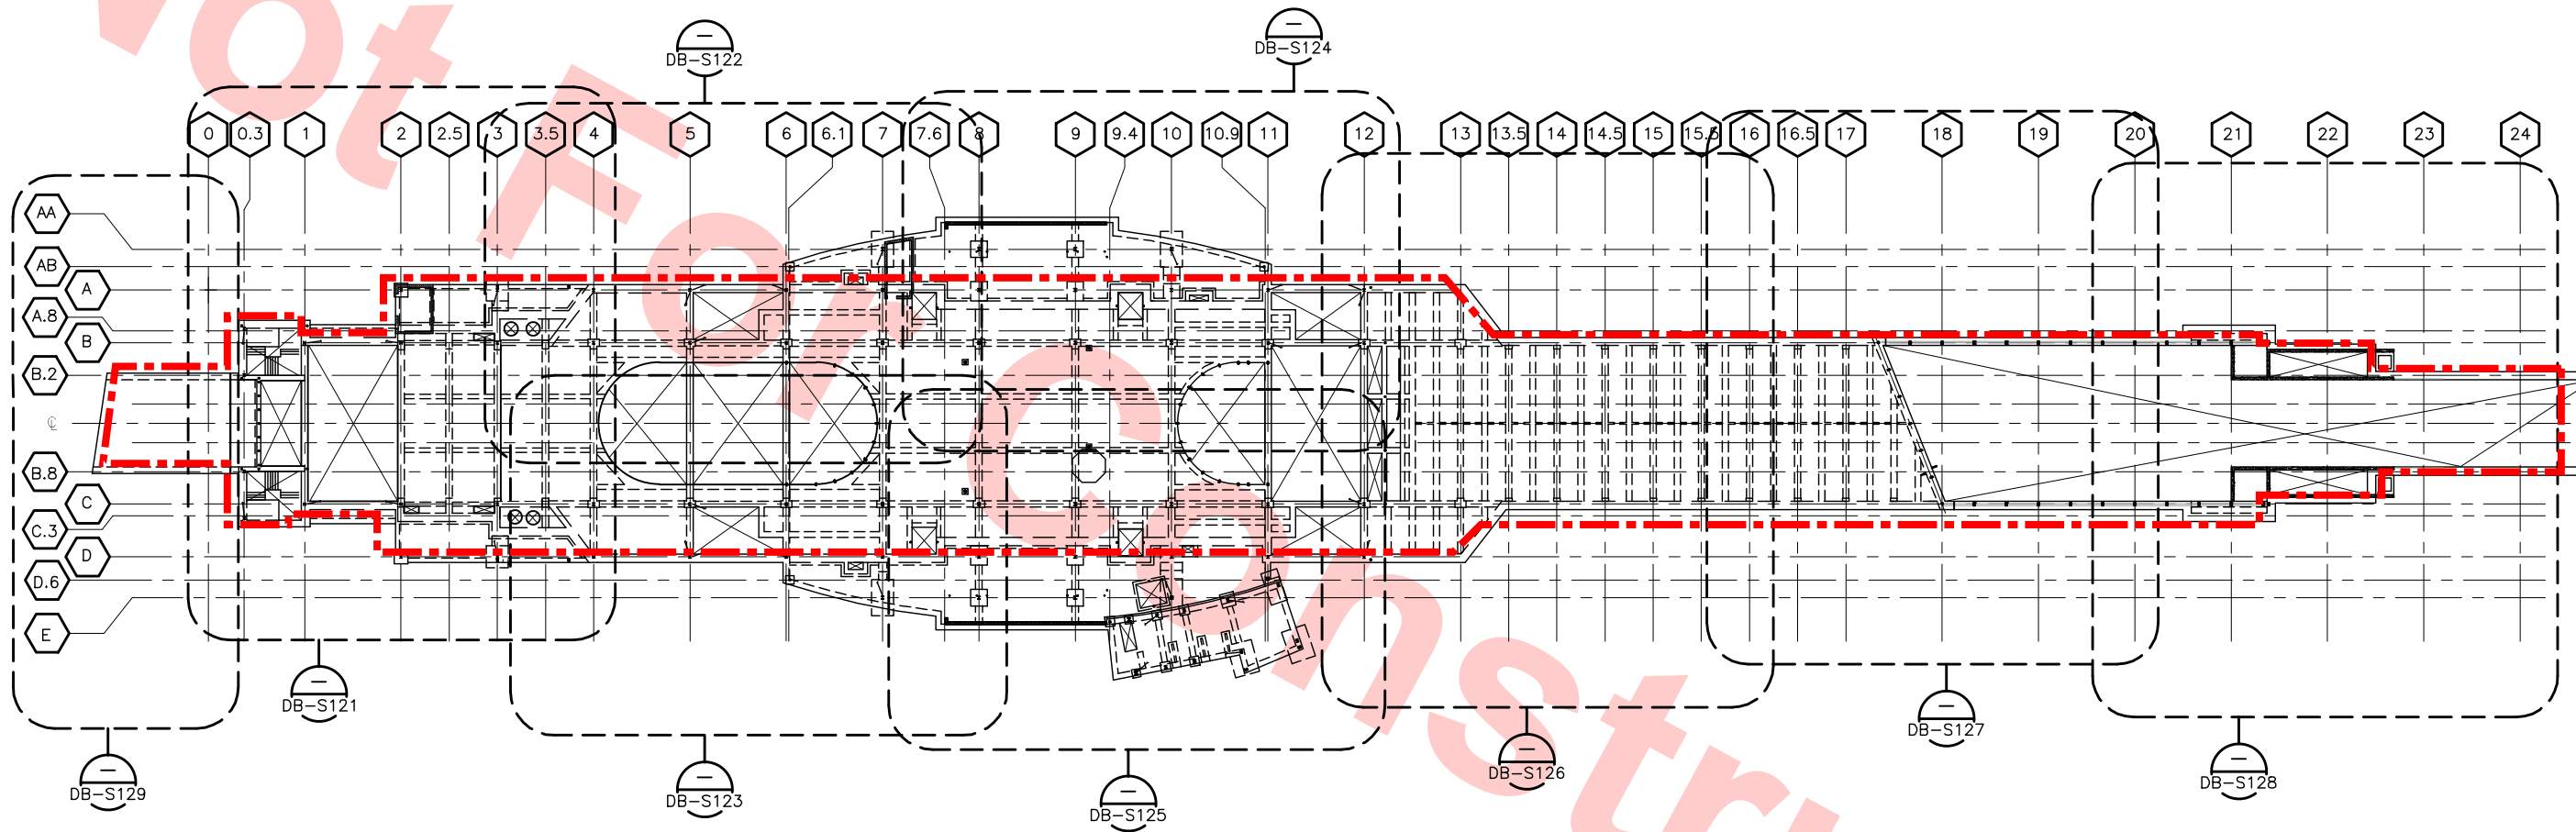

KEY PLAN FOUNDATION AND CONCOURSE FRAMING  
SCALE: 1/32" = 1'-0"

NOTE TO REVIEWER(S):  
DO NOT REVIEW AREAS DESIGNATED AS [REDACTED]

- Santa Clara Valley Transportation Authority
- NO EXCEPTIONS TAKEN (NET)
  - MAKE CORRECTIONS NOTED (MCN)
  - AMEND AND RESUBMIT (A/R)

Any action shown above is subject to the terms of the contract and does not relieve the Contractor of any of its obligations under the contract, including design and detailing.


Contract No.: DB11002F

By: \_\_\_\_\_ Date: \_\_\_\_\_



REV	DATE	BY	SUB	APP	DESCRIPTION
0	20130710				READINESS FOR CONSTRUCTION
0	20130531				READINESS FOR CONSTRUCTION

DESIGNED BY  
J. REBER, S.E.  
DRAWN BY  
P. DIAZ  
CHECKED BY  
M. TARAZI  
IN CHARGE  
M. TARAZI  
DATE  
20130531

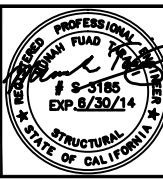

Skanska  
Shimmick  
Herzog  
1436 California Circle  
Milpitas, California 95035  
A Joint Venture  
MFT CONSULTING ENGINEERS, INC. Anil Verma Associates, Inc.  
1773 San Pablo Ave., Suite A3 (510) 222-4100  
Pittsburg, CA 94564 Fax (510) 222-9100


Lealwood, Andrews & Newman, Inc. T-Y-LIN INTERNATIONAL  
1436 California Circle  
Milpitas, California 95035  
A Joint Venture  
APPROVED [Signature]







LINE, TRACK, STATIONS AND SYSTEMS  
DESIGN UNIT 023  
MILPITAS STATION  
FOUNDATION AND CONCOURSE FRAMING  
KEY PLAN

CADD FILENAME	C700-S-DB-S120.dwg
SIZE	D
SCALE	1/32" = 1'-0"
CONTRACT NO.	C700
AREA CODE	DB
SHEET NO.	S120
PAGE NO.	0153
REV.	0




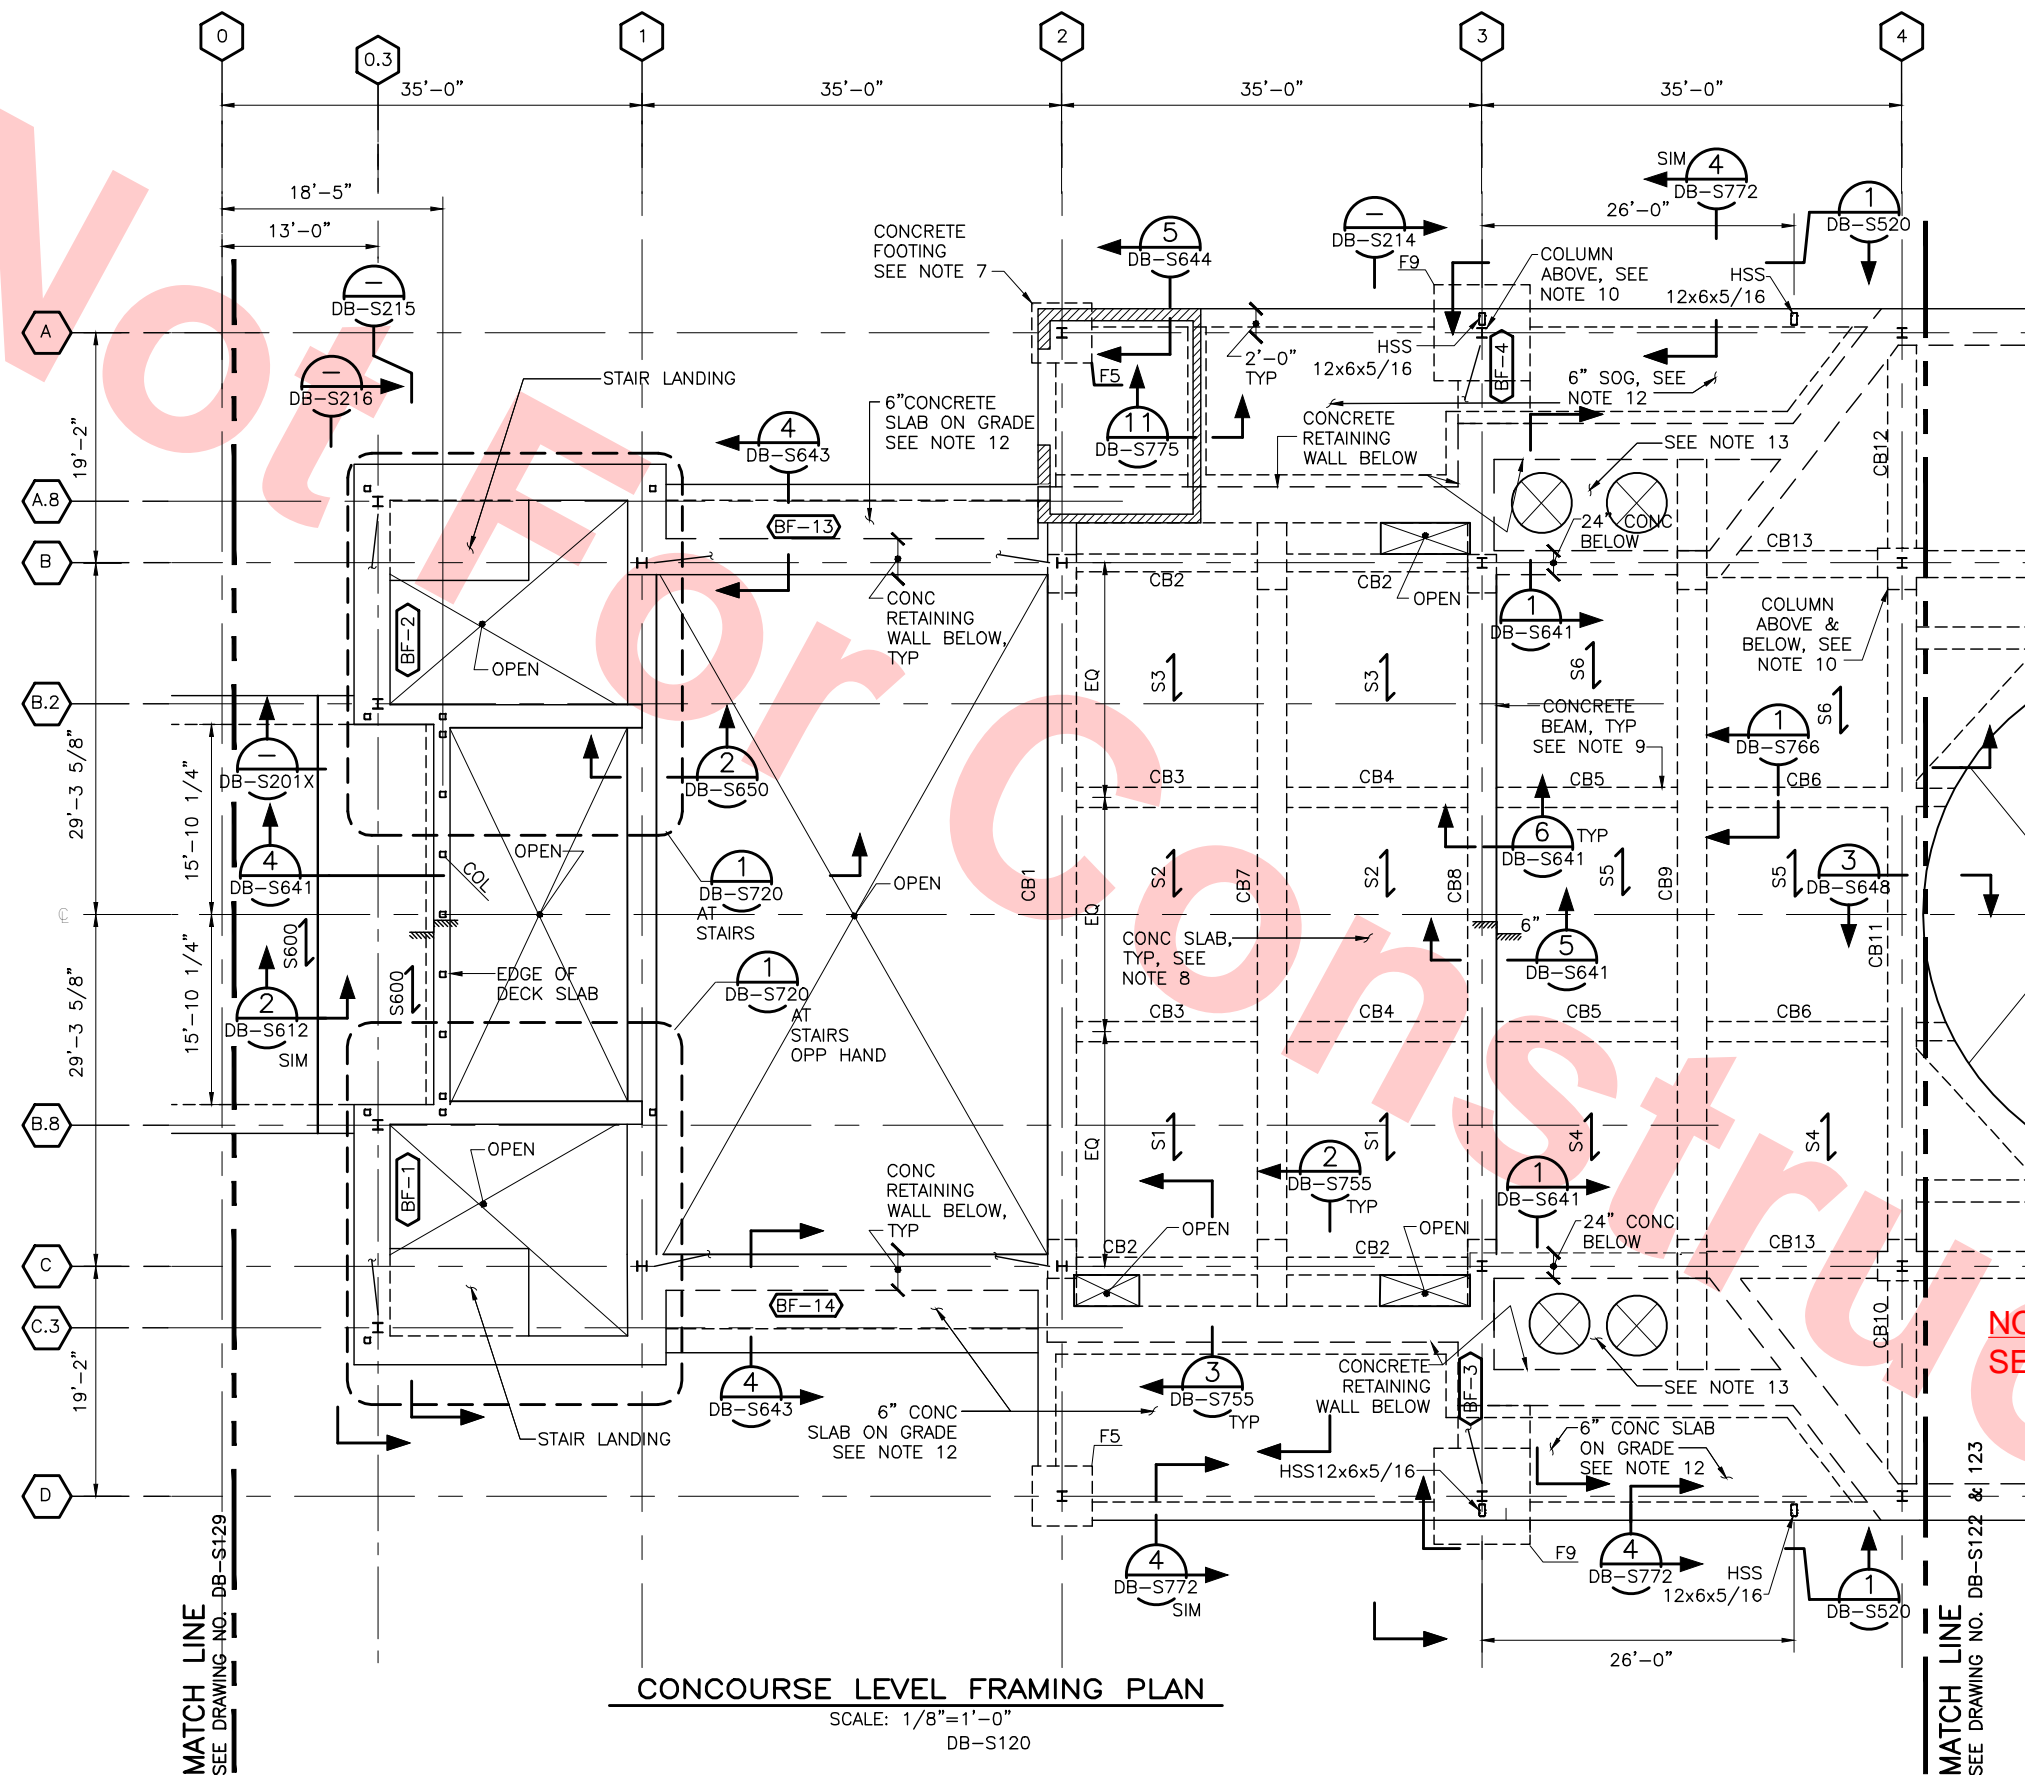


NOTES:

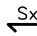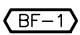 1. TOP OF CONCOURSE LEVEL, FINISH FLOOR ELEVATION,  $53'-6" = 0'-0"$  TYP, UNO.
2. VERIFY ALL OPENINGS AND DIMENSIONS WITH ARCHITECTURAL DRAWINGS.
3. REFER TO GENERAL NOTES, LEGEND, AND ABBREVIATIONS ON DRAWINGS DB-S001X, DB-S002X, AND DB-S003X.
4. CONTROL JOINTS FOR SLABS ON GRADE ARE TO BE INSTALLED @ 20' OC MAX IN 8" SLAB, 12' OC MAX IN 5" SLAB OR AS SHOWN ON PLAN. CONTROL JOINTS SHALL BE MADE BY SAWCUTTING SLAB AS SOON AS THE SURFACE IS FIRM ENOUGH SO THAT IT WILL NOT BE DAMAGED BY THE BLADE, USUALLY WITHIN 4 TO 12 HOURS AFTER THE CONCRETE HARDENS (NO LATER THAN 24 HOURS AFTER PLACEMENT). SAWCUT DEPTH SHALL BE 1 1/2". CONSTRUCTION JOINTS MAY BE INSTALLED AT THE CONTRACTOR'S OPTION.
5. CONTRACTOR IS RESPONSIBLE FOR THE PLACEMENT OF ALL EMBEDDED ITEMS.
6. ALL DIMENSIONS ARE TO CENTERLINE OF COLUMNS OR FACE OF CONCRETE, TYP UNLESS NOTED OTHERWISE.
7. FOR FOOTINGS, DENOTED  SEE SCHEDULE AND DETAILS ON DRAWING 1/DB-S750.
8. FOR SUPPORTED SLABS, DENOTED  SEE SCHEDULE & DETAILS ON DRAWINGS DB-S761 & DB-S762.
9. FOR CONCRETE BEAM/GIRDER, DENOTED CBxx SEE SCHEDULE ON DRAWING DB-S765 & S766
10. FOR ALL STEEL COLUMN AND BASE PLATE SIZES SEE DRAWING DB-S751X & DB-S752X.
11.  INDICATES BRACED FRAME ABOVE. SEE STEEL FRAMING ELEVATIONS DB-S501, DB-S502 & DB-S503 SHEETS.
12. SLAB-ON-GRADE TO BE REINFORCED W/ #4@16" OC EACH WAY, SEE DETAIL 
13. SLAB THICKNESS 14" REINFORCEMENT WITH #6@6" EA WAY, TOP & BOT.


**NOTE TO REVIEWER(S):**  
**SEE SHEET DB-S120 FOR AREAS NOT TO REVIEW**

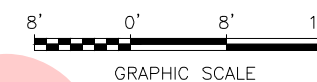

## KEY PLAN

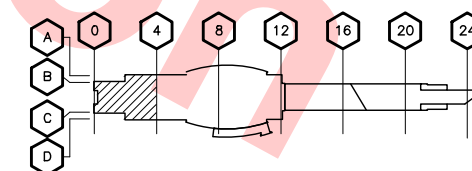

2013-05-06 2013-05-06 2013-05-06 2013-05-06 2013-05-06						DESIGNED BY J. REBER, S.E.
						DRAWN BY P. DIAZ
						CHECKED BY M. TARAZI
	0	20130531			READINESS FOR CONSTRUCTION	IN CHARGE M. TARAZI
					REPLACED C700-S-DB-S201 REV P.	
REV	DATE	BY	SUB	APP	DESCRIPTION	DATE 20130531

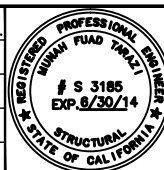

Skanska  
Shimmick  
Herzog

1436 California Circle  
Milpitas, California 95035  
A Joint Venture

**Lockwood, Andrews & Newnam, Inc.** | **T-Y-LIN INTERNATIONAL**

 


BART SILICON VALLEY BERRYESSA EXTENSION

LINE, TRACK, STATIONS AND SYSTEMS  
DESIGN UNIT 023  
MILPITAS STATION  
FOUNDATION AND CONCOURSE  
FRAMING PLAN  
SHEET 1 OF 9

CADD FILENAME C700-S-DB-S121.dwg		
SIZE D	SCALE 1/8" = 1'-0"	
CONTRACT NO. <b>C700</b>		REV.
AREA CODE <b>DB</b>	SHEET NO. <b>S121</b>	PAGE NO. <b>0154</b>





SCALE: 1/8"=1'-0"  
DB-S120

CADD FILENAME C700-S-DB-S122.dwg		
SIZE D	SCALE 1/8" = 1'-0"	
CONTRACT NO. <b>C700</b>		REV.
AREA CODE <b>DB</b>	SHEET NO. <b>S122</b>	PAGE NO. <b>0155</b>






1. FOR FOUNDATION AND CONCOURSE LEVEL FRAMING NOTES, SEE DWG DB-S121.
2. FOR LOCATION AND DETAILS OF COILING GRILLE SUPPORT COLUMNS SEE DRAWING DB-S691.
3. FOR ELEVATOR FRAMING PLANS SEE 1/DB-S135
4. SLAB THICKNESS IS 10" REINFORCEMENT W/#5@6 EW TOP & BOT.

**By:** \_\_\_\_\_ **Date:** \_\_\_\_\_

						DESIGNED BY J. REBER, S.E.
						DRAWN BY P. DIAZ
						CHECKED BY M. TARAZI
0	20130531				READINESS FOR CONSTRUCTION REPLACED C700-S-DB-S203 REV P.	IN CHARGE M. TARAZI
REV	DATE	BY	SUB	APP	DESCRIPTION	DATE 20130531

DESIGNED BY	J. REBER, S.E.
DRAWN BY	P. DIAZ
CHECKED BY	M. TARAZI
IN CHARGE	M. TARAZI
DATE	20130531

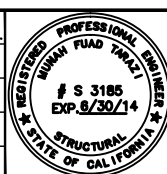

Skanska  
Shimmick  
Herzog

**MFT CONSULTING ENGINEERS, INC.** Anil Verma Associates, Inc.  
1773 San Pablo Ave., Suite A3 (510) 222-4106  
Pinole, CA 94564 Fax (510) 222-6418

**SUBMITTED**

**LEN** Lockwood, Andrews & Newnam, Inc.  
A LEO A. BALT COMPANY

**T-Y-LIN INTERNATIONAL**

APPROVED \_\_\_\_\_



BART SILICON VALLEY BERRYESSA EXTENSION

LINE, TRACK, STATIONS AND SYSTEMS  
DESIGN UNIT 023  
MILPITAS STATION  
FOUNDATION AND CONCOURSE  
FRAMING PLAN  
SHEET 3 OF 9

CADD FILENAME C700-S-DB-S123.dwg		
SIZE D	SCALE 1/8" = 1'-0"	
CONTRACT NO. <b>C700</b>		REV.
AREA CODE <b>DB</b>	SHEET NO. <b>S123</b>	PAGE NO. <b>0156</b>





NOTES:

1. FOR FOUNDATION AND CONCOURSE LEVEL FRAMING NOTES, SEE DWG DB-S121.
2. FOR DETAILS OF COILING GRILLE SUPPORT COLUMNS SEE DRAWING DB-S692.
3. KNOCK-OUT SLAB FOR FUTURE ELEVATOR OPENING.
4. SQUARE HSS ARE SLANTED. LOCATE PER ARCHITECTURAL DRAWING AND MANUFACTURER REQUIREMENTS.
5. SLAB THICKNESS IS 10" REINFORCEMENT W/#5@6" EW TOP & BOT.

015


Santa Clara Valley Transportation Authority

NO EXCEPTIONS TAKEN (NET)  
MAKE CORRECTIONS NOTED (MCN)  
AMEND AND RESUBMIT (A/R)

Any action shown above is subject to the terms of the contract and does not relieve the Contractor of any of its obligations under the contract, including design and detailing.

Contract No.: DB11002F


By: Date:

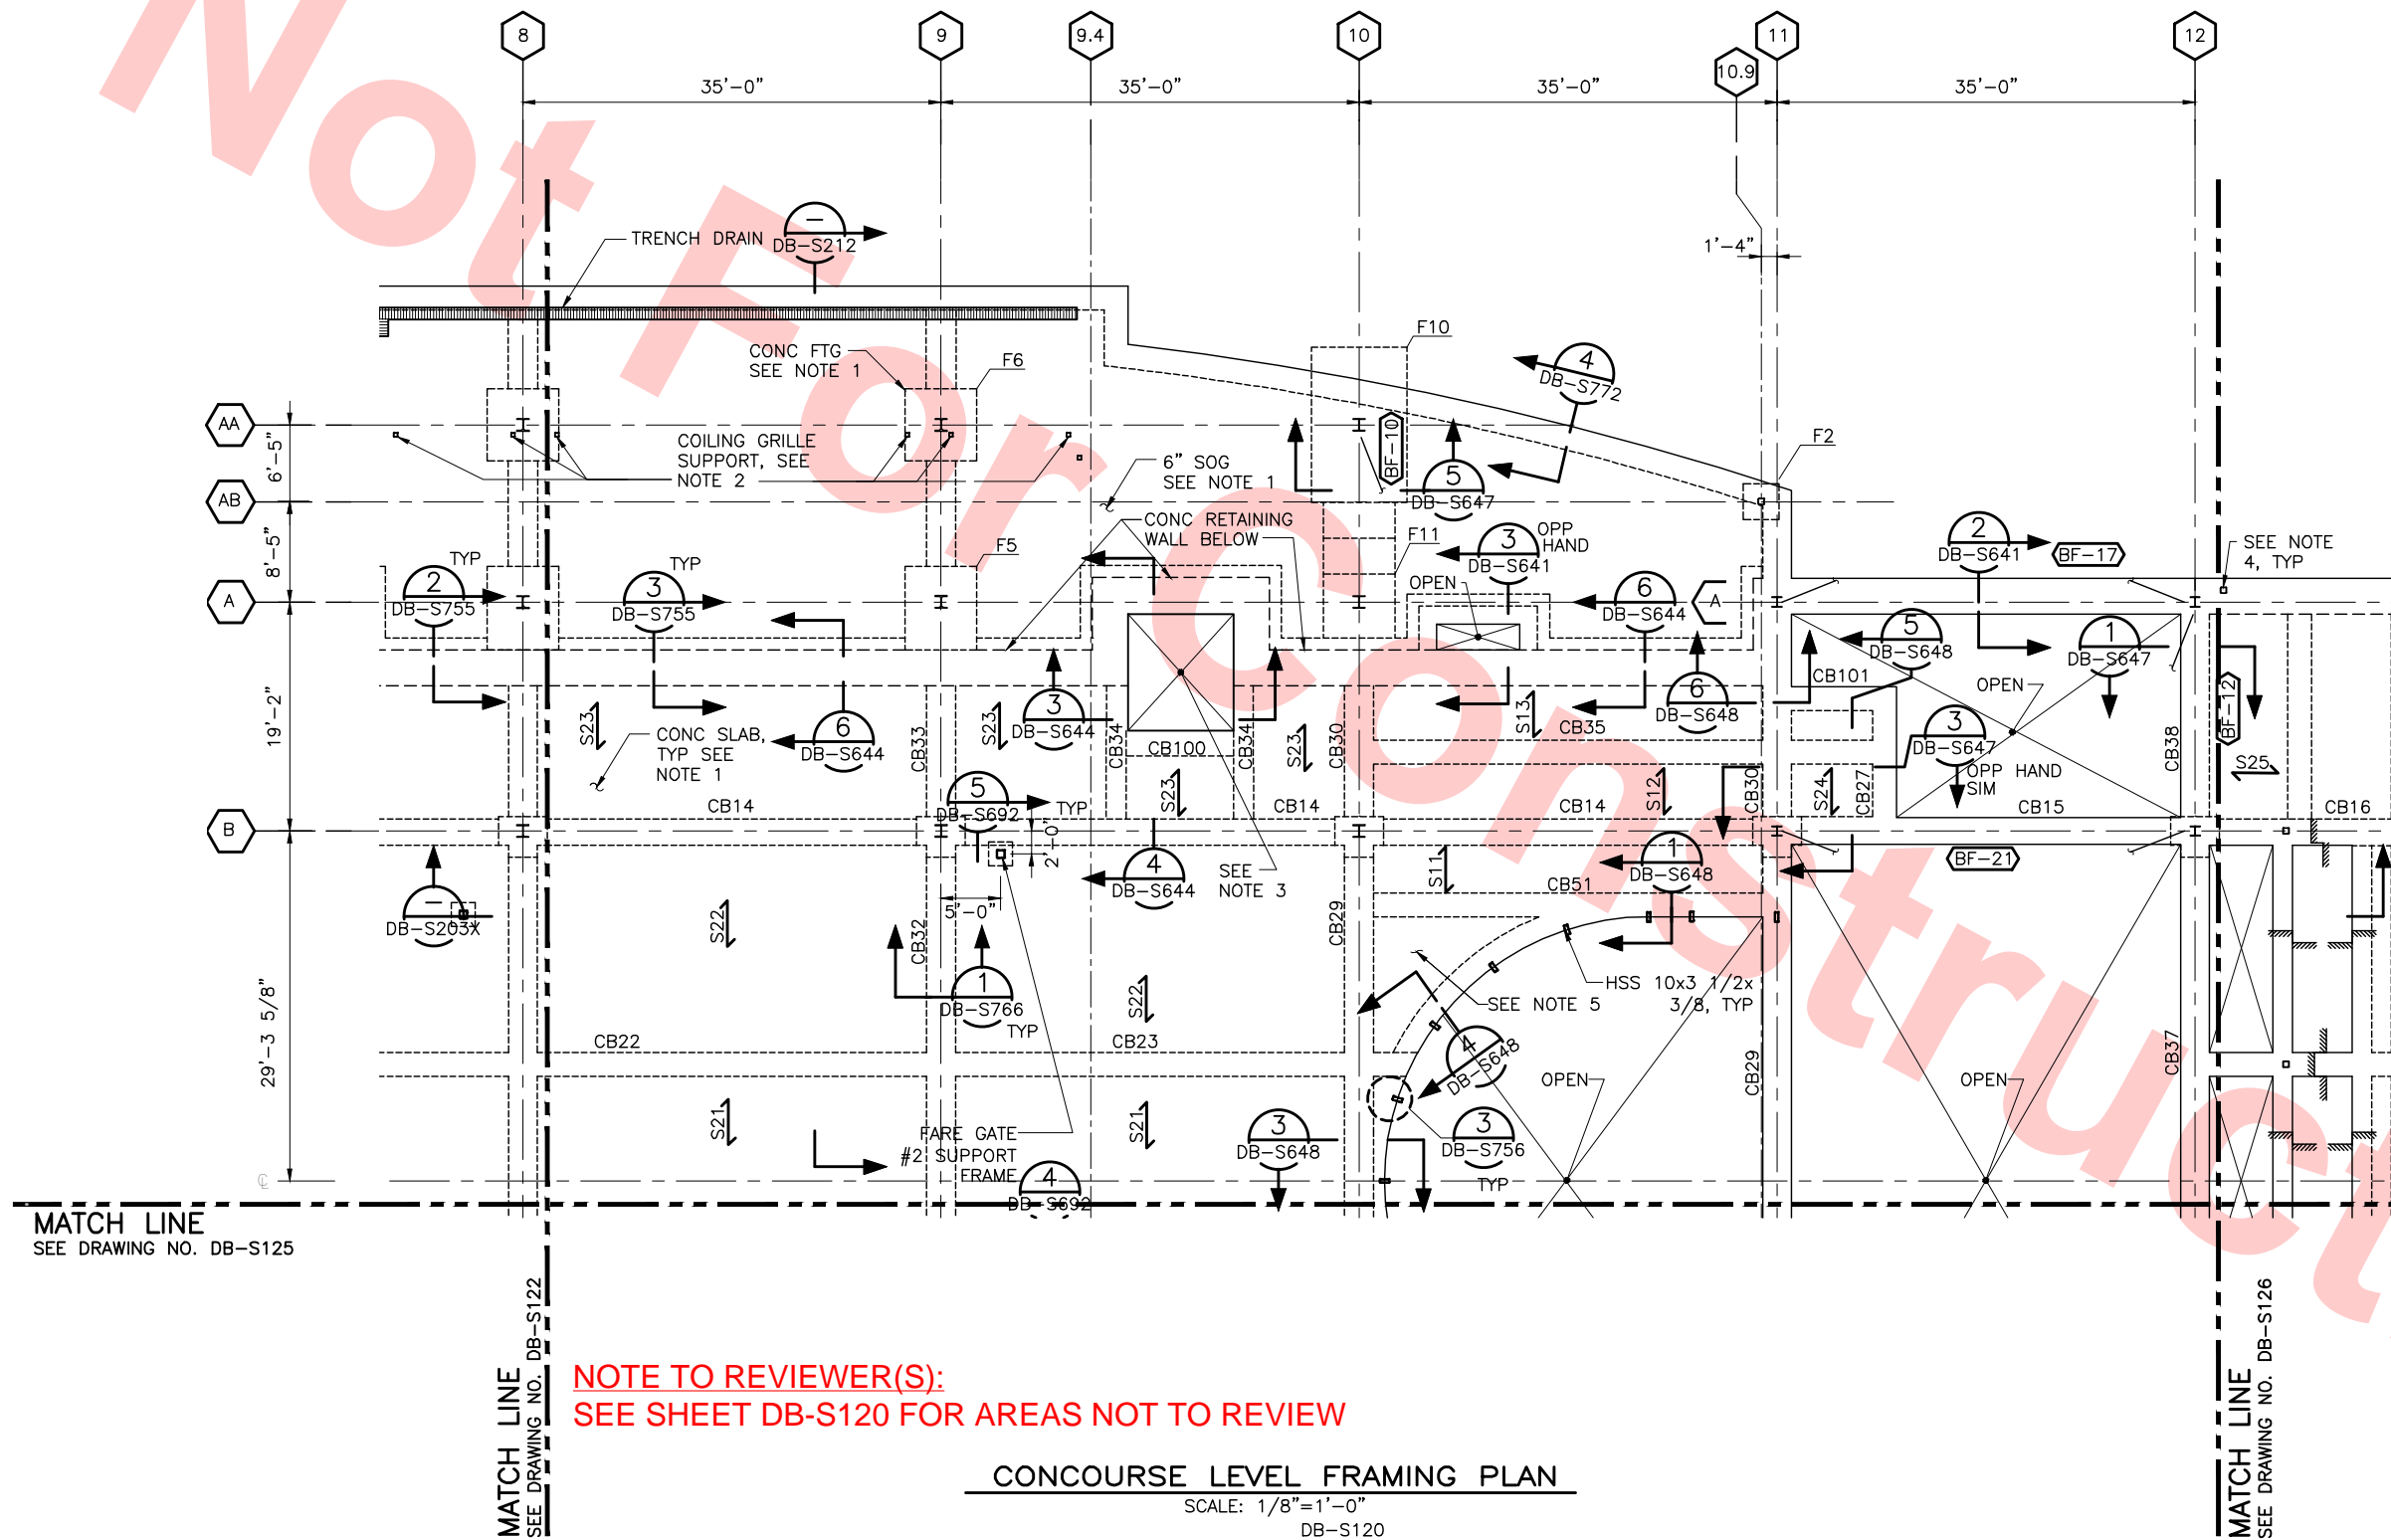


NOTE TO REVIEWER(S):  
SEE SHEET DB-S120 FOR AREAS NOT TO REVIEW

CONCOURSE LEVEL FRAMING PLAN

SCALE: 1/8" = 1'-0"  
DB-S120

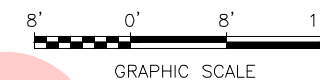


KEY PLAN

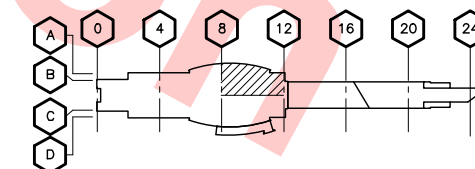

Jul 05, 2013 - 3:37pm P:\BART Berryessa Extension Line\AS - STRUCTURAL MILPITAS WORK\6-10-2012\0700-S-DB-S124.dwg

REV	DATE	BY	SUB	APP	DESCRIPTION
0	20130531				READINESS FOR CONSTRUCTION REPLACED C700-S-DB-S204 REV P.

DESIGNED BY  
J. REBER, S.E.  
DRAWN BY  
P. DIAZ  
CHECKED BY  
M. TARAZI  
IN CHARGE  
M. TARAZI  
DATE  
20130531

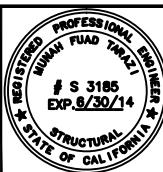

Skanska  
Shimmick  
Herzog  
1436 California Circle  
Milpitas, California 95035  
A Joint Venture  
MFT CONSULTING ENGINEERS, INC. Anil Verma Associates, Inc.  
1773 San Pablo Ave., Suite A3 (510) 222-4166  
Palo Alto, CA 94304 Fax (510) 222-6419

Lealwood, Andrews  
& Newman, Inc.  
A LEO A DALY COMPANY  
T-Y-LIN INTERNATIONAL  
APPROVED



LINE, TRACK, STATIONS AND SYSTEMS  
DESIGN UNIT 023  
MILPITAS STATION  
FOUNDATION AND CONCOURSE  
FRAMING PLAN  
SHEET 4 OF 9


CADD FILENAME C700-S-DB-S124.dwg	REV.	0
SIZE D	SCALE 1/8" = 1'-0"	
CONTRACT NO. C700	SHEET NO. S124	PAGE NO. 0157








Jul 05, 2013 - 1:50pm P:\BART Berryessa Extension Line\A-S - STRUCTURAL MILPITAS WORK\6-10-2012\C700-S-DB-S126.dwg  
c04-02

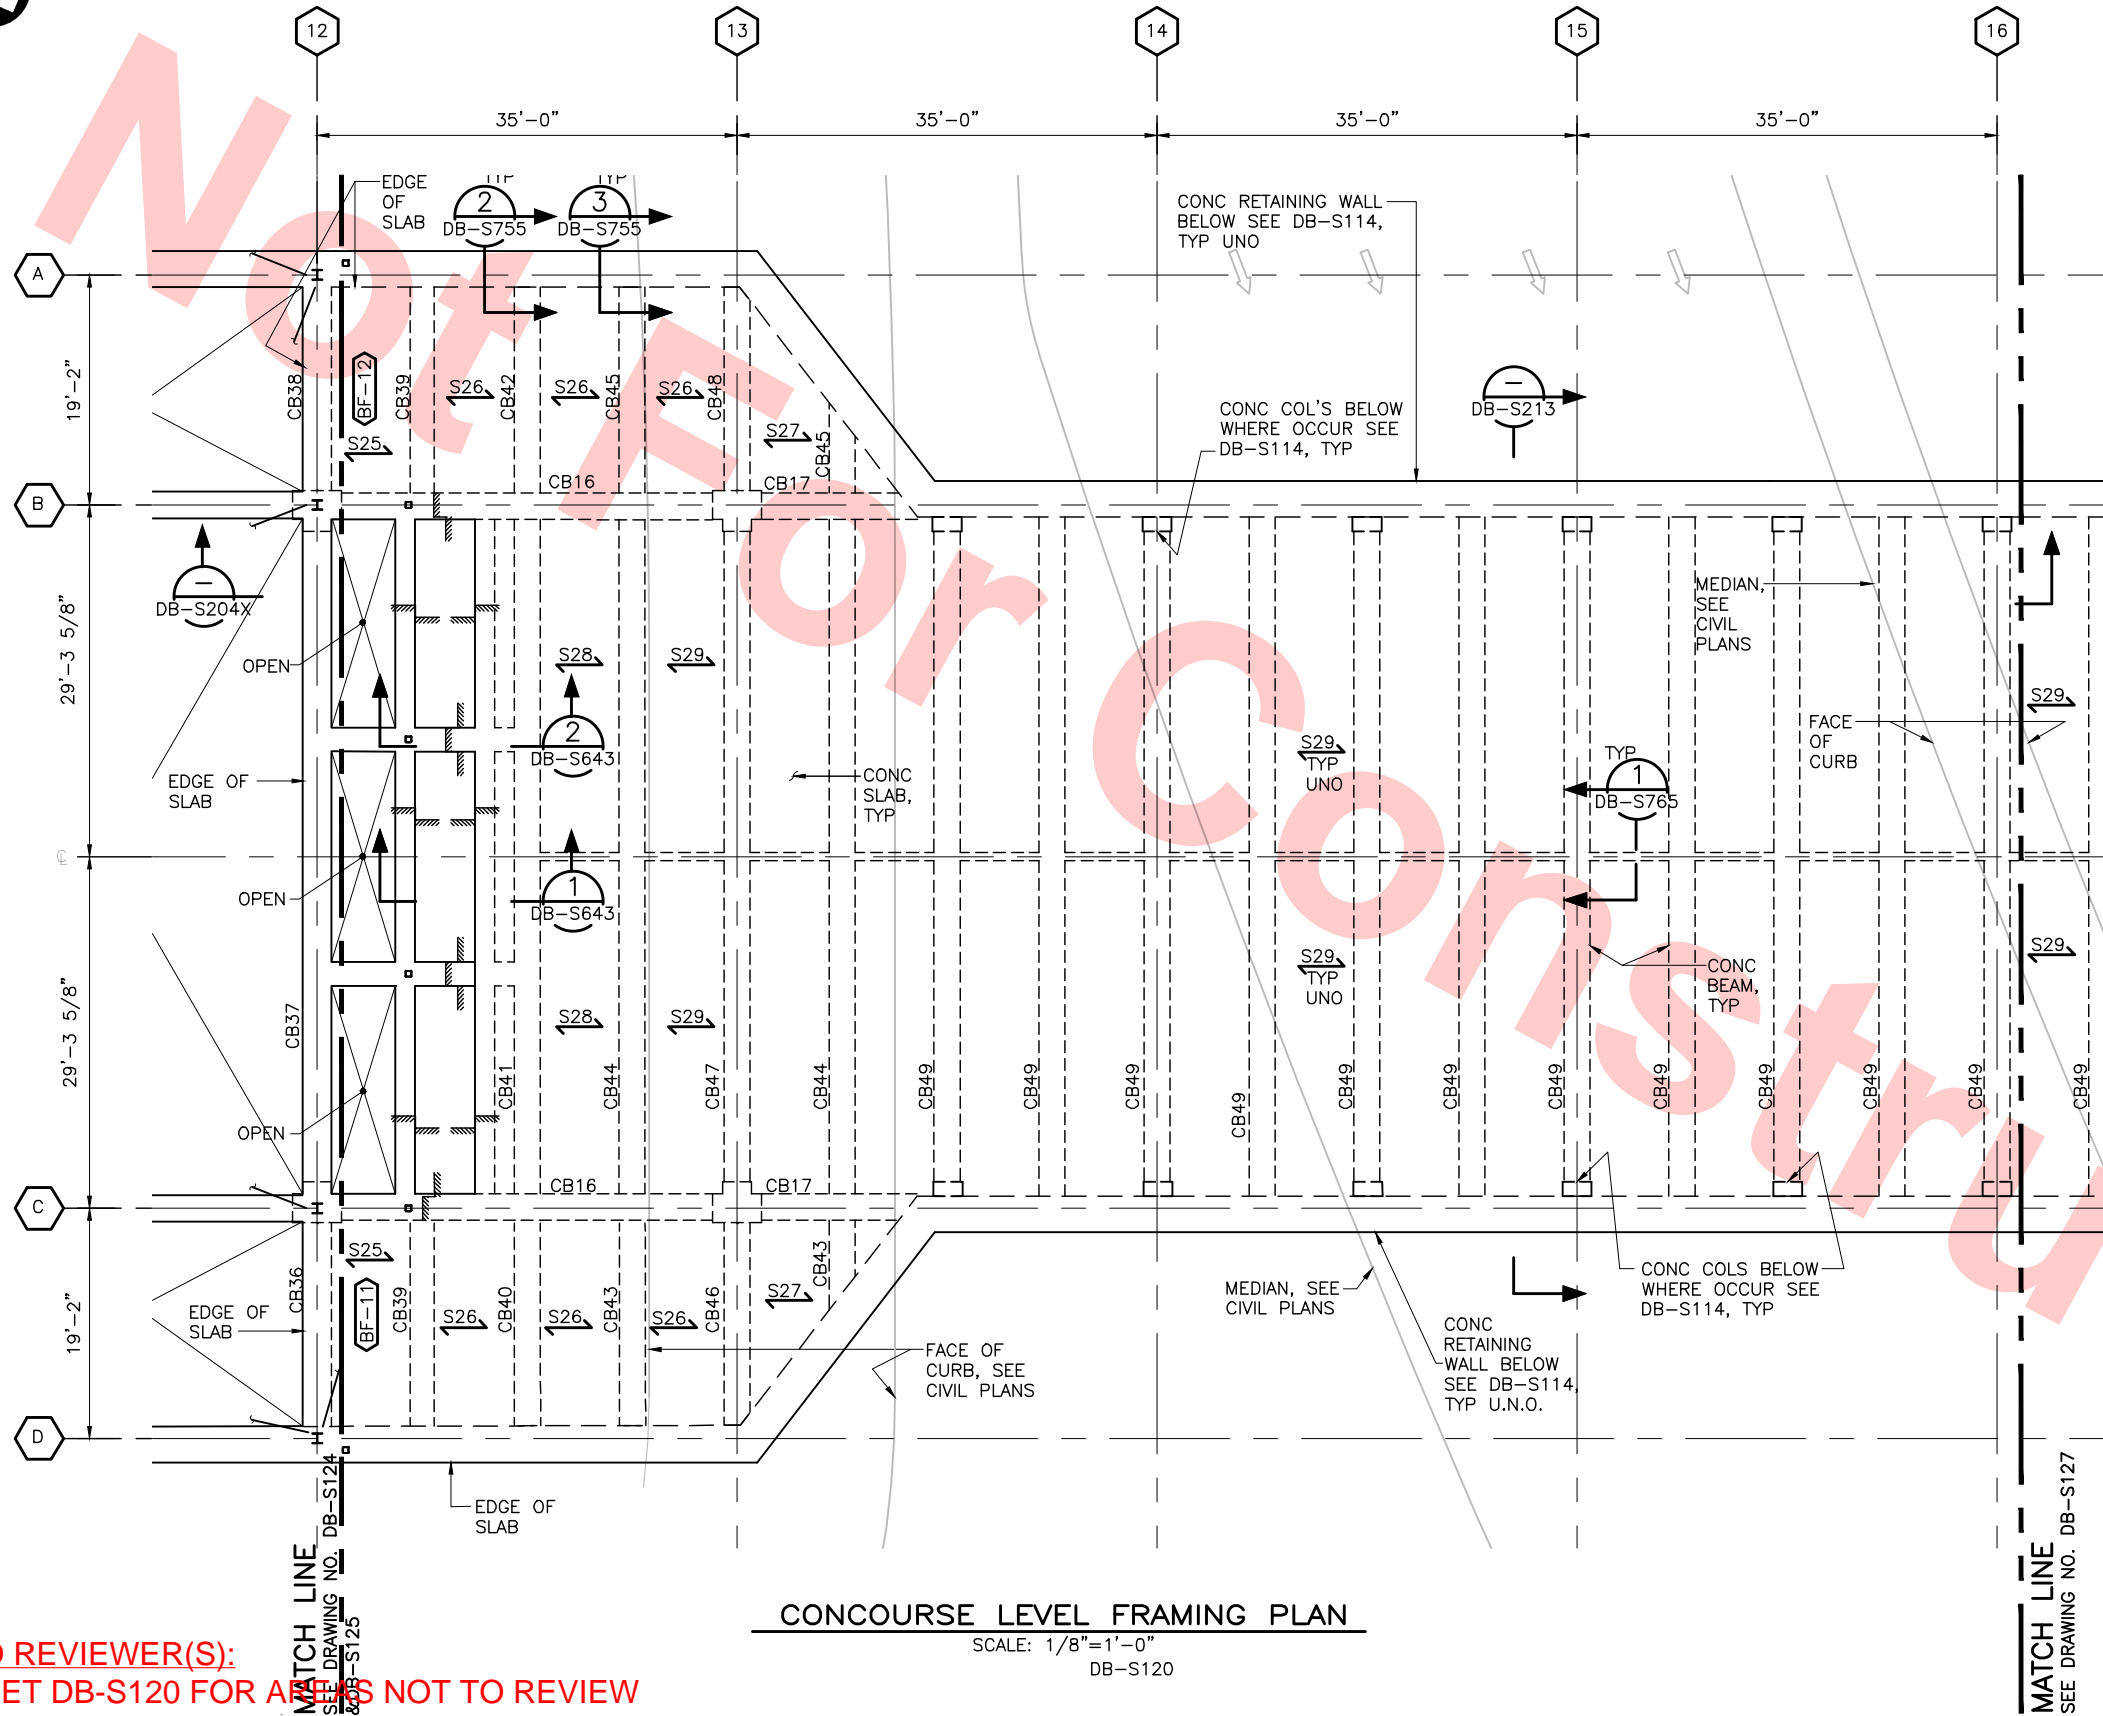


CONCOURSE LEVEL FRAMING PLAN  
SCALE: 1/8"=1'-0"  
DB-S120

NOTES:

1. FOR FOUNDATION AND CONCOURSE LEVEL FRAMING NOTES, DWG DB-S121.
2. COORDINATE LOCATION OF SIDEWALKS, LANDSCAPE ISLAND, CURB AND GUTTER WITH DRAWINGS: LM-C110, LM-C207 AND LM-C171 PROVIDE #4@36" EACH WAY DOWELS INTO ROADWAYS SLAB. SEE SIMILAR DETAIL 3 DB-S771

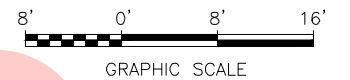

KEY PLAN

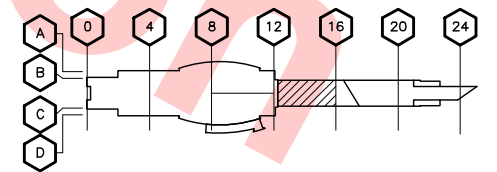

NOTE TO REVIEWER(S):  
SEE SHEET DB-S120 FOR AREAS NOT TO REVIEW

REV	DATE	BY	SUB	APP	DESCRIPTION
0	20130531				READINESS FOR CONSTRUCTION REPLACED C700-S-DB-S206 REV P.

DESIGNED BY J. REBER, S.E.	
DRAWN BY P. DIAZ	
CHECKED BY M. TARAZI	
IN CHARGE M. TARAZI	
DATE 20130531	



Skanska  
Shimmick  
Herzog

1436 California Circle  
Milpitas, California 95035  
A Joint Venture

MFT CONSULTING ENGINEERS, INC. Anil Verma Associates, Inc.  
1773 San Pablo Ave., Suite A3 (510) 222-4106  
Palo Alto, CA 94304 Fax (510) 222-6419

Lealwood, Andrews  
& Newman, Inc.  
A LEO A DALY COMPANY

T-Y-LIN INTERNATIONAL



LINE, TRACK, STATIONS AND SYSTEMS  
DESIGN UNIT 023  
MILPITAS STATION  
FOUNDATION AND CONCOURSE  
FRAMING PLAN  
SHEET 6 OF 9


CADD FILENAME C700-S-DB-S126.dwg	REV.	0
SIZE D	SCALE 1/8" = 1'-0"	
CONTRACT NO. C700	SHEET NO. S126	PAGE NO. 0159
AREA CODE DB		





DB-S77

SCALE: 1/8"=1'-0"  
DB-S120



1436 California Circle  
Milpitas, California 95035  
A Joint Venture

**Lockwood, Andrews & Newnam, Inc.** | **T-Y-LIN INTERNATIONAL**

APPROVED \_\_\_\_\_




CADD FILENAME C700-S-DB-S127.dwg		
SIZE D	SCALE 1/8" = 1'-0"	
CONTRACT NO. <b>C700</b>		REV.
AREA CODE <b>DB</b>	SHEET NO. <b>S127</b>	PAGE NO. <b>0160</b>






- NOTES:
- 1. FOR FOUNDATION AND CONCOURSE LEVEL FRAMING NOTES, SEE DWG NO DB-S121.
  - 2. METAL DECK SHALL BE TYPE D2 AS SHOWN ON A/S781.

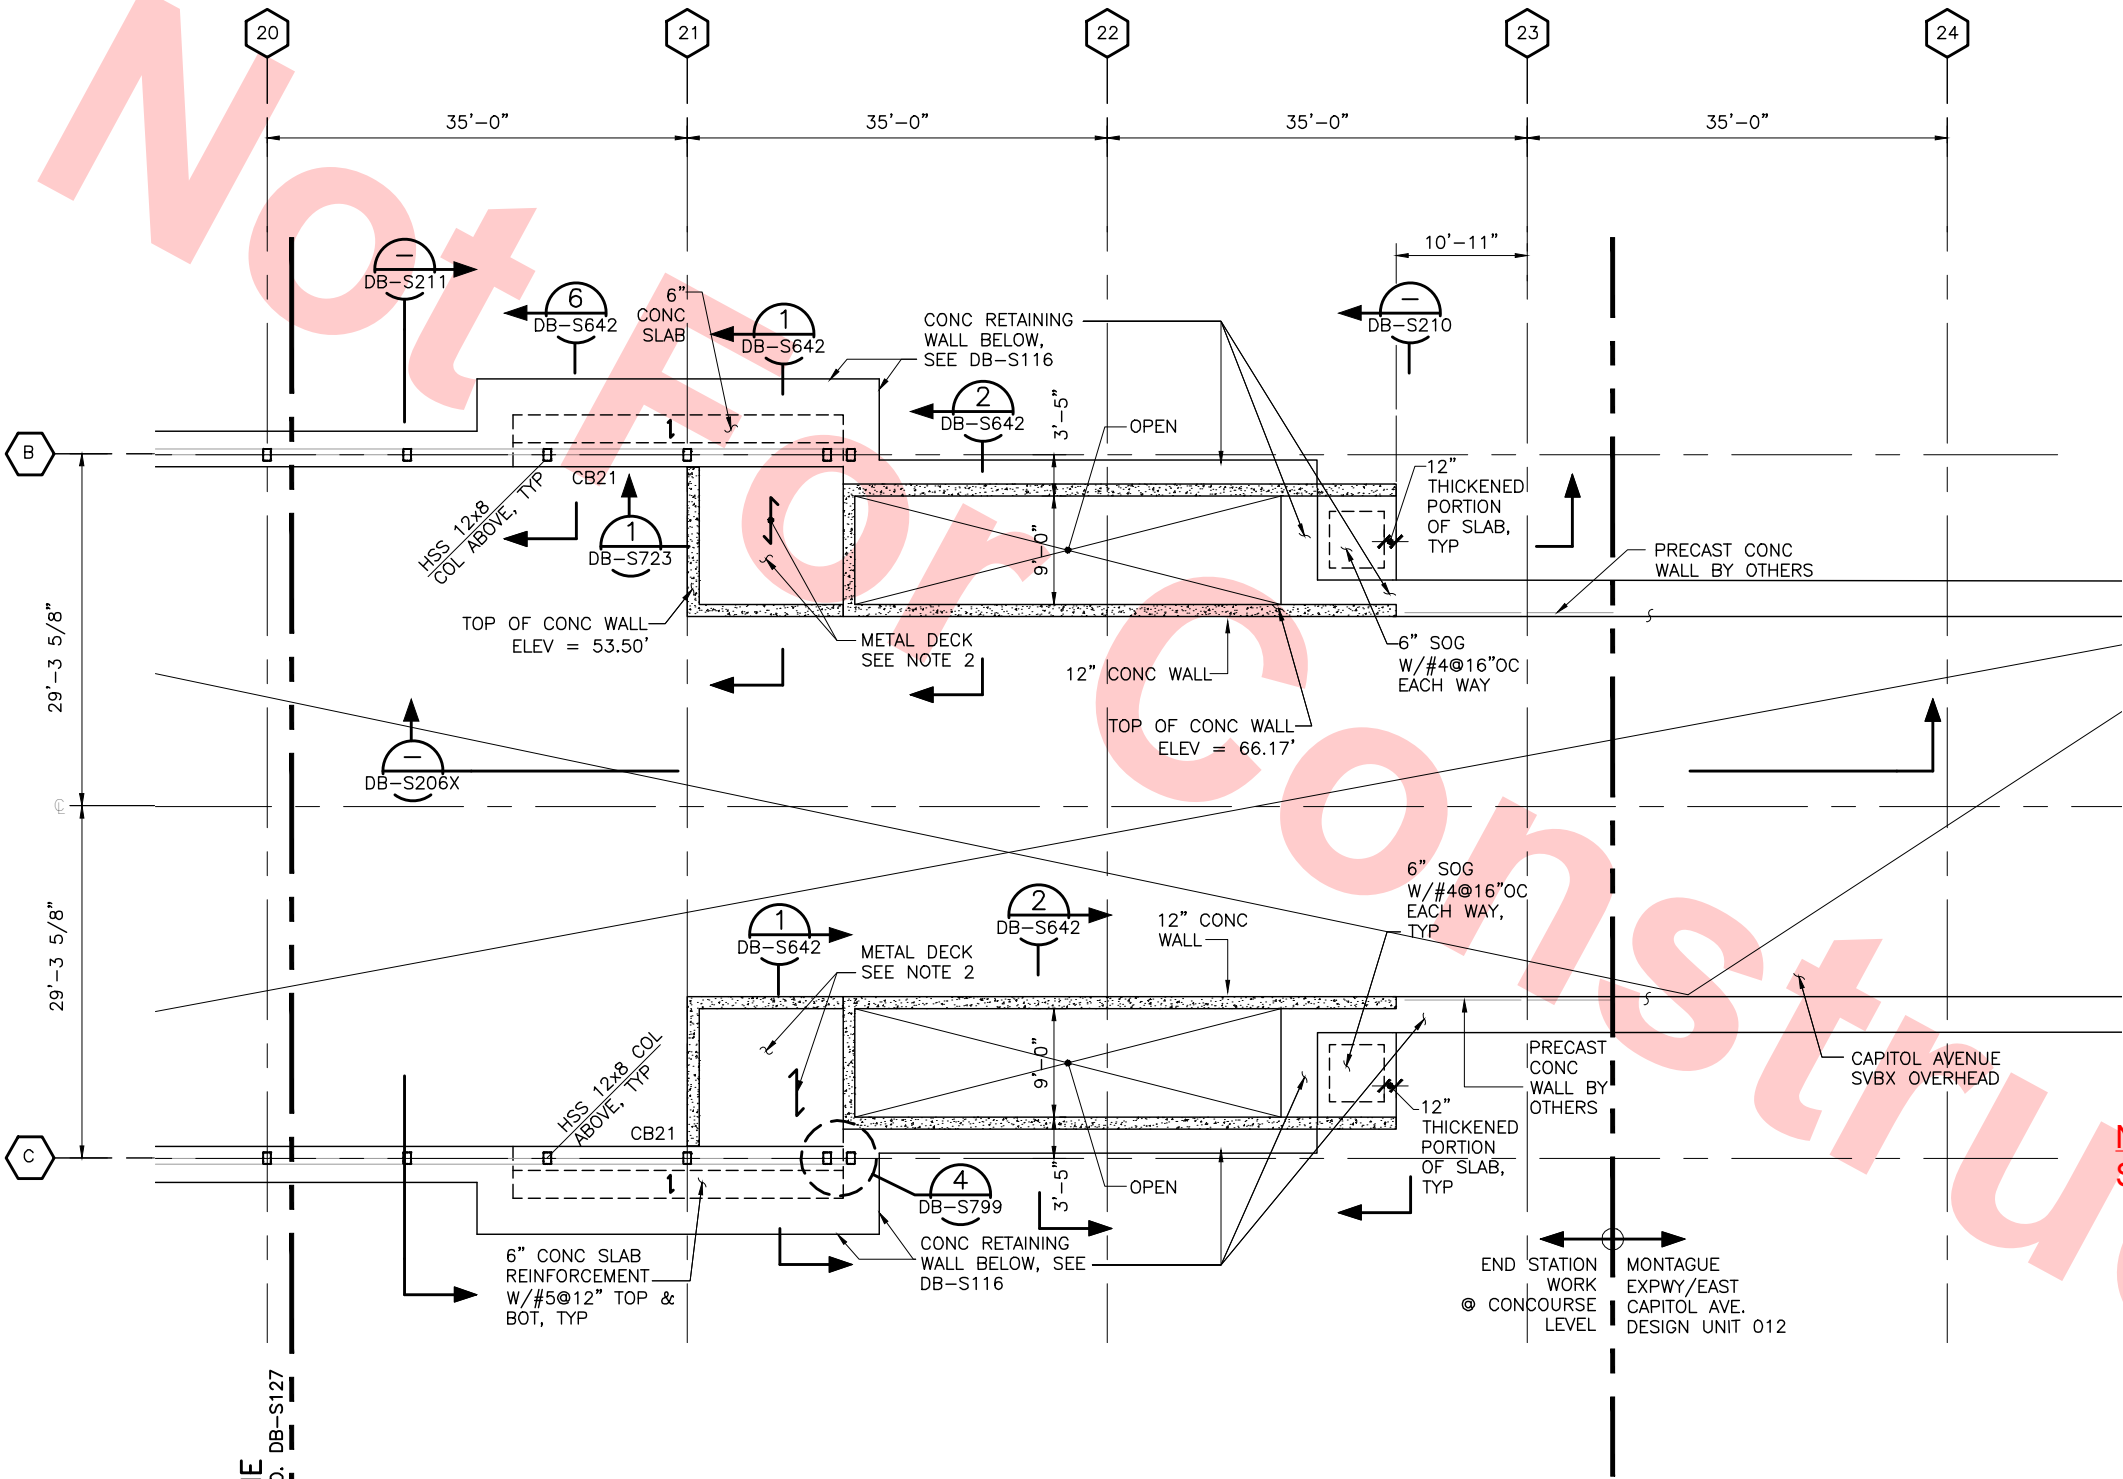

NOTE TO REVIEWER(S):  
SEE SHEET DB-S120 FOR AREAS NOT TO REVIEW

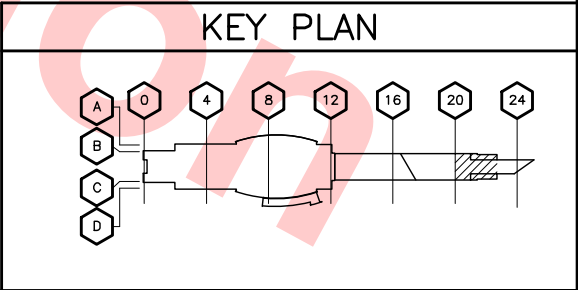

CONCOURSE LEVEL FRAMING PLAN  
SCALE: 1/8"=1'-0"  
DB-S120

Jul 05, 2013 - 1:50pm P:\BART Berryessa Extension Line\A - STRUCTURAL MILPITAS WORK\6-10-2012\C700-S-DB-S128.dwg

REV	DATE	BY	SUB	APP	DESCRIPTION
0	20130531				READINESS FOR CONSTRUCTION REPLACED C700-S-DB-S208 REV P.

DESIGNED BY  
J. REBER, S.E.  
DRAWN BY  
P. DIAZ  
CHECKED BY  
M. TARAZI  
IN CHARGE  
M. TARAZI  
DATE  
20130531



Skanska  
Shimmick  
Herzog  
1436 California Circle  
Milpitas, California 95035  
A Joint Venture  
MFT CONSULTING ENGINEERS, INC. Anil Verma Associates, Inc.  
1773 San Pablo Ave., Suite A3 (510) 222-4166  
Palo Alto, CA 94304 Fax (510) 222-6419

Lealwood, Andrews & Newman, Inc.  
A LEO A DALY COMPANY  
T-Y-LIN INTERNATIONAL



LINE, TRACK, STATIONS AND SYSTEMS  
DESIGN UNIT 023  
MILPITAS STATION  
FOUNDATION AND CONCOURSE  
FRAMING PLAN  
SHEET 8 OF 9

CADD FILENAME C700-S-DB-S128.dwg	CONTRACT NO. C700	REV. 0
SIZE D	SCALE 1/8" = 1'-0"	AREA CODE DB
SHEET NO. S128	PAGE NO. 0161	




Jul 05, 2013 - 1:50pm P:\BART Berryessa Extension Line\A5 - STRUCTURAL MILPITAS WORK\_6-10-2012\0700-S-DB-S129.dwg  
c04-02




NOTES:

1. FOR FOUNDATION AND CONCOURSE LEVEL FRAMING NOTES, SEE DWG NO DB-S121.

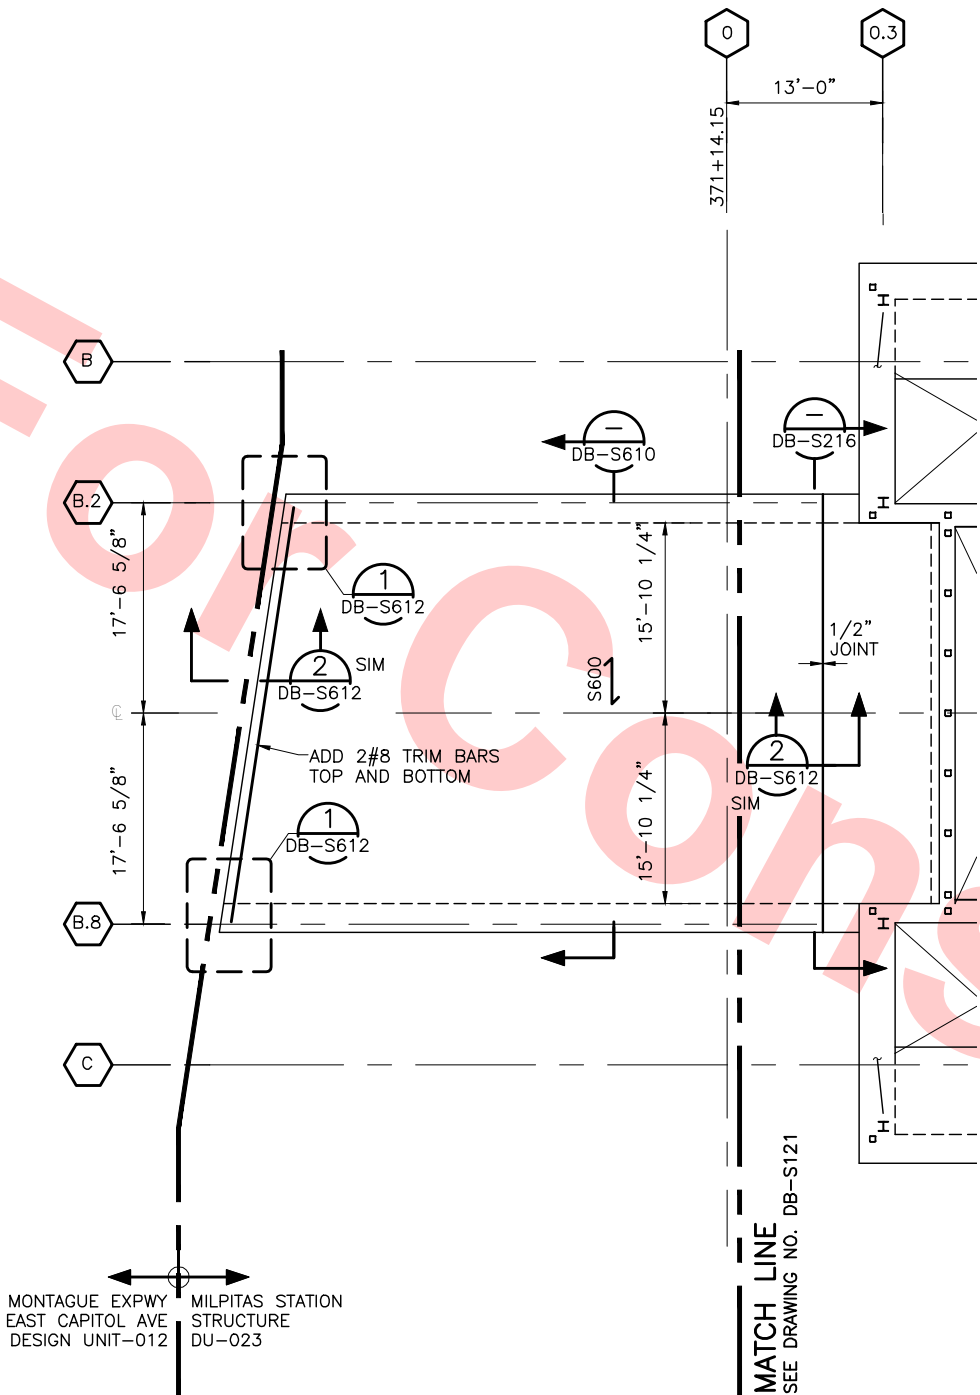


CONCOURSE LEVEL FRAMING PLAN

SCALE: 1/8"=1'-0"  
DB-S070

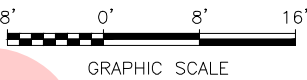

KEY PLAN

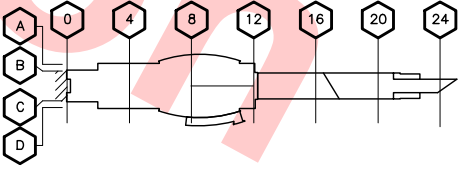

NOTE TO REVIEWER(S):  
SEE SHEET DB-S120 FOR AREAS NOT TO REVIEW

DESIGNED BY J. REBER, S.E.	
DRAWN BY P. DIAZ	
CHECKED BY M. TARAZI	
IN CHARGE M. TARAZI	
DATE 20130531	

REV	DATE	BY	SUB	APP	DESCRIPTION
0	20130531				READINESS FOR CONSTRUCTION



**Skanska  
Shimmick  
Herzog**

1436 California Circle  
Milpitas, California 95035  
A Joint Venture

**MFT CONSULTING ENGINEERS, Inc.** Anil Verma Associates, Inc.  
1773 San Pablo Ave., Suite A3 (510) 222-4166  
Palo Alto, CA 94304 Fax (510) 222-6419

**Lealwood, Andrews  
& Newman, Inc.**  
A LEO A DALY COMPANY

**T-Y-LIN INTERNATIONAL**

SUBMITTED \_\_\_\_\_

APPROVED \_\_\_\_\_




LINE, TRACK, STATIONS AND SYSTEMS  
DESIGN UNIT 023  
MILPITAS STATION  
FOUNDATION AND CONCOURSE  
FRAMING PLAN  
SHEET 9 OF 9

CADD FILENAME C700-S-DB-S129.dwg	
SIZE D	SCALE 1/8" = 1'-0"
CONTRACT NO. C700	REV. 0
AREA CODE DB	SHEET NO. S129
	PAGE NO. 0162



04-02 Jul 05, 2013 - 1:50pm P:\BART Berryessa Extension Line\5 - STRUCTURAL MILPITAS WORK\5-10-2012\0700-S-DB-S130.dwg

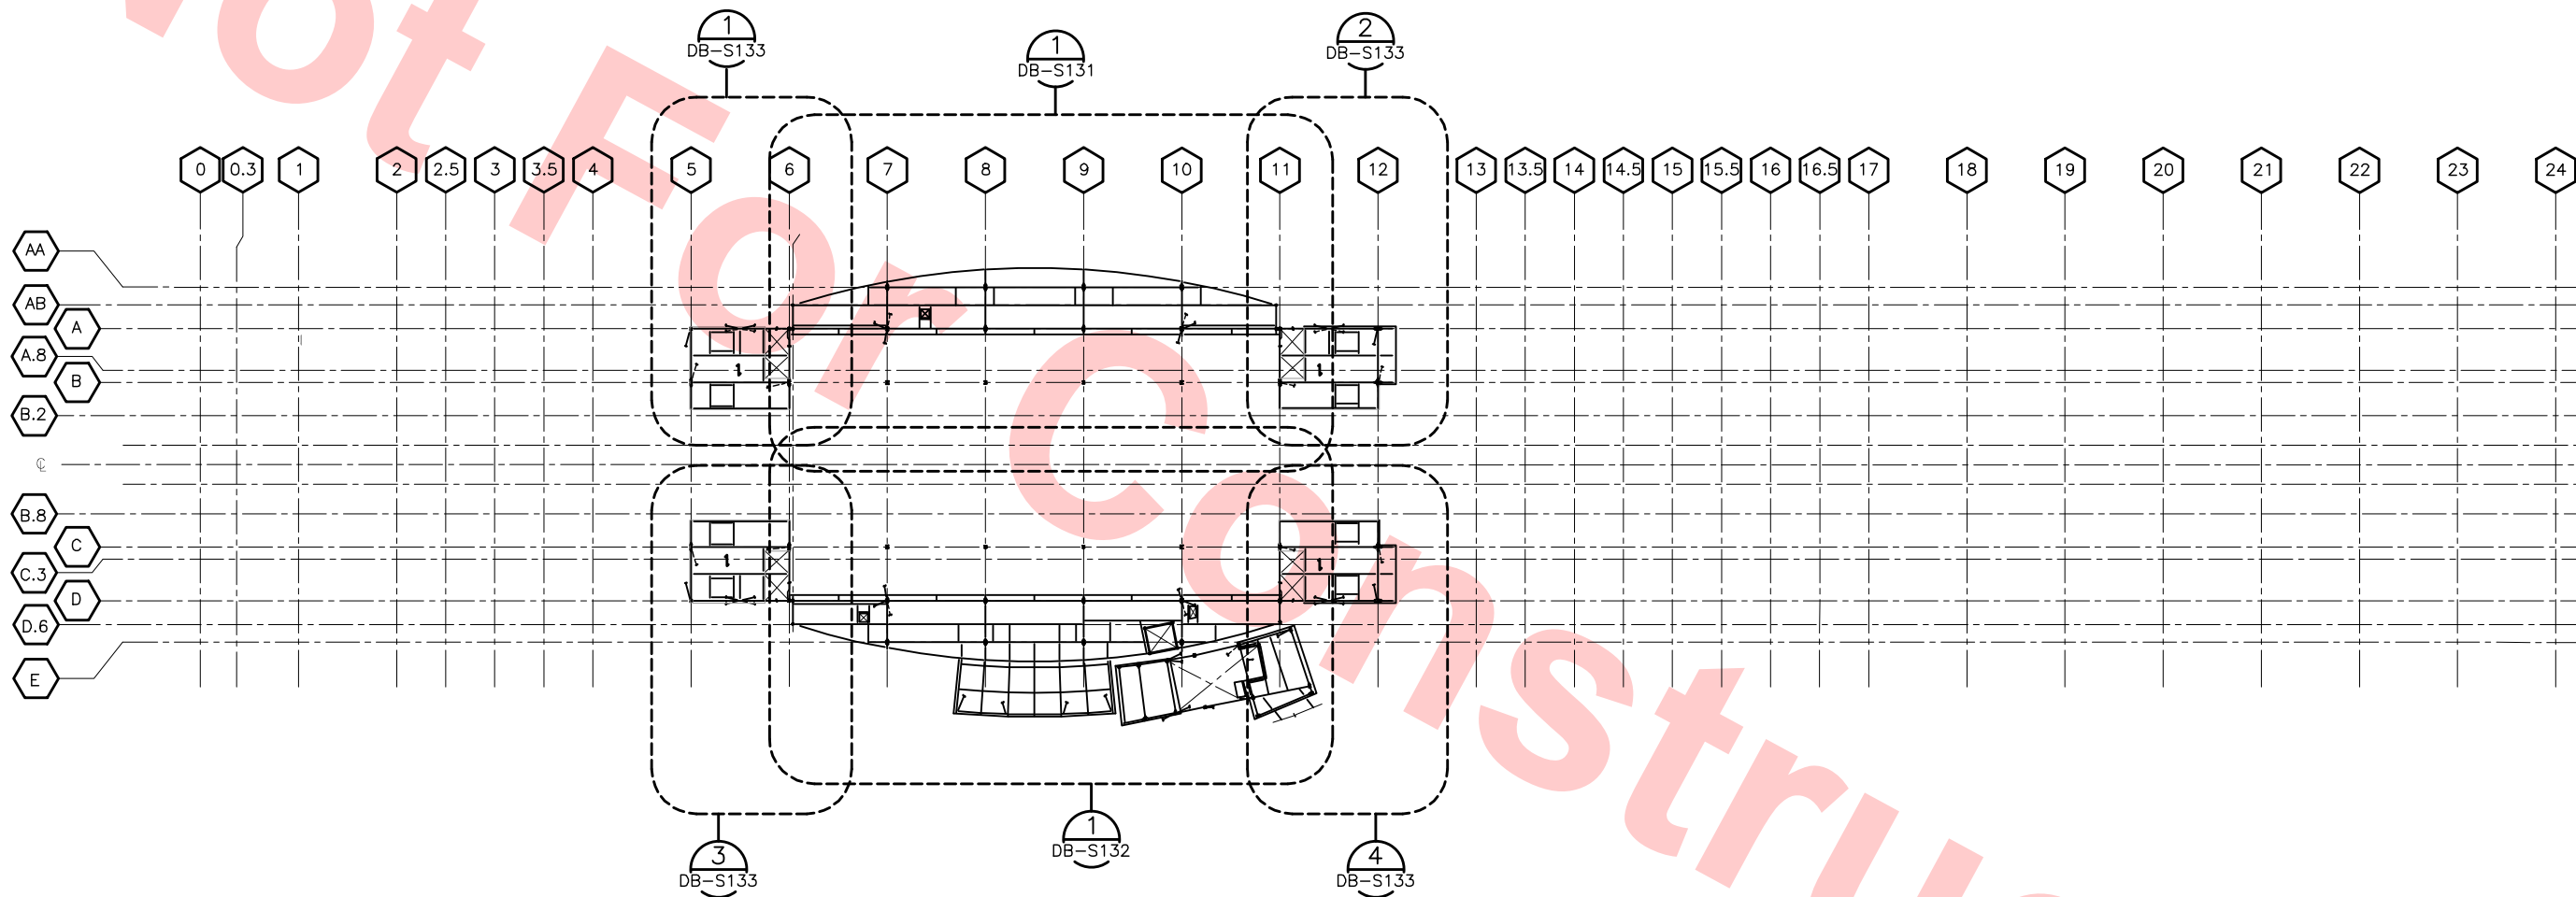

MEZZANINE LEVEL KEY PLAN  
SCALE: 1/32"=1'-0"  
DB-S130

Santa Clara Valley Transportation Authority

- NO EXCEPTIONS TAKEN (NET)
- MAKE CORRECTIONS NOTED (MCN)
- AMEND AND RESUBMIT (A/R)

Any action shown above is subject to the terms of the contract and does not relieve the Contractor of any of its obligations under the contract, including design and detailing.

Contract No.: DB11002F

By: \_\_\_\_\_ Date: \_\_\_\_\_



REV	DATE	BY	SUB	APP	DESCRIPTION
0	20130710				READINESS FOR CONSTRUCTION

DESIGNED BY  
J. REBER, S.E.  
DRAWN BY  
P. DIAZ  
CHECKED BY  
M. TARAZI  
IN CHARGE  
M. TARAZI  
DATE  
20130710



Skanska  
Shimmick  
Herzog  
1436 California Circle  
Milpitas, California 95035  
A Joint Venture  
MFT CONSULTING ENGINEERS, Inc. Anil Verma Associates, Inc.  
1773 San Pablo Ave., Suite A3 (510) 222-4100  
Palo Alto, CA 94304 Fax (415) 222-8410

Lealwood, Andrews  
& Newman, Inc.  
T-Y-LIN INTERNATIONAL  
APPROVED  
By: \_\_\_\_\_




LINE, TRACK, STATIONS AND SYSTEMS  
DESIGN UNIT 023  
MILPITAS STATION  
MEZZANINE LEVEL FRAMING  
KEY PLAN

CADD FILENAME	C700-S-DB-S130.dwg
SIZE	SCALE
D	1/32" = 1'-0"
CONTRACT NO.	C700
REV.	0
AREA CODE	DB
SHEET NO.	S130
PAGE NO.	0163



Jul 05, 2013 - 1:50pm P:\BART Berryessa Extension Line\5 - STRUCTURAL MILPITAS WORK\6-10-2012\0700-S-DB-S131.dwg  
c04-02

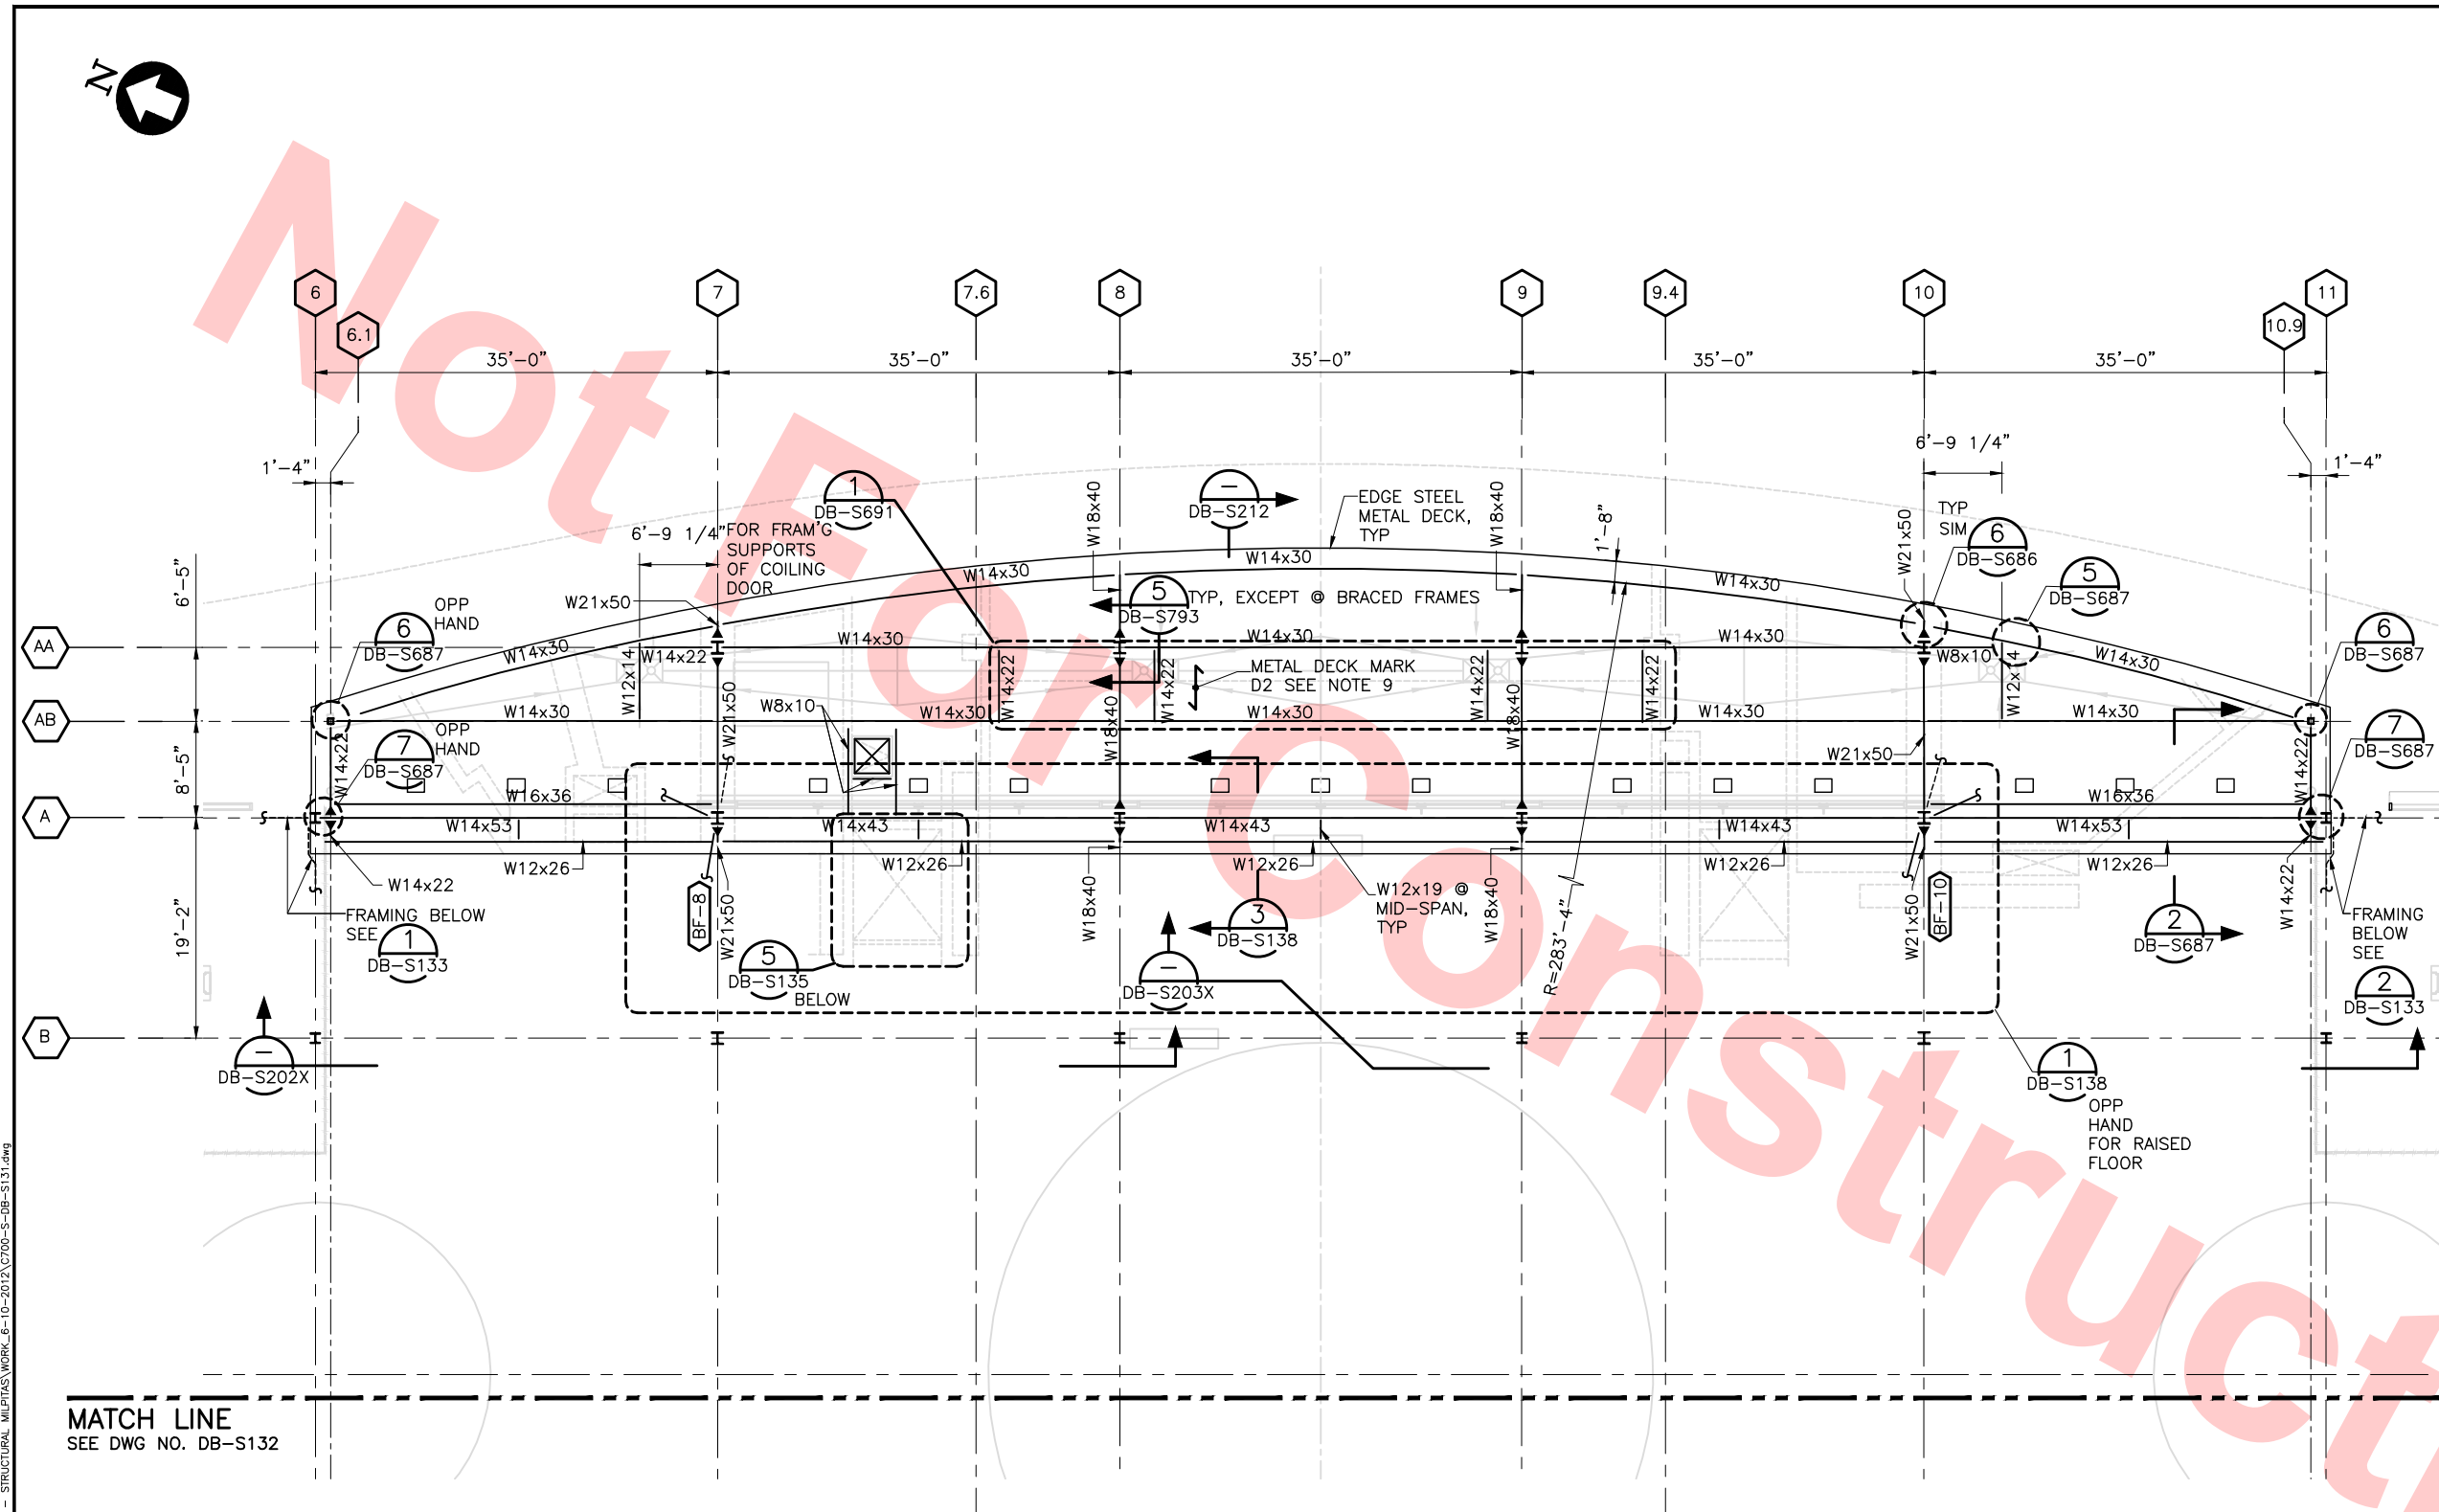

- NOTES:**
1. TOP OF STEEL IS 17'-3" ABOVE CONCOURSE ELEVATION OF 53.5'
  2. VERIFY ALL OPENINGS AND DIMENSIONS WITH ARCHITECTURAL DRAWINGS.
  3. REFER TO GENERAL NOTES, LEGEND, AND ABBREVIATIONS ON SHEET DB-S001X, DB-S002X, AND DB-S003X.
  4. ALL DIMENSIONS ARE TO CENTERLINE OF COLUMNS OR FACE OF CONCRETE, TYP UNLESS NOTED OTHERWISE.
  5. CONTRACTOR IS RESPONSIBLE FOR THE PLACEMENT OF ALL EMBEDDED ITEMS.
  6. **500#** INDICATES MECHANICAL UNIT WITH MAXIMUM OPERATING WEIGHT.
  7. CONTRACTOR TO COORDINATE LOCATION OF FRAMING WITH EQUIPMENT SUPPLIER.
  8. **BF-1** INDICATES BRACED FRAME. ABOVE AND/OR BELOW SEE STEEL FRAMING ELEVATIONS DWGS DB-S501, DB-S502 & DB-S503 SHEETS.
  9. FOR TYPICAL METAL DECK SECTIONS & DETAILS SEE DRAWINGS DB-S781, DB-S782, DB-S783 & DB-S784.
  10. FOR TYPICAL STEEL SECTIONS & DETAILS SEE DRAWINGS DB-S791, DB-S792, DB-S793, DB-S794 & DB-S795.
  11. FOR ALL COLUMN SIZES SEE DRAWINGS DB-S751X & DB-S752X.

**Santa Clara Valley Transportation Authority**

— NO EXCEPTIONS TAKEN (NET)  
— MAKE CORRECTIONS NOTED (MCN)  
— AMEND AND RESUBMIT (A/R)

Any action shown above is subject to the terms of the contract and does not relieve the Contractor of any of its obligations under the contract, including design and detailing.


Contract No.: **DB11002F**




By: \_\_\_\_\_ Date: \_\_\_\_\_

**MATCH LINE**  
SEE DWG NO. DB-S132

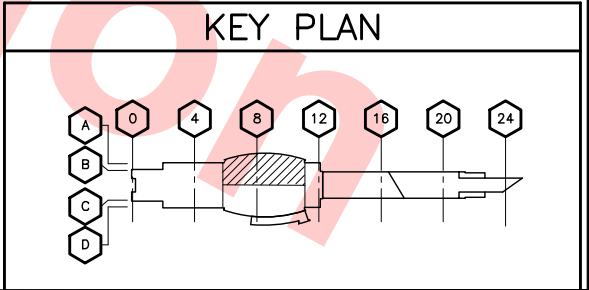

**EAST ENTRANCE ROOF FRAMING PLAN**  
SCALE: 1/8" = 1'-0"




					DESIGNED BY J. REBER, S.E.			<b>Skanska Shimmick Herzog</b>  1436 California Circle Milpitas, California 95035 A Joint Venture		 <b>BART</b> <b>SILICON VALLEY</b>	<b>LINE, TRACK, STATIONS AND SYSTEMS</b>  <b>DESIGN UNIT 023</b>  MILPITAS STATION EAST ENTRANCE ROOF FRAMING PLAN			CADD FILENAME C700-S-DB-S131.dwg	
					DRAWN BY P. DIAZ									SIZE   SCALE D   1/8" = 1'-0"	
					CHECKED BY M. TARAZI									CONTRACT NO. C700	REV. 0
					IN CHARGE M. TARAZI									AREA CODE DB	SHEET NO. S131
0 20130710					READINESS FOR CONSTRUCTION REPLACED C700-S-DB-S801 REV P.										
REV	DATE	BY	SUB	APP	DESCRIPTION		DATE	SUBMITTED		APPROVED					
							20130710								
								MFT CONSULTING ENGINEERS, Inc., Anil Verma Associates, Inc. 1773 San Pablo Ave., Suite A-3 (510) 222-4106 Pinole, CA 94964 Fax (510) 222-4119		Lockwood, Andrews & Newnam, Inc. A ONE A BOLT COMPANY		T-Y-LIN INTERNATIONAL			







Jul 05, 2013 1:50pm P:\BART Berryessa Extension Line\AS - STRUCTURAL MILPITAS WORK\6-10-2012\0700-S-DB-S133.dwg

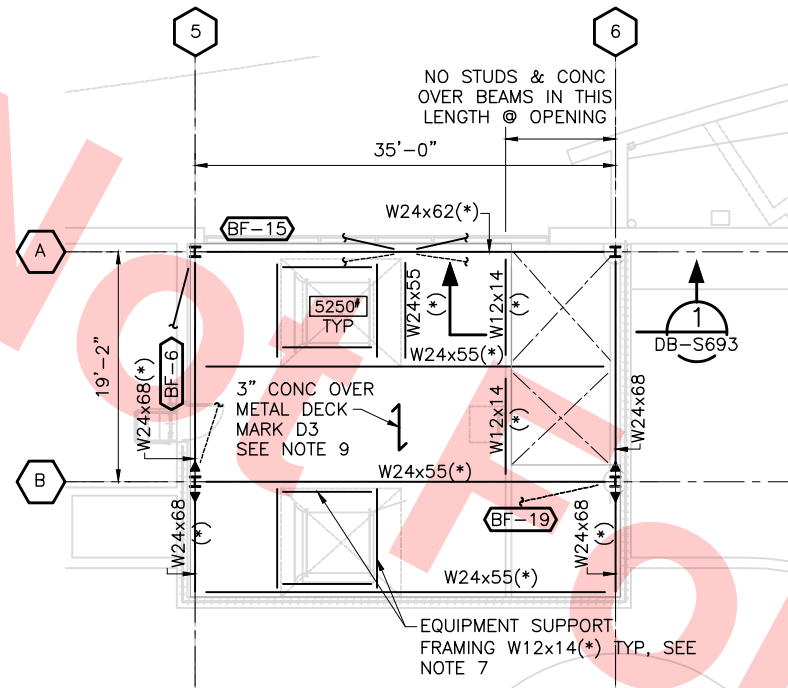


PARTIAL PLAN

SCALE: 1/8" = 1'-0"

1

DB-S133

DB-S130  
DB-S131

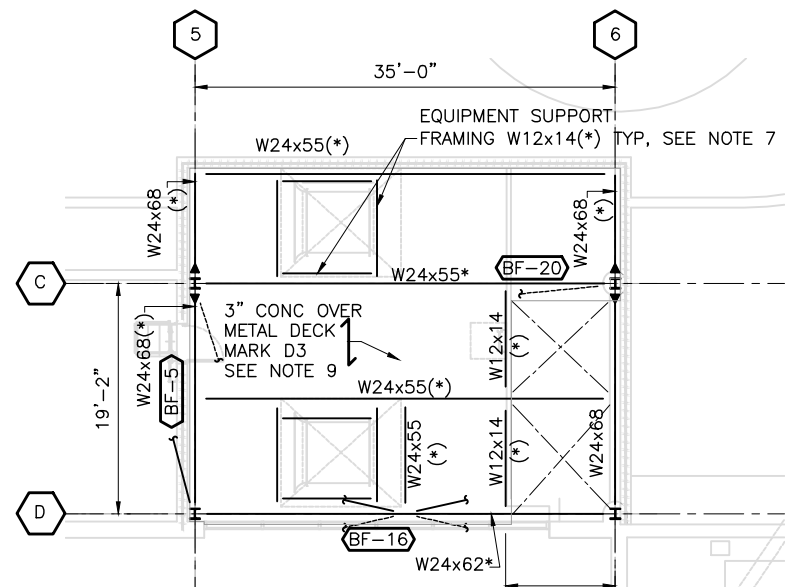


PARTIAL PLAN

SCALE: 1/8" = 1'-0"

3

DB-S133

DB-S130  
DB-S132

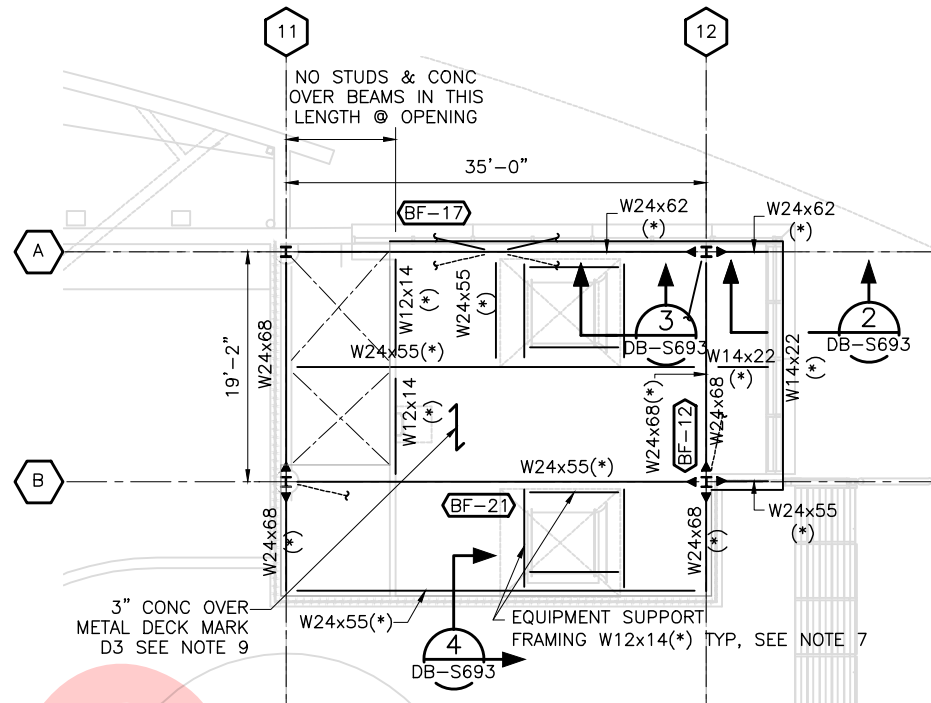


PARTIAL PLAN

SCALE: 1/8" = 1'-0"

2

DB-S133

DB-S130  
DB-S131

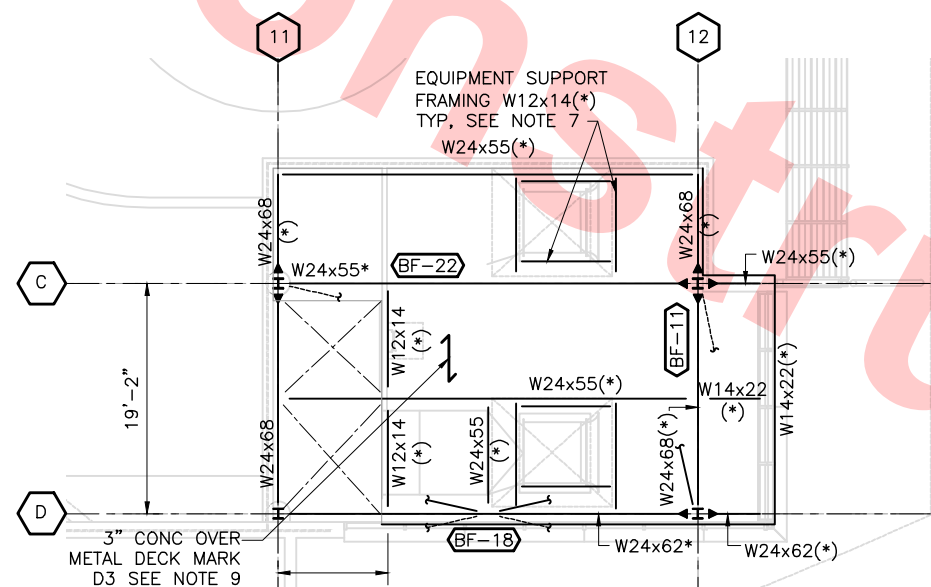

PARTIAL PLAN

SCALE: 1/8" = 1'-0"

4

DB-S133

DB-S130  
DB-S132

NOTES:

1. TOP OF STEEL @ SMOKE CONTROL FAN ROOM LEVEL ELEVATION = 66.81' TYP UNO
2. VERIFY ALL OPENINGS AND DIMENSIONS WITH ARCHITECTURAL DRAWINGS.
3. REFER TO GENERAL NOTES, LEGEND, AND ABBREVIATIONS ON SHEET DB-S003X.
4. ALL DIMENSIONS ARE TO CENTERLINE OF COLUMNS OR FACE OF CONCRETE, TYP UNLESS NOTED OTHERWISE.
5. CONTRACTOR IS RESPONSIBLE FOR THE PLACEMENT OF ALL EMBEDDED ITEMS.
6. [5250'] INDICATES MECHANICAL UNIT WITH MAXIMUM OPERATING WEIGHT PER DRAWING DB-M392.
7. COORDINATE LOCATION OF FRAMING WITH EQUIPMENT SUPPLIER.
8. [BF-1] INDICATES BRACED FRAME ABOVE AND/OR BELOW. SEE "STEEL FRAMING ELEVATION" DRAWINGS DB-S501, DB-S502 & DB-S503 SHEETS.
9. FOR TYPICAL METAL DECK SECTIONS & DETAILS SEE DRAWINGS DB-S781, DB-S782, DB-S783 & DB-S784.
10. FOR TYPICAL STEEL SECTIONS & DETAILS SEE DRAWINGS DB-S791, DB-S792, DB-S793, DB-S794 & DB-S795.
11. FOR ALL COLUMN SIZES SEE DRAWINGS DB-S751X & DB-S752X.
12. ( )- INDICATES # SHEAR STUDS ON BEAM, SEE DRAWING DB-S784 FOR LAYOUT OF STUDS.  
(\*) INDICATES PROVIDE SHEAR STUDS AT 12"OC SPACING.
13. SEE DRAWING DB-S783 FOR SHEAR STUD NOTES.

Santa Clara Valley Transportation Authority

NO EXCEPTIONS TAKEN (NET)  
MAKE CORRECTIONS NOTED (MCN)  
AMEND AND RESUBMIT (A/R)

Any action shown above is subject to the terms of the contract and does not relieve the Contractor of any of its obligations under the contract, including design and detailing.


Contract No.: DB11002F

By: \_\_\_\_\_ Date: \_\_\_\_\_




GRAPHIC SCALE

KEY PLAN

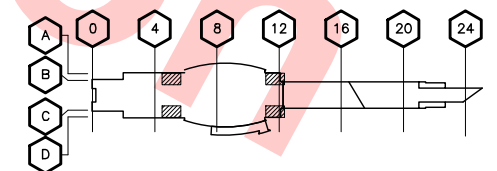

REV	DATE	BY	SUB	APP	DESCRIPTION
0	20130710				READINESS FOR CONSTRUCTION

DESIGNED BY  
J. REBER, S.E.  
DRAWN BY  
P. DIAZ  
CHECKED BY  
M. TARAZI  
IN CHARGE  
M. TARAZI  
DATE  
20130710

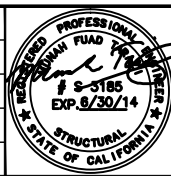

Skanska  
Shimmick  
Herzog  
1436 California Circle  
Milpitas, California 95035  
A Joint Venture  
MFT CONSULTING ENGINEERS, INC. Anil Verma Associates, Inc.  
1773 San Pablo Ave., Suite A3 (510) 222-4100  
Palo Alto, CA 94304 Fax (650) 222-8410


Looswood, Andrews  
& Newman, Inc.  
A LEO A DALY COMPANY  
T-Y-LIN INTERNATIONAL  
APPROVED

BART  
SILICON VALLEY  
BART SILICON VALLEY BERRYESSA EXTENSION

LINE, TRACK, STATIONS AND SYSTEMS  
DESIGN UNIT 023  
MILPITAS STATION  
SMOKE CONTROL FAN ROOM  
FRAMING PLAN

CADD FILENAME  
C700-S-DB-S133.dwg  
SIZE SCALE  
D 1/8" = 1'-0"  
CONTRACT NO. C700 REV. 0  
AREA CODE SHEET NO. DB S133 PAGE NO. 0166



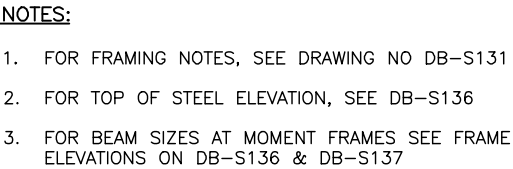

**Santa Clara Valley Transportation Authority**

\_\_\_\_ **NO EXCEPTIONS TAKEN (NET)**  
\_\_\_\_ **MAKE CORRECTIONS NOTED (MCN)**  
\_\_\_\_ **AMEND AND RESUBMIT (A/R)**


Any action shown above is subject to the terms of the contract and does not relieve the Contractor of any of its obligations under the contract, including design and detailing.

Contract No.: \_\_\_\_\_ **DB11002F**

By: \_\_\_\_\_ Date: \_\_\_\_\_


8' 0' 8' 16'

GRAPHIC SCALE

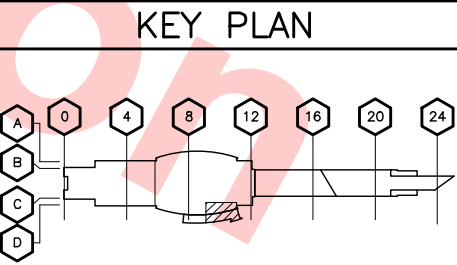[illegible]



Jul 05, 2013 1:51pm P:\BART Berryessa Extension Line\AS - STRUCTURAL\MILPITAS WORK\6-10-2012\0700-S-DB-S135.dwg

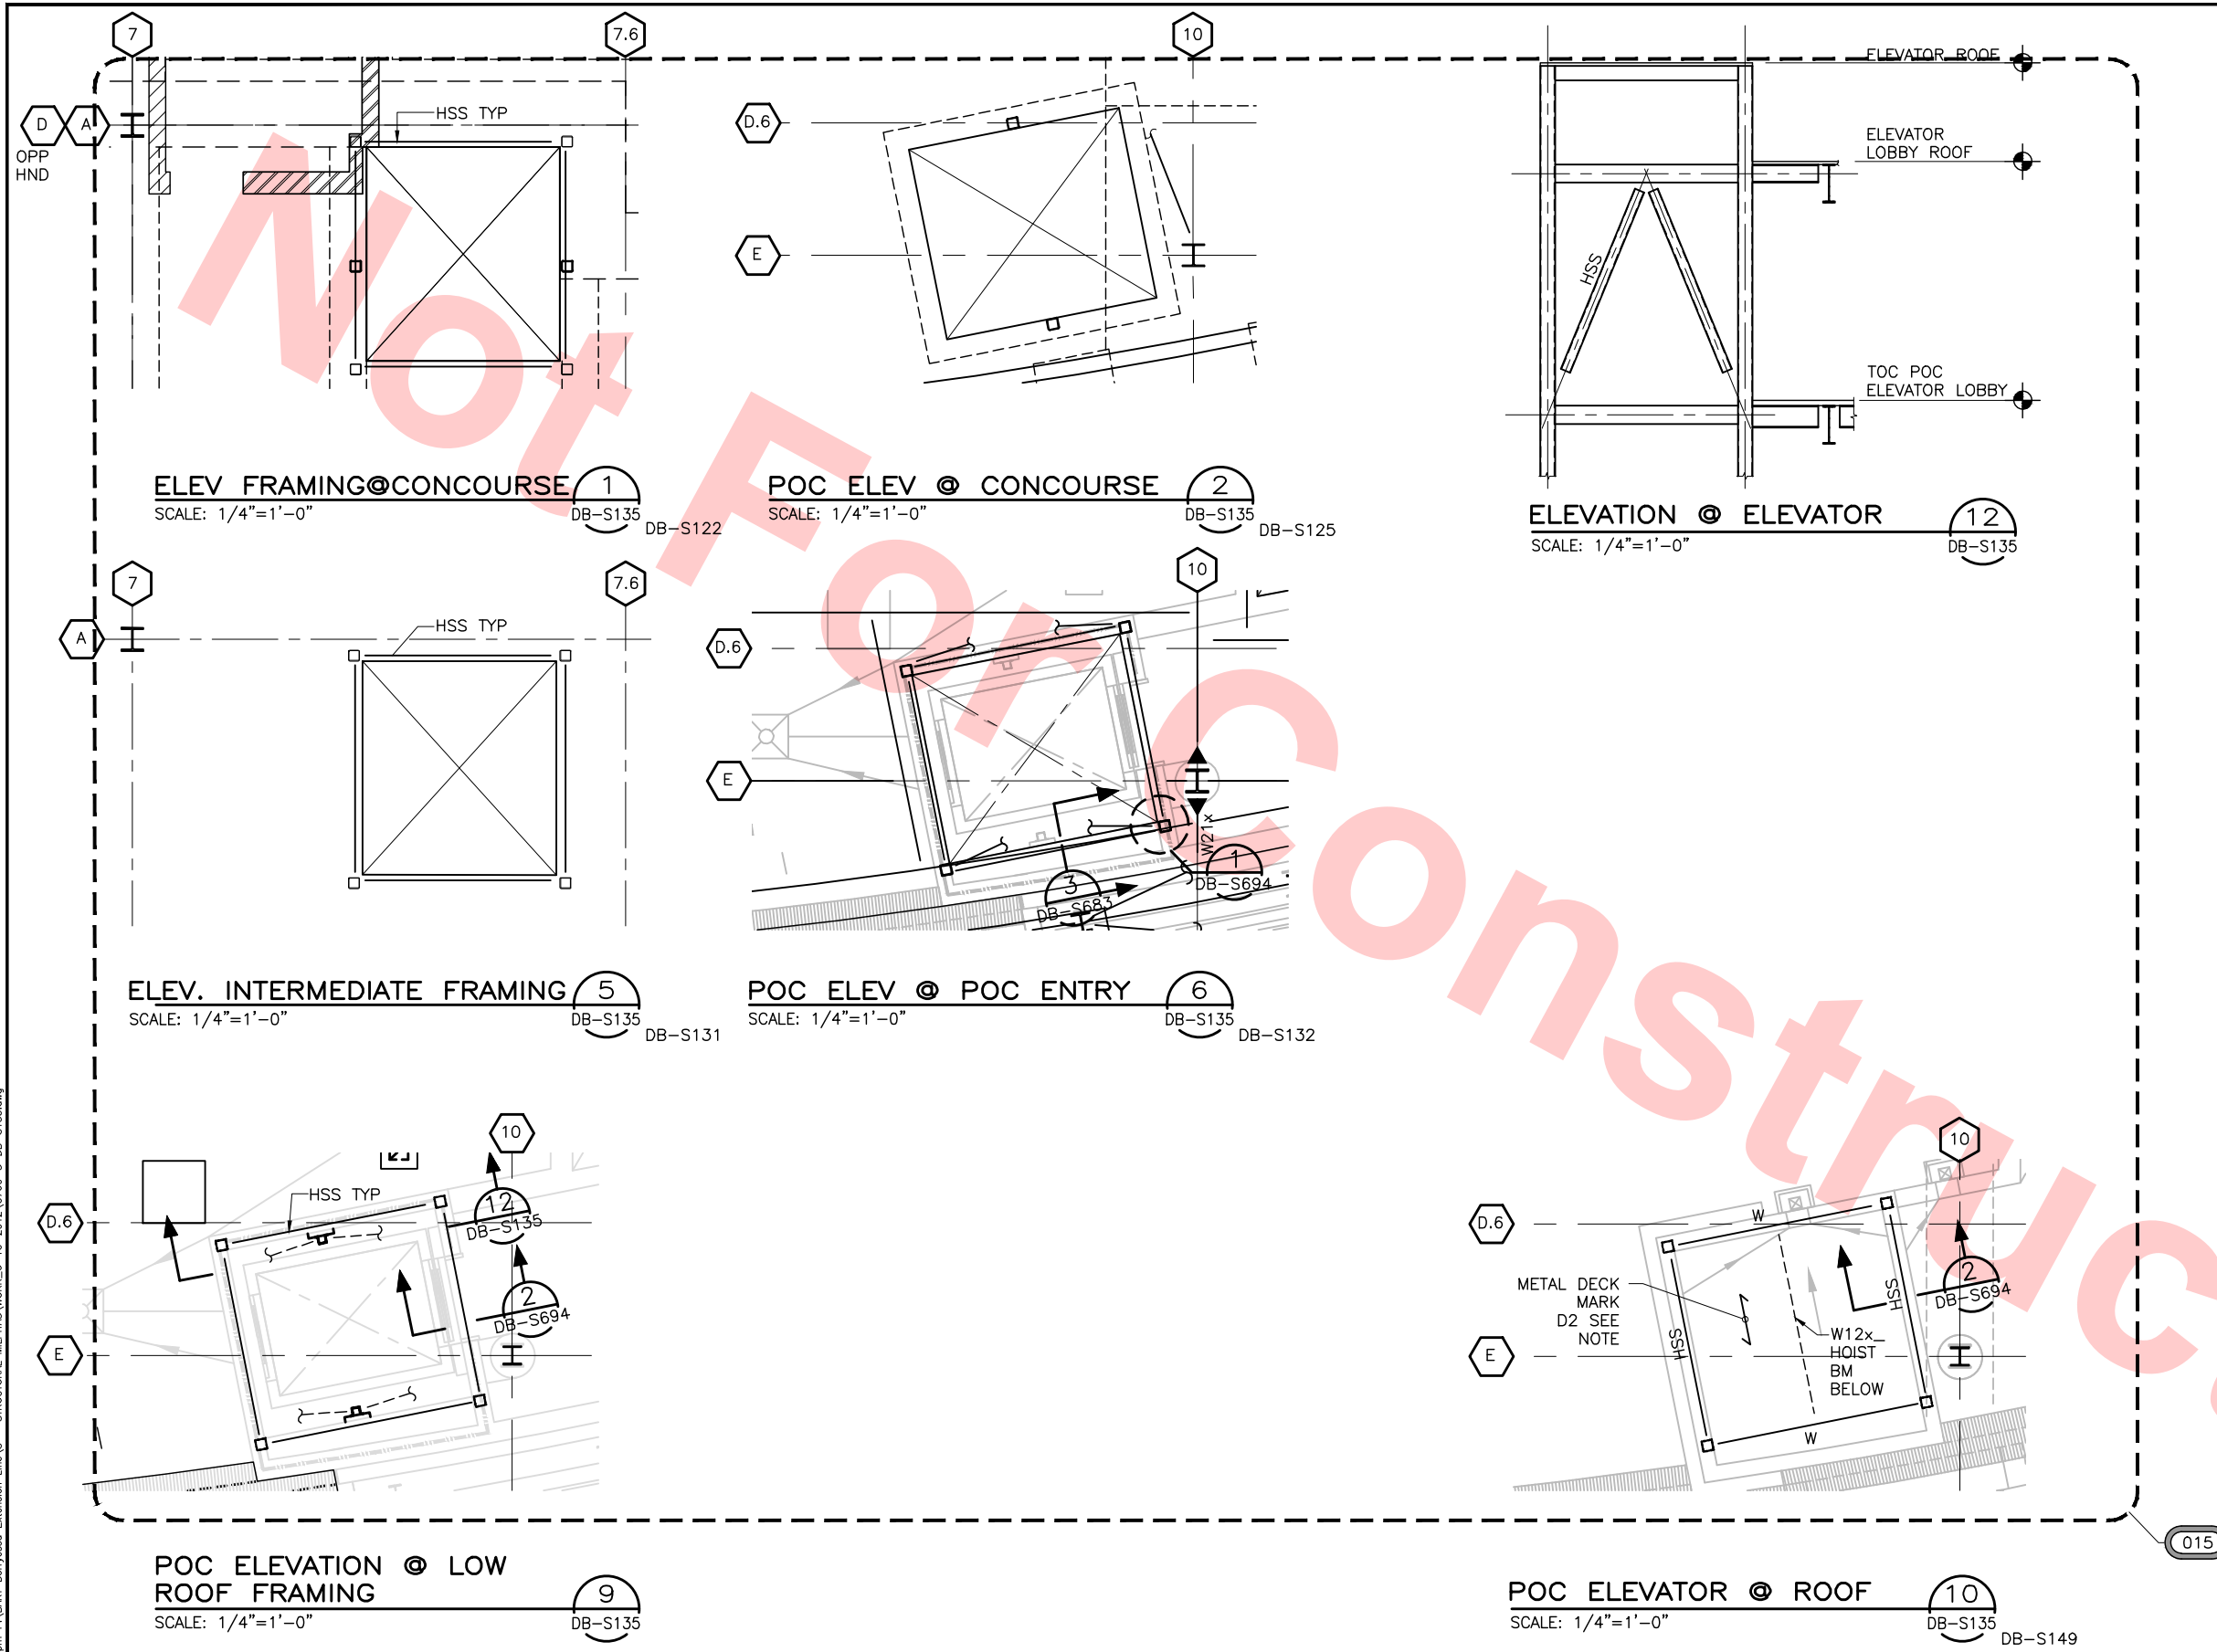


Santa Clara Valley Transportation Authority

NO EXCEPTIONS TAKEN (NET)  
MAKE CORRECTIONS NOTED (MCN)  
AMEND AND RESUBMIT (A/R)

Any action shown above is subject to the terms of the contract and does not relieve the Contractor of any of its obligations under the contract, including design and detailing.


Contract No.: DB11002F

By: Date:

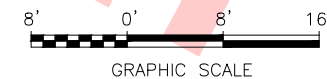


DESIGNED BY J. REBER, S.E.
DRAWN BY P. DIAZ
CHECKED BY M. TARAZI
IN CHARGE M. TARAZI
DATE 20130710

0	20130710				READINESS FOR CONSTRUCTION
REV	DATE	BY	SUB	APP	DESCRIPTION

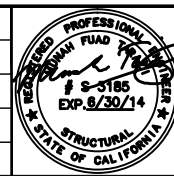


Skanska Shimmick Herzog	1436 California Circle Milpitas, California 95035 A Joint Venture
MFT CONSULTING ENGINEERS, Inc. Anil Verma Associates, Inc. 1773 San Pablo Ave., Suite A3 (510) 222-4100 Palo Alto, CA 94304 Fax (650) 222-8410	Lockwood, Andrews & Newnam, Inc. A LEED A RATED COMPANY T-Y-LIN INTERNATIONAL
SUBMITTED	APPROVED

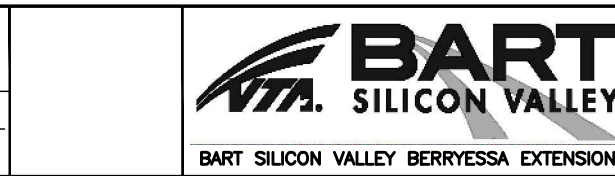

LINE, TRACK, STATIONS AND SYSTEMS DESIGN UNIT 023 MILPITAS STATION ELEVATOR FRAMING PLANS AND SECTIONS	CADD FILENAME C700-S-DB-S135.dwg
SIZE D	SCALE 1/4" = 1'-0"
CONTRACT NO. C700	REV. 0
AREA CODE DB	SHEET NO. S135
	PAGE NO. 0168



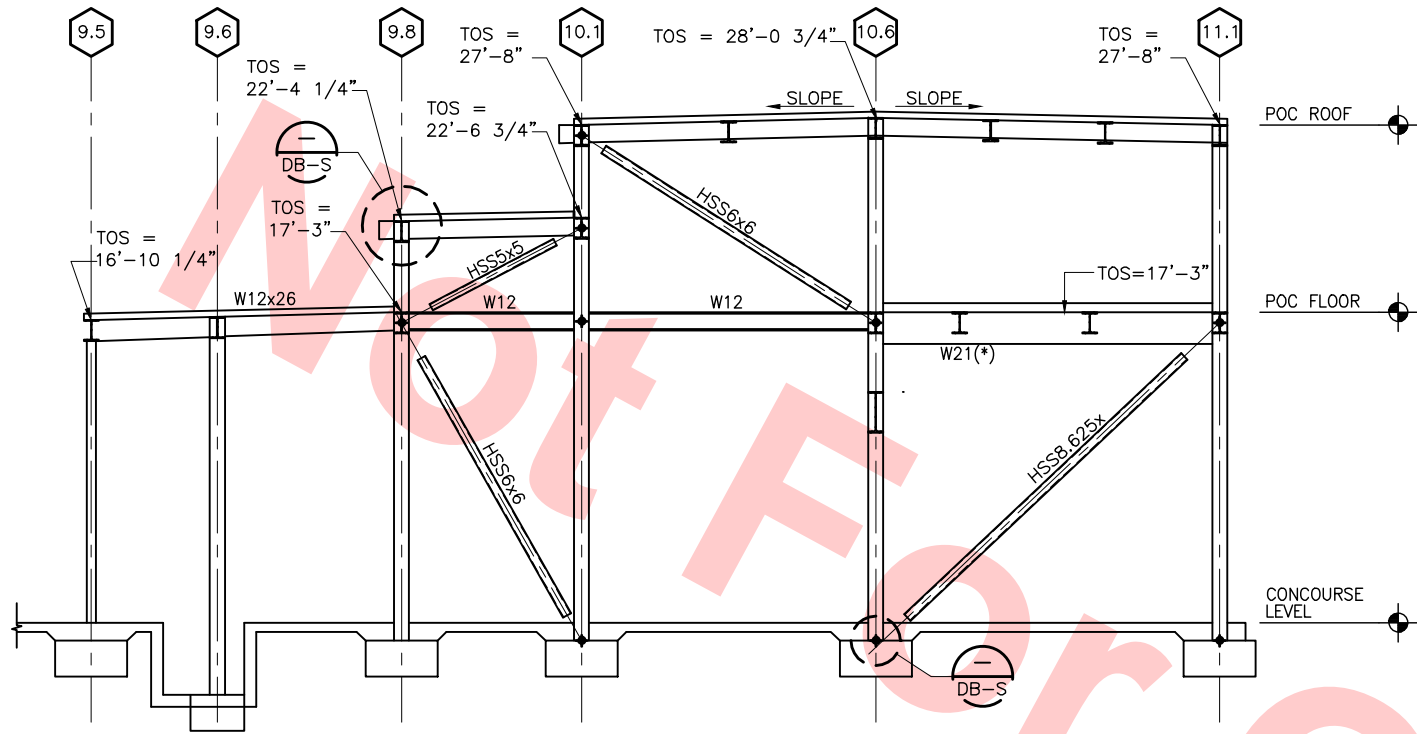


ELEVATION @ GRID D.1

SCALE: 3/16"=1'-0"

1  
DB-S136

DB-S125  
DB-S134  
DB-S149

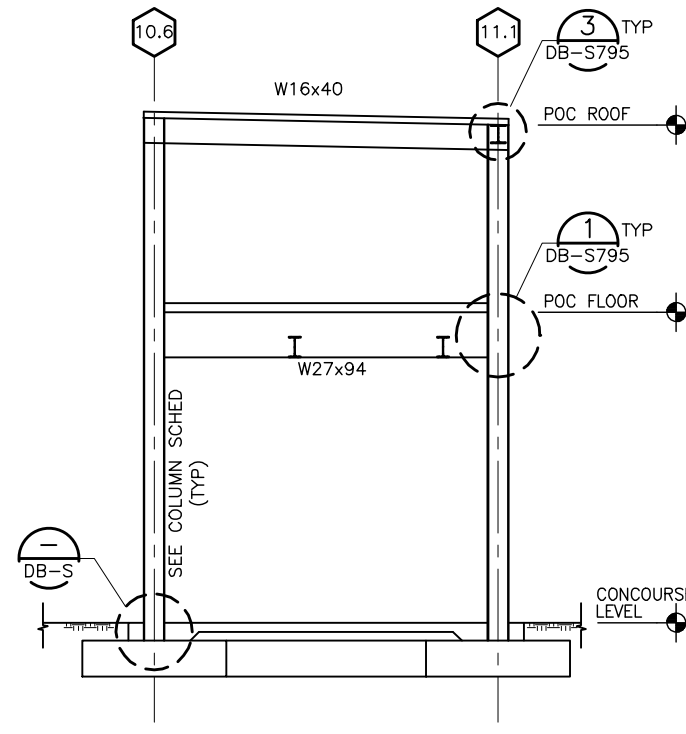


ELEVATION @ GRID D.3

SCALE: 3/16"=1'-0"

2  
DB-S136

DB-S125  
DB-S134  
DB-S149

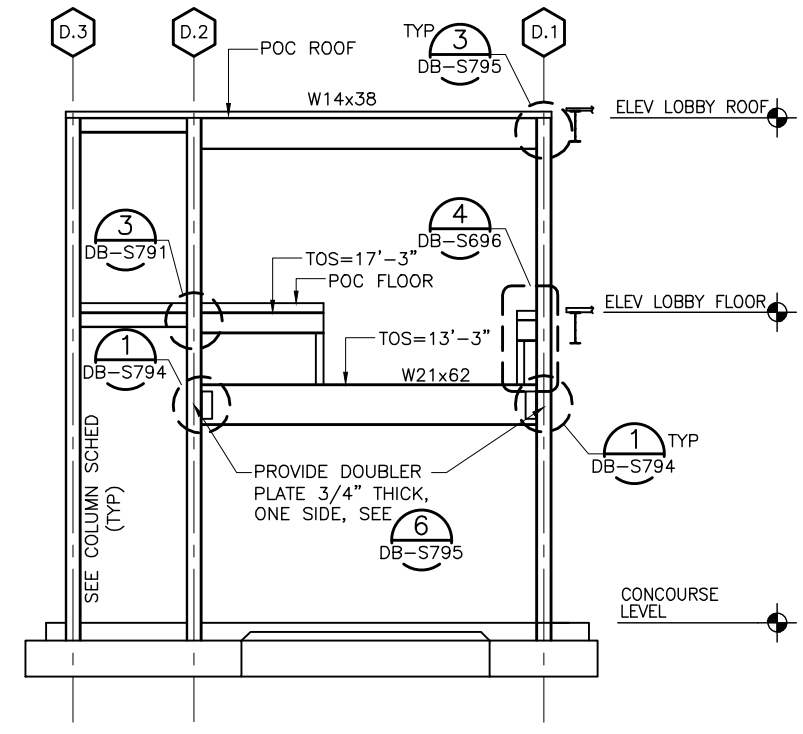


ELEVATION @ GRID 10.6

SCALE: 3/16"=1'-0"

3  
DB-S136

DB-S125  
DB-S134  
DB-S149

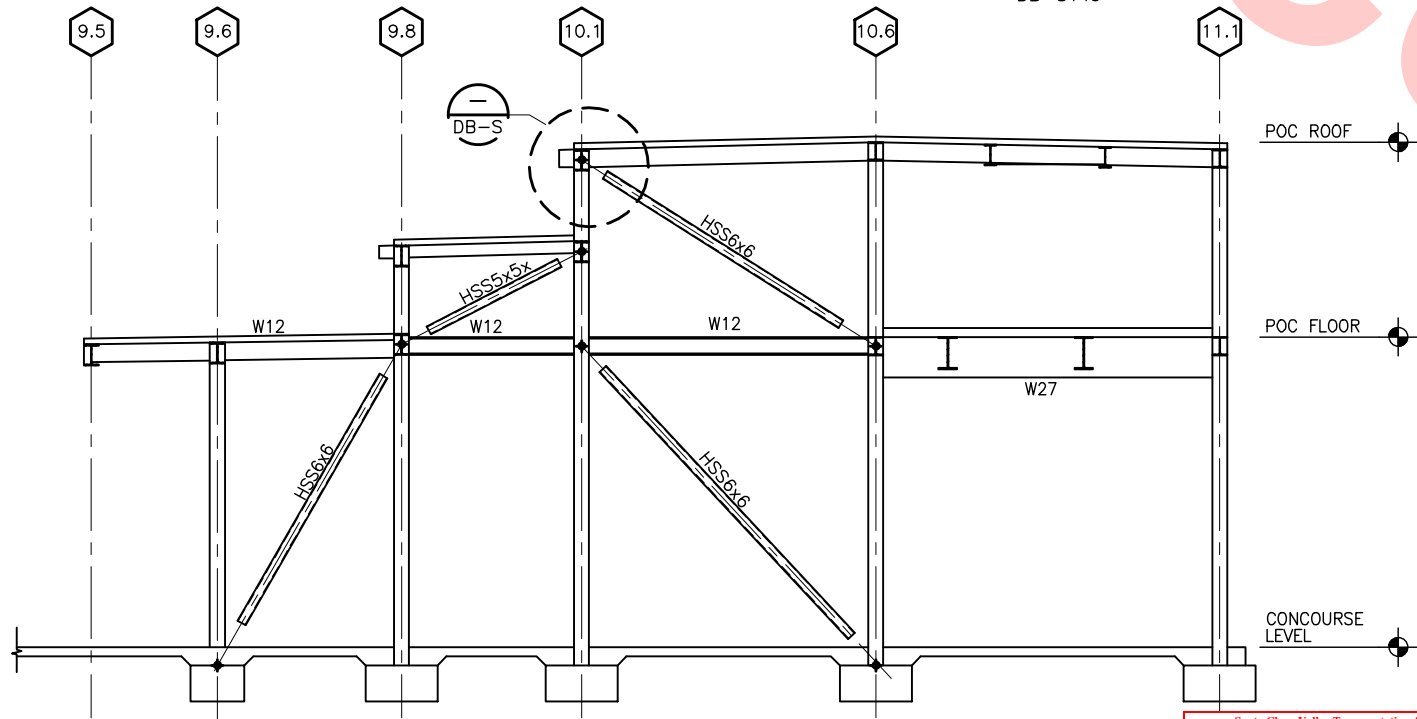


ELEVATION @ GRID D.2

SCALE: 3/16"=1'-0"

4  
DB-S136

DB-S125  
DB-S134  
DB-S149

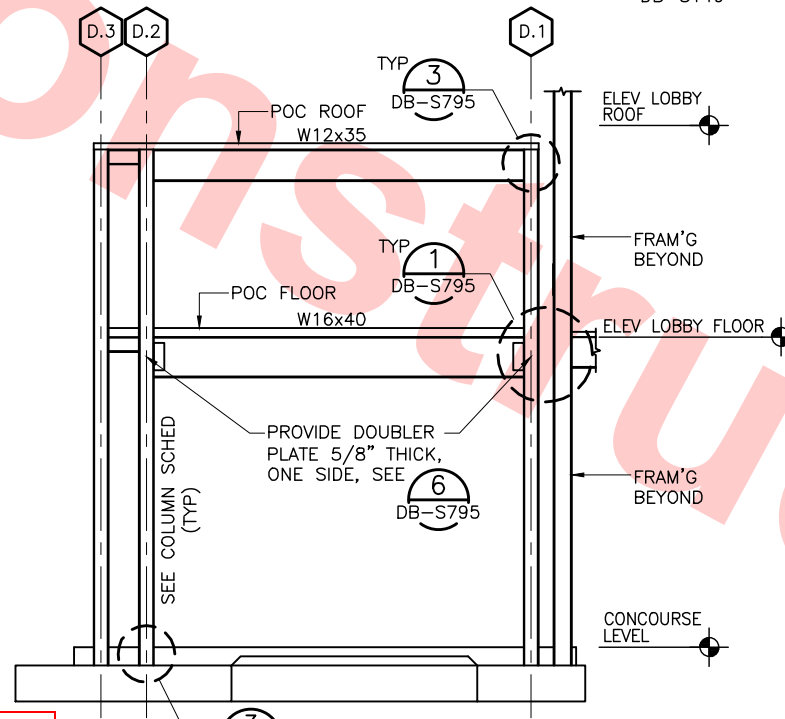


ELEVATION @ GRID 11.1

SCALE: 3/16"=1'-0"

5  
DB-S136

DB-S125  
DB-S134  
DB-S149

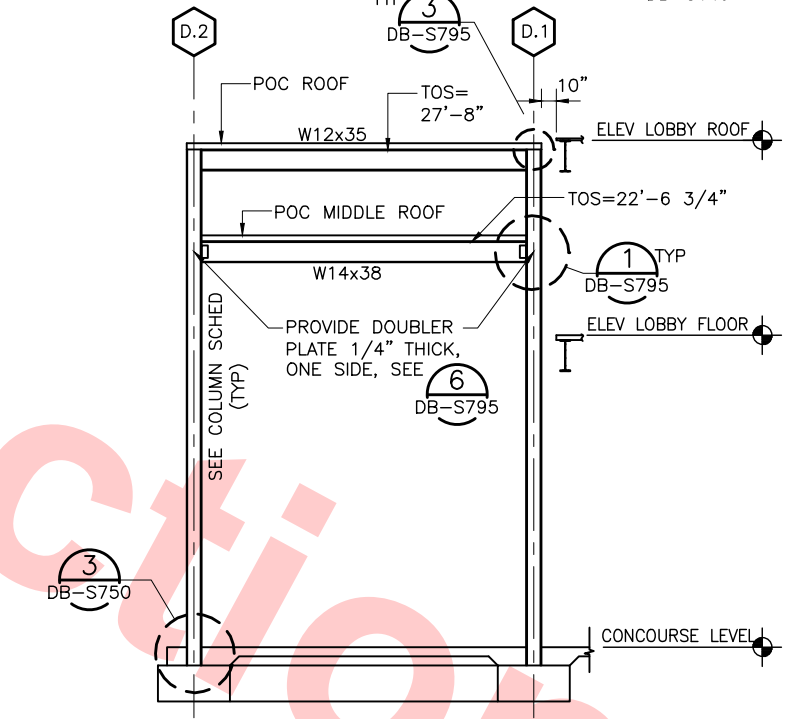

ELEVATION @ GRID 10.1

SCALE: 3/16"=1'-0"

6  
DB-S136


DB-S125  
DB-S134  
DB-S149

Santa Clara Valley Transportation Authority  
NO EXCEPTIONS TAKEN (NET)  
MAKE CORRECTIONS NOTED (MCN)  
AMEND AND RESUBMIT (A/R)  
Any action shown above is subject to the terms of the contract and does not relieve the Contractor of any of its obligations under the contract, including design and detailing.  
Contract No.: DB11002F  
By: \_\_\_\_\_ Date: \_\_\_\_\_

Jul 05, 2013 1:51pm P:\BART Berryessa Extension Line\A-S - STRUCTURAL MILPITAS WORK\6-10-2012\0700-S-DB-S136.dwg

REV	DATE	BY	SUB	APP	DESCRIPTION
0	20130710				READINESS FOR CONSTRUCTION

DESIGNED BY  
J. REBER, S.E.  
DRAWN BY  
P. DIAZ  
CHECKED BY  
M. TARAZI  
IN CHARGE  
M. TARAZI  
DATE  
20130710

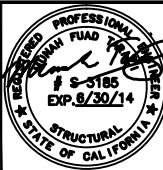

Skanska  
Shimmick  
Herzog  
1436 California Circle  
Milpitas, California 95035  
A Joint Venture  
MFT CONSULTING ENGINEERS, Inc. Anil Verma Associates, Inc.  
1773 San Pablo Ave., Suite A3 (510) 222-4100  
Palo Alto, CA 94304 Fax (415) 222-8410

Lealwood, Andrews & Newman, Inc. T-Y-LIN INTERNATIONAL  
A LEAD & BALLY COMPANY  
APPROVED




LINE, TRACK, STATIONS AND SYSTEMS  
DESIGN UNIT 023  
MILPITAS STATION  
POC ENTRY FRAME ELEVATIONS  
AND DETAILS  
SHEET 1 OF 2

CADD FILENAME C700-S-DB-S136.dwg	REV.
SIZE SCALE D 3/16" = 1'-0"	0
CONTRACT NO. C700	
AREA CODE SHEET NO. DB S136	PAGE NO. 0169



Jul 05, 2013 1:51pm P:\BART Berryessa Extension Line\AS - STRUCTURAL\MILPITAS\WORK\_6-10-2012\C700-S-DB-S137.dwg

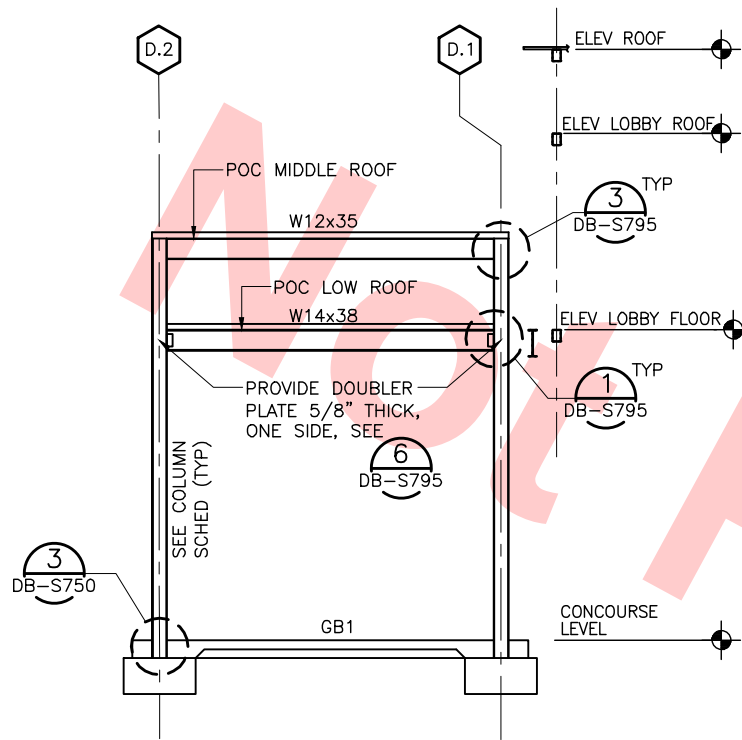


ELEVATION @ GRID 9.8

SCALE: 3/16"=1'-0"

DB-S137

DB-S125  
DB-S134  
DB-S149

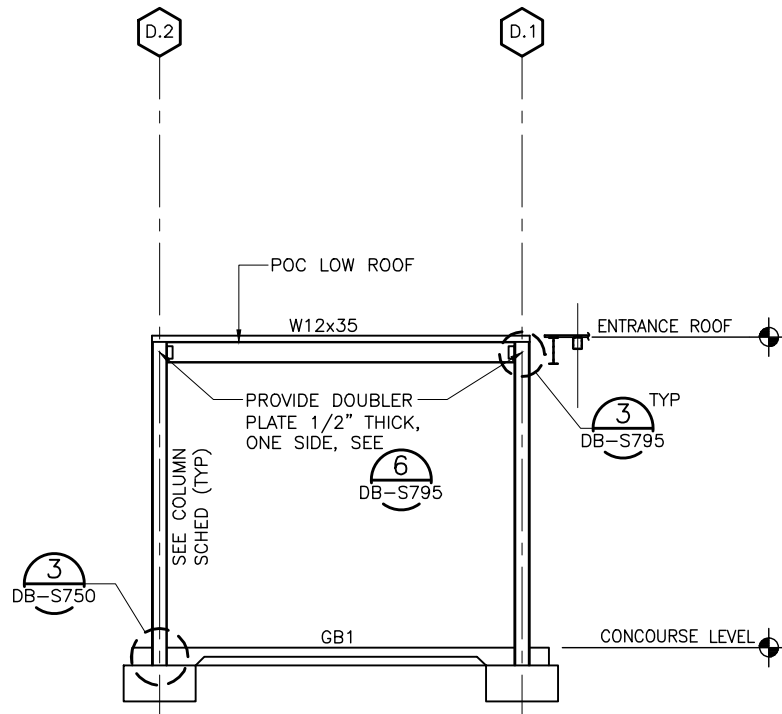

ELEVATION @ GRID 9.6

SCALE: 3/16"=1'-0"

DB-S137

DB-S125  
DB-S134  
DB-S149

Santa Clara Valley Transportation Authority

\_\_\_NO EXCEPTIONS TAKEN (NET)  
\_\_\_MAKE CORRECTIONS NOTED (MCN)  
\_\_\_AMEND AND RESUBMIT (A/R)


Any action shown above is subject to the terms of the contract and does not relieve the Contractor of any of its obligations under the contract, including design and detailing.

Contract No.: DB11002F

By: \_\_\_\_\_ Date: \_\_\_\_\_

REV	DATE	BY	SUB	APP	DESCRIPTION
0	20130710				READINESS FOR CONSTRUCTION

DESIGNED BY  
J. REBER, S.E.  
DRAWN BY  
P. DIAZ  
CHECKED BY  
M. TARAZI  
IN CHARGE  
M. TARAZI  
DATE  
20130710

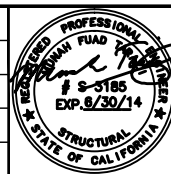

Skanska  
Shimmick  
Herzog  
1436 California Circle  
Milpitas, California 95035  
A Joint Venture  
MFT CONSULTING ENGINEERS, INC. Anil Verma Associates, Inc.  
1773 San Pablo Ave., Suite A3 (510) 222-4100  
Palo Alto, CA 94304 Fax (415) 222-8410




Lockwood, Andrews  
& Newnam, Inc.  
T-Y-LIN INTERNATIONAL  
APPROVED



LINE, TRACK, STATIONS AND SYSTEMS  
DESIGN UNIT 023  
MILPITAS STATION  
POC ENTRY FRAME ELEVATIONS  
AND DETAILS  
SHEET 2 OF 2

CADD FILENAME C700-S-DB-S137.dwg	SIZE D	SCALE 3/8" = 1'-0"
CONTRACT NO. C700	SHEET NO. S137	PAGE NO. 0170



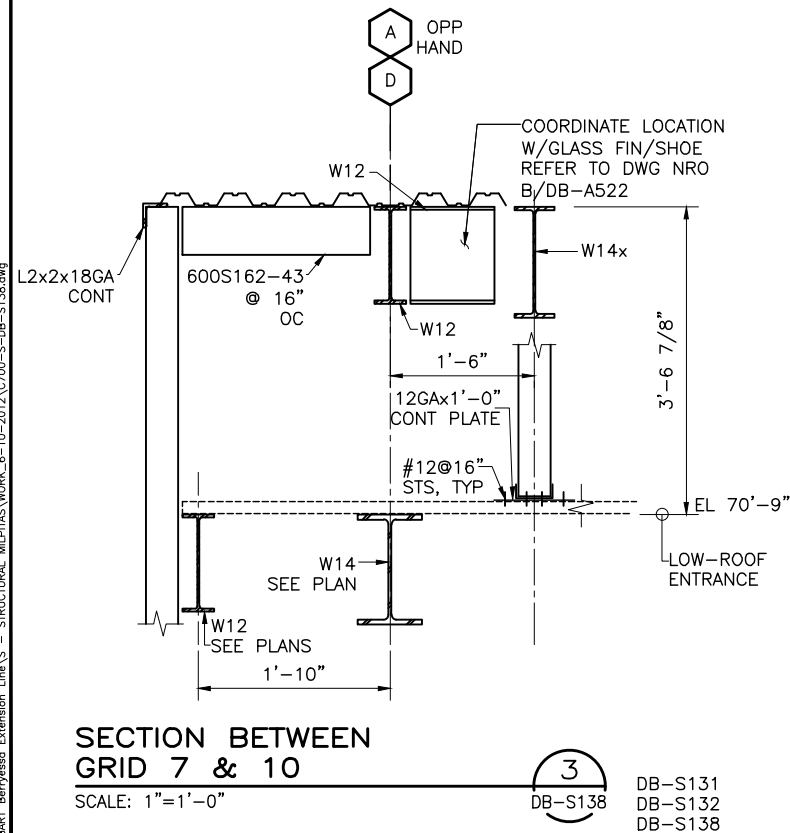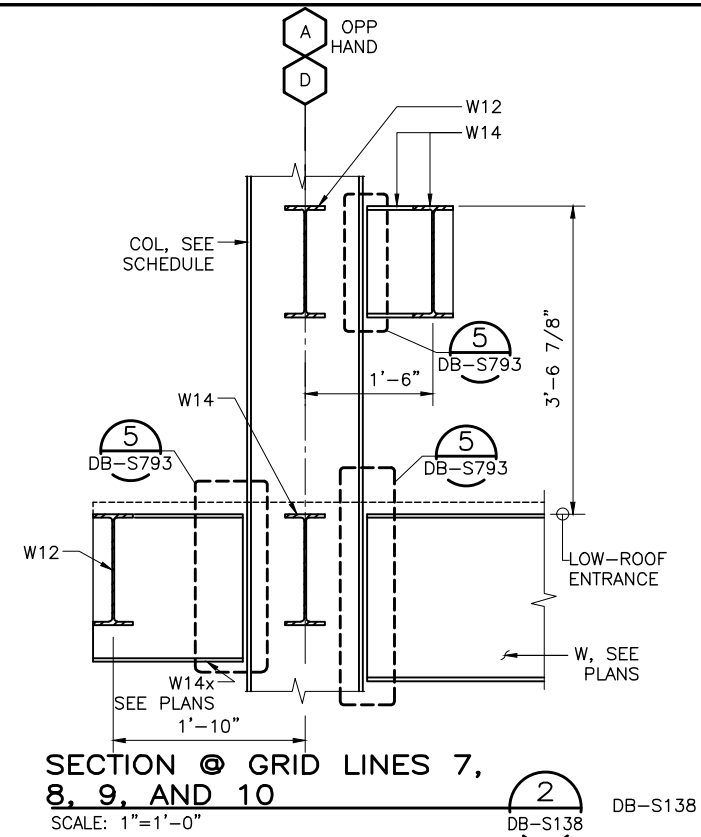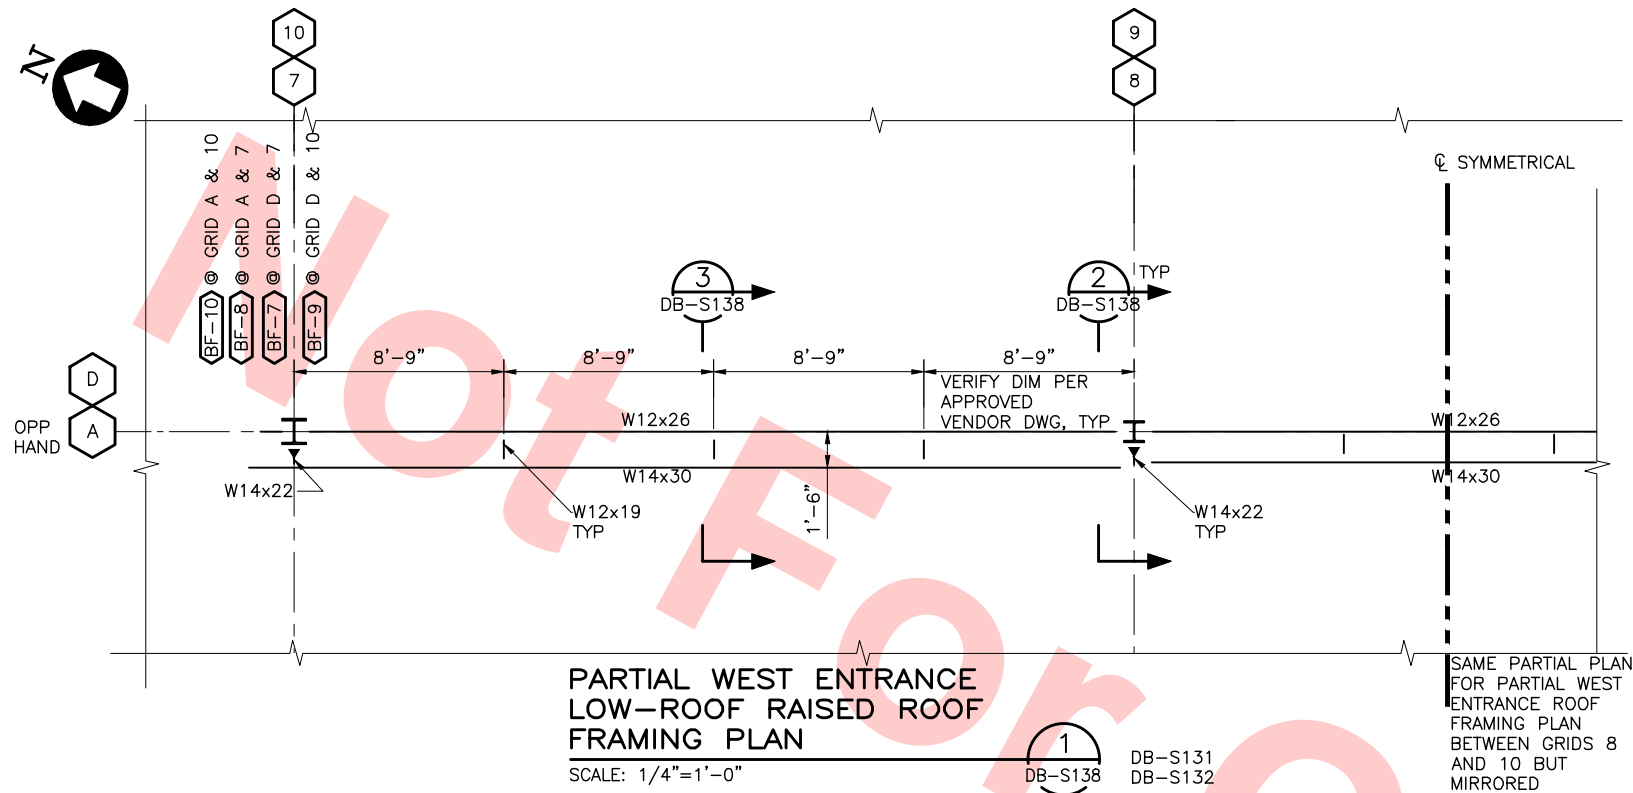

Santa Clara Valley Transportation Authority

NO EXCEPTIONS TAKEN (NET)  
MAKE CORRECTIONS NOTED (MCN)  
AMEND AND RESUBMIT (A/R)


Any action shown above is subject to the terms of the contract and does not relieve the Contractor of any of its obligations under the contract, including design and detailing.

Contract No.: DB11002F

By: \_\_\_\_\_ Date: \_\_\_\_\_

c:\p\2013\0710\BART Berryessa Extension Line\AS - STRUCTURAL\MILPITAS WORK\8-10-2012\0700-S-DB-S138.dwg  
Jul 05, 2013 1:51pm P:\BART Berryessa Extension Line\AS - STRUCTURAL\MILPITAS WORK\8-10-2012\0700-S-DB-S138.dwg

DESIGNED BY J. REBER, S.E.	
DRAWN BY P. DIAZ	
CHECKED BY M. TARAZI	
IN CHARGE M. TARAZI	
DATE 20130710	
REV	DATE
BY	SUB
APP	DESCRIPTION
0	20130710
	READINESS FOR CONSTRUCTION

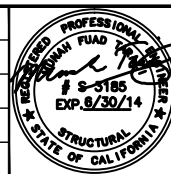

**Skanska Shimmick Herzog**

1436 California Circle  
Milpitas, California 95035  
A Joint Venture

MFT CONSULTING ENGINEERS, Inc. Anil Verma Associates, Inc.  
1773 San Pablo Ave., Suite A3 (510) 222-4100  
Pinole, CA 94664 Fax (510) 222-8100

Lealwood, Andrews & Newman, Inc. T-Y-LIN INTERNATIONAL  
A LEAD A BALLY COMPANY

SUBMITTED *[Signature]* APPROVED *[Signature]*




LINE, TRACK, STATIONS AND SYSTEMS  
DESIGN UNIT 023  
MILPITAS STATION  
PARTIAL WEST ENTRANCE ROOF  
FRAMING PLAN

CADD FILENAME C700-S-DB-S138.dwg	
SIZE D	SCALE AS NOTED
CONTRACT NO. C700	REV. 0
AREA CODE DB	SHEET NO. S138
	PAGE NO. 0171



04-02 Jul 05, 2013 1:51pm P:\BART Berryessa Extension Line\AS - STRUCTURAL MILPITAS WORK\B-10-2012\0700-S-DB-S140.dwg

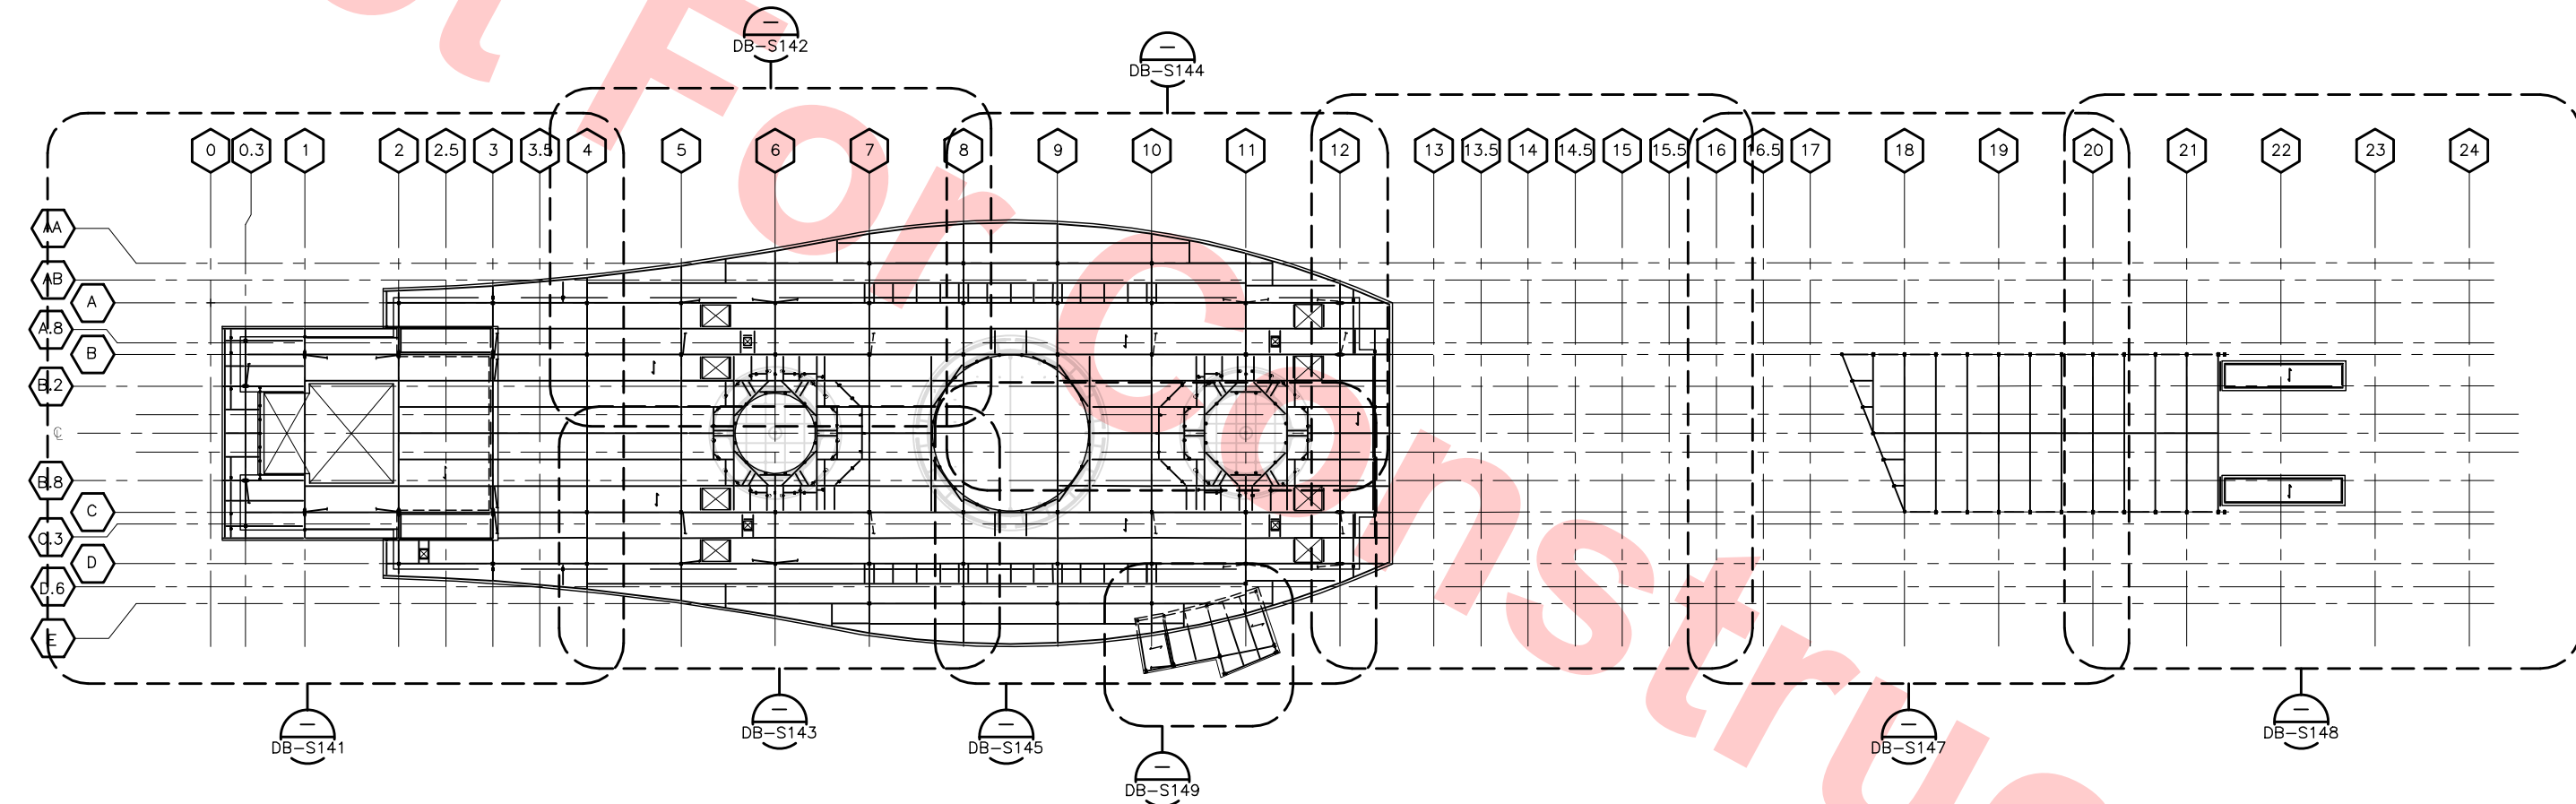

KEY PLAN ROOF LEVEL FRAMING  
SCALE: 1/32"=1'-0"  
DB-S140


Santa Clara Valley Transportation Authority

NO EXCEPTIONS TAKEN (NET)  
MAKE CORRECTIONS NOTED (MCN)  
AMEND AND RESUBMIT (A/R)

Any action shown above is subject to the terms of the contract and does not relieve the Contractor of any of its obligations under the contract, including design and detailing.

Contract No.: DB11002F

By: \_\_\_\_\_ Date: \_\_\_\_\_

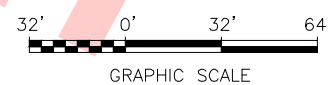

REV	DATE	BY	SUB	APP	DESCRIPTION
0	20130710				READINESS FOR CONSTRUCTION

DESIGNED BY  
J. REBER, S.E.  
DRAWN BY  
P. DIAZ  
CHECKED BY  
M. TARAZI  
IN CHARGE  
M. TARAZI  
DATE  
20130710



Skanska  
Shimmick  
Herzog

MFT CONSULTING ENGINEERS, Inc. Anil Verma Associates, Inc.  
1773 San Pablo Ave., Suite A3 (510) 222-4100  
Palo Alto, CA 94304 Fax (510) 222-8410

1436 California Circle  
Milpitas, California 95035  
A Joint Venture

Lealwood, Andrews & Newman, Inc. T-Y-LIN INTERNATIONAL  
1773 San Pablo Ave., Suite A3 (510) 222-4100  
Palo Alto, CA 94304 Fax (510) 222-8410



LINE, TRACK, STATIONS AND SYSTEMS  
DESIGN UNIT 023  
MILPITAS STATION  
ROOF LEVEL FRAMING  
KEY PLAN

CADD FILENAME	C700-S-DB-S140.dwg
SIZE	D
SCALE	1/32" = 1'-0"
CONTRACT NO.	C700
REV.	0
AREA CODE	DB
SHEET NO.	S140
PAGE NO.	0172



Jul 08, 2013 - 9:51am P:\BART Berryessa Extension Line\AS - STRUCTURAL\MILPITAS WORK\6-10-2012\0700-S-DB-S141.dwg

064-02




Santa Clara Valley Transportation Authority

NO EXCEPTIONS TAKEN (NET)  
MAKE CORRECTIONS NOTED (MCN)  
AMEND AND RESUBMIT (A/R)

Any action shown above is subject to the terms of the contract  
and does not relieve the Contractor of any of its obligations  
under the contract, including design and detailing.

Contract No.: DB11002F

By: \_\_\_\_\_ Date: \_\_\_\_\_

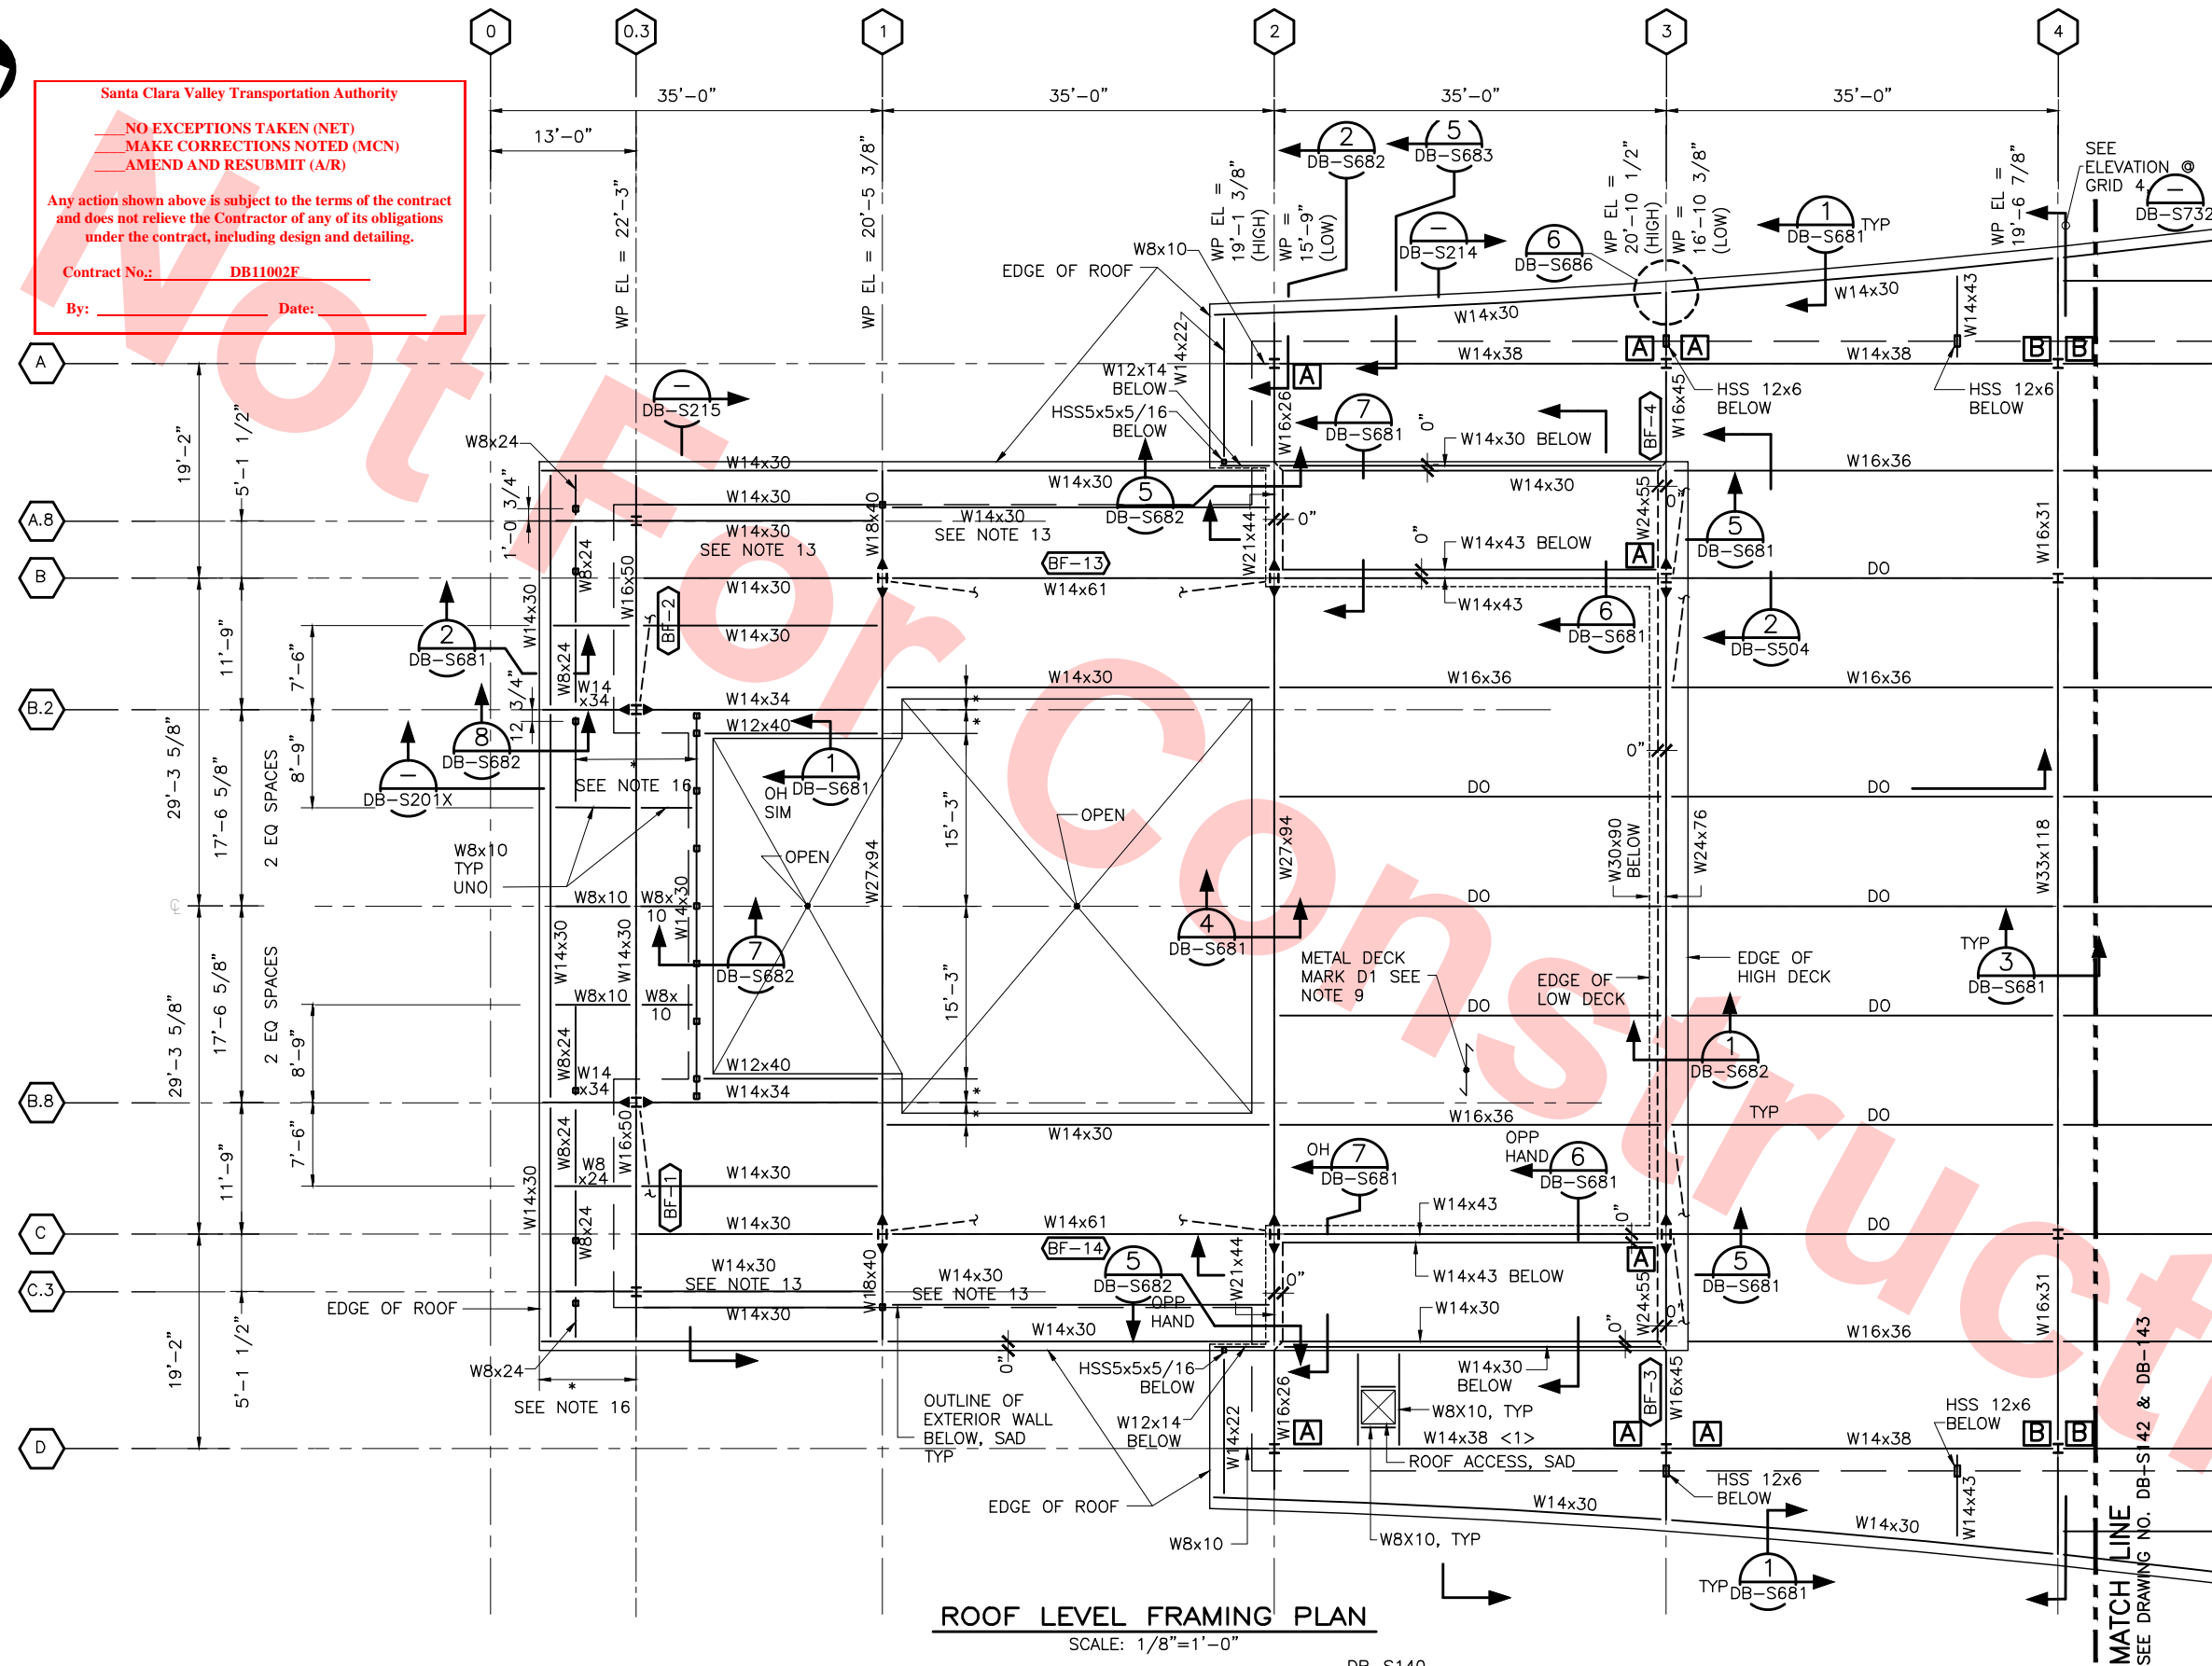



NOTES:

1. FOR ROOF LEVEL FRAMING NOTES, SEE DWG NO DB-S141.

Santa Clara Valley Transportation Authority

- NO EXCEPTIONS TAKEN (NET)  
MAKE CORRECTIONS NOTED (MCN)  
AMEND AND RESUBMIT (A/R)


Any action shown above is subject to the terms of the contract and does not relieve the Contractor of any of its obligations under the contract, including design and detailing.

Contract No.: DB11002F

By: Date:



KEY PLAN

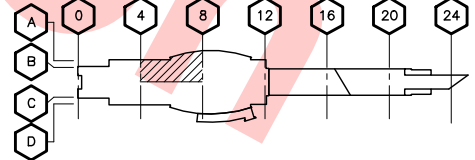

ROOF LEVEL FRAMING PLAN

SCALE: 1/8"=1'-0"  
DB-S140

Jul 08, 2013 1:28pm P:\BART Berryessa Extension Line\AS - STRUCTURAL\MILPITAS WORK\6-10-2012\C700-S-DB-S142.dwg

REV	DATE	BY	SUB	APP	DESCRIPTION
0	20130710				READINESS FOR CONSTRUCTION REPLACED C700-S-DB-S302 REV P.

DESIGNED BY  
J. REBER, S.E.  
DRAWN BY  
P. DIAZ  
CHECKED BY  
M. TARAZI  
IN CHARGE  
M. TARAZI  
DATE  
20130710



Skanska  
Shimmick  
Herzog  
1436 California Circle  
Milpitas, California 95035  
A Joint Venture  
MFT CONSULTING ENGINEERS, INC. Anil Verma Associates, Inc.  
1773 San Pablo Ave., Suite A3 (510) 222-4100  
Pinole, CA 94664 Fax (510) 222-8410


Lealwood, Andrews & Newman, Inc. T-Y-LIN INTERNATIONAL  
A LEAD & BALLY COMPANY  
SUBMITTED APPROVED





LINE, TRACK, STATIONS AND SYSTEMS  
DESIGN UNIT 023  
MILPITAS STATION  
ROOF LEVEL  
FRAMING PLAN  
SHEET 2 OF 9

CADD FILENAME C700-S-DB-S142.dwg	REV. 0
SIZE SCALE D 1/8" = 1'-0"	PAGE NO. 0174
CONTRACT NO. C700	
AREA CODE DB	SHEET NO. S142



 

1. FOR ROOF LEVEL FRAMING NOTES, SEE DWG NO DB-S141.

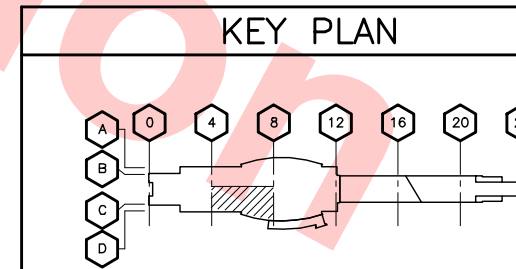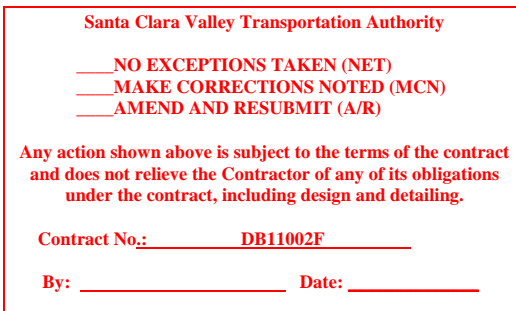

JUL 08, 2013 - 5:00 PM						DESIGNED BY J. REBER, S.E.
						DRAWN BY P. DIAZ
						CHECKED BY M. TARAZI
	0	20130710			READINESS FOR CONSTRUCTION REPLACED C700-S-DB-S303 REV P.	IN CHARGE M. TARAZI
	REV	DATE	BY	SUB	APP	DESCRIPTION
						DATE 20130710

Skanska  
Shimmick  
Herzog

**MFT CONSULTING ENGINEERS, INC.** Anil Verma Associates, Inc.  
1773 San Pablo Ave., Suite A3 (510) 222-4106  
Pinole, CA 94564 Fax (510) 222-4110

**Submittal**

**SUBMITTED**

1436 California Circle  
Milpitas, California 95035  
A Joint Venture

---

**LEN** Lockwood, Andrews & Newmann, Inc.  
A LEO A DALY COMPANY

**T-Y-LIN INTERNATIONAL**

APPROVED *Ry Holmuth*



BART SILICON VALLEY BERRYESSA EXTENSION

LINE, TRACK, STATIONS AND SYSTEMS  
DESIGN UNIT 023  
MILPITAS STATION  
ROOF LEVEL  
FRAMING PLAN  
SHEET 3 OF 9


CADD FILENAME C700-S-DB-S143.dwg		
SIZE D	SCALE 1/8" = 1'-0"	
CONTRACT NO. <b>C700</b>		REV. <b>0</b>
AREA CODE <b>DB</b>	SHEET NO. <b>S143</b>	PAGE NO. <b>0175</b>





NOTES:

1. FOR ROOF LEVEL FRAMING NOTES, SEE DWG NO DB-S141.

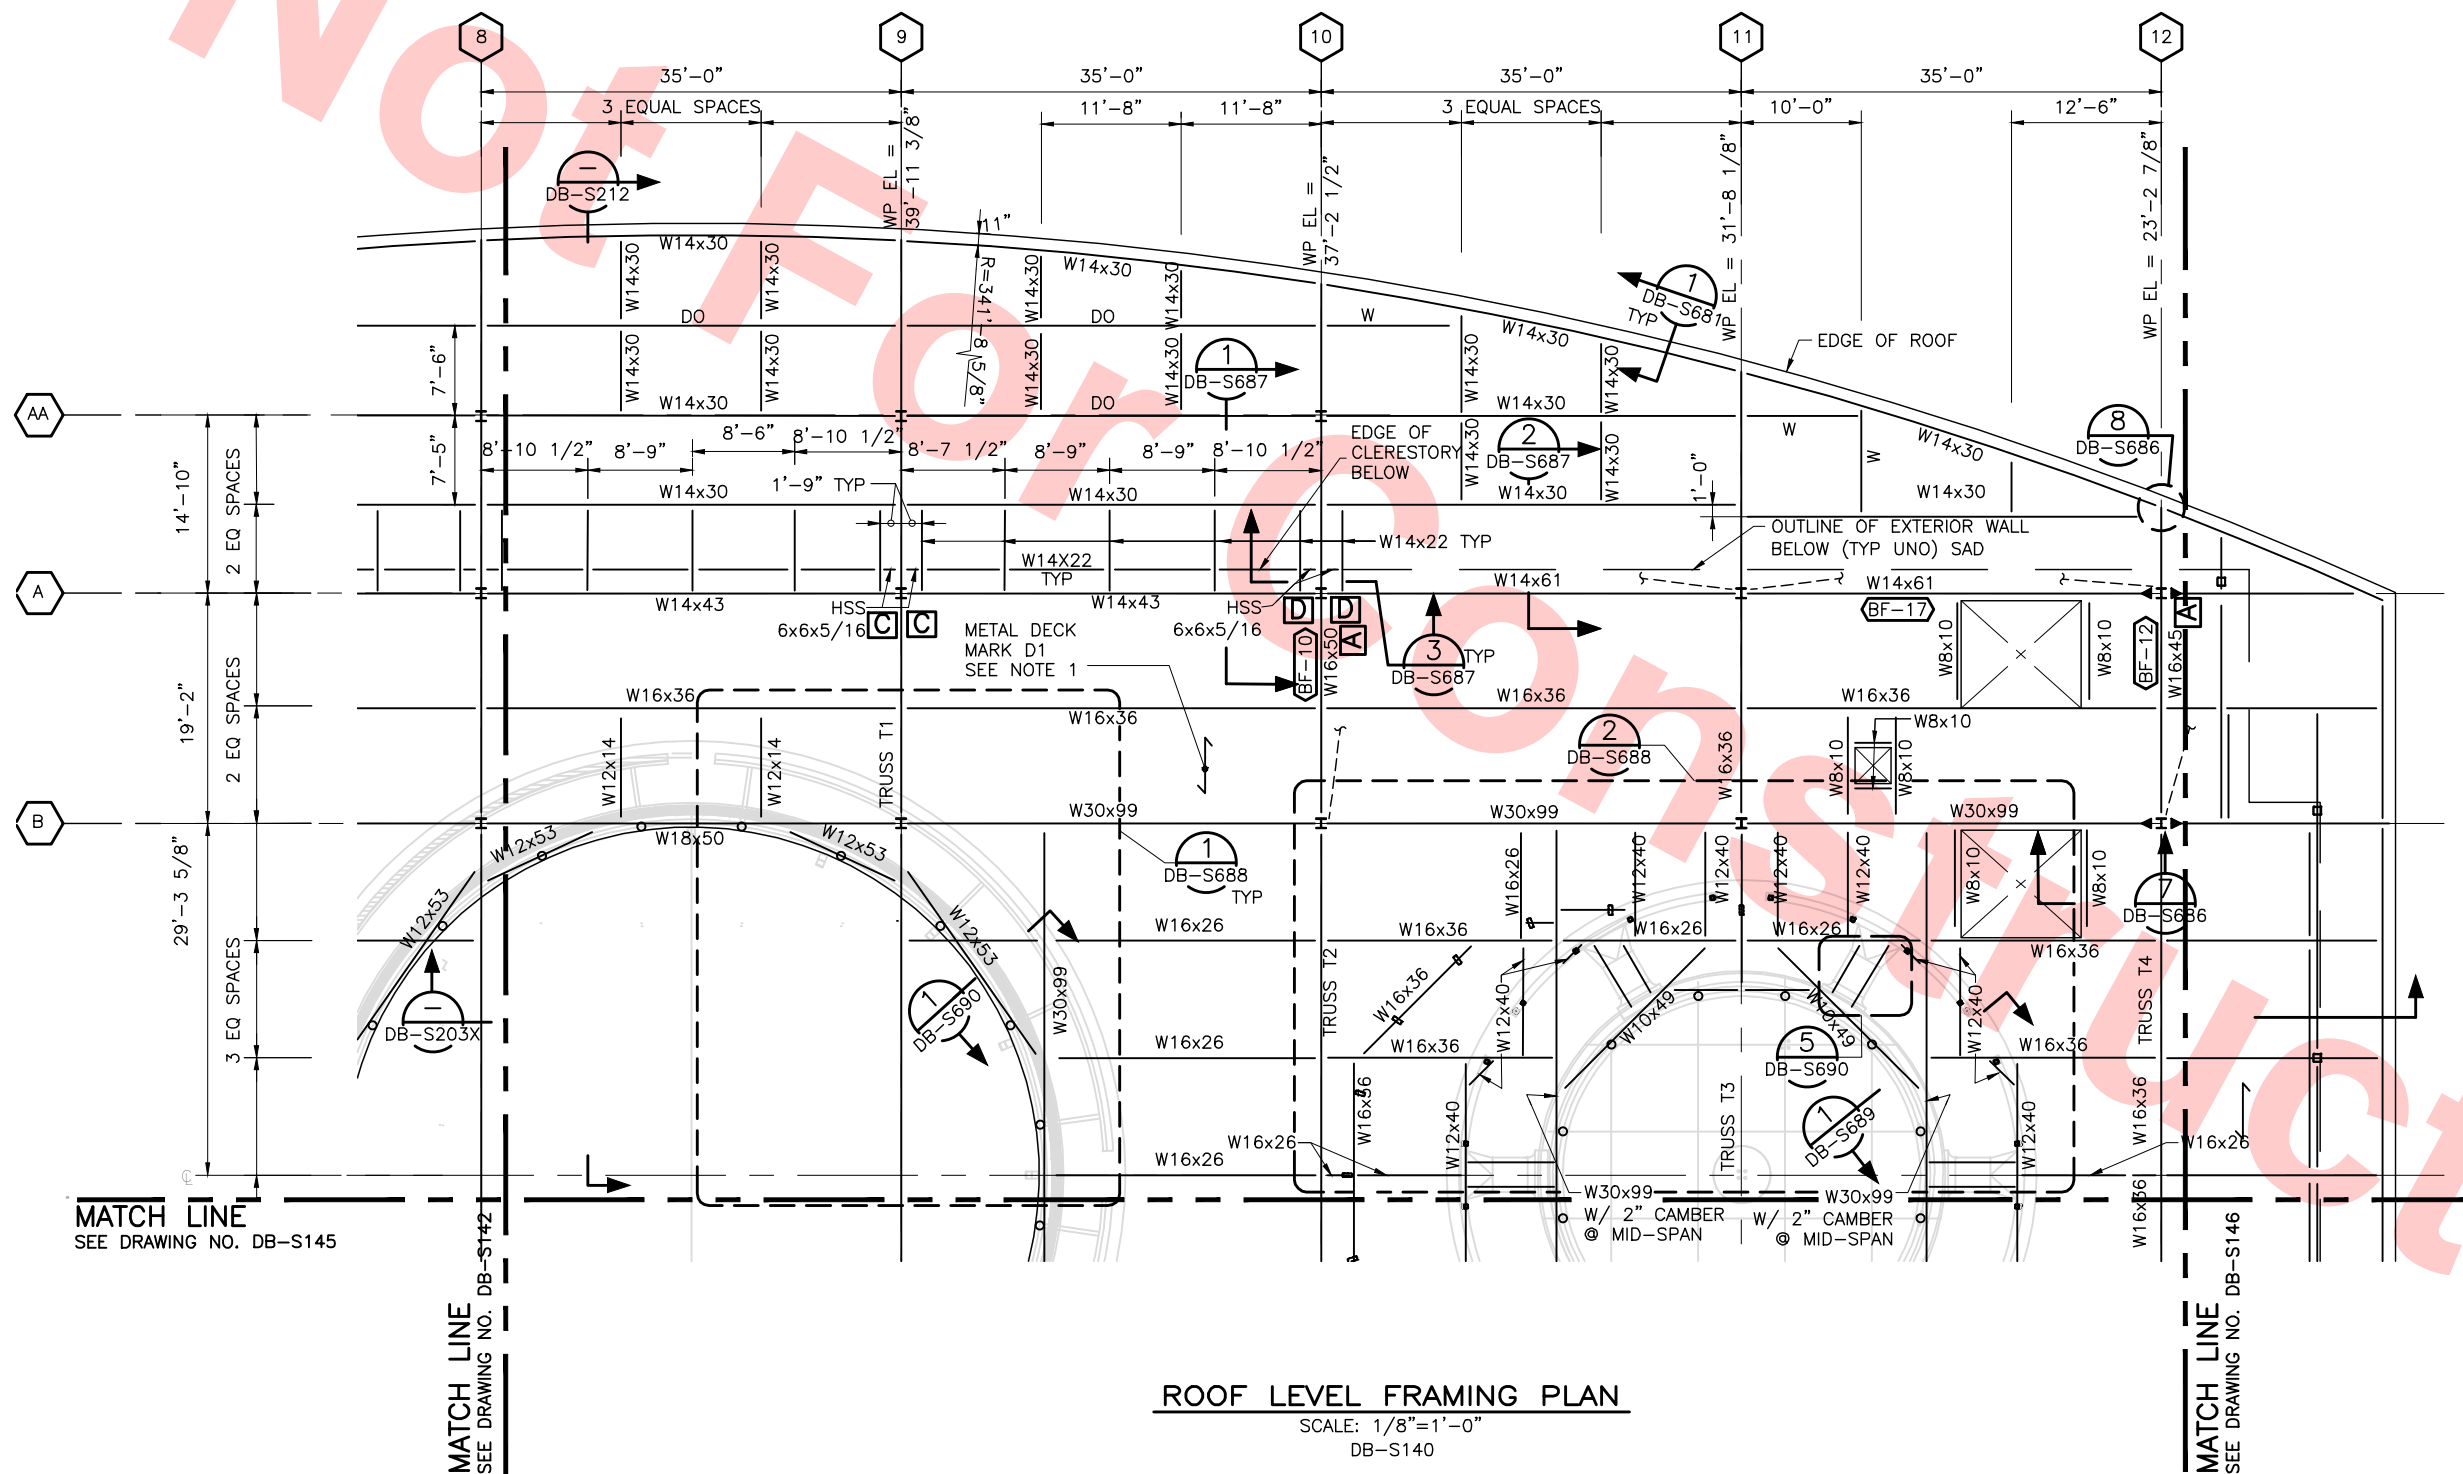

Santa Clara Valley Transportation Authority

NO EXCEPTIONS TAKEN (NET)  
MAKE CORRECTIONS NOTED (MCN)  
AMEND AND RESUBMIT (A/R)


Any action shown above is subject to the terms of the contract and does not relieve the Contractor of any of its obligations under the contract, including design and detailing.

Contract No.: DB11002F

By: \_\_\_\_\_ Date: \_\_\_\_\_



KEY PLAN

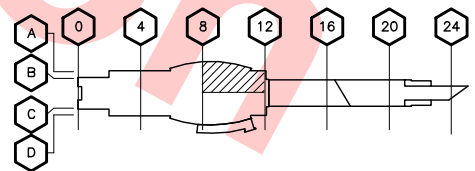

Jul 08, 2013 - 1:28pm P:\BART Berryessa Extension Line\AS - STRUCTURAL\MILPITAS WORK\6-10-2012\C700-S-DB-S144.dwg

REV	DATE	BY	SUB	APP	DESCRIPTION
0	20130710				READINESS FOR CONSTRUCTION REPLACED C700-S-DB-S304 REV P.

DESIGNED BY  
J. REBER, S.E.  
DRAWN BY  
P. DIAZ  
CHECKED BY  
M. TARAZI  
IN CHARGE  
M. TARAZI  
DATE  
20130710



Skanska  
Shimmick  
Herzog

1436 California Circle  
Milpitas, California 95035  
A Joint Venture

MFT CONSULTING ENGINEERS, Inc. Anil Verma Associates, Inc.  
1773 San Pablo Ave., Suite A3 (510) 222-4100  
Palo Alto, CA 94304 Fax (650) 222-8410

Lealwood, Andrews  
& Newman, Inc.  
T-Y-LIN INTERNATIONAL

APPROVED



LINE, TRACK, STATIONS AND SYSTEMS  
DESIGN UNIT 023  
MILPITAS STATION  
ROOF LEVEL  
FRAMING PLAN  
SHEET 4 OF 9


CADD FILENAME C700-S-DB-S144.dwg	REV.	0
SIZE D	SCALE 1/8" = 1'-0"	
CONTRACT NO. C700	SHEET NO. S144	PAGE NO. 0176









Jul 08, 2013 1:28pm P:\BART Berryessa Extension Line\5 - STRUCTURAL\MILPITAS WORK\6-10-2012\C700-S-DB-S146.dwg

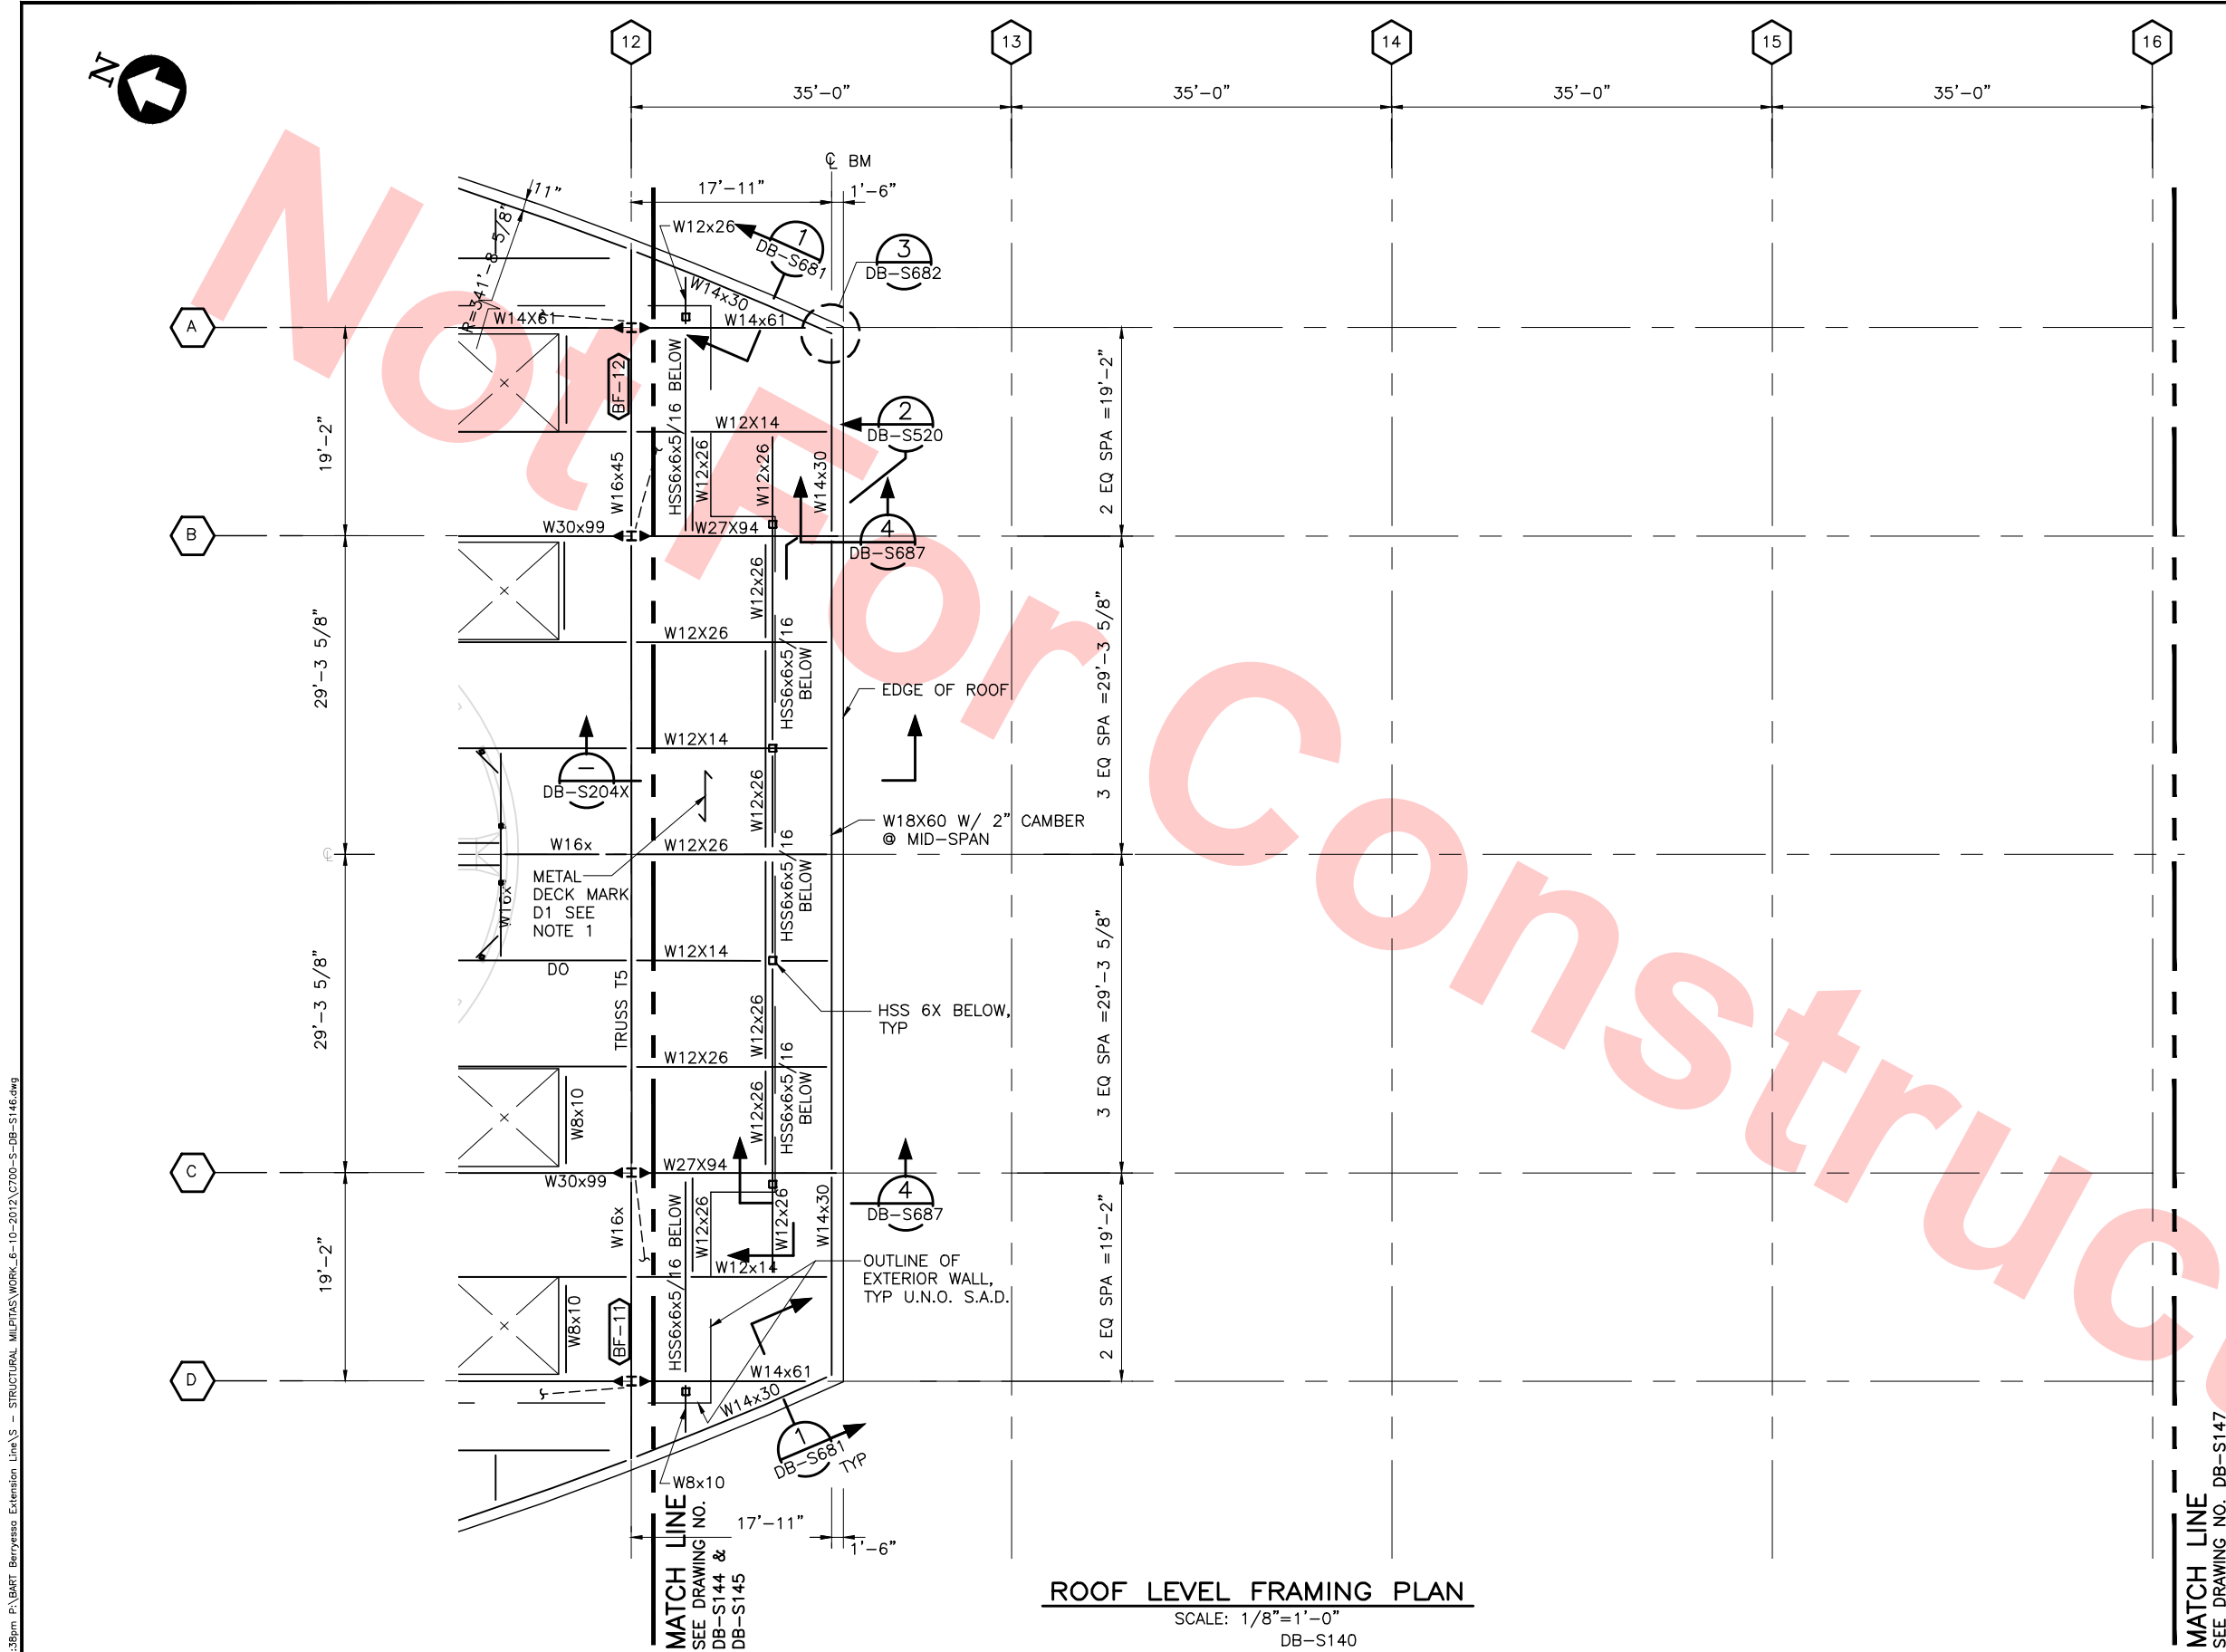

ROOF LEVEL FRAMING PLAN  
SCALE: 1/8" = 1'-0"  
DB-S140


NOTES:  
1. FOR ROOF LEVEL FRAMING NOTES, SEE DWG NO DB-S141.

Santa Clara Valley Transportation Authority  
NO EXCEPTIONS TAKEN (NET)  
MAKE CORRECTIONS NOTED (MCN)  
AMEND AND RESUBMIT (A/R)  
Any action shown above is subject to the terms of the contract and does not relieve the Contractor of any of its obligations under the contract, including design and detailing.  
Contract No.: DB11002F  
By: \_\_\_\_\_ Date: \_\_\_\_\_

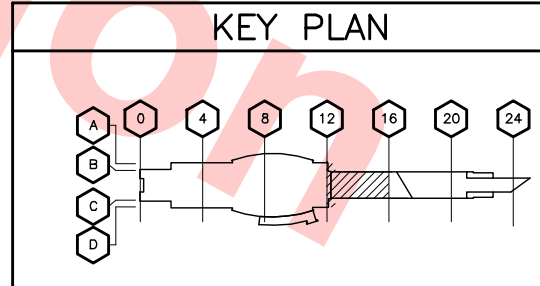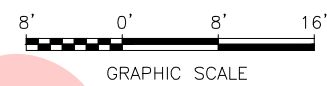

REV	DATE	BY	SUB	APP	DESCRIPTION
0	20130710				READINESS FOR CONSTRUCTION REPLACED C700-S-DB-S306 REV P.

DESIGNED BY  
J. REBER, S.E.  
DRAWN BY  
P. DIAZ  
CHECKED BY  
M. TARAZI  
IN CHARGE  
M. TARAZI  
DATE  
20130710

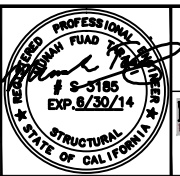

Skanska  
Shimmick  
Herzog  
1436 California Circle  
Milpitas, California 95035  
A Joint Venture  
MFT CONSULTING ENGINEERS, INC. Anil Verma Associates, Inc.  
1773 San Pablo Ave., Suite A3 (510) 222-4168  
Palo Alto, CA 94304 Fax (650) 222-8412

Lealwood, Andrews & Newman, Inc. T-Y-LIN INTERNATIONAL  
1773 San Pablo Ave., Suite A3 (510) 222-4168  
Palo Alto, CA 94304 Fax (650) 222-8412  
APPROVED



LINE, TRACK, STATIONS AND SYSTEMS  
DESIGN UNIT 023  
MILPITAS STATION  
ROOF LEVEL  
FRAMING PLAN  
SHEET 6 OF 9


CADD FILENAME C700-S-DB-S146.dwg	SIZE D	SCALE 1/8" = 1'-0"	CONTRACT NO. C700	REV. 0
AREA CODE DB	SHEET NO. S146	PAGE NO. 0178		





NOTES:

1. FOR ROOF LEVEL FRAMING NOTES, SEE DWG NO DB-S141.

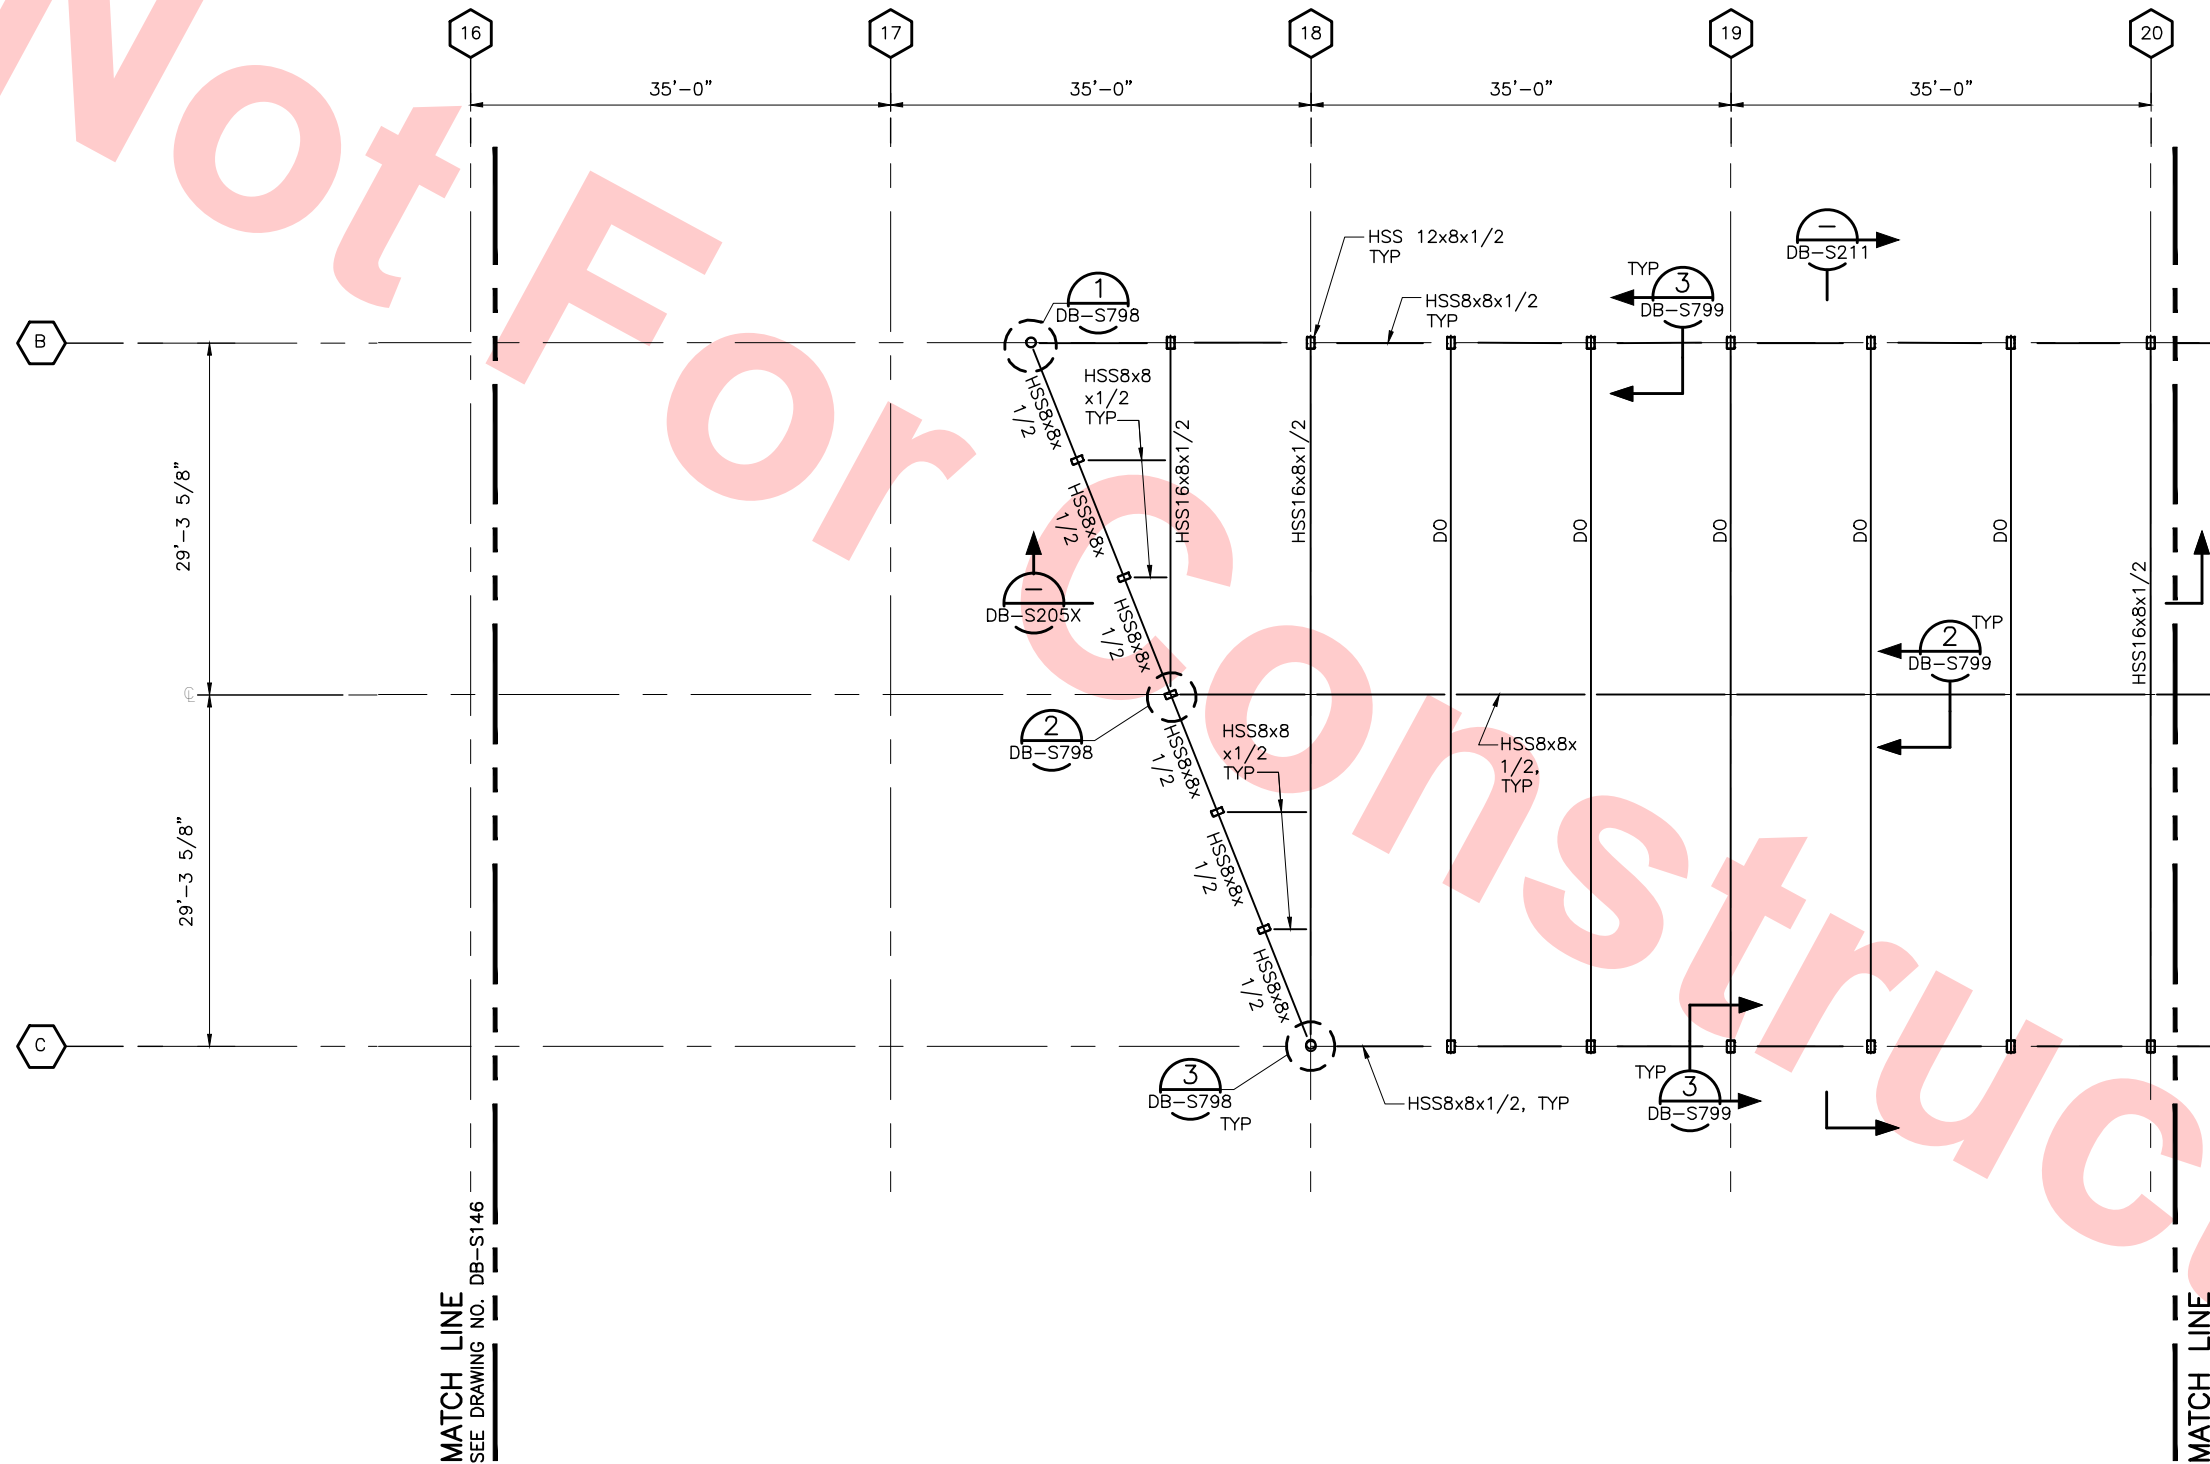

Santa Clara Valley Transportation Authority

NO EXCEPTIONS TAKEN (NET)  
MAKE CORRECTIONS NOTED (MCN)  
AMEND AND RESUBMIT (A/R)


Any action shown above is subject to the terms of the contract and does not relieve the Contractor of any of its obligations under the contract, including design and detailing.

Contract No.: DB11002F

By: \_\_\_\_\_ Date: \_\_\_\_\_



KEY PLAN

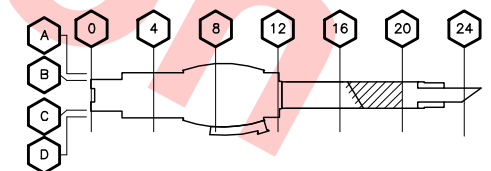


ROOF LEVEL FRAMING PLAN

SCALE: 1/8"=1'-0"  
DB-S140

Jul 05, 2013 1:52pm P:\BART Berryessa Extension Line\AS - STRUCTURAL\MILPITAS WORK\B-10-2012\C700-S-DB-S147.dwg

DESIGNED BY J. REBER, S.E.	EXP. 9/30/14
DRAWN BY P. DIAZ	
CHECKED BY M. TARAZI	
IN CHARGE M. TARAZI	
DATE 20130710	

0	20130710				READINESS FOR CONSTRUCTION REPLACED C700-S-DB-S307 REV P.
REV	DATE	BY	SUB	APP	DESCRIPTION

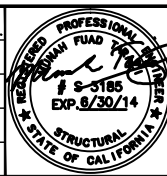

Skanska  
Shimmick  
Herzog

1436 California Circle  
Milpitas, California 95035  
A Joint Venture

MFT CONSULTING ENGINEERS, Inc. Anil Verma Associates, Inc.  
1773 San Pablo Ave., Suite A3 (510) 222-4100  
Palo Alto, CA 94304 Fax (650) 222-8410

Lealwood, Andrews & Newman, Inc. T-Y-LIN INTERNATIONAL  
A LEAD & BALLY COMPANY

SUBMITTED APPROVED



LINE, TRACK, STATIONS AND SYSTEMS  
DESIGN UNIT 023  
MILPITAS STATION  
ROOF LEVEL  
FRAMING PLAN  
SHEET 7 OF 9


CADD FILENAME C700-S-DB-S147.dwg	REV. 0
SIZE D SCALE 1/8" = 1'-0"	
CONTRACT NO. C700	
AREA CODE DB SHEET NO. S147	PAGE NO. 0179





NOTES:

1. FOR ROOF LEVEL FRAMING NOTES, SEE DWG NO DB-S141.

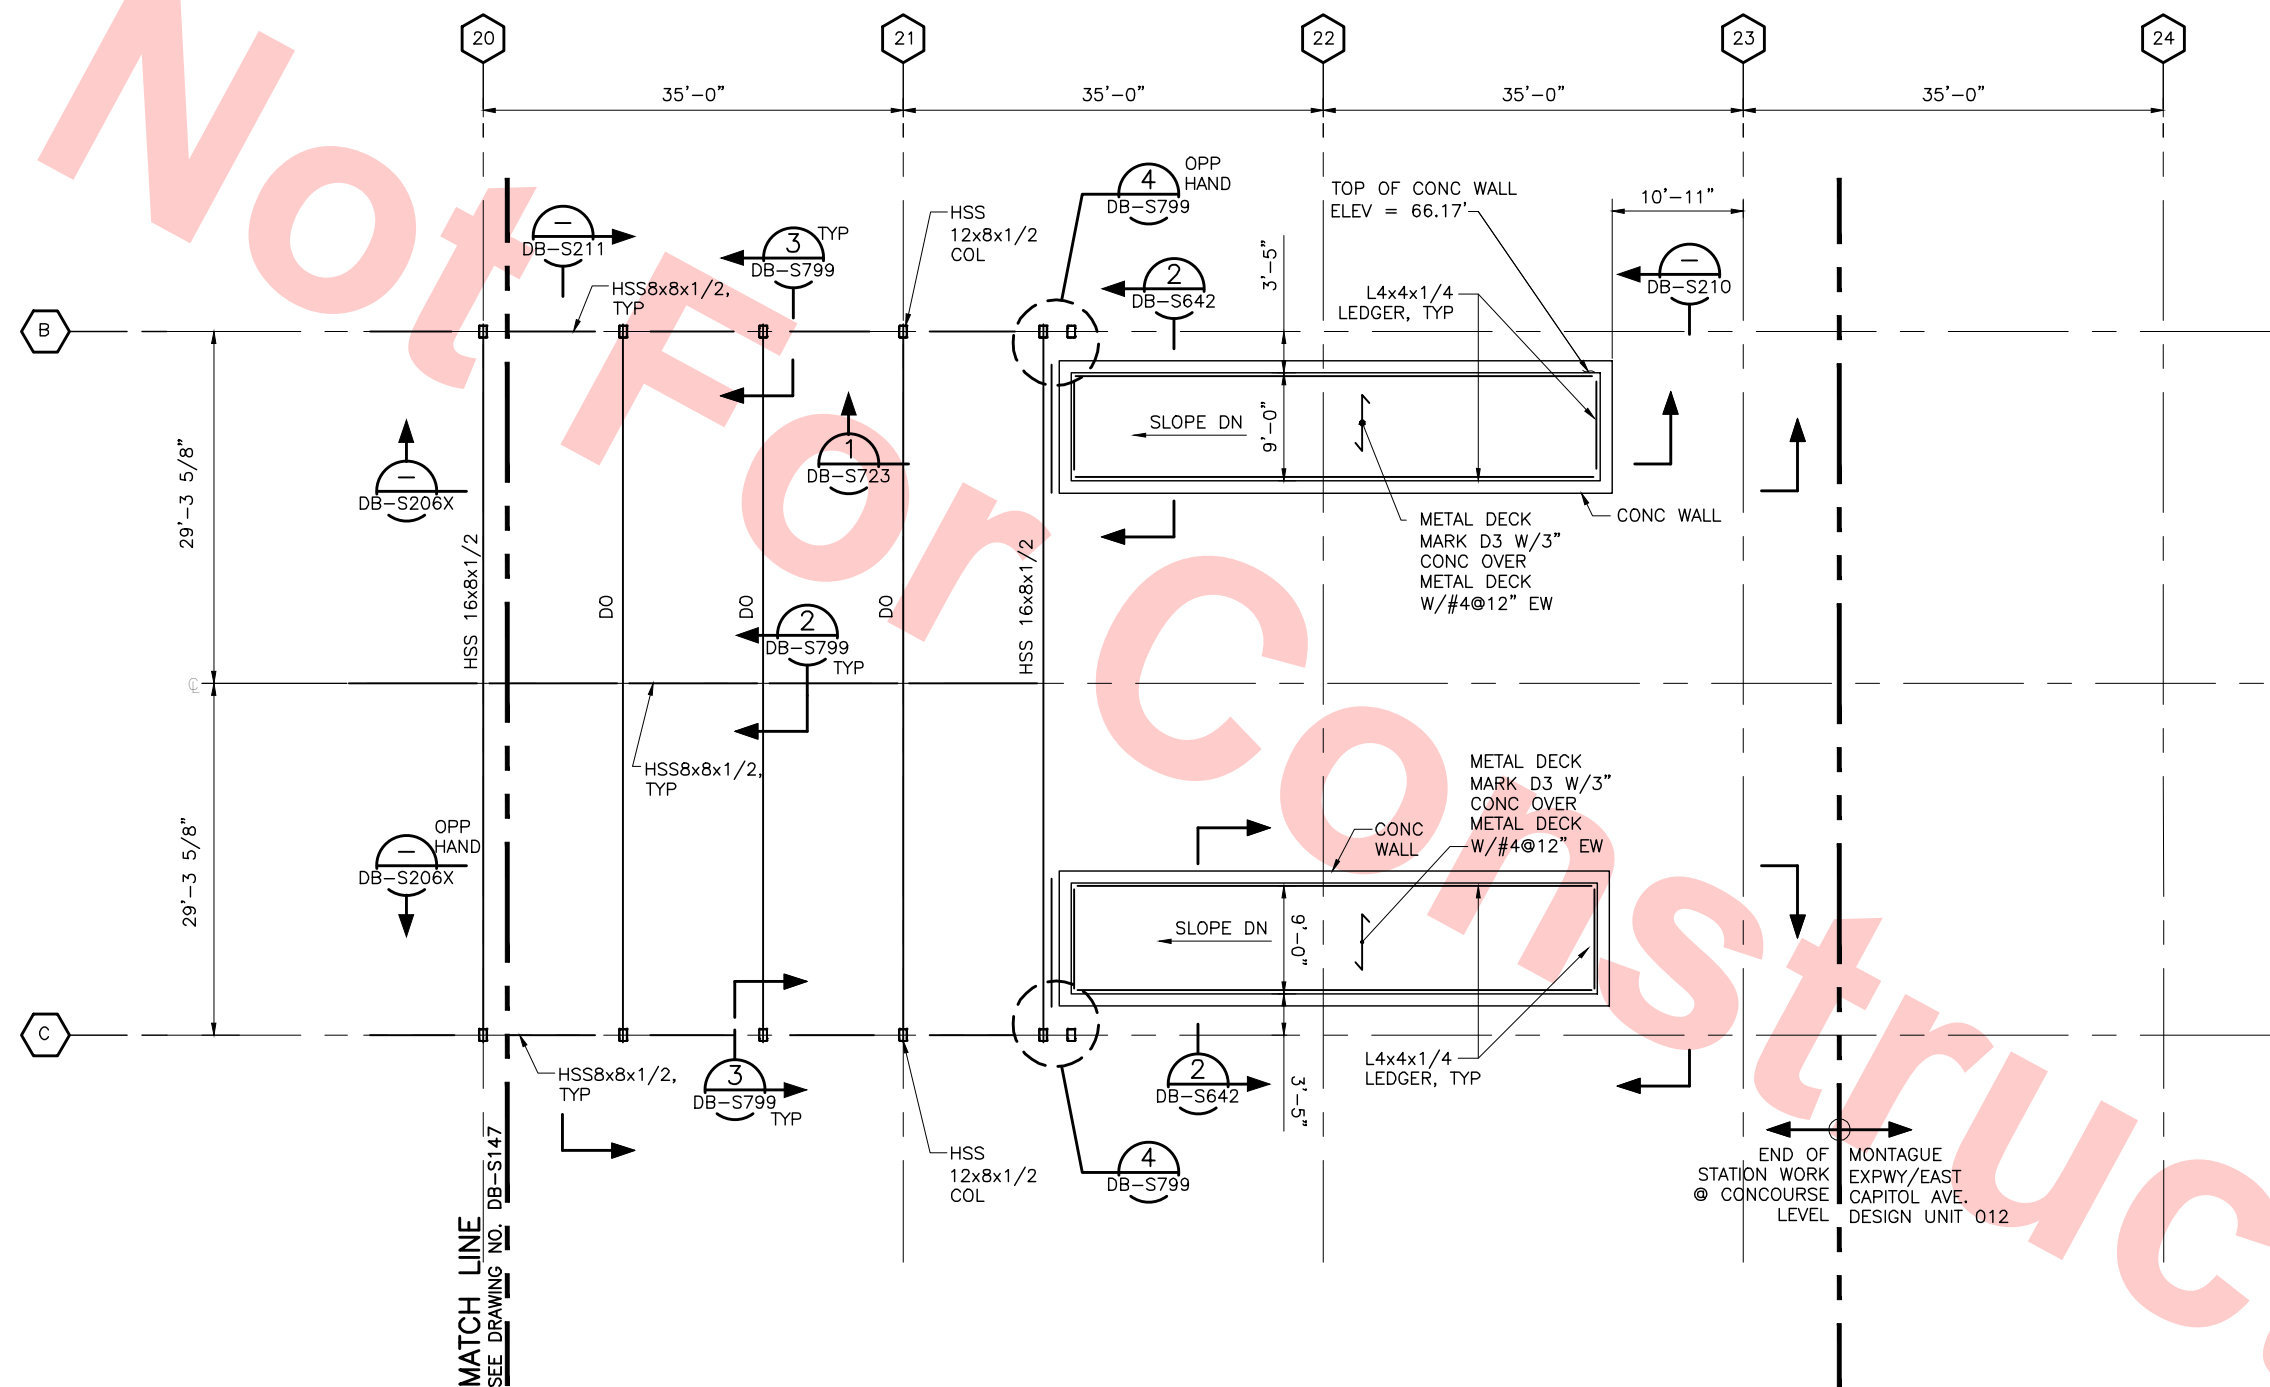

Santa Clara Valley Transportation Authority

NO EXCEPTIONS TAKEN (NET)  
MAKE CORRECTIONS NOTED (MCN)  
AMEND AND RESUBMIT (A/R)


Any action shown above is subject to the terms of the contract and does not relieve the Contractor of any of its obligations under the contract, including design and detailing.

Contract No.: DB11002F

By: \_\_\_\_\_ Date: \_\_\_\_\_



KEY PLAN

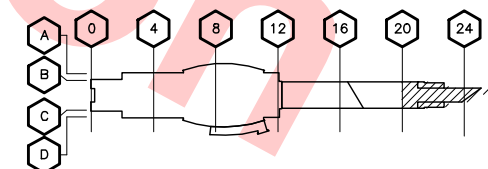


ROOF LEVEL FRAMING PLAN

SCALE: 1/8"=1'-0"  
DB-S140

Jul 05, 2013 1:52pm P:\BART Berryessa Extension Line\AS - STRUCTURAL\MILPITAS WORK\6-10-2012\C700-S-DB-S148.dwg

DESIGNED BY J. REBER, S.E.	
DRAWN BY P. DIAZ	
CHECKED BY M. TARAZI	
IN CHARGE M. TARAZI	
DATE 20130710	
REV	DATE BY SUB APP DESCRIPTION
0	20130710 READINESS FOR CONSTRUCTION REPLACED C700-S-DB-S308 REV P.

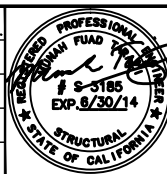

Skanska  
Shimmick  
Herzog

1436 California Circle  
Milpitas, California 95035  
A Joint Venture

MFT CONSULTING ENGINEERS, INC. Anil Verma Associates, Inc.  
1773 San Pablo Ave., Suite A3 (510) 222-4100  
Palo Alto, CA 94304 Fax (650) 222-8410

Lealwood, Andrews  
& Newman, Inc.

T-Y-LIN INTERNATIONAL

APPROVED *[Signature]*


BART  
SILICON VALLEY

BART SILICON VALLEY BERRYESSA EXTENSION

LINE, TRACK, STATIONS AND SYSTEMS  
DESIGN UNIT 023  
MILPITAS STATION  
ROOF LEVEL  
FRAMING PLAN  
SHEET 8 OF 9

CADD FILENAME C700-S-DB-S148.dwg	
SIZE D	SCALE 1/8" = 1'-0"
CONTRACT NO. C700	REV. 0
AREA CODE DB	SHEET NO. S148
	PAGE NO. 0180






DB-S140  
DB-S145





- NOTE:
1. VERIFY TOP OF RAIL PROFILE WITH PLAN AND PROFILE DRAWINGS PRIOR TO FINAL DESIGN MATERIAL FABRICATION AND CONSTRUCTION.
  2. REFER TO DRAWINGS L5-C227 AND L5-C228 FOR INFO NOT SHOWN REGARDING TOP OF RAIL

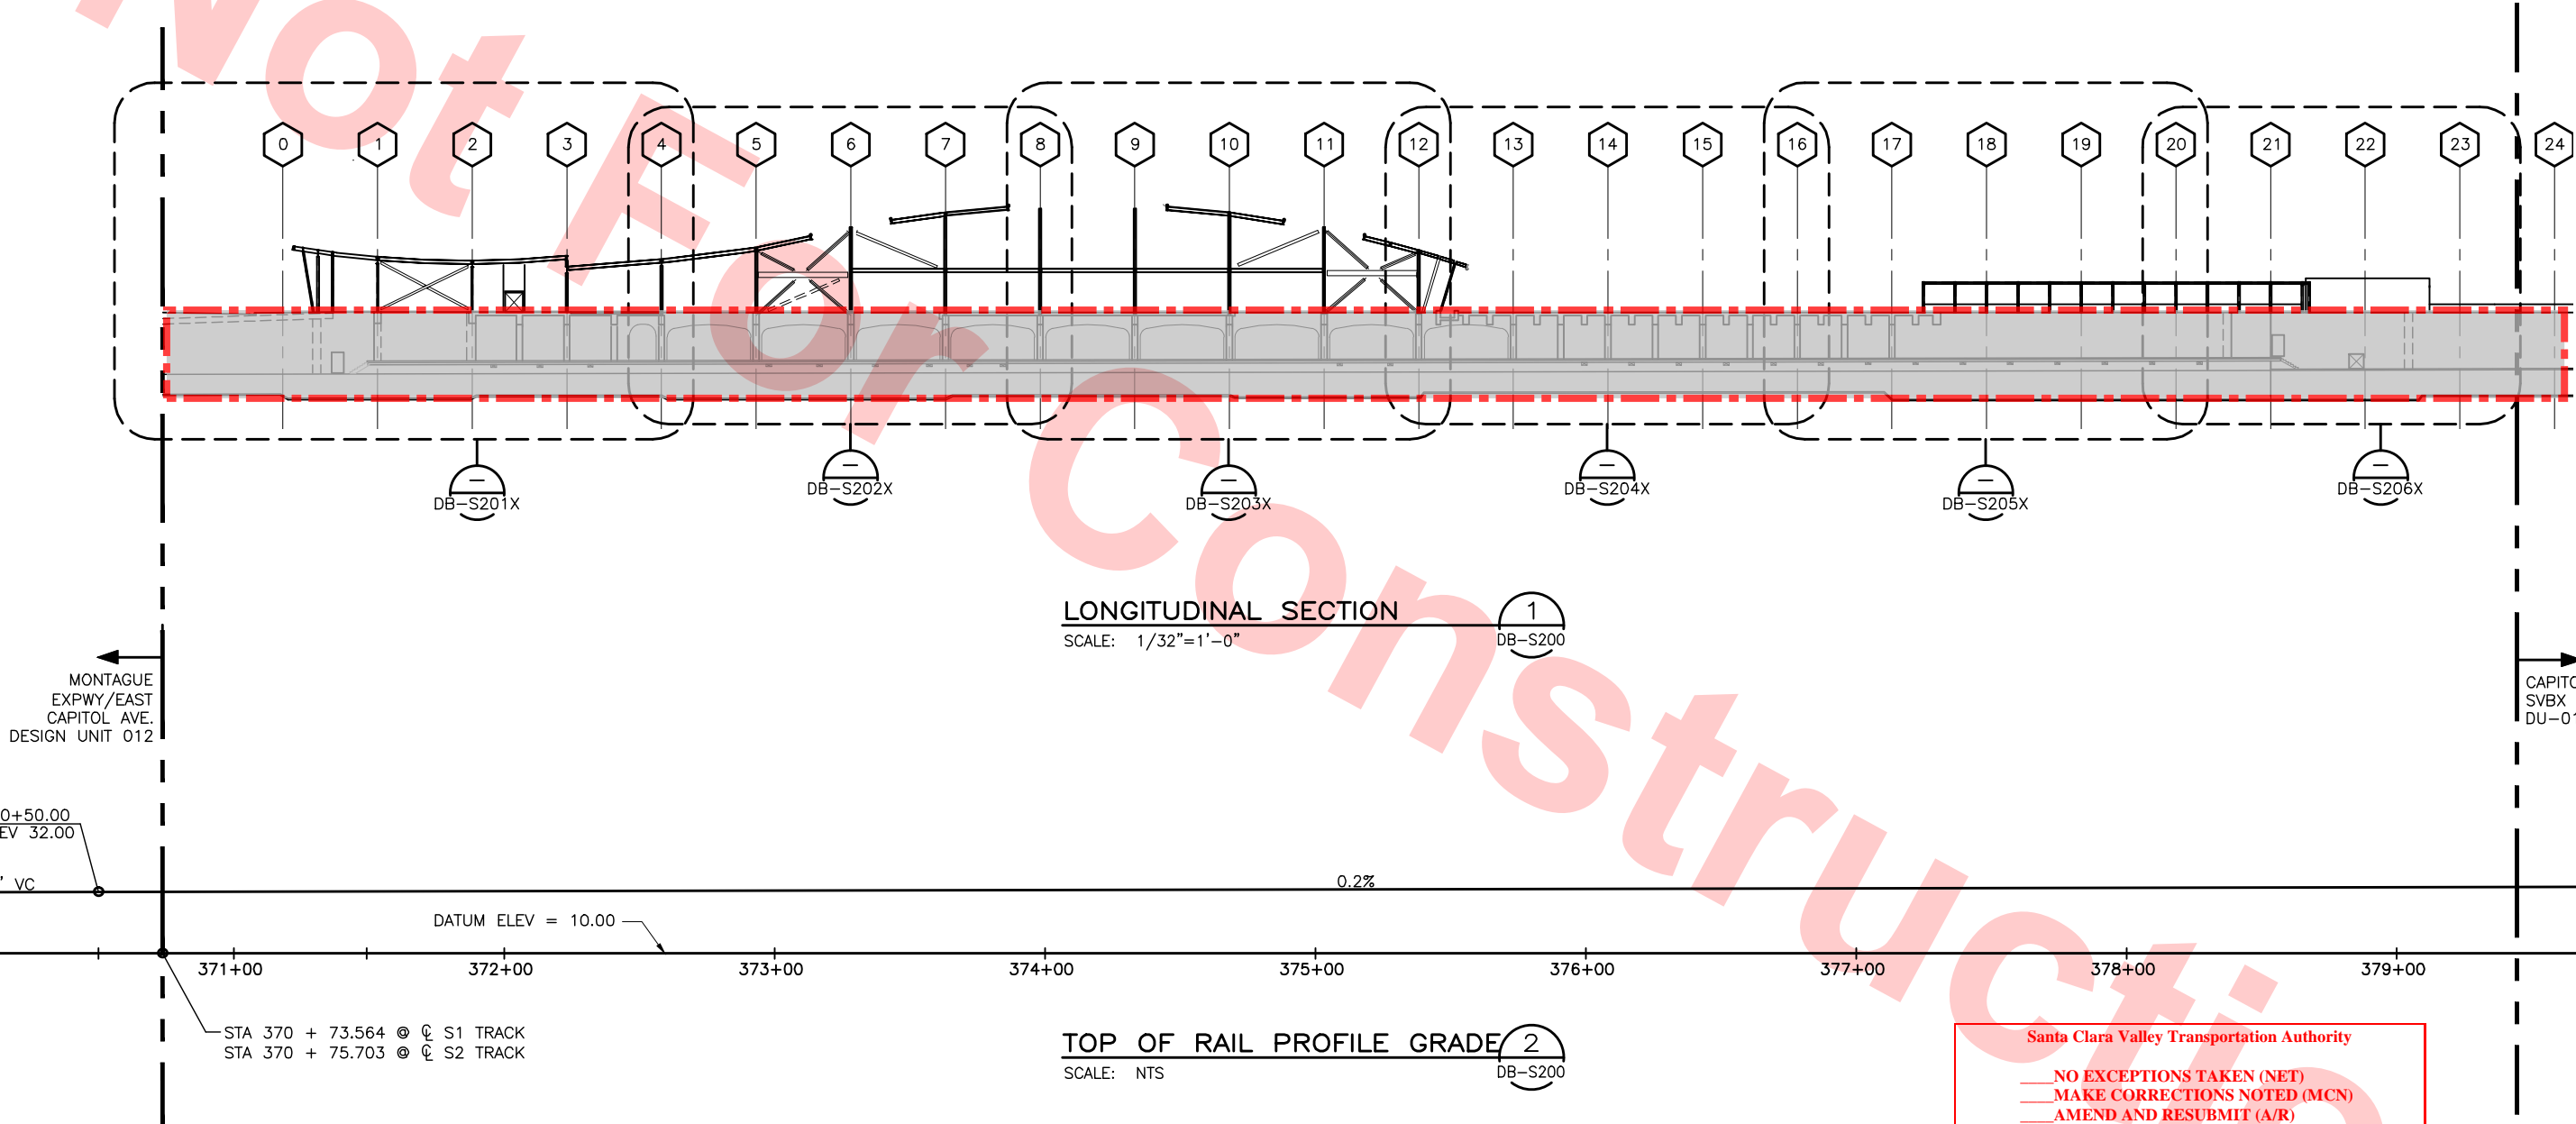

NOTE TO REVIEWER(S):  
DO NOT REVIEW AREAS DESIGNATED AS

Santa Clara Valley Transportation Authority

NO EXCEPTIONS TAKEN (NET)  
MAKE CORRECTIONS NOTED (MCN)  
AMEND AND RESUBMIT (A/R)

Any action shown above is subject to the terms of the contract and does not relieve the Contractor of any of its obligations under the contract, including design and detailing.

Contract No.: DB11002F

By: \_\_\_\_\_ Date: \_\_\_\_\_

Jul 05, 2013 - 1:52pm P:\BART Berryessa Extension Line\AS - STRUCTURAL MILPITAS WORK\6-10-2012\0700-S-DB-S200.dwg

REV	DATE	BY	SUB	APP	DESCRIPTION
0	20130710				READINESS FOR CONSTRUCTION
0	20130531				READINESS FOR CONSTRUCTION


DESIGNED BY  
J. REBER, S.E.

DRAWN BY  
P. DIAZ

CHECKED BY  
M. TARAZI

IN CHARGE  
M. TARAZI

DATE  
20130710

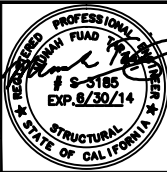

Skanska  
Shimmick  
Herzog

1436 California Circle  
Milpitas, California 95035  
A Joint Venture

MFT CONSULTING ENGINEERS, Inc. Anil Verma Associates, Inc.  
1773 San Pablo Ave., Suite A3 (510) 222-4100  
Pinole, CA 94664 Fax (510) 222-8410

Lealwood, Andrews  
& Newman, Inc.  
A LEO A DALY COMPANY

T-Y-LIN INTERNATIONAL

APPROVED *Ry Holmuth*



LINE, TRACK, STATIONS AND SYSTEMS  
DESIGN UNIT 023  
MILPITAS STATION  
LONGITUDINAL SECTION  
KEY PLAN


CADD FILENAME C700-S-DB-S200.dwg	CONTRACT NO. C700	REV. 0
SIZE D	SHEET NO. S200	PAGE NO. 0182
SCALE AS NOTED		



Jul 05, 2013 1:52pm P:\BART Berryessa Extension Line\AS - STRUCTURAL\MILPITAS WORK\6-10-2012\C700-S-DB-S201X.dwg  
c04-02

NOTES:

- FOR GENERAL NOTES SEE DWG NO DB-S001X, DB-S002X, AND DB-S003X.
- FOR NICHES LOCATION SEE ARCHITECTURAL DRAWINGS DB-A206 AND STRUCTURAL DRAWINGS DB-S613 & DB-S614 FOR STRUCTURAL DETAIL.
- TOP OF MAT SHALL FOLLOW THE SAME SLOPE AS THE TOP OF RAIL

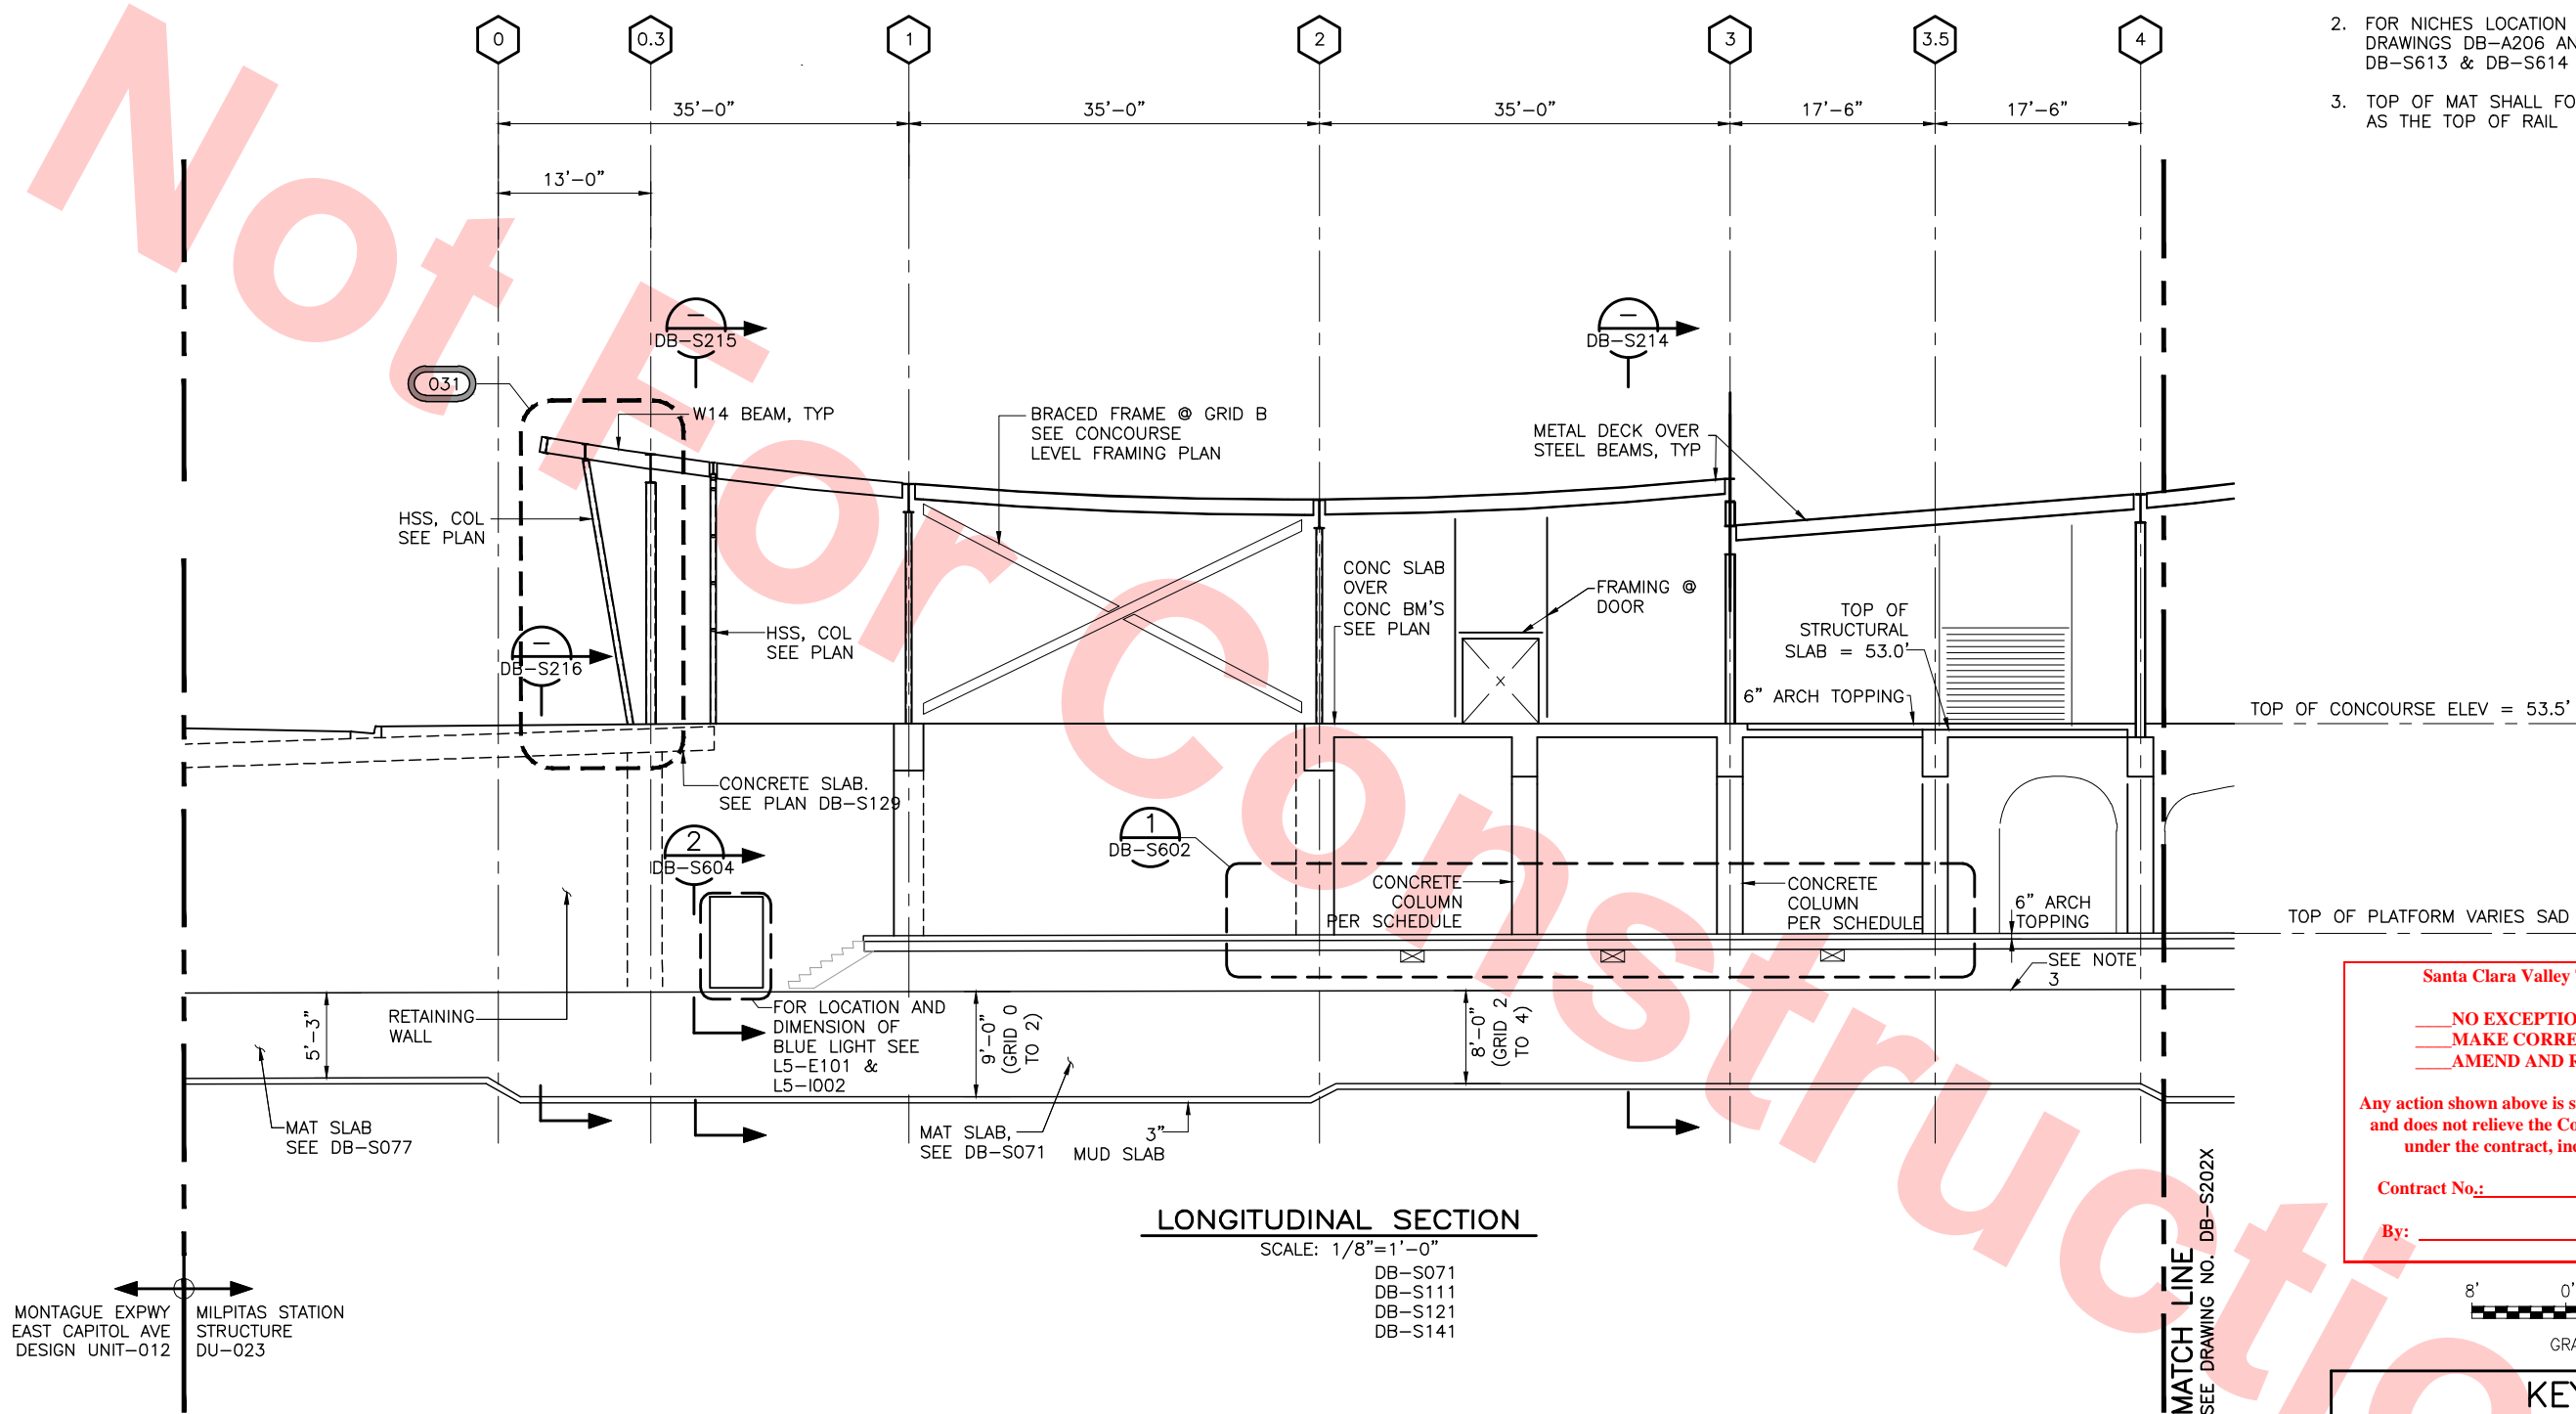

Santa Clara Valley Transportation Authority

**NO EXCEPTIONS TAKEN (NET)**  
**MAKE CORRECTIONS NOTED (MCN)**  
**AMEND AND RESUBMIT (A/R)**


Any action shown above is subject to the terms of the contract and does not relieve the Contractor of any of its obligations under the contract, including design and detailing.

Contract No.: **DB11002F**

By: \_\_\_\_\_ Date: \_\_\_\_\_



KEY PLAN

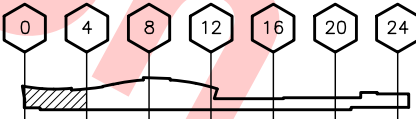

NOTE TO REVIEWER(S):  
SEE SHEET DB-S200 FOR AREAS NOT TO REVIEW

REV	DATE	BY	SUB	APP	DESCRIPTION
0	20130710				READINESS FOR CONSTRUCTION
0	20130531				READINESS FOR CONSTRUCTION
					REPLACED C700-S-DB-S201 REV P.

DESIGNED BY J. REBER, S.E.	
DRAWN BY P. DIAZ	
CHECKED BY M. TARAZI	
IN CHARGE M. TARAZI	
DATE 20130710	

Skanska  
Shimmick  
Herzog

1436 California Circle  
Milpitas, California 95035  
A Joint Venture

MFT CONSULTING ENGINEERS, INC. Anil Verma Associates, Inc.  
1773 San Pablo Ave., Suite A3 (510) 222-4100  
Palo Alto, CA 94304 Fax (650) 222-8410

Lealwood, Andrews  
& Newman, Inc.  
A LEA A BALLY COMPANY

T-Y-LIN INTERNATIONAL

APPROVED

SUBMITTED

**BART**  
SILICON VALLEY

BART SILICON VALLEY BERRYESSA EXTENSION


LINE, TRACK, STATIONS AND SYSTEMS  
DESIGN UNIT 023  
MILPITAS STATION  
LONGITUDINAL SECTION

SHEET 1 OF 6

CADD FILENAME C700-S-DB-S201X.dwg	REV. 0
SIZE SCALE D 1/8" = 1'-0"	
CONTRACT NO. C700	
AREA CODE DB	
SHEET NO. S201X	PAGE NO. 0183



- NOTE:
- FOR GENERAL NOTES SEE DWG NO DB-S001X, DB-S002X, AND DB-S003X.
  - TOP OF MAT SHALL FOLLOW THE SAME SLOPE AS THE TOP OF RAIL

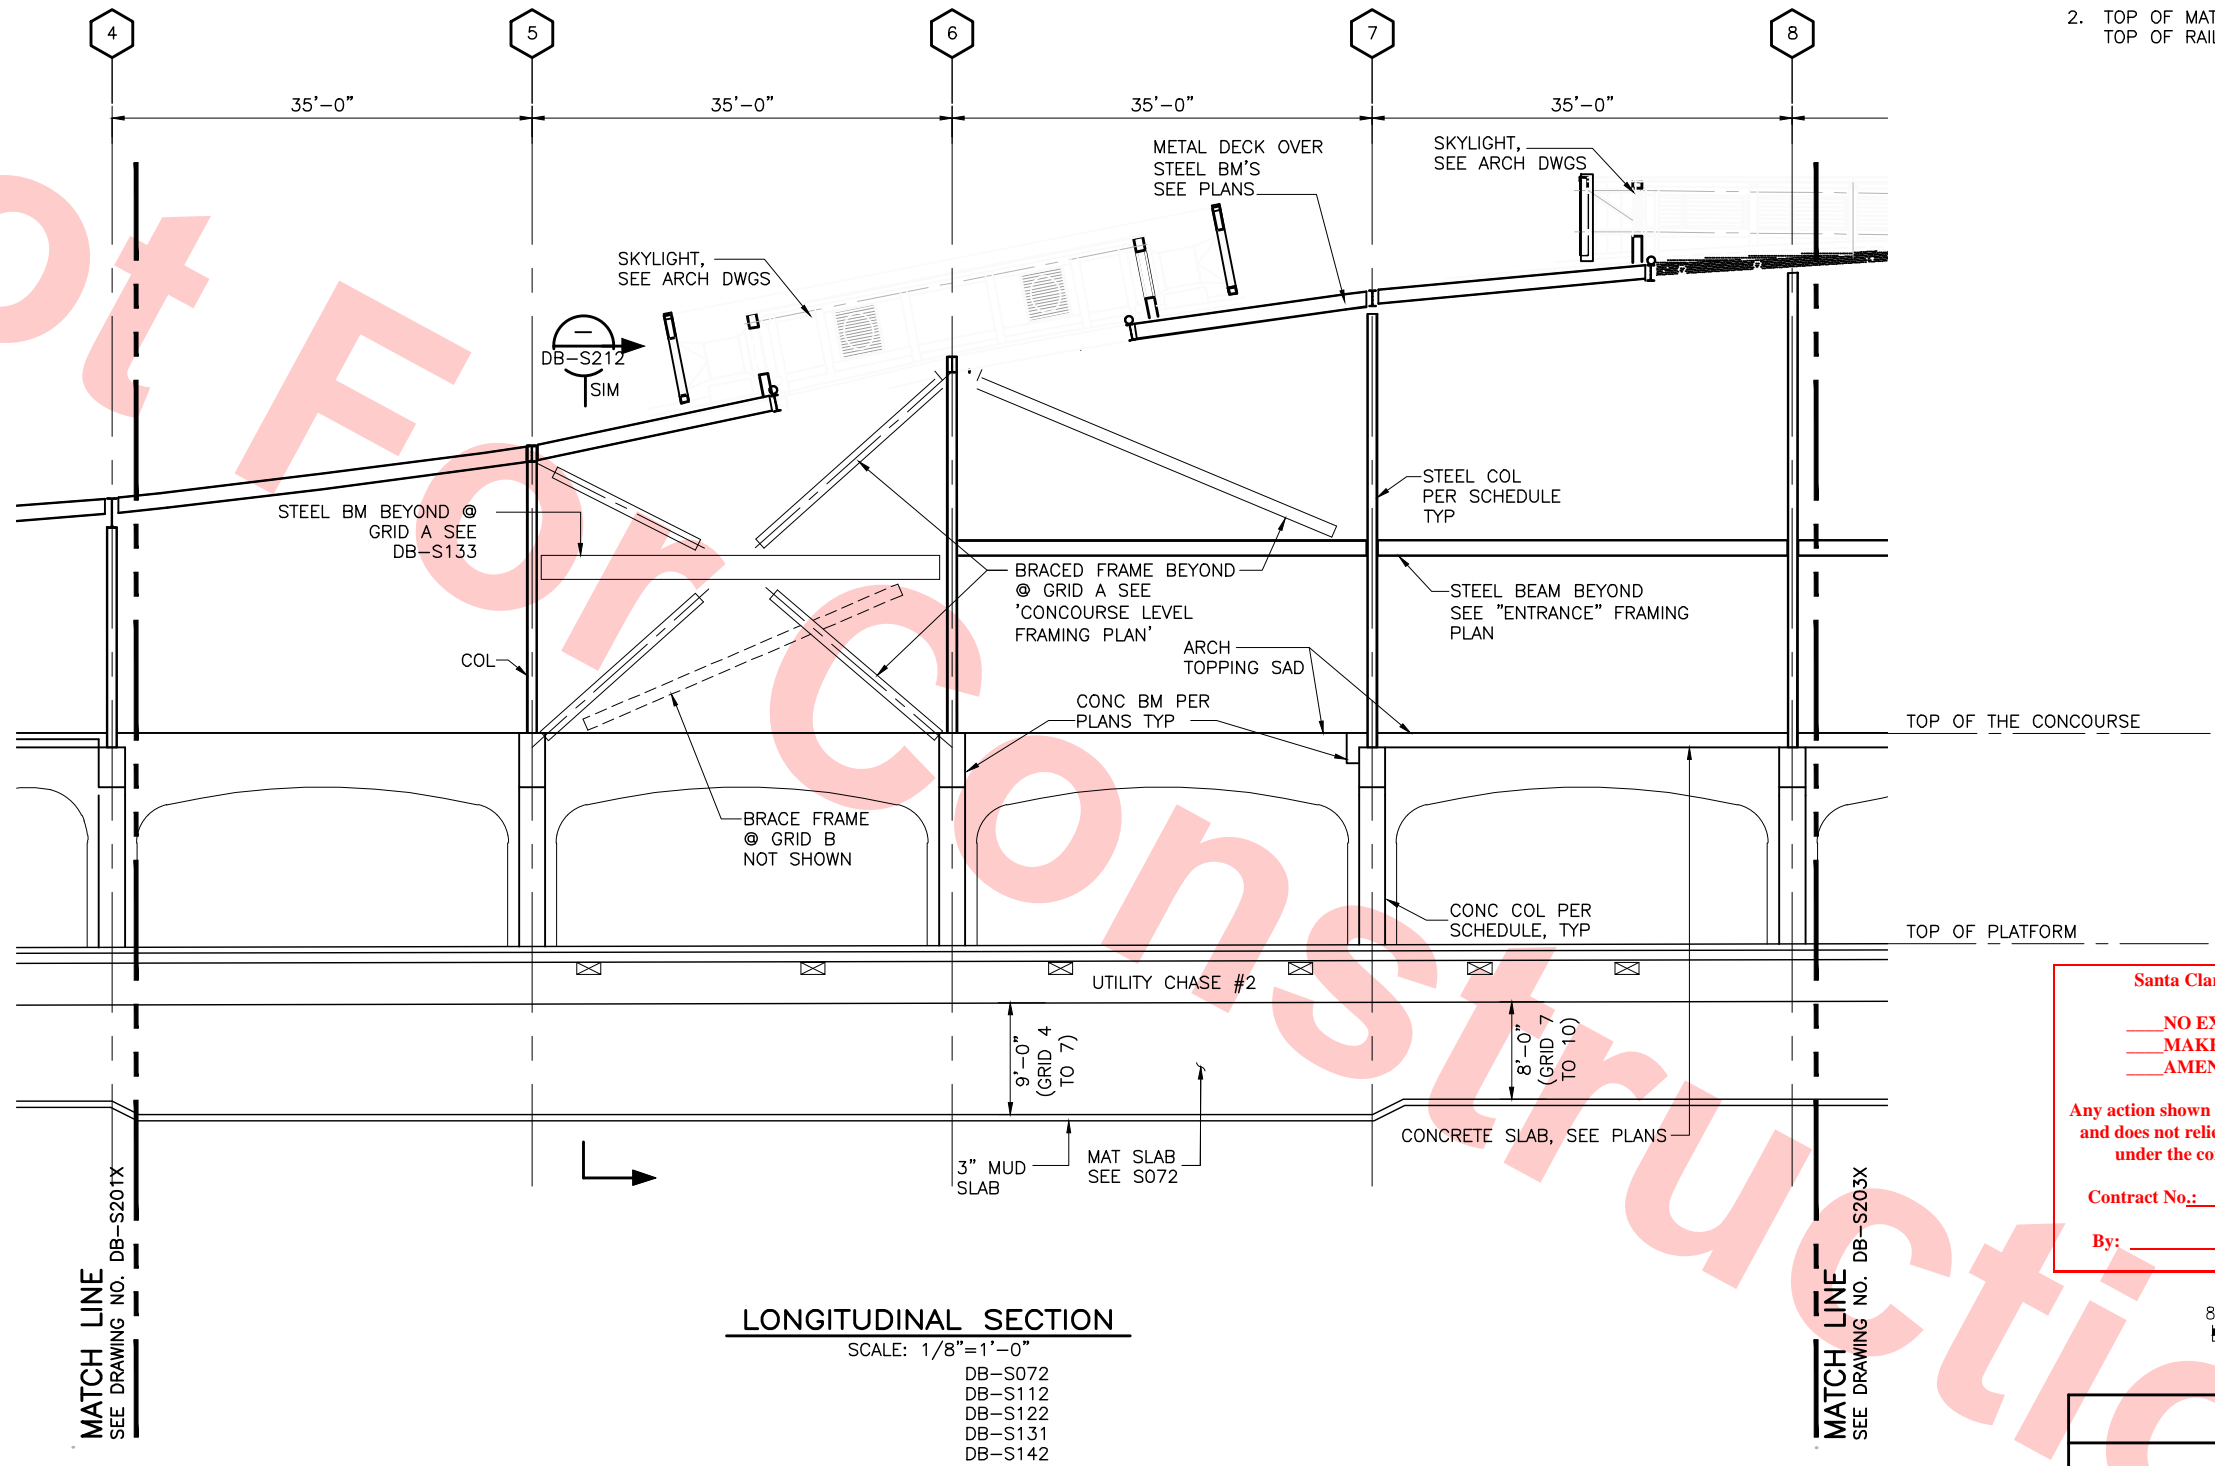


Santa Clara Valley Transportation Authority

NO EXCEPTIONS TAKEN (NET)  
MAKE CORRECTIONS NOTED (MCN)  
AMEND AND RESUBMIT (A/R)

Any action shown above is subject to the terms of the contract and does not relieve the Contractor of any of its obligations under the contract, including design and detailing.

Contract No.: DB11002F

By: \_\_\_\_\_ Date: \_\_\_\_\_

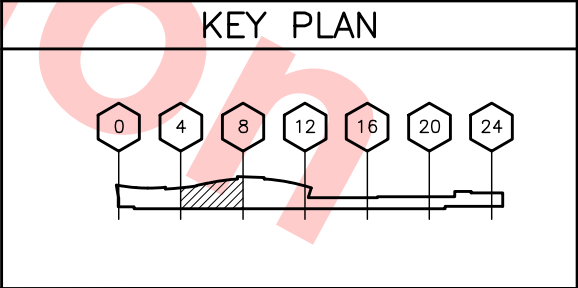


NOTE TO REVIEWER(S):  
SEE SHEET DB-S200 FOR AREAS NOT TO REVIEW

--	--	


NOTE:  
1. FOR GENERAL NOTES SEE DWG NO DB-S001X,  
DB-S002X, AND DB-S003X.

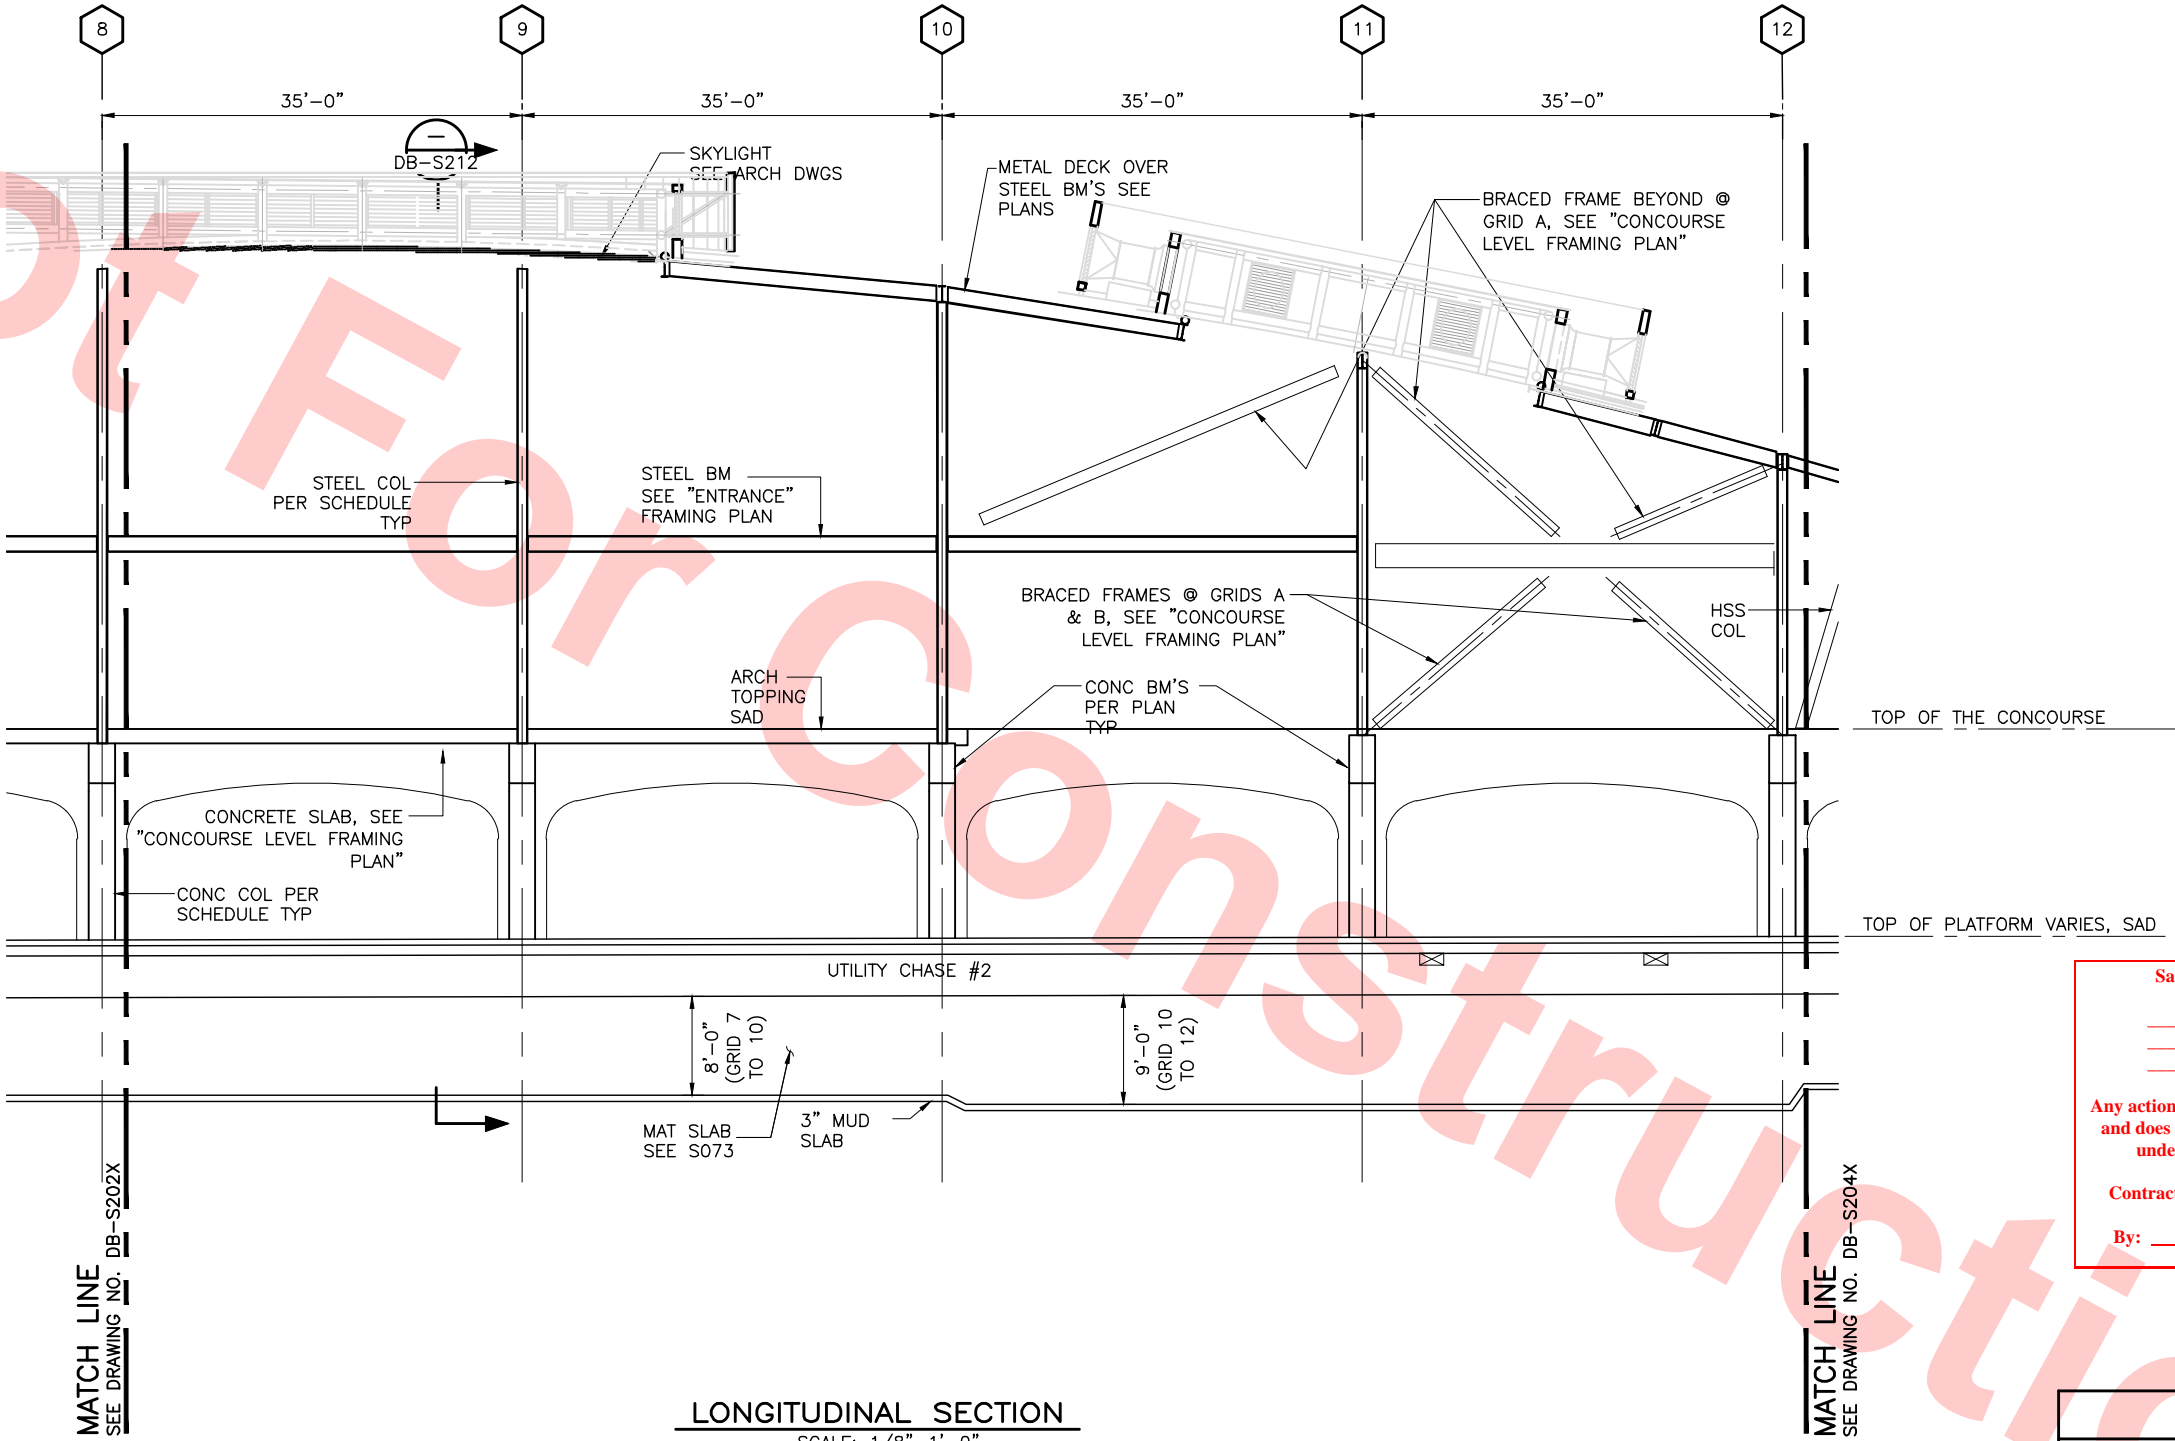


Santa Clara Valley Transportation Authority

NO EXCEPTIONS TAKEN (NET)  
MAKE CORRECTIONS NOTED (MCN)  
AMEND AND RESUBMIT (A/R)

Any action shown above is subject to the terms of the contract and does not relieve the Contractor of any of its obligations under the contract, including design and detailing.

Contract No.: DB11002F

By: \_\_\_\_\_ Date: \_\_\_\_\_

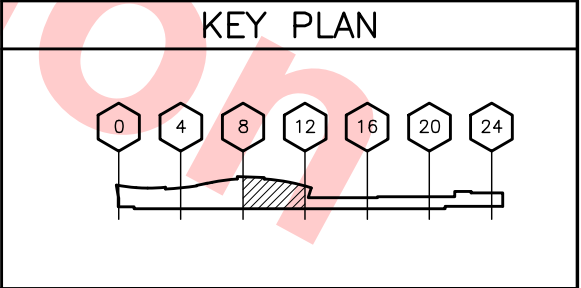


NOTE TO REVIEWER(S):  
SEE SHEET DB-S200 FOR AREAS NOT TO REVIEW

					DESIGNED BY J. REBER, S.E.			1436 California Circle Milpitas, California 95035 A Joint Venture		LINE, TRACK, STATIONS AND SYSTEMS DESIGN UNIT 023 MILPITAS STATION LONGITUDINAL SECTION  SHEET 3 OF 6	CADD FILENAME C700-S-DB-S203X.dwg SIZE   SCALE D   1/8" = 1'-0" CONTRACT NO. C700 AREA CODE DB	REV. 0 SHEET NO. S203X PAGE NO. 0185
0	20130710				DRAWN BY P. DIAZ							
0	20130531				CHECKED BY M. TARAZI							
					IN CHARGE M. TARAZI							
REV	DATE	BY	SUB	APP	DESCRIPTION	DATE 20130710	SUBMITTED 	APPROVED 	BART SILICON VALLEY BERRYESSA EXTENSION			



- NOTE:
- FOR GENERAL NOTES SEE DWG NO DB-S001X, DB-S002X, AND DB-S003X.
  - COORDINATE LOCATION OF SIDEWALKS, LANDSCAPE ISLAND, CURB AND GUTTER WITH DRAWINGS: LM-C110, LM-C207 AND LM-C171 PROVIDE #4@36" EACH WAY DOWELS INTO ROADWAYS SLAB. SEE SIMILAR DETAIL.

3  
DB-S771

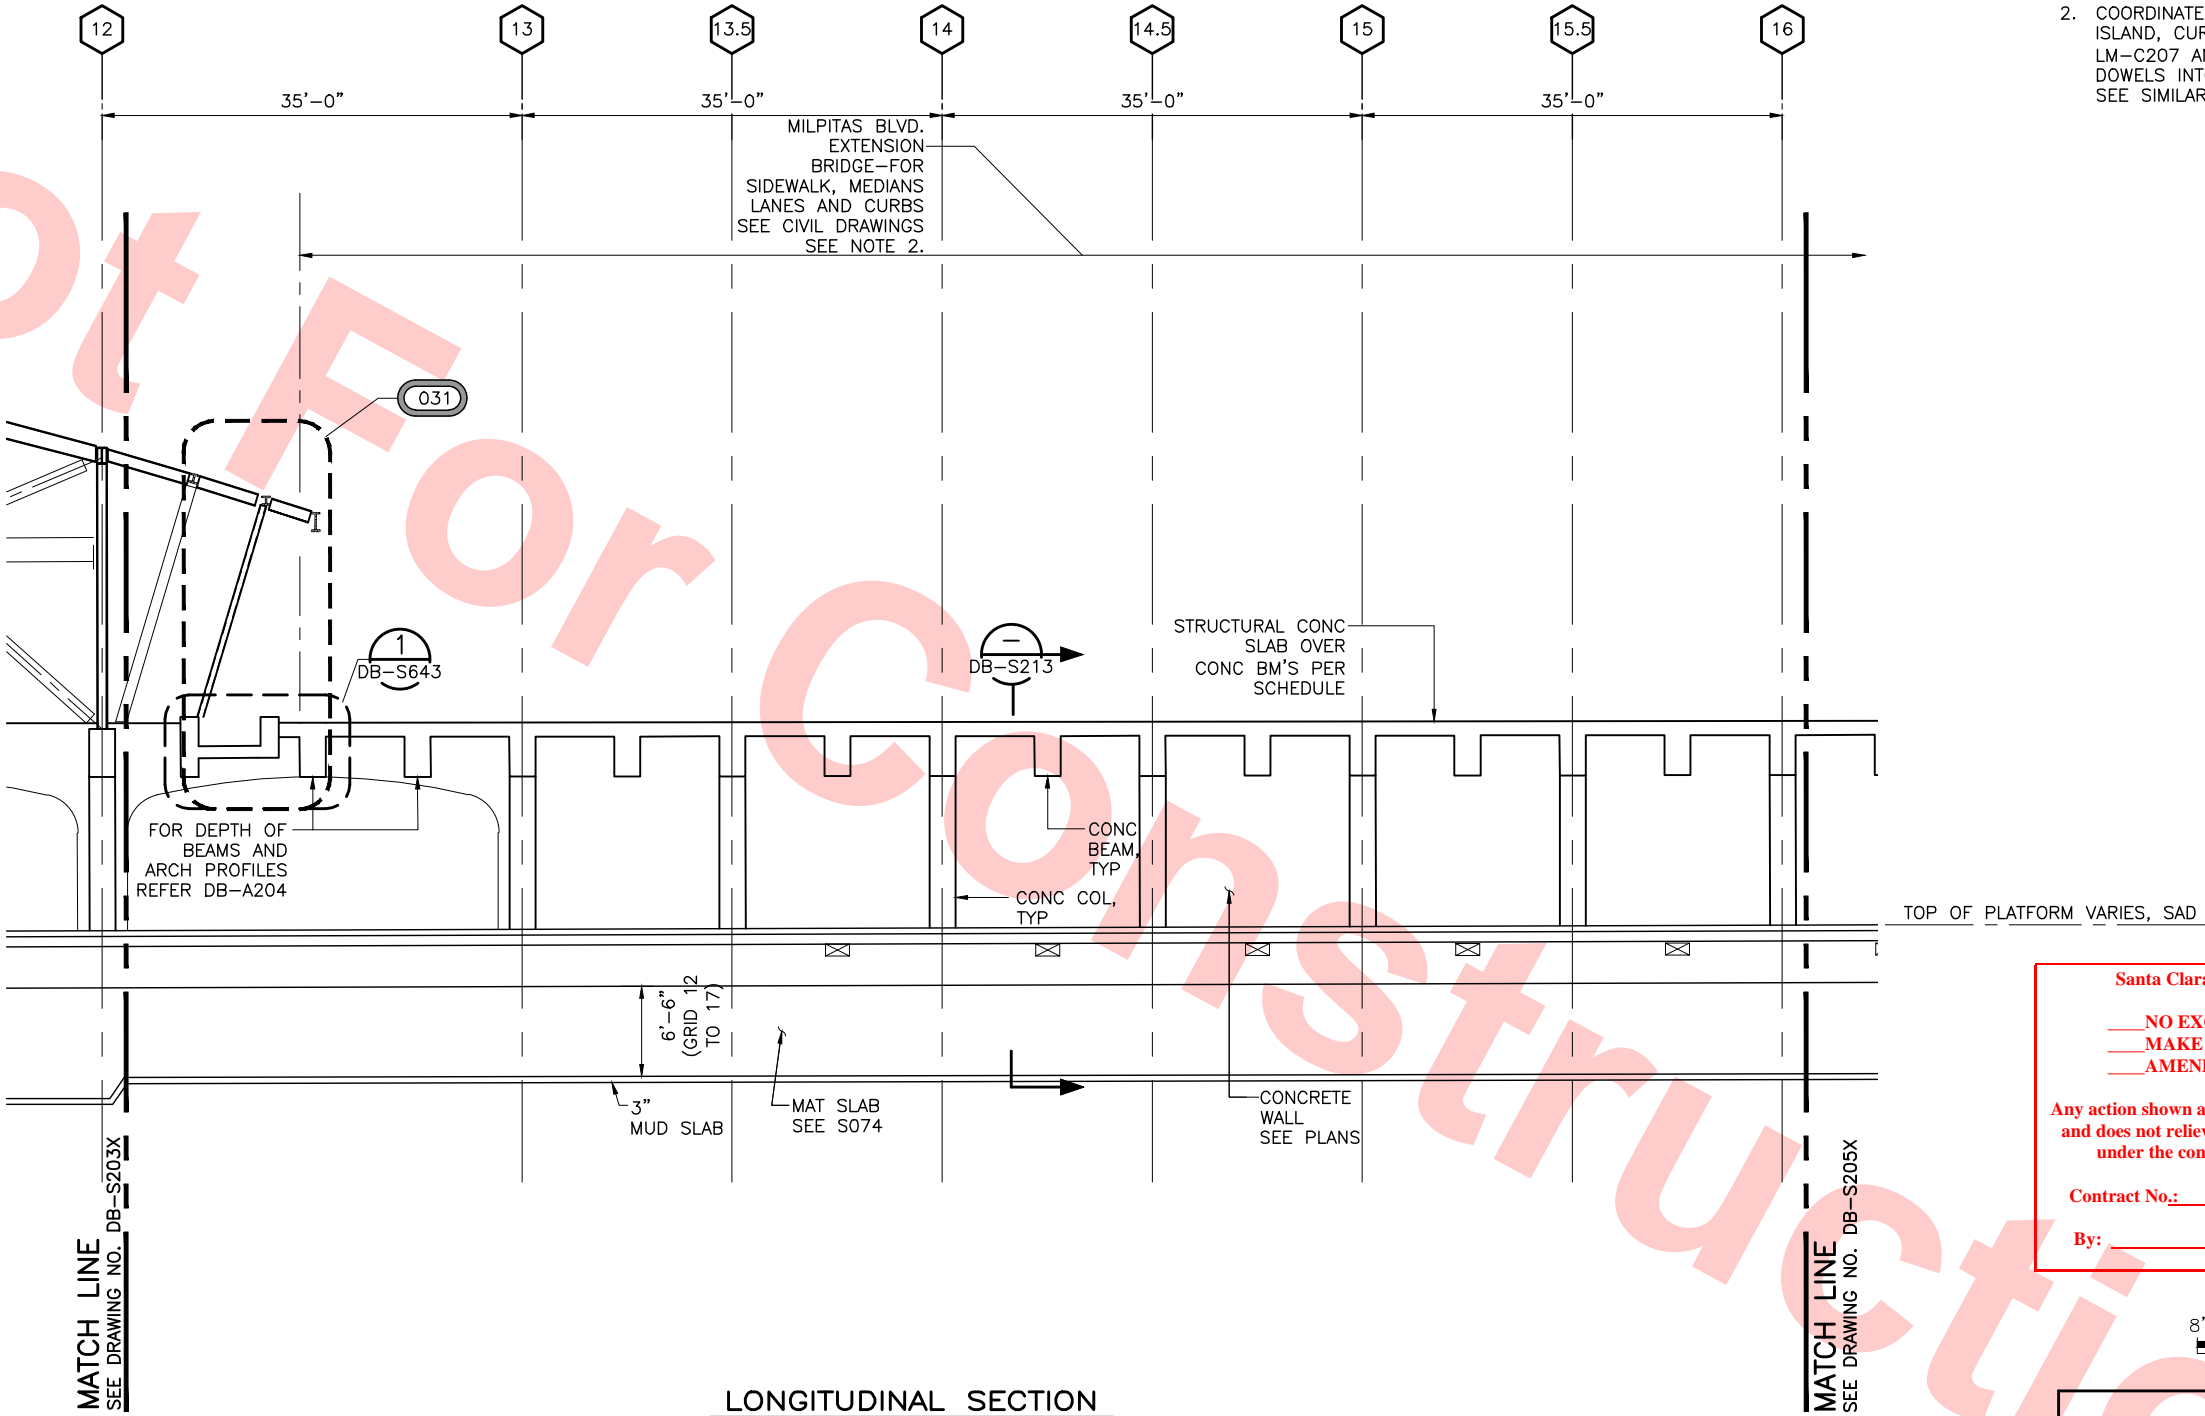

LONGITUDINAL SECTION  
SCALE: 1/8"=1'-0"  
DB-S074  
DB-S114  
DB-S126  
DB-S146


Santa Clara Valley Transportation Authority

NO EXCEPTIONS TAKEN (NET)  
MAKE CORRECTIONS NOTED (MCN)  
AMEND AND RESUBMIT (A/R)

Any action shown above is subject to the terms of the contract and does not relieve the Contractor of any of its obligations under the contract, including design and detailing.

Contract No.: DB11002F


By: Date:

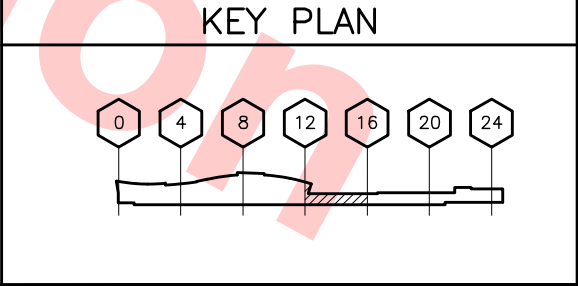


NOTE TO REVIEWER(S):  
SEE SHEET DB-S200 FOR AREAS NOT TO REVIEW

					DESIGNED BY J. REBER, S.E.			1436 California Circle Milpitas, California 95035 A Joint Venture		LINE, TRACK, STATIONS AND SYSTEMS DESIGN UNIT 023 MILPITAS STATION LONGITUDINAL SECTION  SHEET 4 OF 6	CADD FILENAME C700-S-DB-S204X.dwg SIZE SCALE D 1/8" = 1'-0" CONTRACT NO. C700 REV. 0 AREA CODE SHEET NO. PAGE NO. DB S204X 0186
0	20130710				DRAWN BY P. DIAZ						
0	20130531				CHECKED BY M. TARAZI						
					IN CHARGE M. TARAZI						
REV	DATE	BY	SUB	APP	DESCRIPTION	DATE 20130710	SUBMITTED 	APPROVED 	BART SILICON VALLEY BERRYESSA EXTENSION		



- NOTE:
- FOR GENERAL NOTES SEE DWG NO DB-S001X, DB-S002X, AND DB-S003X.
  - COORDINATE LOCATION OF SIDEWALKS, LANDSCAPE ISLAND, CURB AND GUTTER WITH DRAWINGS: LM-C110, LM-C207 AND LM-C171 PROVIDE #4@36" EACH WAY DOWELS INTO ROADWAYS SLAB. SEE SIMILAR DETAIL 

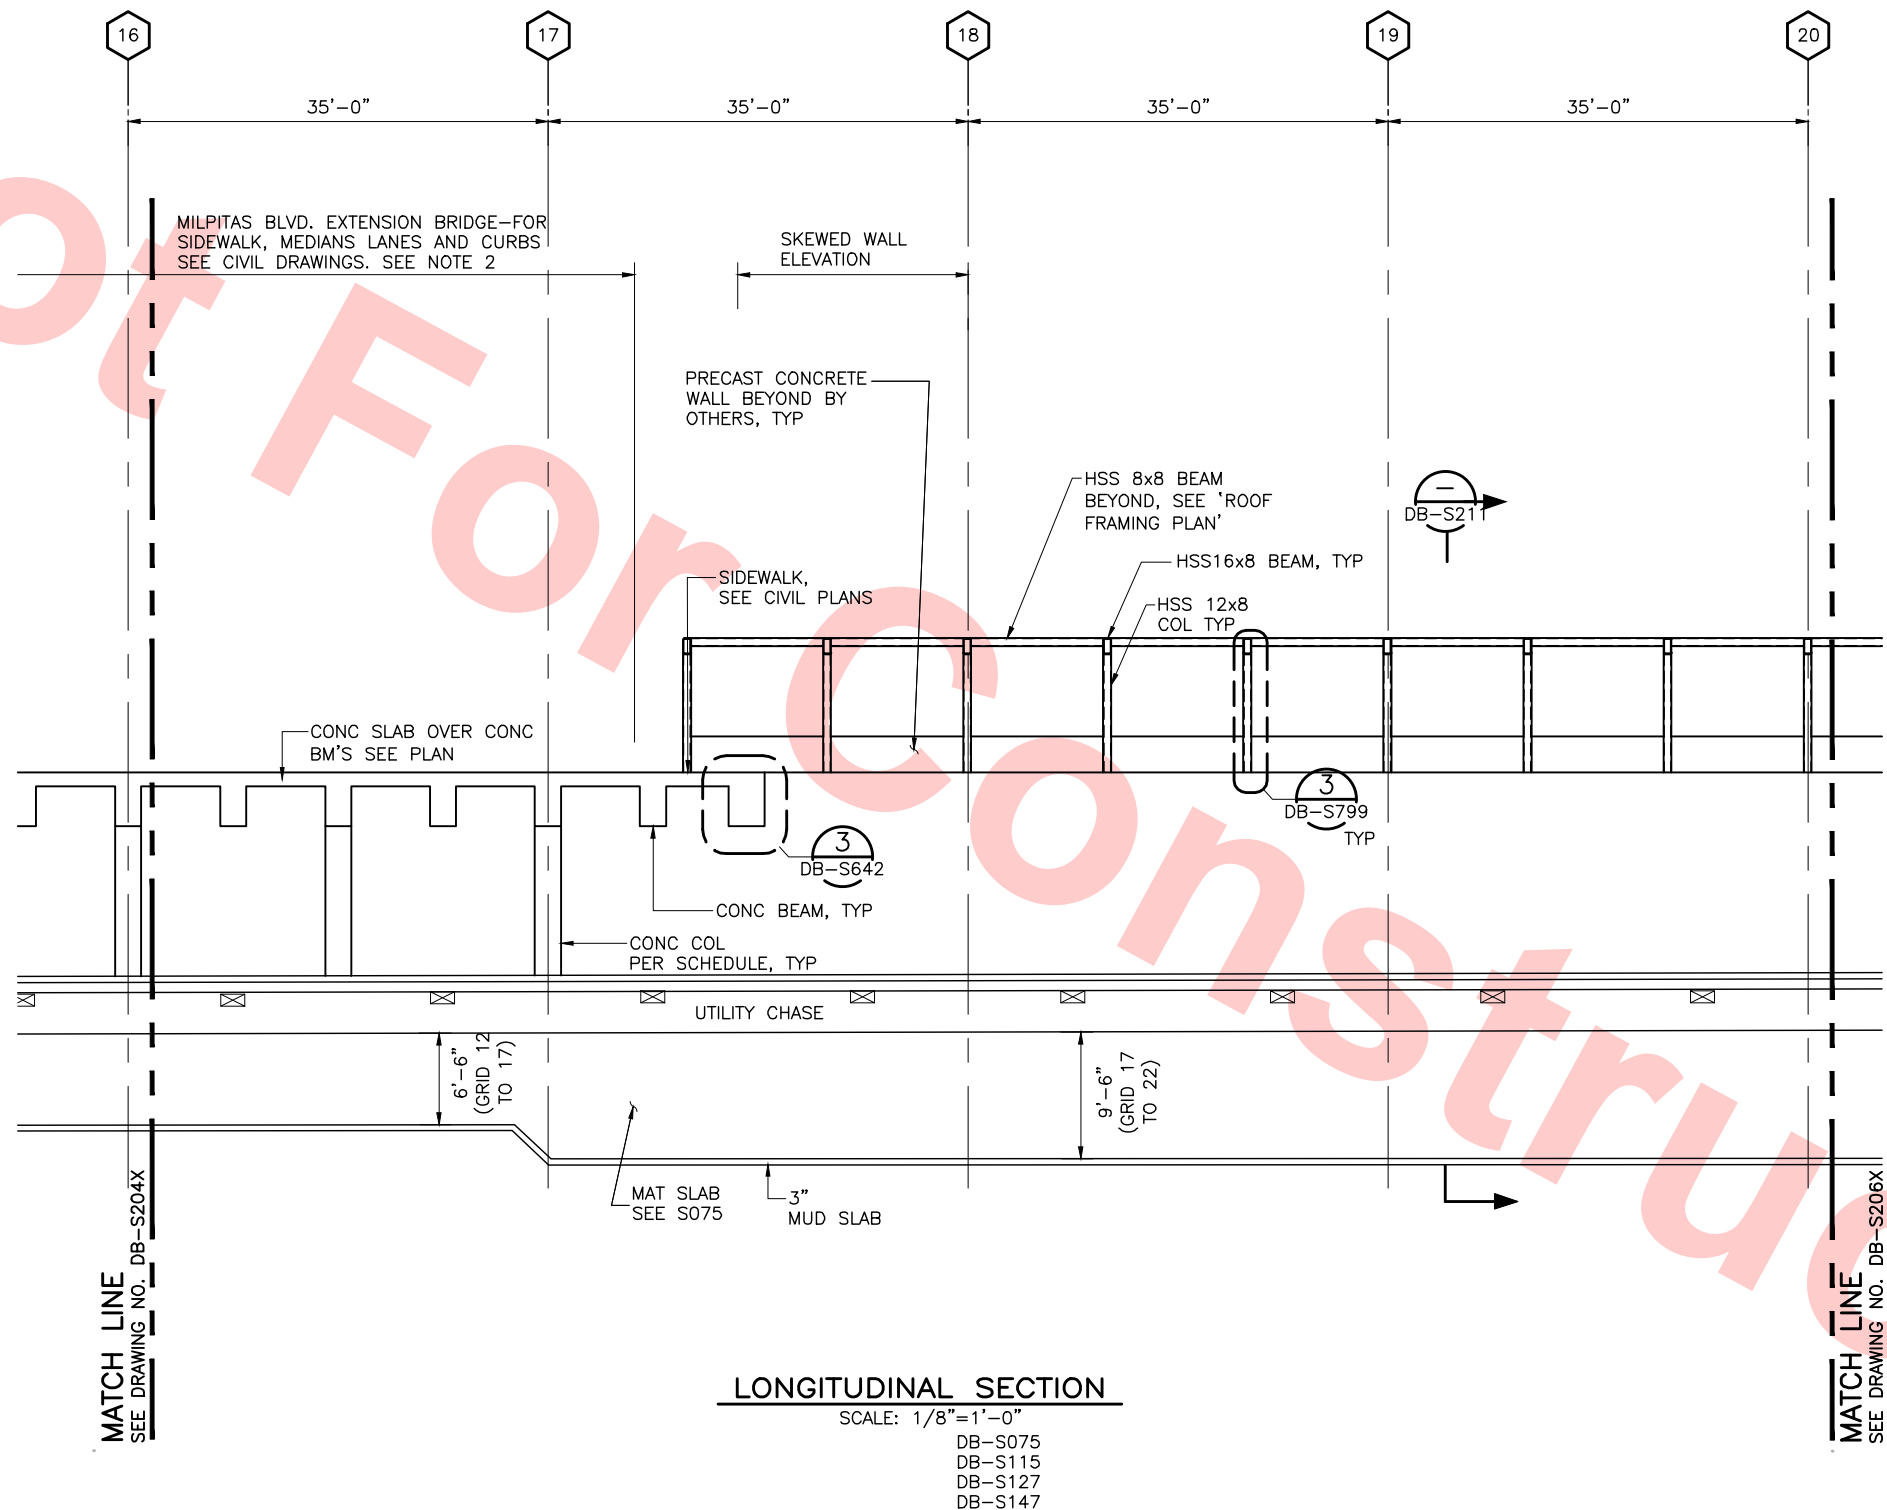

LONGITUDINAL SECTION  
SCALE: 1/8"=1'-0"  
DB-S075  
DB-S115  
DB-S127  
DB-S147


Santa Clara Valley Transportation Authority

NO EXCEPTIONS TAKEN (NET)  
MAKE CORRECTIONS NOTED (MCN)  
AMEND AND RESUBMIT (A/R)





Any action shown above is subject to the terms of the contract and does not relieve the Contractor of any of its obligations under the contract, including design and detailing.

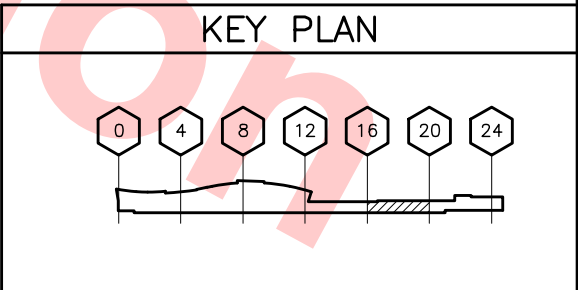Contract No.: DB11002F

By: \_\_\_\_\_ Date: \_\_\_\_\_




NOTE TO REVIEWER(S):  
SEE SHEET DB-S200 FOR AREAS NOT TO REVIEW

						DESIGNED BY J. REBER, S.E.		<b>Skanska Shimmick Herzog</b>  1436 California Circle Milpitas, California 95035 A Joint Venture	 <b>MFT CONSULTING ENGINEERS, Inc.</b> Anil Verma Associates, Inc. 1773 San Pablo Ave., Suite A3 (510) 222-4100 Pinole, CA 94864 Fax (510) 222-8410	 <b>Leonwood, Andrews &amp; Newman, Inc.</b> A LEAD & BALLY COMPANY	<b>T-Y-LIN INTERNATIONAL</b>	 <b>BART SILICON VALLEY BERRYESSA EXTENSION</b>	LINE, TRACK, STATIONS AND SYSTEMS DESIGN UNIT 023 MILPITAS STATION LONGITUDINAL SECTION  SHEET 5 OF 6	CADD FILENAME C700-S-DB-S205X.dwg SIZE SCALE D 1/8" = 1'-0" CONTRACT NO. C700 REV. 0 AREA CODE SHEET NO. PAGE NO. DB S205X 0187
0	20130710				READINESS FOR CONSTRUCTION									
0	20130531				READINESS FOR CONSTRUCTION									
					REPLACED C700-S-DB-S205 REV P.									
REV	DATE	BY	SUB	APP	DESCRIPTION	DATE	SUBMITTED	APPROVED						



1. FOR GENERAL NOTES SEE DWG NO DB-S001X, DB-S002X, AND DB-S003X.
2. FOR NICHES LOCATION SEE ARCHITECTURAL DRAWINGS DB-A206, L5-I002, L5-E101 AND L5-E102 STRUCTURAL DRAWINGS DB-S613 & DB-S614 FOR STRUCTURAL DETAIL

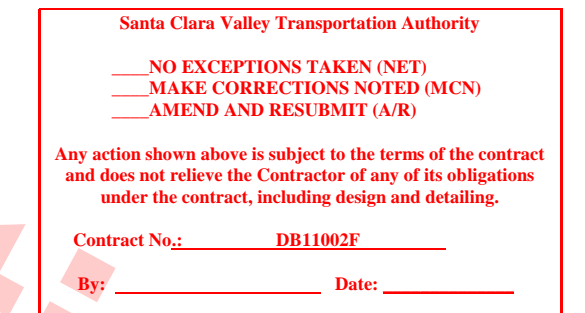


88-02 JUL 05, 2013 - 1:33PM F:\BAK1 Berryessd Extension LINE\S - SIRUCIURAL MILFIIAS\WORK\_6-10-2012\000-3-DB-SZ06X.dwg



						DESIGNED BY J. REBER, S.E.		 1436 California Circle Milpitas, California 95035 A Joint Venture	 MFT CONSULTING ENGINEERS, INC.: Anil Verma Associates, Inc. 1773 San Pablo Ave., Suite A3 Palo Alto, CA 94304 Fax (650) 222-6410	 LOCKWOOD, ANDREWS & NEWNAM, INC. A LEO A DALY COMPANY	 T-Y-LIN INTERNATIONAL		LINE, TRACK, STATIONS AND SYSTEMS DESIGN UNIT 023 MILPITAS STATION LONGITUDINAL SECTION	CADD FILENAME C700-S-DB-S206X.dwg		
0	20130710				READINESS FOR CONSTRUCTION	DRAWN BY P. DIAZ								SIZE SCALE D 1/8" = 1'-0"		
0	20130531				READINESS FOR CONSTRUCTION	CHECKED BY M. TARAZI								CONTRACT NO. C700		
					REPLACED C700-S-DB-S206 REV P.	IN CHARGE M. TARAZI								REV. 0		
REV	DATE	BY	SUB	APP	DESCRIPTION	DATE								AREA CODE DB	SHEET NO. S206X	PAGE NO. 0188
						20130710										
							SUBMITTED		APPROVED							



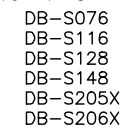



1. FOR GENERAL NOTES SEE DWG NO DB-S001X,  
DB-S002X, AND DB-S003X.




**By:** \_\_\_\_\_ **Date:** \_\_\_\_\_

						DESIGNED BY J. REBER, S.E.		<b>Skanska Shimmick Herzog</b>  1436 California Circle Milpitas, California 95035 A Joint Venture		<b>LINE, TRACK, STATIONS AND SYSTEMS DESIGN UNIT 023 MILPITAS STATION TRANSVERSE SECTION</b>	CADD FILENAME C700-S-DB-S210.dwg			
					DRAWN BY P. DIAZ	SIZE D					SCALE 3/16" = 1'-0"	CONTRACT NO. <b>C700</b>		REV. <b>0</b>
0	20130710				READINESS FOR CONSTRUCTION	IN CHARGE M. TARAZI								
0	20130531				READINESS FOR CONSTRUCTION	DATE 20130710					AREA CODE <b>DB</b>	SHEET NO. <b>S210</b>	PAGE NO. <b>0189</b>	
REV	DATE	BY	SUB	APP	DESCRIPTION									

	<b>MFT CONSULTING ENGINEERS, INC.</b> 1773 San Pablo Ave., Suite A3 Pinole, CA 94564 Fax (510) 222-5616		<b>Lockwood, Andrews &amp; Newnam, Inc.</b> A LOW A "B" COMPANY	<b>T-Y-LIN INTERNATIONAL</b>
SUBMITTED 		APPROVED 		



NOTE:  
1. FOR GENERAL NOTES SEE DWG NO DB-S001X,  
DB-S002X, AND DB-S003X.

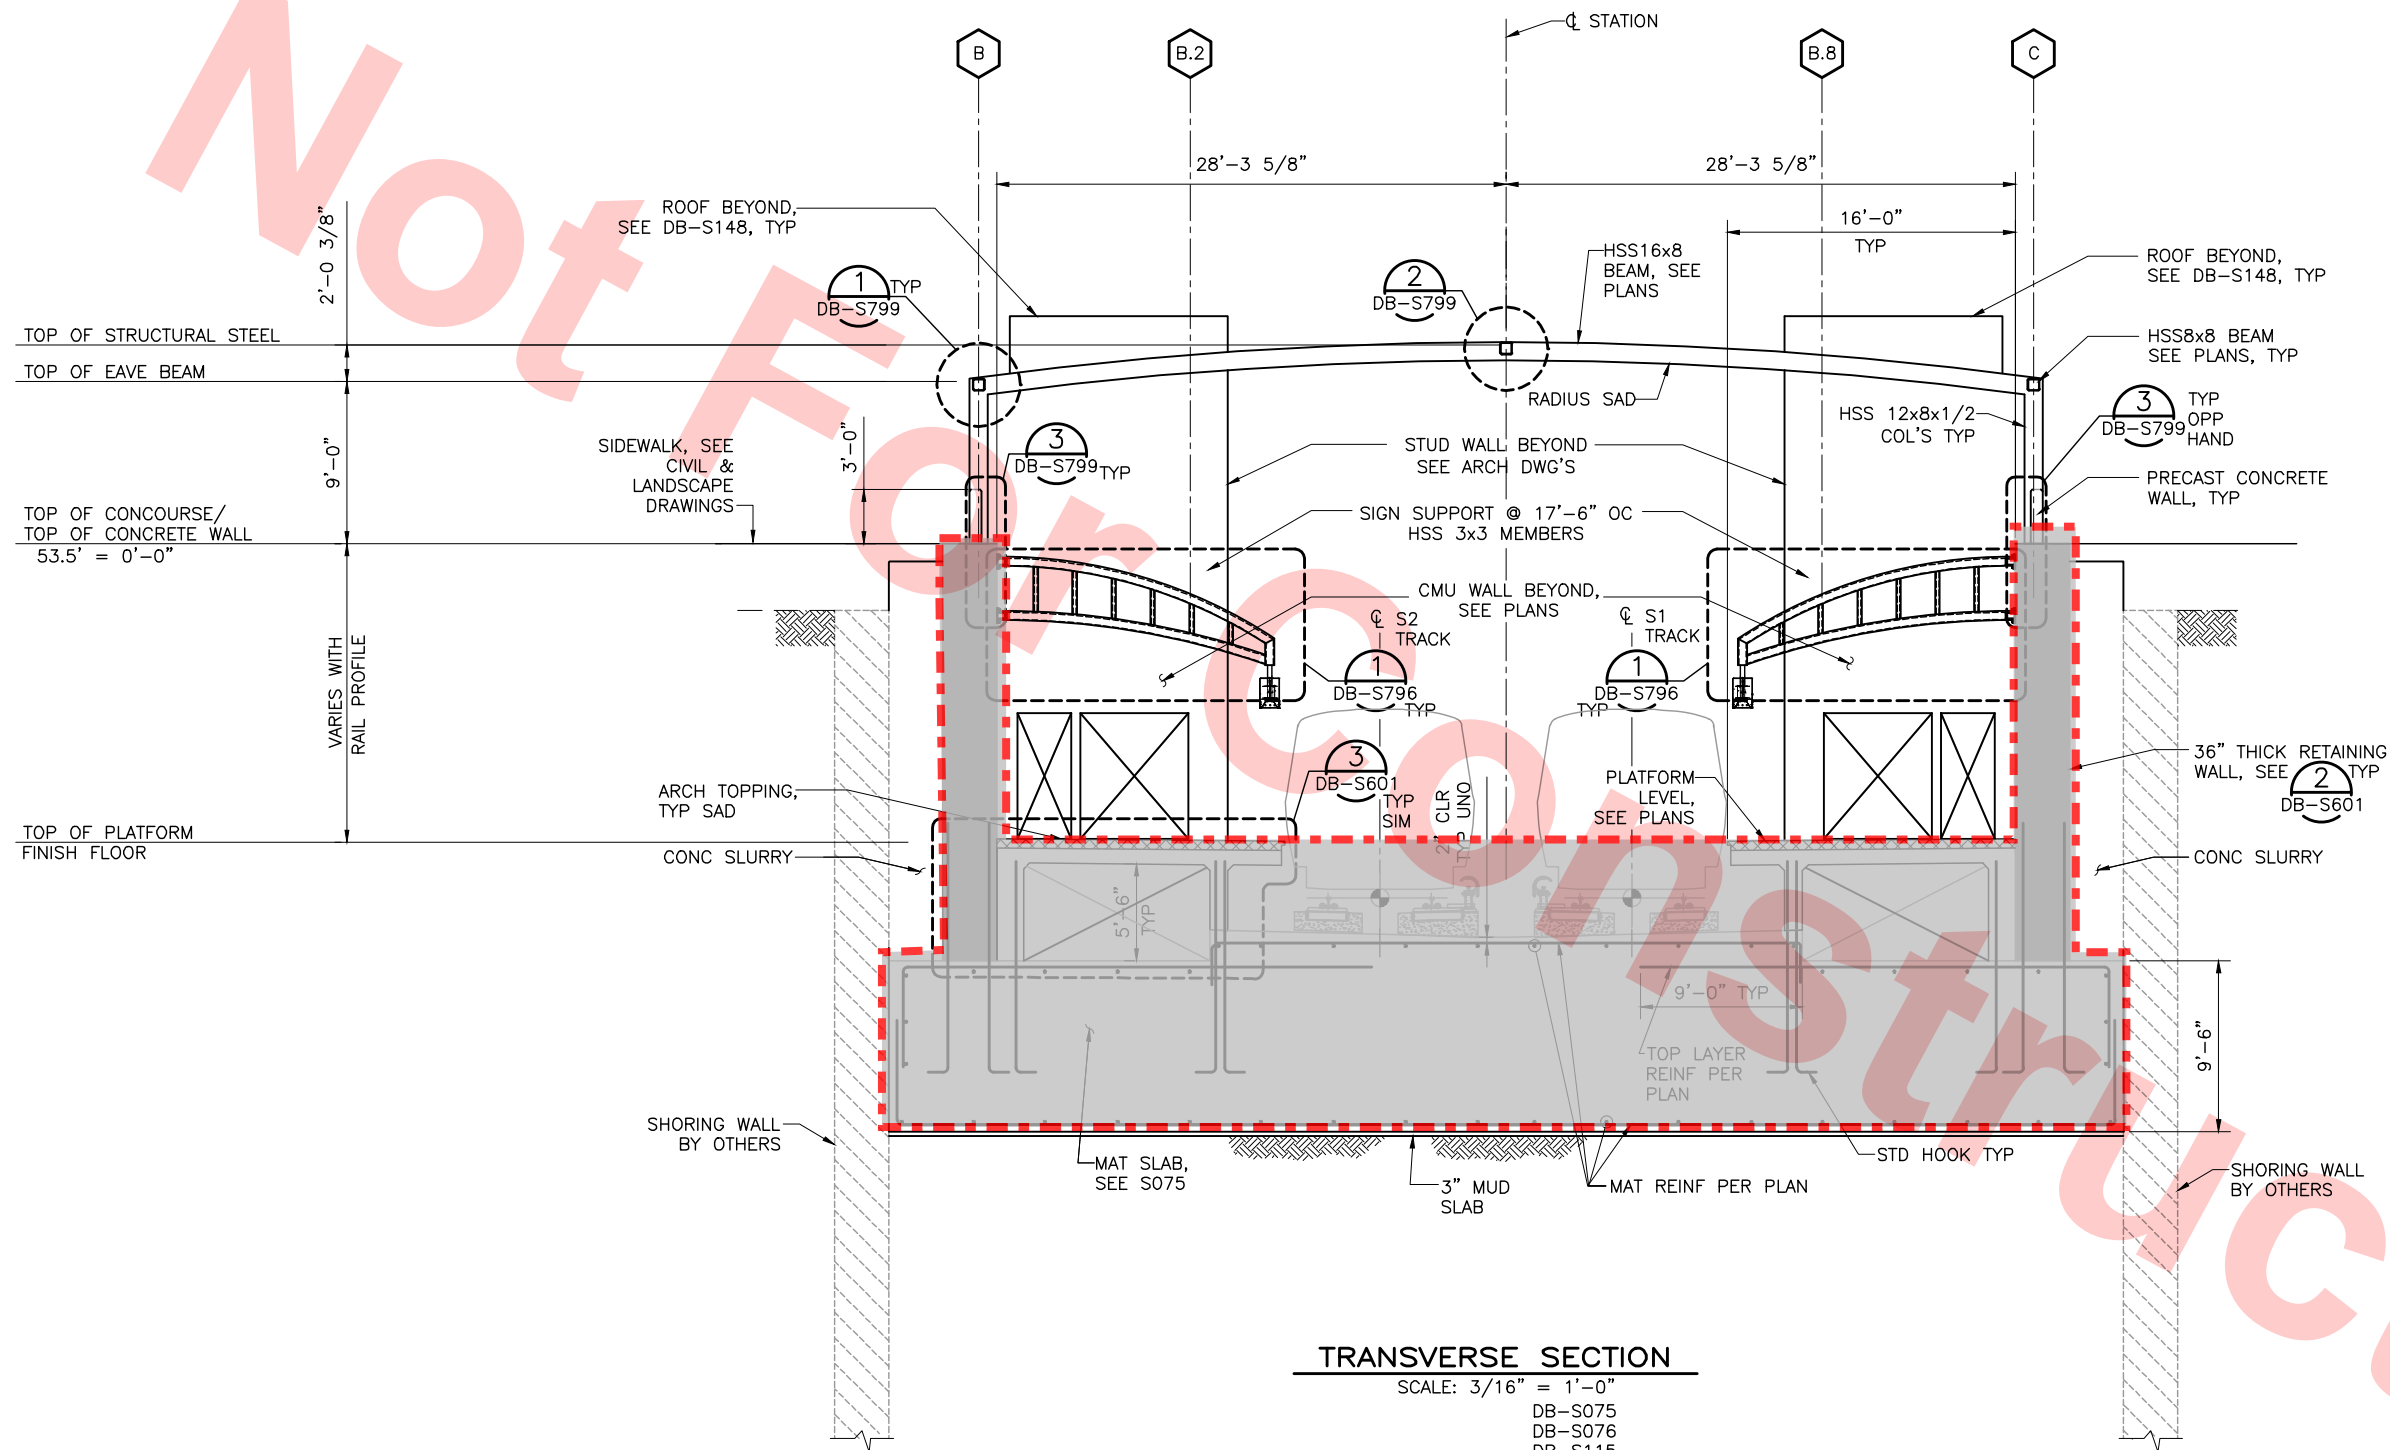

Santa Clara Valley Transportation Authority

NO EXCEPTIONS TAKEN (NET)  
MAKE CORRECTIONS NOTED (MCN)  
AMEND AND RESUBMIT (A/R)

Any action shown above is subject to the terms of the contract and does not relieve the Contractor of any of its obligations under the contract, including design and detailing.

Contract No.: DB11002F


By: \_\_\_\_\_ Date: \_\_\_\_\_

NOTE TO REVIEWER(S):  
DO NOT REVIEW AREAS DESIGNATED AS [REDACTED]

Jul 05, 2013 1:53pm P:\BART Berryessa Extension Line\AS - STRUCTURAL\MILPITAS WORK\6-10-2012\0700-S-DB-S211.dwg

REV	DATE	BY	SUB	APP	DESCRIPTION
0	20130710				READINESS FOR CONSTRUCTION
0	20130531				READINESS FOR CONSTRUCTION

DESIGNED BY  
J. REBER, S.E.  
DRAWN BY  
P. DIAZ  
CHECKED BY  
M. TARAZI  
IN CHARGE  
M. TARAZI  
DATE  
20130710

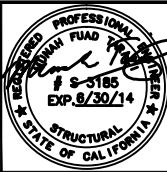

Skanska  
Shimmick  
Herzog

1436 California Circle  
Milpitas, California 95035  
A Joint Venture

MFT CONSULTING ENGINEERS, Inc. Anil Verma Associates, Inc.  
1773 San Pablo Ave., Suite A3 (510) 222-4100  
Palo Alto, CA 94304 Fax (415) 222-8410

Lealwood, Andrews  
& Newman, Inc.  
T-Y-LIN INTERNATIONAL

APPROVED



LINE, TRACK, STATIONS AND SYSTEMS  
DESIGN UNIT 023  
MILPITAS STATION  
TRANSVERSE SECTION






SHEET 2 OF 7

CADD FILENAME C700-S-DB-S211.dwg	CONTRACT NO. C700	REV. 0
SIZE D	SCALE 3/16" = 1'-0"	
AREA CODE DB	SHEET NO. S211	PAGE NO. 0190




**By:** \_\_\_\_\_ **Date:** \_\_\_\_\_

1. FOR GENERAL NOTES SEE DWG NO DB-S001X,  
DB-S002X, AND DB-S003X.

					DESIGNED BY J. REBER, S.E.					1436 California Circle Milpitas, California 95035 A Joint Venture			LINE, TRACK, STATIONS AND SYSTEMS DESIGN UNIT 023 MILPITAS STATION TRANSVERSE SECTION			CADD FILENAME C700-S-DB-S212.dwg				
					DRAWN BY P. DIAZ								SIZE D 3/16" = 1'-0"		CONTRACT NO. C700		REV. 0			
0 20130710					CHECKED BY M. TARAZI										AREA CODE DB		SHEET NO. S212		PAGE NO. 0191	
0 20130531					IN CHARGE M. TARAZI															
					DATE 20130710								BART SILICON VALLEY BERRYESSA EXTENSION			SHEET 3 OF 7				
REV DATE BY SUB APP DESCRIPTION					MFT CONSULTING ENGINEERS, INC. Anil Verma Associates, Inc. 1773 San Pablo Ave., Suite A3 (510) 222-4168 Pinola, CA 94854 Fax (510) 222-5616		SUBMITTED 		APPROVED 		LOCKWOOD, ANDREWS & NEWBURN, INC. A LIN & BENTLEY COMPANY T-Y-LIN INTERNATIONAL									




1. FOR GENERAL NOTES SEE DWG NO DB-S001X,  
DB-S002X, AND DB-S003X.

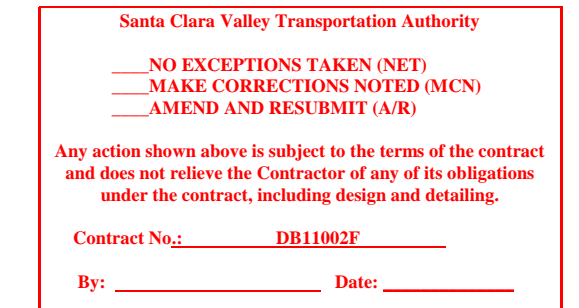


SCALE: 3/16"=1'-0"

DB-S074  
DB-S114  
DB-S126

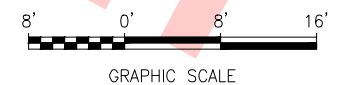

					DESIGNED BY J. REBER, S.E.
					DRAWN BY P. DIAZ
					CHECKED BY M. TARAZI
0	20130710				IN CHARGE M. TARAZI
0	20130531				DATE 20130710
REV	DATE	BY	SUB	APP	DESCRIPTION

DESIGNED BY J. REBER, S.E.
DRAWN BY P. DIAZ
CHECKED BY M. TARAZI
IN CHARGE M. TARAZI
DATE 20130710

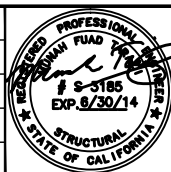

Skanska  
Shimmick  
Herzog

1436 California Circle  
Milpitas, California 95035  
A Joint Venture

**MFT CONSULTING ENGINEERS, INC.** Anil Verma, Associates, Inc.  
1773 San Pablo Ave., Suite A3 (510) 222-4106  
Pinole, CA 94564 Fax (510) 222-0418

SUBMITTED *Meena K. Verma*


**Lockwood, Andrews & Newnam, Inc.**  
 A LEO A DALY COMPANY

**T-Y-LIN INTERNATIONAL**  
 APPROVED *R. A. Henth*



BART SILICON VALLEY BERRYESSA EXTENSION


LINE, TRACK, STATIONS AND SYSTEMS  
DESIGN UNIT 023  
MILPITAS STATION  
TRANSVERSE SECTION

SHEET 4 OF 7

CADD FILENAME C700-S-DB-S213.dwg		
SIZE D	SCALE 3/16" = 1'-0"	
CONTRACT NO. <b>C700</b>		REV. <b>0</b>
AREA CODE <b>DB</b>	SHEET NO. <b>S213</b>	PAGE NO. <b>0192</b>



NOTE:  
1. FOR GENERAL NOTES SEE DWG NO DB-S001X, DB-S002X, AND DB-S003X.

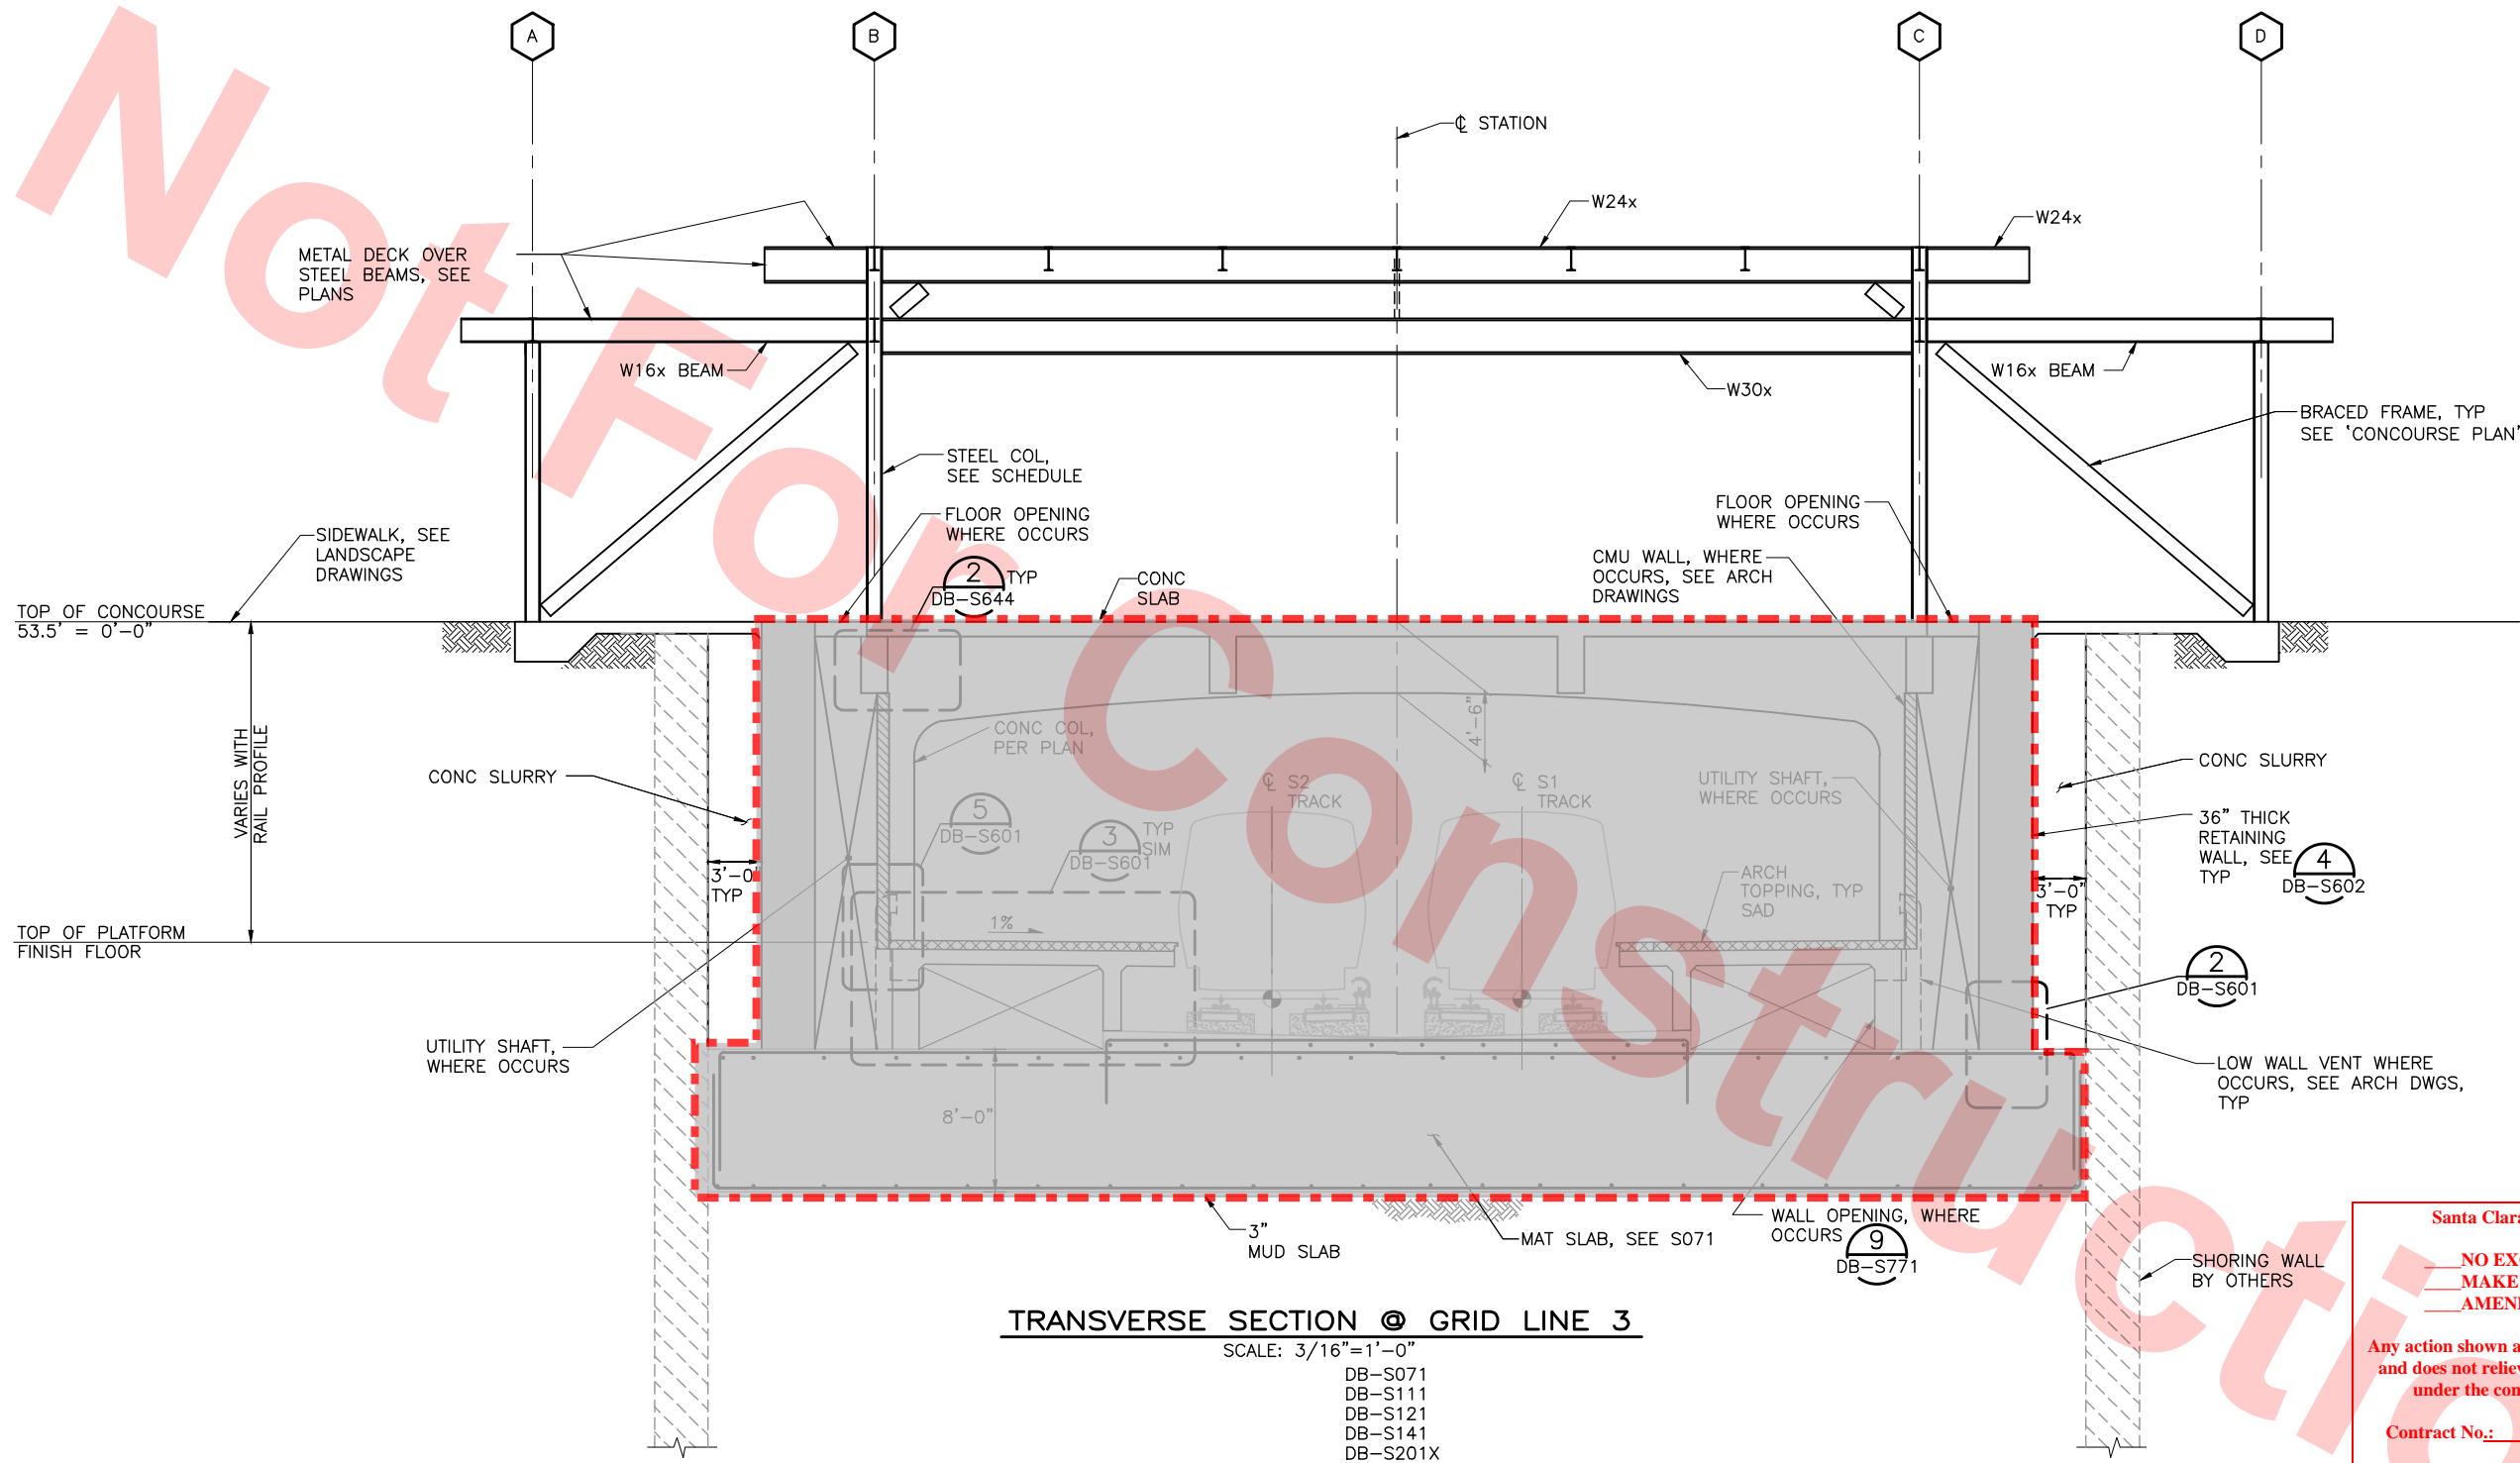

TRANSVERSE SECTION @ GRID LINE 3

SCALE: 3/16"=1'-0"

DB-S071  
DB-S111  
DB-S121  
DB-S141  
DB-S201X

Santa Clara Valley Transportation Authority

NO EXCEPTIONS TAKEN (NET)  
MAKE CORRECTIONS NOTED (MCN)  
AMEND AND RESUBMIT (A/R)

Any action shown above is subject to the terms of the contract and does not relieve the Contractor of any of its obligations under the contract, including design and detailing.

Contract No.: DB11002F

By: \_\_\_\_\_ Date: \_\_\_\_\_



NOTE TO REVIEWER(S):  
DO NOT REVIEW AREAS DESIGNATED AS

Jul 05, 2013 1:53pm P:\BART Berryessa Extension Line\AS - STRUCTURAL\MILPITAS WORK\6-10-2012\0700-S-DB-S214.dwg

						DESIGNED BY J. REBER, S.E.
						DRAWN BY P. DIAZ
0	20130710				READINESS FOR CONSTRUCTION	CHECKED BY M. TARAZI
0	20130531				READINESS FOR CONSTRUCTION	IN CHARGE M. TARAZI
REV	DATE	BY	SUB	APP	DESCRIPTION	DATE 20130710



Skanska  
Shimmick  
Herzog

1436 California Circle  
Milpitas, California 95035  
A Joint Venture

MFT CONSULTING ENGINEERS, Inc. Anil Verma Associates, Inc.  
1773 San Pablo Ave., Suite A3 (510) 222-4100  
Palo Alto, CA 94304 Fax (650) 222-8410

Submitted: \_\_\_\_\_

Lealwood, Andrews  
& Newman, Inc.

T-Y-LIN INTERNATIONAL

Approved: \_\_\_\_\_

BART  
SILICON VALLEY

BART SILICON VALLEY BERRYESSA EXTENSION


LINE, TRACK, STATIONS AND SYSTEMS  
DESIGN UNIT 023  
MILPITAS STATION  
TRANSVERSE SECTION

SHEET 5 OF 7

CADD FILENAME		
C700-S-DB-S214.dwg		
SIZE	SCALE	
D	3/16" = 1'-0"	
CONTRACT NO.		REV.
C700		0
AREA CODE	SHEET NO.	PAGE NO.
DB	S214	0193



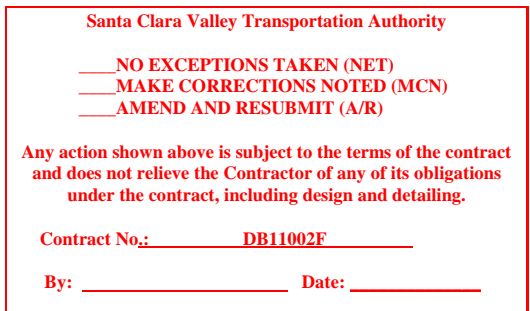

1. FOR GENERAL NOTES SEE DWG NO DB-S001X,  
DB-S002X, AND DB-S003X.



\_\_\_\_\_


DB-S071  
DB-S111  
DB-S121  
DB-S141  
DB-S201X

GRAPHIC SCALE

					DESIGNED BY J. REBER, S.E.		<b>Skanska Shimmick Herzog</b>  1436 California Circle Milpitas, California 95035 A Joint Venture		<b>LINE, TRACK, STATIONS AND SYSTEMS</b>  <b>DESIGN UNIT 023</b>  MILPITAS STATION TRANSVERSE SECTION	CADD FILENAME C700-S-DB-S215.dwg		
					DRAWN BY P. DIAZ					SIZE D	SCALE 3/16" = 1'-0"	REV.
0	20130710				CHECKED BY M. TARAZI							
0	20130531				IN CHARGE M. TARAZI							
READINESS FOR CONSTRUCTION					DATE 20130710							
READINESS FOR CONSTRUCTION												
REV	DATE	BY	SUB	APP	DESCRIPTION							



NOTE:  
1. FOR GENERAL NOTES SEE DWG NO DB-S001X,  
DB-S002X, AND DB-S003X.

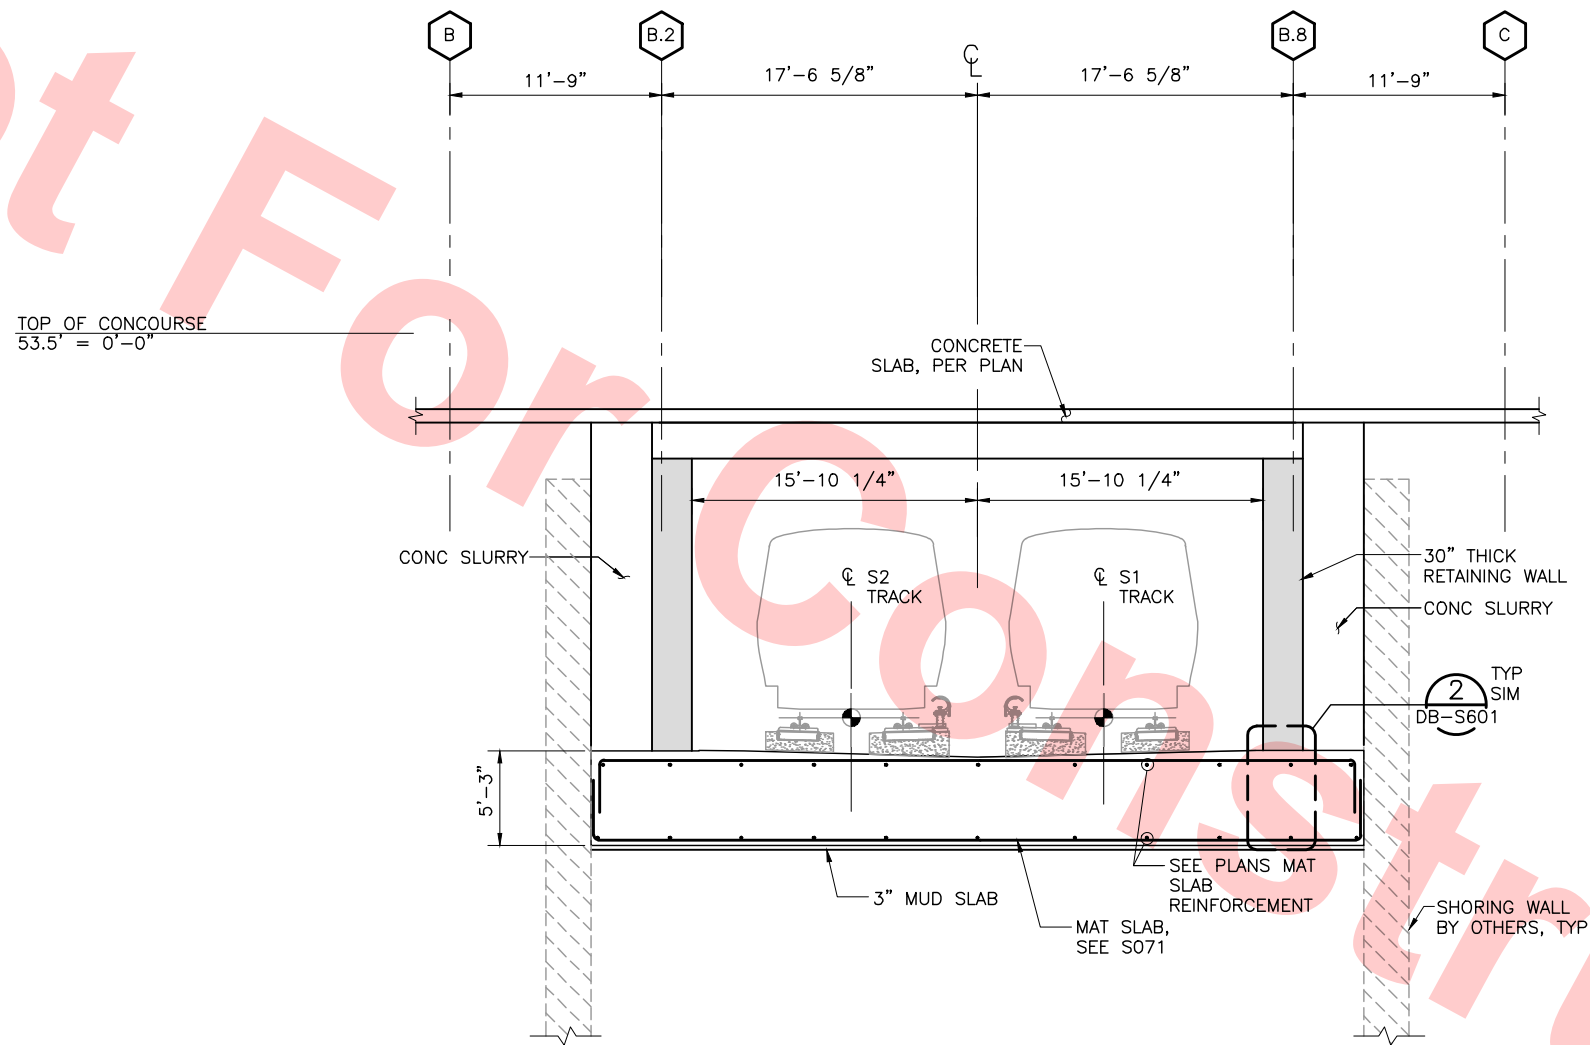

TRANSVERSE SECTION

SCALE: 3/16"=1'-0"

DB-S071  
DB-S111  
DB-S121  
DB-S201X  
DB-S204X




FOR REFERENCE ONLY AND NOT FOR REVIEW.  
THIS DRAWING WAS SUBMITTED UNDER  
DU-23-WP08 TRENCH PACKAGE

Jul 05, 2013 - 1:53pm P:\BART Berryessa Extension Line\AS - STRUCTURAL MILPITAS WORK\_6-10-2012\0700-S-DB-S216.dwg


						DESIGNED BY J. REBER, S.E.		 1436 California Circle Milpitas, California 95035 A Joint Venture		 1773 San Pablo Ave., Suite A3 Pinole, CA 94664 (510) 222-4166 Fax (510) 222-6418	 A LEO A DALY COMPANY		 BART SILICON VALLEY BERRYESSA EXTENSION		LINE, TRACK, STATIONS AND SYSTEMS DESIGN UNIT 023 MILPITAS STATION TRANSVERSE SECTION  SHEET 7 OF 7		CADD FILENAME C700-S-DB-S216.dwg		
						DRAWN BY P. DIAZ											SIZE SCALE D 3/16" = 1'-0"	CONTRACT NO. C700	REV. 0
						CHECKED BY M. TARAZI													
						IN CHARGE M. TARAZI													
0	20130531				READINESS FOR CONSTRUCTION	DATE 20130531		SUBMITTED		APPROVED						AREA CODE SHEET NO. PAGE NO. DB S216 0195			
REV	DATE	BY	SUB	APP	DESCRIPTION														




Jul 05, 2013 1:53pm P:\BART Berryessa Extension Line\5 - STRUCTURAL MILPITAS WORK\6-10-2012\0700-S-DB-S501.dwg

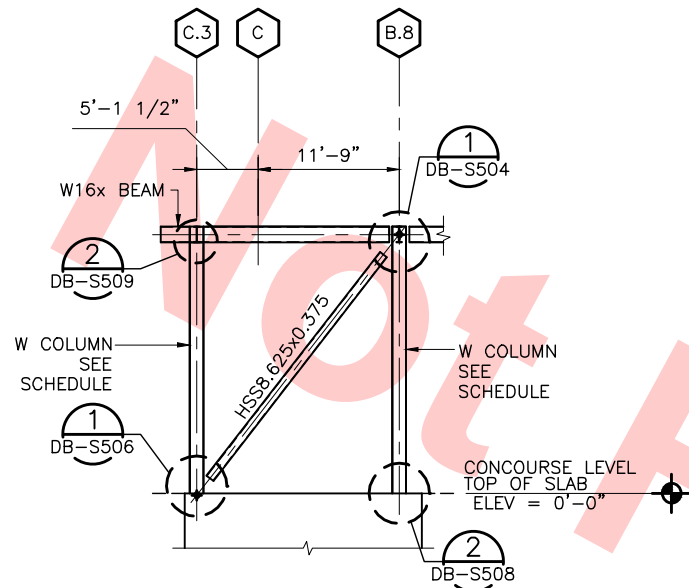


FRAME ELEVATION @ GRID 0.3 (BF-1)  
SCALE: 1/8"=1'-0"  
DB-S121  
DB-S141

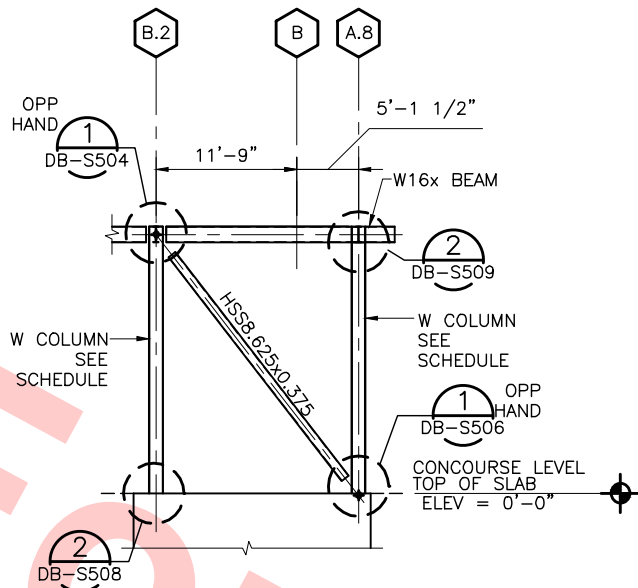

FRAME ELEVATION @ GRID 0.3 (BF-2)  
SCALE: 1/8"=1'-0"  
DB-S121  
DB-S141

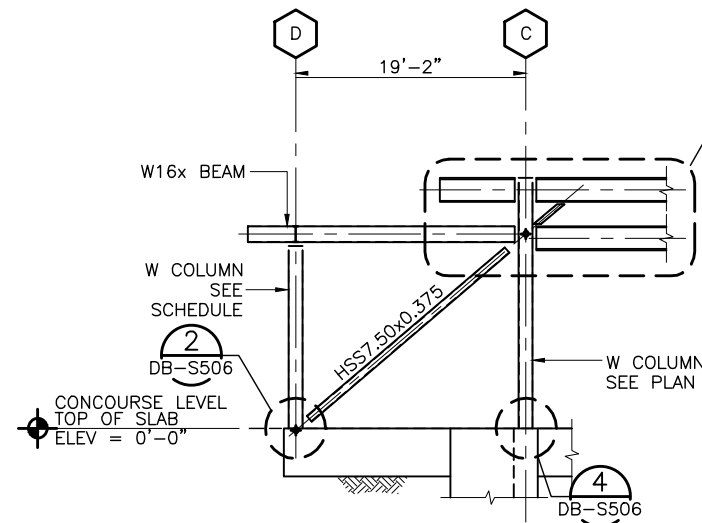

FRAME ELEVATION @ GRID 3 (BF-3)  
SCALE: 1/8"=1'-0"  
DB-S121  
DB-S141

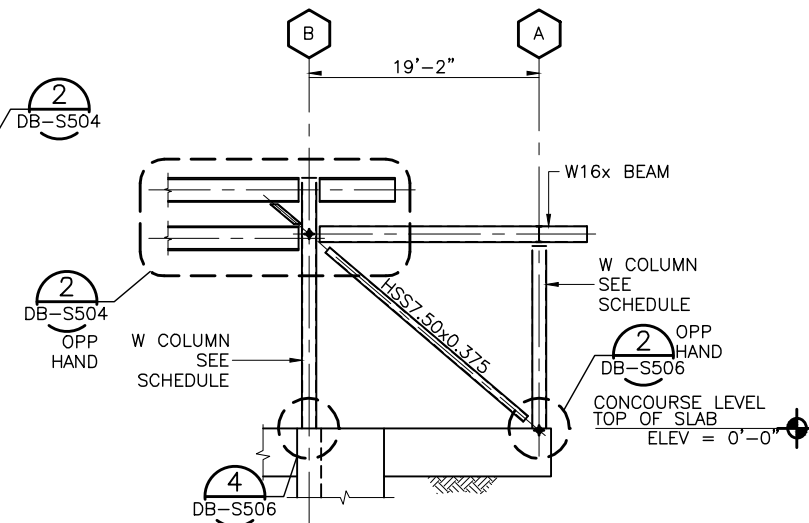


FRAME ELEVATION @ GRID 3 (BF-4)  
SCALE: 1/8"=1'-0"  
DB-S121  
DB-S141

Santa Clara Valley Transportation Authority


NO EXCEPTIONS TAKEN (NET)  
MAKE CORRECTIONS NOTED (MCN)  
AMEND AND RESUBMIT (A/R)

Any action shown above is subject to the terms of the contract and does not relieve the Contractor of any of its obligations under the contract, including design and detailing.


Contract No.: DB11002F  
By: \_\_\_\_\_ Date: \_\_\_\_\_

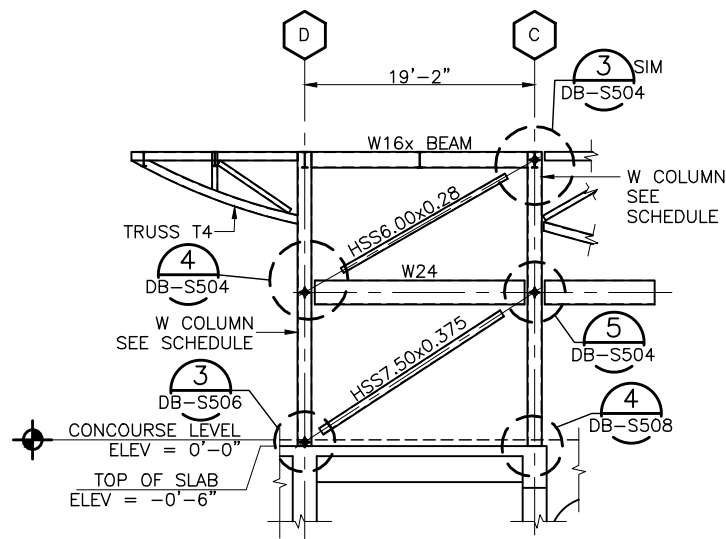


FRAME ELEVATION @ GRID 5 (BF-5)  
SCALE: 1/8"=1'-0"  
DB-S123  
DB-S143

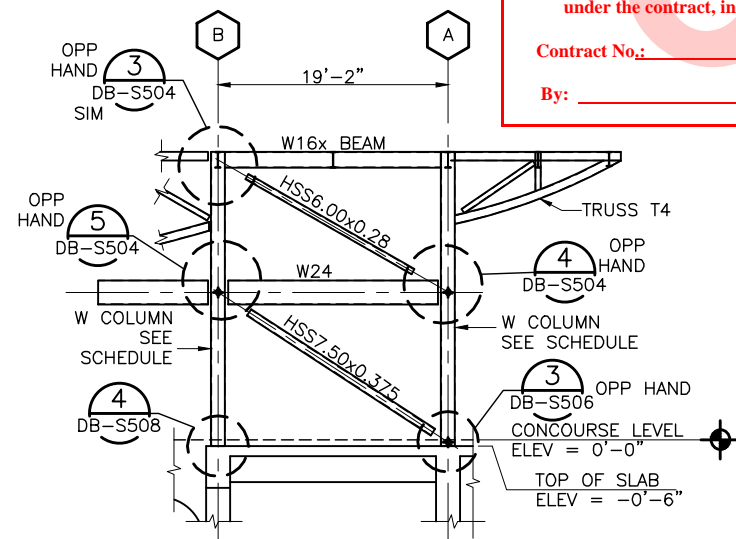

FRAME ELEVATION @ GRID 5 (BF-6)  
SCALE: 1/8"=1'-0"  
DB-S122  
DB-S142

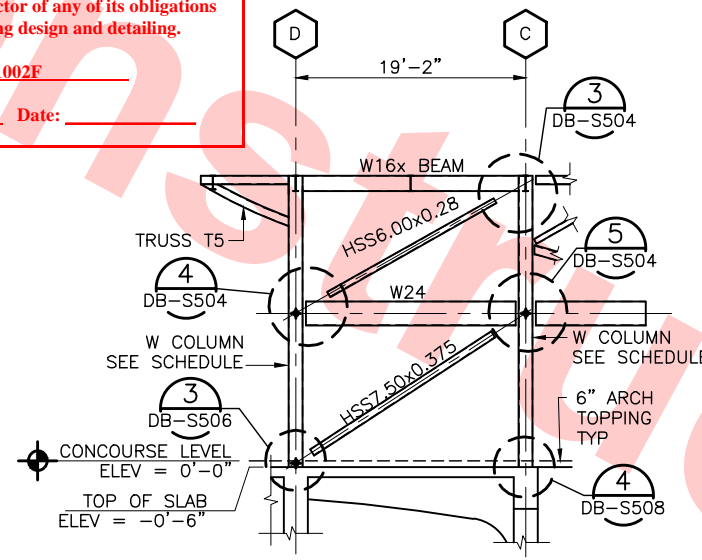


FRAME ELEVATION @ GRID 12 (BF-11)  
SCALE: 1/8"=1'-0"  
DB-S125  
DB-S145

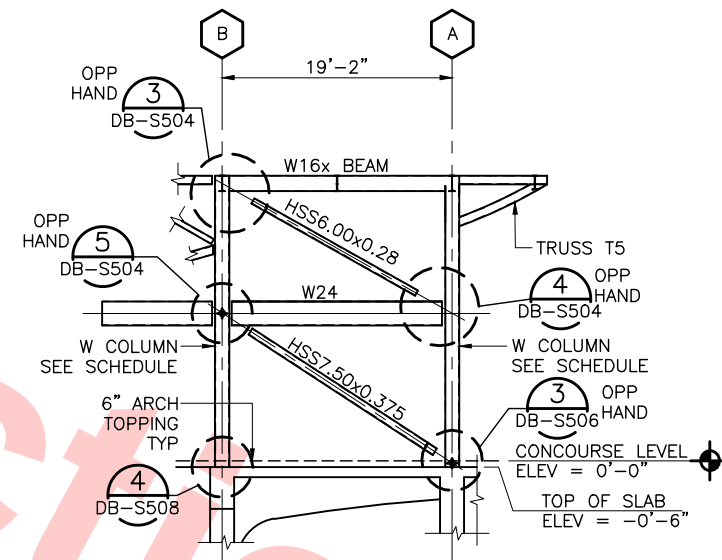

FRAME ELEVATION @ GRID 12 (BF-12)  
SCALE: 1/8"=1'-0"  
DB-S124  
DB-S144

NOTE: REFER TO (5) FOR DIAGONAL BRACE PROTECTED ZONE, TYP.  
DB-S511

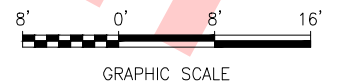

REV	DATE	BY	SUB	APP	DESCRIPTION
0	20130710				READINESS FOR CONSTRUCTION

DESIGNED BY  
J. REBER, S.E.  
DRAWN BY  
P. DIAZ  
CHECKED BY  
M. TARAZI  
IN CHARGE  
M. TARAZI  
DATE  
20130710



Skanska  
Shimmick  
Herzog

1436 California Circle  
Milpitas, California 95035  
A Joint Venture

MFT CONSULTING ENGINEERS, Inc. Anil Verma Associates, Inc.  
1773 San Pablo Ave., Suite A3 (510) 222-4100  
Palo Alto, CA 94304 Fax (415) 323-8410

Lealwood, Andrews  
& Newman, Inc.  
A LEO A DALY COMPANY


T-Y-LIN INTERNATIONAL



LINE, TRACK, STATIONS AND SYSTEMS  
DESIGN UNIT 023  
MILPITAS STATION  
STEEL BRACED FRAME  
ELEVATIONS & DETAILS  
SHEET 1 OF 11

CADD FILENAME C700-S-DB-S501.dwg	REV.
SIZE   SCALE 1/8"=1'-0"	0
CONTRACT NO. C700	PAGE NO. 0196
AREA CODE DB	SHEET NO. S501




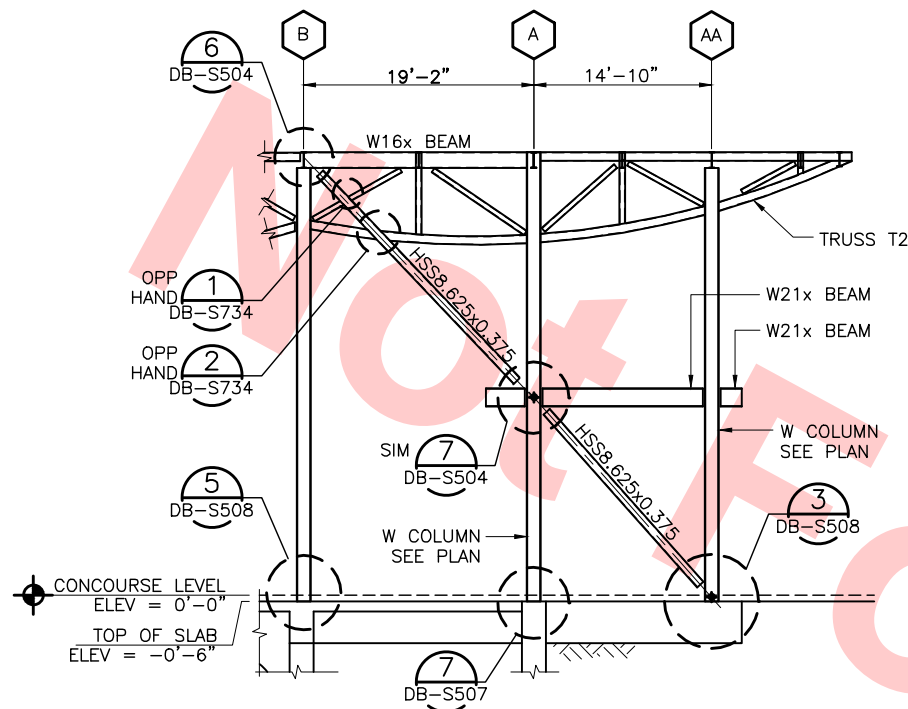

FRAME ELEVATION @ GRID 7 & 10 (BF-8) (BF-10)

SCALE: 1/8"=1'-0"


DB-S122  
DB-S124  
DB-S142  
DB-S144

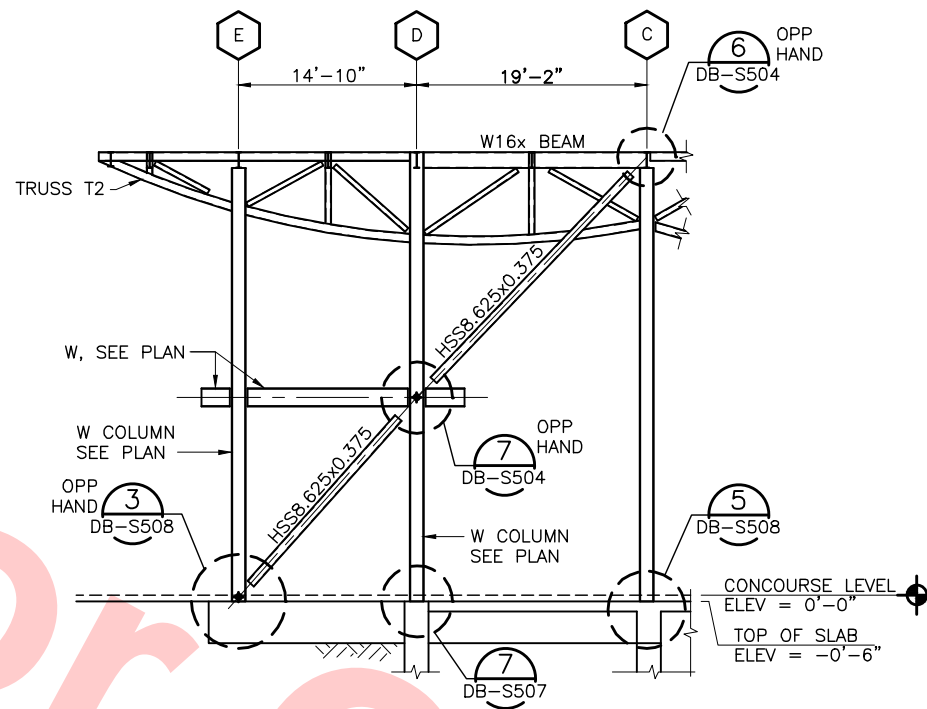

FRAME ELEVATION @ GRID 7 & 10 (BF-7) (BF-9)

SCALE: 1/8"=1'-0"


DB-S123  
DB-S125  
DB-S143  
DB-S145

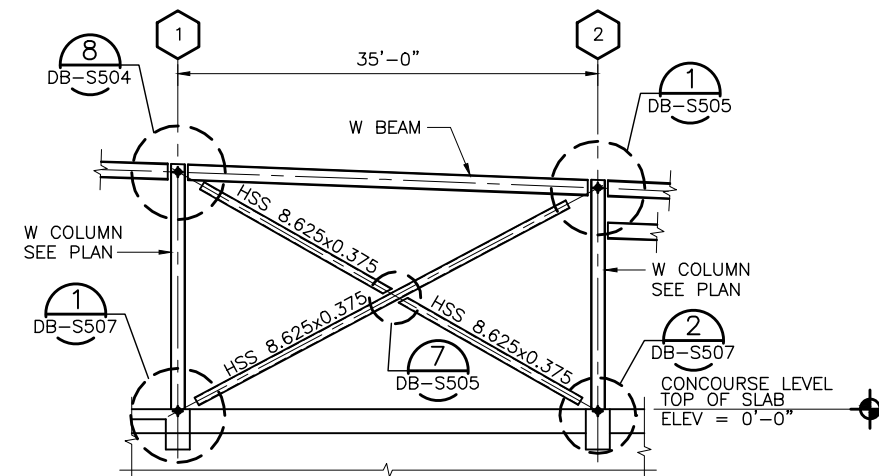

FRAME ELEVATION @ GRID B & C (BF-13) (BF-14)

SCALE: 1/8"=1'-0"


DB-S121  
DB-S141

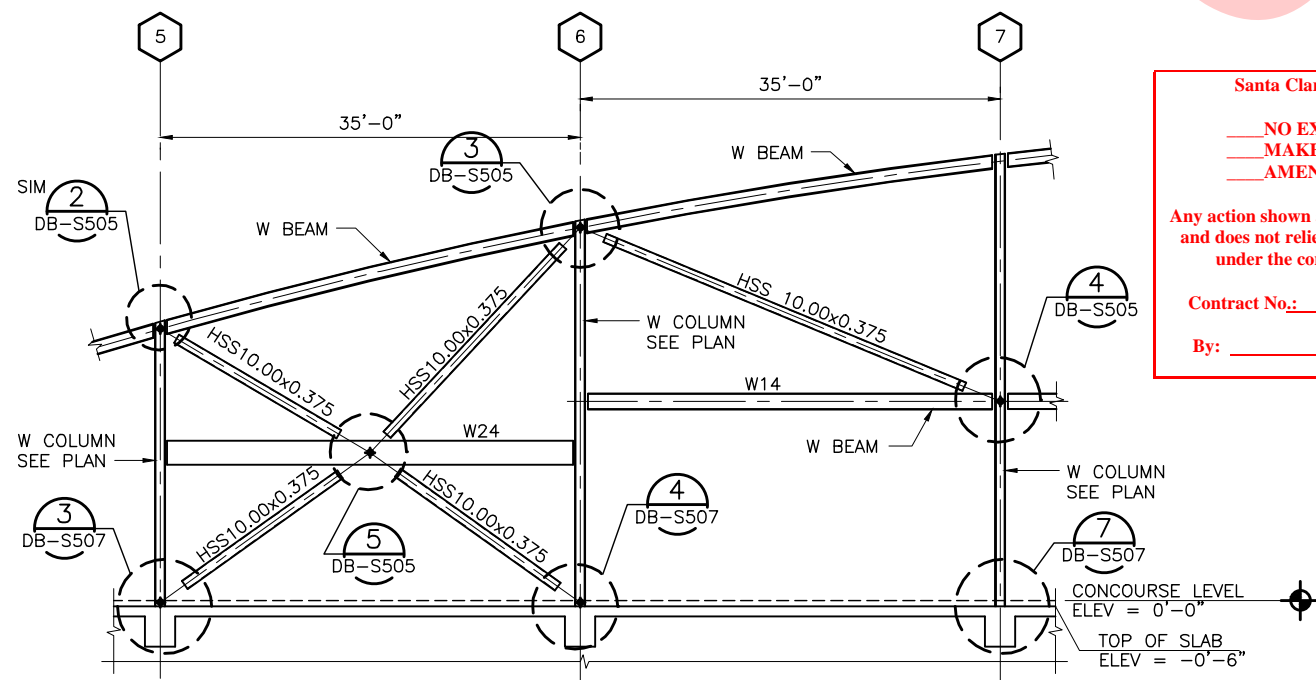

FRAME ELEVATION @ GRID A & D (BF-15) (BF-16)

SCALE: 1/8"=1'-0"

DB-S122  
DB-S123  
DB-S142  
DB-S143

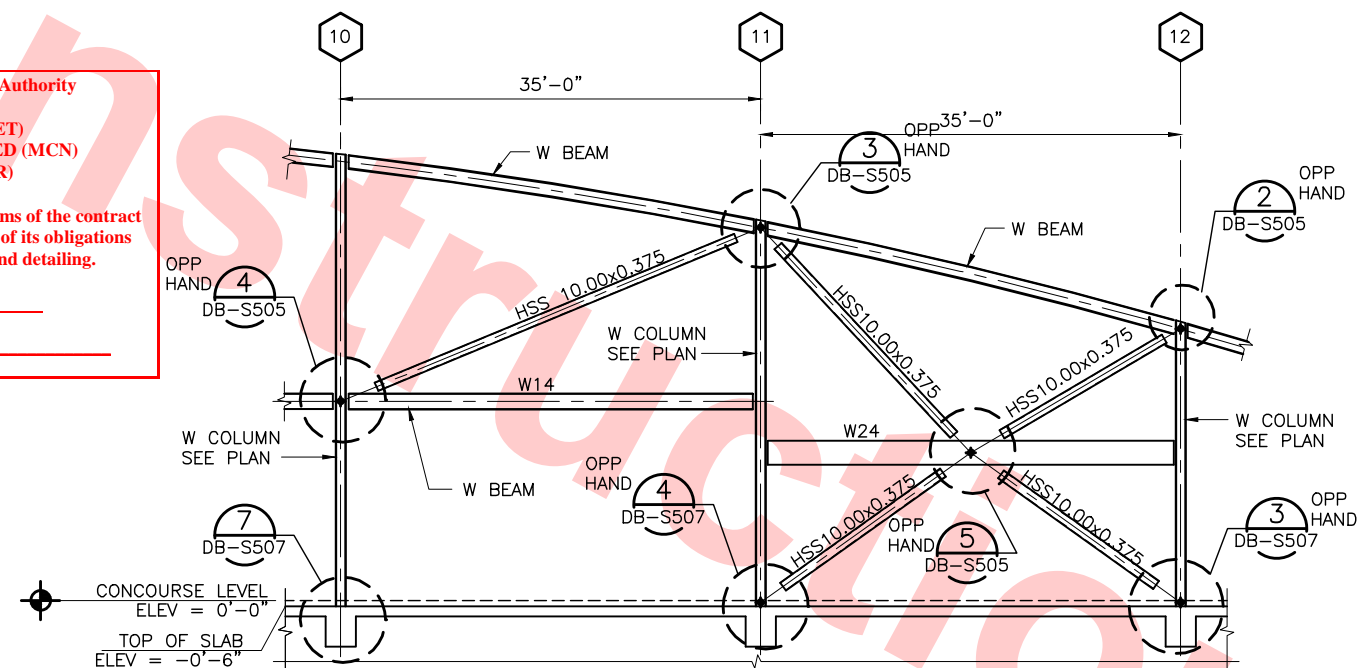

FRAME ELEVATION @ GRID A & D (BF-17) (BF-18)

SCALE: 1/8"=1'-0"

DB-S124  
DB-S125

Santa Clara Valley Transportation Authority

NO EXCEPTIONS TAKEN (NET)  
MAKE CORRECTIONS NOTED (MCN)  
AMEND AND RESUBMIT (A/R)

Any action shown above is subject to the terms of the contract and does not relieve the Contractor of any of its obligations under the contract, including design and detailing.


Contract No.: DB11002F

By: \_\_\_\_\_ Date: \_\_\_\_\_

Jul 05, 2013 1:53pm P:\BART Berryessa Extension Line\AS - STRUCTURAL MILPITAS WORK\6-10-2012\0700-S-DB-S502.dwg

DESIGNED BY	J. REBER, S.E.
DRAWN BY	P. DIAZ
CHECKED BY	M. TARAZI
IN CHARGE	M. TARAZI
DATE	20130710

0	20130710					READINESS FOR CONSTRUCTION
REV	DATE	BY	SUB	APP		DESCRIPTION

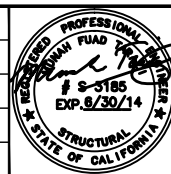

Skanska Shimmick Herzog	1436 California Circle Milpitas, California 95035 A Joint Venture
MFT CONSULTING ENGINEERS, INC. Anil Verma Associates, Inc. 1773 San Pablo Ave., Suite A3 Palo Alto, CA 94304 (650) 222-4100 Fax (650) 222-8410	Lealwood, Andrews & Newman, Inc. A LEO A DALY COMPANY
T-Y-LIN INTERNATIONAL	



LINE, TRACK, STATIONS AND SYSTEMS  
DESIGN UNIT 023  
MILPITAS STATION  
STEEL BRACED FRAME  
ELEVATIONS & DETAILS  
SHEET 2 OF 11

CADD FILENAME	C700-S-DB-S502.dwg
SIZE	D
SCALE	1/8"=1'-0"
CONTRACT NO.	C700
AREA CODE	DB
SHEET NO.	S502
PAGE NO.	0197



Jul 05, 2013 - 1:53pm P:\BART Berryessa Extension Line\S - STRUCTURAL MILPITAS WORK\_E-10-2012\0700-S-DB-S503.dwg  
c04-02

REV	DATE	BY	SUB	APP	DESCRIPTION
0	20130710				READINESS FOR CONSTRUCTION

DESIGNED BY  
J. REBER, S.E.  
DRAWN BY  
P. DIAZ  
CHECKED BY  
M. TARAZI  
IN CHARGE  
M. TARAZI  
DATE  
20130710




**MFT CONSULTING ENGINEERS, Inc.**  
1773 San Pablo Ave., Suite A3  
Pinole, CA 94664  
(910) 222-4100  
Fax (910) 222-8410

**Skanska Shimmick Herzog**  
1436 California Circle  
Milpitas, California 95035  
A Joint Venture  
**Lealwood, Andrews & Newman, Inc.**  
A LEO A DALY COMPANY  
**T-Y-LIN INTERNATIONAL**




**LINE, TRACK, STATIONS AND SYSTEMS**  
**DESIGN UNIT 023**  
MILPITAS STATION  
STEEL BRACED FRAME  
ELEVATIONS & DETAILS  
SHEET 3 OF 11


CADD FILENAME C700-S-DB-S503.dwg	CONTRACT NO. C700	REV. 0
SIZE D	SCALE 1/8"=1'-0"	AREA CODE DB
SHEET NO. S503	PAGE NO. 0198	

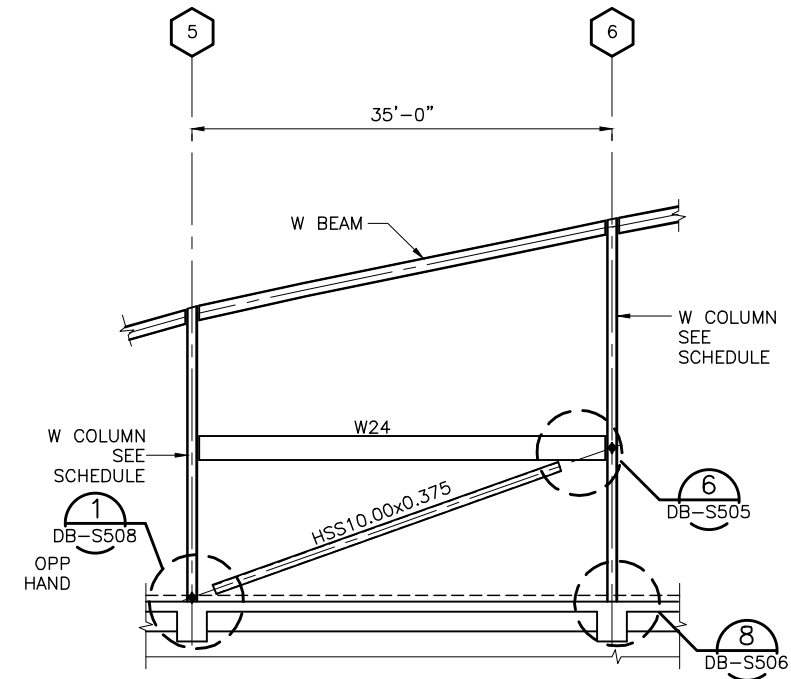

FRAME ELEVATION @ GRID B & C (BF-19) (BF-20)  
SCALE: 1/8"=1'-0"  
DB-S122  
DB-S123





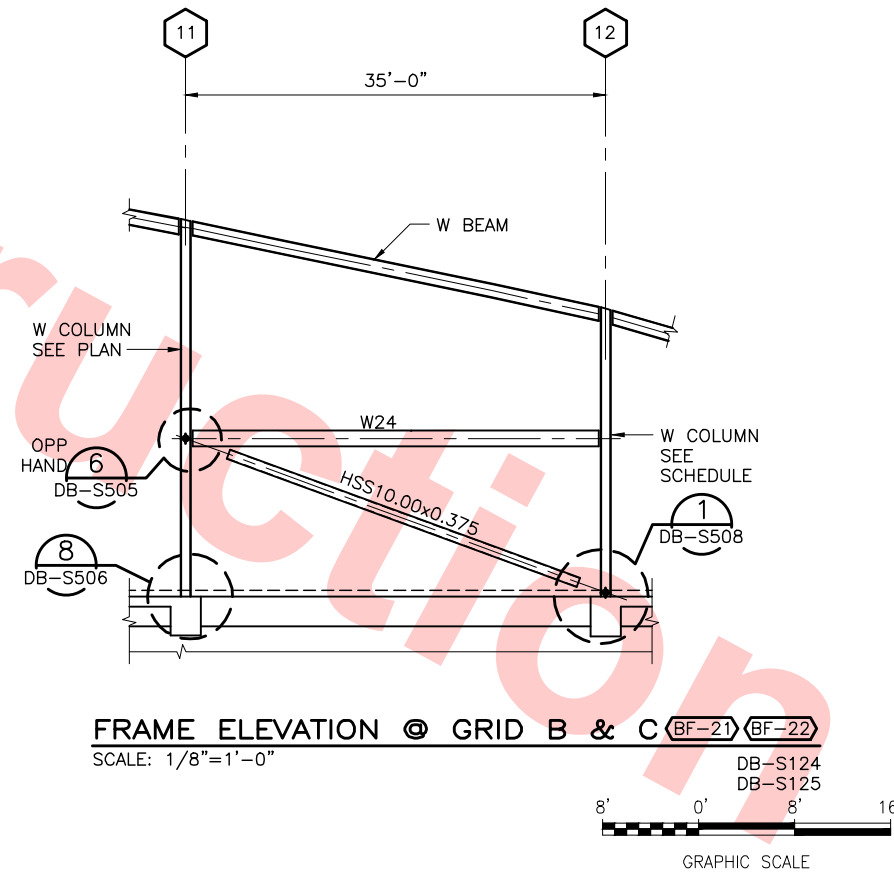


FRAME ELEVATION @ GRID B & C (BF-21) (BF-22)  
SCALE: 1/8"=1'-0"  
DB-S124  
DB-S125

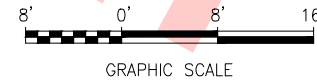

**Santa Clara Valley Transportation Authority**  
NO EXCEPTIONS TAKEN (NET)  
MAKE CORRECTIONS NOTED (MCN)  
AMEND AND RESUBMIT (A/R)  
Any action shown above is subject to the terms of the contract and does not relieve the Contractor of any of its obligations under the contract, including design and detailing.  
Contract No.: DB11002F  
By: \_\_\_\_\_ Date: \_\_\_\_\_



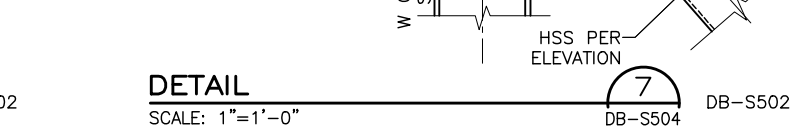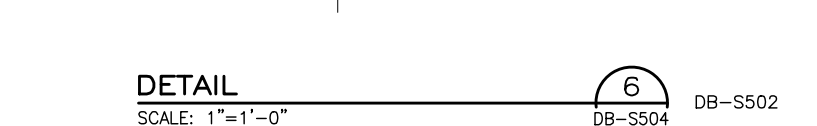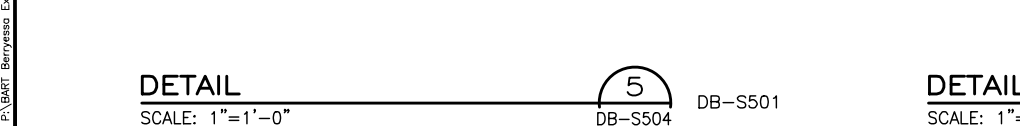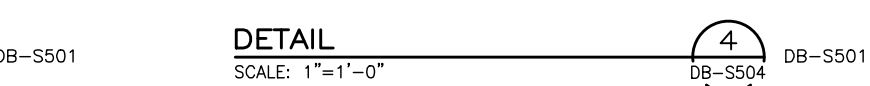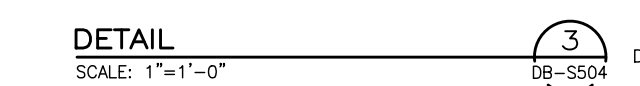


	<b>Skanska Shimmick Herzog</b> 1436 California Circle Milpitas, California 95035 A Joint Venture	
	<b>MFT CONSULTING ENGINEERS, Inc.</b> 1773 San Pablo Ave., Suite A3 Pinole, CA 94964 Tel: (916) 222-4056 Fax: (916) 222-6114	<b>Lockwood, Andrews &amp; Newnam, Inc.</b> 2 LIND A WAY DRIVE
SUBMITTED <i>Michael Herzog</i>	APPROVED <i>Ry. Apthorn</i>	



CADD FILENAME C700-S-DB-S504.dwg		
SIZE	SCALE AS NOTED	
CONTRACT NO. C700		REV. 0
AREA CODE DB	SHEET NO. S504	PAGE NO. 0199



04-02 Jul 05, 2013 1:53pm P:\BART Berryessa Extension Line\AS - STRUCTURAL\MILPITAS WORK\6-10-2012\0700-S-DB-S505.dwg

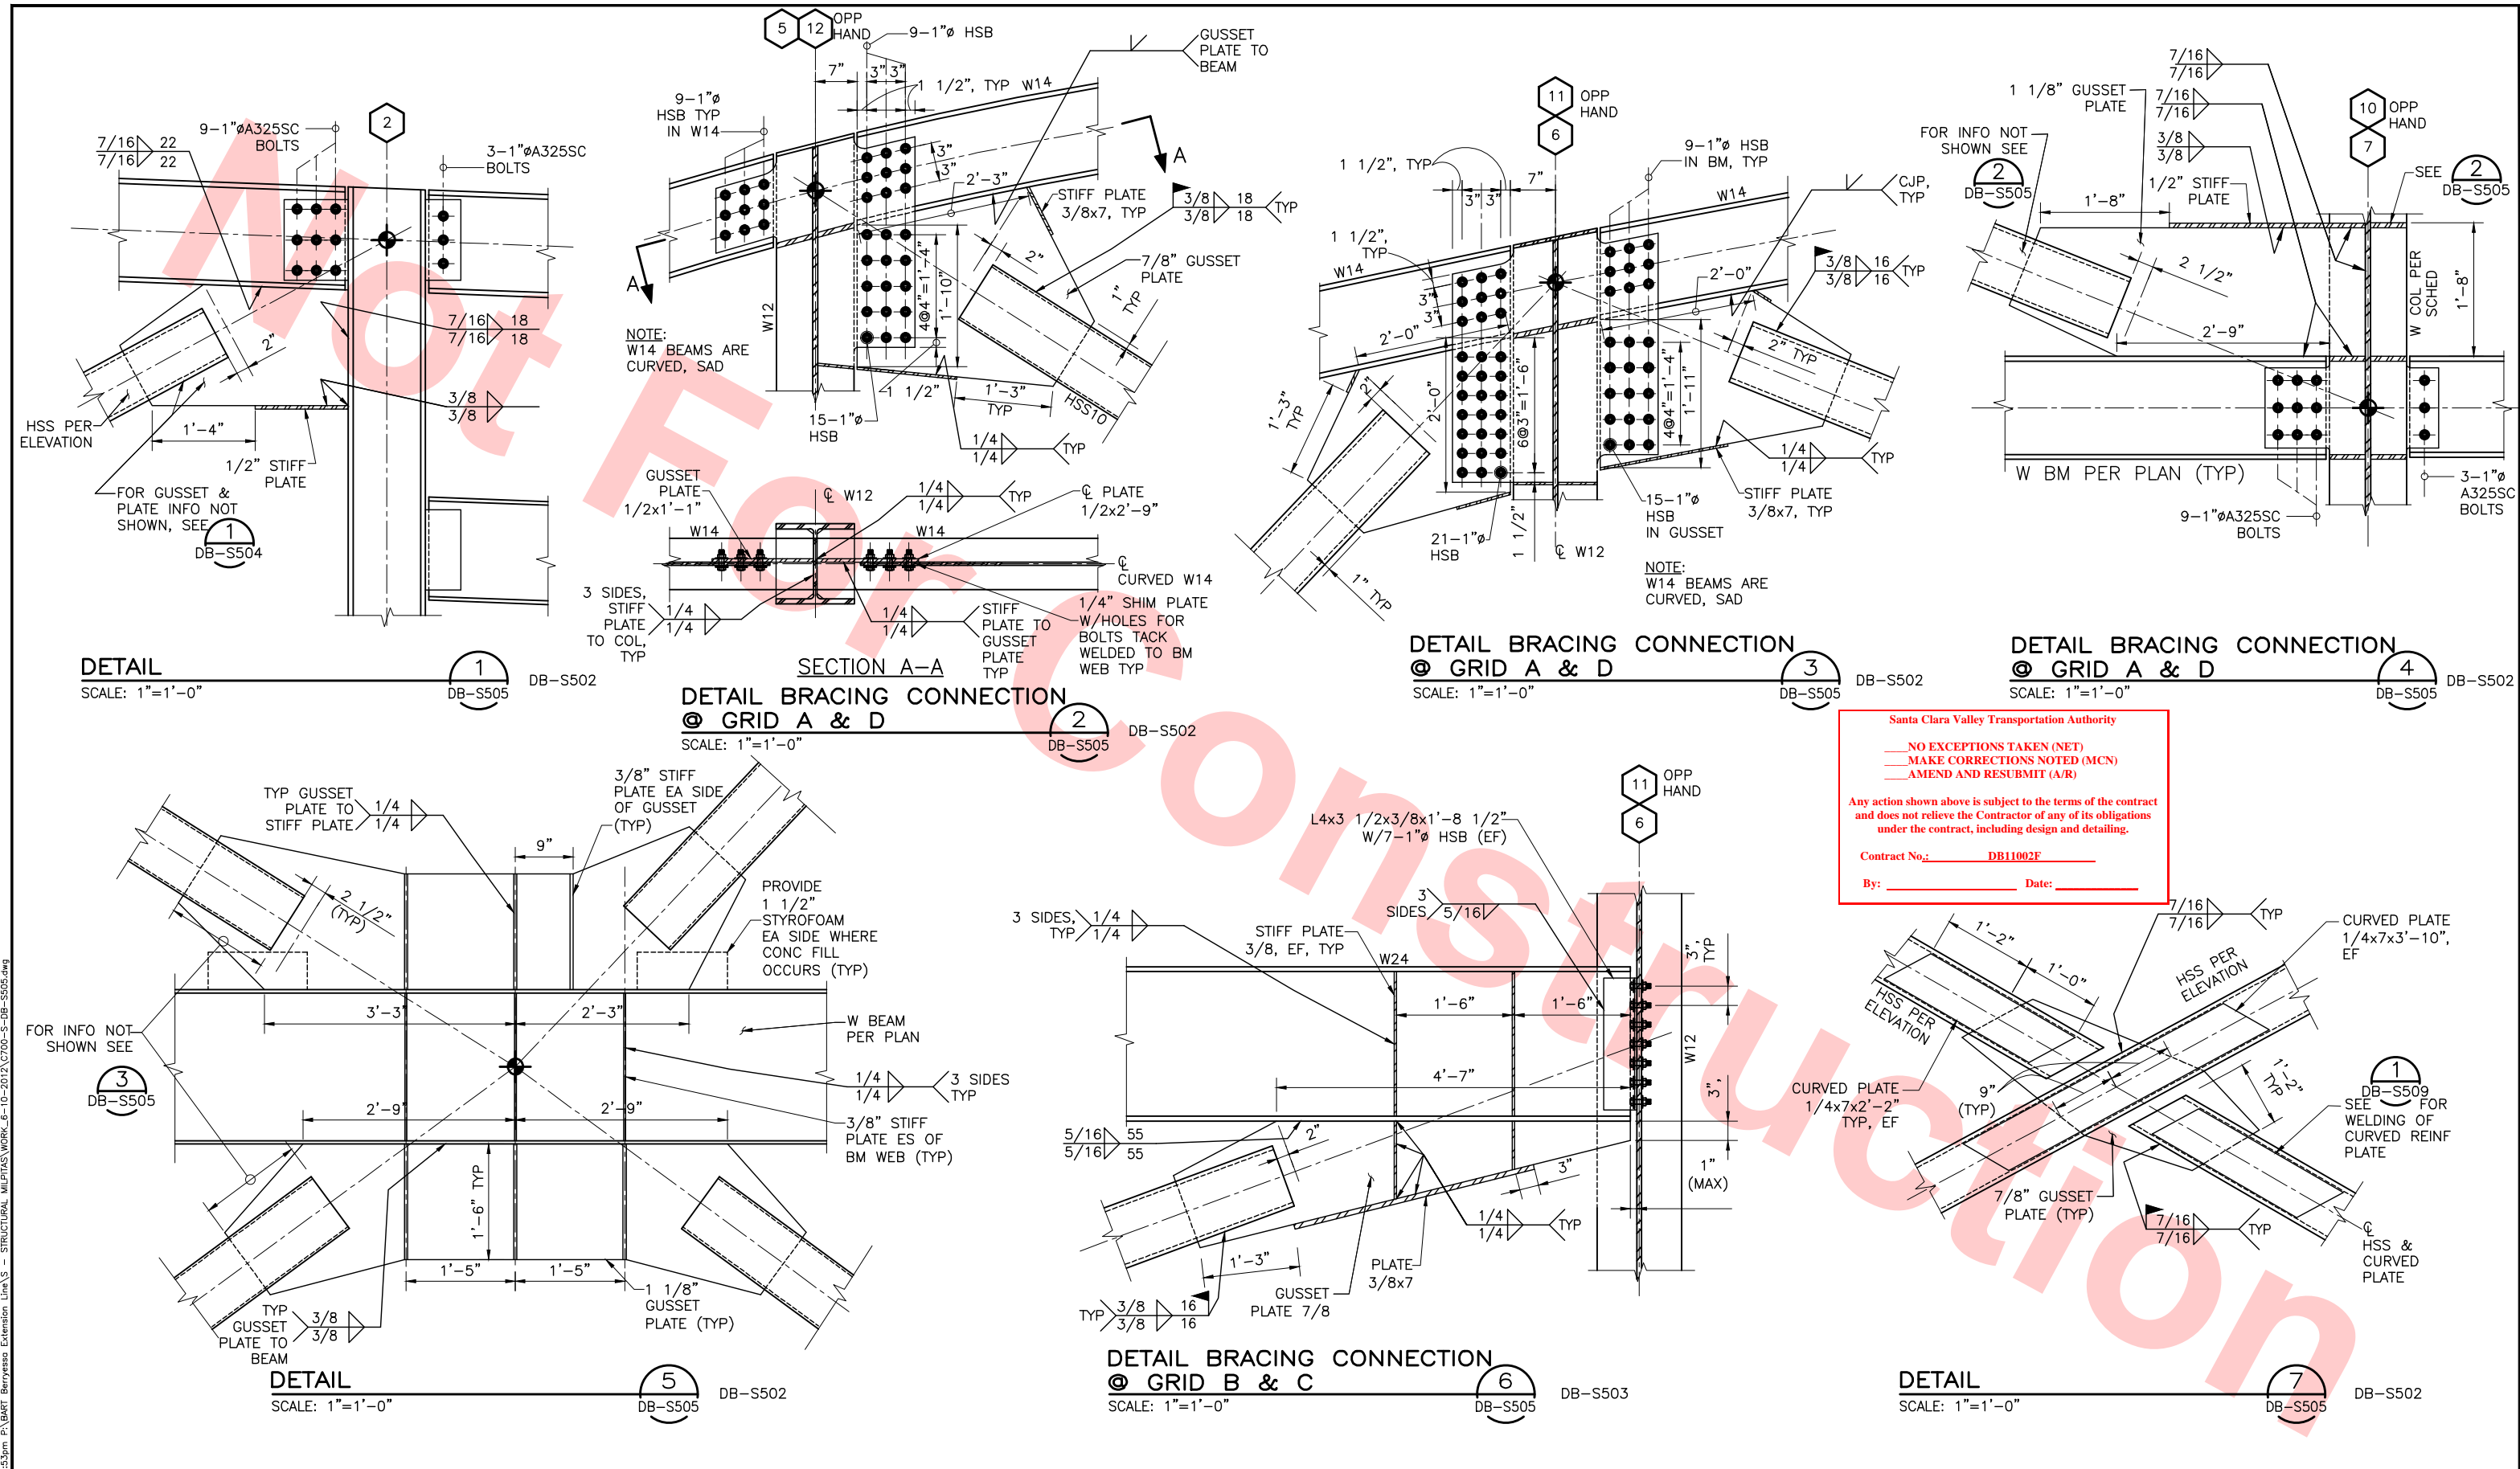

Santa Clara Valley Transportation Authority

NO EXCEPTIONS TAKEN (NET)  
MAKE CORRECTIONS NOTED (MCN)  
AMEND AND RESUBMIT (A/R)

Any action shown above is subject to the terms of the contract and does not relieve the Contractor of any of its obligations under the contract, including design and detailing.

Contract No.: DB11002F


By: \_\_\_\_\_ Date: \_\_\_\_\_





DESIGNED BY J. REBER, S.E.					DRAWN BY P. DIAZ					CHECKED BY M. TARAZI					IN CHARGE M. TARAZI					DATE 20130710				
0					20130710					READINESS FOR CONSTRUCTION					DESCRIPTION									
REV					DATE					BY					SUB					APP				

MFT CONSULTING ENGINEERS, INC. Anil Verma Associates, Inc. 1773 San Pablo Ave., Suite A3 (510) 222-4100 Pittsburg, CA 94564					Skanska Shimmick Herzog 1436 California Circle Milpitas, California 95035 A Joint Venture					Lodowood, Andrews & Newman, Inc. T-Y-LIN INTERNATIONAL 1773 San Pablo Ave., Suite A3 (510) 222-4100 Pittsburg, CA 94564				
SUBMITTED					APPROVED									

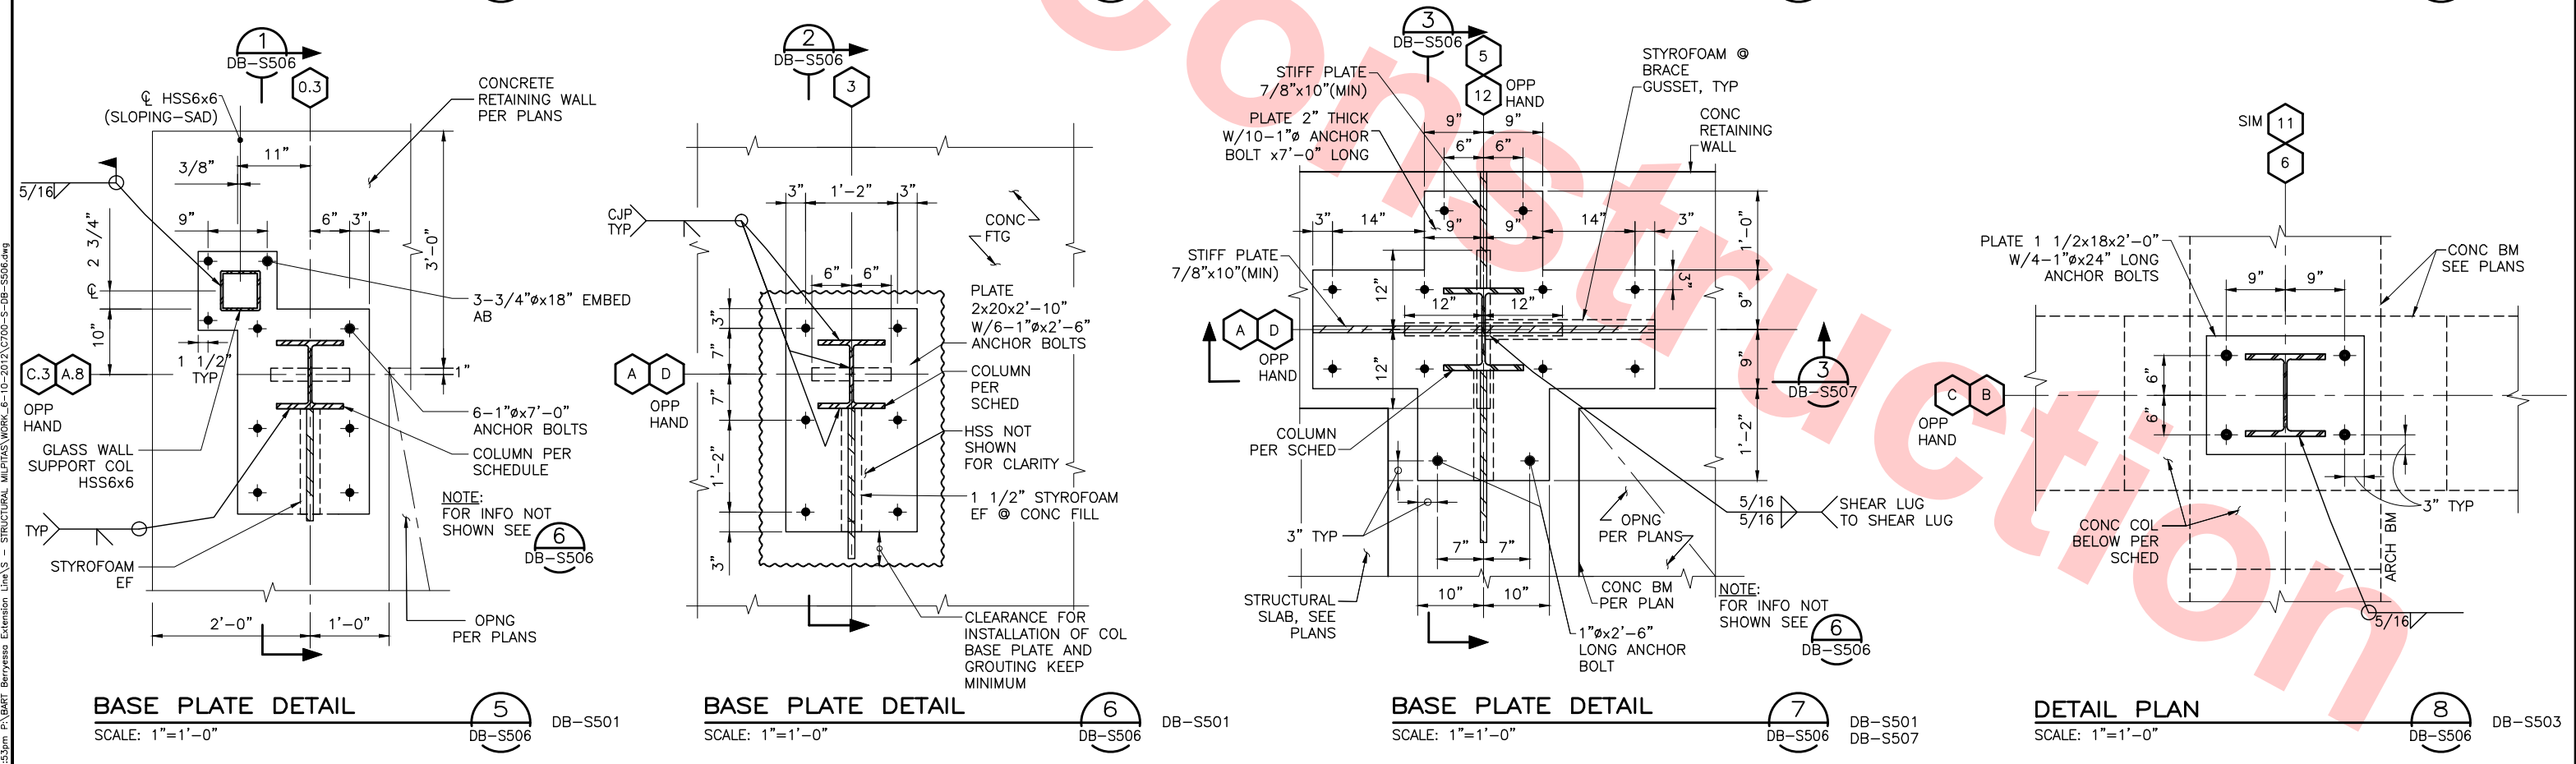BART SILICON VALLEY BERRYESSA EXTENSION					LINE, TRACK, STATIONS AND SYSTEMS DESIGN UNIT 023 MILPITAS STATION STEEL BRACED FRAME ELEVATIONS & DETAILS SHEET 5 OF 11					CADD FILENAME C700-S-DB-S505.dwg				
SIZE D					SCALE AS NOTED					CONTRACT NO. C700				
AREA CODE DB					SHEET NO. S505					PAGE NO. 0200				





					DESIGNED BY J. REBER, S.E. DRAWN BY P. DIAZ CHECKED BY M. TARAZI IN CHARGE M. TARAZI DATE 20130710				Skanska Shimmick Herzog 1436 California Circle Milpitas, California 95035 A Joint Venture				LINE, TRACK, STATIONS AND SYSTEMS DESIGN UNIT 023 MILPITAS STATION STEEL BRACED FRAME ELEVATIONS & DETAILS SHEET 6 OF 11		CADD FILENAME C700-S-DB-S506.dwg SIZE   SCALE D   1" = 1'-0" CONTRACT NO.   REV.   C700   0 AREA CODE   SHEET NO.   PAGE NO. DB   S506   0201			
0 20130710					READINESS FOR CONSTRUCTION				MFT CONSULTING ENGINEERS, Inc. Anil Verma Associates, Inc. 1773 San Pablo Ave., Suite A3 (510) 222-4100 Pinole, CA 94564 Fax (510) 222-4119		Lockwood, Andrews & Newnam, Inc. T-Y-LIN INTERNATIONAL A LEO A DALY COMPANY		BART SILICON VALLEY BERRYESSA EXTENSION					
REV DATE BY SUB APP					DESCRIPTION		SUBMITTED 		APPROVED 									




Santa Clara Valley Transportation Authority

NO EXCEPTIONS TAKEN (NET)  
MAKE CORRECTIONS NOTED (MCN)  
AMEND AND RESUBMIT (A/R)

Any action shown above is subject to the terms of the contract and does not relieve the Contractor of any of its obligations under the contract, including design and detailing.

Contract No.: DB11002F

By: \_\_\_\_\_ Date: \_\_\_\_\_

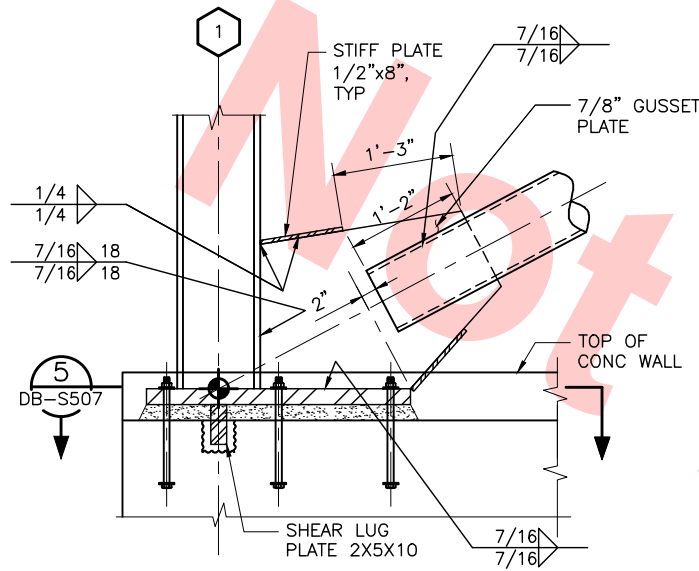


BRACE TO BASE PLATE

SCALE: 1"=1'-0"

1  
DB-S507

DB-S502

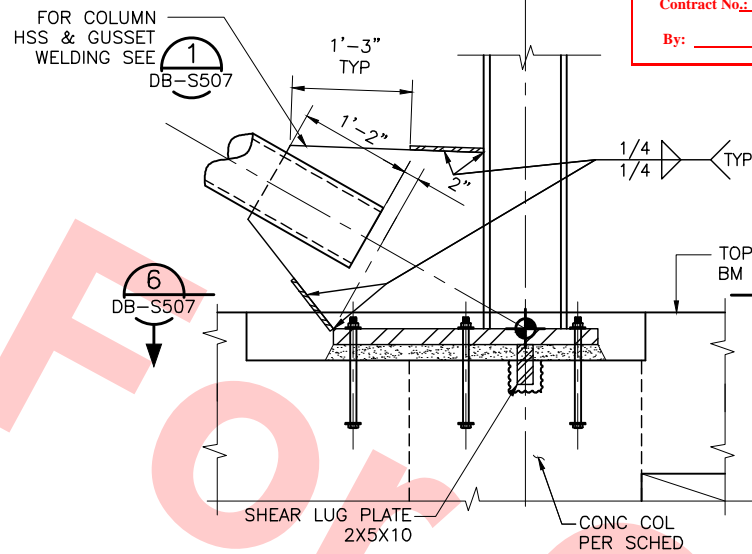


BRACE TO BASE PLATE

SCALE: 1"=1'-0"

2  
DB-S507

DB-S502

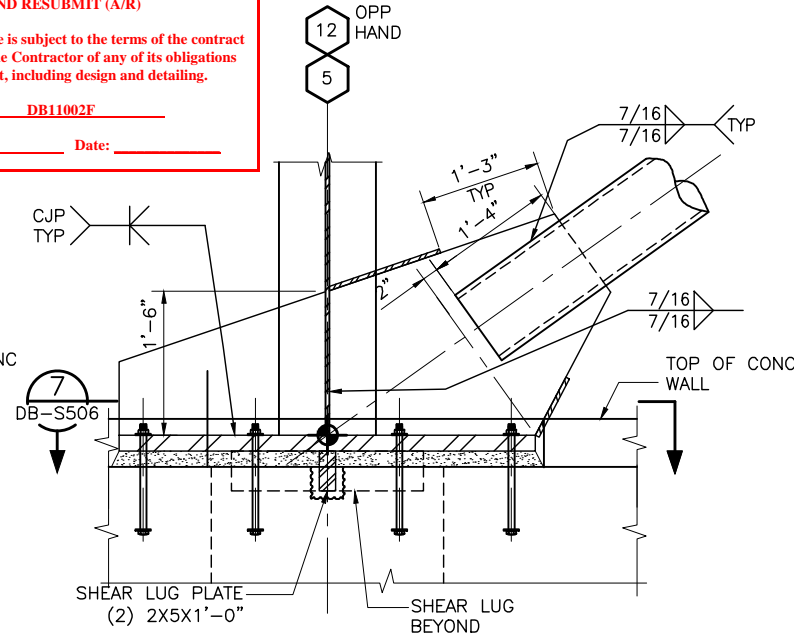


BRACE TO BASE PLATE

SCALE: 1"=1'-0"

3  
DB-S507

DB-S502  
DB-S506

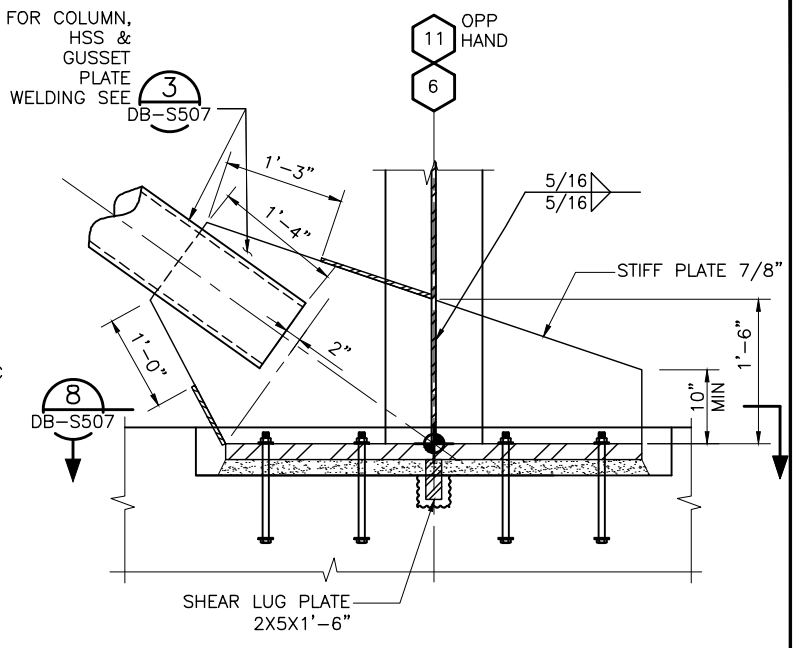


BRACE TO BASE PLATE

SCALE: 1"=1'-0"

4  
DB-S507

DB-S502

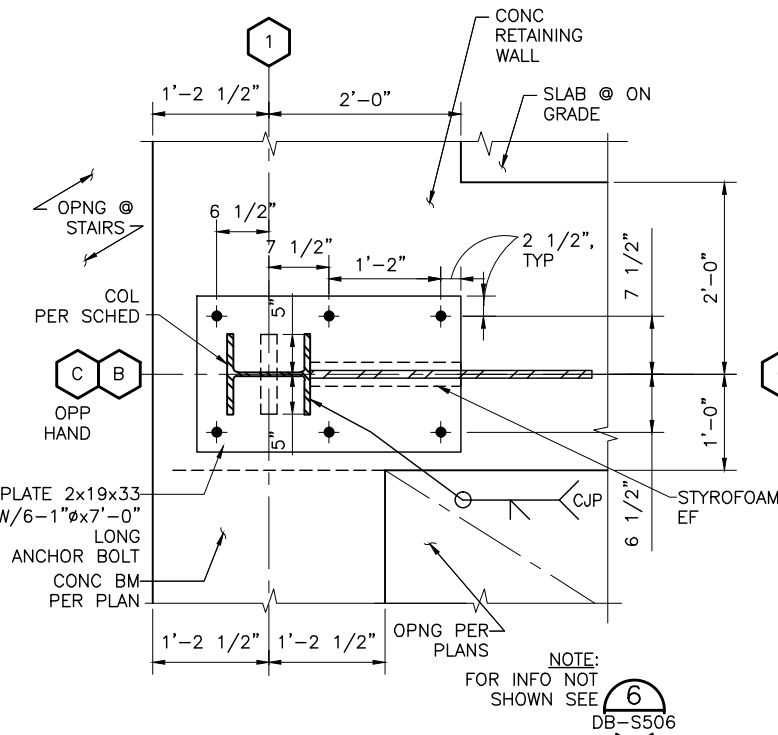


BRACE TO BASE PLATE

SCALE: 1"=1'-0"

5  
DB-S507

DB-S502

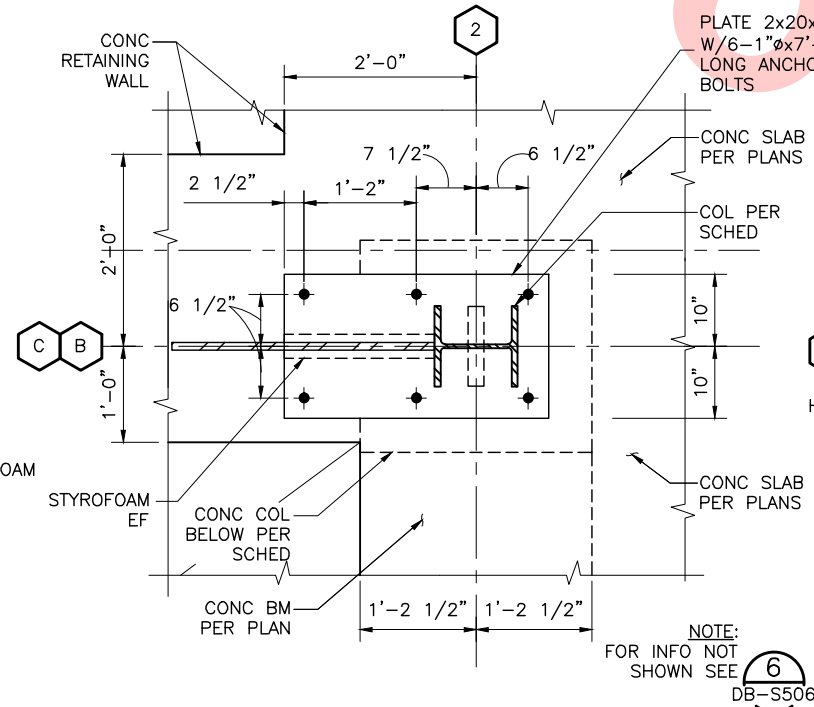


BRACE TO BASE PLATE

SCALE: 1"=1'-0"

6  
DB-S507

DB-S502

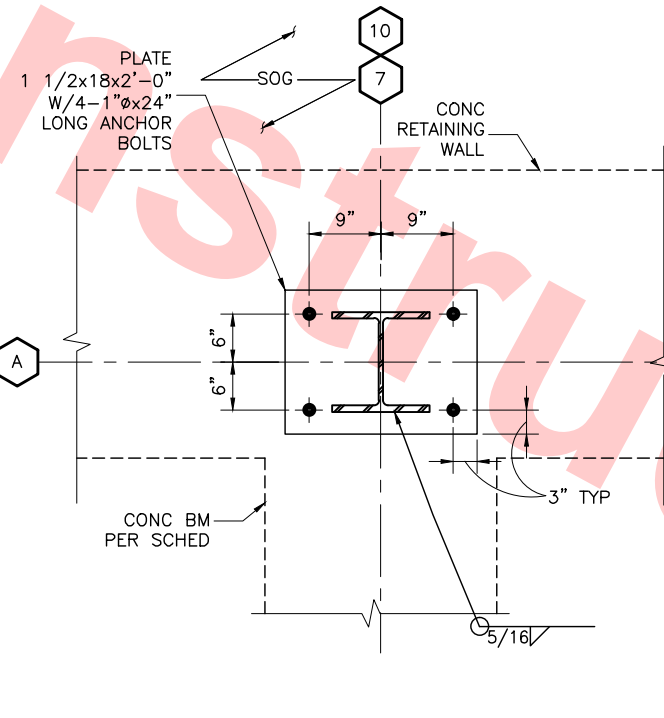


DETAIL PLAN

SCALE: 1"=1'-0"

7  
DB-S507

DB-S502

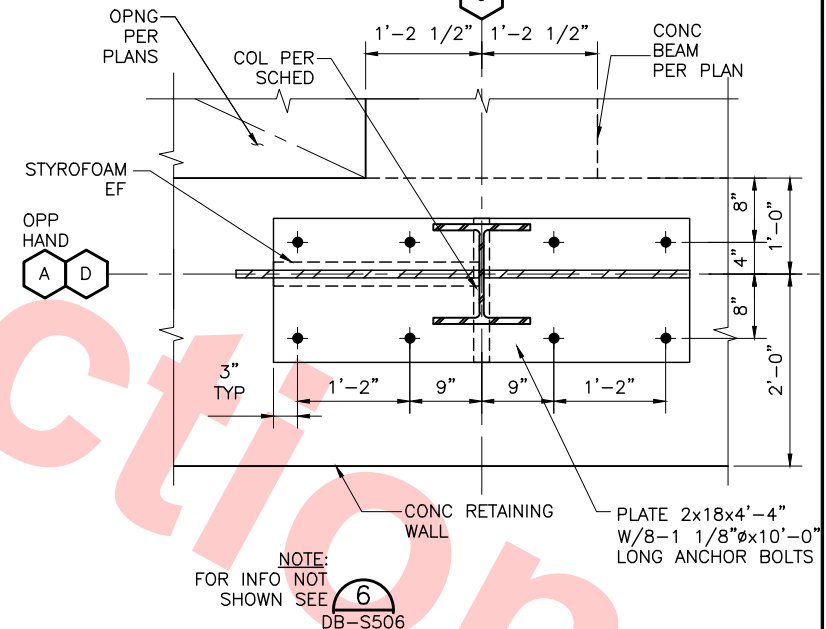

BRACE TO BASE PLATE


SCALE: 1"=1'-0"

8  
DB-S507

DB-S502

Jul 05, 2013 1:53pm P:\BART Berryessa Extension Line\AS - STRUCTURAL\MILPITAS WORK\6-10-2012\0700-S-DB-S507.dwg

DESIGNED BY	J. REBER, S.E.
DRAWN BY	P. DIAZ
CHECKED BY	M. TARAZI
IN CHARGE	M. TARAZI
DATE	20130710
REV	0
DATE	20130710
BY	
SUB	
APP	
DESCRIPTION	READINESS FOR CONSTRUCTION

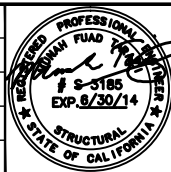

Skanska  
Shimmick  
Herzog

1436 California Circle  
Milpitas, California 95035  
A Joint Venture

MFT CONSULTING ENGINEERS, INC. Anil Verma Associates, Inc.  
1773 San Pablo Ave., Suite A3 (510) 222-4100  
Palo Alto, CA 94304 Fax (650) 222-8410





Lealwood, Andrews  
& Newman, Inc.  
A LEAD & BALLY COMPANY

T-Y-LIN INTERNATIONAL



LINE, TRACK, STATIONS AND SYSTEMS	CADD FILENAME
DESIGN UNIT 023	C700-S-DB-S507.dwg
MILPITAS STATION	SIZE SCALE
STEEL BRACED FRAME	D 1" = 1'-0"
ELEVATIONS & DETAILS	CONTRACT NO.
SHEET 7 OF 11	C700
	REV. 0
	AREA CODE
	DB
	SHEET NO.
	S507
	PAGE NO.
	0202




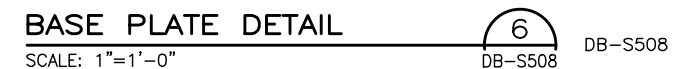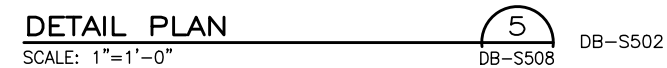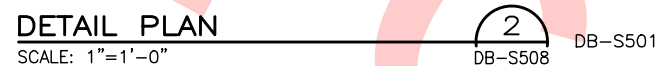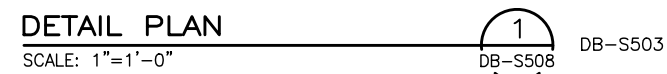

CADD FILENAME C700-S-DB-S508.dwg		
SIZE D	SCALE 1" = 1'-0"	
CONTRACT NO. C700		REV. 0
AREA CODE DB	SHEET NO. S508	PAGE NO. 0203




04-02 Jul 05, 2013 1:53pm P:\BART Berryessa Extension Line\5 - STRUCTURAL MILPITAS WORK\_6-10-2012\CT00-S-DB-S509.dwg

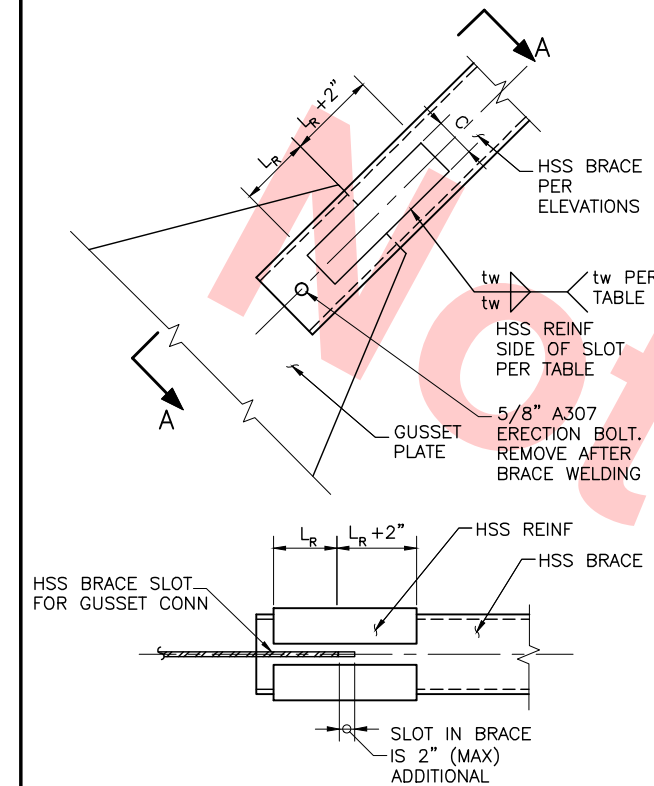

SECTION A-A

BRACE SIZE	L <sub>R</sub>	C	tw	REINF SIZE
HSS 10.00x0.375	14	8	3/16	CURVED PLATE 1/4
HSS 8.625x0.375	12	7	3/16	CURVED PLATE 1/4
HSS 7.50x0.375	10	6	3/16	CURVED PLATE 1/4
HSS 6.00x0.280	8	4.5	3/16	CURVED PLATE 1/4

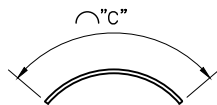


BRACE REINFORCEMENT  
DETAIL

SCALE: 1"=1'-0"

1  
DB-S509

DB-S505

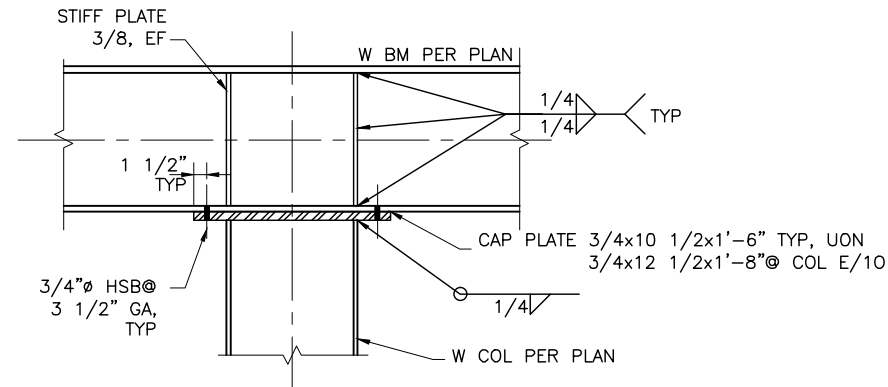

CONT BEAM OVER COLUMN

SCALE: 1"=1'-0"

2  
DB-S509

DB-S501  
DB-S731  
DB-S510

Santa Clara Valley Transportation Authority

\_\_\_ NO EXCEPTIONS TAKEN (NET)  
\_\_\_ MAKE CORRECTIONS NOTED (MCN)  
\_\_\_ AMEND AND RESUBMIT (A/R)


Any action shown above is subject to the terms of the contract  
and does not relieve the Contractor of any of its obligations  
under the contract, including design and detailing.

Contract No.: DB11002F

By: \_\_\_\_\_ Date: \_\_\_\_\_

REV	DATE	BY	SUB	APP	DESCRIPTION
0	20130710				READINESS FOR CONSTRUCTION

DESIGNED BY  
J. REBER, S.E.  
DRAWN BY  
P. DIAZ  
CHECKED BY  
M. TARAZI  
IN CHARGE  
M. TARAZI  
DATE  
20130710

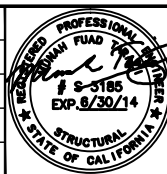

Skanska  
Shimmick  
Herzog  
1436 California Circle  
Milpitas, California 95035  
A Joint Venture  
MFT CONSULTING ENGINEERS, INC. Anil Verma Associates, Inc.  
1773 San Pablo Ave., Suite A3 (510) 222-4100  
Palo Alto, CA 94304 Fax (650) 222-8410

Lealwood, Andrews  
& Newman, Inc.  
T-Y-LIN INTERNATIONAL  
APPROVED  
BART SILICON VALLEY BERRYESSA EXTENSION




LINE, TRACK, STATIONS AND SYSTEMS  
DESIGN UNIT 023  
MILPITAS STATION  
STEEL BRACED FRAME  
ELEVATIONS & DETAILS  
SHEET 9 OF 11

CADD FILENAME C700-S-DB-S509.dwg	CONTRACT NO. C700	REV. 0
AREA CODE DB	SHEET NO. S509	PAGE NO. 0204



Jul 05, 2013 - 1:53pm P:\BART Berryessa Extension Line\AS - STRUCTURAL MILPITAS WORK\_E-10-2012\0700-S-DB-S510.dwg  
c04-02

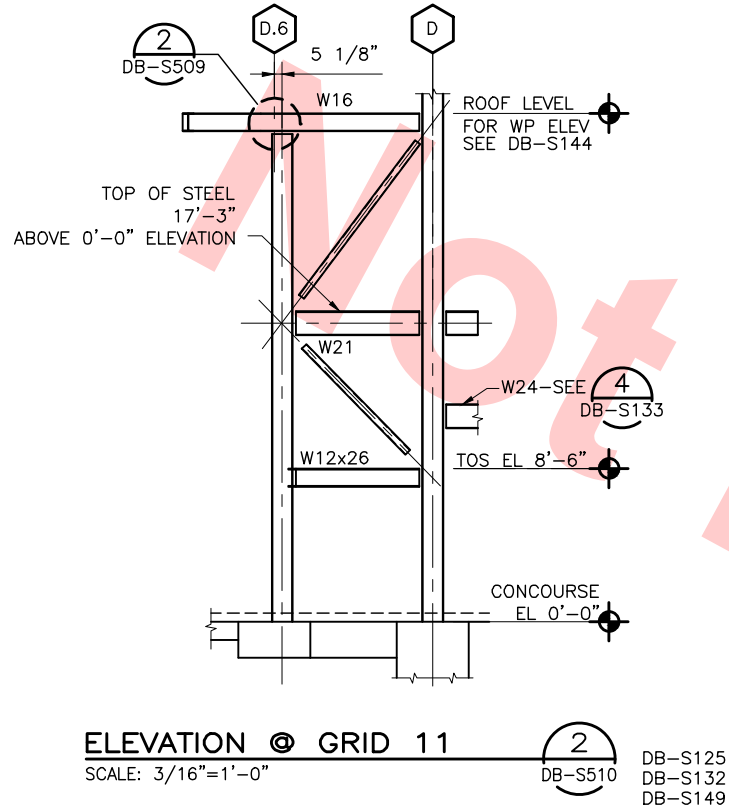

Santa Clara Valley Transportation Authority

NO EXCEPTIONS TAKEN (NET)





MAKE CORRECTIONS NOTED (MCN)

AMEND AND RESUBMIT (A/R)

Any action shown above is subject to the terms of the contract and does not relieve the Contractor of any of its obligations under the contract, including design and detailing.


Contract No.: DB11002F

By: Date:

					DESIGNED BY J. REBER, S.E.		<div>Skanska Shimmick Herzog</div> <div>1436 California Circle Milpitas, California 95035 A Joint Venture</div>		 <div>BART SILICON VALLEY BERRYESSA EXTENSION</div>	<div>LINE, TRACK, STATIONS AND SYSTEMS</div> <div>DESIGN UNIT 023</div> <div>MILPITAS STATION</div> <div>STEEL BRACED FRAME</div> <div>ELEVATIONS &amp; DETAILS</div> <div>SHEET 10 OF 11</div>	CADD FILENAME C700-S-DB-S510.dwg			
					DRAWN BY P. DIAZ						SIZE D	SCALE AS NOTED	CONTRACT NO. C700	REV. 0
					CHECKED BY M. TARAZI						AREA CODE DB	SHEET NO. S510	PAGE NO. 0205	
					IN CHARGE M. TARAZI									
0	20130710				DATE 20130710		SUBMITTED 		APPROVED 					
REV	DATE	BY	SUB	APP	DESCRIPTION									



Jul 05, 2013 1:54pm P:\BART Berryessa Extension Line\AS - STRUCTURAL MILPITAS WORK\6-10-2012\C700-S-DB-S511.dwg  
c6d-02

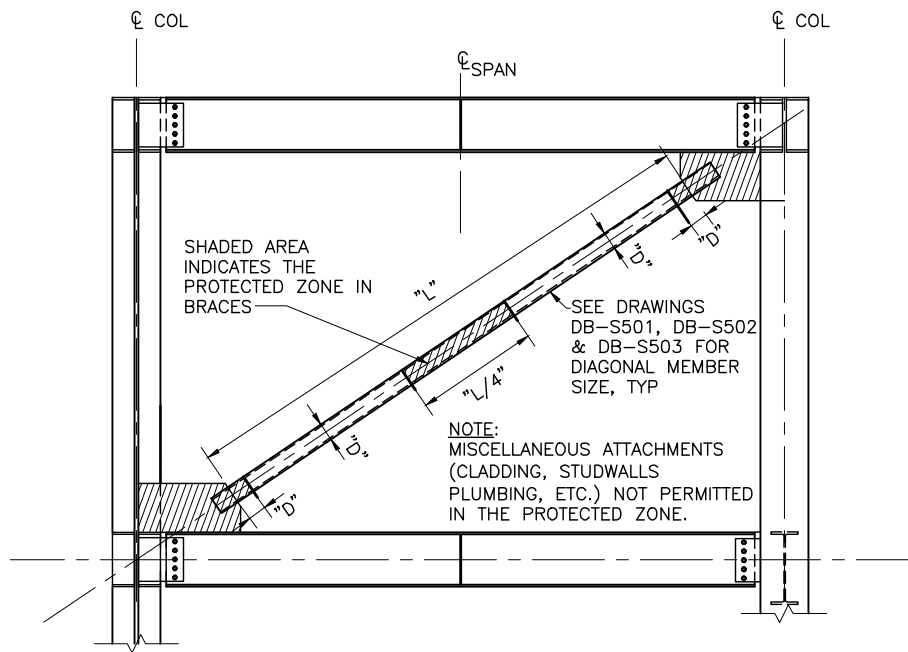

PROTECTED ZONE IN BRACES

5 DB-S501

DB-S511

SCALE: 1"=1'-0"

Santa Clara Valley Transportation Authority

☐ NO EXCEPTIONS TAKEN (NET)  
☐ MAKE CORRECTIONS NOTED (MCN)  
☐ AMEND AND RESUBMIT (A/R)

Any action shown above is subject to the terms of the contract and does not relieve the Contractor of any of its obligations under the contract, including design and detailing.

Contract No.: DB11002F

By: \_\_\_\_\_ Date: \_\_\_\_\_

REV	DATE	BY	SUB	APP	DESCRIPTION
0	20130710				READINESS FOR CONSTRUCTION

DESIGNED BY  
J. REBER, S.E.

DRAWN BY  
P. DIAZ

CHECKED BY  
M. TARAZI

IN CHARGE  
M. TARAZI

DATE  
20130710



Skanska  
Shimmick  
Herzog

1436 California Circle  
Milpitas, California 95035  
A Joint Venture

MFT CONSULTING ENGINEERS, Inc. Anil Verma Associates, Inc.

1773 San Pablo Ave., Suite A3 (510) 222-4168  
Pinole, CA 94664 Fax (510) 222-8410

Lealwood, Andrews & Newman, Inc.

T-Y-LIN INTERNATIONAL


SUBMITTED *[Signature]* APPROVED *[Signature]*



LINE, TRACK, STATIONS AND SYSTEMS				CADD FILENAME C700-S-DB-S511.dwg	
DESIGN UNIT 023		MILPITAS STATION		SIZE D	SCALE AS NOTED
STEEL BRACED FRAME		ELEVATIONS & DETAILS		CONTRACT NO. C700	REV. 0
SHEET 11 OF 11		AREA CODE DB	SHEET NO. S511	PAGE NO. 0206	



04-02 Jul 05, 2013 1:54pm P:\BART Berryessa Extension Line\1S - STRUCTURAL MILPITAS WORK\6-10-2012\0700-S-DB-S520.dwg

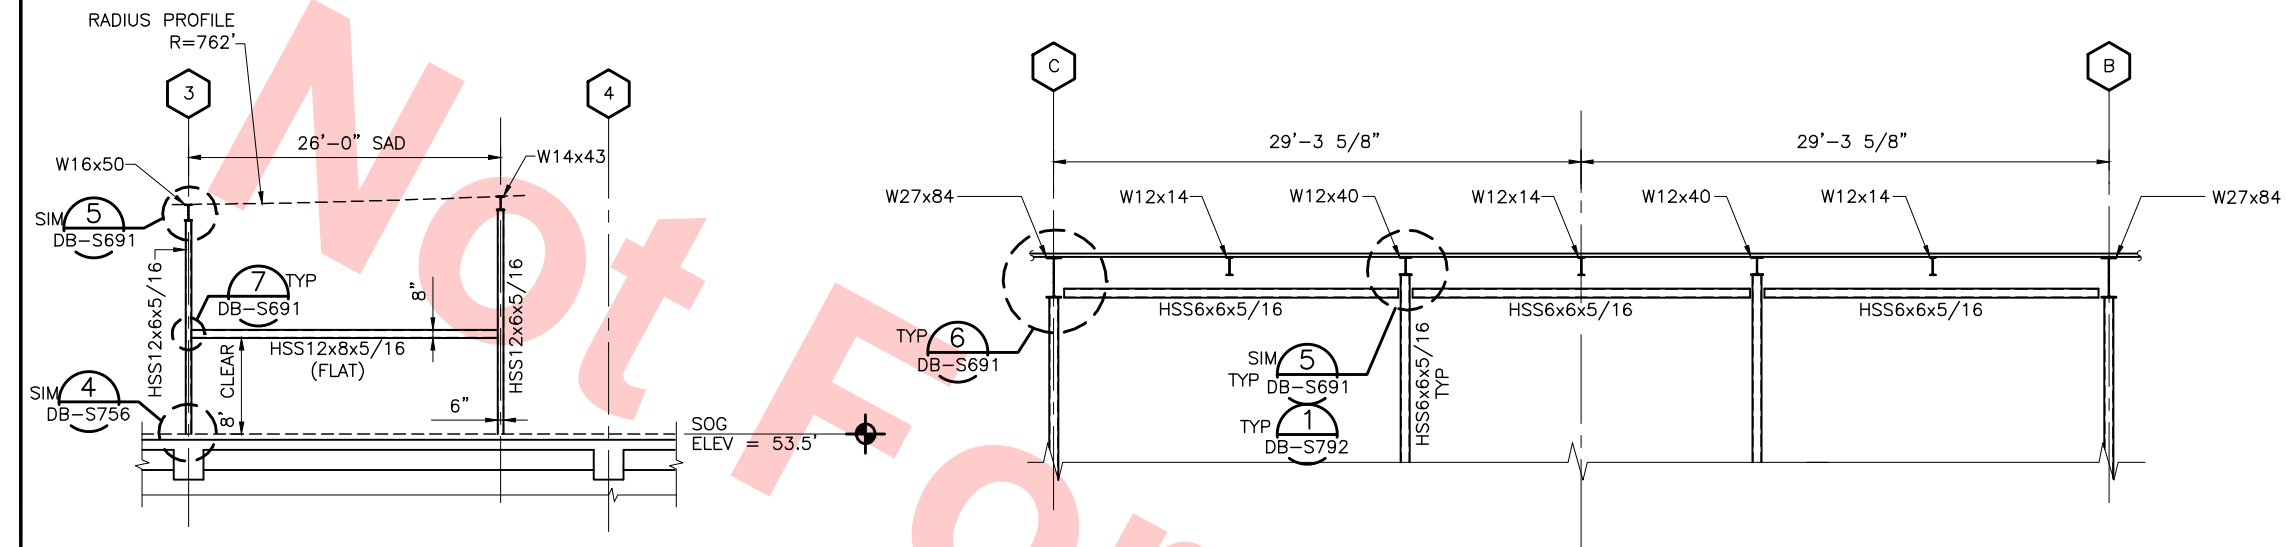

STEEL FRAME  
ELEVATION @ SMOKE VENT  
ROOM #1 & #2

SCALE: 1/8"=1'-0"

1 DB-S121  
DB-S520

STEEL FRAME ELEVATION

SCALE: 3/16"=1'-0"

2 DB-S146  
DB-S520

Santa Clara Valley Transportation Authority


- ☐ NO EXCEPTIONS TAKEN (NET)  
☐ MAKE CORRECTIONS NOTED (MCN)  
☐ AMEND AND RESUBMIT (A/R)

Any action shown above is subject to the terms of the contract and does not relieve the Contractor of any of its obligations under the contract, including design and detailing.

Contract No.: DB11002F

By: \_\_\_\_\_ Date: \_\_\_\_\_

DESIGNED BY J. REBER, S.E.	
DRAWN BY P. DIAZ	
CHECKED BY M. TARAZI	
IN CHARGE M. TARAZI	
DATE 20130710	
REV	DATE
BY	SUB
APP	DESCRIPTION
0	20130710
	READINESS FOR CONSTRUCTION

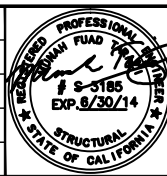

Skanska  
Shimmick  
Herzog

1436 California Circle  
Milpitas, California 95035  
A Joint Venture

MFT CONSULTING ENGINEERS, Inc. Anil Verma Associates, Inc.  
1773 San Pablo Ave., Suite A3 (510) 222-4100  
Palo Alto, CA 94304 Fax (650) 222-8410

Lealwood, Andrews & Newman, Inc. T-Y-LIN INTERNATIONAL  
A LEA A BALLY COMPANY


SUBMITTED *[Signature]* APPROVED *[Signature]*




LINE, TRACK, STATIONS AND SYSTEMS  
DESIGN UNIT 023  
MILPITAS STATION  
MISCELLANEOUS STEEL FRAME  
AND DETAILS  
SHEET 1 OF 1

CADD FILENAME C700-S-DB-S520.dwg	
SIZE D	SCALE AS NOTED
CONTRACT NO. C700	REV. 0
AREA CODE DB	SHEET NO. S520
	PAGE NO. 0207



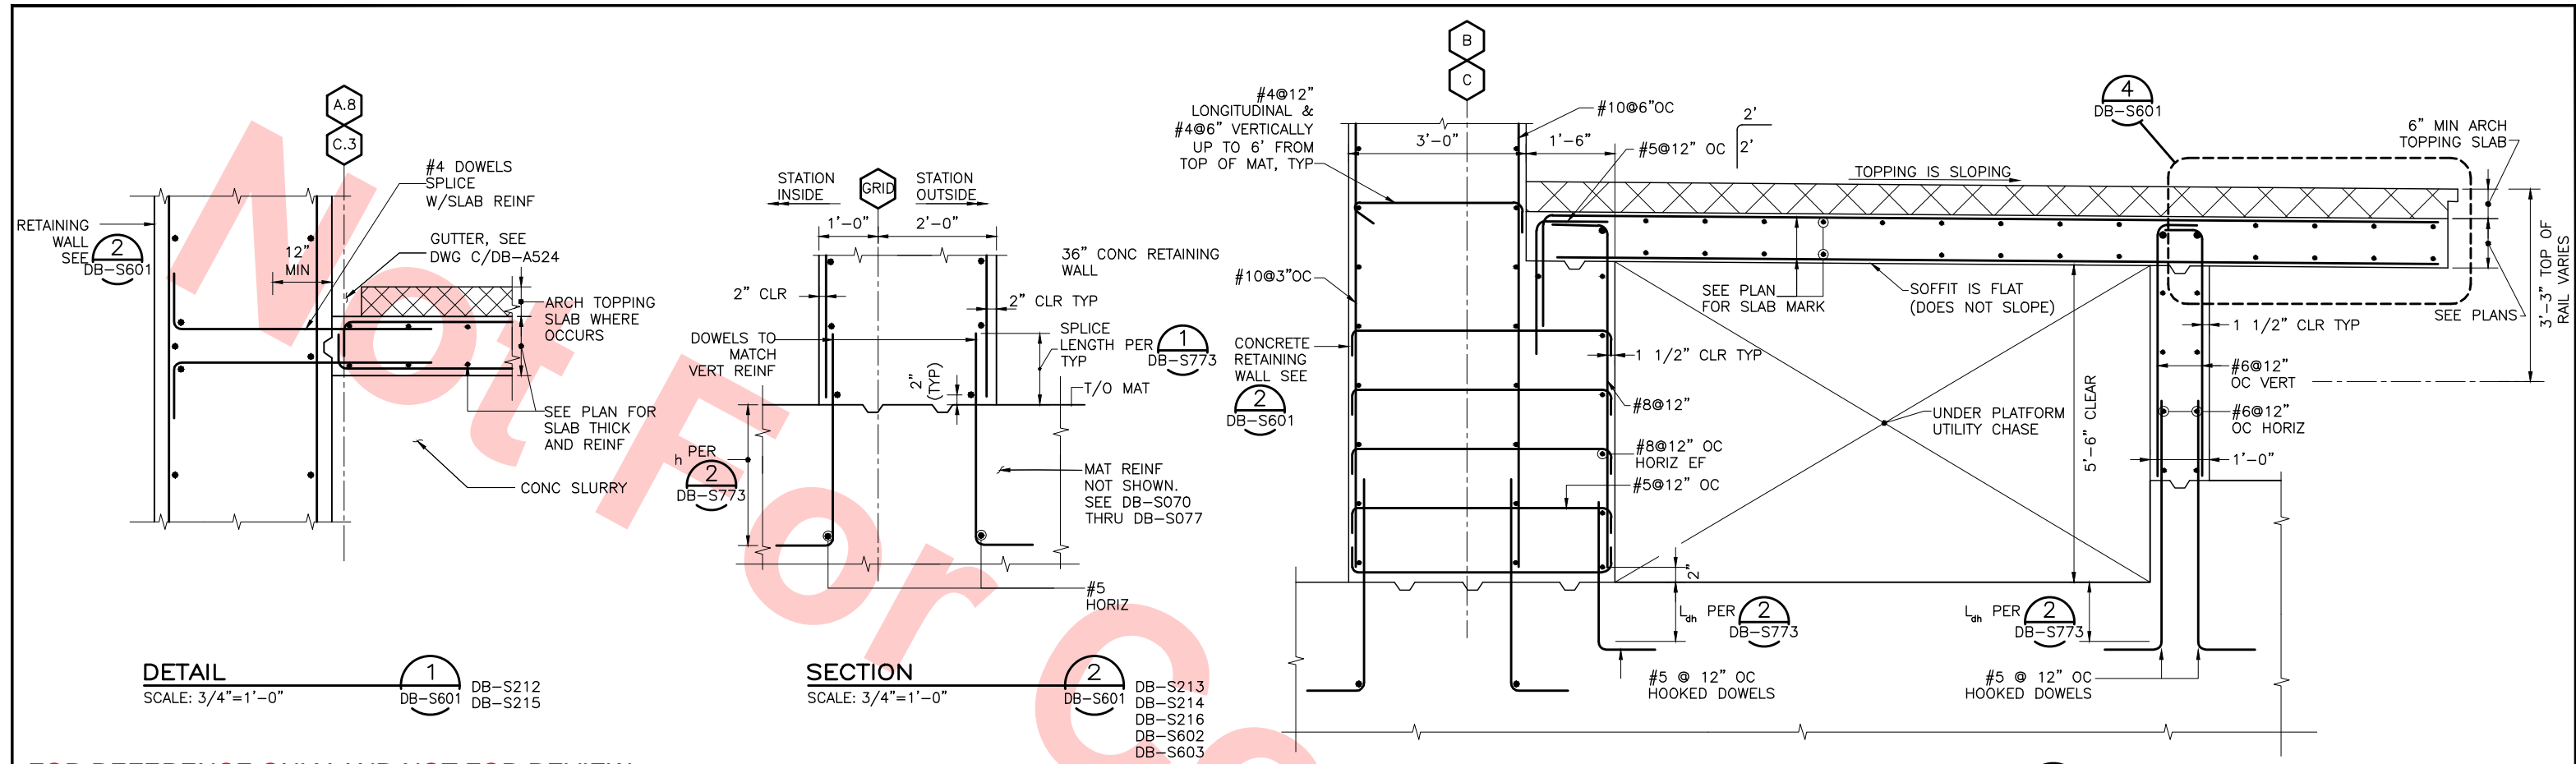

FOR REFERENCE ONLY AND NOT FOR REVIEW.  
THIS DRAWING WAS SUBMITTED UNDER  
DU-23-WP08 TRENCH PACKAGE

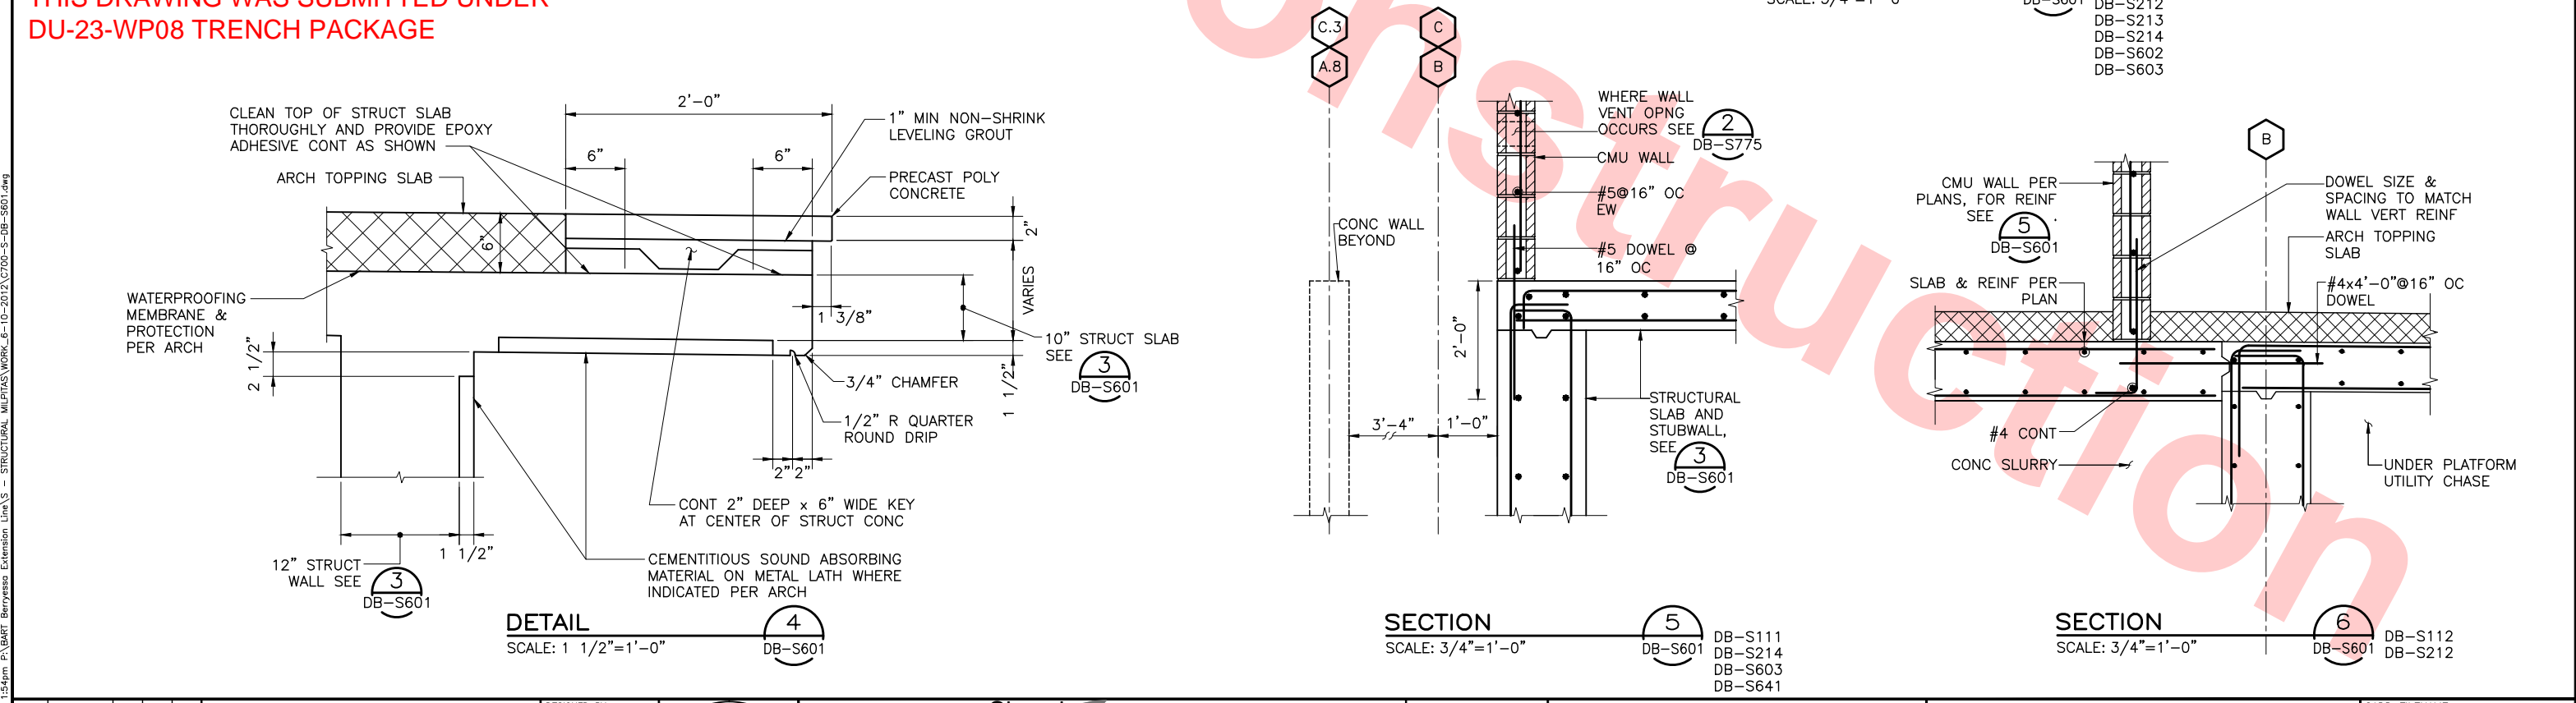





0 20130531 REV DATE BY SUB APP					DESIGNED BY J. REBER, S.E. DRAWN BY P. DIAZ CHECKED BY M. TARAZI IN CHARGE M. TARAZI DATE 20130531		READINESS FOR CONSTRUCTION DESCRIPTION		SUBMITTED APPROVED		1436 California Circle Milpitas, California 95035 A Joint Venture MFT CONSULTING ENGINEERS, INC. Anil Verma Associates, Inc. 1773 San Pablo Ave., Suite A3 (510) 222-4166 Pinole, CA 94964 Fax (916) 222-6419 Skanska Shimmick Herzog Lodiwood, Andrews & Newman, Inc. A LEO A DALY COMPANY T-Y-LIN INTERNATIONAL		BART SILICON VALLEY BERRYESSA EXTENSION		LINE, TRACK, STATIONS AND SYSTEMS DESIGN UNIT 023 MILPITAS STATION MAT AND PLATFORM FRAMING SECTIONS AND DETAILS SHEET 1 OF 4		CADD FILENAME C700-S-DB-S601.dwg SIZE SCALE D AS NOTED CONTRACT NO. C700 REV. 0 AREA CODE SHEET NO. DB S601 PAGE NO. 0208	
-----------------------------------	--	--	--	--	---	--	---	--	-----------------------	--	---	--	---	--	--	--	--	--





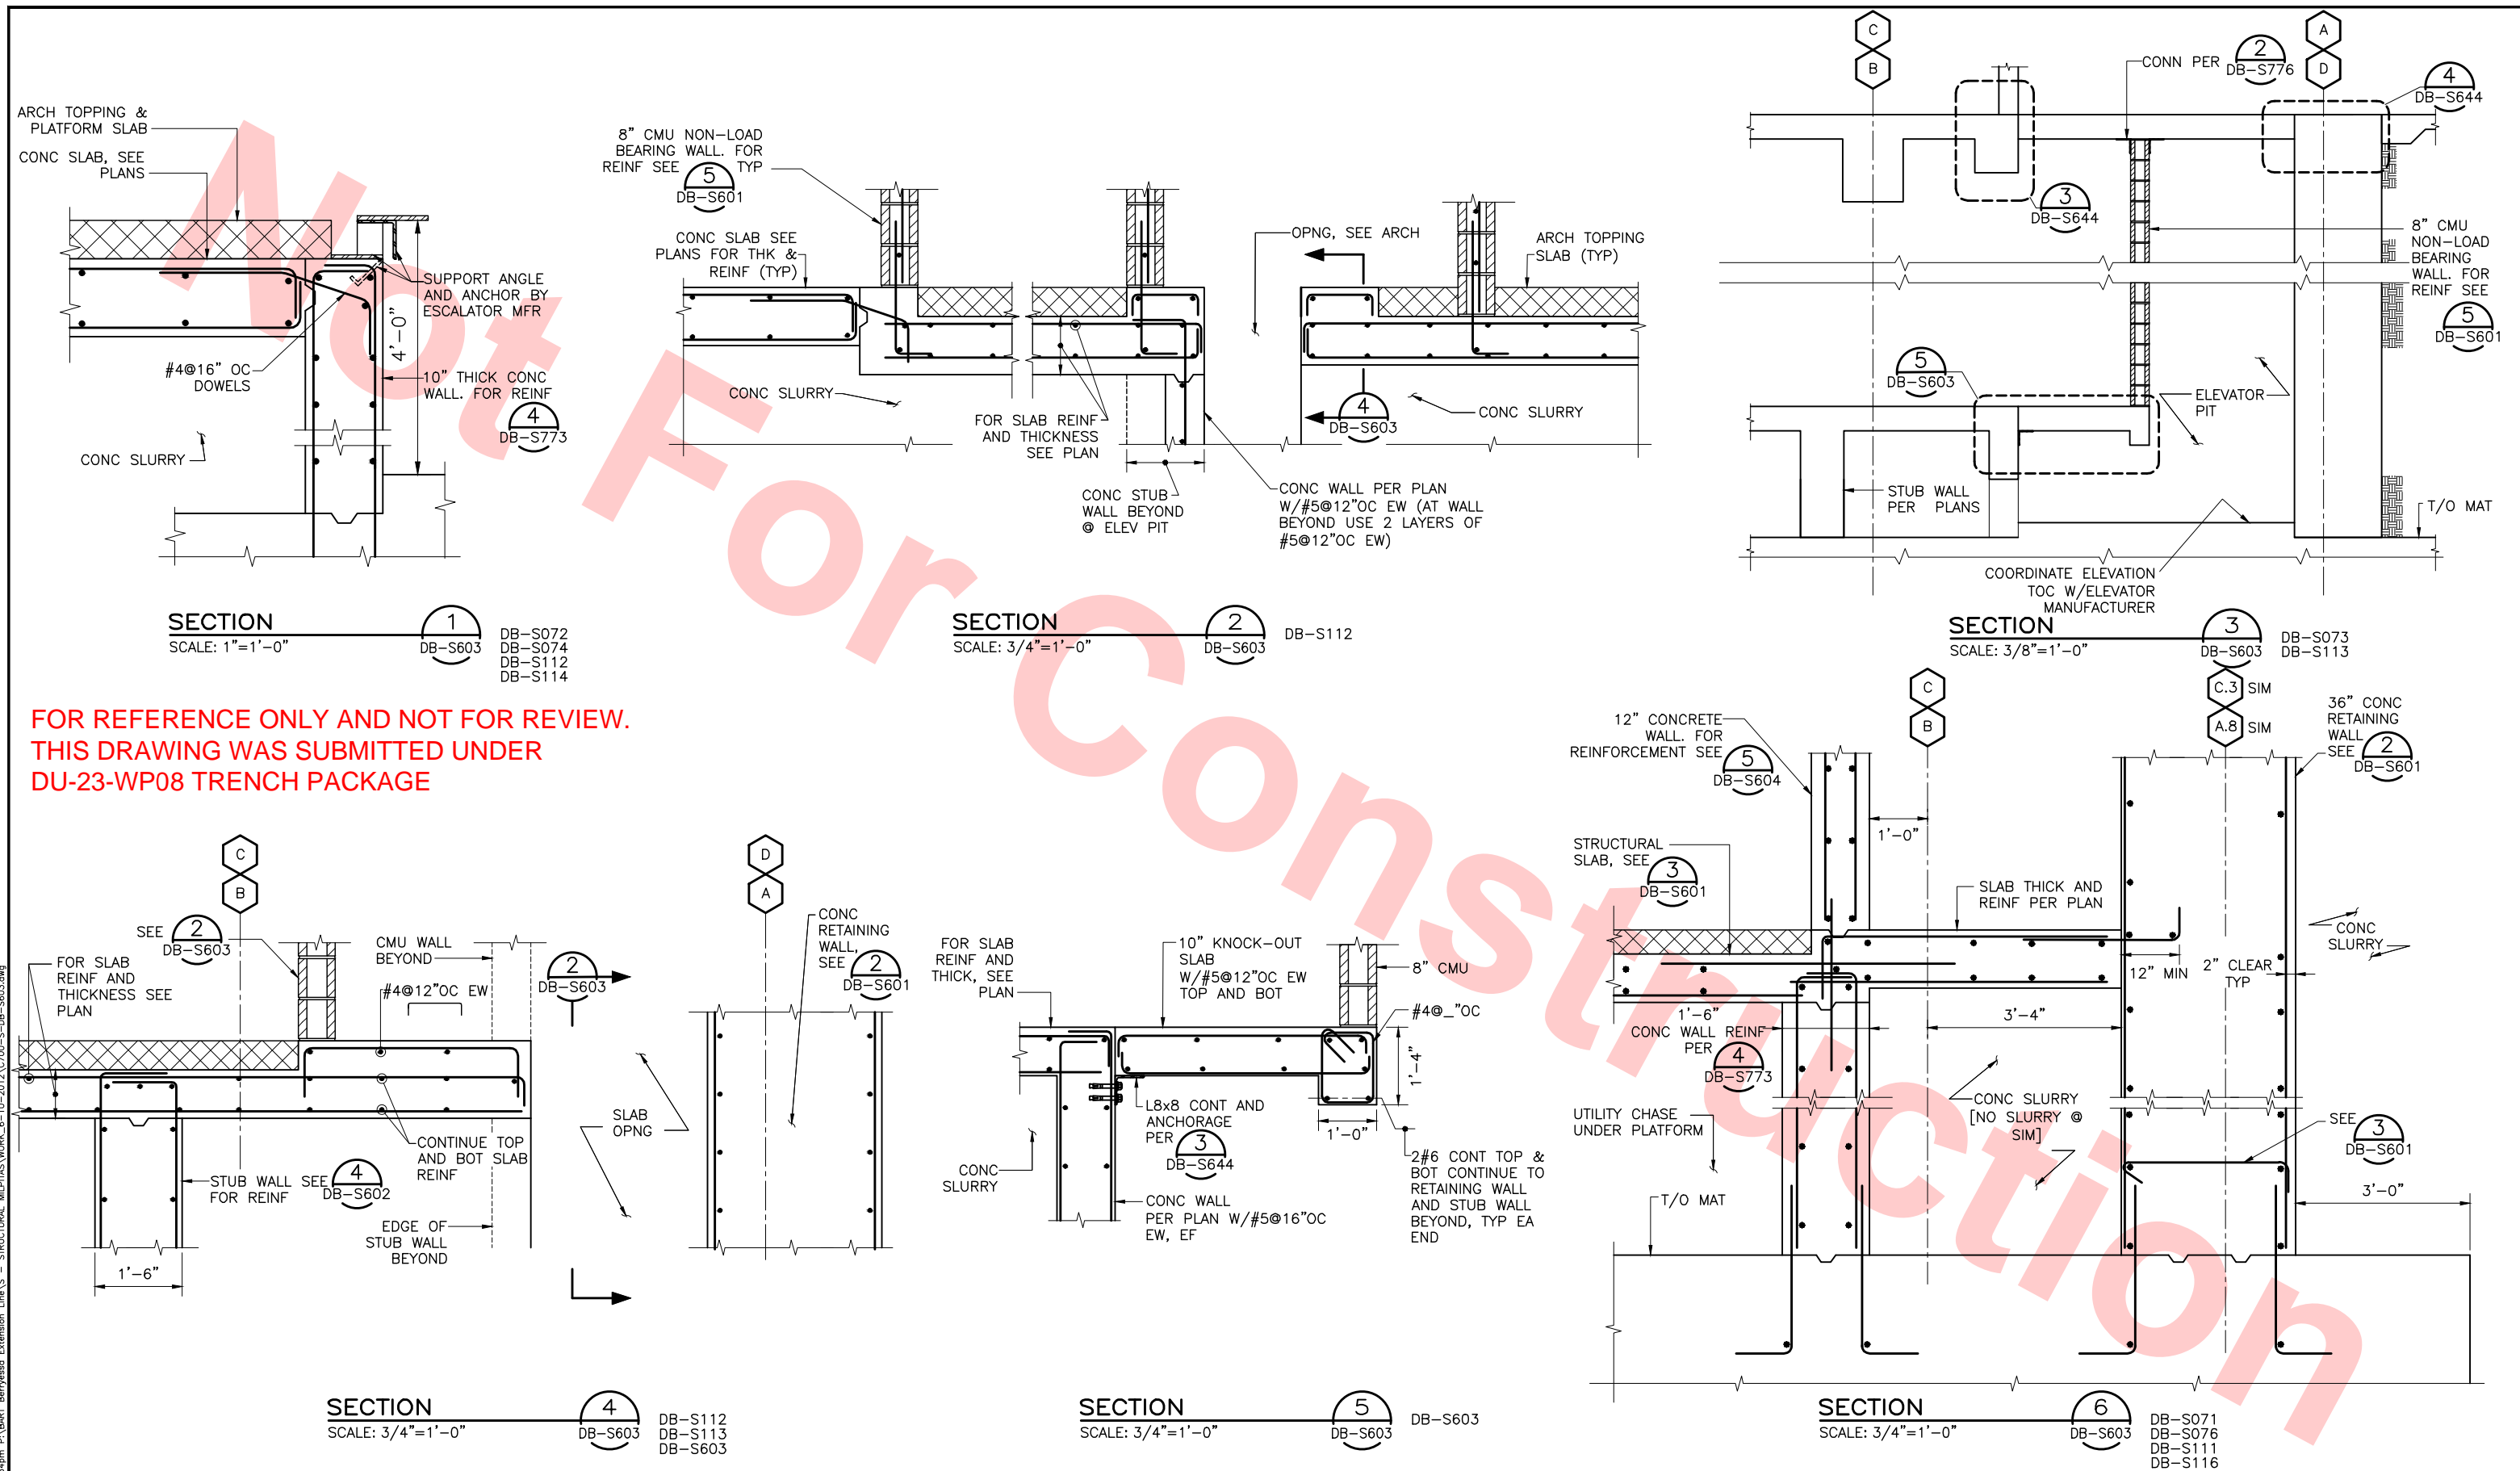





						DESIGNED BY J. REBER, S.E.			1436 California Circle Milpitas, California 95035 A Joint Venture		LINE, TRACK, STATIONS AND SYSTEMS DESIGN UNIT 023 MILPITAS STATION MAT AND PLATFORM FRAMING SECTIONS AND DETAILS SHEET 3 OF 4	CADD FILENAME C700-S-DB-S603.dwg
					DRAWN BY P. DIAZ	SIZE D SCALE AS NOTED						CONTRACT NO. C700 REV. 0
					CHECKED BY M. TARAZI	AREA CODE DB SHEET NO. S603 PAGE NO. 0210						
					IN CHARGE M. TARAZI							
0	20130531				READINESS FOR CONSTRUCTION	DATE 20130531						
REV	DATE	BY	SUB	APP	DESCRIPTION							




Jul 05, 2013 1:54pm P:\BART Berryessa Extension Line\AS - STRUCTURAL MILPITAS WORK\6-10-2012\0700-S-DB-S604.dwg

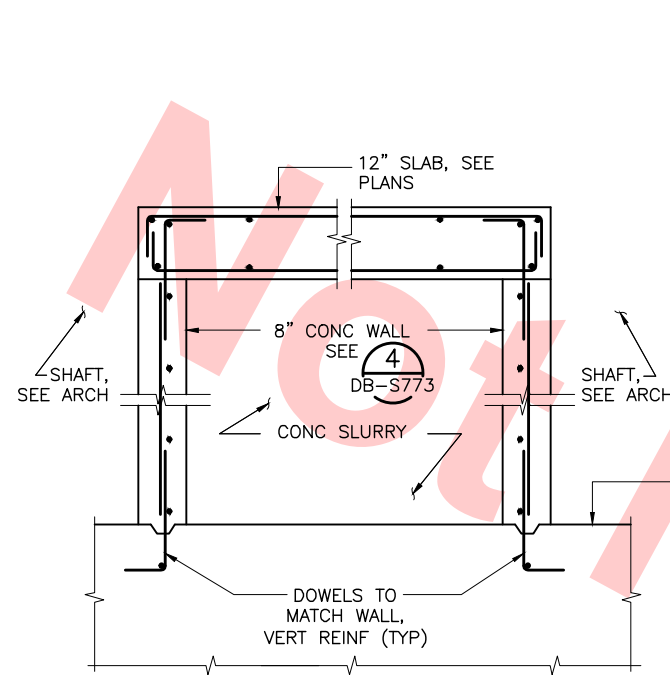


DETAIL 1  
SCALE: 3/4"=1'-0"  
DB-S604 DB-S071 DB-S111

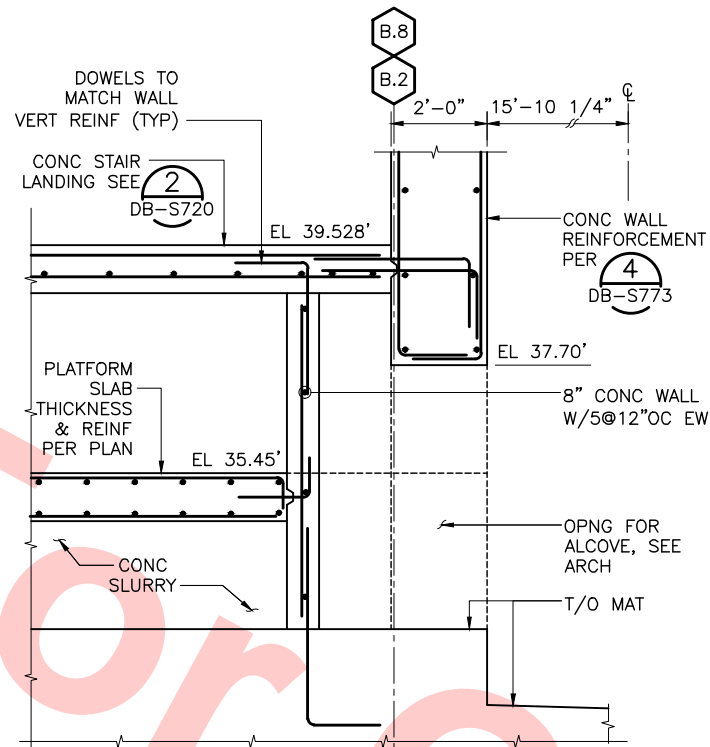


DETAIL 2  
SCALE: 1/2"=1'-0"  
DB-S604 DB-S071 DB-S111 DB-S201X DB-S720

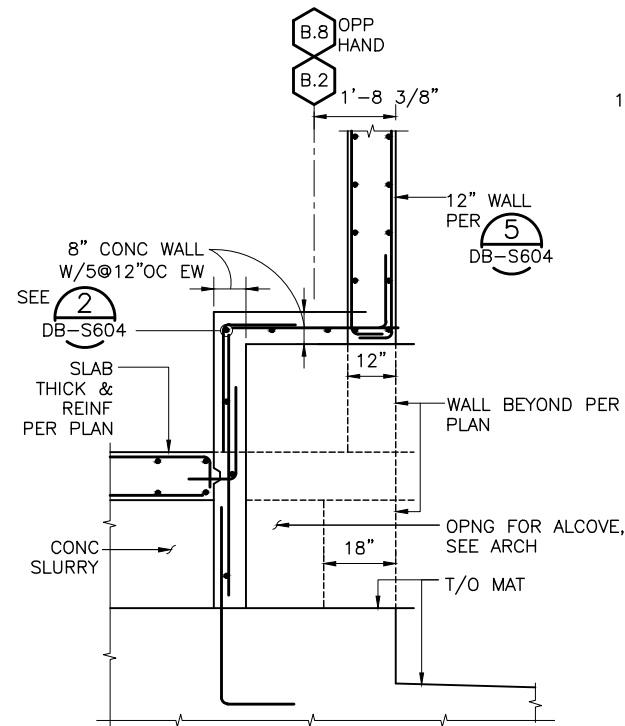


DETAIL 3  
SCALE: 1/2"=1'-0"  
DB-S604 DB-S076 DB-S116 DB-S206X

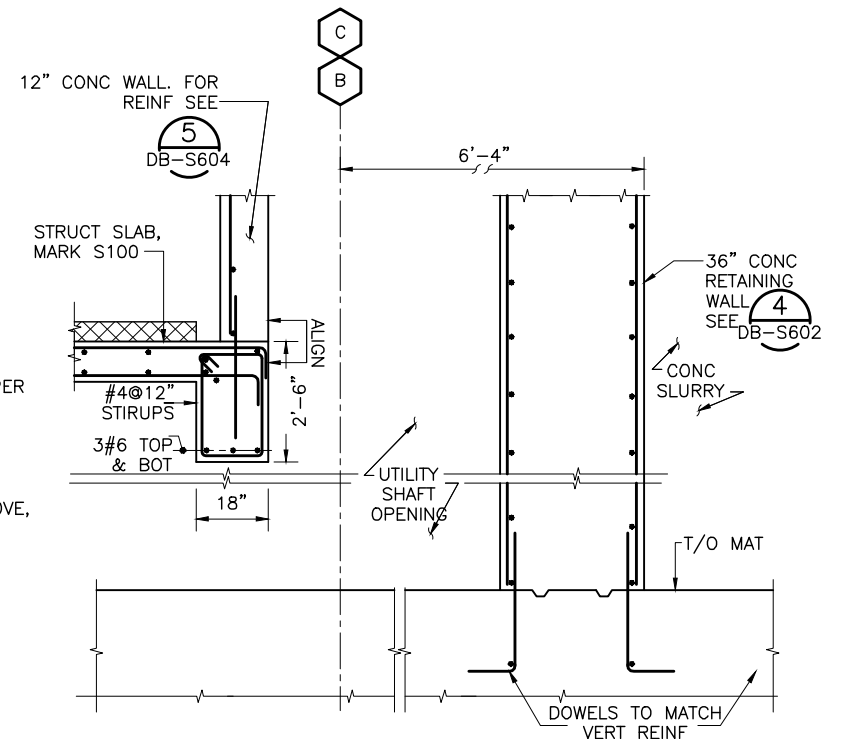


DETAIL 4  
SCALE: 1/2"=1'-0"  
DB-S604 DB-S076 DB-S116

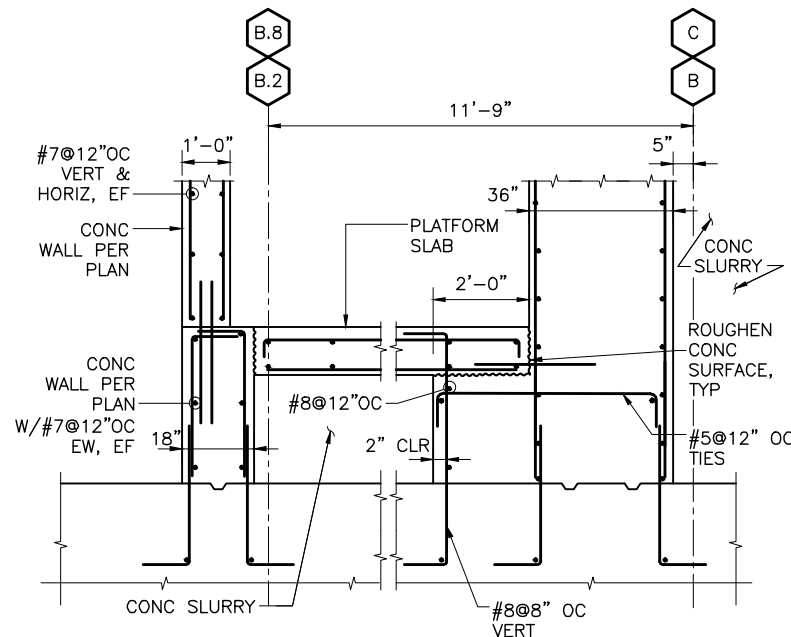

SECTION 5  
SCALE: 1/2"=1'-0"  
DB-S604 DB-S076 DB-S116

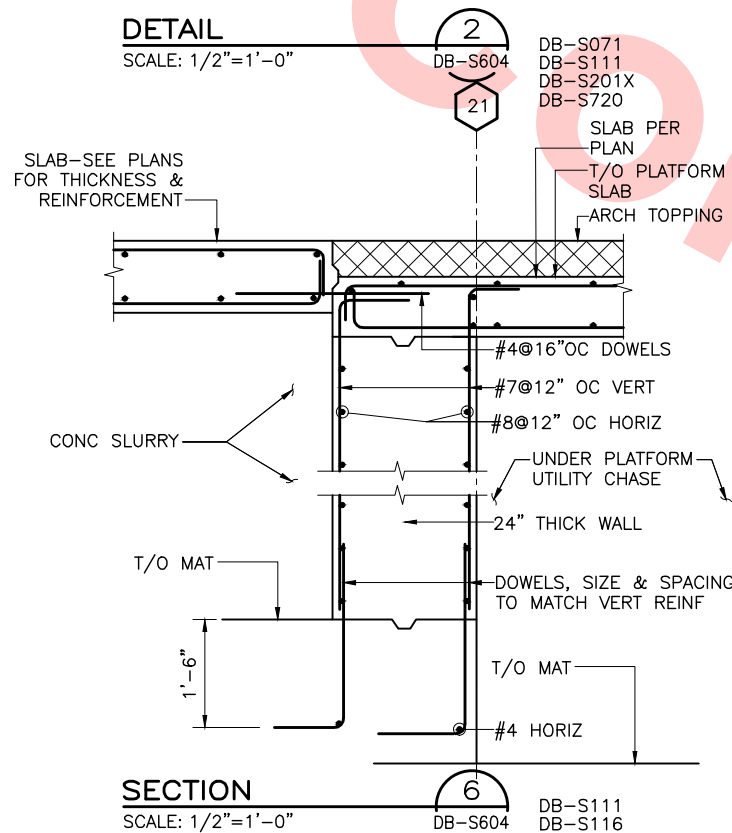

SECTION 6  
SCALE: 1/2"=1'-0"  
DB-S604 DB-S111 DB-S116

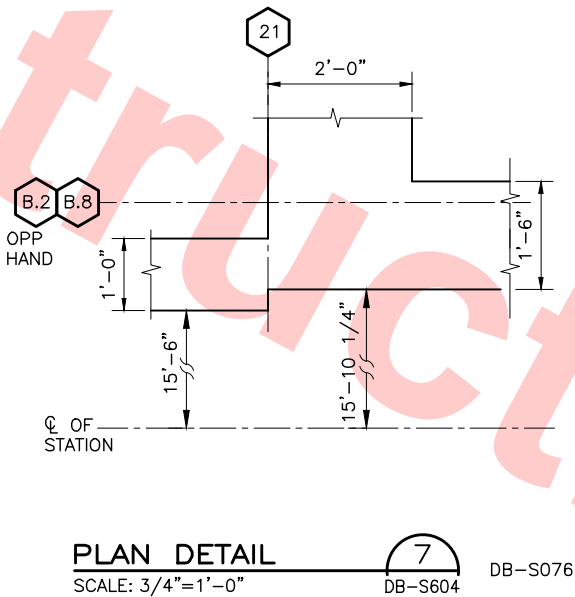


PLAN DETAIL 7  
SCALE: 3/4"=1'-0"  
DB-S604 DB-S076

FOR REFERENCE ONLY AND NOT FOR REVIEW.  
THIS DRAWING WAS SUBMITTED UNDER  
DU-23-WP08 TRENCH PACKAGE

DESIGNED BY J. REBER, S.E.	
DRAWN BY P. DIAZ	
CHECKED BY M. TARAZI	
IN CHARGE M. TARAZI	
DATE 20130531	

0	20130531				READINESS FOR CONSTRUCTION
REV	DATE	BY	SUB	APP	DESCRIPTION

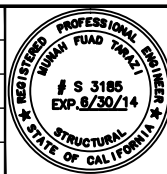

Skanska Shimmick Herzog	1436 California Circle Milpitas, California 95035 A Joint Venture
MFT CONSULTING ENGINEERS, Inc. Anil Verma Associates, Inc. 1773 San Pablo Ave., Suite A3 (510) 222-4166 Palo Alto, CA 94304 Fax (510) 222-6419	Lealwood, Andrews & Newman, Inc. A LEO A DALY COMPANY
SUBMITTED	APPROVED




LINE, TRACK, STATIONS AND SYSTEMS  
DESIGN UNIT 023  
MILPITAS STATION  
MAT AND PLATFORM FRAMING  
SECTIONS AND DETAILS  
SHEET 4 OF 4

CADD FILENAME C700-S-DB-S604.dwg	
SIZE D	SCALE AS NOTED
CONTRACT NO. C700	REV. 0
AREA CODE DB	SHEET NO. S604
	PAGE NO. 0211



- NOTES:
- SEE DWGS DB-S001X, DB-S002X AND DB-S003X FOR NOTES.
  - SEE CIVIL DRAWINGS FOR STORM DRAIN.

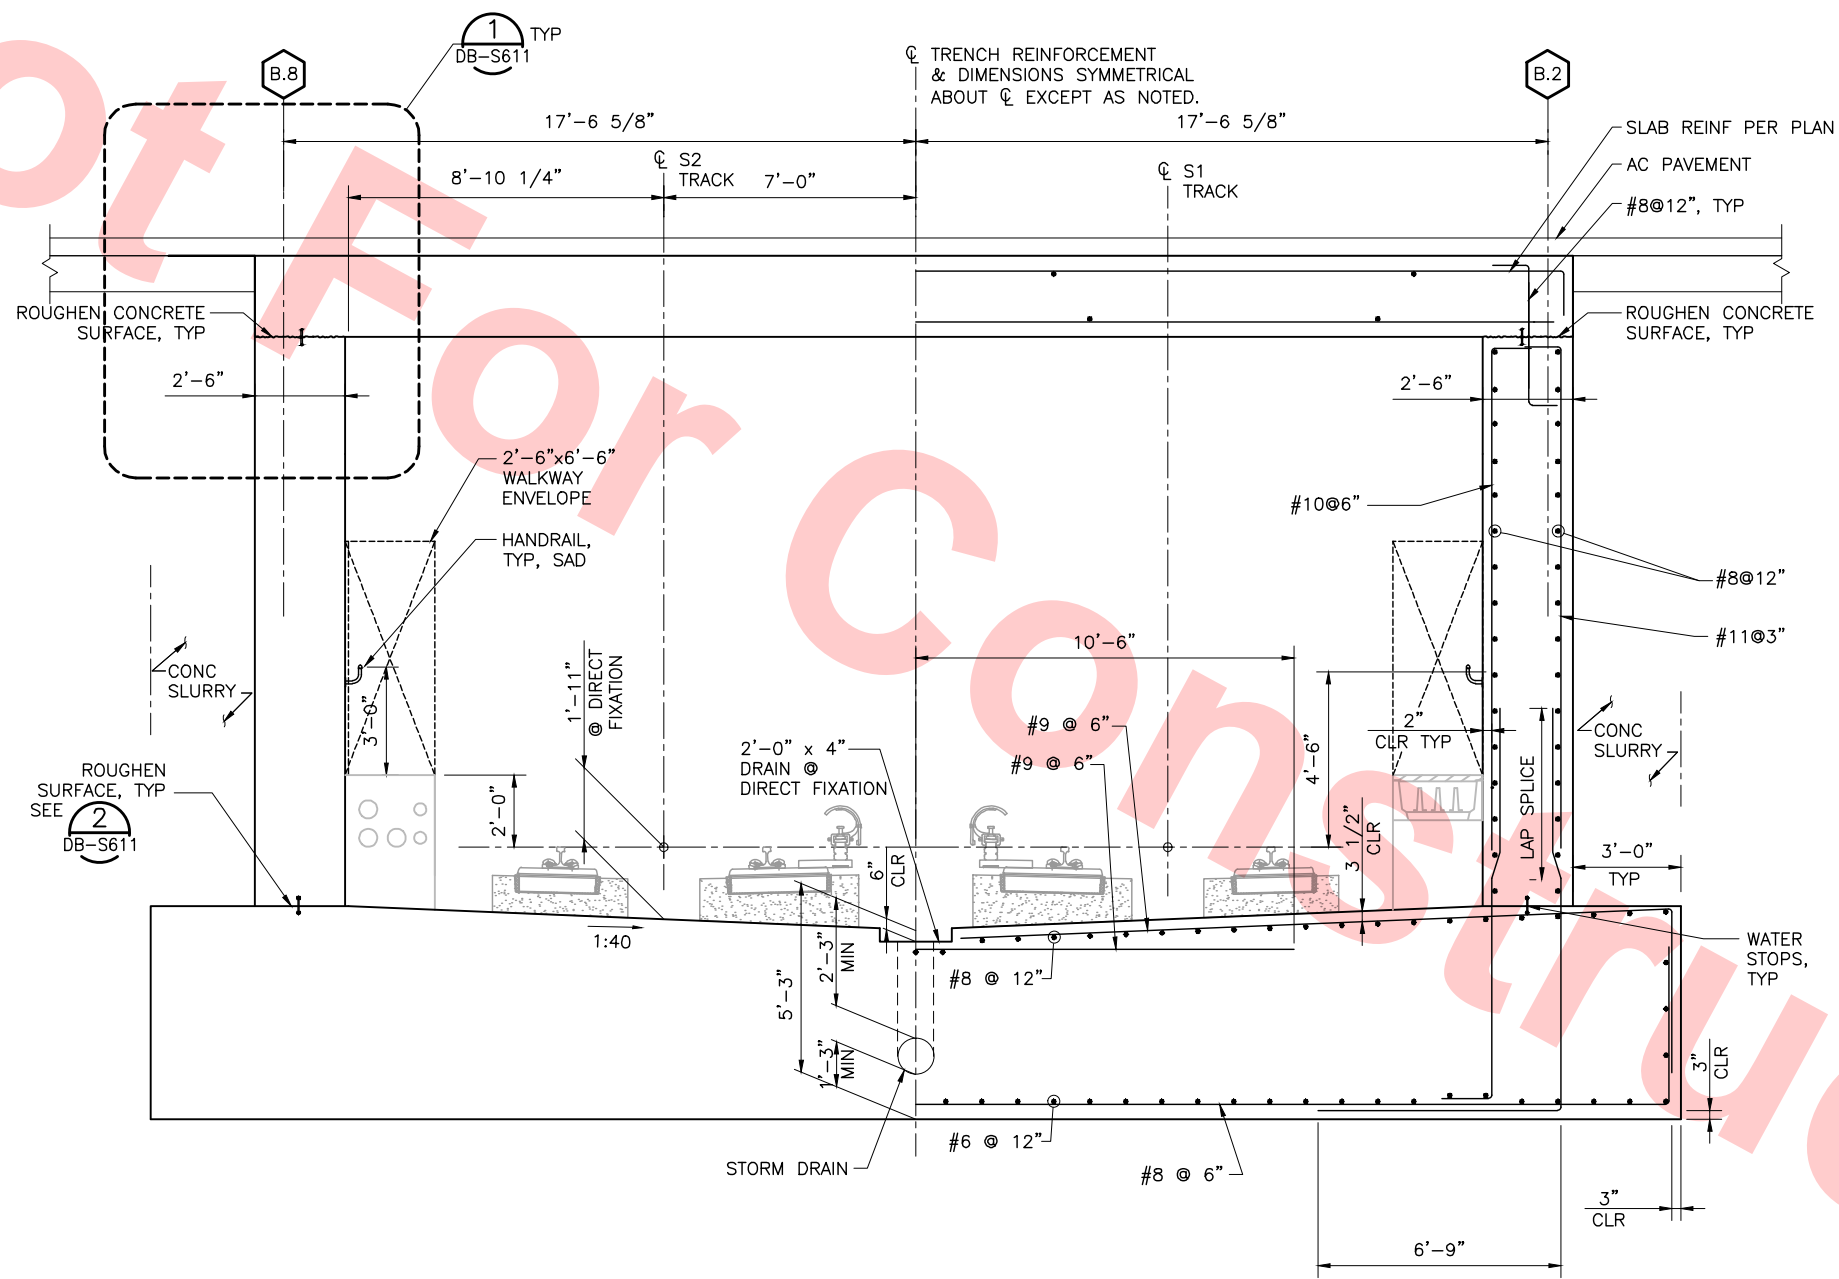

TYPICAL SECTION  
SCALE: 3/8"=1'-0"


DB-S077  
DB-S117  
DB-S129

FOR REFERENCE ONLY AND NOT FOR REVIEW.  
THIS DRAWING WAS SUBMITTED UNDER  
DU-23-WP08 TRENCH PACKAGE


Jul 05, 2013 02							DESIGNED BY J. REBER, S.E.		<b>Skanska Shimmick Herzog</b>  1436 California Circle Milpitas, California 95035 A Joint Venture	 MFT CONSULTING ENGINEERS, Inc. Anil Verma Associates, Inc. 1773 San Pablo Ave., Suite A3 (510) 222-4106 Pinole, CA 94664 Fax (510) 222-6419	 Leonwood, Andrews & Newman, Inc. A LEO A. RALY COMPANY	<b>T-Y-LIN INTERNATIONAL</b>	 <b>BART SILICON VALLEY BERRYESSA EXTENSION</b>	<b>LINE, TRACK, STATIONS AND SYSTEMS DESIGN UNIT 023 MILPITAS STATION TYPICAL SECTION</b>  SHEET 1 OF 1	CADD FILENAME C700-S-DB-S610.dwg SIZE SCALE D 3/8" = 1'-0" CONTRACT NO. C700 REV. 0 AREA CODE SHEET NO. PAGE NO. DB S610 0212		
	0	20130531				DRAWN BY P. DIAZ											
						CHECKED BY M. TARAZI											
						IN CHARGE M. TARAZI											
REV	DATE	BY	SUB	APP	DESCRIPTION	DATE 20130531	SUBMITTED		APPROVED								



04-02 Jul 05, 2013 1:54pm P:\BART Berryessa Extension Line\AS - STRUCTURAL MILPITAS WORK\_6-10-2012\0700-S-DB-S611.dwg

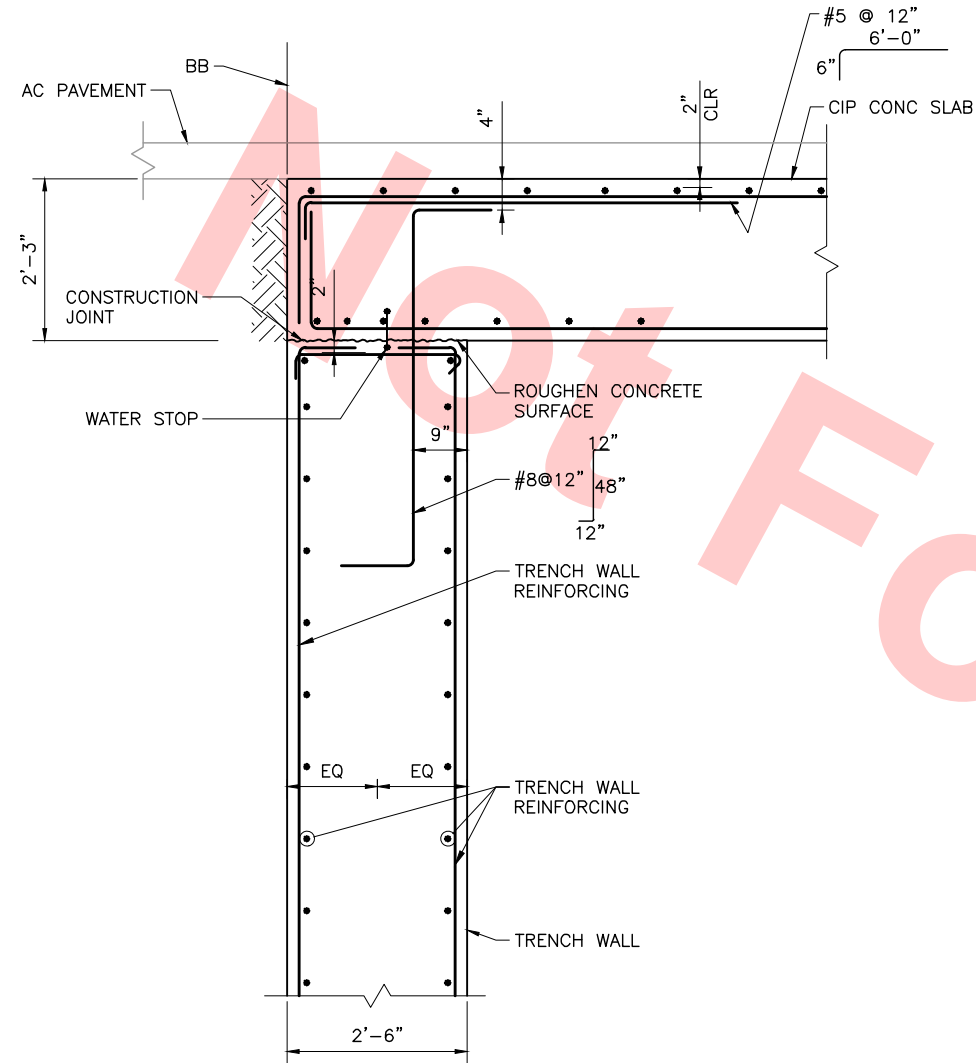

SECTION 1  
SCALE: 3/4"=1'-0" DB-S611 DB-S610

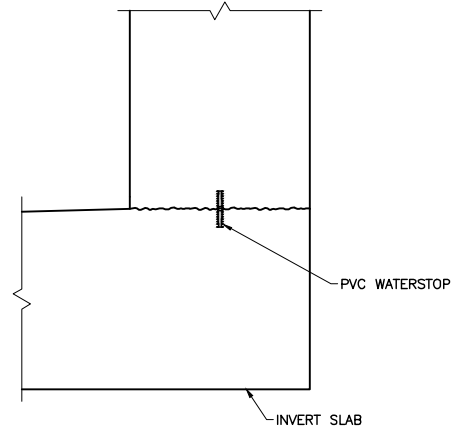


DETAIL 2  
SCALE: NTS DB-S611 DB-S610

FOR REFERENCE ONLY AND NOT FOR REVIEW.  
THIS DRAWING WAS SUBMITTED UNDER  
DU-23-WP08 TRENCH PACKAGE

REV	DATE	BY	SUB	APP	DESCRIPTION
0	20130531				READINESS FOR CONSTRUCTION

DESIGNED BY  
J. REBER, S.E.  
DRAWN BY  
P. DIAZ  
CHECKED BY  
M. TARAZI  
IN CHARGE  
M. TARAZI  
DATE  
20130531

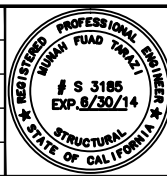

Skanska  
Shimmick  
Herzog  
1436 California Circle  
Milpitas, California 95035  
A Joint Venture  
MFT CONSULTING ENGINEERS, Inc. Anil Verma Associates, Inc.  
1773 San Pablo Ave., Suite A3 (510) 222-4166  
Pinole, CA 94664 Fax (510) 222-6418

Lealwood, Andrews  
& Newman, Inc.  
A LEO A DALY COMPANY  
T-Y-LIN INTERNATIONAL  
SUBMITTED \_\_\_\_\_ APPROVED \_\_\_\_\_




LINE, TRACK, STATIONS AND SYSTEMS  
DESIGN UNIT 023  
MILPITAS STATION  
TYPICAL SECTION  
DETAILS  
SHEET 1 OF 4

CADD FILENAME C700-S-DB-S611.dwg	SIZE D	SCALE AS NOTED
CONTRACT NO. C700	SHEET NO. S611	REV. 0
AREA CODE DB	PAGE NO. 0213	



Jul 05, 2013 1:54pm P:\BART Berryessa Extension Line\5 - STRUCTURAL MILPITAS WORK\5-10-2012\0700-S-DB-S612.dwg

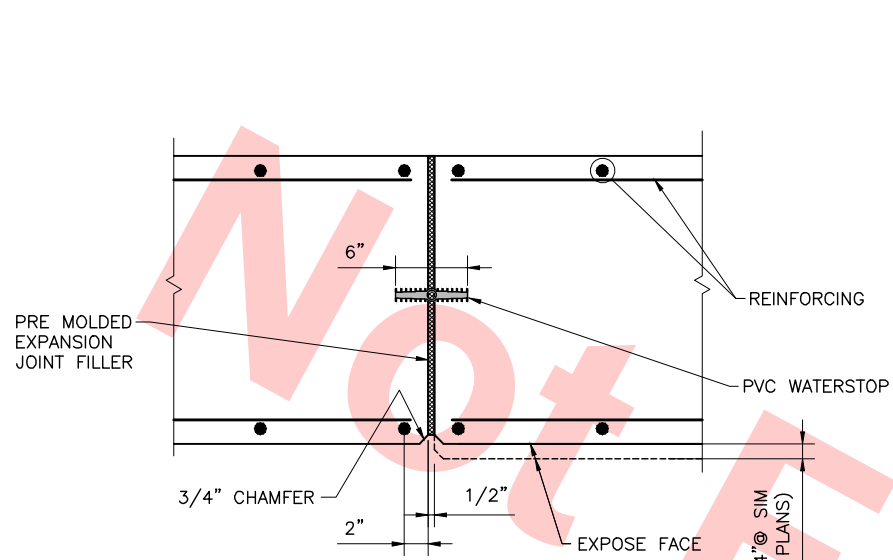


WALL EXPANSION JOINT  
DETAIL

SCALE: NTS

1  
DB-S612

DB-S071  
DB-S075  
DB-S076  
DB-S077  
DB-S117

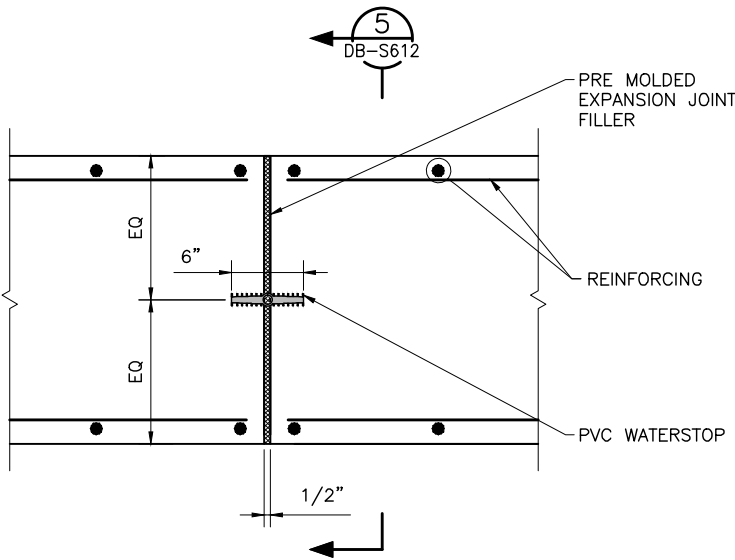


INVERT SLAB EXPANSION JOINT  
DETAIL

SCALE: NTS (SIM @ DECK SLAB)

2  
DB-S612

DB-S076  
DB-S129

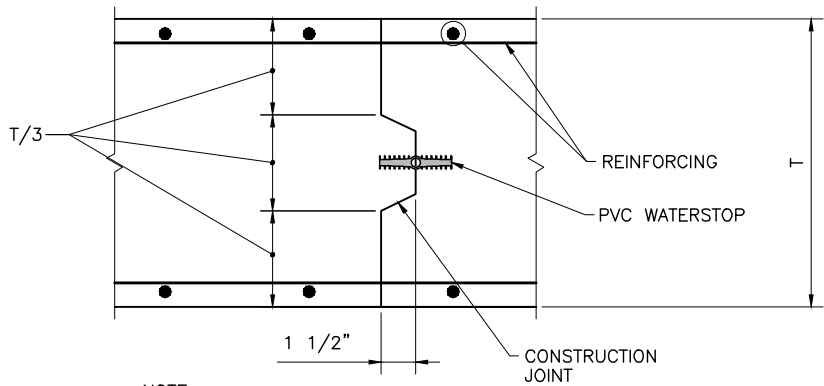


NOTE:  
REINFORCING SHALL BE CONTINUOUS  
THRU CONSTRUCTION JOINT

WALL & INVERT SLAB  
CONSTRUCTION JOINT DETAIL

SCALE: NTS

3  
DB-S612

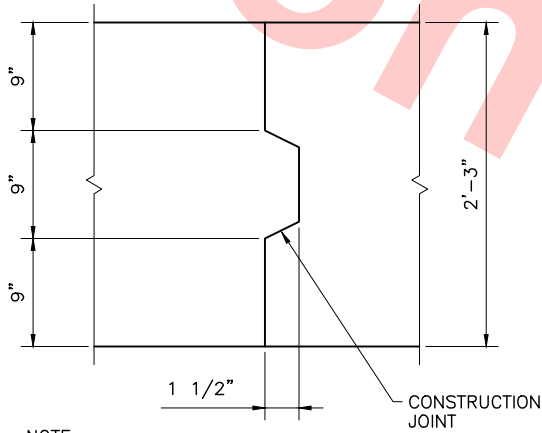


NOTE:  
REINFORCING NOT SHOWN

DECK CONSTRUCTION JOINT  
DETAIL

SCALE: NTS

4  
DB-S612

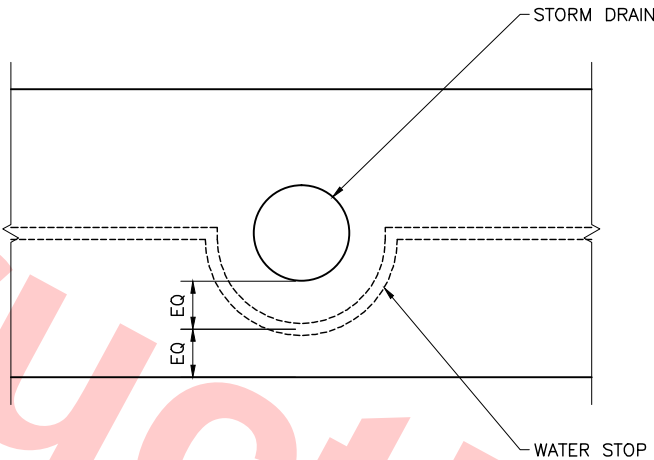

SECTION

SCALE: NTS

5  
DB-S612

FOR REFERENCE ONLY AND NOT FOR REVIEW.  
THIS DRAWING WAS SUBMITTED UNDER  
DU-23-WP08 TRENCH PACKAGE

DESIGNED BY J. REBER, S.E.	
DRAWN BY P. DIAZ	
CHECKED BY M. TARAZI	
IN CHARGE M. TARAZI	
DATE 20130531	

REV	DATE	BY	SUB	APP	DESCRIPTION
0	20130531				READINESS FOR CONSTRUCTION



<b>Skanska</b> <b>Shimmick</b> <b>Herzog</b>	1436 California Circle Milpitas, California 95035 A Joint Venture
<b>MFT CONSULTING ENGINEERS, Inc.</b> 1773 San Pablo Ave., Suite A3 Pinole, CA 94664 (910) 222-4106 Fax (910) 222-6419	<b>Lealwood, Andrews &amp; Newman, Inc.</b> A LEO A DALY COMPANY
<b>T-Y-LIN INTERNATIONAL</b>	




LINE, TRACK, STATIONS AND SYSTEMS DESIGN UNIT 023 MILPITAS STATION TYPICAL SECTION DETAILS SHEET 2 OF 4			
CADD FILENAME C700-S-DB-S612.dwg			
SIZE D	SCALE NONE		
CONTRACT NO. C700	REV. 0		
AREA CODE DB	SHEET NO. S612	PAGE NO. 0214	



NOTES:


1. REFER TO ARCHITECTURAL DRAWINGS FOR LOCATIONS OF NICHES. SEE DWG DB-S614 FOR NICHES SIZES.
2. THE AREA OF THE ADDITIONAL VERTICAL REINFORCING AND THE ADDITIONAL HORIZONTAL REINFORCING SHALL NOT BE LESS THAN THE INTERRUPTED VERTICAL AND HORIZONTAL REINFORCING. RESPECTIVELY, ADDITIONAL REINFORCING SHALL BE DISTRIBUTED WITHIN THE DISTANCE SHOWN IN THE DETAILS

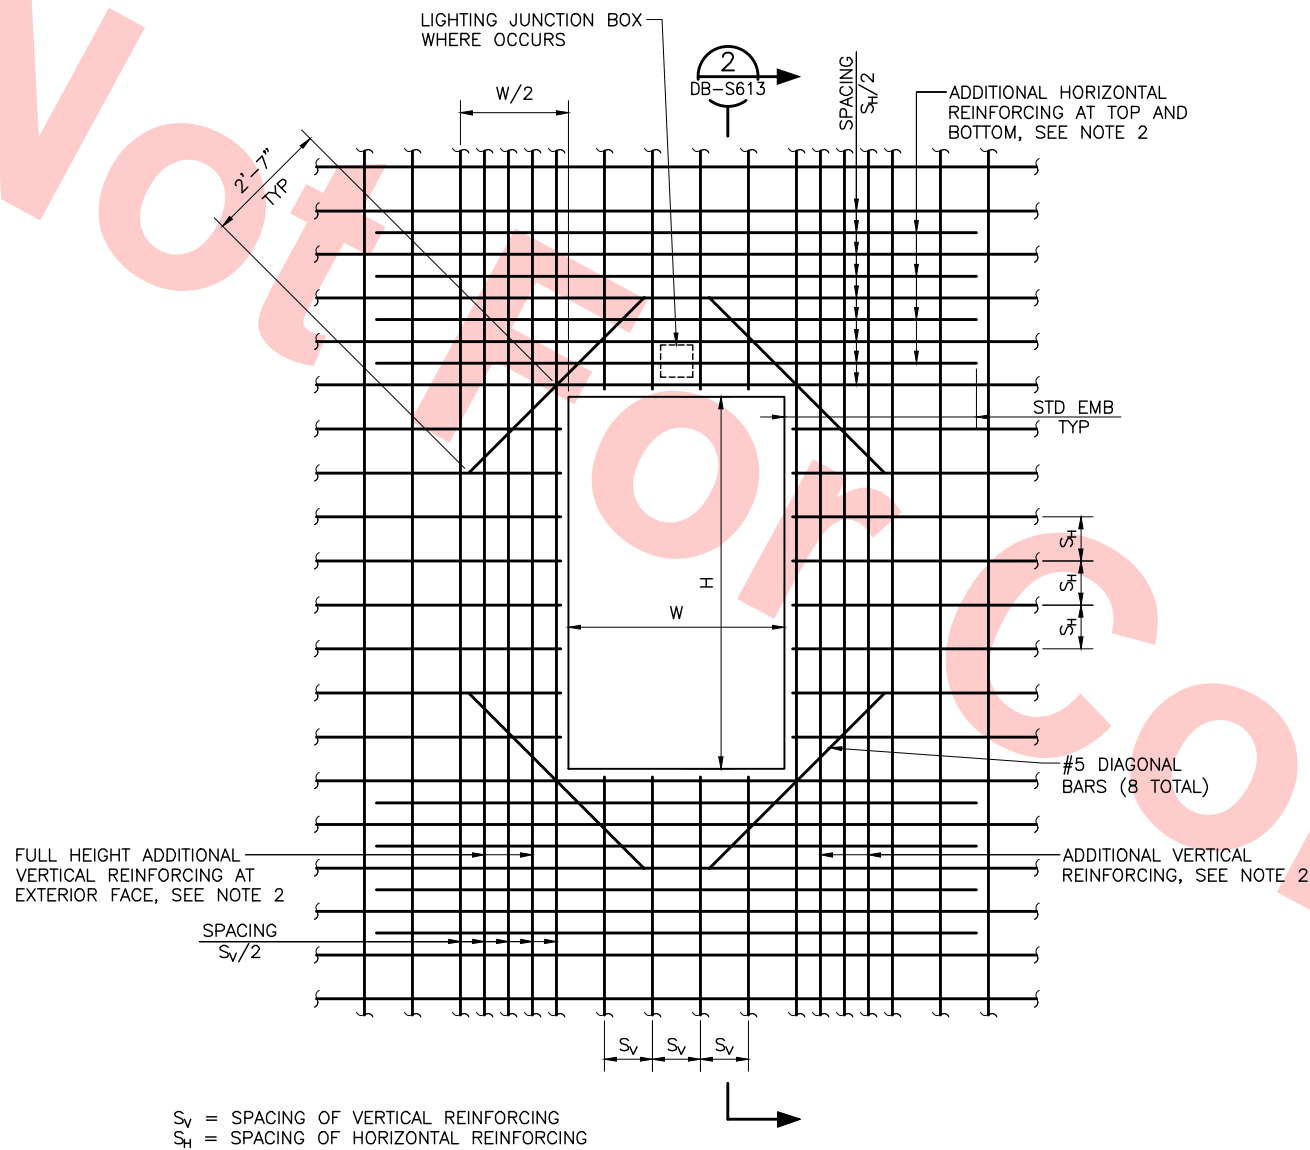

ADDITIONAL REINFORCEMENT  
AT NICHES

SCALE: 1/2"=1'-0"

1  
DB-S613

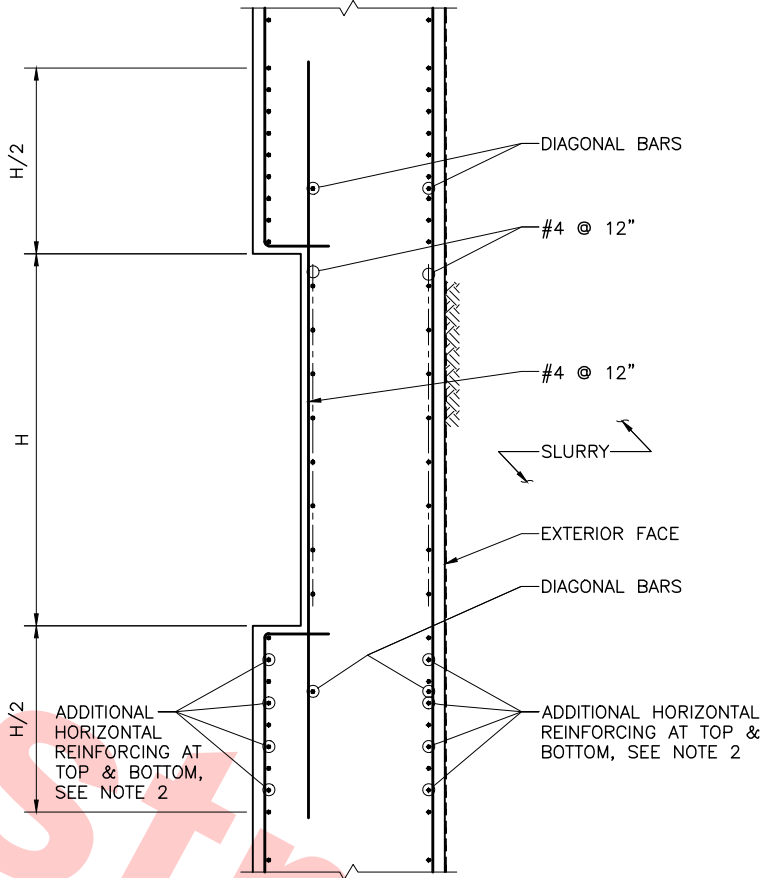

SECTION AT NICHE

SCALE: 1/2"=1'-0"

2  
DB-S613

FOR REFERENCE ONLY AND NOT FOR REVIEW.  
THIS DRAWING WAS SUBMITTED UNDER  
DU-23-WP08 TRENCH PACKAGE

04-02 Jul 05, 2013 1:54pm P:\BART Berryessa Extension Line\AS - STRUCTURAL MILPITAS WORK\_6-10-2012\0700-S-DB-S613.dwg

DESIGNED BY J. REBER, S.E.	
DRAWN BY P. DIAZ	
CHECKED BY M. TARAZI	
IN CHARGE M. TARAZI	
DATE 20130531	
REV	0
DATE	20130531
BY	
SUB	
APP	
DESCRIPTION	READINESS FOR CONSTRUCTION



1436 California Circle Milpitas, California 95035 A Joint Venture	
MFT CONSULTING ENGINEERS, INC. Anil Verma Associates, Inc. 1773 San Pablo Ave., Suite A3 (510) 222-4166 Pinole, CA 94664 Fax (510) 222-6419	
Skanska Shimmick Herzog	
Submitted	Approved

1436 California Circle Milpitas, California 95035 A Joint Venture	
Lealwood, Andrews & Newman, Inc. A LEO A DALY COMPANY	
T-Y-LIN INTERNATIONAL	
Submitted	Approved



LINE, TRACK, STATIONS AND SYSTEMS DESIGN UNIT 023 MILPITAS STATION TYPICAL SECTION DETAILS SHEET 3 OF 4	
--	--

CADD FILENAME C700-S-DB-S613.dwg	
SIZE D	SCALE AS NOTED
CONTRACT NO. C700	REV. 0
AREA CODE DB	SHEET NO. S613
PAGE NO. 0215	



Jul 05, 2013 - 1:54pm P:\BART Berryessa Extension Line\AS - STRUCTURAL MILPITAS WORK\6-10-2012\0700-S-DB-S614.dwg  
c04-02

FOR REFERENCE ONLY AND NOT FOR REVIEW.  
THIS DRAWING WAS SUBMITTED UNDER  
DU-23-WP08 TRENCH PACKAGE

REV	DATE	BY	SUB	APP	DESCRIPTION
0	20130531				READINESS FOR CONSTRUCTION

DESIGNED BY  
J. REBER, S.E.  
DRAWN BY  
P. DIAZ  
CHECKED BY  
M. TARAZI  
IN CHARGE  
M. TARAZI  
DATE  
20130531



**Skanska  
Shimmick  
Herzog**

1436 California Circle  
Milpitas, California 95035  
A Joint Venture

**MFT CONSULTING ENGINEERS, Inc.** Anil Verma Associates, Inc.  
1773 San Pablo Ave., Suite A3  
Palo Alto, CA 94304  
(810) 222-4168  
Fax (810) 222-6419

**Lealwood, Andrews  
& Newman, Inc.**  
A LEO A DALY COMPANY


**T-Y-LIN INTERNATIONAL**


SUBMITTED \_\_\_\_\_ APPROVED \_\_\_\_\_




LINE, TRACK, STATIONS AND SYSTEMS DESIGN UNIT 023 MILPITAS STATION TYPICAL SECTION DETAILS SHEET 4 OF 4			CADD FILENAME C700-S-DB-S614.dwg		
SIZE D	SCALE 3/4" = 1'-0"		CONTRACT NO. C700	REV. 0	
AREA CODE DB	SHEET NO. S614	PAGE NO. 0216			



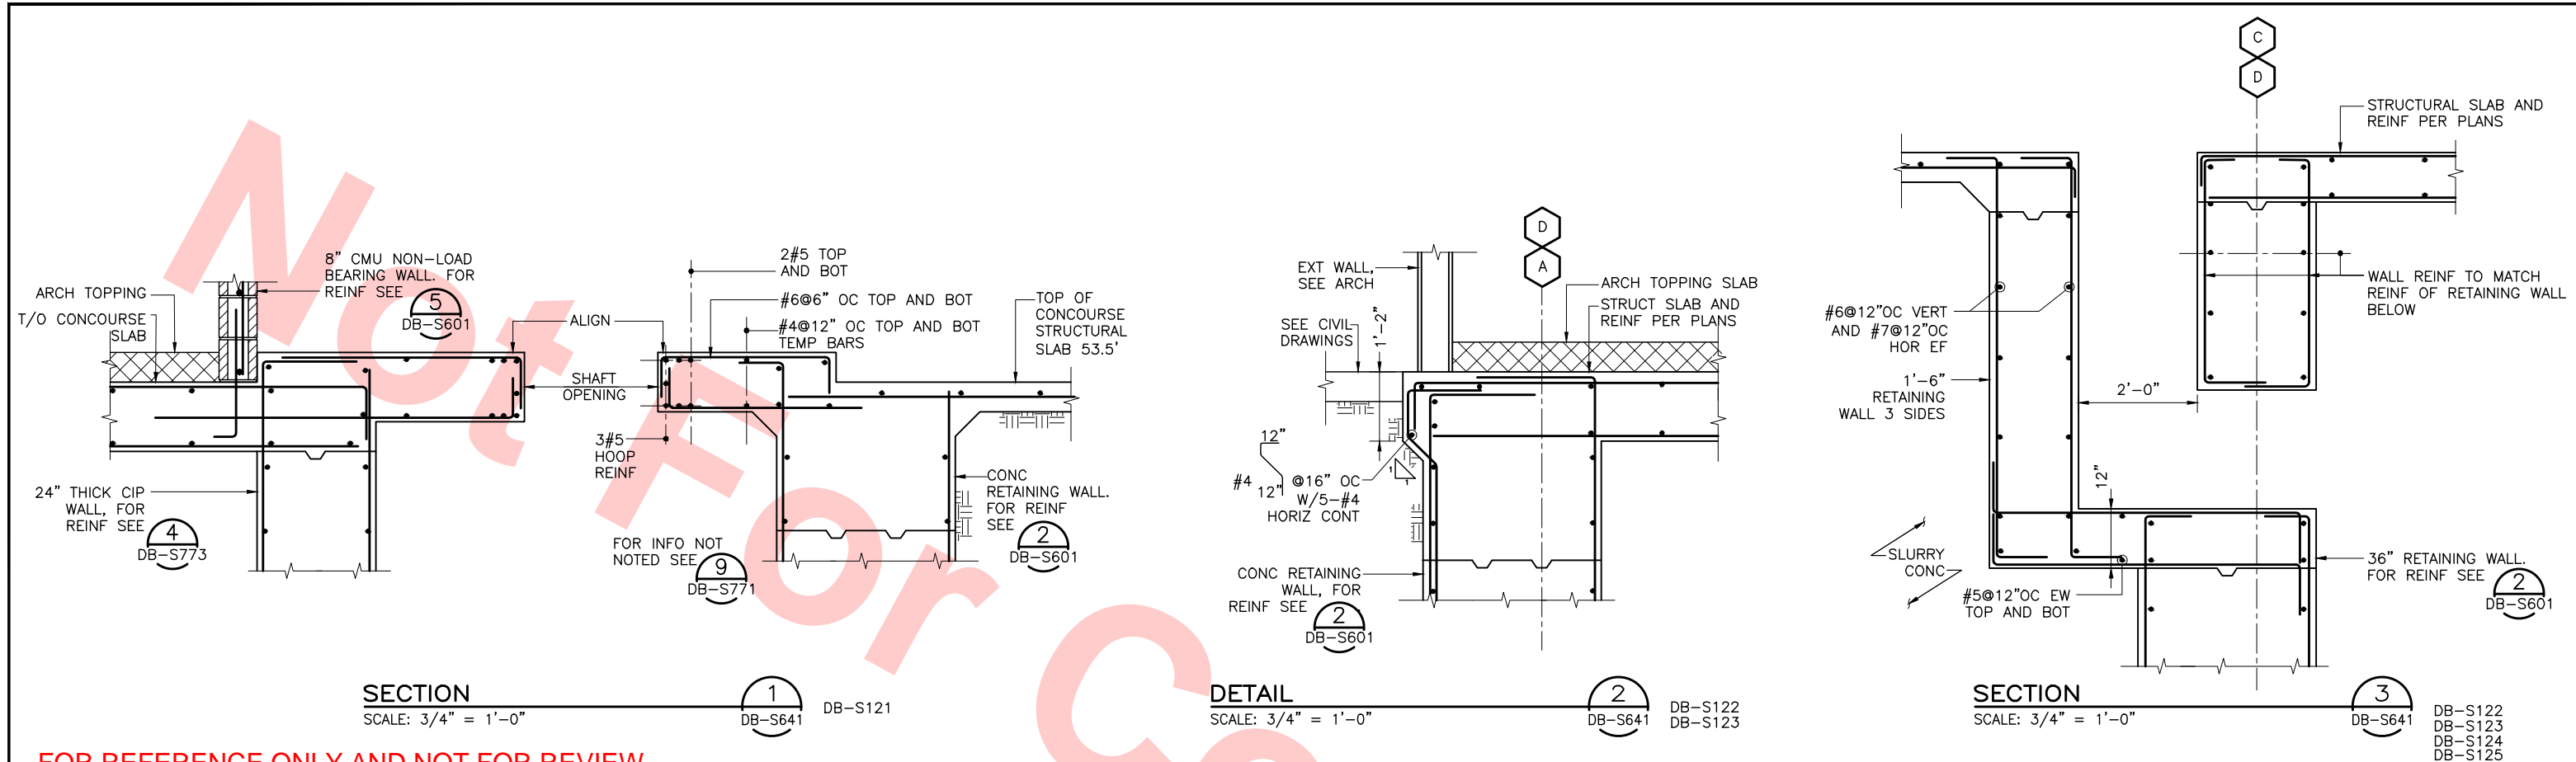


					DESIGNED BY J. REBER, S.E.				1436 California Circle Milpitas, California 95035 A Joint Venture			LINE, TRACK, STATIONS AND SYSTEMS DESIGN UNIT 023		CADD FILENAME C700-S-DB-S641.dwg	
					DRAWN BY P. DIAZ							SIZE D SCALE AS NOTED		CONTRACT NO. C700 REV. 0	
					CHECKED BY M. TARAZI							AREA CODE DB SHEET NO. S641		PAGE NO. 0217	
0 20130531 READINESS FOR CONSTRUCTION					IN CHARGE M. TARAZI										
REV	DATE	BY	SUB	APP	DESCRIPTION	DATE	MFT CONSULTING ENGINEERS, Inc. And Verma Associates, Inc. 1775 San Pablo Ave., Suite A3 (510) 222-4198 Pinole, CA 94564 Fax (510) 222-6418		 T-Y-LIN INTERNATIONAL		BART SILICON VALLEY BERRYESSA EXTENSION				
						20130531	SUBMITTED _____		APPROVED _____		SHEET 1 OF 10				



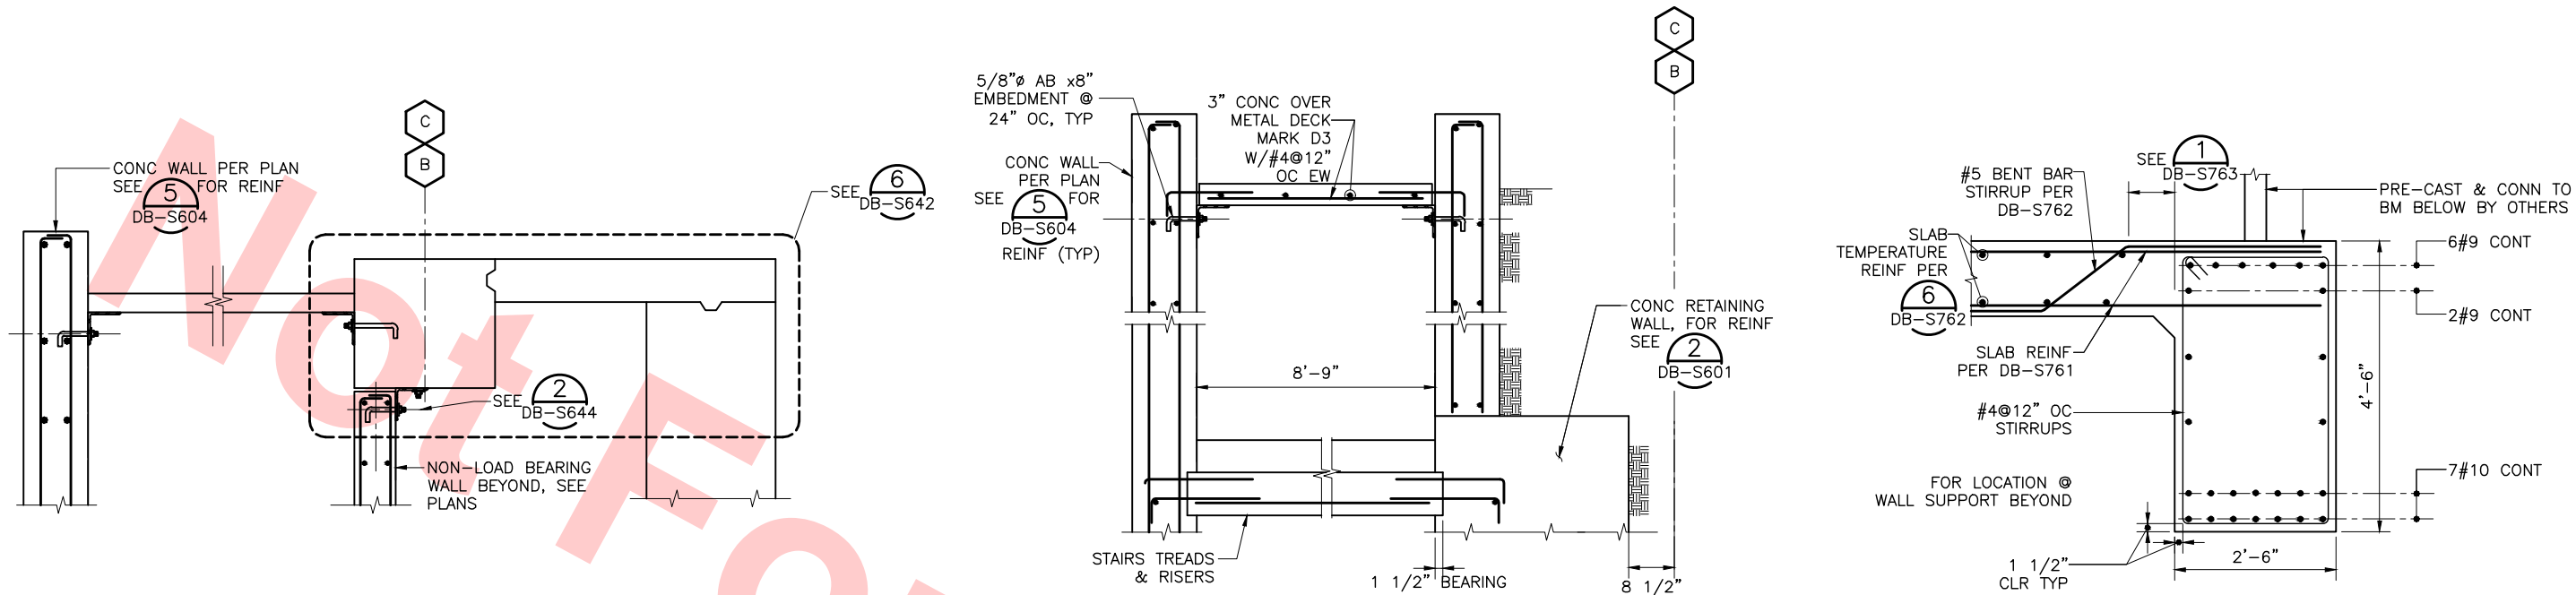


FOR REFERENCE ONLY AND NOT FOR REVIEW.  
THIS DRAWING WAS SUBMITTED UNDER  
DU-23-WP08 TRENCH PACKAGE

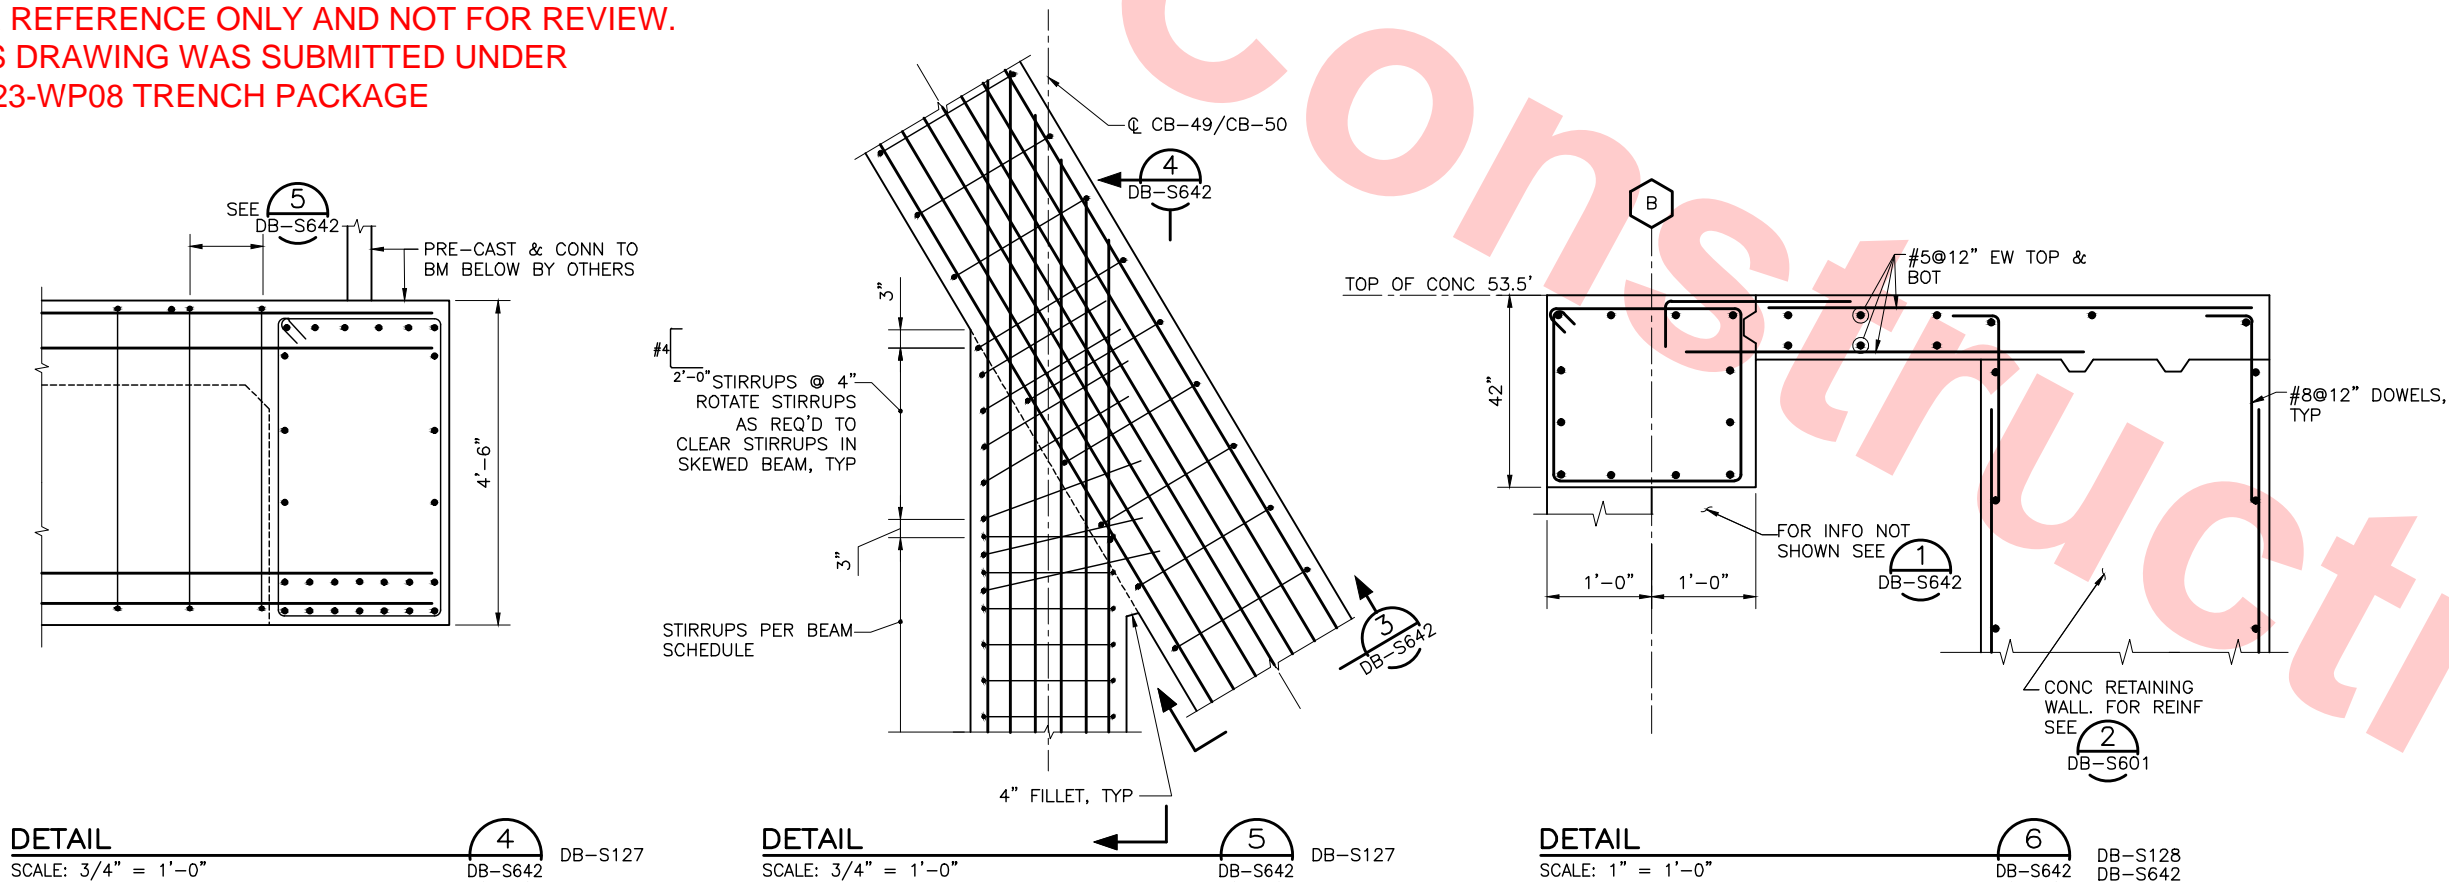

Jul 08, 2013 - 10:16am P:\BART Berryessa Extension Line\AS - STRUCTURAL\MULTI\WORK\_6-10-2012\0700-S-DB-S642.dwg

DESIGNED BY J. REBER, S.E.	
DRAWN BY P. DIAZ	
CHECKED BY M. TARAZI	
IN CHARGE M. TARAZI	
DATE 20130531	
REV	0
DATE	20130531
BY	
SUB	
APP	
DESCRIPTION	READINESS FOR CONSTRUCTION

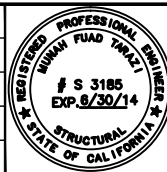

Skanska Shimmick Herzog	1436 California Circle Milpitas, California 95035 A Joint Venture
MFT CONSULTING ENGINEERS, Inc. Anil Verma Associates, Inc. 1773 San Pablo Ave., Suite A3 Palo Alto, CA 94304 (510) 222-4106 Fax (510) 222-6419	Lealwood, Andrews & Newman, Inc. A LEO A DALY COMPANY
T-Y-LIN INTERNATIONAL	


BART SILICON VALLEY	
BART SILICON VALLEY BERRYESSA EXTENSION	

LINE, TRACK, STATIONS AND SYSTEMS DESIGN UNIT 023 MILPITAS STATION CONCOURSE SECTIONS AND DETAILS SHEET 2 OF 10	
--	--


CADD FILENAME C700-S-DB-S642.dwg	
SIZE D	SCALE AS NOTED
CONTRACT NO. C700	REV. 0
AREA CODE DB	SHEET NO. S642
PAGE NO. 0218	




Jul 05, 2013 - 3:37pm P:\BART Berryessa Extension Line\AS - STRUCTURAL MILPITAS WORK\6-10-2012\0700-S-DB-S643.dwg  
c6d-02

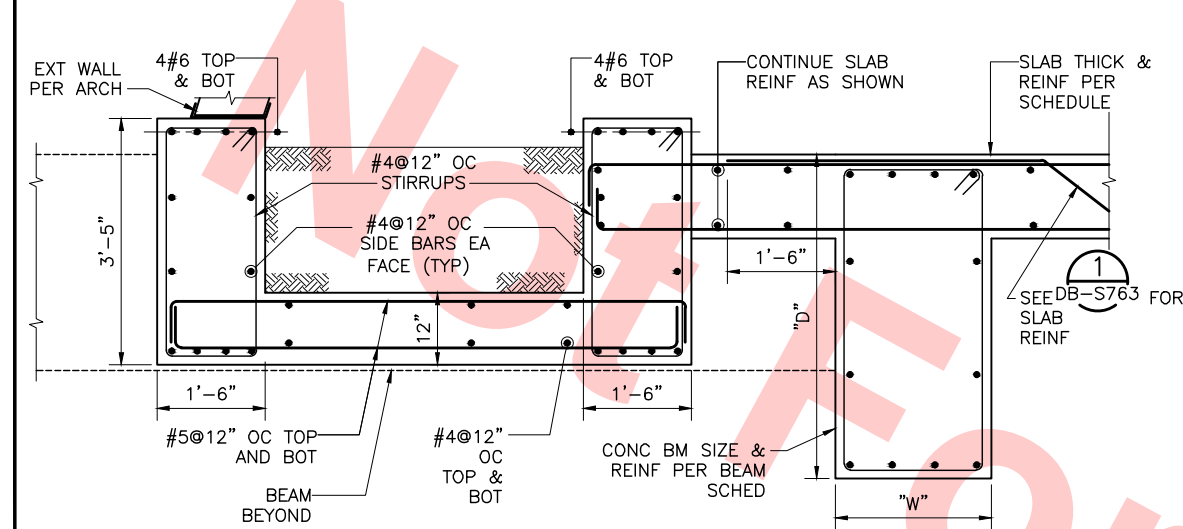

SECTION 1  
SCALE: 3/4"=1'-0"  
DB-S643 DB-S126 DB-S204X

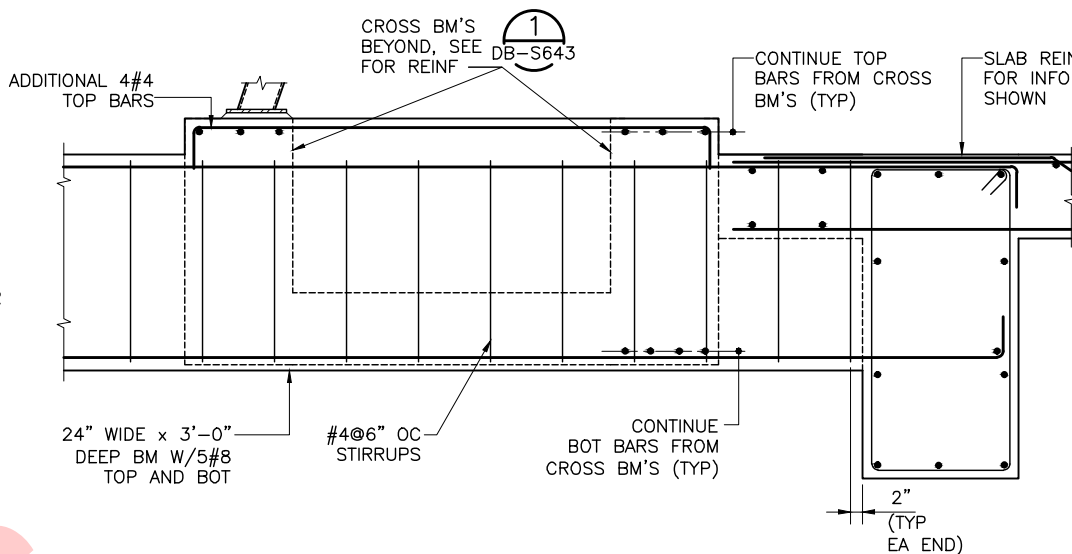


SECTION 2  
SCALE: 3/4"=1'-0"  
DB-S643 DB-S126

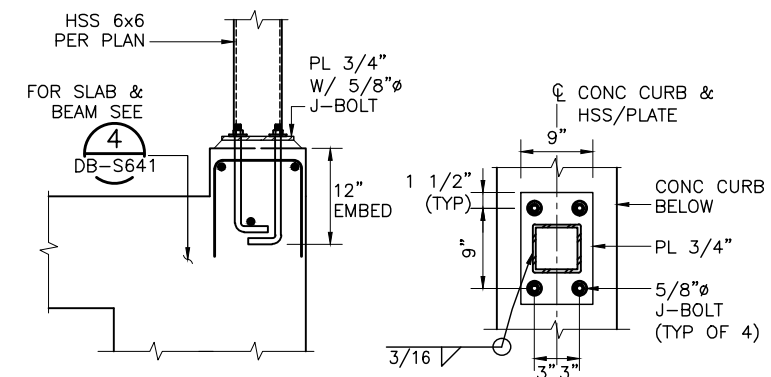


SECTION 3  
SCALE: 1"=1'-0"  
DB-S641 DB-S643


FOR REFERENCE ONLY AND NOT FOR REVIEW.  
THIS DRAWING WAS SUBMITTED UNDER  
DU-23-WP08 TRENCH PACKAGE

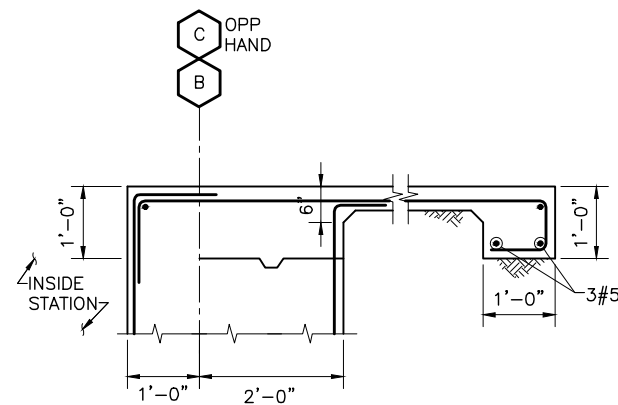

SECTION 4  
SCALE: 3/4"=1'-0"  
DB-S643 DB-S121

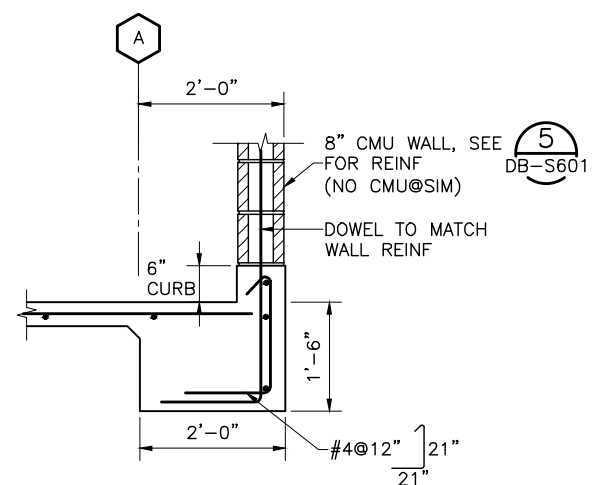


SECTION 5  
SCALE: 3/4"=1'-0"  
DB-S643 DB-S121

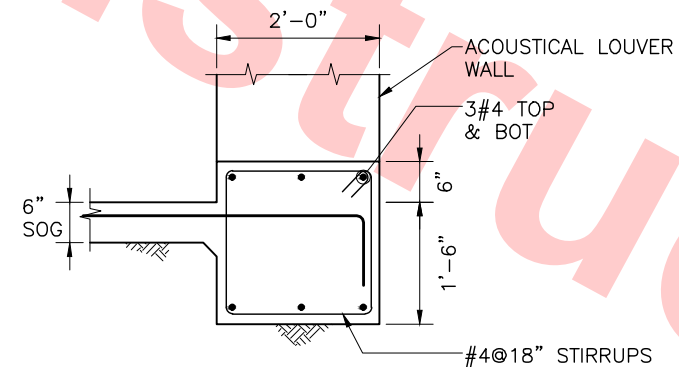

SECTION 6  
SCALE: 3/4"=1'-0"  
DB-S643 DB-S121

REV	DATE	BY	SUB	APP	DESCRIPTION

DESIGNED BY J. REBER, S.E.
DRAWN BY P. DIAZ
CHECKED BY M. TARAZI
IN CHARGE M. TARAZI
DATE

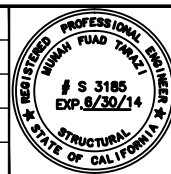








Skanska Shimmick Herzog	1436 California Circle Milpitas, California 95035 A Joint Venture
MFT CONSULTING ENGINEERS, INC. Anil Verma Associates, Inc. 1773 San Pablo Ave., Suite A3 Pinole, CA 94664 (510) 222-4166 Fax (510) 222-6419	Lealwood, Andrews & Newman, Inc. A LEO A DALY COMPANY T-Y-LIN INTERNATIONAL
SUBMITTED	APPROVED



LINE, TRACK, STATIONS AND SYSTEMS DESIGN UNIT 023 MILPITAS STATION CONCOURSE SECTIONS AND DETAILS SHEET 3 OF 10	CADD FILENAME C700-S-DB-S643.dwg SIZE SCALE D AS NOTED CONTRACT NO. C700 AREA CODE DB SHEET NO. S643 PAGE NO. 0219
--	---



Jul 05, 2013 - 1:54pm P:\BART Berryessa Extension Line\AS - STRUCTURAL\MILPITAS WORK\6-10-2012\0700-S-DB-S644.dwg

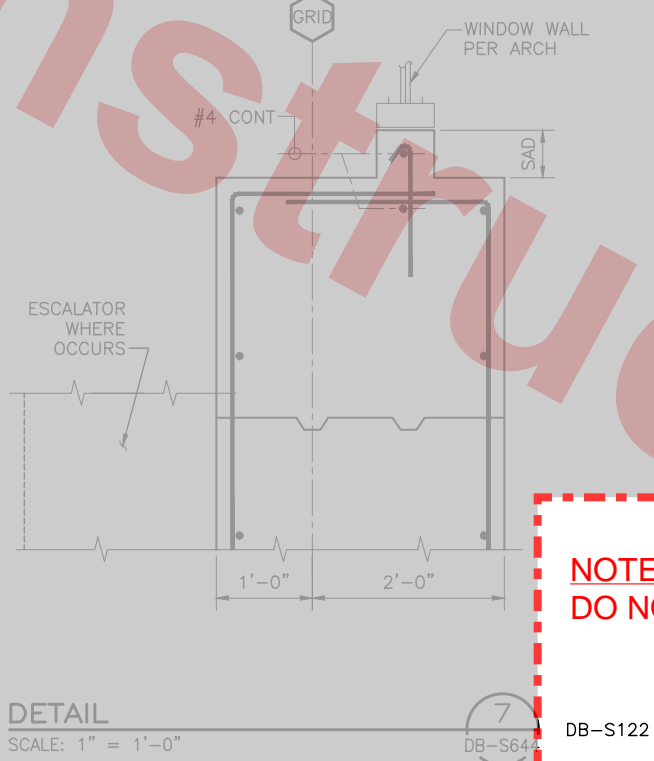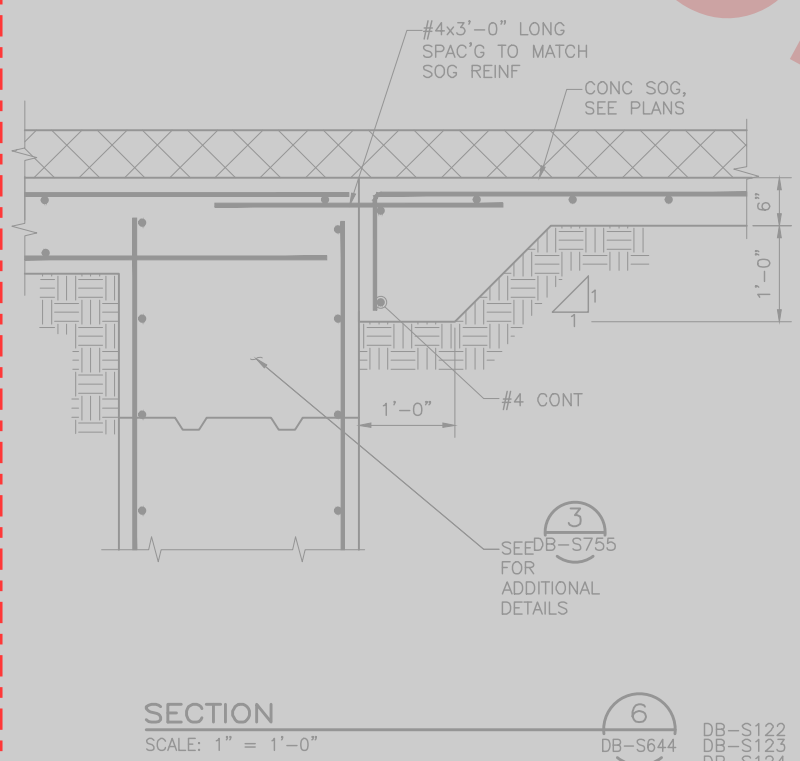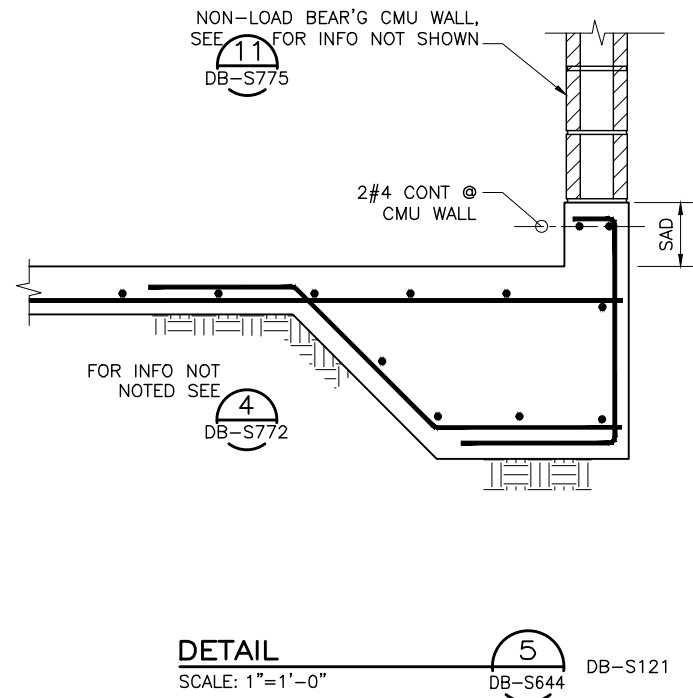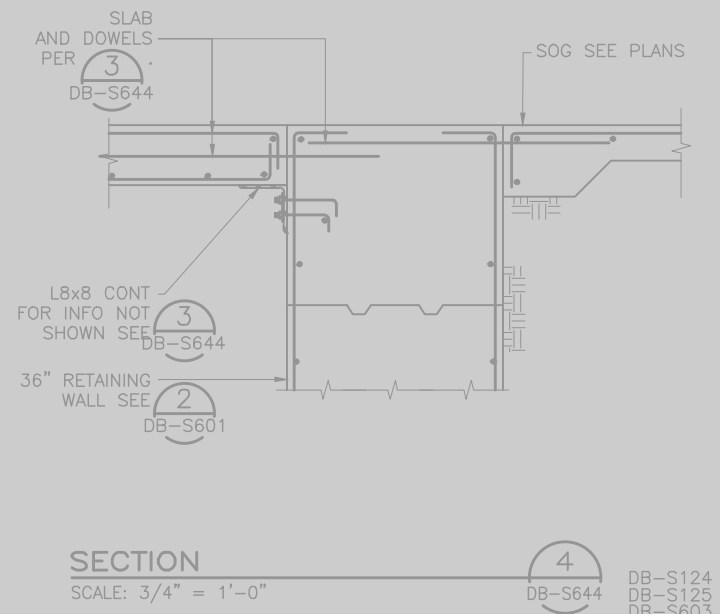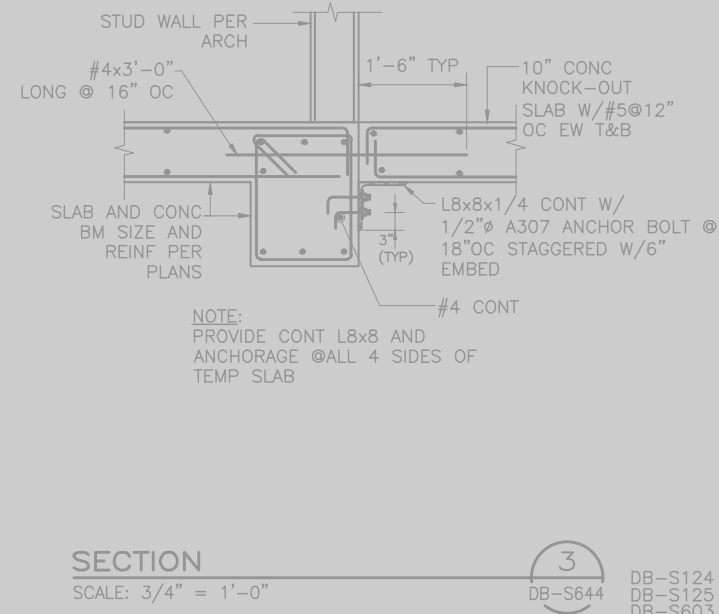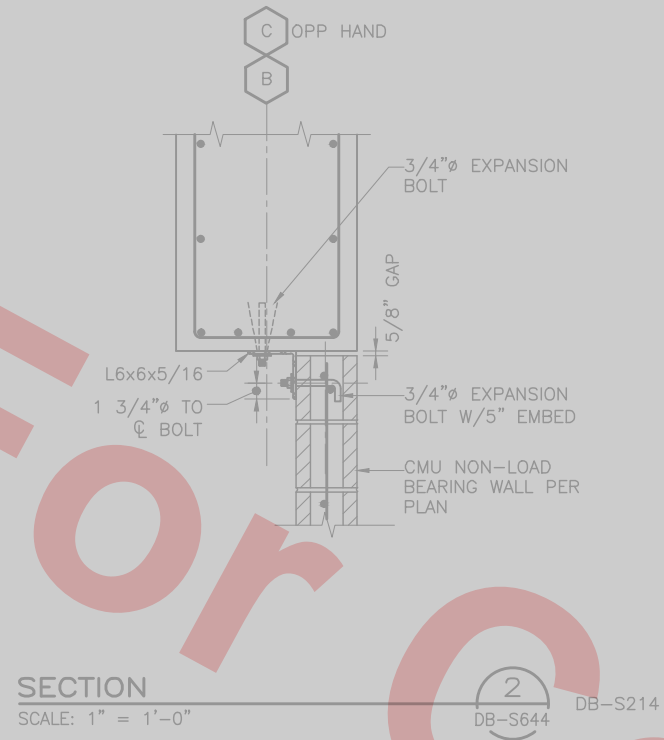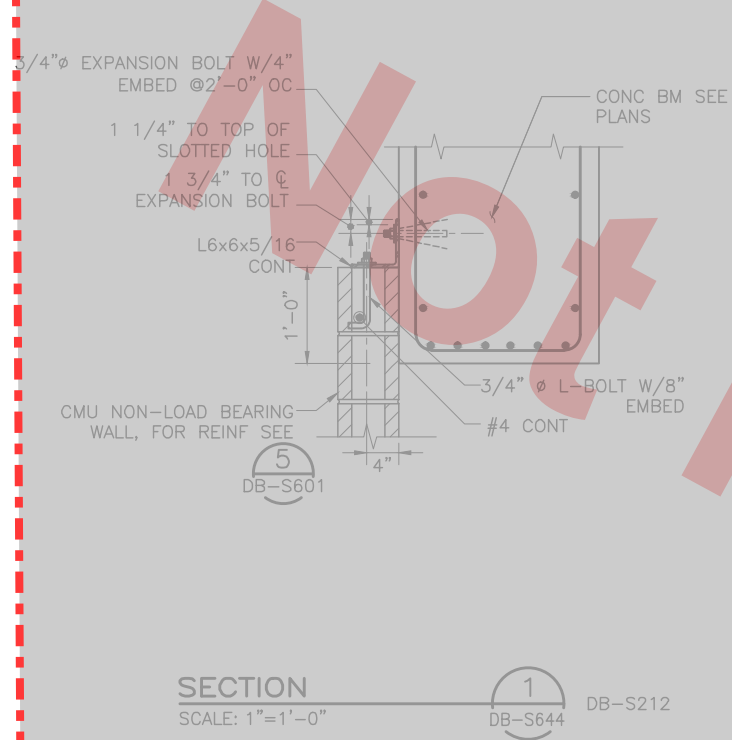

Santa Clara Valley Transportation Authority

\_\_\_ NO EXCEPTIONS TAKEN (NET)  
\_\_\_ MAKE CORRECTIONS NOTED (MCN)  
\_\_\_ AMEND AND RESUBMIT (A/R)

Any action shown above is subject to the terms of the contract and does not relieve the Contractor of any of its obligations under the contract, including design and detailing.

Contract No.: DB11002F

By: \_\_\_\_\_ Date: \_\_\_\_\_

NOTE TO REVIEWER(S):  
DO NOT REVIEW AREAS DESIGNATED AS

REV	DATE	BY	SUB	APP	DESCRIPTION
0	20130710				READINESS FOR CONSTRUCTION
0	20130531				READINESS FOR CONSTRUCTION

DESIGNED BY J. REBER, S.E.	
DRAWN BY P. DIAZ	
CHECKED BY M. TARAZI	
IN CHARGE M. TARAZI	
DATE 20130710	

Skanska  
Shimmick  
Herzog

1436 California Circle  
Milpitas, California 95035  
A Joint Venture

MFT CONSULTING ENGINEERS, Inc. Anil Verma Associates, Inc.

1773 San Pablo Ave., Suite A3 (510) 222-4100  
Palo Alto, CA 94304 Fax (650) 222-8410

Lealwood, Andrews & Newman, Inc. T-Y-LIN INTERNATIONAL

A LEAD & BALLY COMPANY

APPROVED *Ry Holmuth*

BART SILICON VALLEY BERRYESSA EXTENSION








LINE, TRACK, STATIONS AND SYSTEMS			
DESIGN UNIT 023			
MILPITAS STATION			
CONCOURSE SECTIONS AND DETAILS			
SHEET 4 OF 10			

CADD FILENAME C700-S-DB-S644.dwg	CONTRACT NO. <b>C700</b>		REV. <b>0</b>
SIZE D	SCALE AS NOTED	AREA CODE DB	PAGE NO. 0220
SHEET NO. S644			










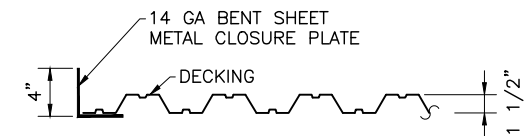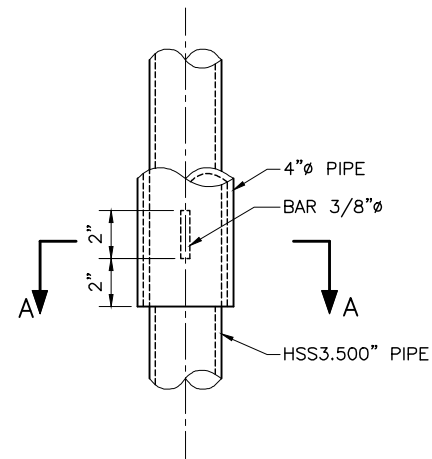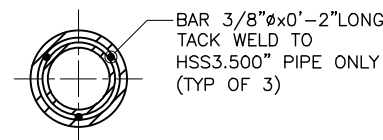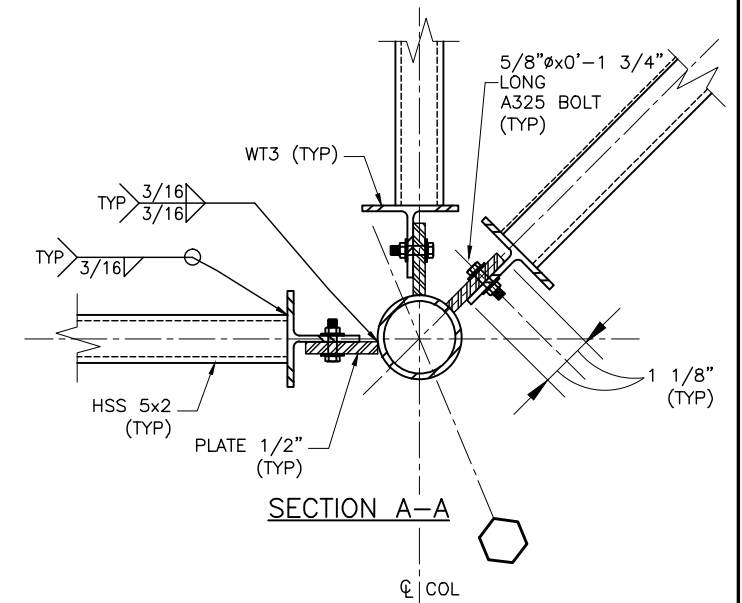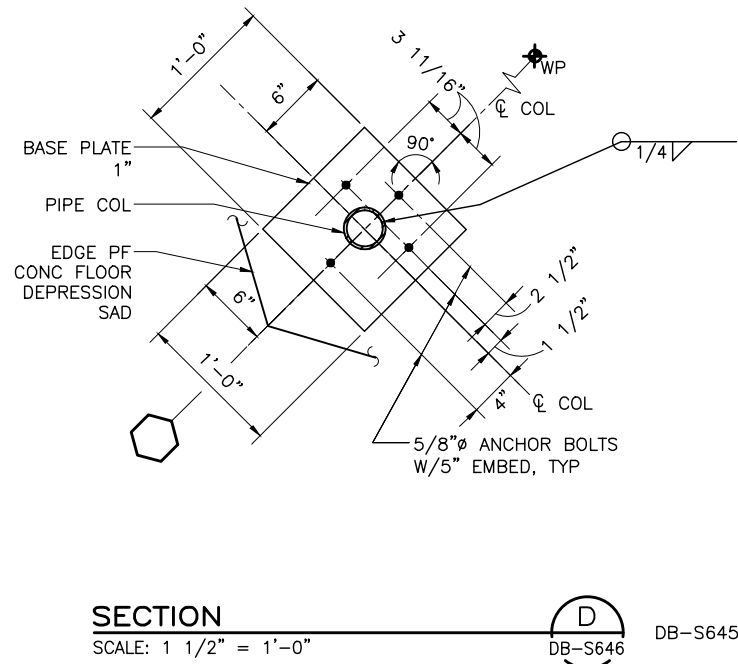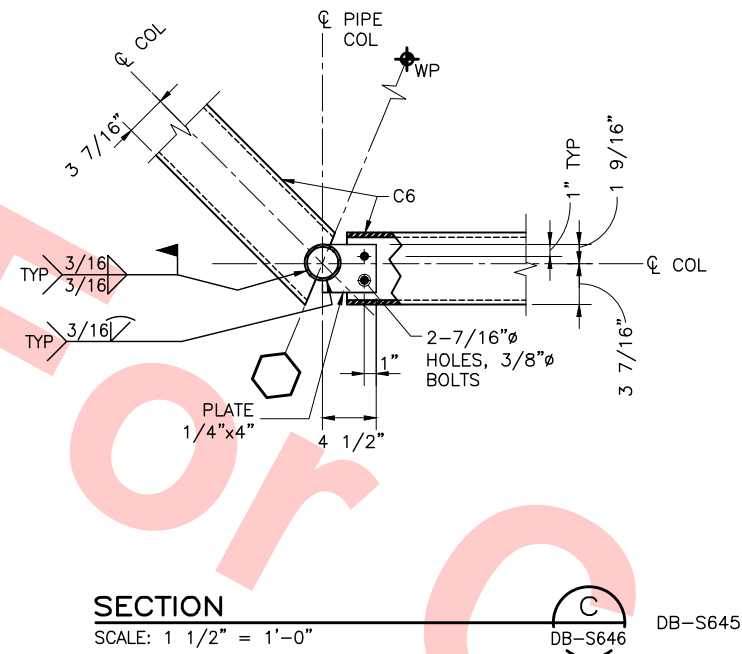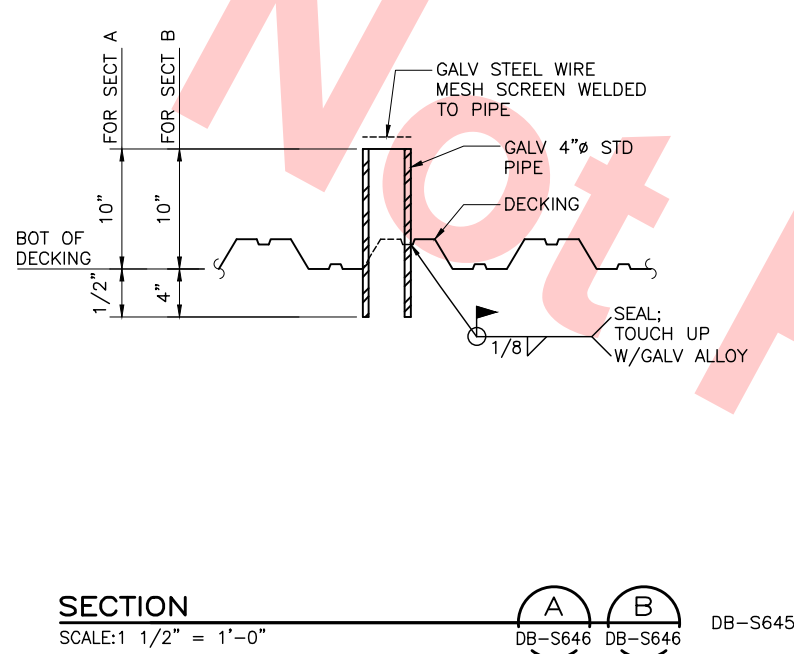

**TYP SECT ALONG DECKING PERIMETER AND OPENINGS**

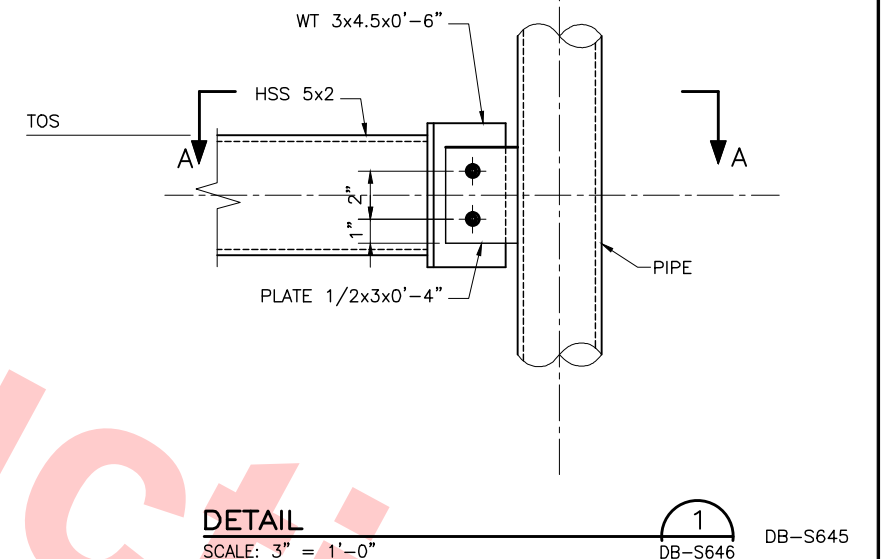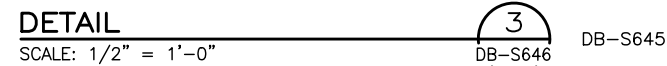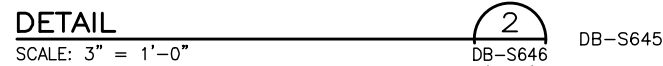

**Santa Clara Valley Transportation Authority**

**NO EXCEPTIONS TAKEN (NET)  
MAKE CORRECTIONS NOTED (MCN)  
AMEND AND RESUBMIT (A/R)**





**Any action shown above is subject to the terms of the contract and does not relieve the Contractor of any of its obligations under the contract, including design and detailing.**

**Contract No.: DB11002F**

**By: \_\_\_\_\_ Date: \_\_\_\_\_**

Jul 05, 2013 1:54pm P:\BART Berryessa Extension Line\AS - STRUCTURAL\MILPITAS WORK\6-10-2012\0700-S-DB-S646.dwg



DESIGNED BY J. REBER, S.E.	
DRAWN BY P. DIAZ	
CHECKED BY M. TARAZI	
IN CHARGE M. TARAZI	
DATE 20130710	
REV	DATE
0	20130710
BY	
SUB	
APP	
DESCRIPTION	READINESS FOR CONSTRUCTION

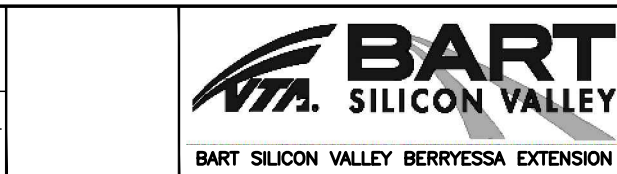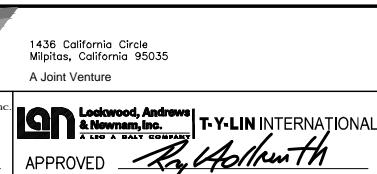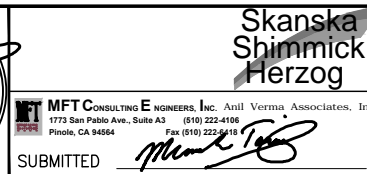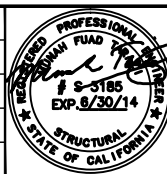

CADD FILENAME C700-S-DB-S646.dwg	
SIZE D	SCALE AS NOTED
CONTRACT NO. C700	REV. 0
AREA CODE DB	SHEET NO. S646
	PAGE NO. 0222



Jul 05, 2013 - 1:54pm P:\BART Berryessa Extension Line\AS - STRUCTURAL MILPITAS WORK\_6-10-2012\0700-S-DB-S647.dwg

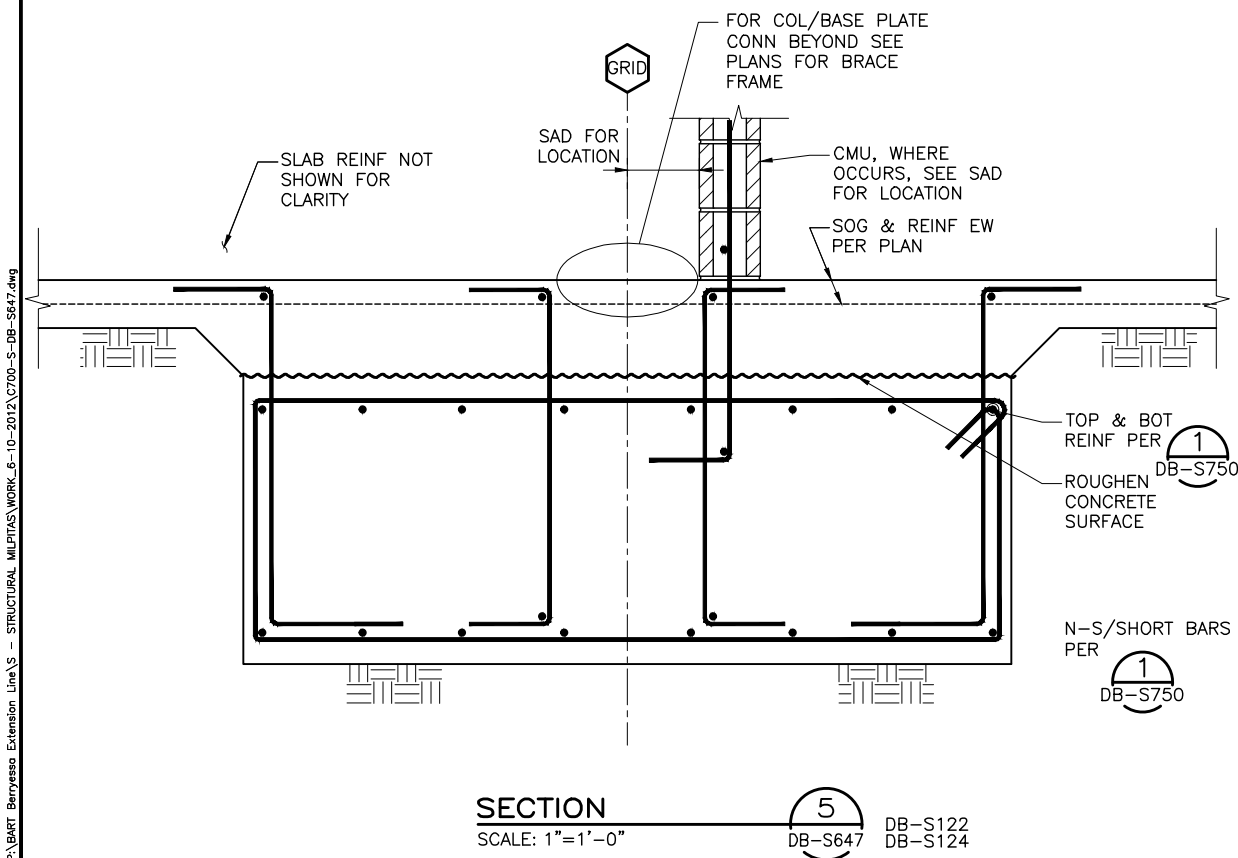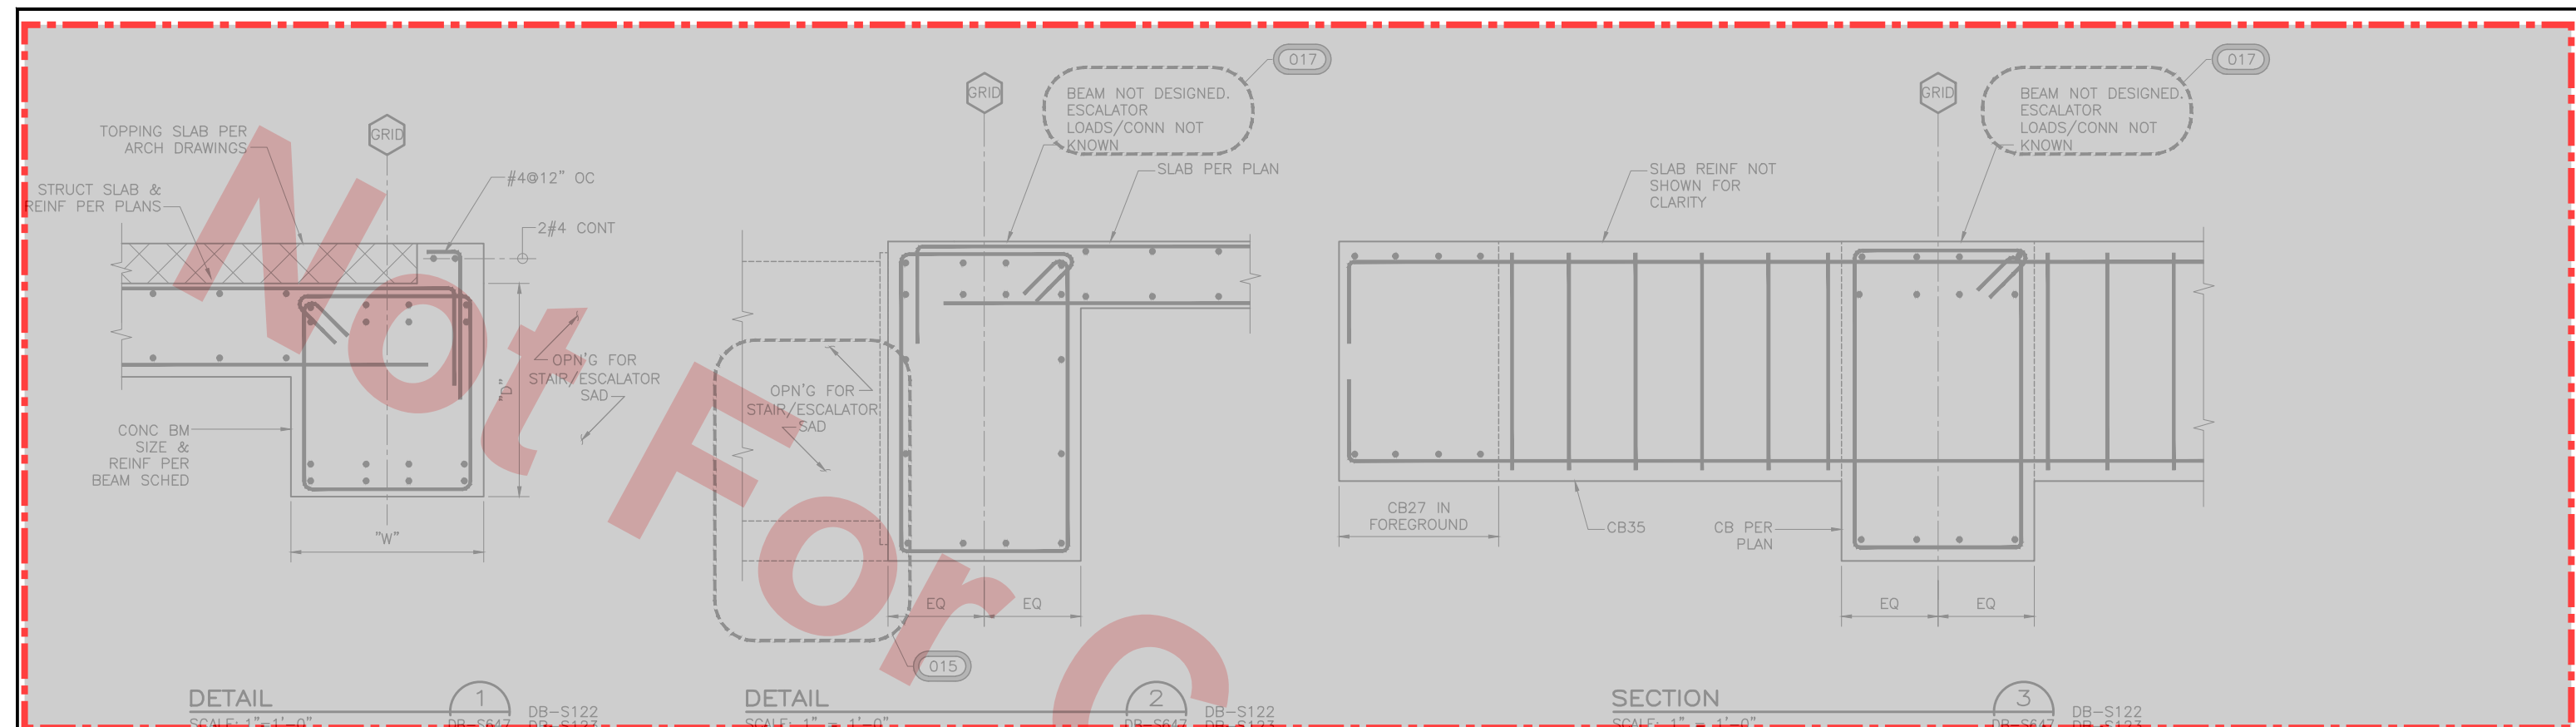

NOTE TO REVIEWER(S):  
DO NOT REVIEW AREAS DESIGNATED AS


Santa Clara Valley Transportation Authority

☐ NO EXCEPTIONS TAKEN (NET)  
☐ MAKE CORRECTIONS NOTED (MCN)  
☐ AMEND AND RESUBMIT (A/R)


Any action shown above is subject to the terms of the contract and does not relieve the Contractor of any of its obligations under the contract, including design and detailing.

Contract No.: DB11002F


By: \_\_\_\_\_ Date: \_\_\_\_\_

					DESIGNED BY J. REBER, S.E.										<p>Skanska Shimmick Herzog</p> <p>1436 California Circle Milpitas, California 95035 A Joint Venture</p> <p>MFT CONSULTING ENGINEERS, INC. Anil Verma Associates, Inc. 1773 San Pablo Ave., Suite A-5 (510) 222-6106 Pinole, CA 94664 Fax (510) 222-6118</p> <p>LOOKWOOD, ANDREWS &amp; NEWMAN, INC. A T-Y-LIN BERRYESSA EXTENSION</p> <p>T-Y-LIN INTERNATIONAL</p>				
					DRAWN BY P. DIAZ														
					CHECKED BY M. TARAZI														
					IN CHARGE M. TARAZI														
					DATE 20130710														
					SUBMITTED					APPROVED									




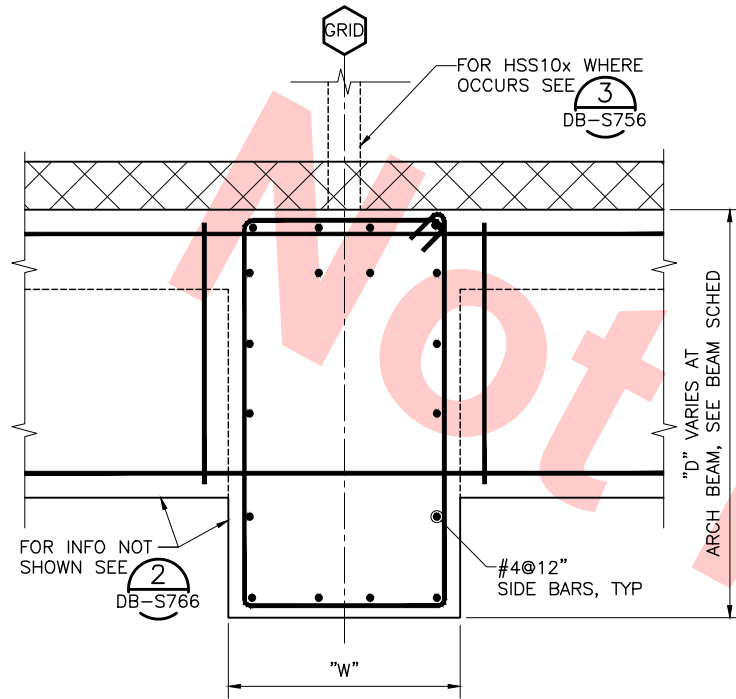


DETAIL  
SCALE: 1"=1'-0"

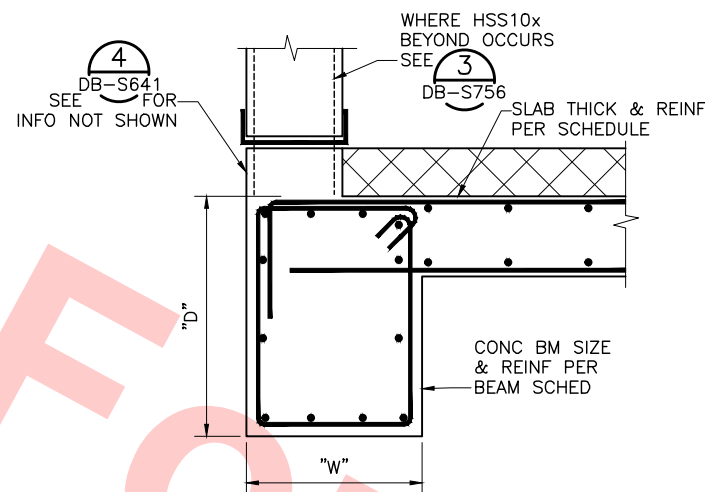


DETAIL  
SCALE: 1"=1'-0"

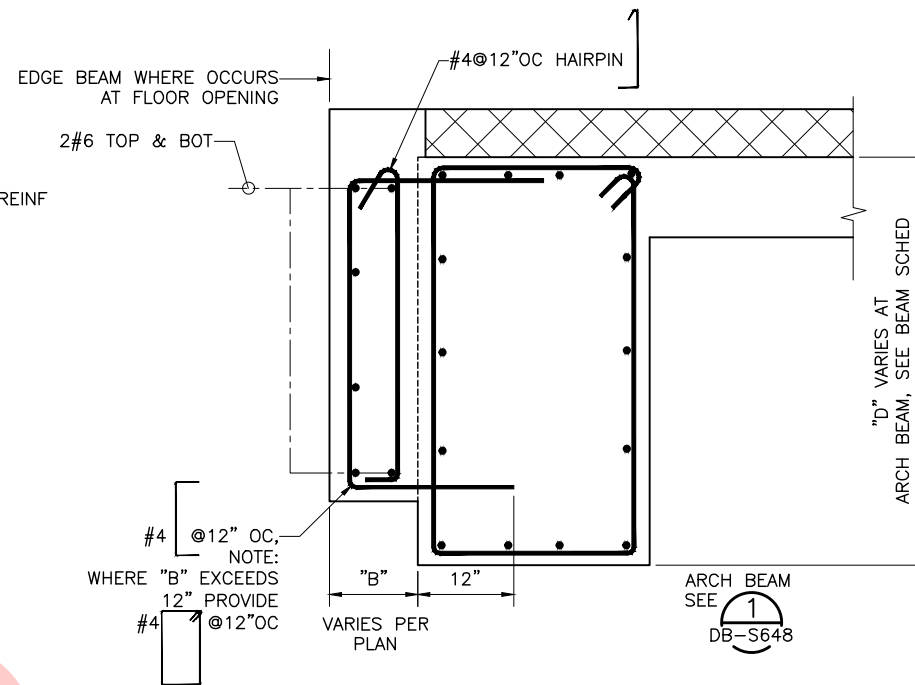


DETAIL  
SCALE: 1"=1'-0"

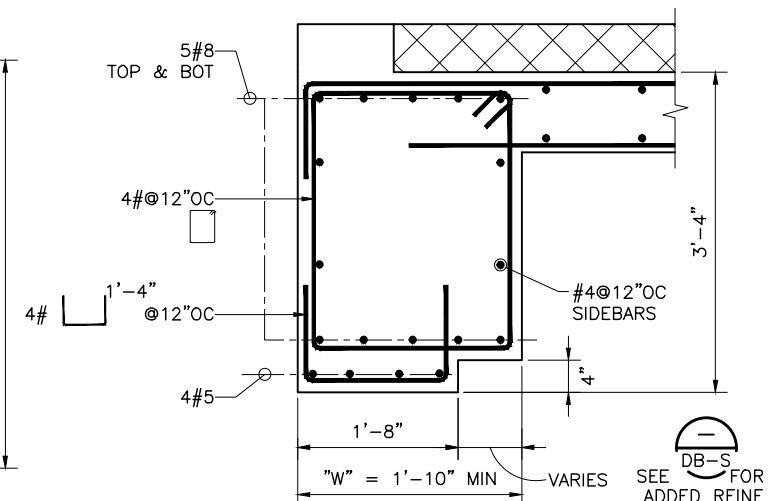


DETAIL  
SCALE: 1"=1'-0"

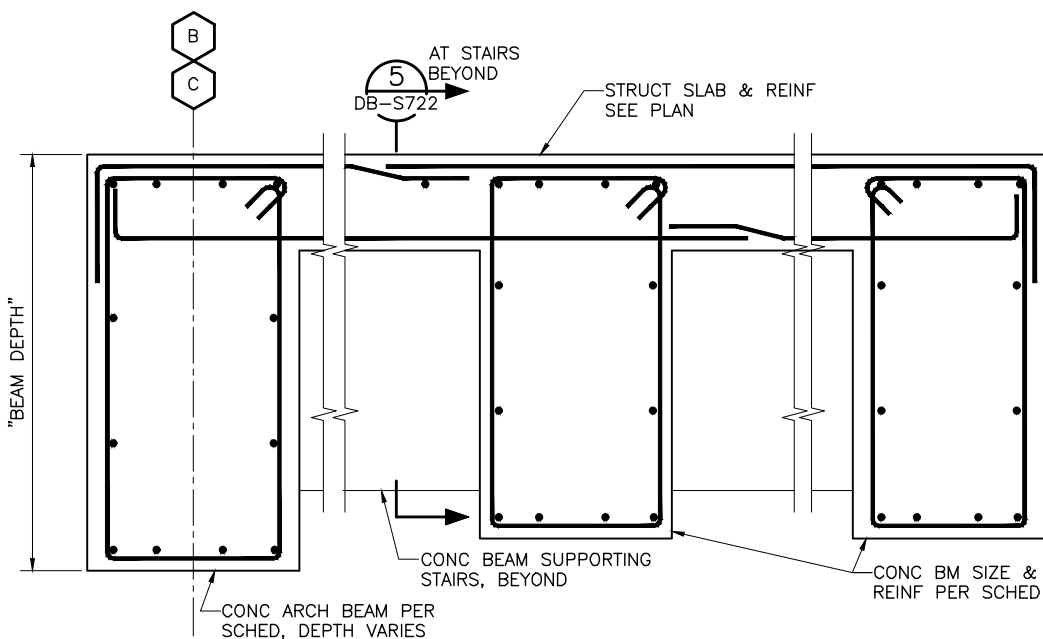

SECTION  
SCALE: 1"=1'-0"

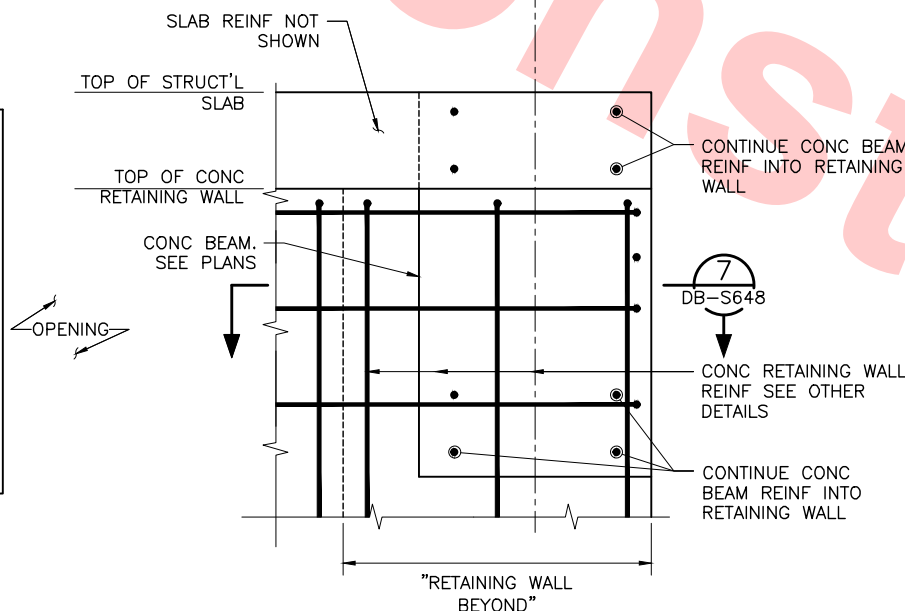

DETAIL  
SCALE: 1"=1'-0"

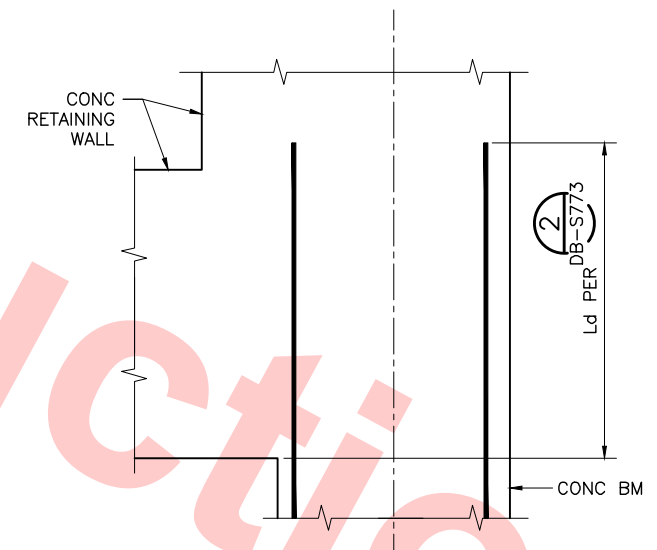


SECTION  
SCALE: 1"=1'-0"

FOR REFERENCE ONLY AND NOT FOR REVIEW.  
THIS DRAWING WAS SUBMITTED UNDER  
DU-23-WP08 TRENCH PACKAGE

Jul 05, 2013 1:54pm P:\BART Berryessa Extension Line\AS - STRUCTURAL MILPITAS WORK\6-10-2012\0700-S-DB-S648.dwg

DESIGNED BY J. REBER, S.E.	
DRAWN BY P. DIAZ	
CHECKED BY M. TARAZI	
IN CHARGE M. TARAZI	
DATE 20130531	

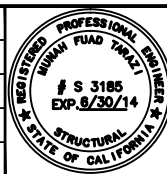



1436 California Circle Milpitas, California 95035 A Joint Venture	
MFT CONSULTING ENGINEERS, Inc. Anil Verma Associates, Inc. 1773 San Pablo Ave., Suite A3 (510) 222-4106 Pinole, CA 94664 Fax (510) 222-6419	

Skanska Shimmick Herzog	
Leonwood, Andrews & Newman, Inc. A LEO A DALY COMPANY	
T-Y-LIN INTERNATIONAL	



LINE, TRACK, STATIONS AND SYSTEMS DESIGN UNIT 023 MILPITAS STATION CONCOURSE SECTIONS AND DETAILS SHEET 8 OF 10	
CADD FILENAME C700-S-DB-S648.dwg	
SIZE SCALE D AS NOTED	
CONTRACT NO. C700	REV. 0
AREA CODE DB	SHEET NO. S648
PAGE NO. 0224	



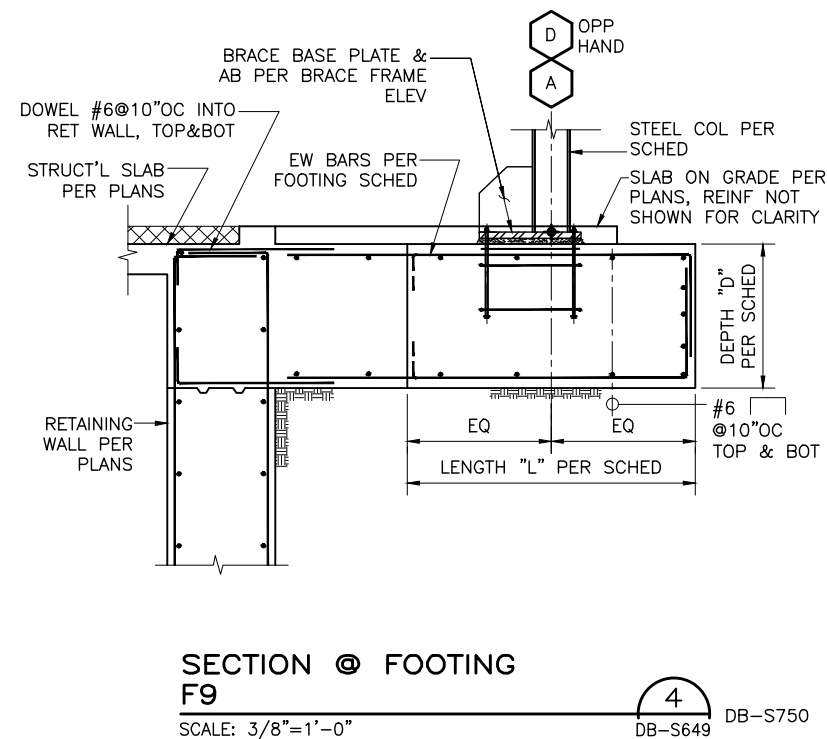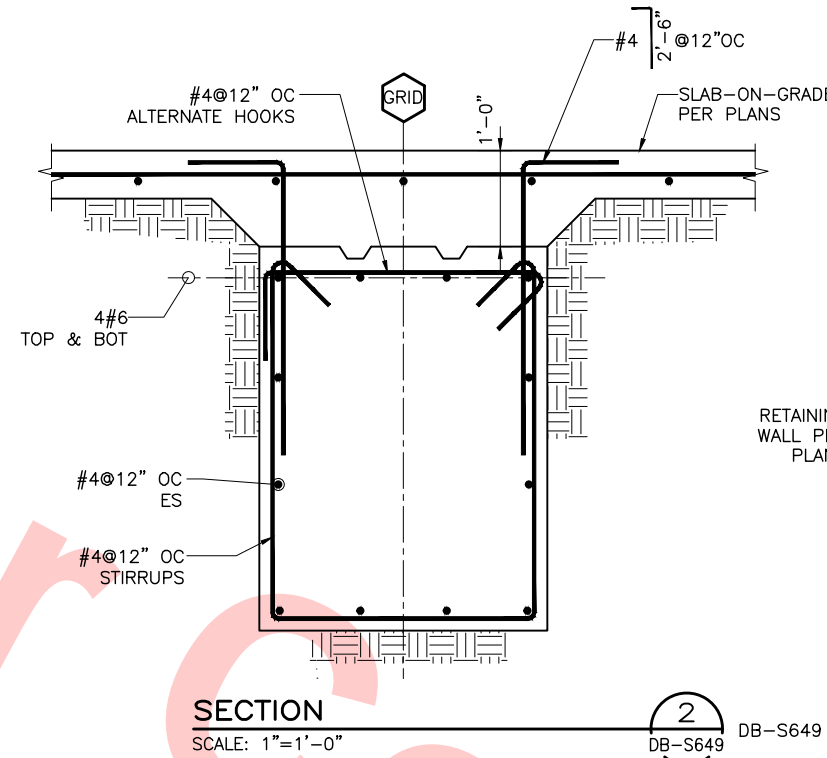

**By:** \_\_\_\_\_ **Date:** \_\_\_\_\_

CADD FILENAME C700-S-DB-S649.dwg		
SIZE D	SCALE AS NOTED	
CONTRACT NO. C700		REV. 0
AREA CODE DB	SHEET NO. S649	PAGE NO. 0225








Santa Clara Valley Transportation Authority

NO EXCEPTIONS TAKEN (NET)  
MAKE CORRECTIONS NOTED (MCN)  
AMEND AND RESUBMIT (A/R)


Any action shown above is subject to the terms of the contract  
and does not relieve the Contractor of any of its obligations  
under the contract, including design and detailing.

Contract No.: DB11002F


By: Date:

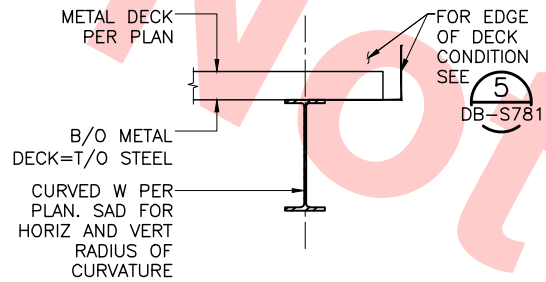


DETAIL 1  
SCALE: 1"=1'-0"

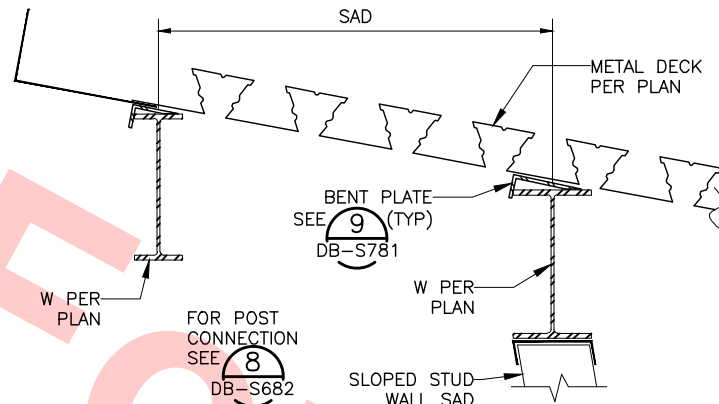


DETAIL 2  
SCALE: 1 1/2"=1'-0"

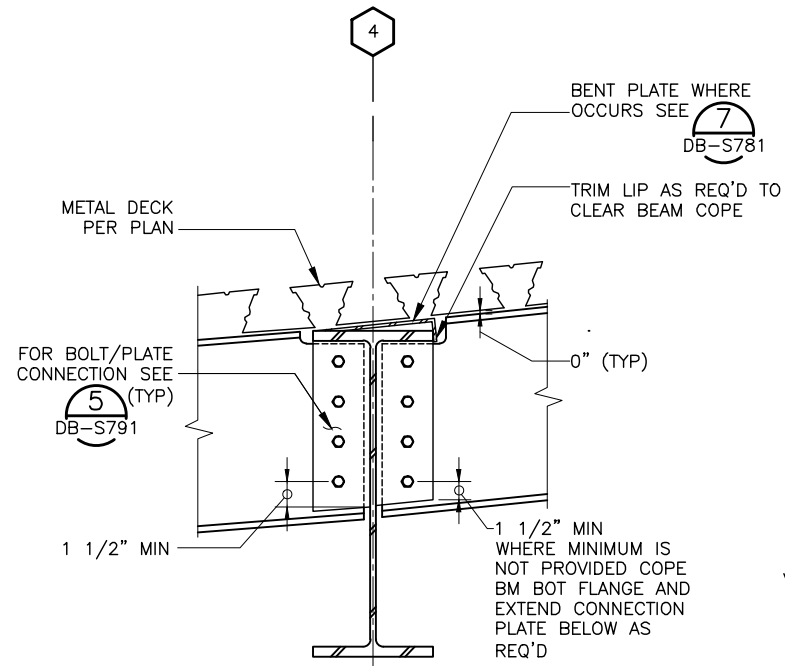


DETAIL 3  
SCALE: 1 1/2"=1'-0"

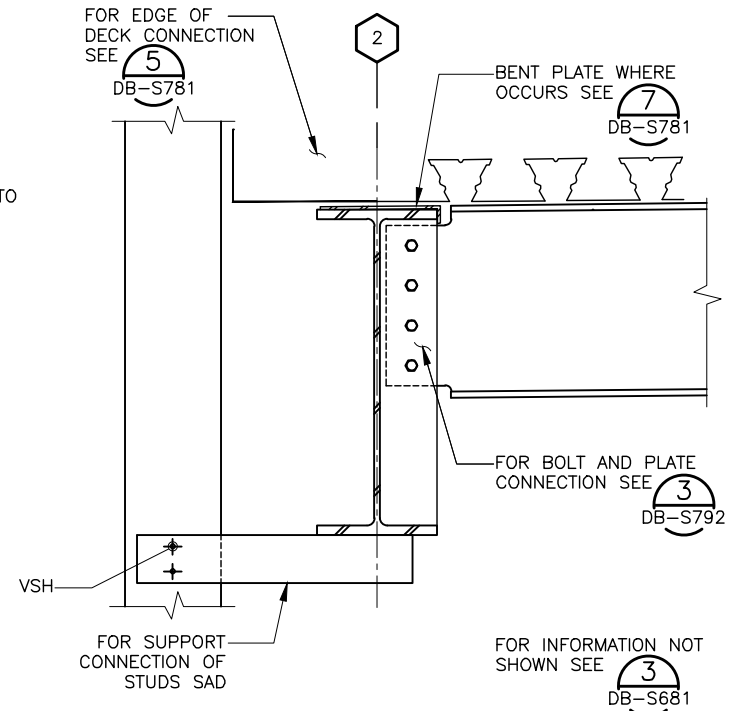


DETAIL 4  
SCALE: 1 1/2"=1'-0"

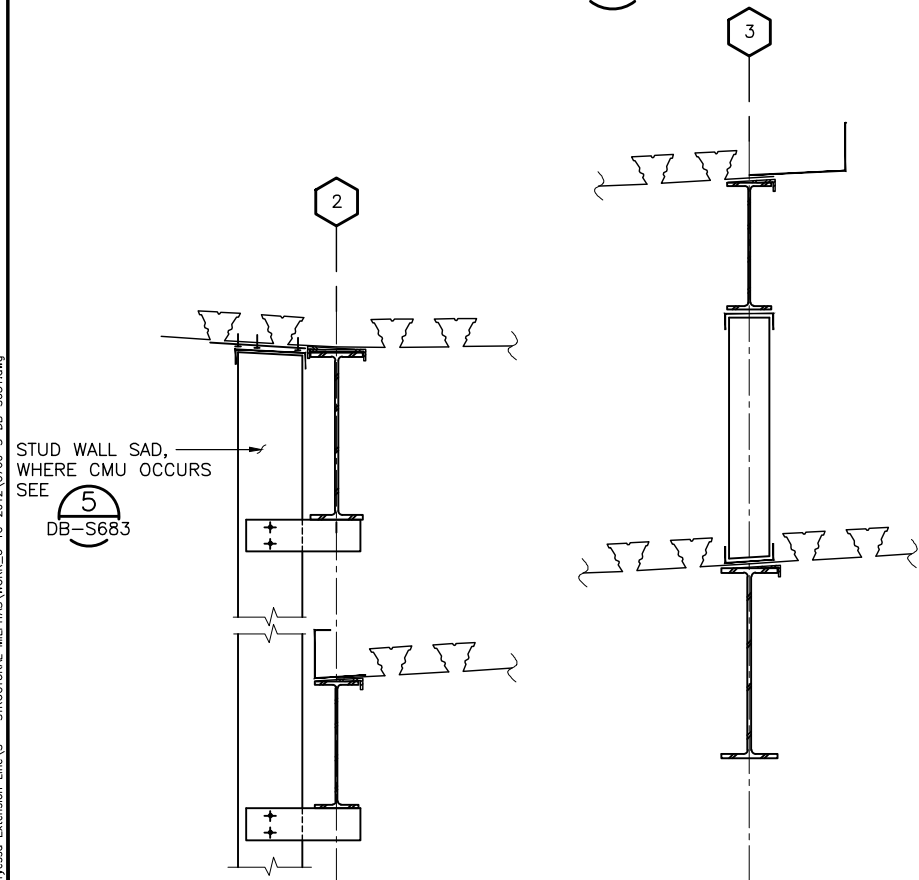

SECTION 5  
SCALE: 1"=1'-0"

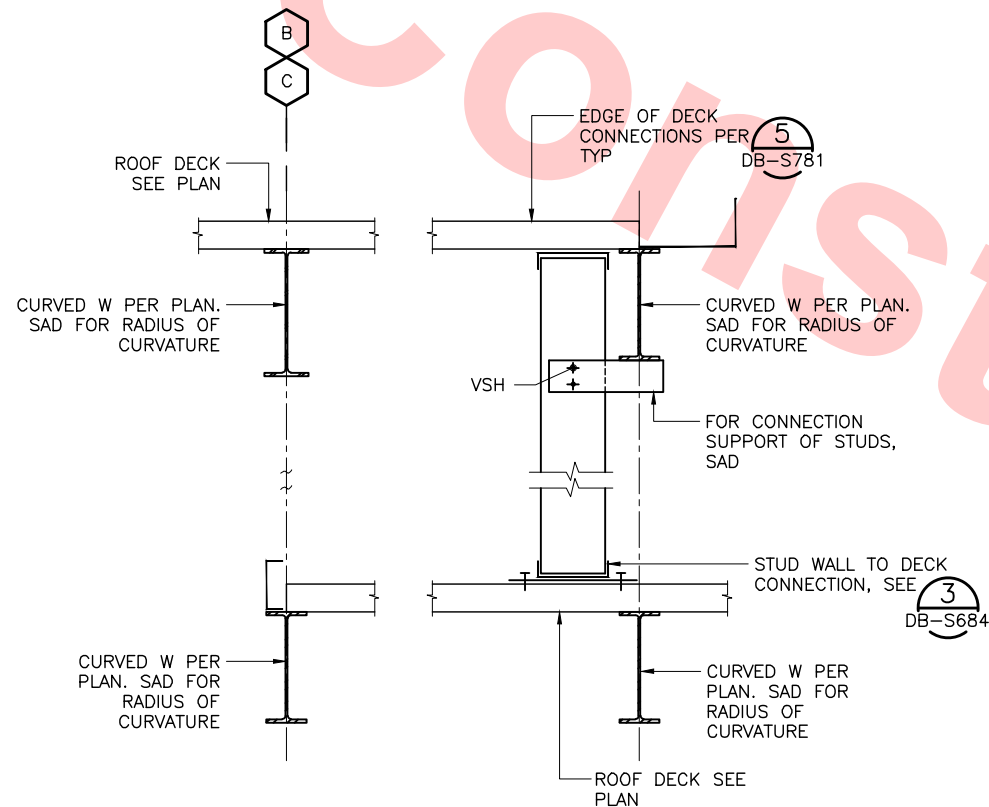

SECTION 6  
SCALE: 1"=1'-0"

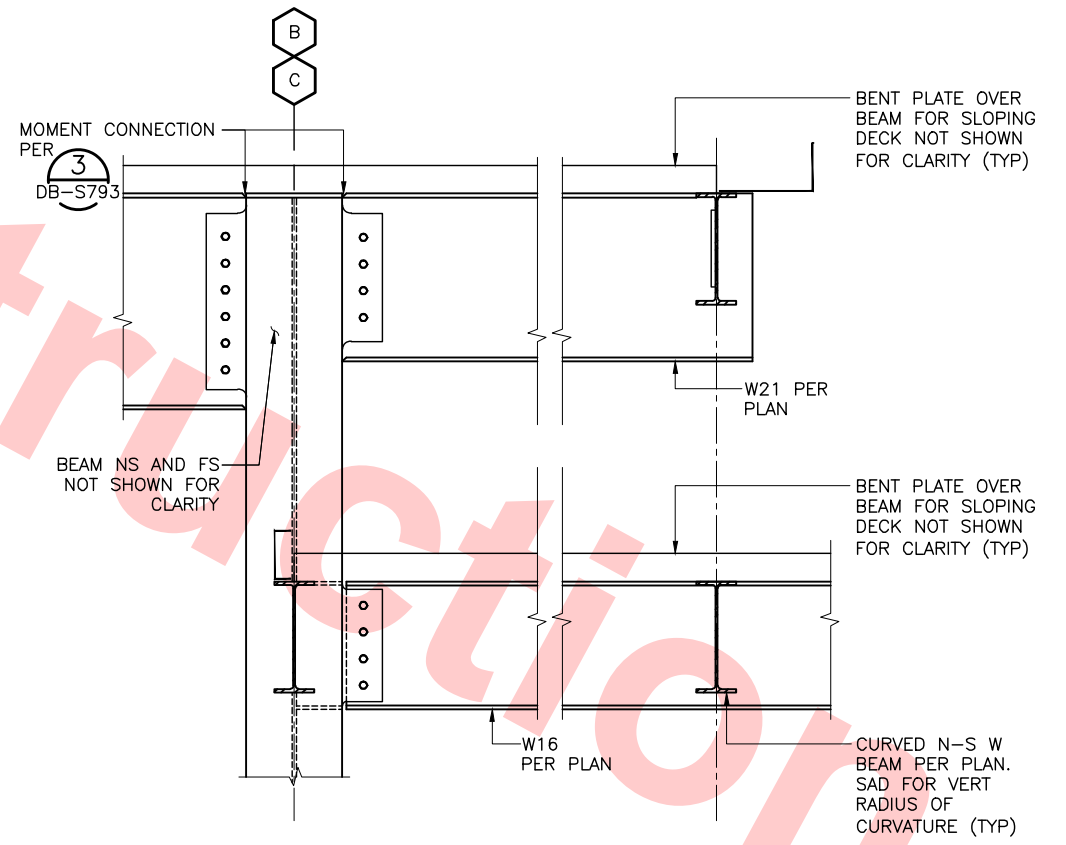

SECTION 7  
SCALE: 1"=1'-0"

Jul 05, 2013 1:55pm P:\BART Berryessa Extension Line\AS - STRUCTURAL MILPITAS WORK\6-10-2012\0700-S-DB-S681.dwg

REV	DATE	BY	SUB	APP	DESCRIPTION
0	20130710				READINESS FOR CONSTRUCTION

DESIGNED BY  
J. REBER, S.E.  
DRAWN BY  
P. DIAZ  
CHECKED BY  
M. TARAZI  
IN CHARGE  
M. TARAZI  
DATE  
20130710



Skanska  
Shimmick  
Herzog  
1436 California Circle  
Milpitas, California 95035  
A Joint Venture  
MFT CONSULTING ENGINEERS, INC. Anil Verma Associates, Inc.  
1773 San Pablo Ave., Suite A3 (510) 222-4100  
Palo Alto, CA 94304 Fax (415) 222-8410








Lealwood, Andrews  
& Newman, Inc.  
A LEAD & BALLY COMPANY  
T-Y-LIN INTERNATIONAL  
APPROVED



LINE, TRACK, STATIONS AND SYSTEMS  
DESIGN UNIT 023  
MILPITAS STATION  
DETAILS  
SHEET 1 OF 17


CADD FILENAME C700-S-DB-S681.dwg	REV. 0
SIZE SCALE D AS NOTED	REV. 0
CONTRACT NO. C700	REV. 0
AREA CODE DB	SHEET NO. S681
PAGE NO. 0227	



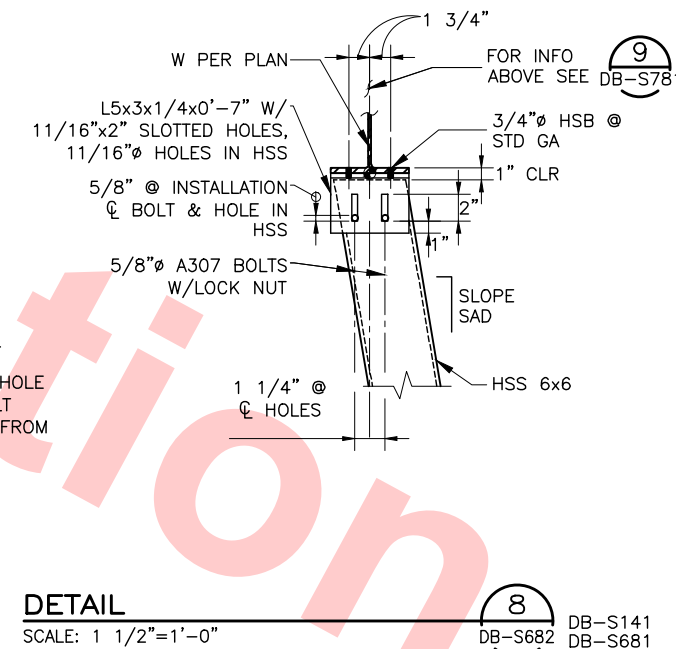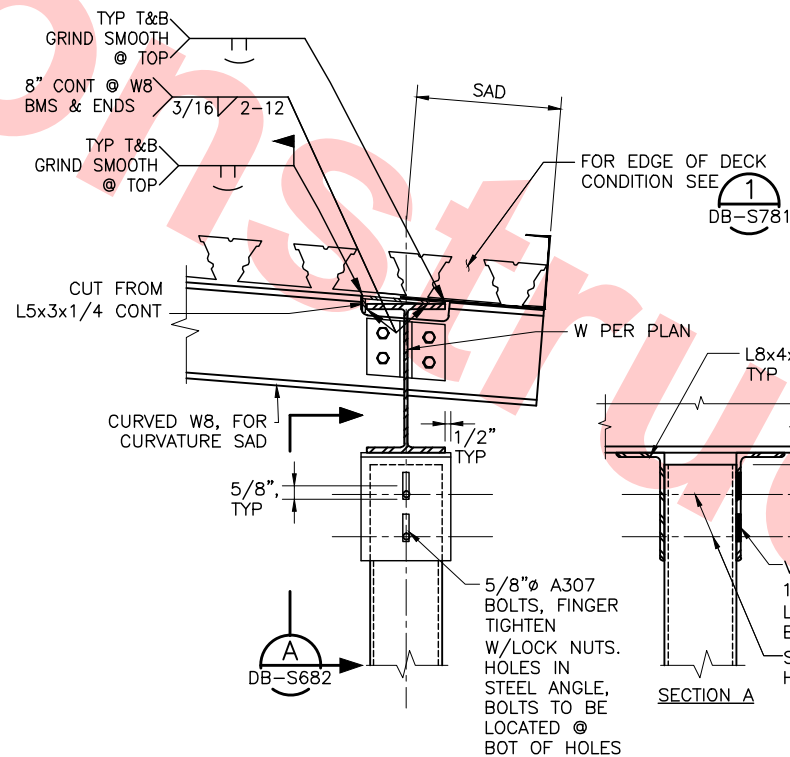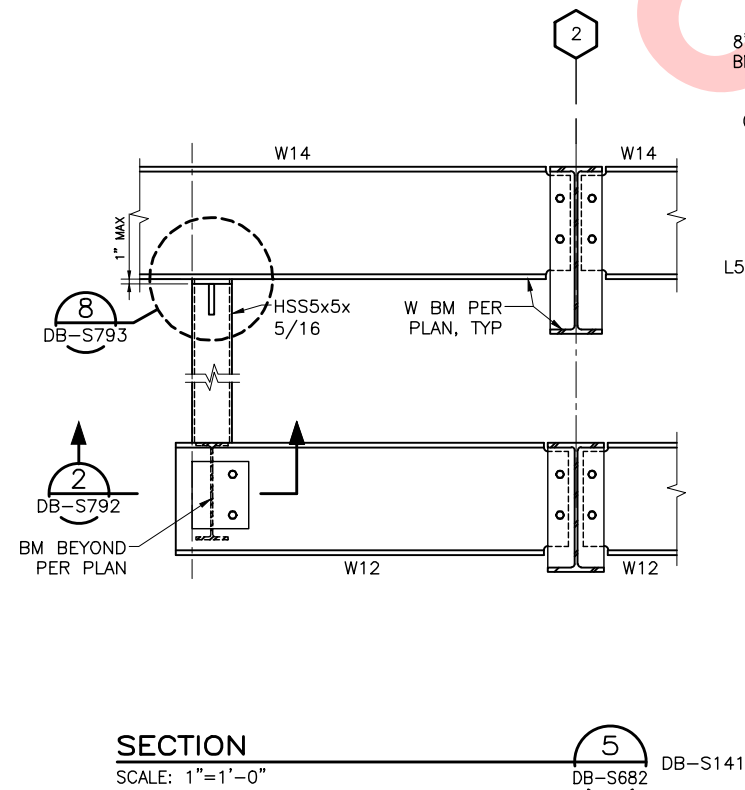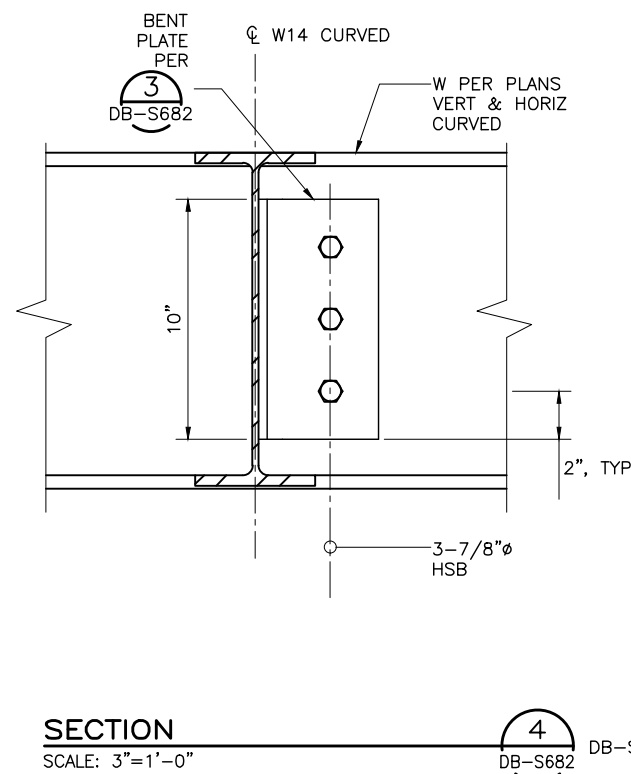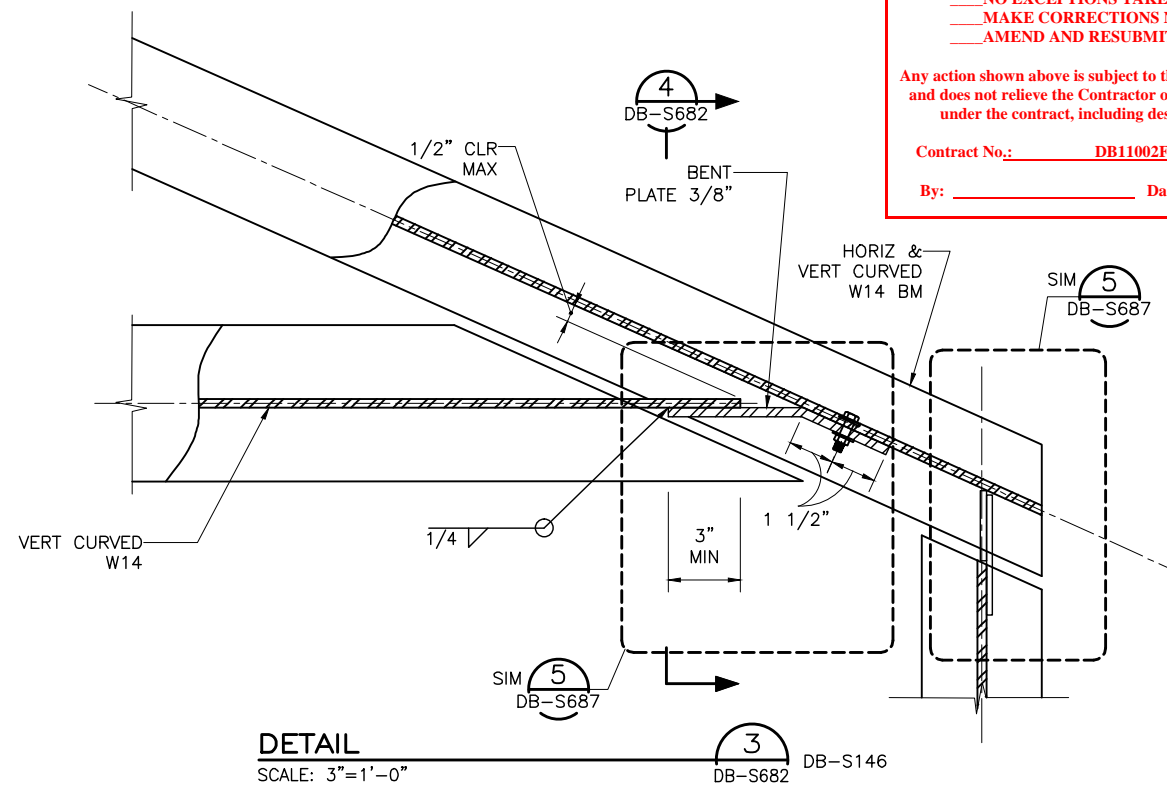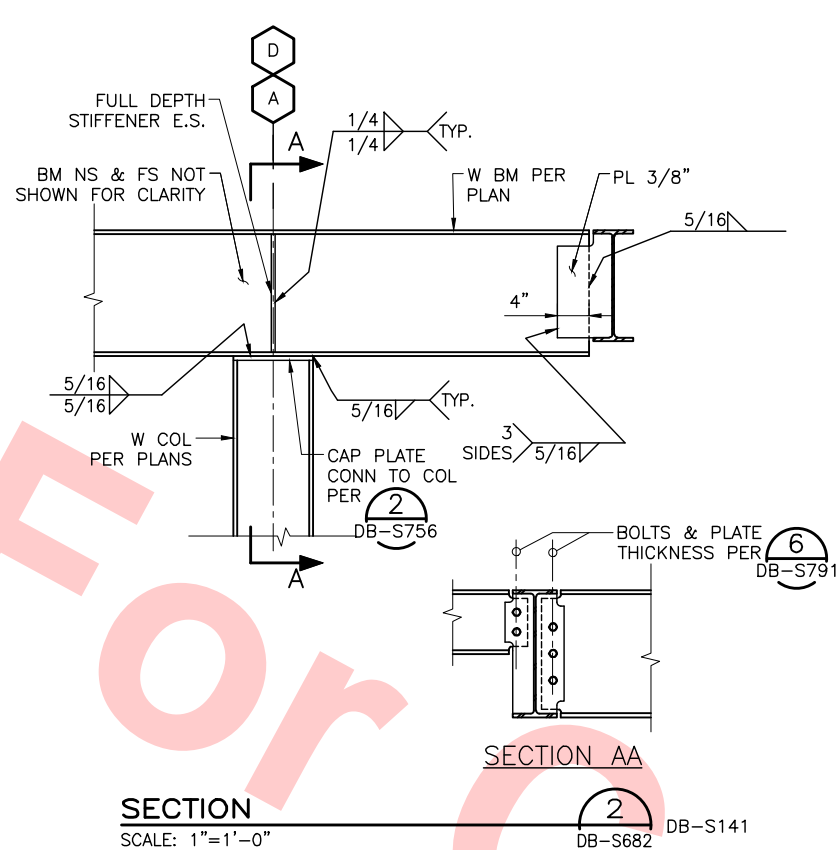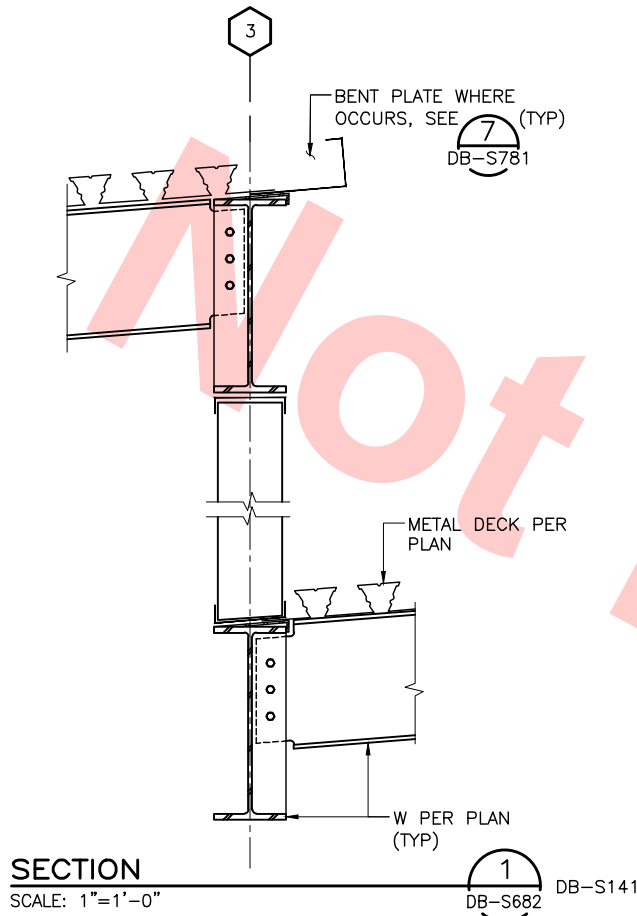

DESIGNED BY J. REBER, S.E.	
DRAWN BY P. DIAZ	
CHECKED BY M. TARAZI	
IN CHARGE M. TARAZI	
DATE 20130710	

0	20130710				READINESS FOR CONSTRUCTION
REV	DATE	BY	SUB	APP	DESCRIPTION

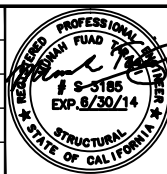

Skanska Shimmick Herzog	1436 California Circle Milpitas, California 95035 A Joint Venture
MFT CONSULTING ENGINEERS, INC. Anil Verma Associates, Inc. 1773 San Pablo Ave., Suite A3 (510) 222-4100 Palo Alto, CA 94304 Fax (415) 222-8410	Loebwood, Andrews & Newman, Inc. T-Y-LIN INTERNATIONAL A LEO A DALY COMPANY
SUBMITTED	APPROVED




LINE, TRACK, STATIONS AND SYSTEMS DESIGN UNIT 023 MILPITAS STATION DETAILS
SHEET 2 OF 17


CADD FILENAME C700-S-DB-S682.dwg	
SIZE SCALE D AS NOTED	
CONTRACT NO. C700	REV. 0
AREA CODE DB	SHEET NO. S682
	PAGE NO. 0228




Jul 05, 2013 1:55pm P:\BART Berryessa Extension Line\A5 - STRUCTURAL MILPITAS WORK\_6-10-2012\CT00-S-DB-S683.dwg

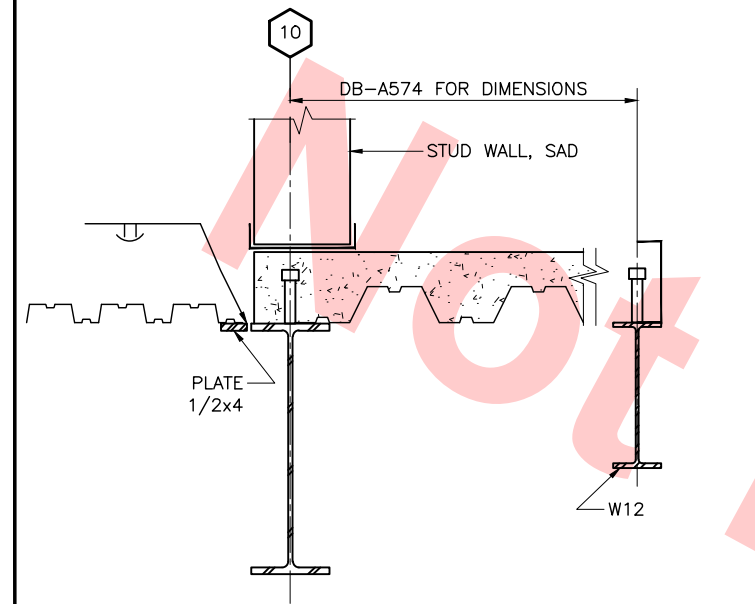


DETAIL 1  
SCALE: 1 1/2"=1'-0"  
DB-S132  
DB-S683

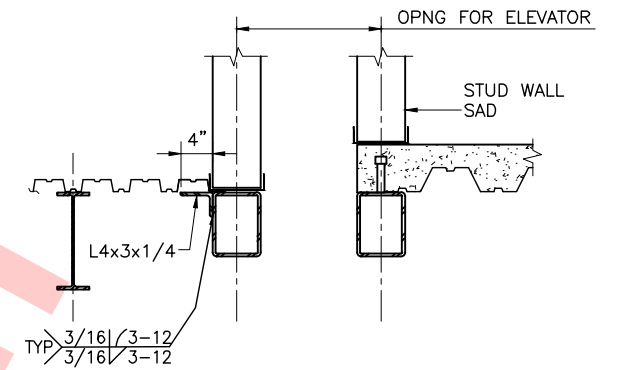


SECTION 2  
SCALE: 1"=1'-0"  
DB-S132  
DB-S683

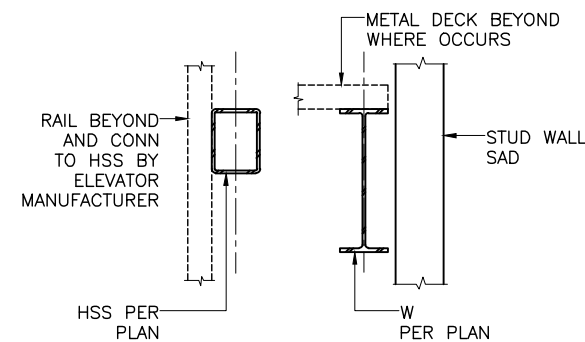

DETAIL 3  
SCALE: 1"=1'-0"  
DB-S135  
DB-S683

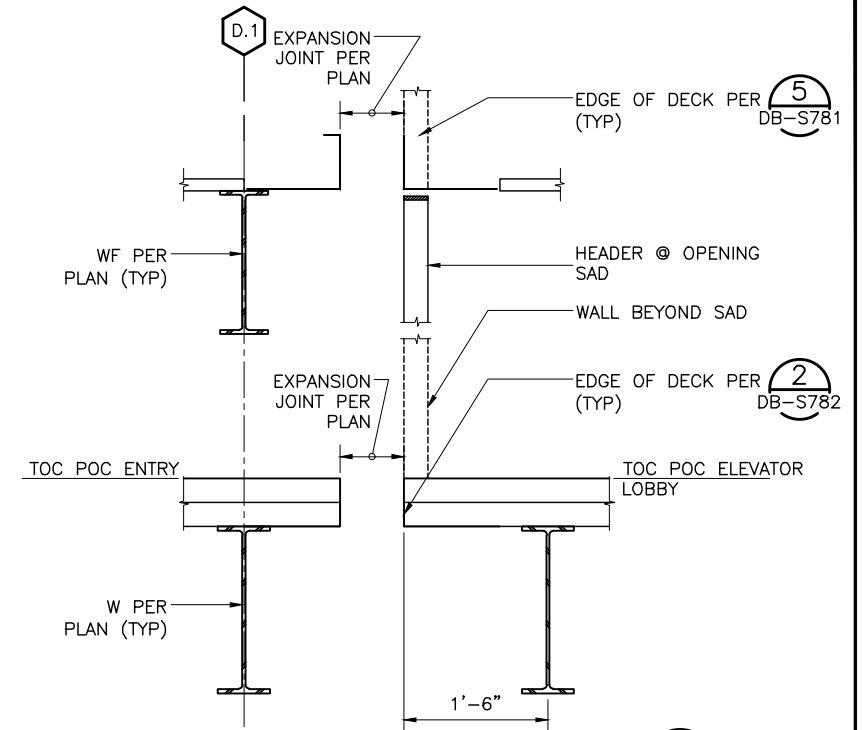

SECTION 4  
SCALE: 1"=1'-0"  
DB-S132  
DB-S683

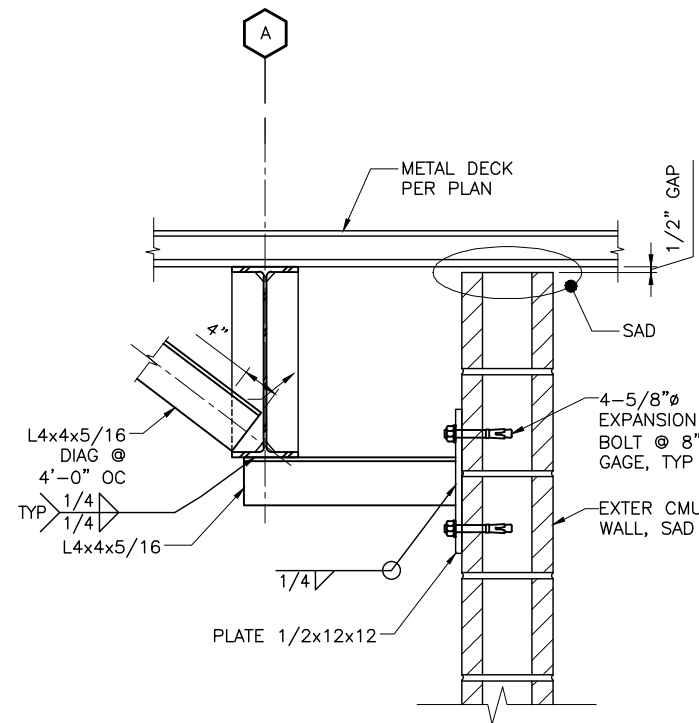

DETAIL 5  
SCALE: 1 1/2"=1'-0"  
DB-S141  
DB-S683

Santa Clara Valley Transportation Authority

NO EXCEPTIONS TAKEN (NET)  
MAKE CORRECTIONS NOTED (MCN)  
AMEND AND RESUBMIT (A/R)

Any action shown above is subject to the terms of the contract and does not relieve the Contractor of any of its obligations under the contract, including design and detailing.

Contract No.: DB11002F

By: \_\_\_\_\_ Date: \_\_\_\_\_

REV	DATE	BY	SUB	APP	DESCRIPTION
0	20130710				READINESS FOR CONSTRUCTION

DESIGNED BY J. REBER, S.E.	
DRAWN BY P. DIAZ	
CHECKED BY M. TARAZI	
IN CHARGE M. TARAZI	
DATE 20130710	

Skanska Shimmick Herzog

1436 California Circle  
Milpitas, California 95035  
A Joint Venture

MFT CONSULTING ENGINEERS, Inc. Anil Verma Associates, Inc.  
1773 San Pablo Ave., Suite A3 (510) 222-4100  
Palo Alto, CA 94304 Fax (650) 222-8410

Lealwood, Andrews & Newman, Inc. T-Y-LIN INTERNATIONAL  
A LEAD & BALLY COMPANY

SUBMITTED APPROVED




LINE, TRACK, STATIONS AND SYSTEMS  
DESIGN UNIT 023  
MILPITAS STATION  
DETAILS  
SHEET 3 OF 17


CADD FILENAME C700-S-DB-S683.dwg	REV. 0
SIZE SCALE D AS NOTED	
CONTRACT NO. C700	
AREA CODE DB	SHEET NO. S683
PAGE NO. 0229	




Jul 05, 2013 - 1:55pm P:\BART Berryessa Extension Line\5 - STRUCTURAL MILPITAS WORK\_6-10-2012\0700-S-DB-S684.dwg  
c04-02

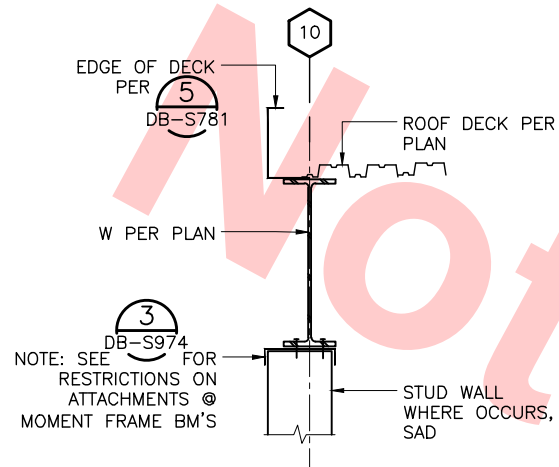

DETAIL 1  
SCALE: 1"=1'-0"  
DB-S149

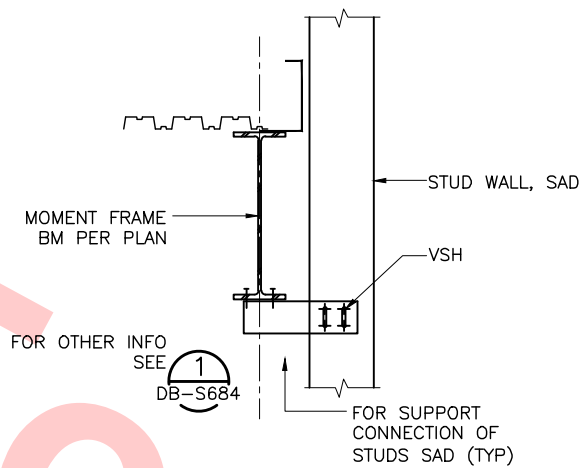

DETAIL 2  
SCALE: 1"=1'-0"  
DB-S684

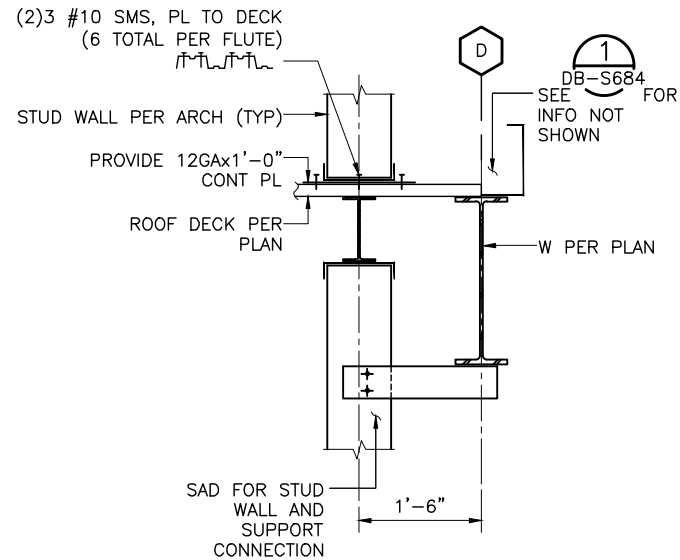

DETAIL 3  
SCALE: 1"=1'-0"  
DB-S684

Santa Clara Valley Transportation Authority

NO EXCEPTIONS TAKEN (NET)  
MAKE CORRECTIONS NOTED (MCN)  
AMEND AND RESUBMIT (A/R)


Any action shown above is subject to the terms of the contract and does not relieve the Contractor of any of its obligations under the contract, including design and detailing.

Contract No.: DB11002F

By: \_\_\_\_\_ Date: \_\_\_\_\_

REV	DATE	BY	SUB	APP	DESCRIPTION
0	20130710				READINESS FOR CONSTRUCTION

DESIGNED BY  
J. REBER, S.E.  
DRAWN BY  
P. DIAZ  
CHECKED BY  
M. TARAZI  
IN CHARGE  
M. TARAZI  
DATE  
20130710

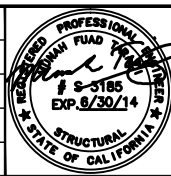

Skanska  
Shimmick  
Herzog  
1436 California Circle  
Milpitas, California 95035  
A Joint Venture  
MFT CONSULTING ENGINEERS, INC. Anil Verma Associates, Inc.  
1773 San Pablo Ave., Suite A3 (510) 222-4100  
Palo Alto, CA 94304 Fax (415) 222-8410


Lealwood, Andrews & Newman, Inc.  
T-Y-LIN INTERNATIONAL  
APPROVED



LINE, TRACK, STATIONS AND SYSTEMS  
DESIGN UNIT 023  
MILPITAS STATION  
DETAILS  
SHEET 4 OF 17


CADD FILENAME C700-S-DB-S684.dwg	CONTRACT NO. C700	REV. 0
SIZE D	SCALE AS NOTED	AREA CODE DB
SHEET NO. S684	PAGE NO. 0230	



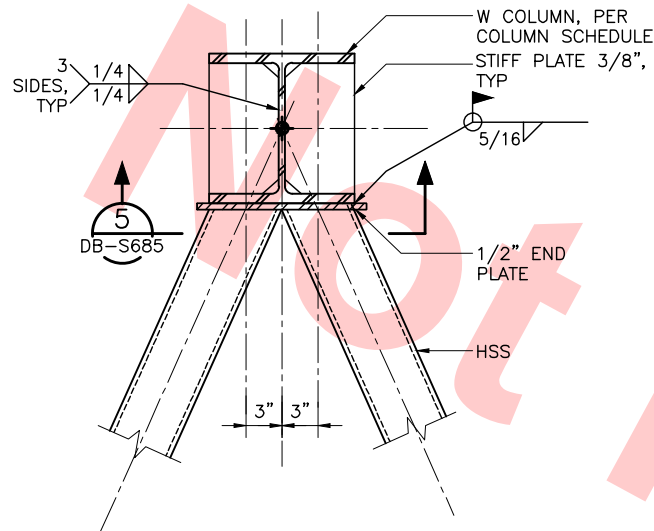


**DETAIL PLAN**  
SCALE: 1 1/2"=1'-0"

1 DB-S685

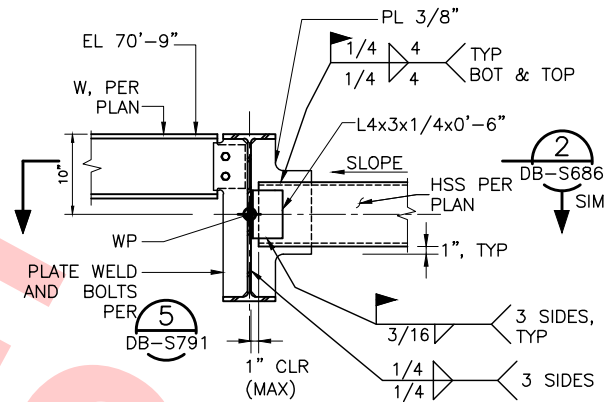


**DETAIL**  
SCALE: 1"=1'-0"

2 DB-S686

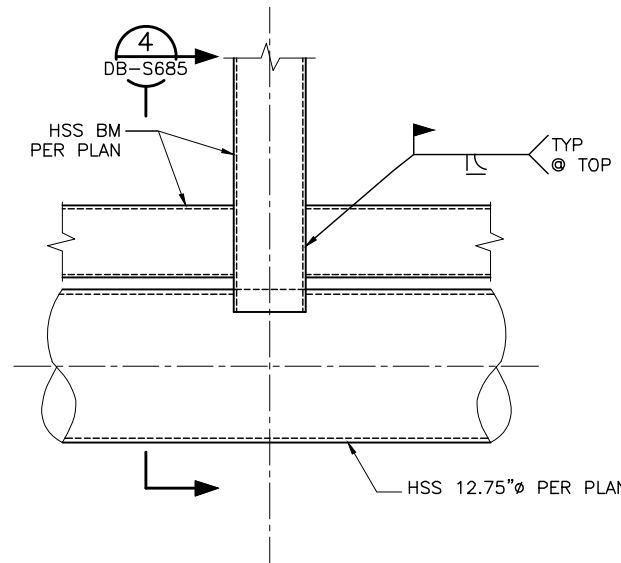

**DETAIL PLAN**  
SCALE: 1 1/2"=1'-0"

3 DB-S685

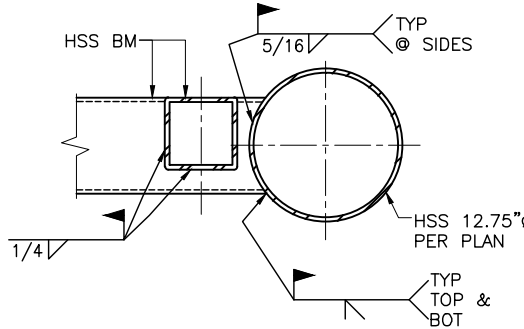

**SECTION DETAIL**  
SCALE: 1 1/2"=1'-0"

4 DB-S685


**Santa Clara Valley Transportation Authority**

\_\_\_NO EXCEPTIONS TAKEN (NET)  
\_\_\_MAKE CORRECTIONS NOTED (MCN)  
\_\_\_AMEND AND RESUBMIT (A/R)

Any action shown above is subject to the terms of the contract and does not relieve the Contractor of any of its obligations under the contract, including design and detailing.


Contract No.: **DB11002F**

By: \_\_\_\_\_ Date: \_\_\_\_\_

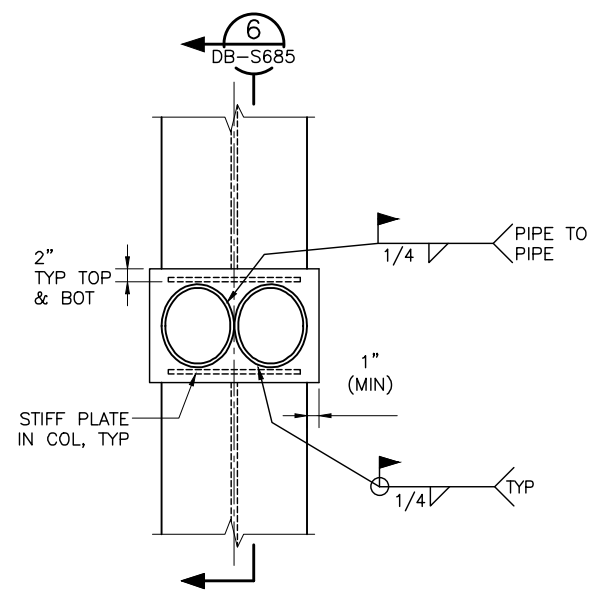


**DETAIL**  
SCALE: 1 1/2"=1'-0"

5 DB-S685

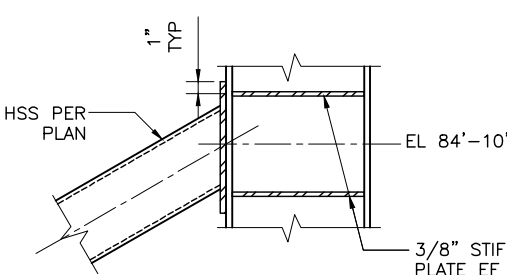


**SECTION**  
SCALE: 1 1/2"=1'-0"

6 DB-S685

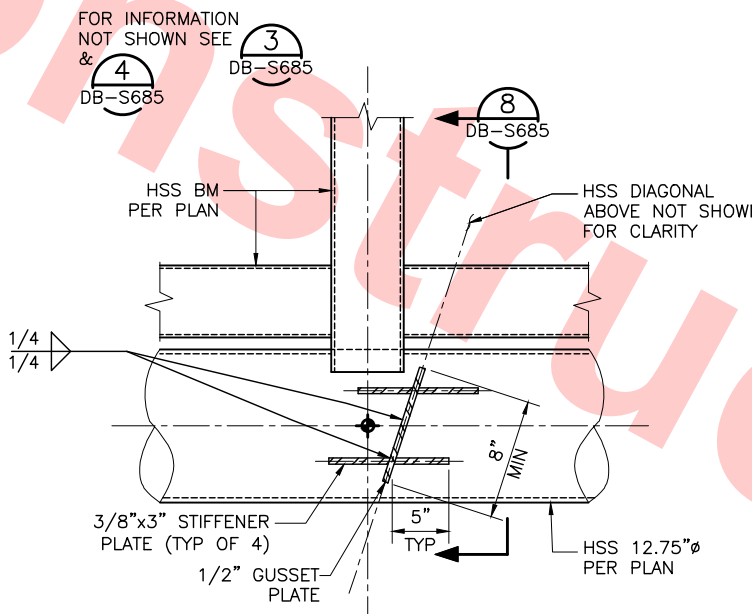

**DETAIL PLAN**  
SCALE: 1 1/2"=1'-0"

7 DB-S685

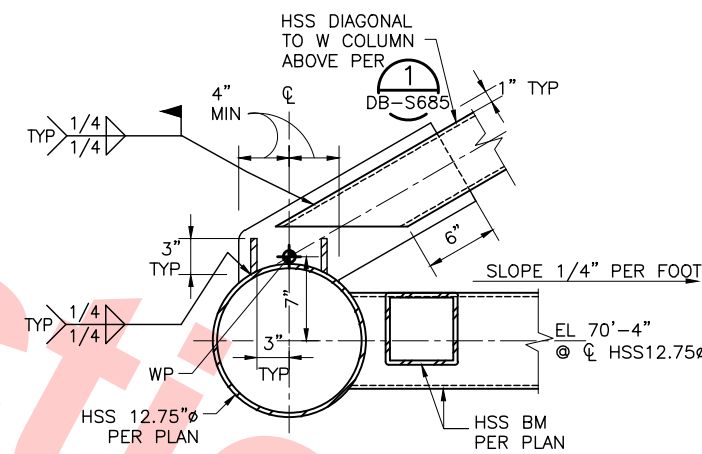

**SECTION DETAIL**  
SCALE: 1 1/2"=1'-0"

8 DB-S685

Jul 05, 2013 1:55pm P:\BART Berryessa Extension Line\AS - STRUCTURAL MILPITAS WORK\6-10-2012\0700-S-DB-S685.dwg

REV	DATE	BY	SUB	APP	DESCRIPTION
0	20130710				READINESS FOR CONSTRUCTION

DESIGNED BY  
J. REBER, S.E.

DRAWN BY  
P. DIAZ

CHECKED BY  
M. TARAZI

IN CHARGE  
M. TARAZI

DATE  
20130710



**Skanska Shimmick Herzog**

1436 California Circle  
Milpitas, California 95035  
A Joint Venture

MFT CONSULTING ENGINEERS, Inc. Anil Verma Associates, Inc.  
1773 San Pablo Ave., Suite A3 (510) 222-4100  
Pinole, CA 94664 Fax (510) 222-8410

**Lealwood, Andrews & Newman, Inc.**  
A LEAD & BALLY COMPANY

**T-Y-LIN INTERNATIONAL**




**LINE, TRACK, STATIONS AND SYSTEMS**  
**DESIGN UNIT 023**  
MILPITAS STATION  
DETAILS

SHEET 5 OF 17

CADD FILENAME C700-S-DB-S685.dwg	REV. 0
SIZE D	SCALE AS NOTED
CONTRACT NO. C700	SHEET NO. S685
AREA CODE DB	PAGE NO. 0231



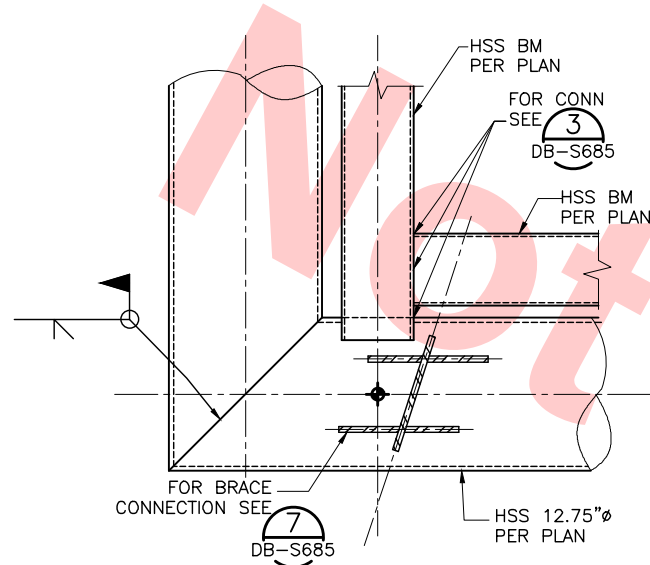


DETAIL PLAN

SCALE: 1 1/2"=1'-0"

1

DB-S686 DB-S132

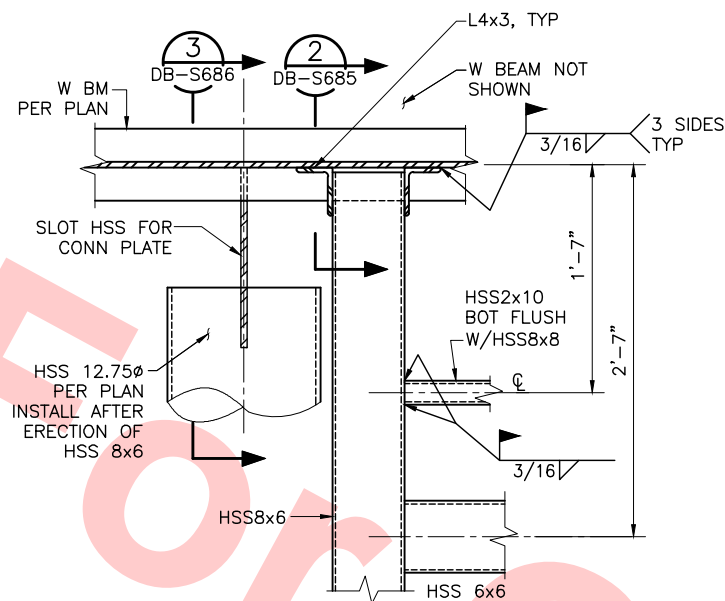


DETAIL PLAN

SCALE: 1 1/2"=1'-0"

2

DB-S686 DB-S132 DB-S212 DB-S685

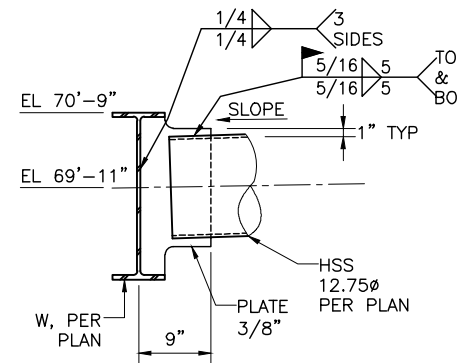


DETAIL

SCALE: 1"=1'-0"

3

DB-S686 DB-S686

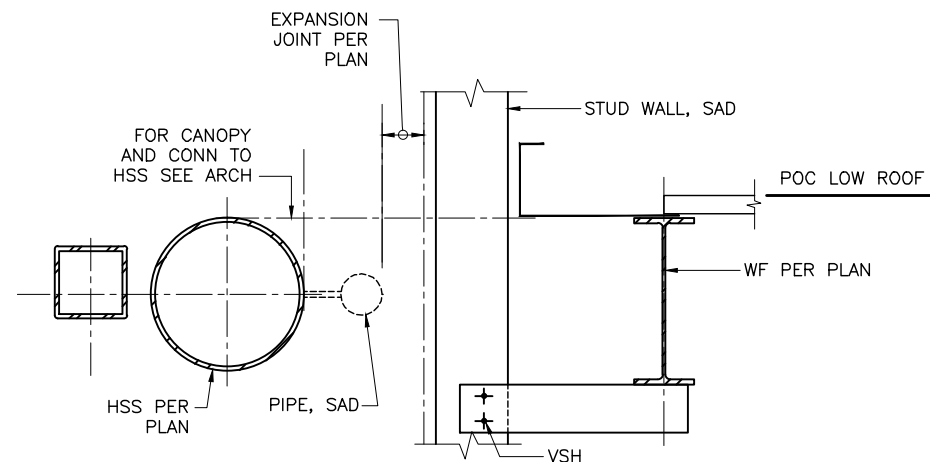


DETAIL

SCALE: 1 1/2"=1'-0"

4

DB-S686 DB-S132

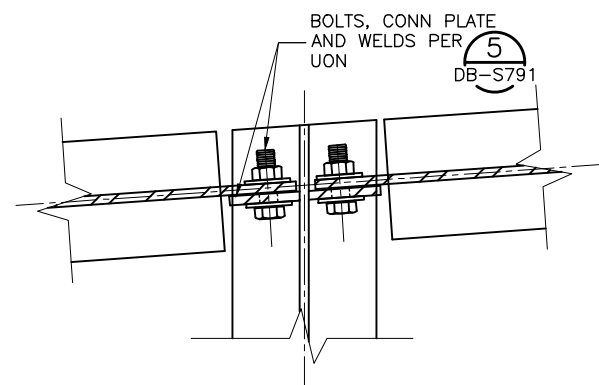


SECTION

SCALE: 3"=1'-0"

5

DB-S686 DB-S141 DB-S142 DB-S131 DB-S132 DB-S686

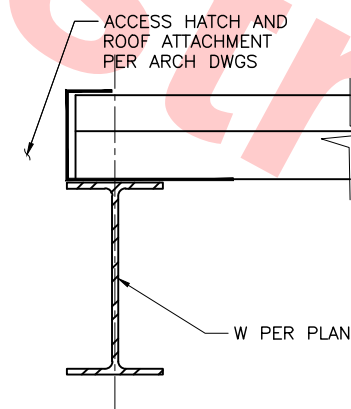


DETAIL

SCALE: 3"=1'-0"

6

DB-S686 DB-S142 DB-S143 DB-S144 DB-S145

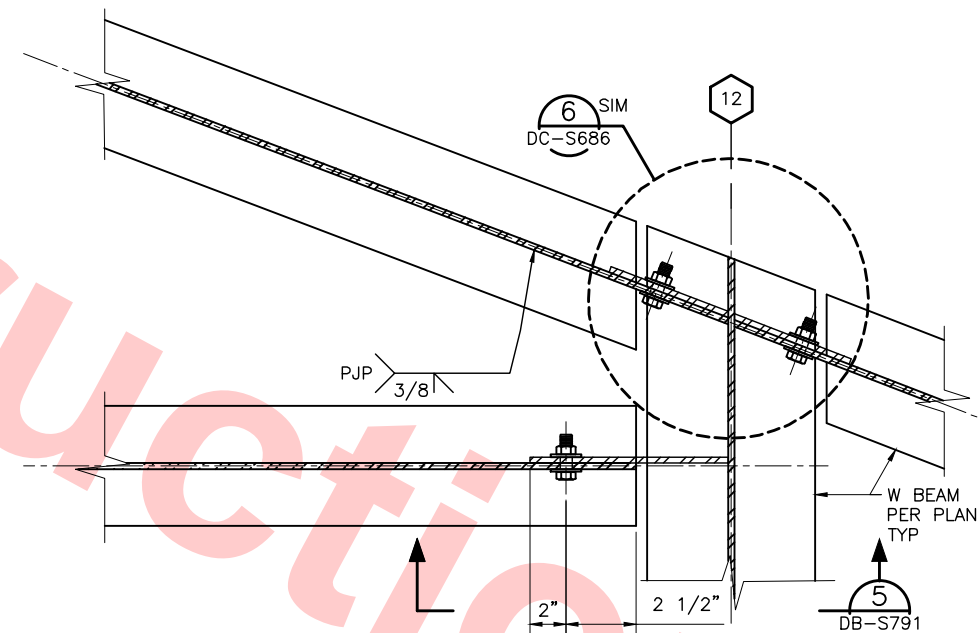

DETAIL

SCALE: 3"=1'-0"

7

DB-S686 DB-S145 DB-S144

Santa Clara Valley Transportation Authority

NO EXCEPTIONS TAKEN (NET)  
MAKE CORRECTIONS NOTED (MCN)  
AMEND AND RESUBMIT (A/R)


Any action shown above is subject to the terms of the contract and does not relieve the Contractor of any of its obligations under the contract, including design and detailing.

Contract No.: DB11002F

By: Date:

Jul 05, 2013 1:55pm P:\BART Berryessa Extension Line\AS - STRUCTURAL\MILPITAS WORK\6-10-2012\0700-S-DB-S686.dwg

DESIGNED BY J. REBER, S.E.	
DRAWN BY P. DIAZ	
CHECKED BY M. TARAZI	
IN CHARGE M. TARAZI	
DATE 20130710	
0	20130710
REV	DATE
BY	SUB
APP	DESCRIPTION
	READINESS FOR CONSTRUCTION

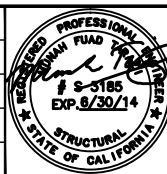

Skanska  
Shimmick  
Herzog

1436 California Circle  
Milpitas, California 95035  
A Joint Venture

MFT CONSULTING ENGINEERS, INC. Anil Verma Associates, Inc.  
1773 San Pablo Ave., Suite A3 (510) 222-4100  
Palo Alto, CA 94304 Fax (415) 222-8410

Lealwood, Andrews & Newman, Inc.  
A LEAD & BALLY COMPANY


BART  
SILICON VALLEY  
BART SILICON VALLEY BERRYESSA EXTENSION

LINE, TRACK, STATIONS AND SYSTEMS  
DESIGN UNIT 023  
MILPITAS STATION  
DETAILS  
SHEET 6 OF 17

CADD FILENAME C700-S-DB-S686.dwg	
SIZE D	SCALE AS NOTED
CONTRACT NO. C700	REV. 0
AREA CODE DB	SHEET NO. S686
	PAGE NO. 0232



Jul 05, 2013 1:55pm P:\BART Berryessa Extension Line\AS - STRUCTURAL\MILPITAS WORK\6-10-2012\0700-S-DB-S687.dwg

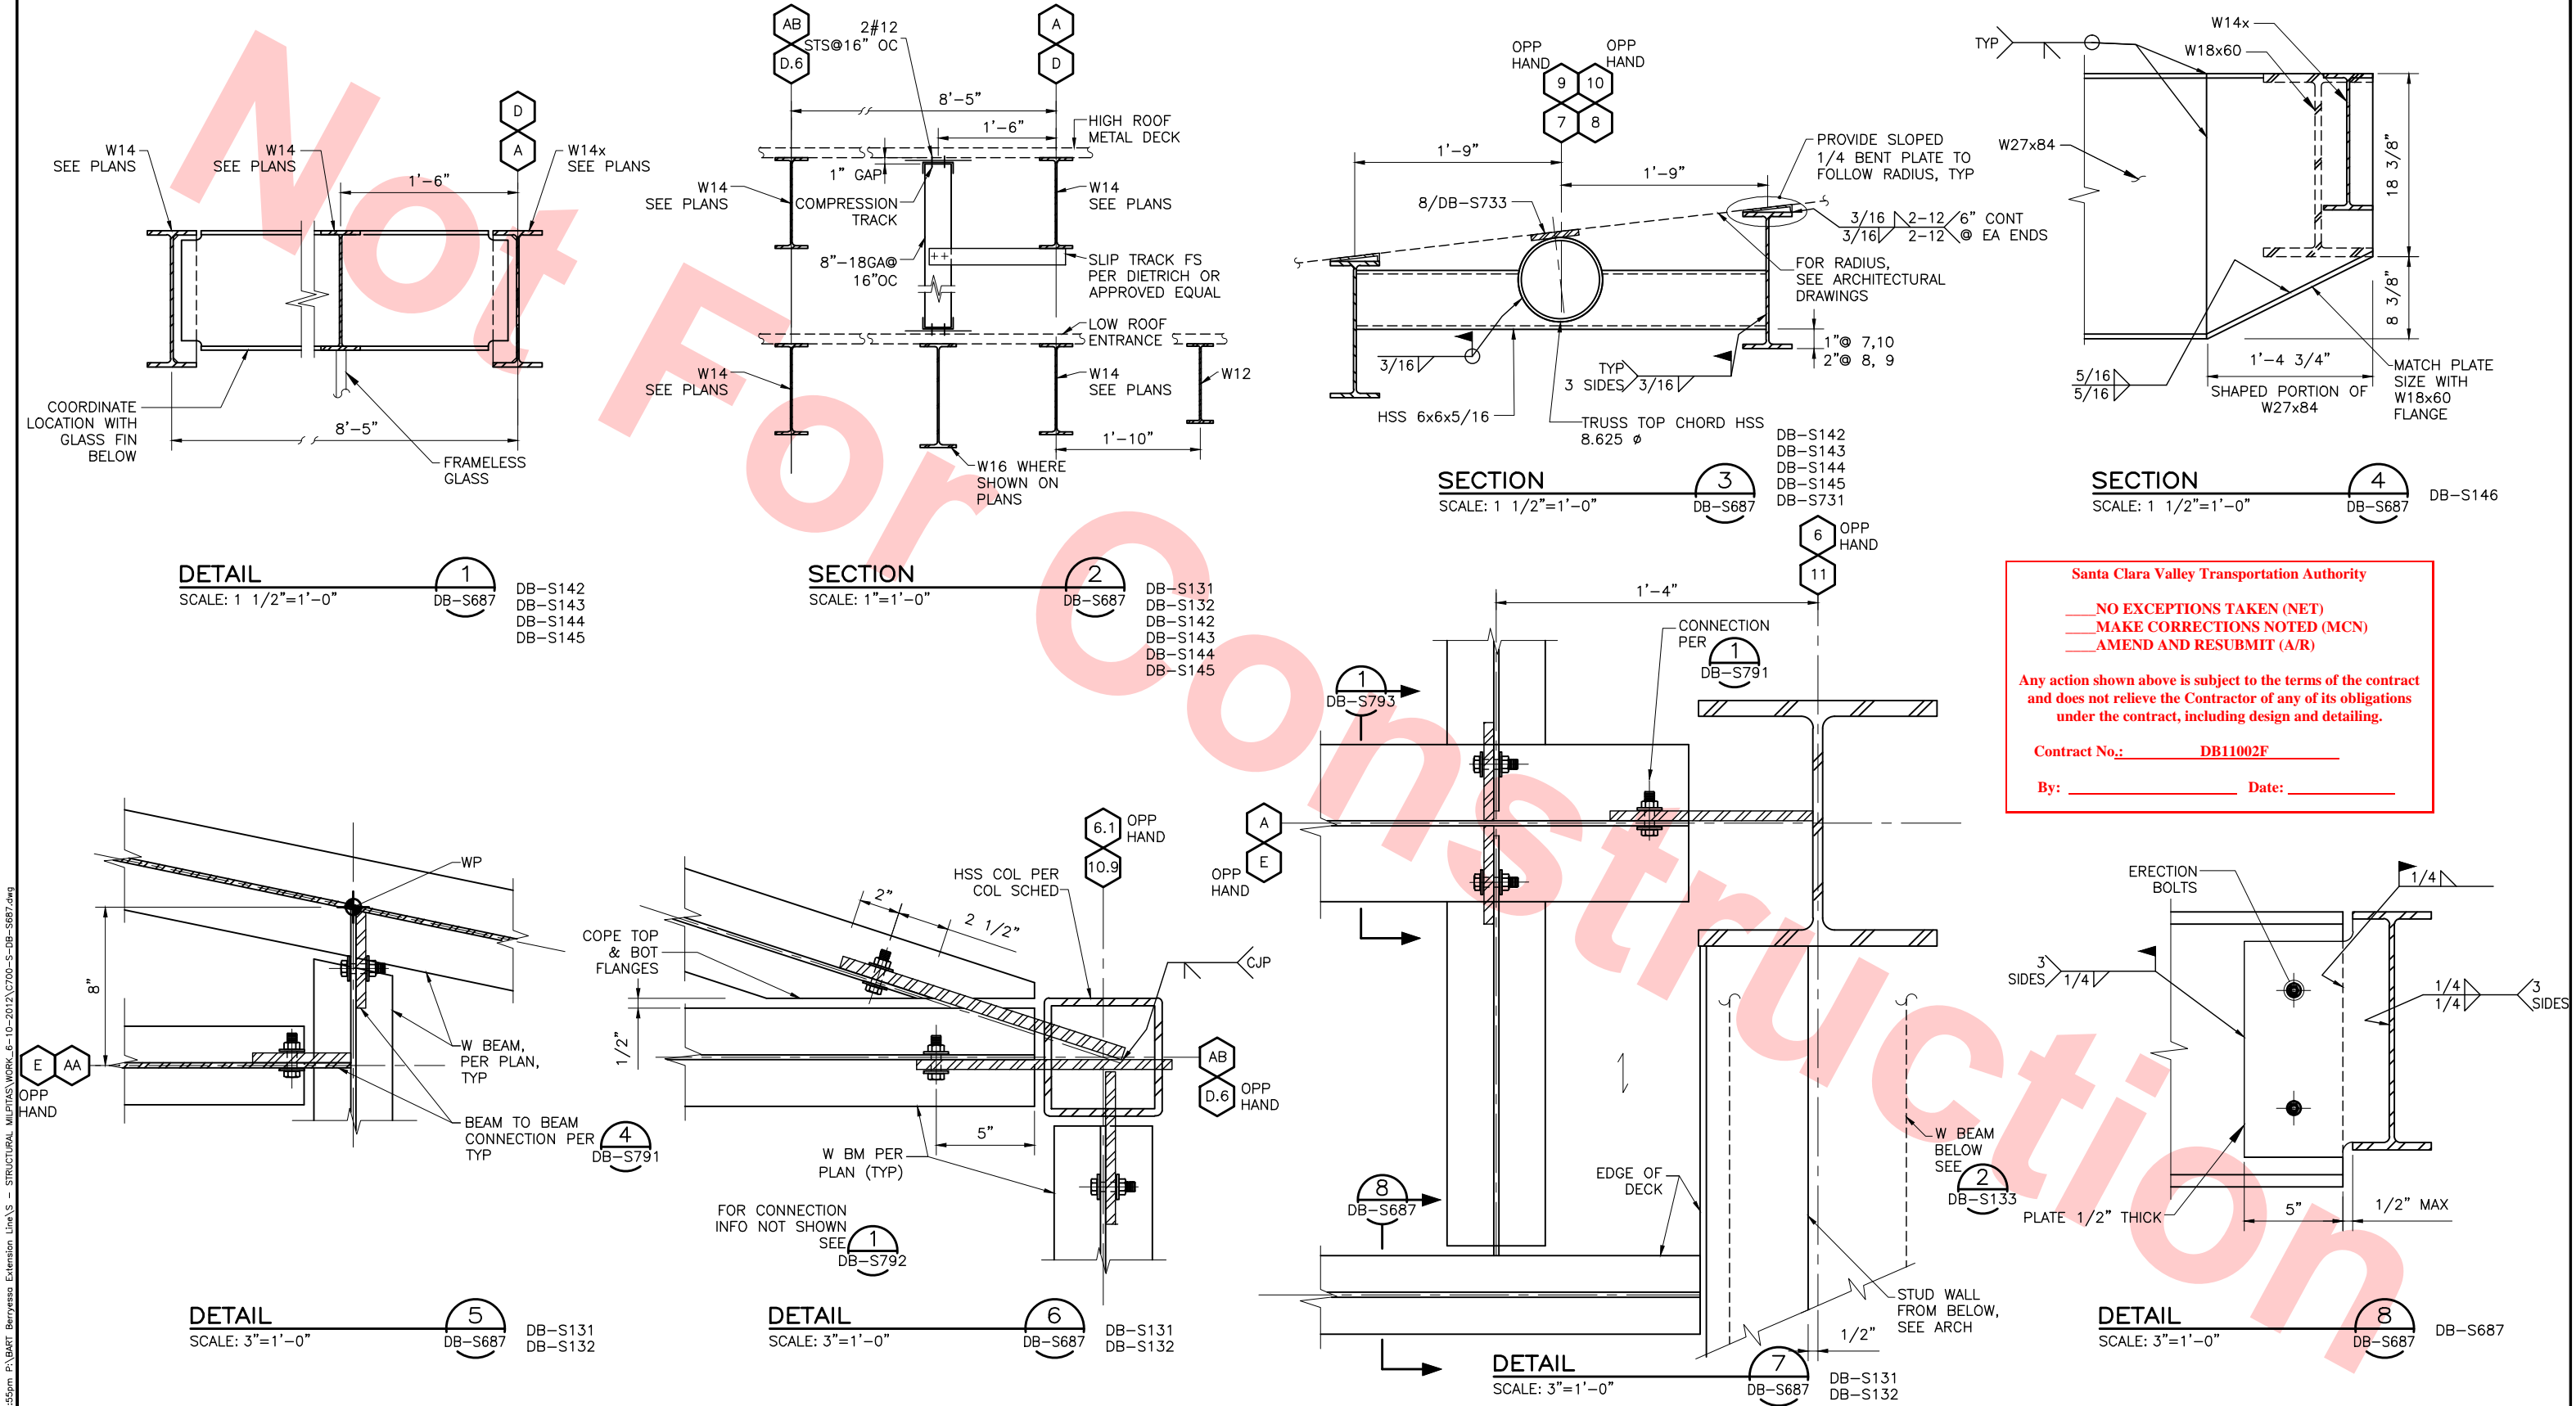







**Santa Clara Valley Transportation Authority**

**NO EXCEPTIONS TAKEN (NET)**  
**MAKE CORRECTIONS NOTED (MCN)**  
**AMEND AND RESUBMIT (A/R)**


Any action shown above is subject to the terms of the contract and does not relieve the Contractor of any of its obligations under the contract, including design and detailing.

Contract No.: **DB11002F**


By: \_\_\_\_\_ Date: \_\_\_\_\_

										DESIGNED BY J. REBER, S.E.			Skanska Shimmick Herzog		1436 California Circle Milpitas, California 95035 A Joint Venture		
										DRAWN BY P. DIAZ							
										CHECKED BY M. TARAZI							
										IN CHARGE M. TARAZI							
0 20130710 READINESS FOR CONSTRUCTION										DATE 20130710							
REV DATE BY SUB APP DESCRIPTION														MFT CONSULTING ENGINEERS, Inc. Audit Verma Associates, Inc. 1773 San Pablo Ave., Suite A-3 Pinole, CA 94864 Fax (510) 222-6165		 T-Y-LIN INTERNATIONAL	
										SUBMITTED 		APPROVED 					
																LINE, TRACK, STATIONS AND SYSTEMS DESIGN UNIT 023 MILPITAS STATION DETAILS	
														BART SILICON VALLEY BERRYESSA EXTENSION		SHEET 7 OF 17	
																CADD FILENAME C700-S-DB-S687.dwg	
																SIZE D SCALE AS NOTED	
																CONTRACT NO. C700 REV. 0	
																AREA CODE DB SHEET NO. S687 PAGE NO. 0233	



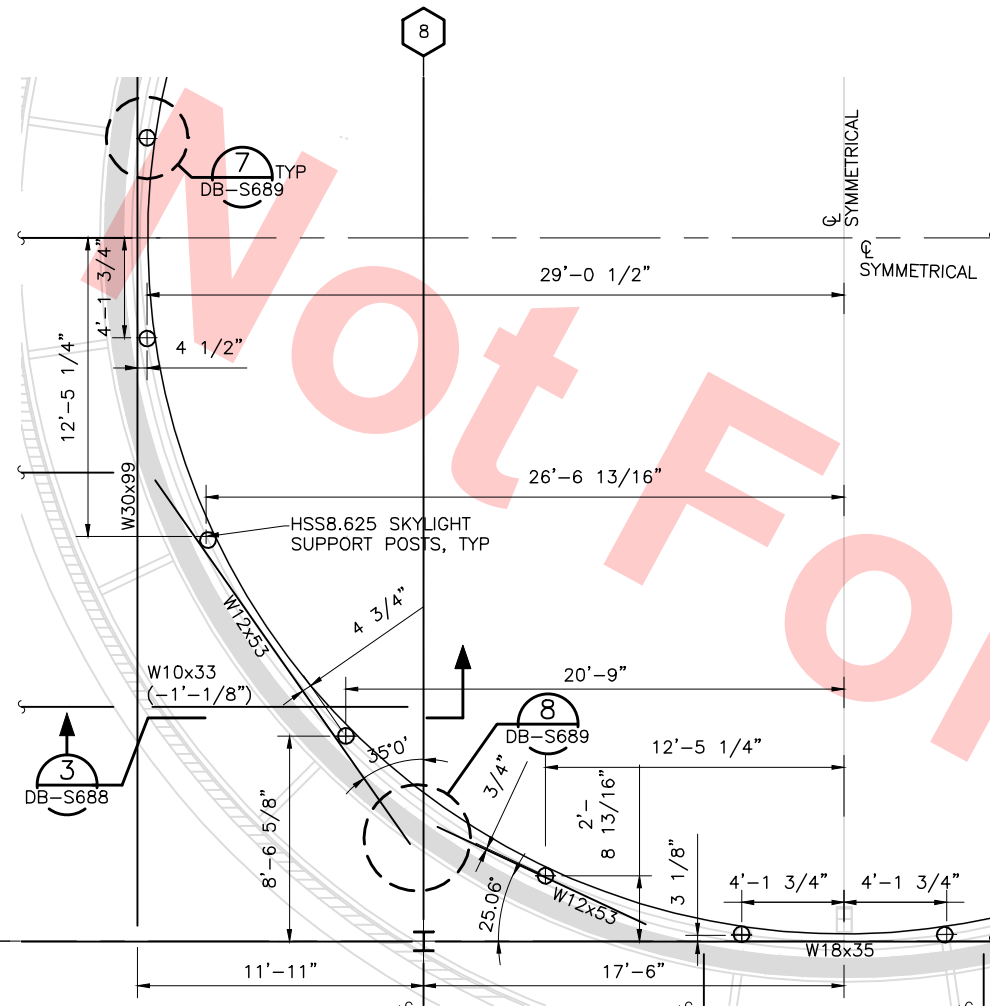


**PLAN SKYLIGHT #2**  
SCALE: 1/4"=1'-0"

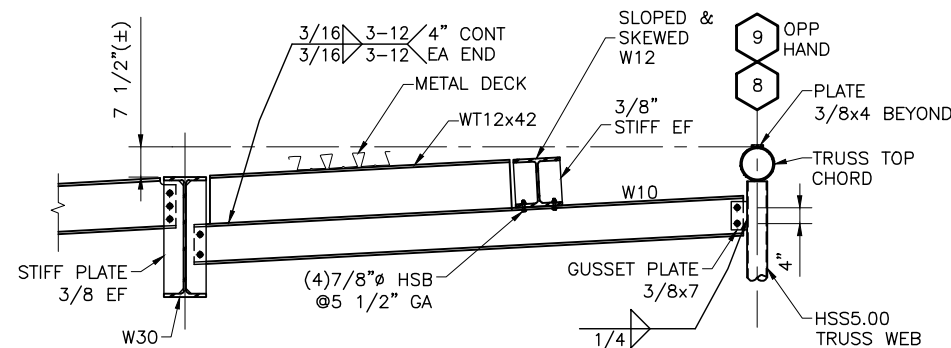

**SECTION**  
SCALE: 1/2"=1'-0"

NOTE:  
FOR TYPICAL BEAM  
CONNECTION SEE

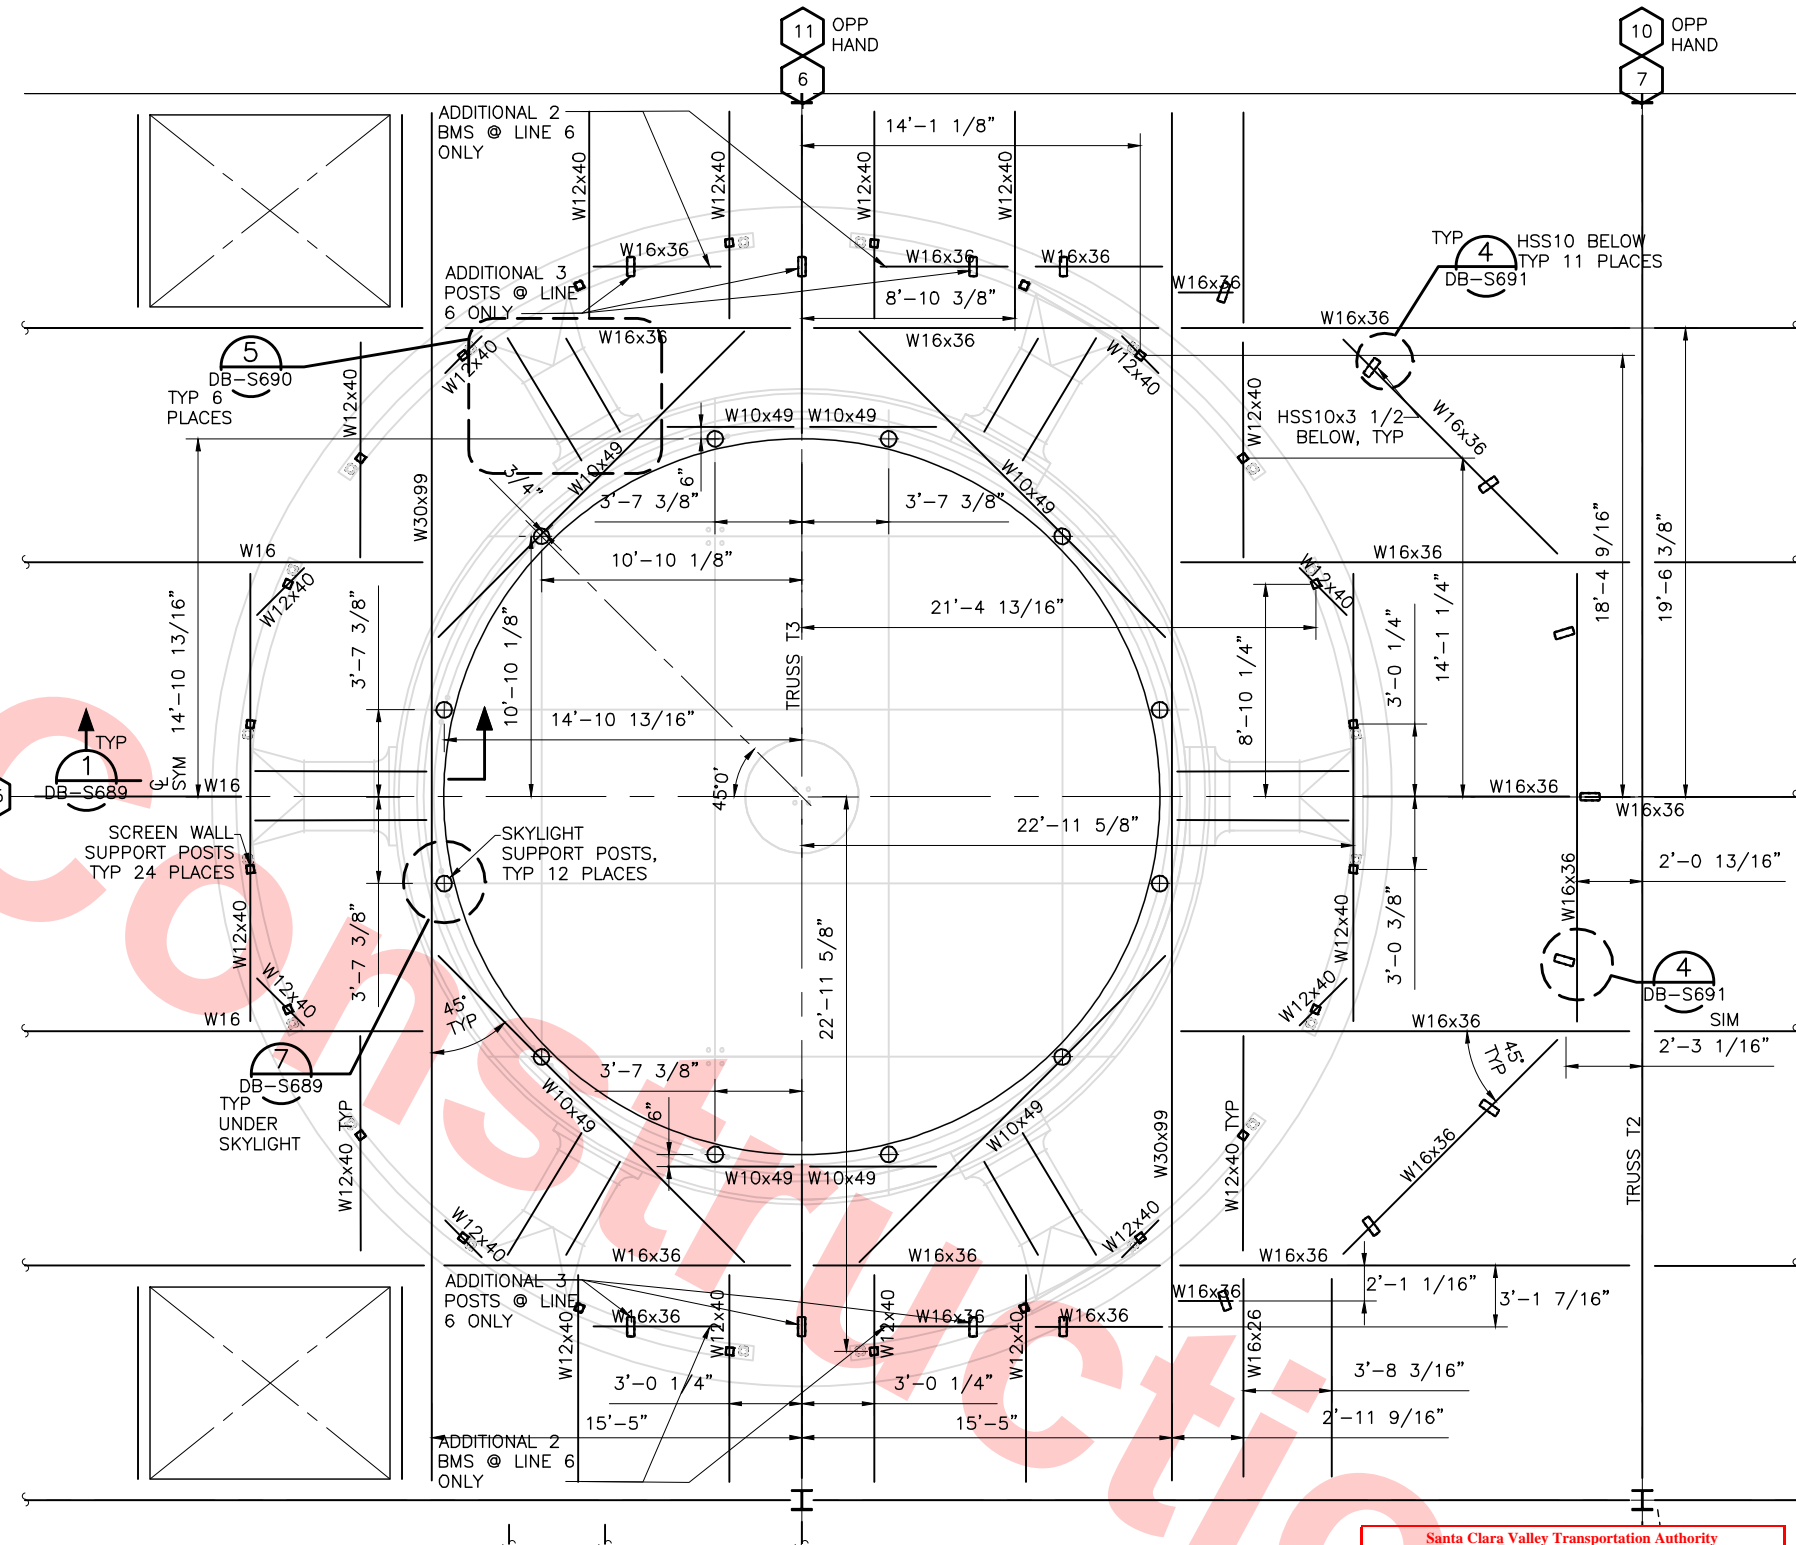


**PLAN SKYLIGHT  
#1 & #3**  
SCALE: 1/4"=1'-0"

DB-S142  
DB-S143  
DB-S144  
DB-S145

Santa Clara Valley Transportation Authority  
NO EXCEPTIONS TAKEN (NET)  
MAKE CORRECTIONS NOTED (MCN)  
AMEND AND RESUBMIT (A/R)  
Any action shown above is subject to the terms of the contract and does not relieve the Contractor of any of its obligations under the contract, including design and detailing.  
Contract No.: DB11002F  
By: \_\_\_\_\_ Date: \_\_\_\_\_

Jul 05, 2013 1:55pm P:\BART Berryessa Extension Line\AS - STRUCTURAL\MILPITAS WORK\6-10-2012\0700-S-DB-S688.dwg

DESIGNED BY J. REBER, S.E.	
DRAWN BY P. DIAZ	
CHECKED BY M. TARAZI	
IN CHARGE M. TARAZI	
DATE 20130710	
0 20130710	READINESS FOR CONSTRUCTION
REV	DATE
BY	SUB
APP	DESCRIPTION

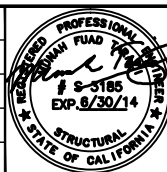

Skanska  
Shimmick  
Herzog  
1436 California Circle  
Milpitas, California 95035  
A Joint Venture  
MFT CONSULTING ENGINEERS, INC. Anil Verma Associates, Inc.  
1773 San Pablo Ave., Suite A3 (510) 222-4100  
Palo Alto, CA 94304 Fax (650) 222-8410






1436 California Circle  
Milpitas, California 95035  
A Joint Venture  
Leonwood, Andrews & Newman, Inc.  
T-Y-LIN INTERNATIONAL  
APPROVED

**BART**  
SILICON VALLEY  
BART SILICON VALLEY BERRYESSA EXTENSION

LINE, TRACK, STATIONS AND SYSTEMS  
DESIGN UNIT 023  
MILPITAS STATION  
DETAILS  
SHEET 8 OF 17

CADD FILENAME C700-S-DB-S688.dwg	
SIZE D	SCALE AS NOTED
CONTRACT NO. C700	REV. 0
AREA CODE DB	SHEET NO. S688
	PAGE NO. 0234



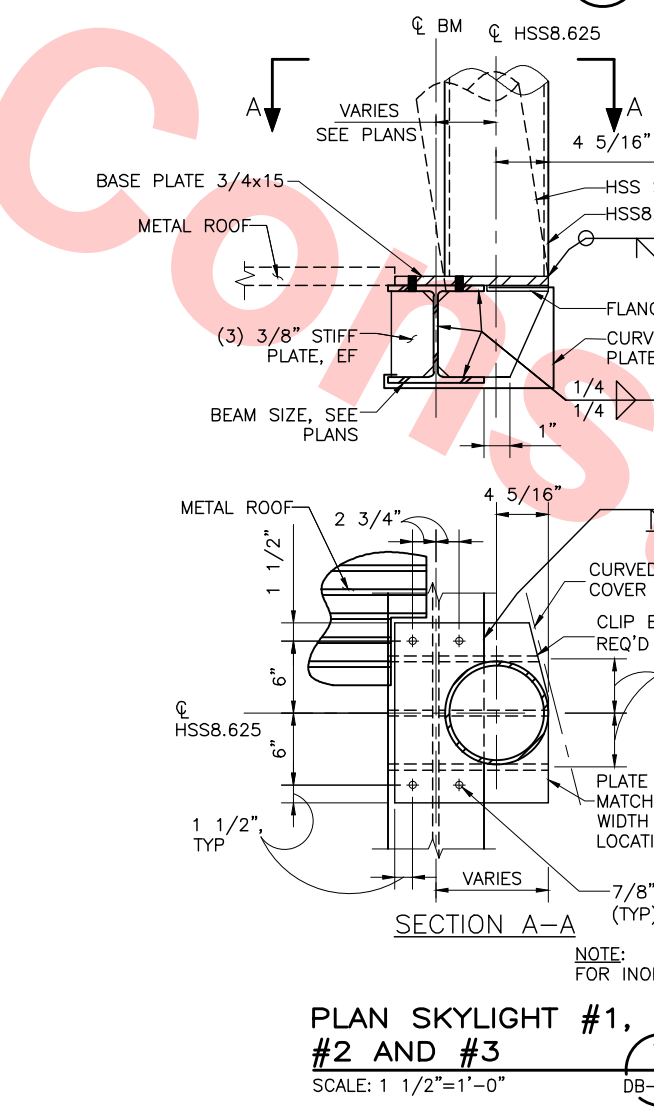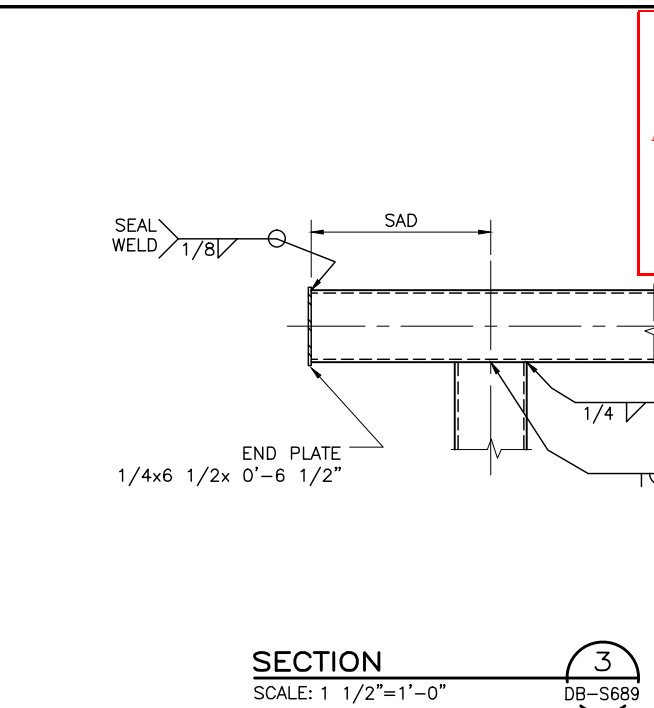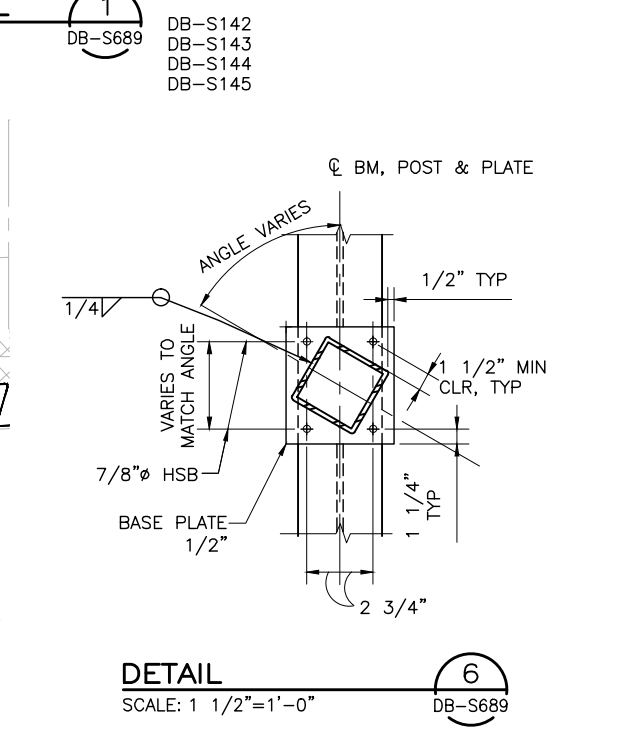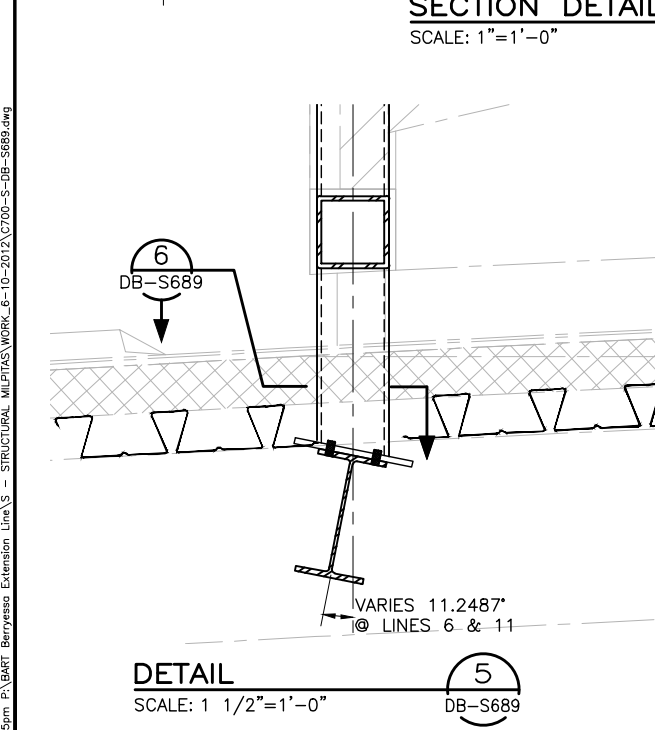
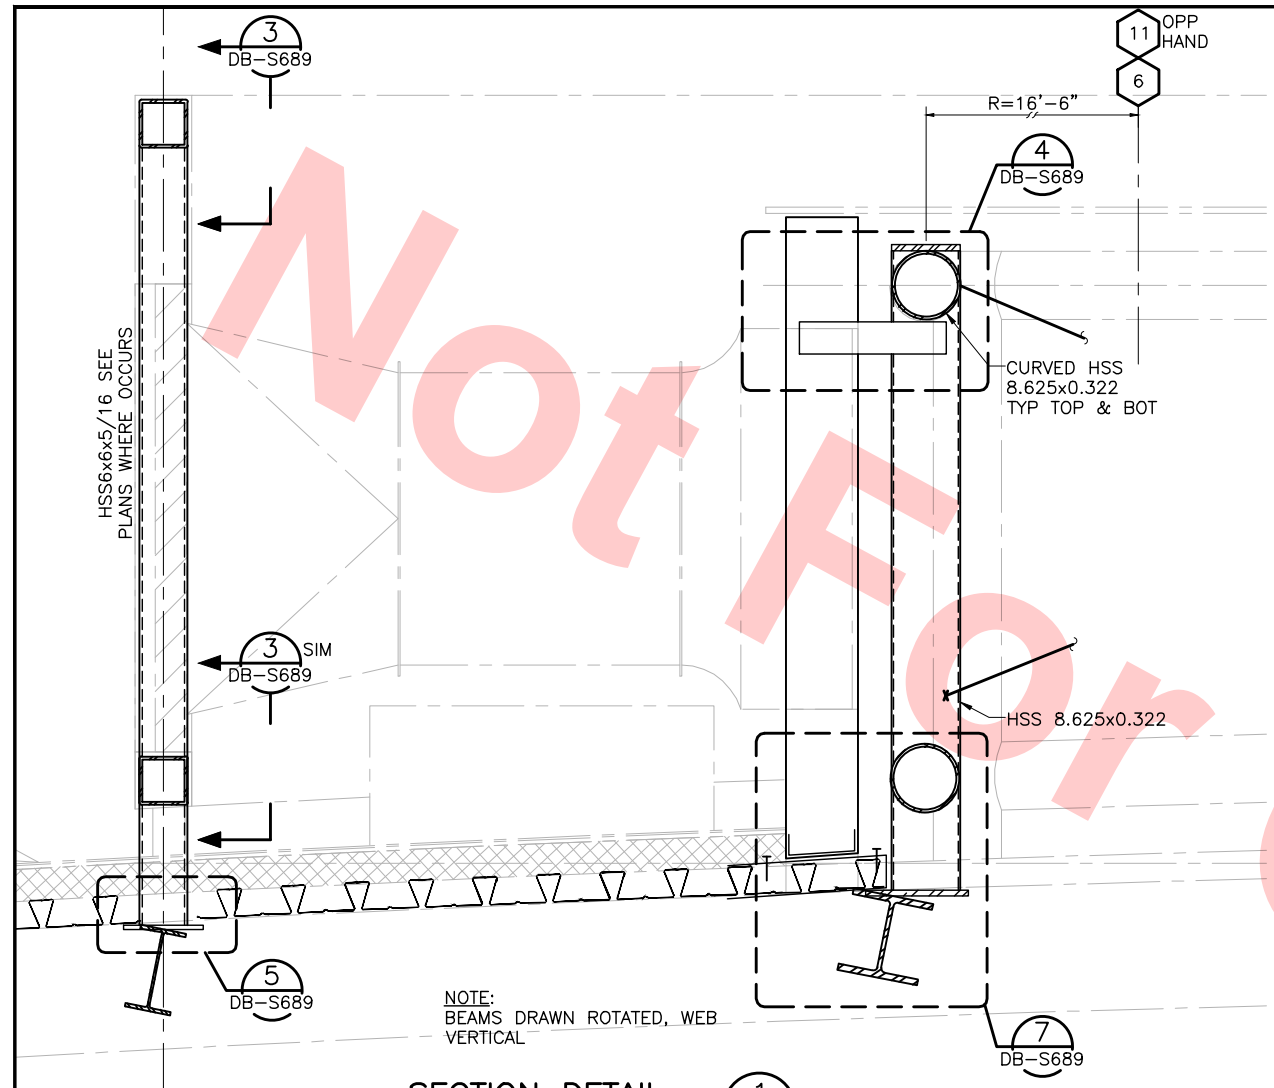


Santa Clara Valley Transportation Authority

NO EXCEPTIONS TAKEN (NET)  
MAKE CORRECTIONS NOTED (MCN)  
AMEND AND RESUBMIT (A/R)

Any action shown above is subject to the terms of the contract and does not relieve the Contractor of any of its obligations under the contract, including design and detailing.

Contract No.: DB11002F  
By: \_\_\_\_\_ Date: \_\_\_\_\_

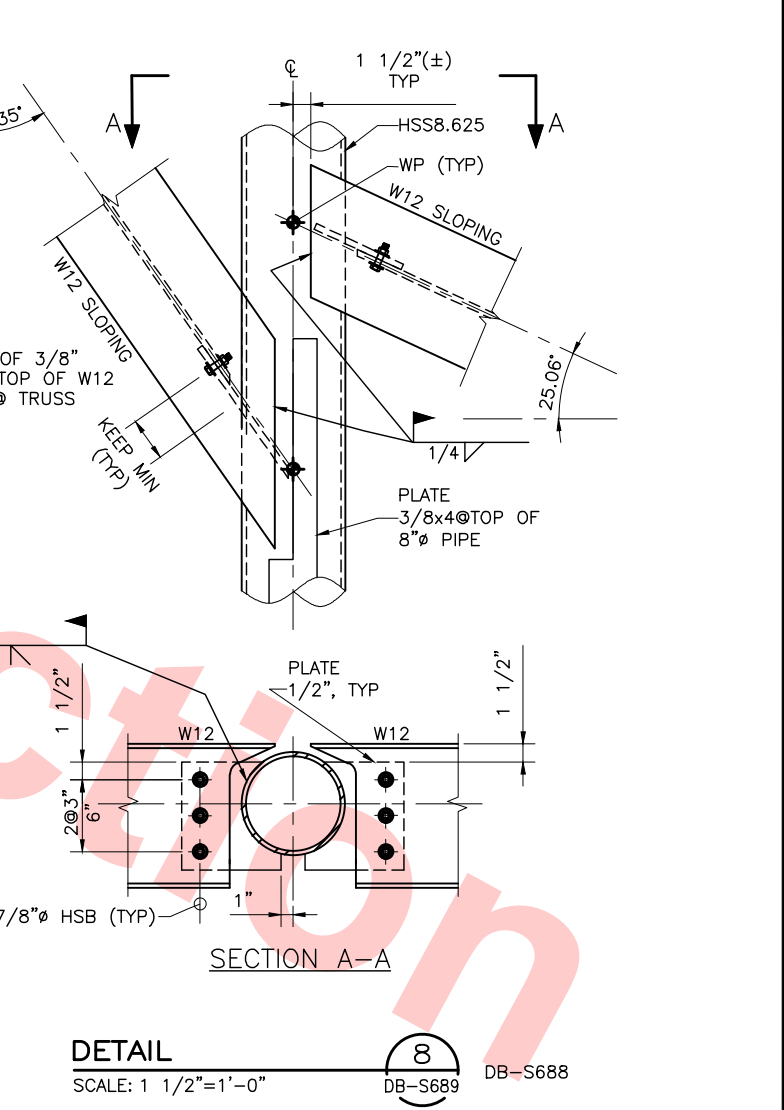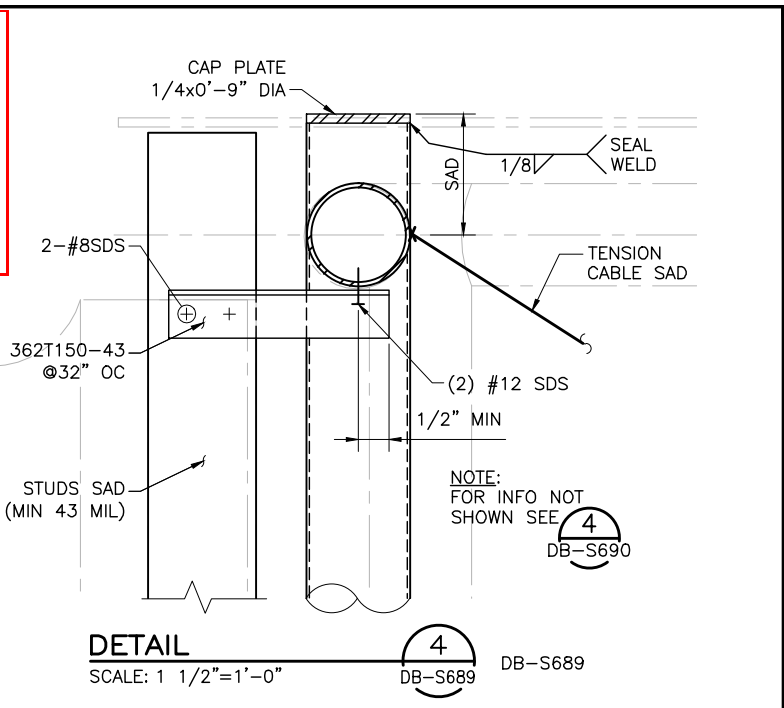

REV	DATE	BY	SUB	APP	DESCRIPTION
0	20130710				READINESS FOR CONSTRUCTION

DESIGNED BY  
J. REBER, S.E.

DRAWN BY  
P. DIAZ

CHECKED BY  
M. TARAZI

IN CHARGE  
M. TARAZI

DATE  
20130710

Skanska  
Shimmick  
Herzog

1436 California Circle  
Milpitas, California 95035  
A Joint Venture

MFT CONSULTING ENGINEERS, INC. Anil Verma Associates, Inc.  
1773 San Pablo Ave., Suite A3 (510) 222-4100  
Pinole, CA 94664 Fax (916) 222-8410

Lealwood, Andrews & Newman, Inc.  
A LEAD & BALLY COMPANY

T-Y-LIN INTERNATIONAL

BART  
SILICON VALLEY

BART SILICON VALLEY BERRYESSA EXTENSION

LINE, TRACK, STATIONS AND SYSTEMS  
DESIGN UNIT 023  
MILPITAS STATION  
DETAILS

SHEET 9 OF 17


CADD FILENAME  
C700-S-DB-S689.dwg

SIZE SCALE  
D AS NOTED


CONTRACT NO.  
C700

AREA CODE SHEET NO. PAGE NO.  
DB S689 0235



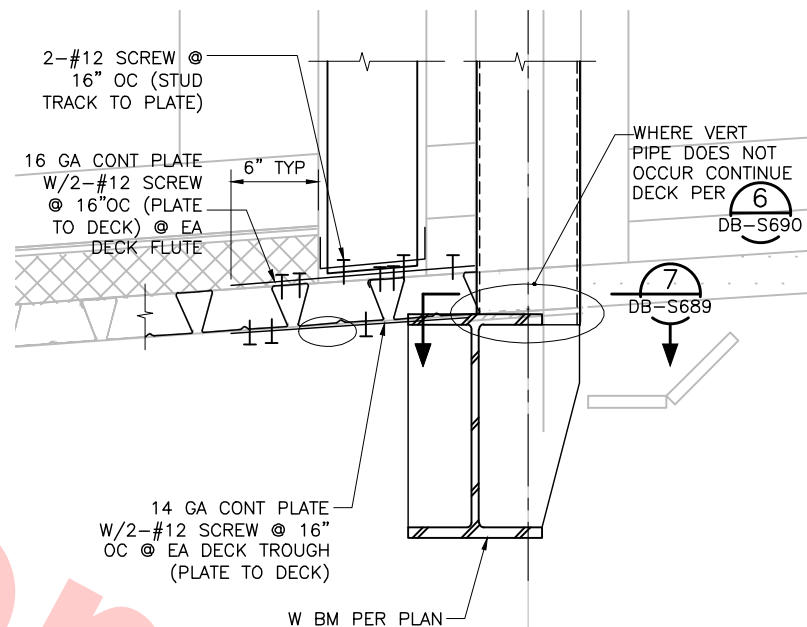

DETAIL @ BASE 2 DB-S690  
SCALE: 1 1/2"=1'-0" DB-S690

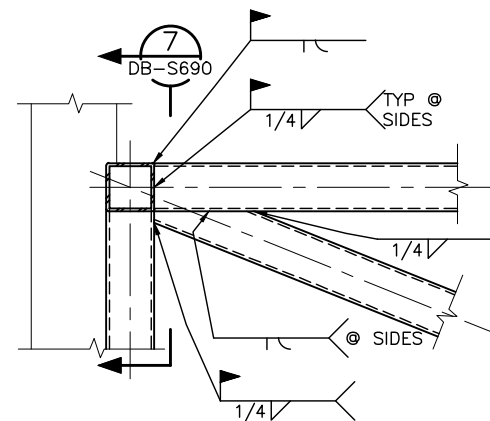


CONNECTION  
CURVED TOP & BOT  
HSS TO BRACKET

SCALE: 1 1/2"=1'-0"

DB-S690

DB-S690

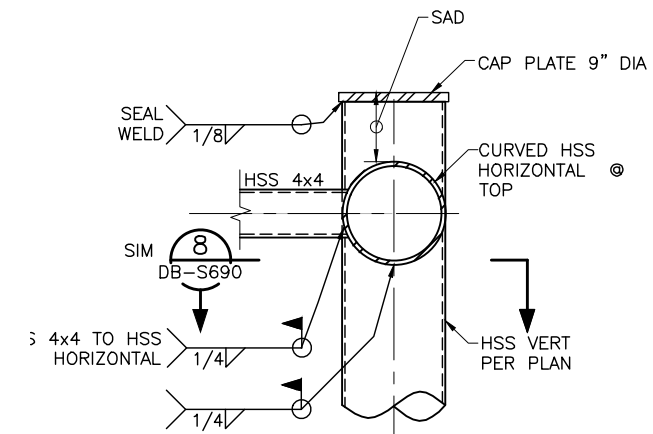

DETAIL @ TOP


SCALE: 1 1/2"=1'-0"

4

DB-S690

DB-S690


DB-S142  
DB-S143  
DB-S144  
DB-S145

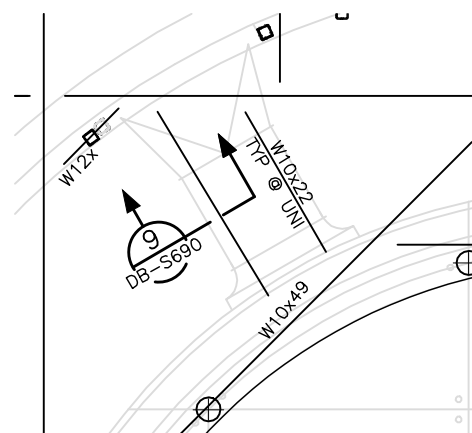


**SECTION**  
SCALE: 3/8"=1'-0"

5  
DB-S690

DB-S142

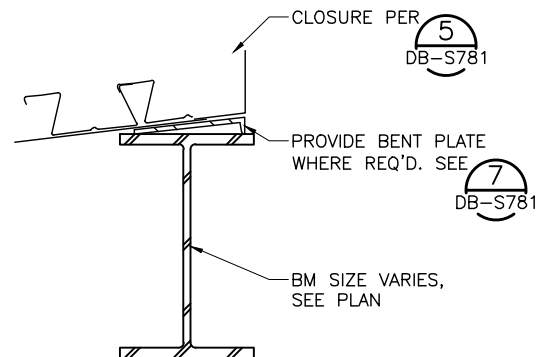

**DETAIL**  
SCALE: 1 1/2" = 1'-0" DB-S690 DB-S690

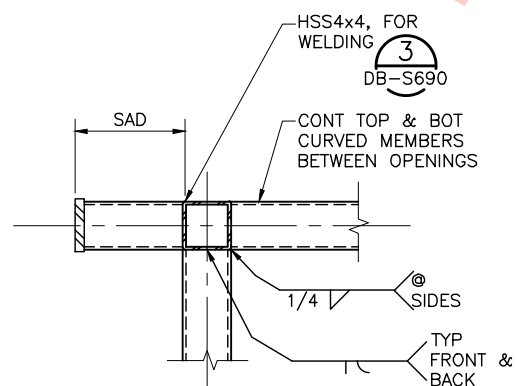


CONNECTION  
CURVED TOP & BOT  
HSS TO VERT

SCALE: 1 1/2" = 1'-0"

DB-S690

DB-S690

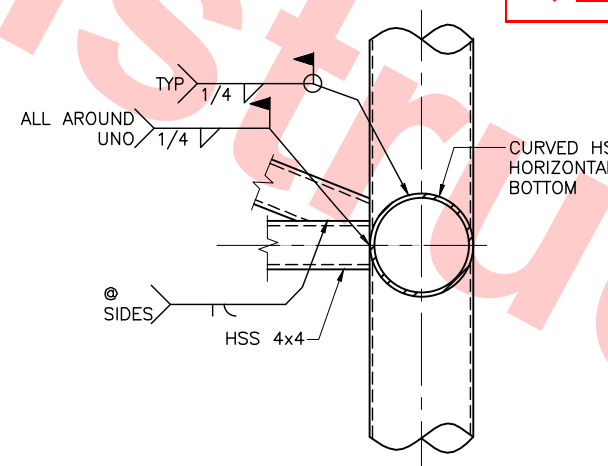


CONNECTION OF  
DIAGONAL @  
BOTTOM

SCALE: 1 1/2"=1'-0"

DB-S690

DB-S690

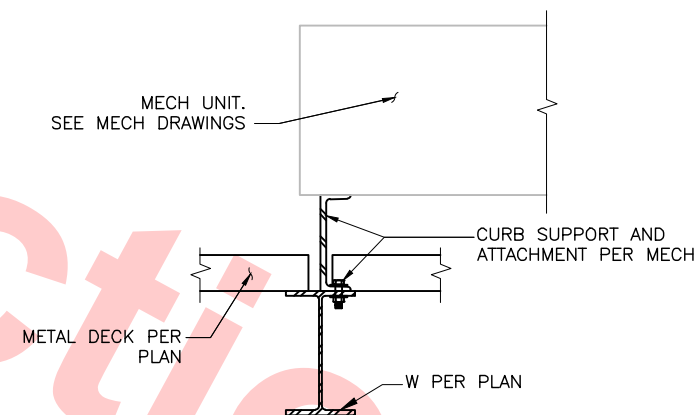


**SECTION**  
SCALE: 1 1/2"=1'-0"

9  
DB-S690 DB-S690

0	20130710				READINESS FOR CONSTRUCTION
REV	DATE	BY	SUB	APP	DESCRIPTION

DESIGNED BY J. REBER, S.E.
DRAWN BY P. DIAZ
CHECKED BY M. TARAZI
IN CHARGE M. TARAZI
DATE 20130710

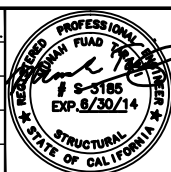

Skanska  
Shimmick  
Herzog

**MFT** CONSULTING ENGINEERS, INC. Anil Verma Associates, Inc.  
1773 San Pablo Ave., Suite A3 (510) 222-4106  
Pinole, CA 94564 Fax (510) 222-6118

*Anil Verma*

SUBMITTED

1436 California Circle  
Milpitas, California 95035

A Joint Venture

**LAN** **Lesliewood, Andrews & Nowman, Inc.**  
A LEO A BAY COMPANY

**T-Y-LIN INTERNATIONAL**

APPROVED *R. Holmuth*




BART SILICON VALLEY BERRYESSA EXTENSION

LINE, TRACK, STATIONS AND SYSTEMS  
DESIGN UNIT 023  
MILPITAS STATION  
DETAILS

SHEET 10 OF 17


CADD FILENAME C700-S-DB-S690.dwg		
SIZE D	SCALE AS NOTED	
CONTRACT NO. <b>C700</b>		REV.
AREA CODE <b>DB</b>	SHEET NO. <b>S690</b>	PAGE NO. <b>0236</b>



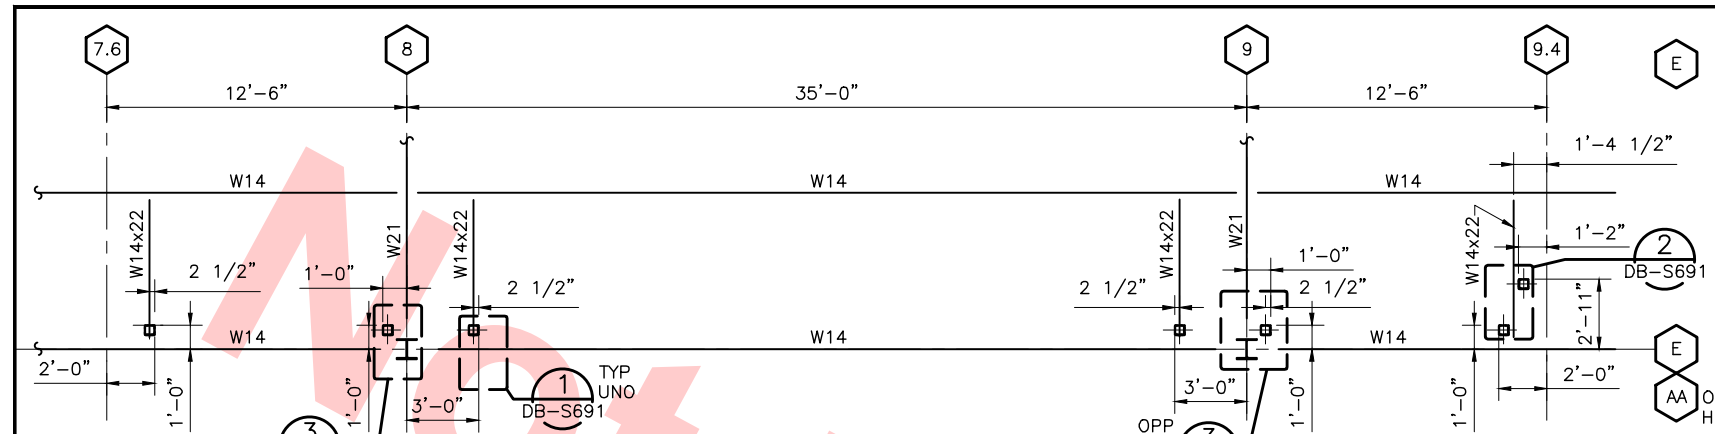


**PLAN @ LOW ROOF A**  
SCALE: 1/4"=1'-0"


**Santa Clara Valley Transportation Authority**  
 NO EXCEPTIONS TAKEN (NET)  
 MAKE CORRECTIONS NOTED (MCN)  
 AMEND AND RESUBMIT (A/R)  
 Any action shown above is subject to the terms of the contract and does not relieve the Contractor of any of its obligations under the contract, including design and detailing.  
 Contract No.: DB11002F  
 By: \_\_\_\_\_ Date: \_\_\_\_\_

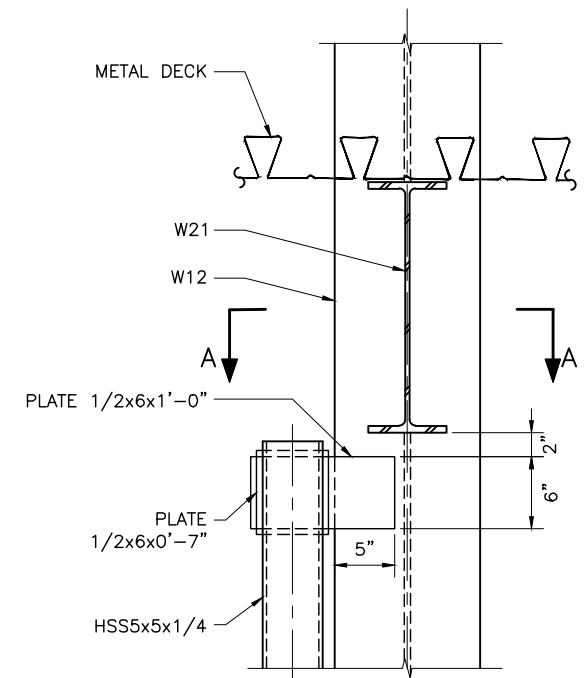


**DETAIL 3**  
SCALE: 1 1/2"=1'-0"

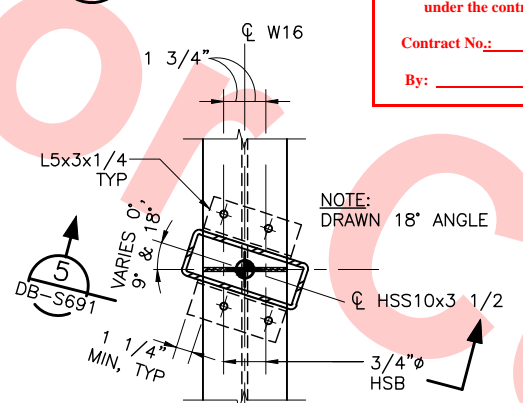


**PLAN DETAIL 4**  
SCALE: 1 1/2"=1'-0"

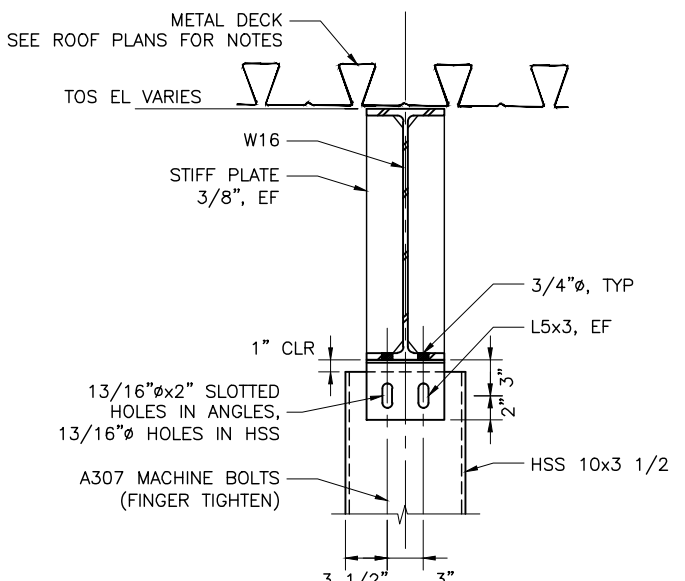


**SECTION 5**  
SCALE: 1 1/2"=1'-0"

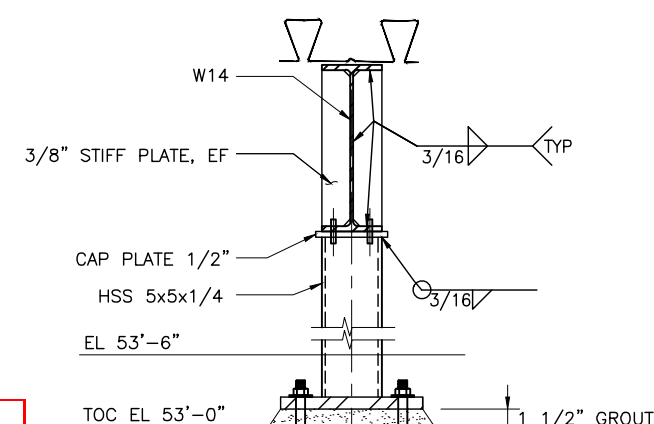


**DETAIL 1**  
SCALE: 1 1/2"=1'-0"

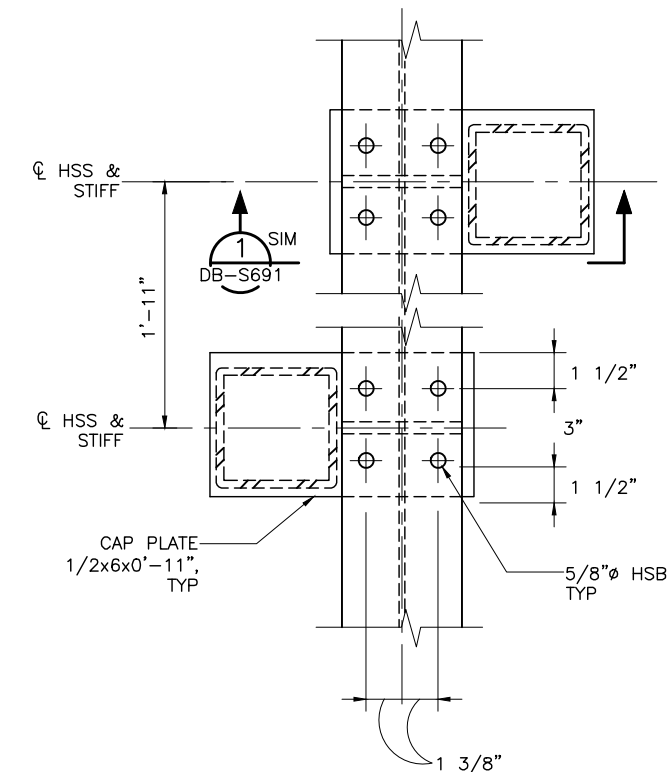

**DETAIL PLAN 2**  
SCALE: 3"=1'-0"

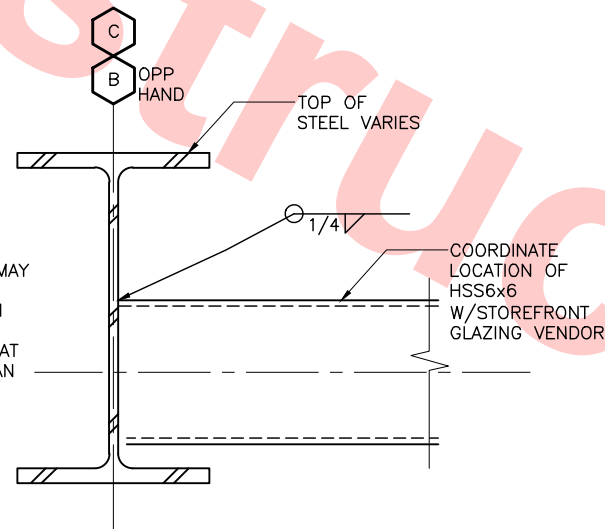

**DETAIL 6**  
SCALE: 3"=1'-0"

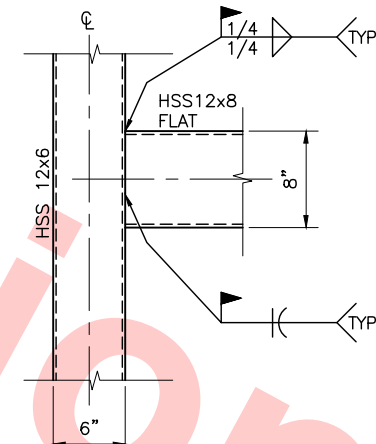


**DETAIL 7**  
SCALE: 1 1/2"=1'-0"

Jul 05, 2013 1:55pm P:\BART Berryessa Extension Line\AS - STRUCTURAL\MILPITAS WORK\6-10-2012\0700-S-DB-S691.dwg

REV	DATE	BY	SUB	APP	DESCRIPTION
0	20130710				READINESS FOR CONSTRUCTION

DESIGNED BY  
J. REBER, S.E.  
 DRAWN BY  
P. DIAZ  
 CHECKED BY  
M. TARAZI  
 IN CHARGE  
M. TARAZI  
 DATE  
20130710

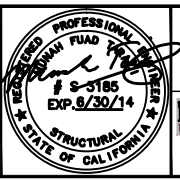

**Skanska Shimmick Herzog**  
 1436 California Circle  
 Milpitas, California 95035  
 A Joint Venture  
 MFT CONSULTING ENGINEERS, Inc. Anil Verma Associates, Inc.  
 1773 San Pablo Ave., Suite A3 (510) 222-4100  
 Pinole, CA 94664 Fax (510) 222-8410

**Leonwood, Andrews & Newman, Inc.**  
 T-Y-LIN INTERNATIONAL  
 APPROVED




**LINE, TRACK, STATIONS AND SYSTEMS**  
**DESIGN UNIT 023**  
 MILPITAS STATION  
 DETAILS  
 SHEET 11 OF 17

CADD FILENAME	C700-S-DB-S691.dwg
SIZE	D
SCALE	AS NOTED
CONTRACT NO.	C700
AREA CODE	DB
SHEET NO.	S691
PAGE NO.	0237



Jul 05, 2013 1:55pm P:\BART Berryessa Extension Line\AS - STRUCTURAL\MILPITAS WORK\6-10-2012\0700-S-DB-S692.dwg

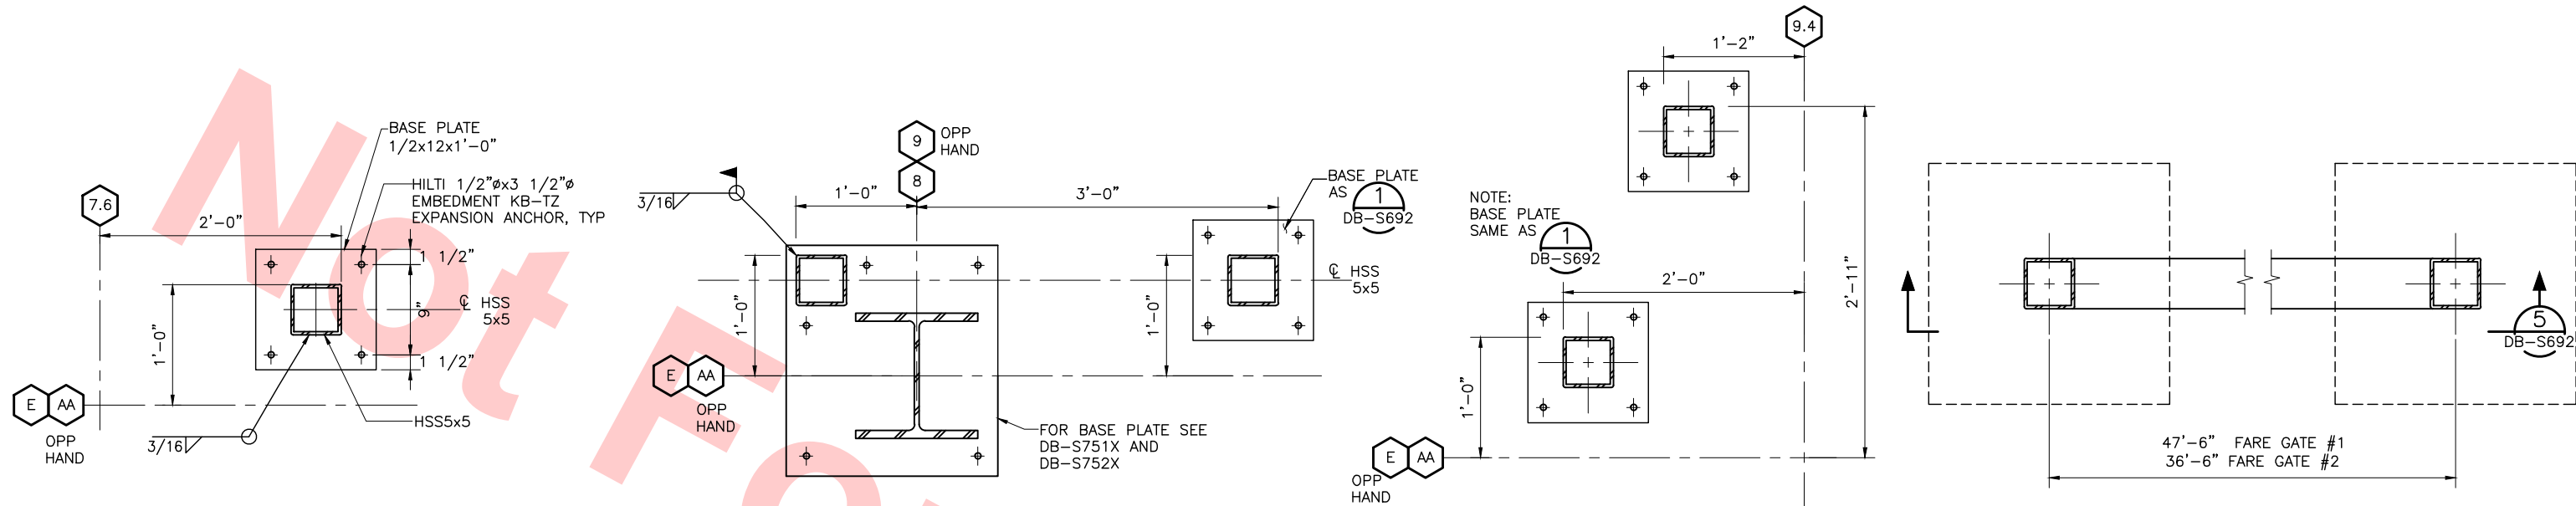


DETAIL PLAN@ BASE 1  
SCALE: 1 1/2"=1'-0"

DETAIL PLAN@ BASE 2  
SCALE: 1 1/2"=1'-0"


DETAIL PLAN@ BASE 3  
SCALE: 1 1/2"=1'-0"

FARE GATE PLAN 4  
SCALE: 1"=1'-0"


Santa Clara Valley Transportation Authority  
NO EXCEPTIONS TAKEN (NET)  
MAKE CORRECTIONS NOTED (MCN)  
AMEND AND RESUBMIT (A/R)  
Any action shown above is subject to the terms of the contract and does not relieve the Contractor of any of its obligations under the contract, including design and detailing.  
Contract No.: DB11002F  
By: \_\_\_\_\_ Date: \_\_\_\_\_

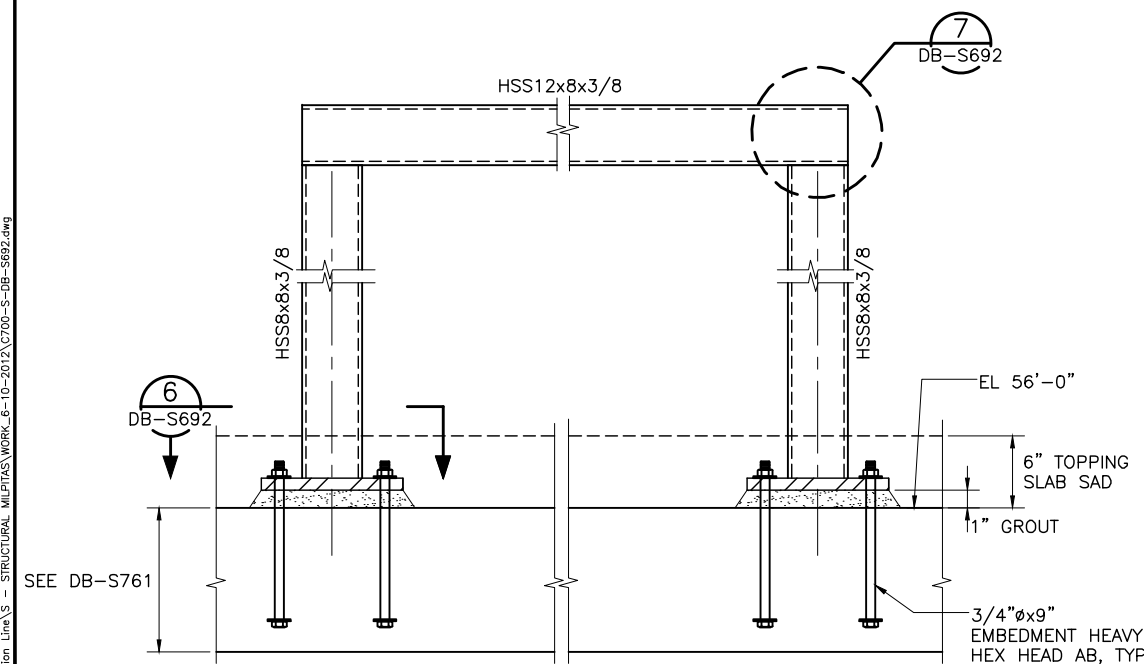



FARE GATE ELEV 5  
SCALE: 1 1/2"=1'-0"

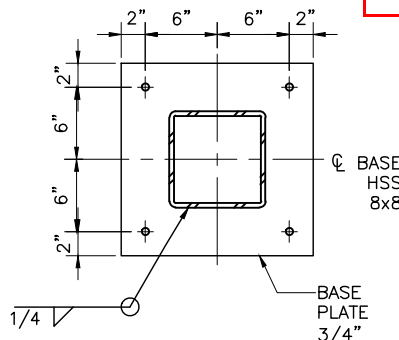

BASE PLATE 6  
SCALE: 1 1/2"=1'-0"






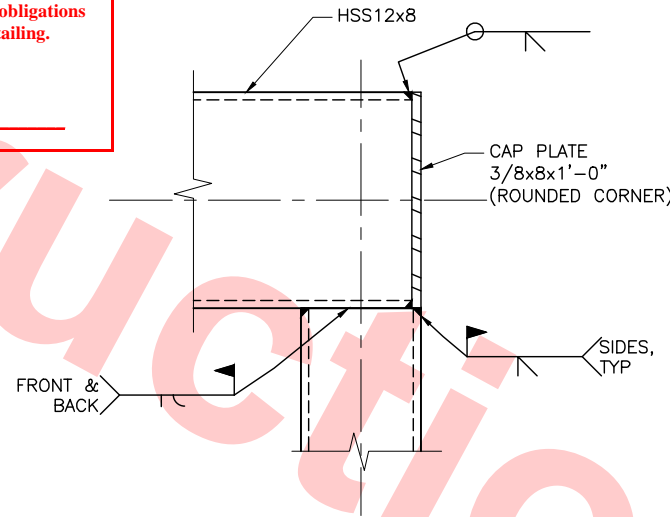


COL TO BM CONN 7  
SCALE: 3"=1'-0"

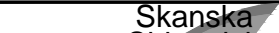					DESIGNED BY J. REBER, S.E.						Skanska Shimmick Herzog					1436 California Circle Milpitas, California 95035 A Joint Venture															LINE, TRACK, STATIONS AND SYSTEMS DESIGN UNIT 023 MILPITAS STATION DETAILS					CADD FILENAME C700-S-DB-S692.dwg																																																																																																																																																																																																																																																																																																																																																																																																																																																																																																																																																																																																																																																																																																																																																																																																																																																																																																																																																																																																																																																																																																																																																																																																																																																																																																																																																																																																																																																																																																																																																																																																																																																																																																																																																																																																																																																																																																																																																																																																																																																																																																																																																																																																																																																																																																																																																																																																																																																																																																																																																																																																																																																																																																																																																																																							
					DRAWN BY P. DIAZ																															SIZE D					SCALE 1 1/2" = 1'-0"					CONTRACT NO. C700					REV.																																																																																																																																																																																																																																																																																																																																																																																																																																																																																																																																																																																																																																																																																																																																																																																																																																																																																																																																																																																																																																																																																																																																																																																																																																																																																																																																																																																																																																																																																																																																																																																																																																																																																																																																																																																																																																																																																																																																																																																																																																																																																																																																																																																																																																																																																																																																																																																																																																																																																																																																																																																																																																																																																																																																																																								
					CHECKED BY M. TARAZI																																																																																																																																																																																																																																																																																																																																																																																																																																																																																																																																																																																																																																																																																																																																																																																																																																																																																																																																																																																																																																																																																																																																																																																																																																																																																																																																																																																																																																																																																																																																																																																																																																																																																																																																																																																																																																																																																																																																																																																																																																																																																																																																																																																																																																																																																																																																																																																																																																																																																																																																																																																																																																																																																																																																																																																																																						



04-02 Jul 05, 2013 - 1:56pm P:\BART Berryessa Extension Line\5 - STRUCTURAL MILPITAS WORK\_6-10-2012\CT00-S-DB-S693.dwg

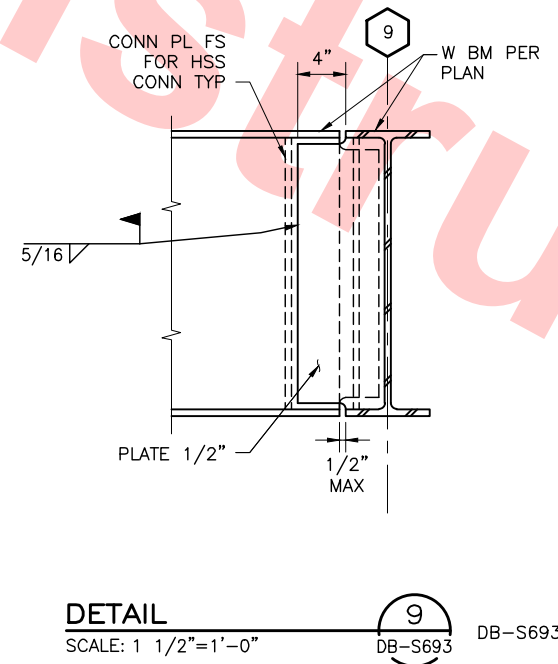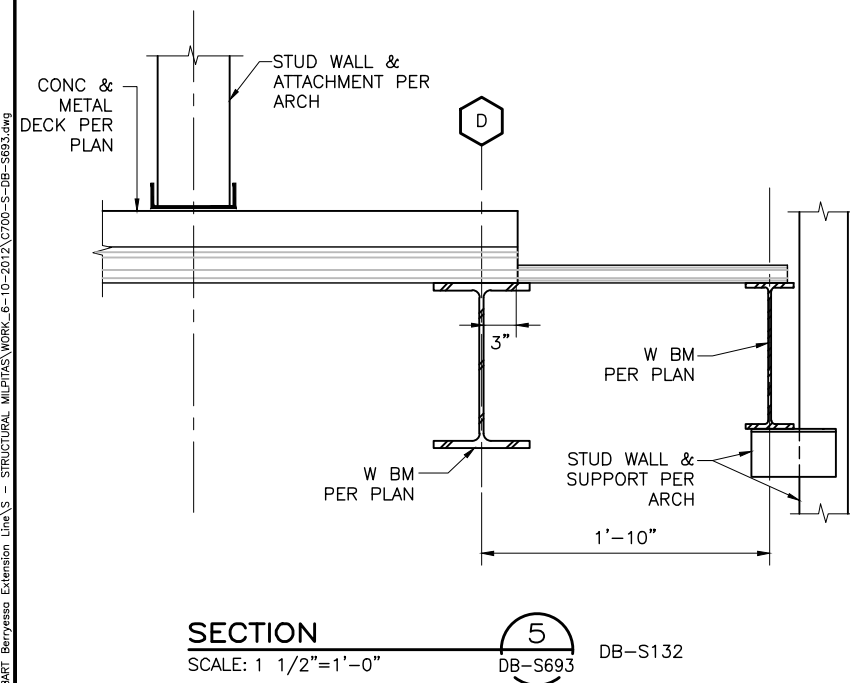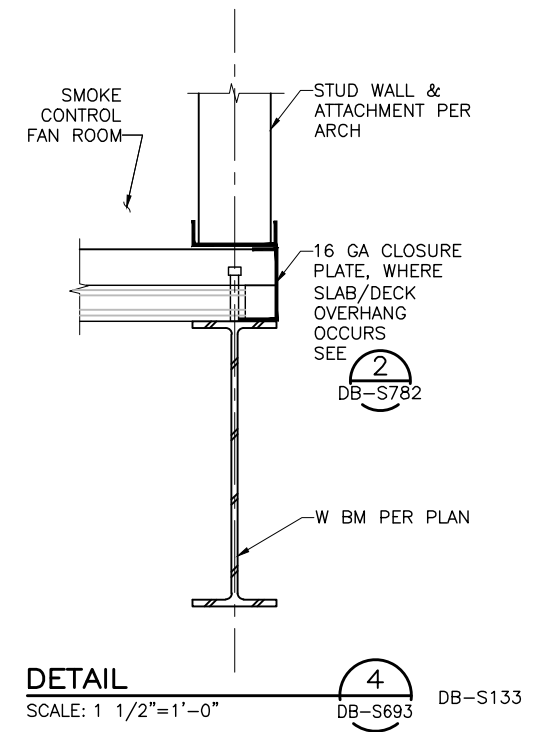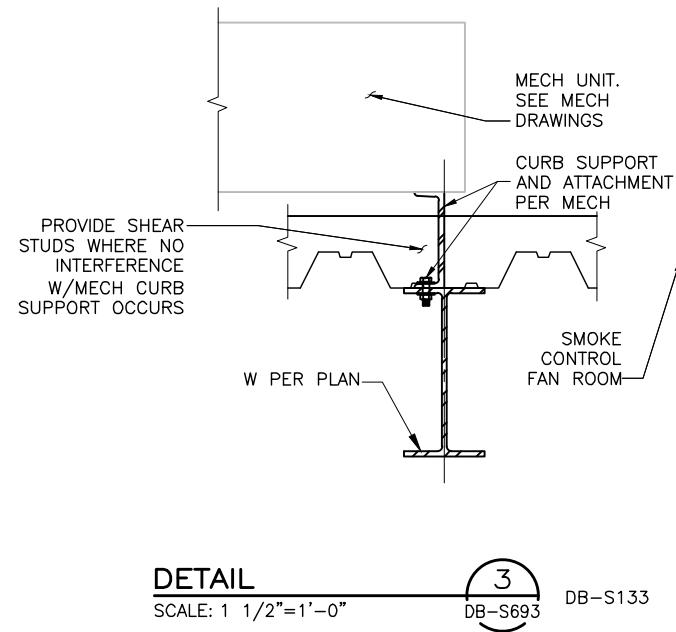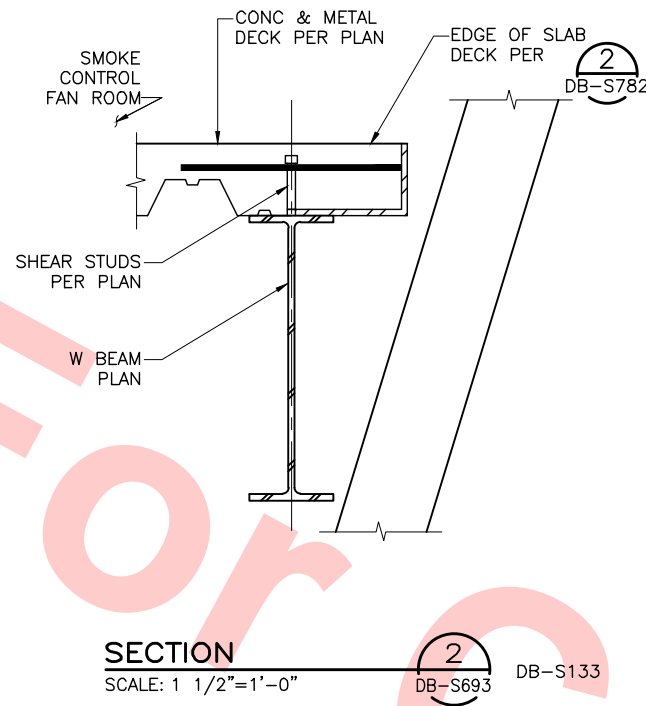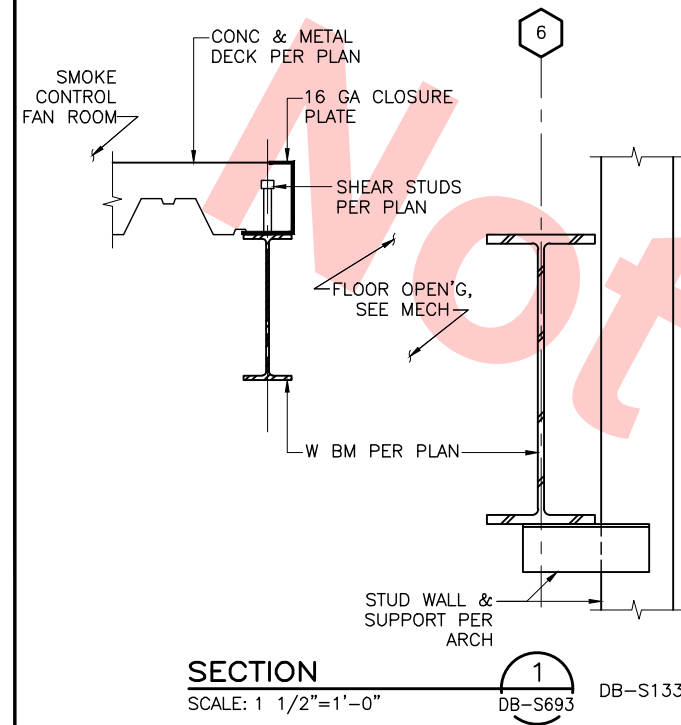

Santa Clara Valley Transportation Authority

NO EXCEPTIONS TAKEN (NET)  
MAKE CORRECTIONS NOTED (MCN)  
AMEND AND RESUBMIT (A/R)


Any action shown above is subject to the terms of the contract and does not relieve the Contractor of any of its obligations under the contract, including design and detailing.

Contract No.: DB11002F

By: \_\_\_\_\_ Date: \_\_\_\_\_

DESIGNED BY	J. REBER, S.E.
DRAWN BY	P. DIAZ
CHECKED BY	M. TARAZI
IN CHARGE	M. TARAZI
DATE	20130710

0	20130710				READINESS FOR CONSTRUCTION
REV	DATE	BY	SUB	APP	DESCRIPTION

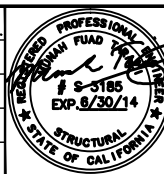

Skanska Shimmick Herzog	1436 California Circle Milpitas, California 95035 A Joint Venture
MFT CONSULTING ENGINEERS, Inc. Anil Verma Associates, Inc.	1773 San Pablo Ave., Suite A3 (510) 222-4100 Pinole, CA 94664 Fax (510) 222-8410
Lealwood, Andrews & Newman, Inc. A LEAD A RALLY COMPANY	T-Y-LIN INTERNATIONAL
SUBMITTED	APPROVED




LINE, TRACK, STATIONS AND SYSTEMS
DESIGN UNIT 023
MILPITAS STATION
DETAILS
SHEET 13 OF 17

CADD FILENAME	C700-S-DB-S693.dwg
SIZE	D
SCALE	AS NOTED
CONTRACT NO.	C700
AREA CODE	DB
SHEET NO.	S693
PAGE NO.	0239



Jul 05, 2013 - 1:56pm P:\BART Berryessa Extension Line\AS - STRUCTURAL MILPITAS WORK\_6-10-2012\CT00-S-DB-S694.dwg  
c04-02

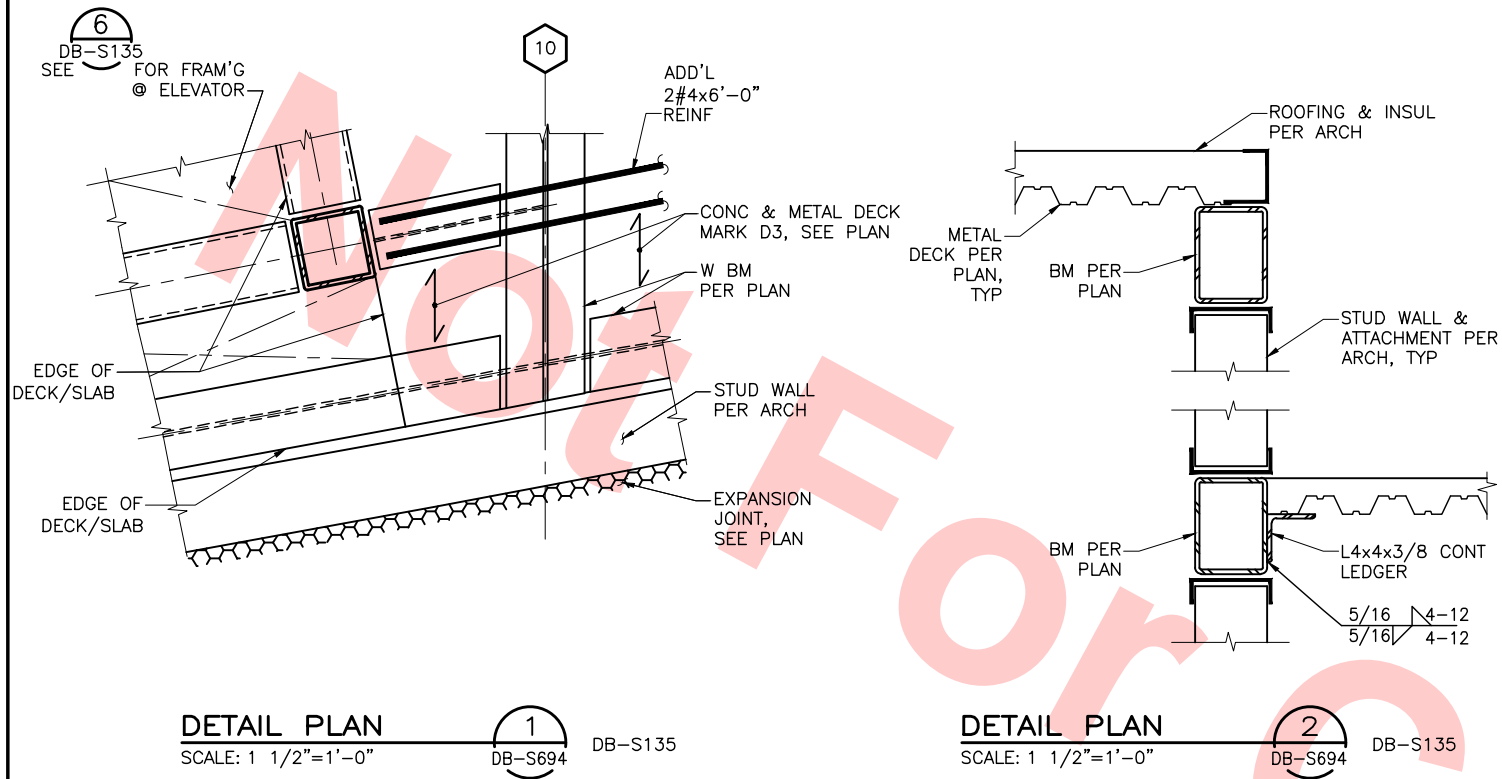

Santa Clara Valley Transportation Authority

NO EXCEPTIONS TAKEN (NET)  
MAKE CORRECTIONS NOTED (MCN)  
AMEND AND RESUBMIT (A/R)


Any action shown above is subject to the terms of the contract and does not relieve the Contractor of any of its obligations under the contract, including design and detailing.

Contract No.: DB11002F

By: \_\_\_\_\_ Date: \_\_\_\_\_

DESIGNED BY J. REBER, S.E.	
DRAWN BY P. DIAZ	
CHECKED BY M. TARAZI	
IN CHARGE M. TARAZI	
DATE 20130710	

REV	DATE	BY	SUB	APP	DESCRIPTION
0	20130710				READINESS FOR CONSTRUCTION

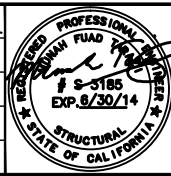

<b>Skanska Shimmick Herzog</b> 1436 California Circle Milpitas, California 95035 A Joint Venture	<b>MFT CONSULTING ENGINEERS, Inc.</b> Anil Verma Associates, Inc. 1773 San Pablo Ave., Suite A3 (510) 222-4100 Palo Alto, CA 94304 Fax (650) 222-8410	<b>Leonwood, Andrews &amp; Newman, Inc.</b> A LEAD & BARRY COMPANY	<b>T-Y-LIN INTERNATIONAL</b>
SUBMITTED <i>[Signature]</i>	APPROVED <i>[Signature]</i>		




LINE, TRACK, STATIONS AND SYSTEMS  
DESIGN UNIT 023  
MILPITAS STATION  
DETAILS  
SHEET 14 OF 17

CADD FILENAME C700-S-DB-S694.dwg	
SIZE D	SCALE 1 1/2"= 1'-0"
CONTRACT NO. C700	REV. 0
AREA CODE DB	SHEET NO. S694
	PAGE NO. 0240



NOTES:

1. FOR CONCRETE STAIRS DETAILS, REFER TO DRAWING DB-S722 FOR DETAILED INFORMATION.

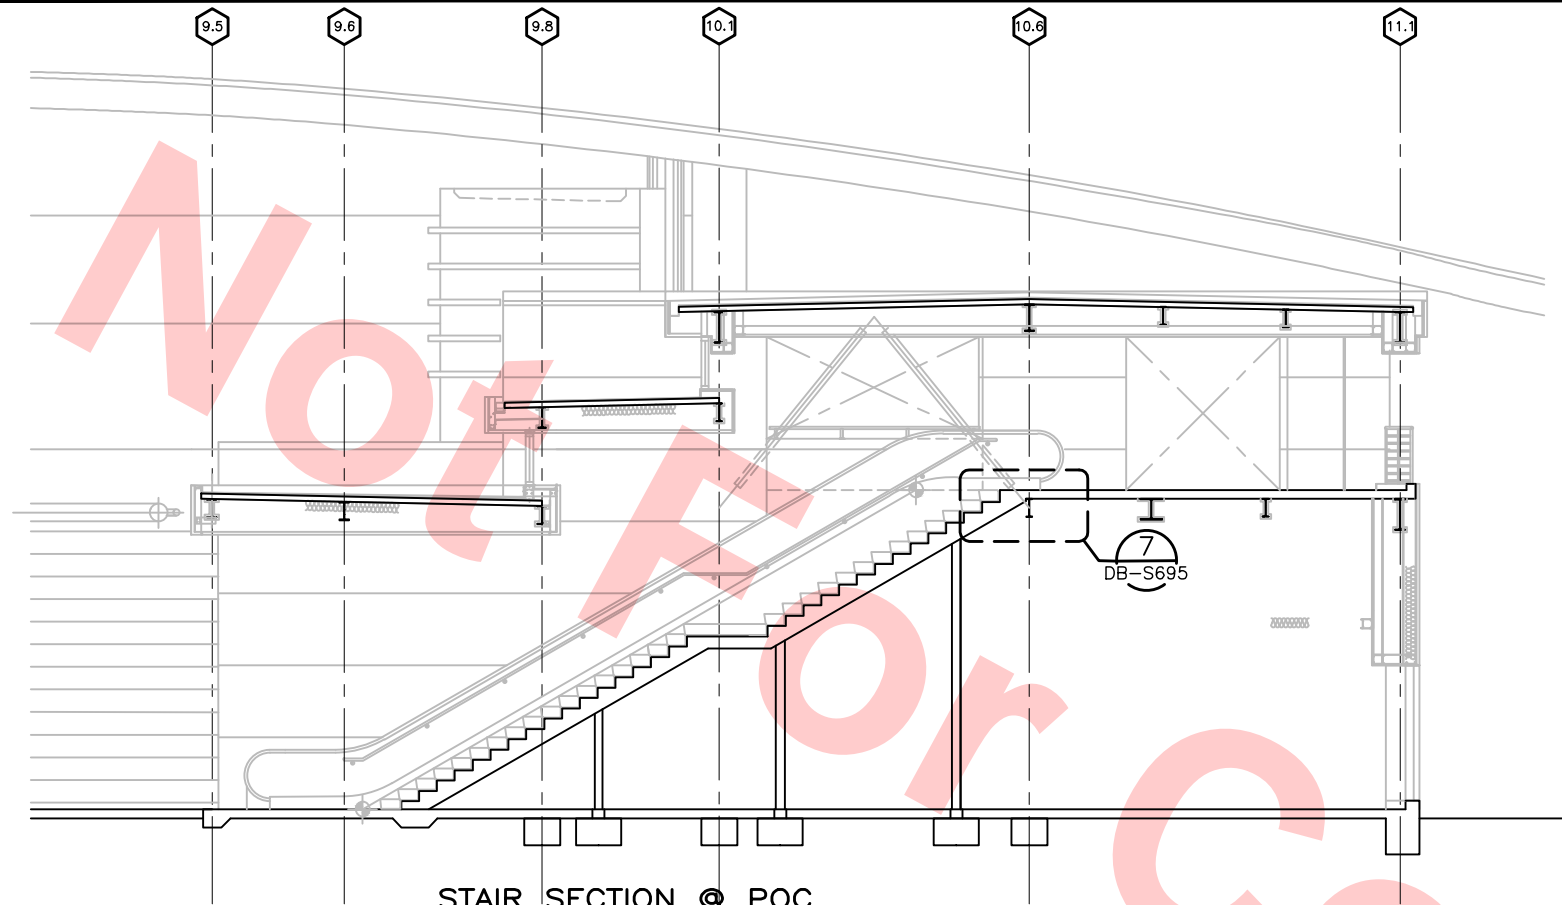


STAIR SECTION @ POC ENTRY

SCALE: 3/16"=1'-0"

1  
DB-S695

DB-S125  
DB-S134  
DB-S149

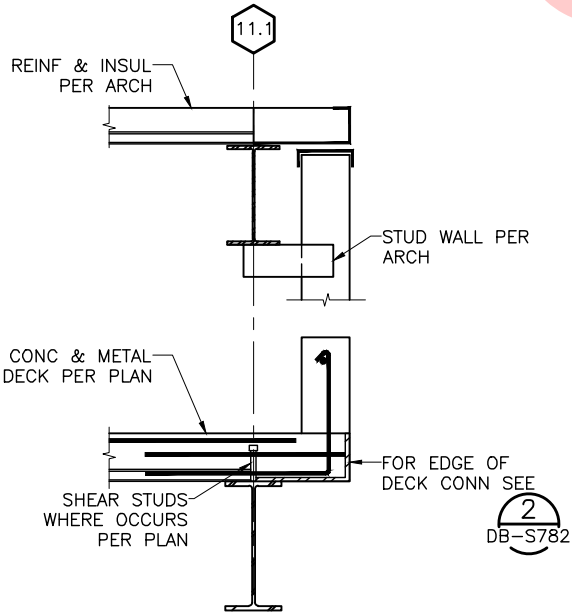


SECTION 6

SCALE: 1"=1'-0"

6  
DB-S695

DB-S134  
DB-S149

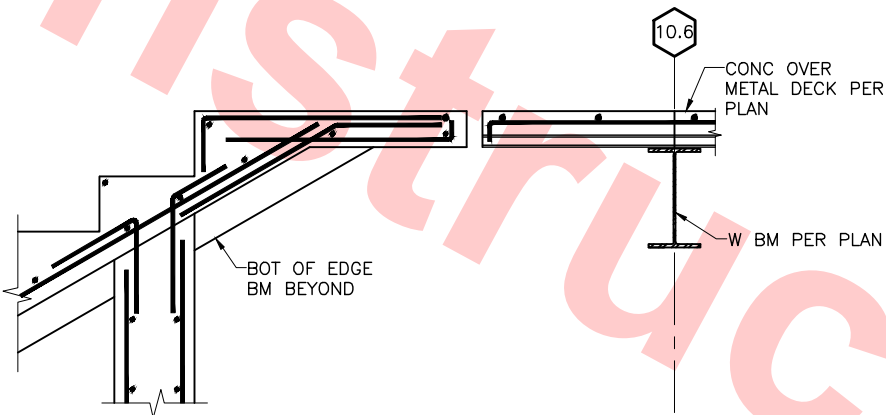

SECTION 7

SCALE: 1"=1'-0"

7  
DB-S695

DB-S695

Santa Clara Valley Transportation Authority

- NO EXCEPTIONS TAKEN (NET)
- MAKE CORRECTIONS NOTED (MCN)
- AMEND AND RESUBMIT (A/R)

Any action shown above is subject to the terms of the contract and does not relieve the Contractor of any of its obligations under the contract, including design and detailing.

Contract No.: DB11002F

By: \_\_\_\_\_ Date: \_\_\_\_\_

Jul 05, 2013 - 1:56pm P:\BART Berryessa Extension Line\AS - STRUCTURAL MILPITAS WORK\_6-10-2012\0700-S-DB-S695.dwg

REV	DATE	BY	SUB	APP	DESCRIPTION
0	20130710				READINESS FOR CONSTRUCTION

DESIGNED BY  
J. REBER, S.E.  
DRAWN BY  
P. DIAZ  
CHECKED BY  
M. TARAZI  
IN CHARGE  
M. TARAZI  
DATE  
20130710



Skanska  
Shimmick  
Herzog  
1436 California Circle  
Milpitas, California 95035  
A Joint Venture  
MFT CONSULTING ENGINEERS, INC. Anil Verma Associates, Inc.  
1773 San Pablo Ave., Suite A3 (510) 222-4100  
Palo Alto, CA 94304 Fax: (510) 222-8410


Lealwood, Andrews & Newman, Inc. T-Y-LIN INTERNATIONAL  
A LEAD A BALLY COMPANY  
APPROVED




LINE, TRACK, STATIONS AND SYSTEMS  
DESIGN UNIT 023  
MILPITAS STATION  
DETAILS  
SHEET 15 OF 17

CADD FILENAME C700-S-DB-S695.dwg	SIZE D	SCALE AS NOTED
CONTRACT NO. C700	SHEET NO. S695	PAGE NO. 0241




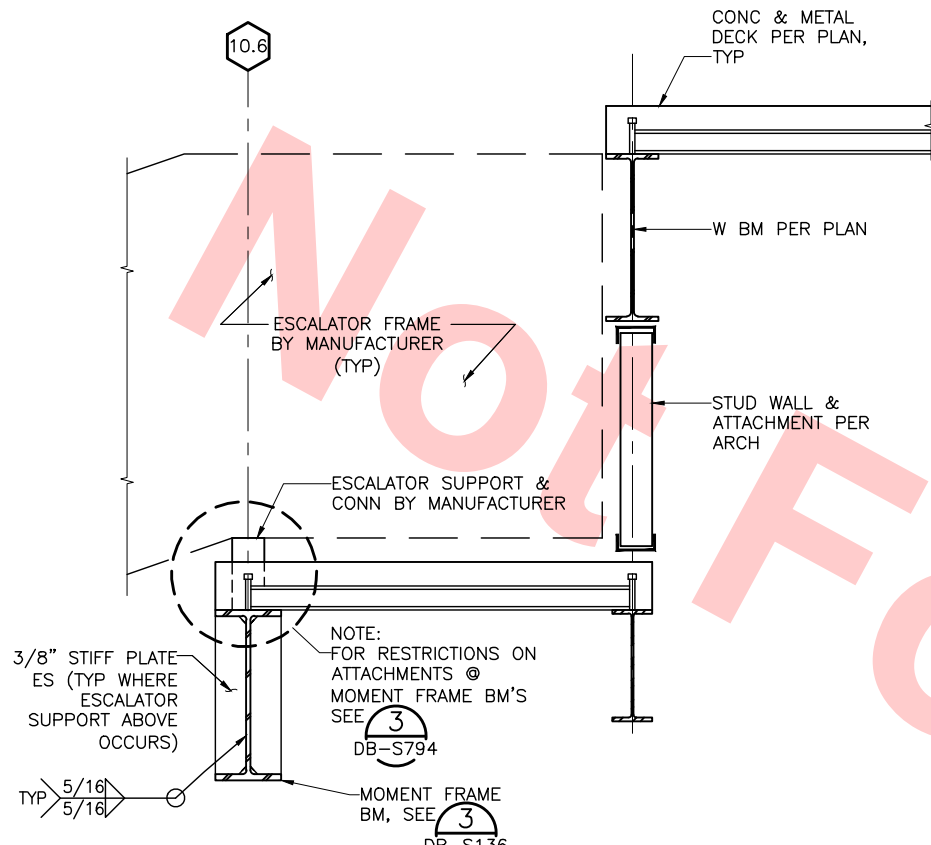

**SECTION 1**  
SCALE: 1"=1'-0"  
DB-S134

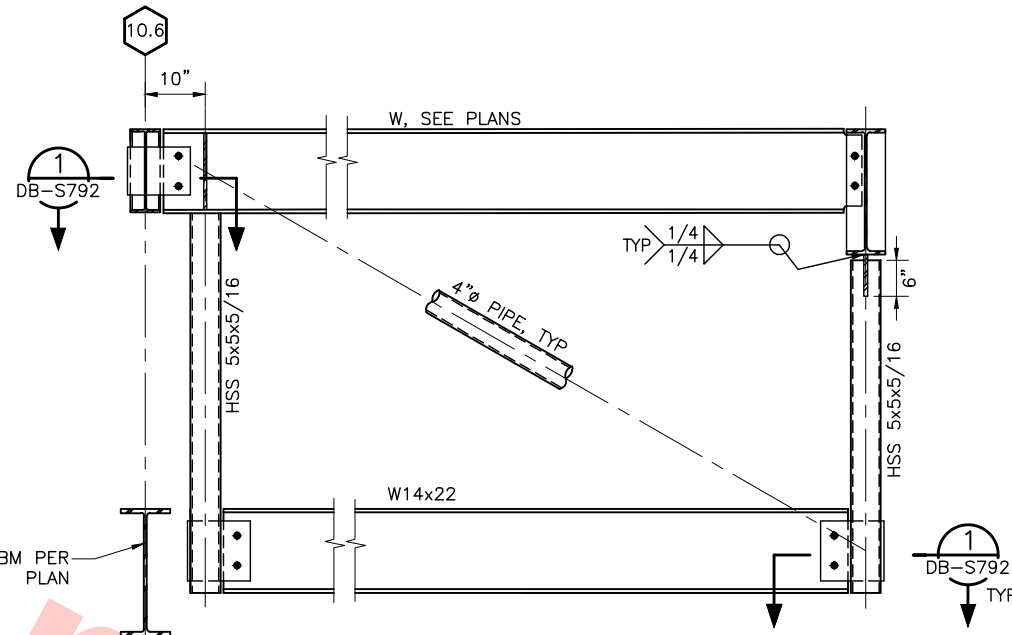

**SECTION 2**  
SCALE: 3/4"=1'-0"  
DB-S134

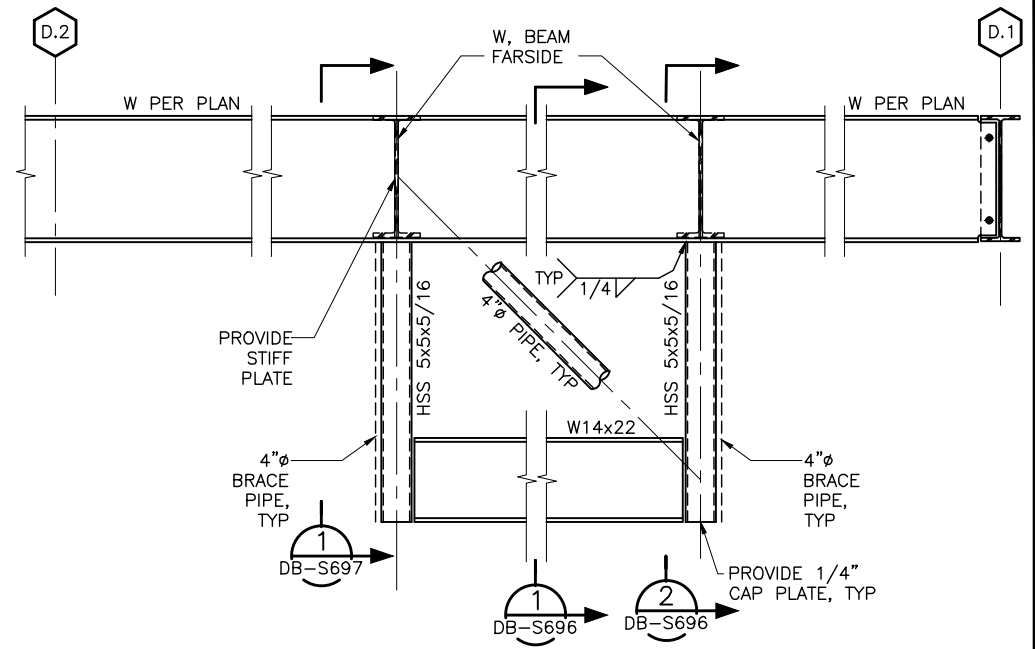

**SECTION 3**  
SCALE: 3/4"=1'-0"  
DB-S134


**Santa Clara Valley Transportation Authority**

\_\_\_ NO EXCEPTIONS TAKEN (NET)  
\_\_\_ MAKE CORRECTIONS NOTED (MCN)  
\_\_\_ AMEND AND RESUBMIT (A/R)


Any action shown above is subject to the terms of the contract and does not relieve the Contractor of any of its obligations under the contract, including design and detailing.

Contract No.: DB11002F


By: \_\_\_\_\_ Date: \_\_\_\_\_

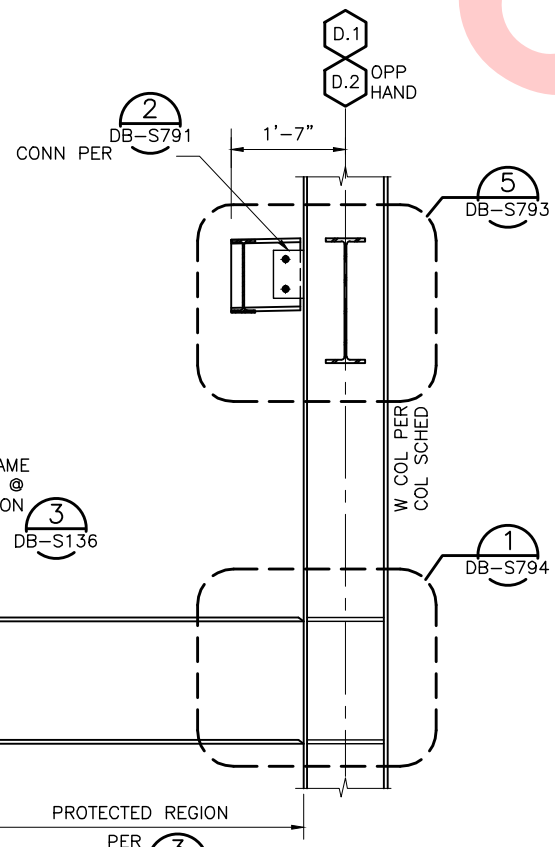

**SECTION 4**  
SCALE: 3/4"=1'-0"  
DB-S136

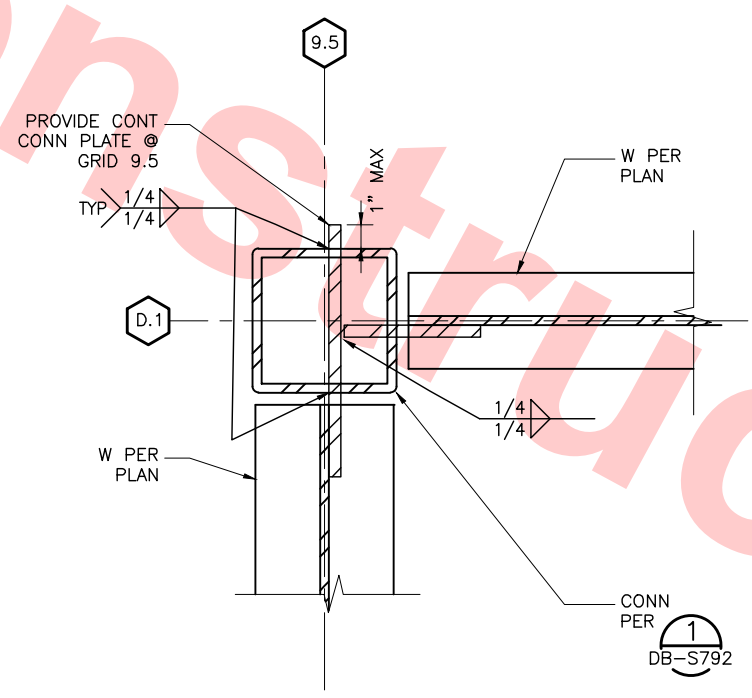

**DETAIL PLAN 5**  
SCALE: 3"=1'-0"  
DB-S696

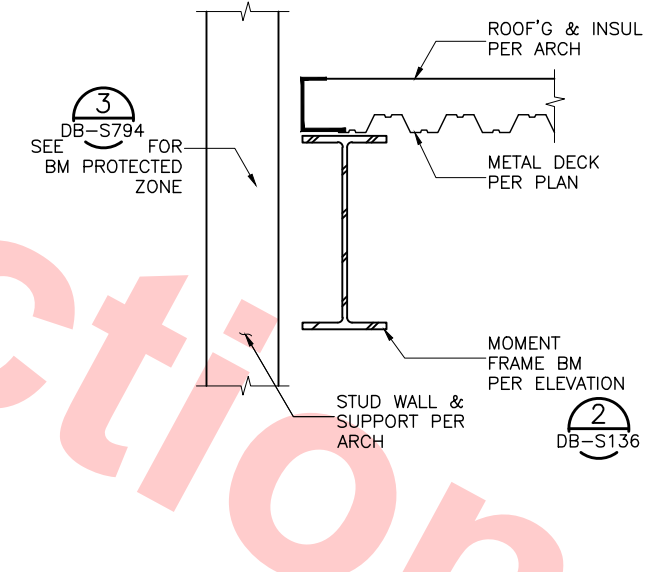

**DETAIL 6**  
SCALE: 1 1/2"=1'-0"  
DB-S149

Jul 05, 2013 1:56pm P:\BART Berryessa Extension Line\AS - STRUCTURAL\MILPITAS WORK\6-10-2012\0700-S-DB-S696.dwg

REV	DATE	BY	SUB	APP	DESCRIPTION
0	20130710				READINESS FOR CONSTRUCTION

DESIGNED BY  
J. REBER, S.E.

DRAWN BY  
P. DIAZ

CHECKED BY  
M. TARAZI

IN CHARGE  
M. TARAZI

DATE  
20130710



**Skanska Shimmick Herzog**

1436 California Circle  
Milpitas, California 95035  
A Joint Venture

MFT CONSULTING ENGINEERS, Inc. Anil Verma Associates, Inc.  
1773 San Pablo Ave., Suite A3 (510) 222-4100  
Palo Alto, CA 94304 Fax (650) 222-8410

**Lealwood, Andrews & Newman, Inc.**  
T-Y-LIN INTERNATIONAL

APPROVED *[Signature]*




**LINE, TRACK, STATIONS AND SYSTEMS**  
**DESIGN UNIT 023**  
MILPITAS STATION  
DETAILS

SHEET 16 OF 17

CADD FILENAME C700-S-DB-S696.dwg	SIZE D	SCALE AS NOTED
CONTRACT NO. C700	REV. 0	
AREA CODE DB	SHEET NO. S696	PAGE NO. 0242



004-02 Jul 05, 2013 - 1:56pm P:\BART Berryessa Extension Line\AS - STRUCTURAL MILPITAS WORK\_8-10-2012\0700-S-DB-S697.dwg

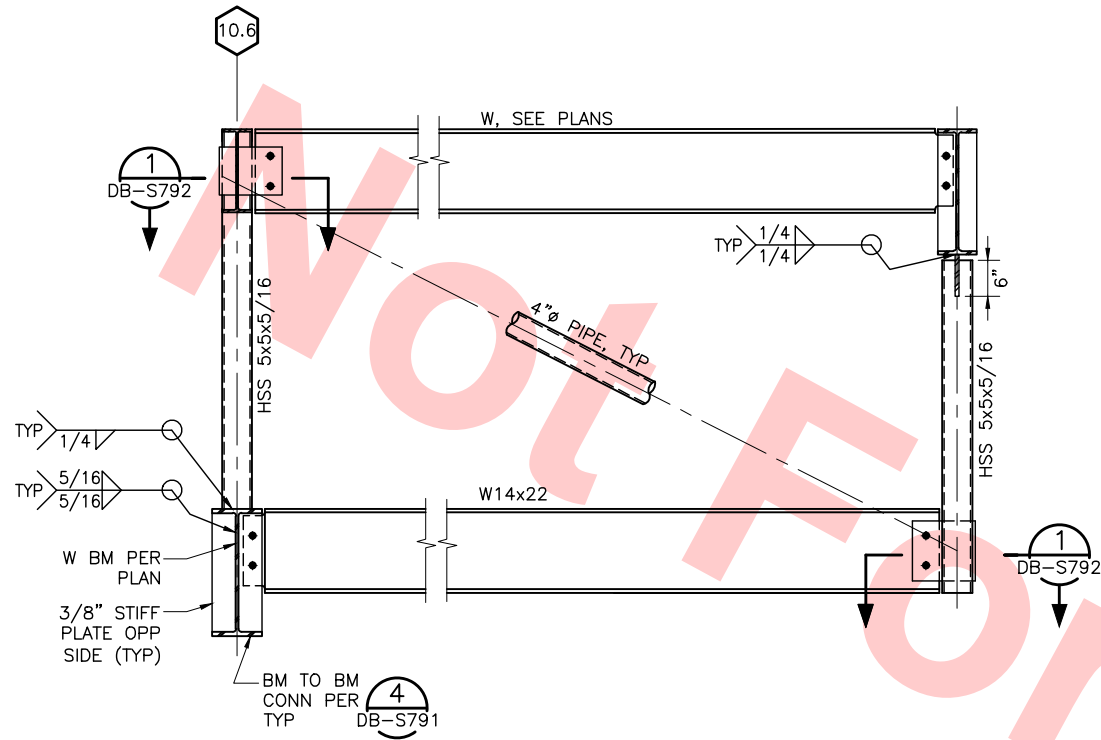

SECTION 1 DB-S134  
SCALE: 3/4"=1'-0"

Santa Clara Valley Transportation Authority

\_\_\_ NO EXCEPTIONS TAKEN (NET)  
\_\_\_ MAKE CORRECTIONS NOTED (MCN)  
\_\_\_ AMEND AND RESUBMIT (A/R)

Any action shown above is subject to the terms of the contract and does not relieve the Contractor of any of its obligations under the contract, including design and detailing.

Contract No.: DB11002F

By: \_\_\_\_\_ Date: \_\_\_\_\_

REV	DATE	BY	SUB	APP	DESCRIPTION
0	20130710				READINESS FOR CONSTRUCTION

DESIGNED BY  
J. REBER, S.E.  
DRAWN BY  
P. DIAZ  
CHECKED BY  
M. TARAZI  
IN CHARGE  
M. TARAZI  
DATE  
20130710



Skanska  
Shimmick  
Herzog  
MFT CONSULTING ENGINEERS, Inc. Anil Verma Associates, Inc.  
1773 San Pablo Ave., Suite A3 (510) 222-4100  
Pinole, CA 94664 Fax (510) 222-8410

1436 California Circle  
Milpitas, California 95035  
A Joint Venture  
Leonwood, Andrews & Newman, Inc. T-Y-LIN INTERNATIONAL  
A LEAD & BALLY COMPANY




LINE, TRACK, STATIONS AND SYSTEMS  
DESIGN UNIT 023  
MILPITAS STATION  
DETAILS  
SHEET 17 OF 17





CADD FILENAME C700-S-DB-S697.dwg	SIZE D	SCALE AS NOTED
CONTRACT NO. C700	SHEET NO. DB	PAGE NO. 0243

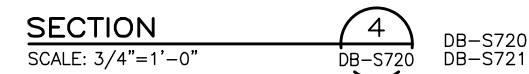

cad-02 Jul 05, 2013 - 1:56pm P:\BART Berryessa Extension Line\S - STRUCTURAL MILPITAS\WORK\_6-10-2013\C700-S-DB-S720.dwg




**SECTION**  
SCALE:  $3/4" = 1'-0"$

					DESIGNED BY J. REBER, S.E.			Skanska Shimmick Herzog  1436 California Circle Milpitas, California 95035 A Joint Venture		 MFT CONSULTING ENGINEERS INC. Anil Verma Associates, Inc. 1775 San Pablo Ave., Suite A-3 (510) 222-6106 Pinole, CA 94564 Fax (510) 222-6418		 LOCKWOOD, ANDREWS & NEWNAM, INC. A L&N A B&N COMPANY T-Y-LIN INTERNATIONAL				LINE, TRACK, STATIONS AND SYSTEMS DESIGN UNIT 023 MILPITAS STATION STAIRS SECTIONS AND DETAILS SHEET 1 OF 4				CADD FILENAME C700-S-DB-S720.dwg			
					DRAWN BY P. DIAZ															SIZE D SCALE AS NOTED		CONTRACT NO. C700 REV. 0	
					CHECKED BY M. TARAZI																		
					IN CHARGE M. TARAZI																		
0 20130531					READINESS FOR CONSTRUCTION		DATE 20130531												AREA CODE DB SHEET NO. S720 PAGE NO. 0244				
REV DATE BY SUB APP DESCRIPTION																							




Jul 05, 2013 - 1:56pm P:\BART Berryessa Extension Line\AS - STRUCTURAL MILPITAS WORK\6-10-2012\CT00-S-DB-S721.dwg

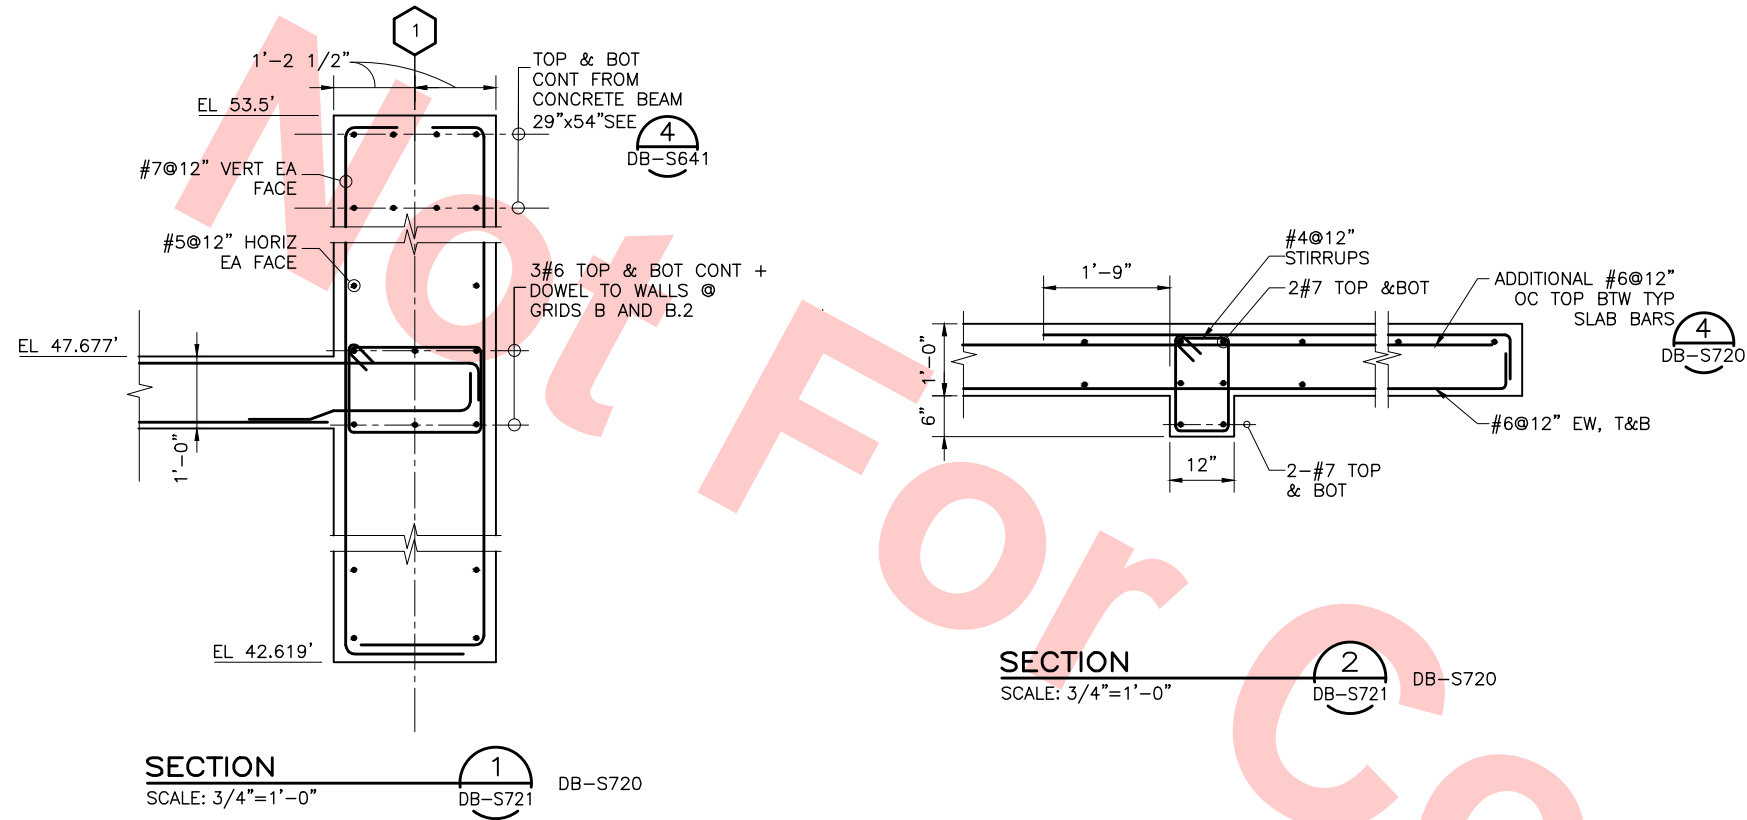

FOR REFERENCE ONLY AND NOT FOR REVIEW. THIS  
DRAWING WAS ALREADY SUBMITTED UNDER DU23-  
WP08 RFC TRENCH PACKAGE.

						DESIGNED BY J. REBER, S.E.		<div>Skanska Shimmick Herzog</div> <div>1436 California Circle Milpitas, California 95035 A Joint Venture</div>		<div></div> <div>BART SILICON VALLEY BERRYESSA EXTENSION</div>	<div>LINE, TRACK, STATIONS AND SYSTEMS DESIGN UNIT 023 MILPITAS STATION STAIRS SECTIONS AND DETAILS SHEET 2 OF 4</div>			CADD FILENAME C700-S-DB-S721.dwg			
						DRAWN BY P. DIAZ								SIZE D	SCALE 3/4" = 1'-0"		
						CHECKED BY M. TARAZI								CONTRACT NO. C700	REV. 0		
						IN CHARGE M. TARAZI								AREA CODE DB	SHEET NO. S721	PAGE NO. 0245	
0	20130531				READINESS FOR CONSTRUCTION		<div>MFT CONSULTING ENGINEERS, Inc. Anil Verma Associates, Inc. 1773 San Pablo Ave., Suite A3 (510) 222-4166 Pinole, CA 94664 Fax (510) 222-6418</div>		<div></div> <div>T-Y-LIN INTERNATIONAL</div>								
REV	DATE	BY	SUB	APP	DESCRIPTION												



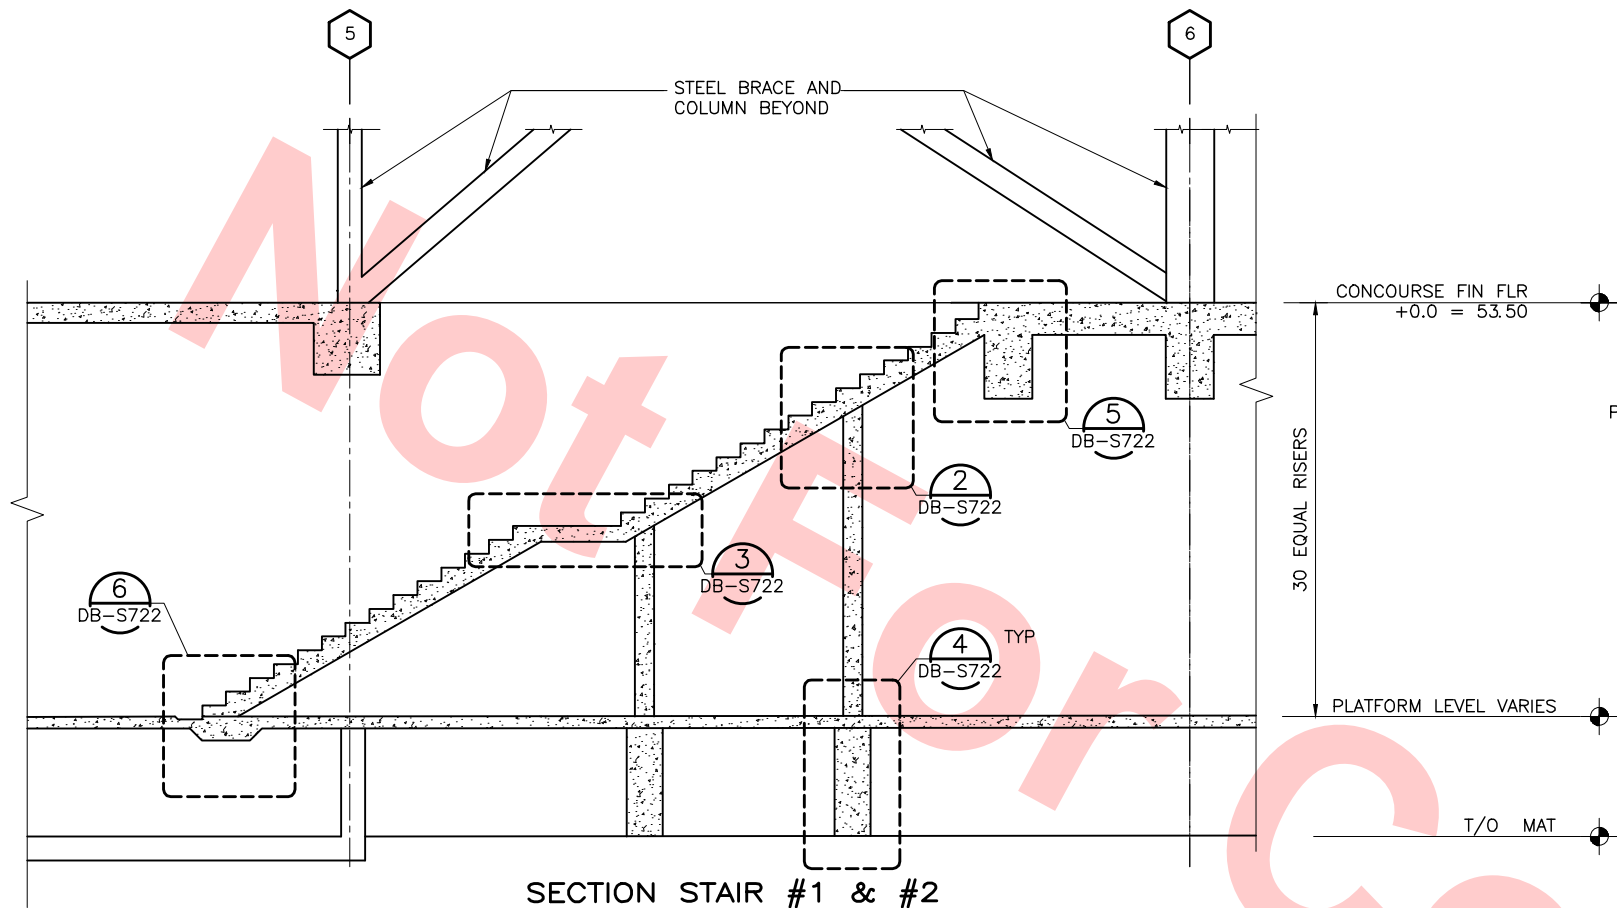


SECTION STAIR #1 & #2  
(STAIR #3  
& #4 SIM)

SCALE: 1/4"=1'-0"

1  
DB-S722


DB-S072  
DB-S112

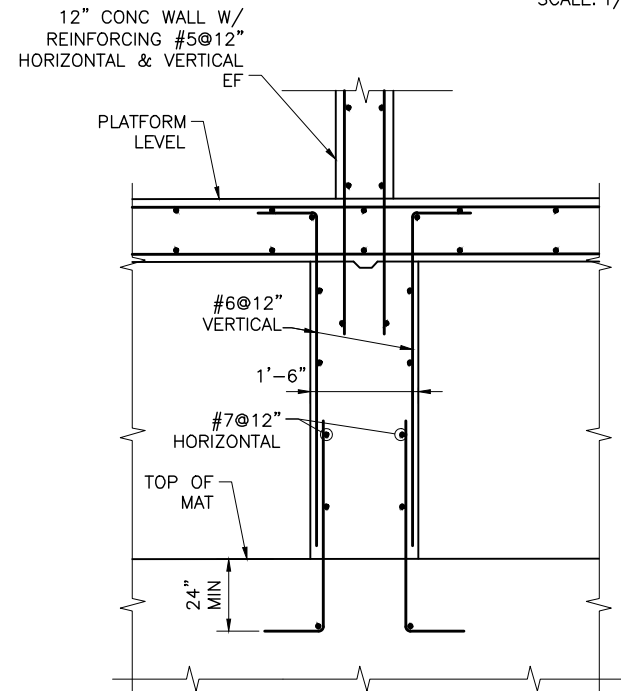

DETAIL  
SCALE: 3/4"=1'-0"

4  
DB-S722


DB-S722

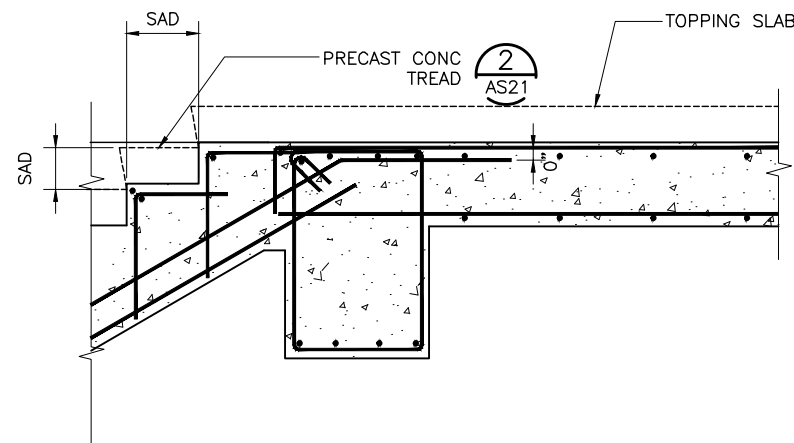

SECTION  
SCALE: 3/4"=1'-0"

5  
DB-S722


DB-S722

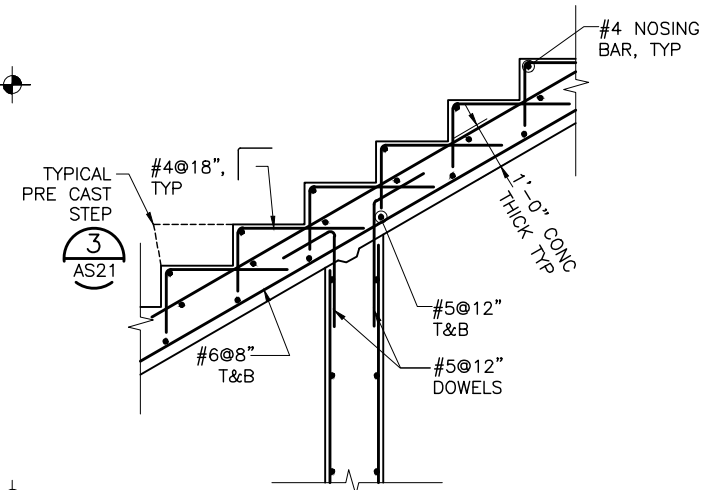

DETAIL  
SCALE: 3/4"=1'-0"

2  
DB-S722


DB-S722

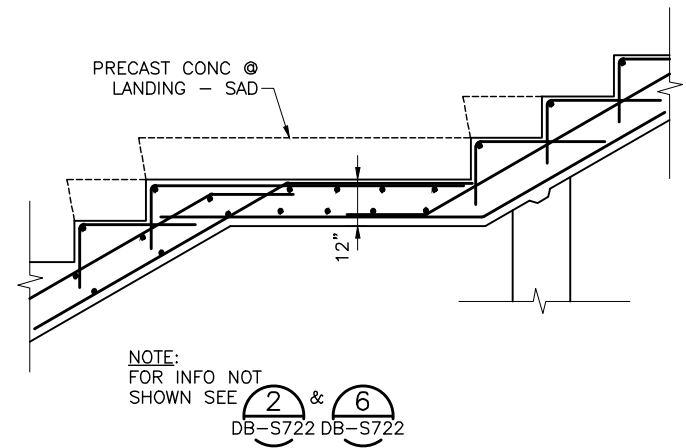

DETAIL  
SCALE: 3/4"=1'-0"

3  
DB-S722

DB-S722

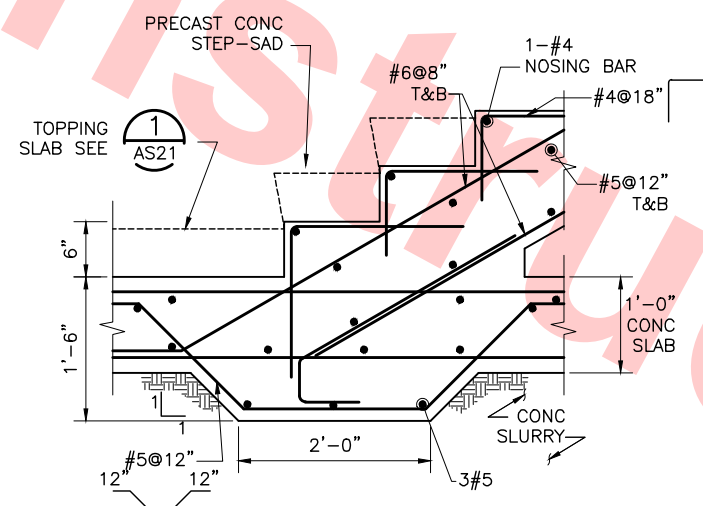

SECTION  
SCALE: 1"=1'-0"

6  
DB-S722


DB-S722  
DB-S114

FOR REFERENCE ONLY AND NOT FOR REVIEW. THIS  
DRAWING WAS ALREADY SUBMITTED UNDER DU23-  
WP08 RFC TRENCH PACKAGE.

Jul 05, 2013 1:56pm P:\BART Berryessa Extension Line\AS - STRUCTURAL MILPITAS WORK\6-10-2012\0700-S-DB-S722.dwg

REV	DATE	BY	SUB	APP	DESCRIPTION
0	20130531				READINESS FOR CONSTRUCTION

DESIGNED BY  
J. REBER, S.E.  
DRAWN BY  
P. DIAZ  
CHECKED BY  
M. TARAZI  
IN CHARGE  
M. TARAZI  
DATE  
20130531

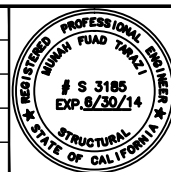

Skanska  
Shimmick  
Herzog  
1436 California Circle  
Milpitas, California 95035  
A Joint Venture  
MFT CONSULTING ENGINEERS, INC. Anil Verma Associates, Inc.  
1773 San Pablo Ave., Suite A3 (510) 222-4166  
Pinole, CA 94664 Fax (510) 222-6419


Lealwood, Andrews  
& Newman, Inc.  
A LEO A DALY COMPANY  
T-Y-LIN INTERNATIONAL  
SUBMITTED  
APPROVED



LINE, TRACK, STATIONS AND SYSTEMS  
DESIGN UNIT 023  
MILPITAS STATION  
STAIRS SECTIONS  
AND DETAILS  
SHEET 3 OF 4

CADD FILENAME C700-S-DB-S722.dwg	CONTRACT NO. C700	REV. 0
SIZE D	SCALE AS NOTED	AREA CODE DB
SHEET NO. S722	PAGE NO. 0246	



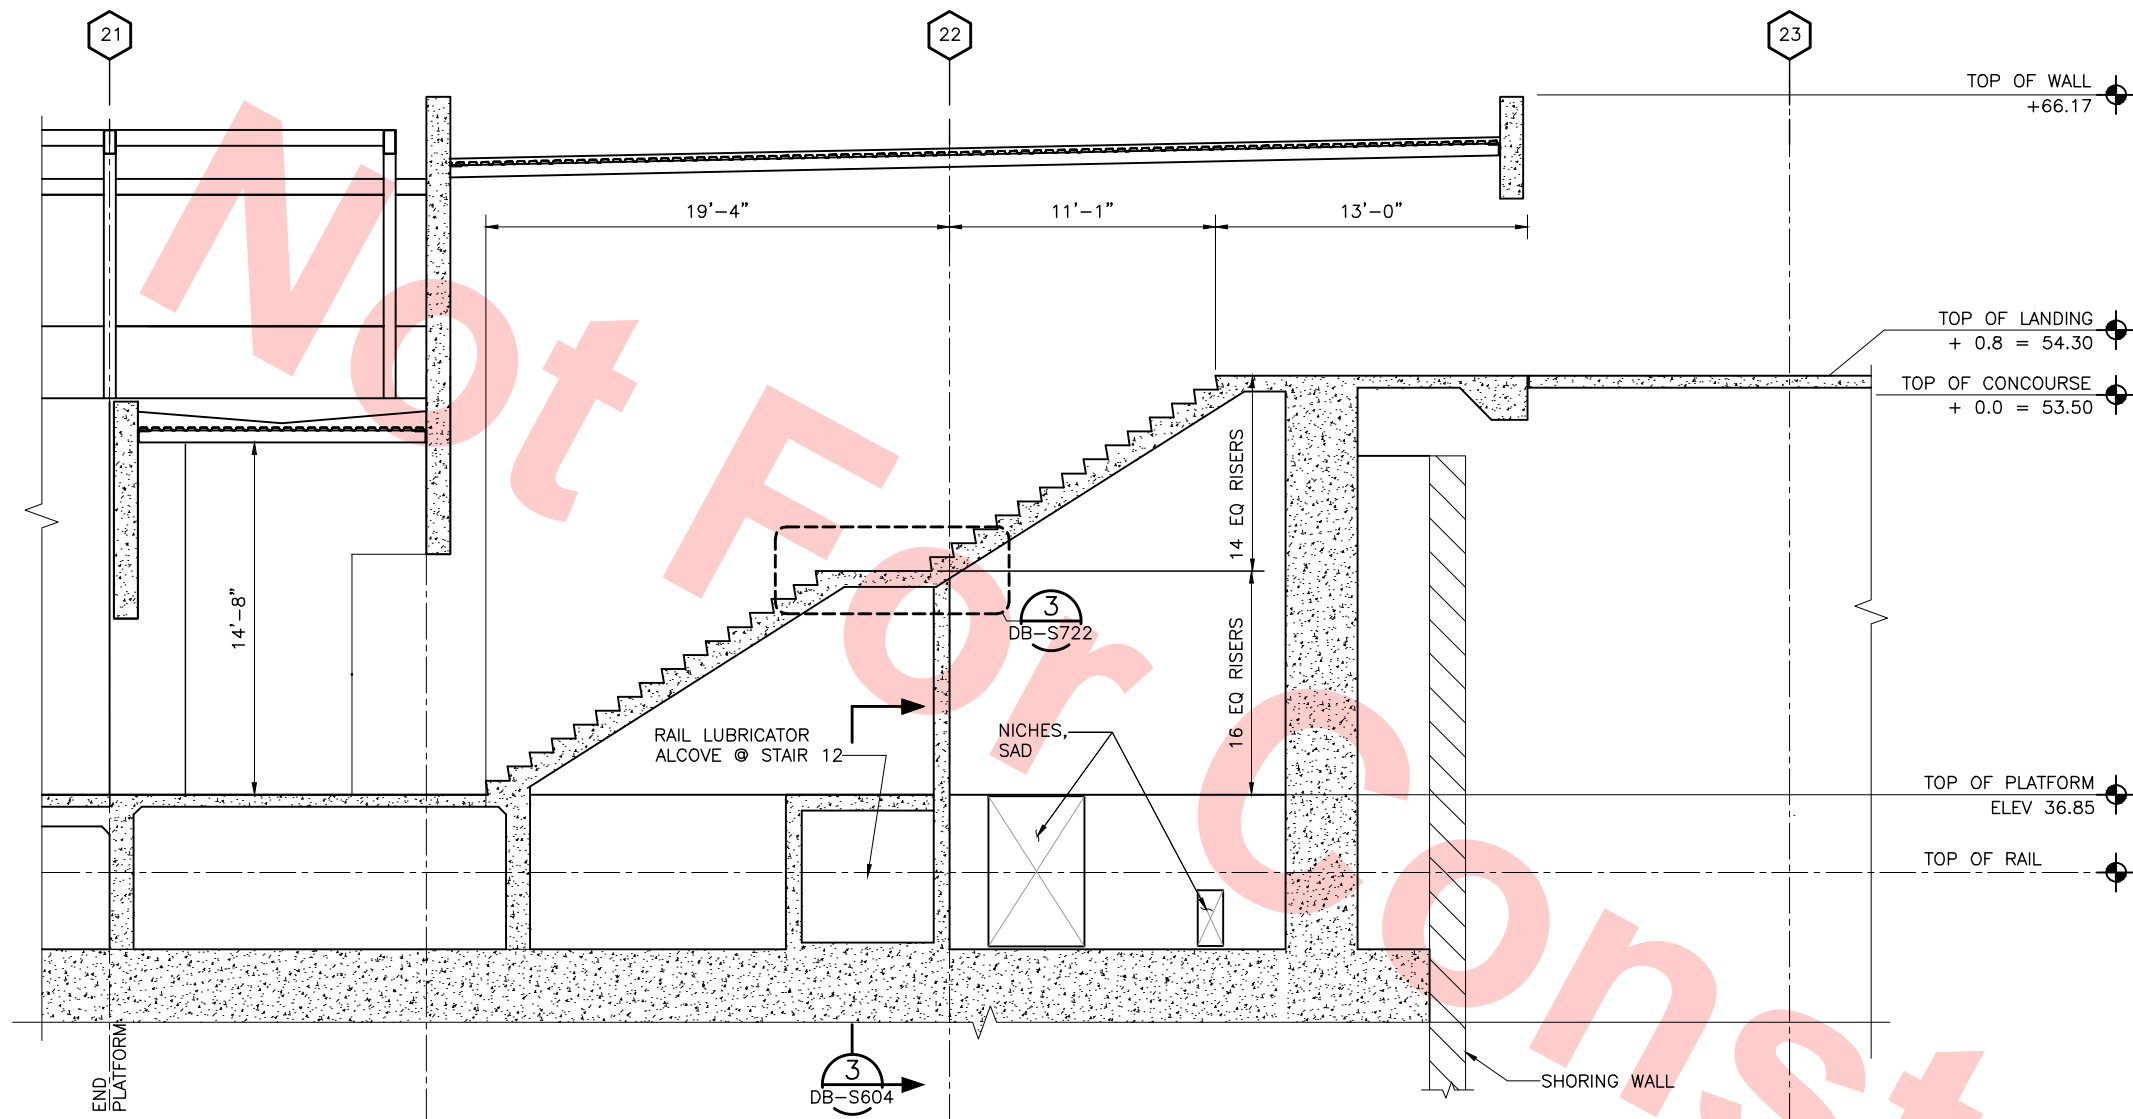

SECTION  
SCALE: 1/4"=1'-0"

1  
DB-S723


DB-S076  
DB-S116  
DB-S148

FOR REFERENCE ONLY AND NOT FOR REVIEW. THIS  
DRAWING WAS ALREADY SUBMITTED UNDER DU23-  
WP08 RFC TRENCH PACKAGE.

Jul 05, 2013 1:56pm P:\BART Berryessa Extension Line\AS - STRUCTURAL MILPITAS WORK\6-10-2012\0700-S-DB-S723.dwg

REV	DATE	BY	SUB	APP	DESCRIPTION
0	20130710				READINESS FOR CONSTRUCTION
0	20130531				READINESS FOR CONSTRUCTION

DESIGNED BY J. REBER, S.E.
DRAWN BY P. DIAZ
CHECKED BY M. TARAZI
IN CHARGE M. TARAZI
DATE 20130710

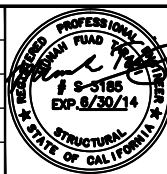

Skanska  
Shimmick  
Herzog

1436 California Circle  
Milpitas, California 95035  
A Joint Venture

MFT CONSULTING ENGINEERS, Inc. Anil Verma Associates, Inc.  
1773 San Pablo Ave., Suite A3 (510) 222-4168  
Pleasanton, CA 94566 Fax (916) 222-8410

Lealwood, Andrews  
& Newman, Inc.  
A LEO A DALY COMPANY

T-Y-LIN INTERNATIONAL




LINE, TRACK, STATIONS AND SYSTEMS  
DESIGN UNIT 023  
MILPITAS STATION  
STAIRS SECTIONS  
AND DETAILS  
SHEET 4 OF 4

CADD FILENAME C700-S-DB-S723.dwg		
SIZE D	SCALE AS NOTED	
CONTRACT NO. C700		REV. 0
AREA CODE DB	SHEET NO. S723	PAGE NO. 0247




- NOTE:
1. FOR GENERAL NOTES, SEE DWG NO DB-S001X, DB-S002X, AND DB-S003X.
  2. (BF-7) INDICATES BRACED FRAME. SEE STEEL FRAMING ELEVATIONS ON DB-S501, DB-S502 & DB-S503 SHEETS.

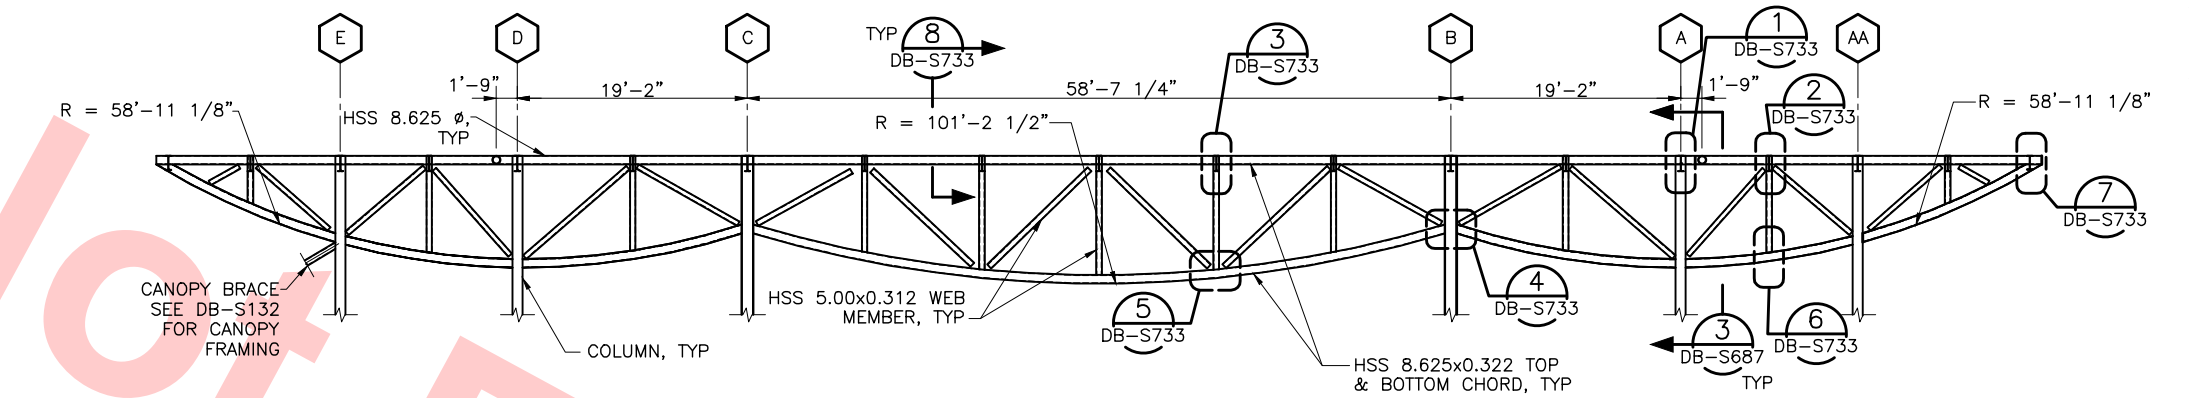

TRUSS - T1 (GRIDS 8 & 9)

SCALE: 1/8" = 1'-0"


DB-S142  
DB-S143  
DB-S144  
DB-S145

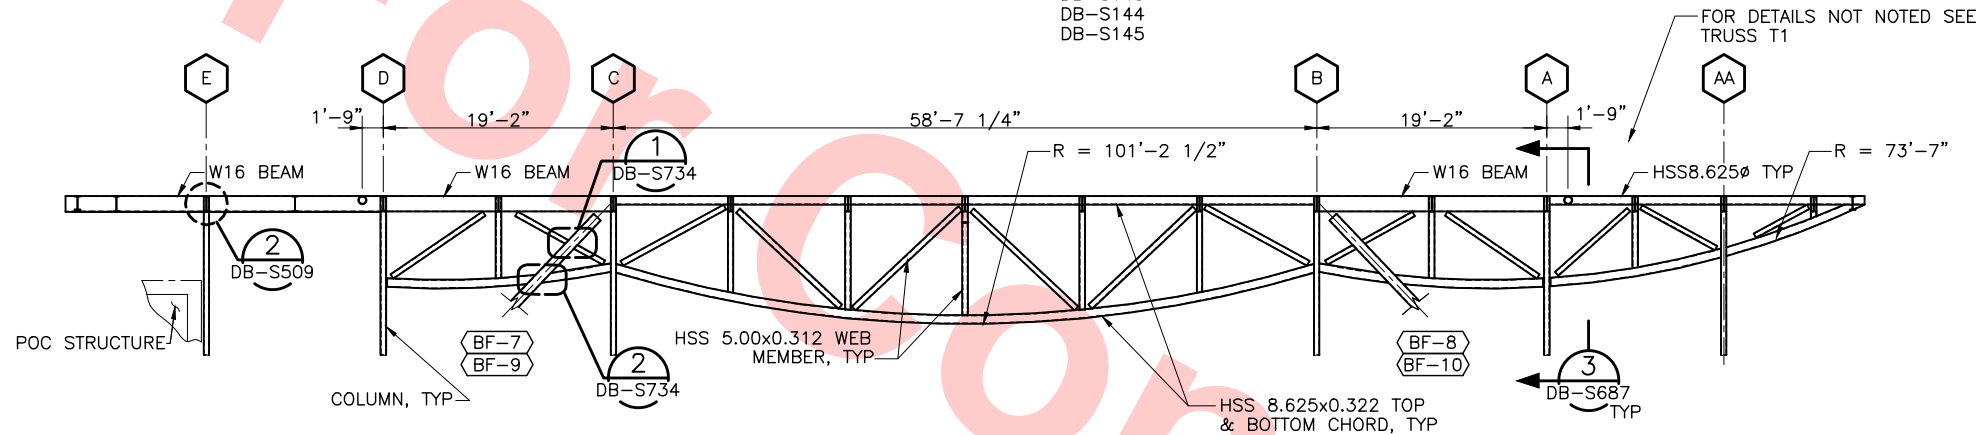

TRUSS - T2 (GRIDS 7 & 10)

SCALE: 1/8" = 1'-0"

DB-S142  
DB-S143  
DB-S144  
DB-S145

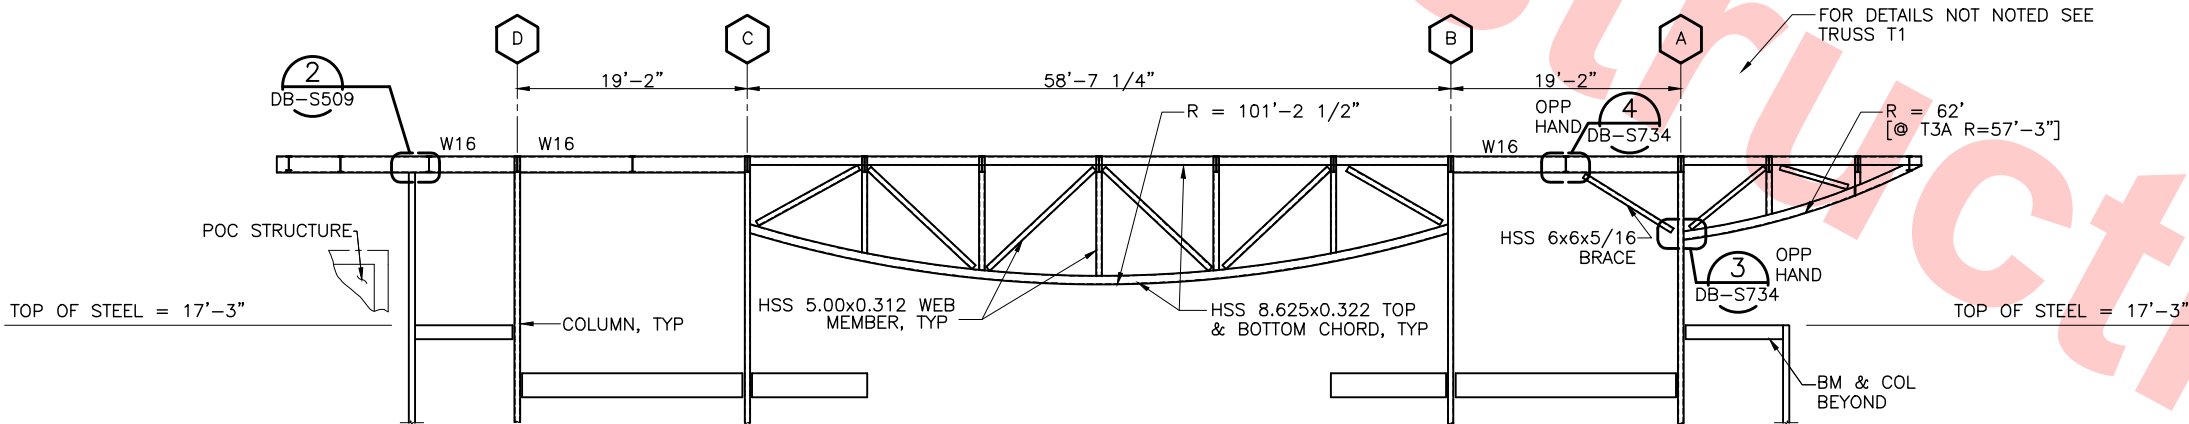

TRUSS - T3 (GRID 6) [T3A @ GRID 11]

SCALE: 1/8" = 1'-0"

DB-S142  
DB-S143  
DB-S144  
DB-S145

Santa Clara Valley Transportation Authority

NO EXCEPTIONS TAKEN (NET)  
MAKE CORRECTIONS NOTED (MCN)  
AMEND AND RESUBMIT (A/R)

Any action shown above is subject to the terms of the contract and does not relieve the Contractor of any of its obligations under the contract, including design and detailing.

Contract No.: DB11002F

By: \_\_\_\_\_ Date: \_\_\_\_\_

Jul 05, 2013 - 1:56pm P:\BART Berryessa Extension Line\AS - STRUCTURAL MILPITAS WORK\6-10-2012\0700-S-DB-S731.dwg


REV	DATE	BY	SUB	APP	DESCRIPTION
0	20130710				READINESS FOR CONSTRUCTION

DESIGNED BY  
J. REBER, S.E.  
DRAWN BY  
P. DIAZ  
CHECKED BY  
M. TARAZI  
IN CHARGE  
M. TARAZI  
DATE  
20130710



Skanska  
Shimmick  
Herzog  
1436 California Circle  
Milpitas, California 95035  
A Joint Venture  
MFT CONSULTING ENGINEERS, INC. Anil Verma Associates, Inc.  
1773 San Pablo Ave., Suite A3 (510) 222-4100  
Palo Alto, CA 94304 Fax (415) 222-8410

Lealwood, Andrews & Newman, Inc.  
T-Y-LIN INTERNATIONAL  
APPROVED



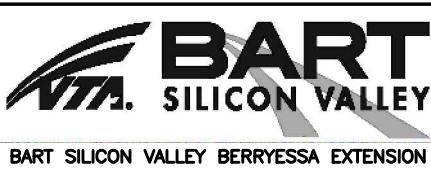


LINE, TRACK, STATIONS AND SYSTEMS  
DESIGN UNIT 023  
MILPITAS STATION  
ROOF TRUSS FRAMING  
SECTIONS AND DETAILS  
SHEET 1 OF 4

CADD FILENAME C700-S-DB-S731.dwg	CONTRACT NO. C700	REV. 0
SIZE D	SCALE 1/8" = 1'-0"	AREA CODE DB
SHEET NO. S731	PAGE NO. 0248	



- NOTE:
- FOR GENERAL NOTES, SEE DWG NO DB-S001X, DB-S002X, AND DB-S003X.
  - CLOUDED AREAS: DELETED TRUSS MEMBERS AND CHANGED TO WIDE FLANGE BEAMS AS THE TRUSS IS NOT EXPOSED TO THE PUBLIC.
  - BF-7** INDICATES BRACED FRAME. SEE STEEL FRAMING ELEVATIONS ON DB-S501, DB-S502 & DB-S503 SHEETS.

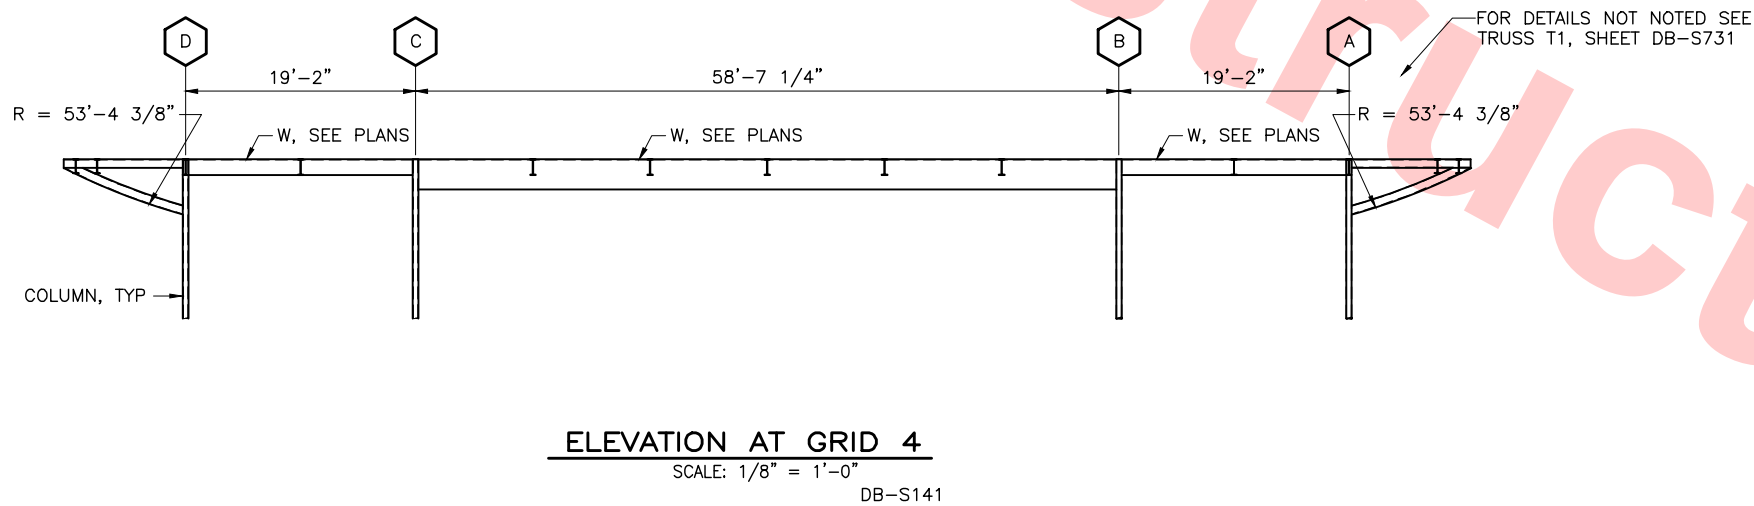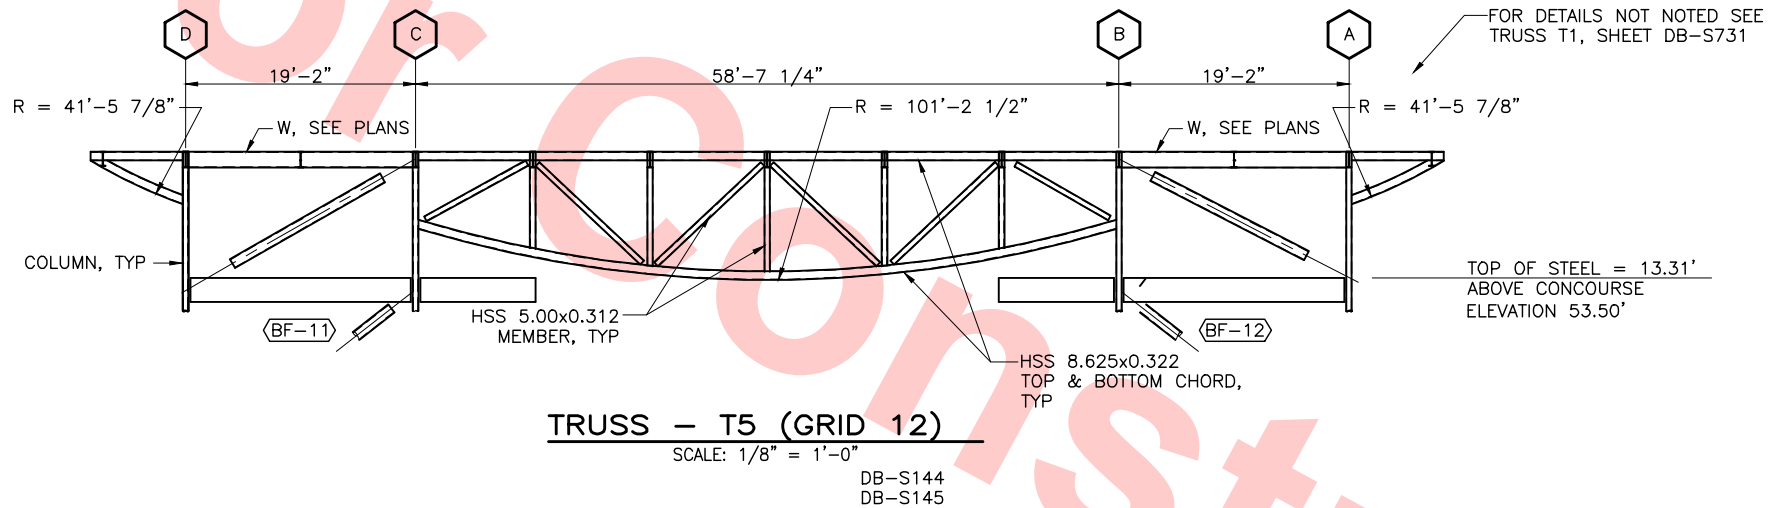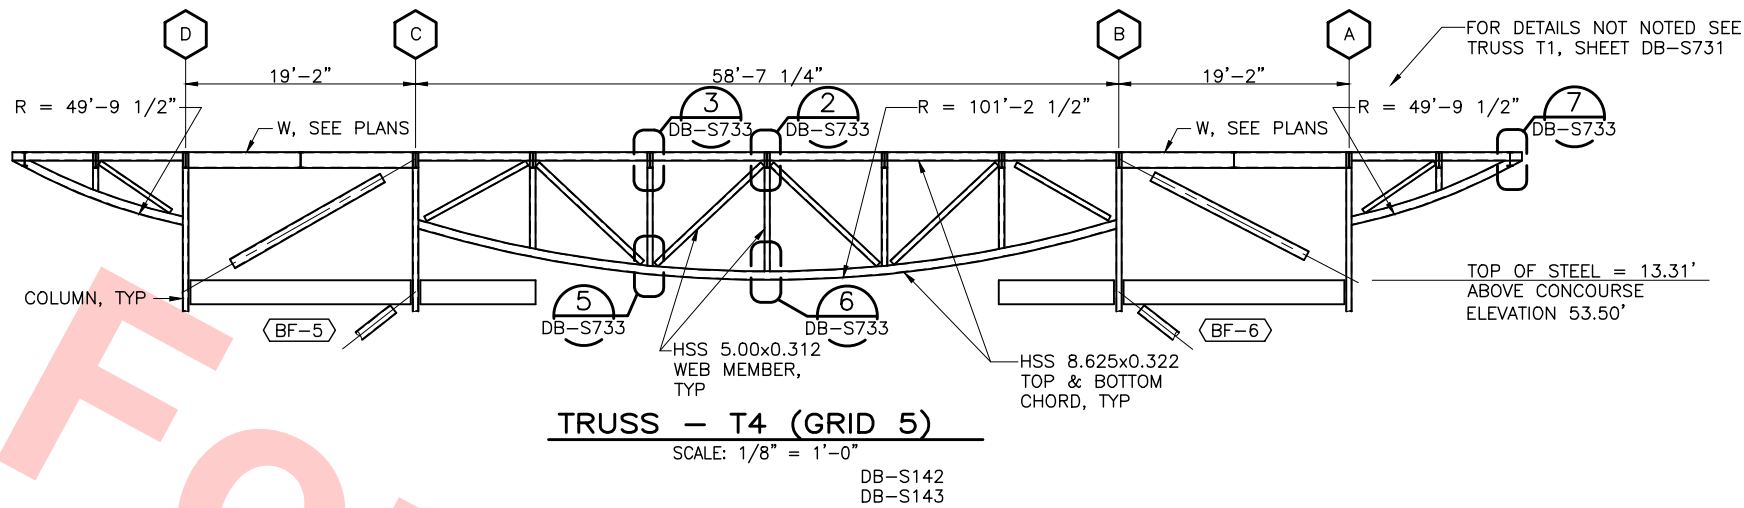

Santa Clara Valley Transportation Authority



NO EXCEPTIONS TAKEN (NET)  
MAKE CORRECTIONS NOTED (MCN)  
AMEND AND RESUBMIT (A/R)

Any action shown above is subject to the terms of the contract and does not relieve the Contractor of any of its obligations under the contract, including design and detailing.


Contract No.: DB11002F

By: \_\_\_\_\_ Date: \_\_\_\_\_


Jul 05, 2013 - 1:56pm P:\BART Berryessa Extension Line\AS - STRUCTURAL MILPITAS WORK\6-10-2012\CT00-S-DB-S732.dwg

0						20130710						READINESS FOR CONSTRUCTION						DESIGNED BY J. REBER, S.E. DRAWN BY P. DIAZ CHECKED BY M. TARAZI IN CHARGE M. TARAZI DATE 20130710												Skanska Shimmick Herzog 1436 California Circle Milpitas, California 95035 A Joint Venture						MFT CONSULTING ENGINEERS, Inc. Anil Verma Associates, Inc. 1773 San Pablo Ave., Suite A3 (510) 222-4100 Pinole, CA 94664 Fax (916) 222-8410												BART SILICON VALLEY BART SILICON VALLEY BERRYESSA EXTENSION						LINE, TRACK, STATIONS AND SYSTEMS DESIGN UNIT 023 MILPITAS STATION ROOF TRUSS FRAMING SECTIONS AND DETAILS SHEET 2 OF 4						CADD FILENAME C700-S-DB-S732.dwg SIZE SCALE D 1/8" = 1'-0" CONTRACT NO. C700 AREA CODE SHEET NO. PAGE NO. DB S732 0249																																																																																																																																																																																																																																																																																																																																																																																																																																																																																																																																																																																																																																																																																																																																																																																																																																																																																																																																																																																																																																																																																																																																																																																																																																																																																																																																																																																																																																																																																																																																																																																																																																																																																																																																																																																																																																																																																																																																																																																																																																																																																																																																																																																																																																																																																																																																																																																																																																																																																																																																																																																																																																																																																																																																																																																																																																																																																																																																																																																																																																																																																																																																																																																																																																																																																																																																																																																																																																																																																																																																																																																																					
REV						DATE						BY						SUB						APP						DESCRIPTION																																																																																																																																																																																																																																																																																																																																																																																																																																																																																																																																																																																																																																																																																																																																																																																																																																																																																																																																																																																																																																																																																																																																																																																																																																																																																																																																																																																																																																																																																																																																																																																																																																																																																																																																																																																																																																																																																																																																																																																																																																																																																																																																																																																																																																																																																																																																																																																																																																																																																																																																																																																																																																																																																																																																																																																																																																																																																																																																																																																																																																																																																																																																																																																																																																																																																																																																																																																																																																																																																																																																																																																																																														</					




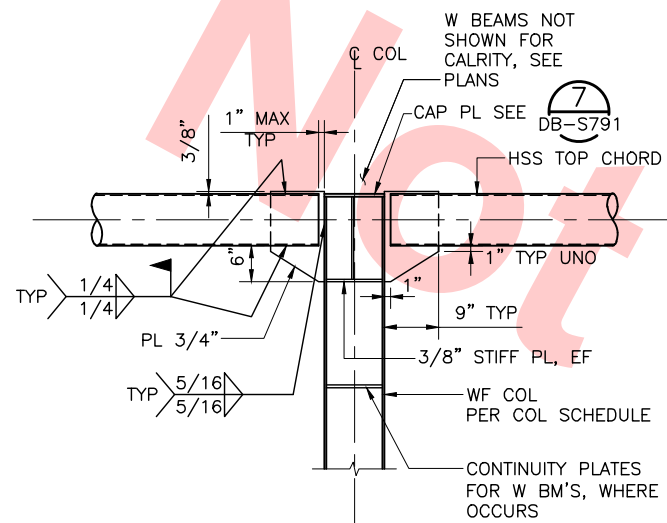


**DETAIL 1** DB-S731  
SCALE: 3/4" = 1'-0" DB-S733 DB-S732

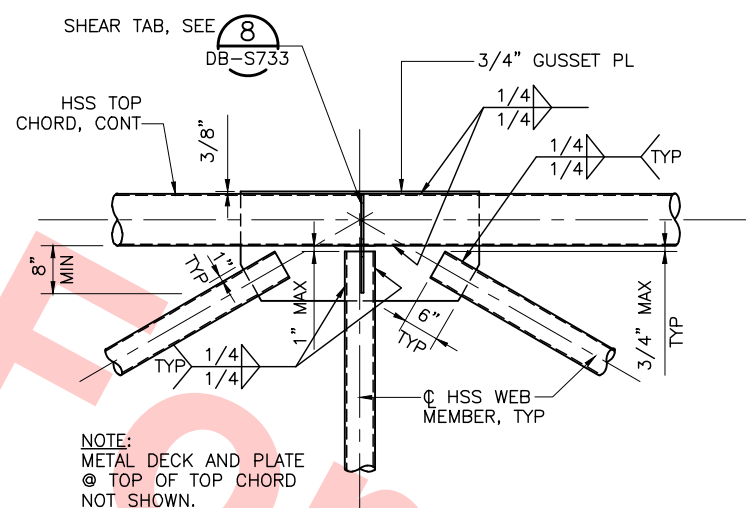

**DETAIL 2** DB-S731  
SCALE: 3/4" = 1'-0" DB-S733 DB-S732

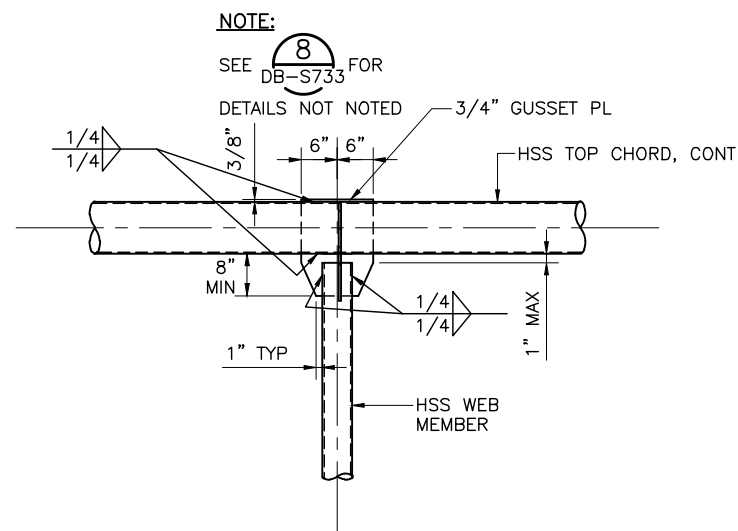

**DETAIL 3** DB-S731  
SCALE: 3/4" = 1'-0" DB-S733 DB-S732

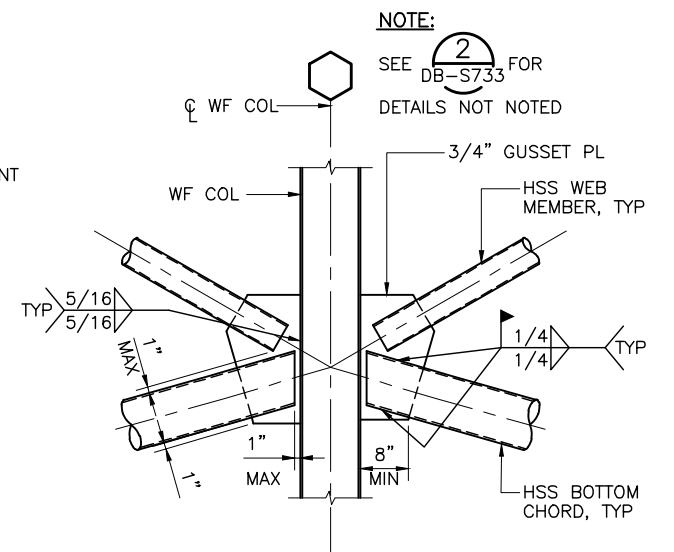


**DETAIL 4** DB-S731  
SCALE: 3/4" = 1'-0" DB-S733

Santa Clara Valley Transportation Authority  
NO EXCEPTIONS TAKEN (NET)  
MAKE CORRECTIONS NOTED (MCN)  
AMEND AND RESUBMIT (A/R)


Any action shown above is subject to the terms of the contract and does not relieve the Contractor of any of its obligations under the contract, including design and detailing.

Contract No.: DB11002F


By: Date:

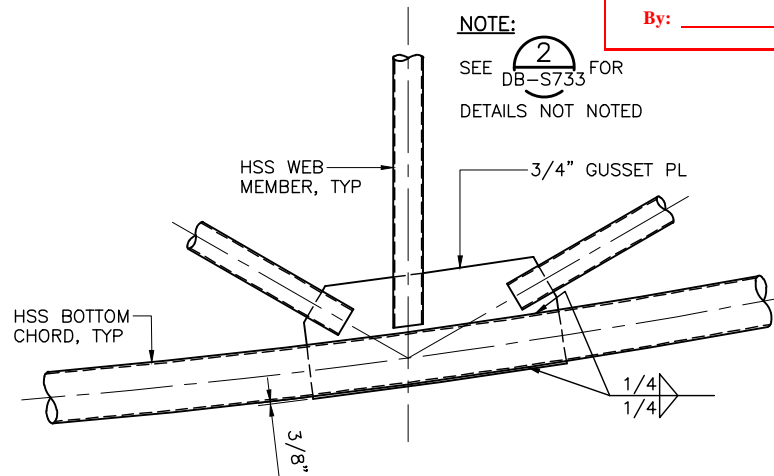


**DETAIL 5** DB-S731  
SCALE: 3/4" = 1'-0" DB-S733 DB-S732

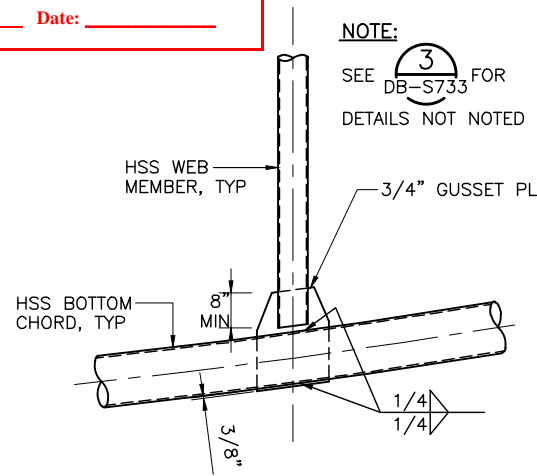

**DETAIL 6** DB-S731  
SCALE: 3/4" = 1'-0" DB-S733 DB-S732

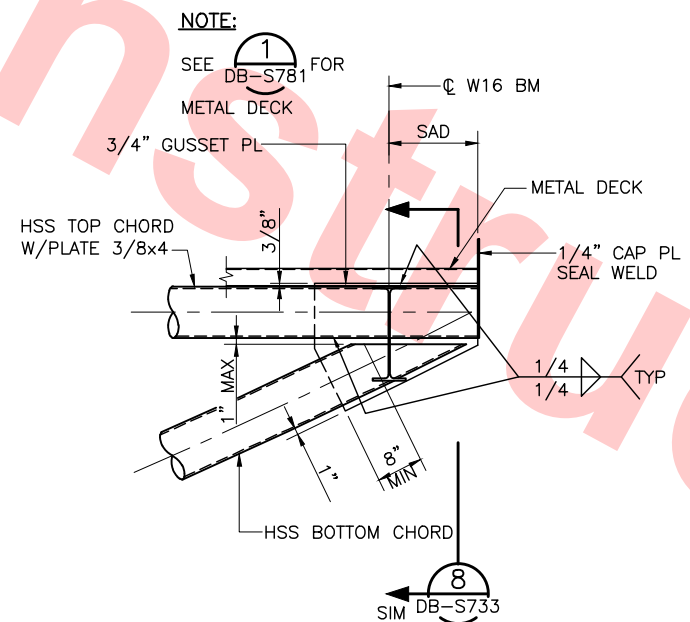


**DETAIL 7** DB-S731  
SCALE: 3/4" = 1'-0" DB-S733 DB-S732

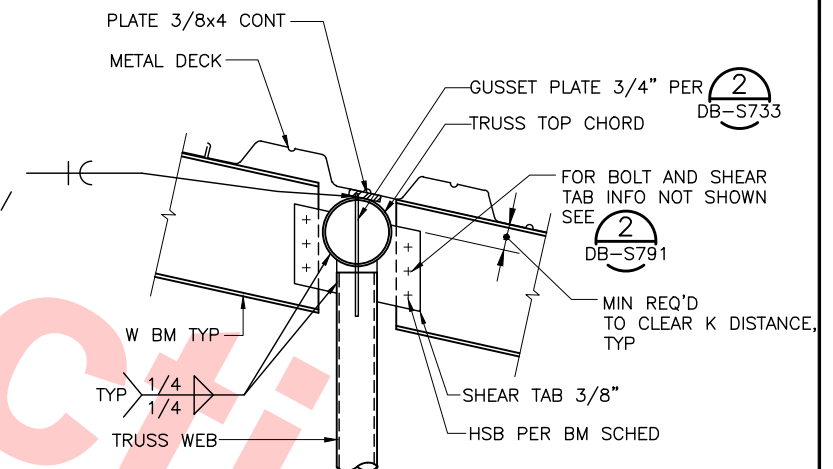

**SECTION 8** DB-S731  
SCALE: 1" = 1'-0" DB-S733

Jul 05, 2013 1:56pm P:\BART Berryessa Extension Line\AS - STRUCTURAL\MILPITAS WORK\6-10-2012\C700-S-DB-S733.dwg

DESIGNED BY J. REBER, S.E.	
DRAWN BY P. DIAZ	
CHECKED BY M. TARAZI	
IN CHARGE M. TARAZI	
DATE 20130710	
0 20130710	READINESS FOR CONSTRUCTION
REV	DATE BY SUB APP DESCRIPTION

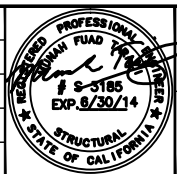

Skanska Shimmick Herzog	1436 California Circle Milpitas, California 95035 A Joint Venture
MFT CONSULTING ENGINEERS, INC. Anil Verma Associates, Inc. 1773 San Pablo Ave., Suite A3 (510) 222-4100 Palo Alto, CA 94304 Fax (650) 222-8410	Leewood, Andrews & Newman, Inc. T-Y-LIN INTERNATIONAL A LEED A RALLY COMPANY
SUBMITTED	APPROVED



LINE, TRACK, STATIONS AND SYSTEMS  
DESIGN UNIT 023  
MILPITAS STATION  
ROOF TRUSS FRAMING  
SECTIONS AND DETAILS  
SHEET 3 OF 4

CADD FILENAME C700-S-DB-S733.dwg	
SIZE SCALE D AS NOTED	
CONTRACT NO. C700	REV. 0
AREA CODE DB	SHEET NO. S733
	PAGE NO. 0250



**Santa Clara Valley Transportation Authority**

☐ **NO EXCEPTIONS TAKEN (NET)**  
☐ **MAKE CORRECTIONS NOTED (MCN)**  
☐ **AMEND AND RESUBMIT (A/R)**



Any action shown above is subject to the terms of the contract and does not relieve the Contractor of any of its obligations under the contract, including design and detailing.

Contract No.: DB11002F

By: \_\_\_\_\_ Date: \_\_\_\_\_



FOOTING (F) SCHEDULE				
F#	SIZE (WXLXD)	BOT REBAR	TOP REBAR	REMARKS
F1	2'-6"x2'-6"x2'-0"	3#6		
F2	3'-0"x3'-0"x2'-0"	4#6		
F3	4'-0"x4'-0"x2'-0"	5#6		
F4	5'-0"x5'-0"x2'-0"	6#6		
F5	6'-0"x6'-0"x2'-0"	8#6		
F6	6'-6"x6'-6"x2'-0"	8#6		
F7	7'-0"x7'-0"x3'-0"	14#6		
F8	12'-6"x6'-0"x3'-0"	22#6 T 12#6 L	22#6 T 12#6 L	T=TRANSVERSAL L=LONGITUDINAL
F9	8'-0"x8'-0"x4'-0"	#7@10"OC EW	#7@10"OC EW	SEE SECTION 4/DB-S649
F10	13'-0"x8'-0"x7'-0"	#8@10"OC EW	#8@10"OC EW	SEE SECTION 1/DB-S649
F11	6'-0"xLENGTH PER PLANx4'-0"	#7@10"OC EW	#7@10"OC EW	SEE SECTION 3/DB-S649
F12	6'-0"xLENGTH PER PLANx7'-0"	#8@10"OC EW	#8@10"OC EW	SEE SECTION 4/DB-S650
F13	13'-0"x8'-0"x7'-0"	#8@10"OC EW	#8@10"OC EW	SEE SECTION 4/DB-S650
F14				
F15				
F16				
F17				

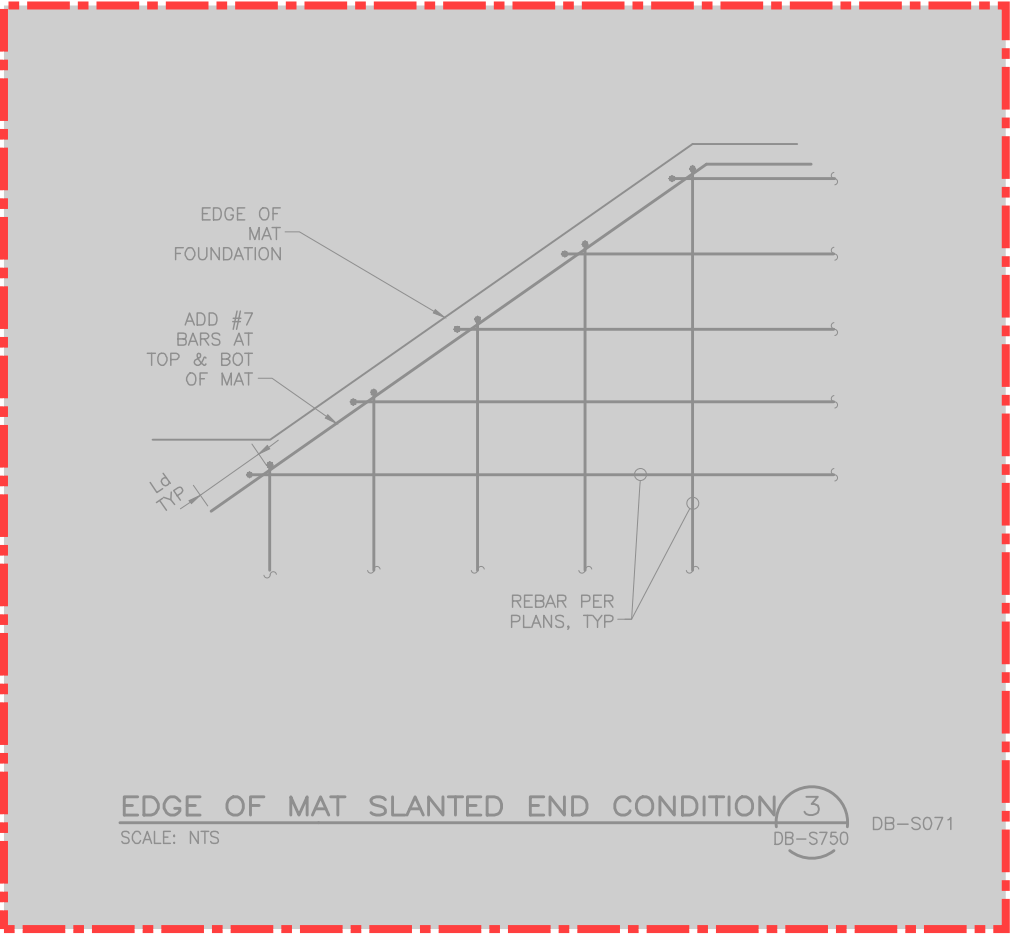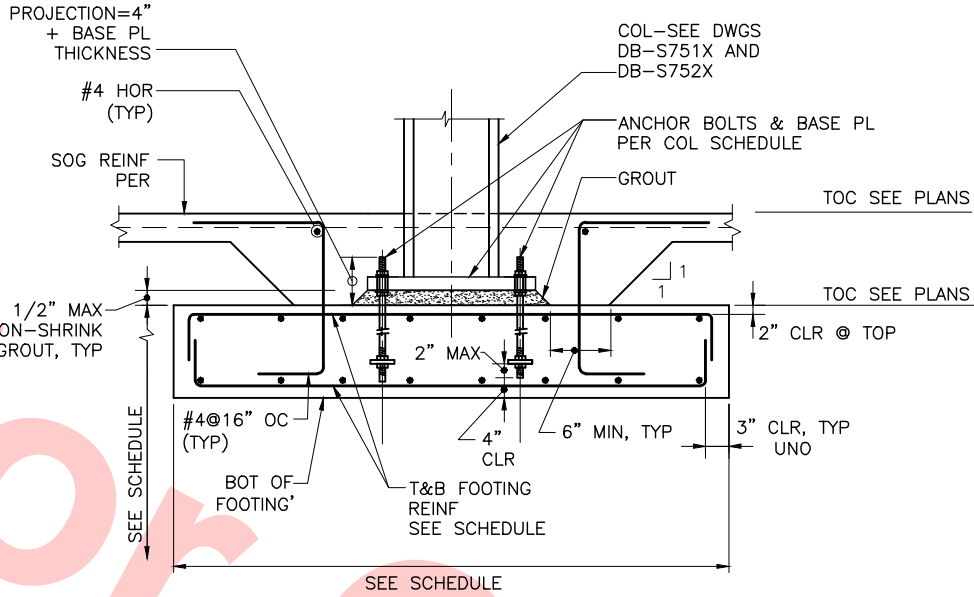

NOTE:  
1. SEE DB-S750 FOR FOOTING PROFILE AT STEEL COLUMN

FOOTING SCHEDULE


SCALE: NTS

DB-S121

TYPICAL SPREAD FOOTING @ ST'L COL.

SCALE: NTS

DB-S750

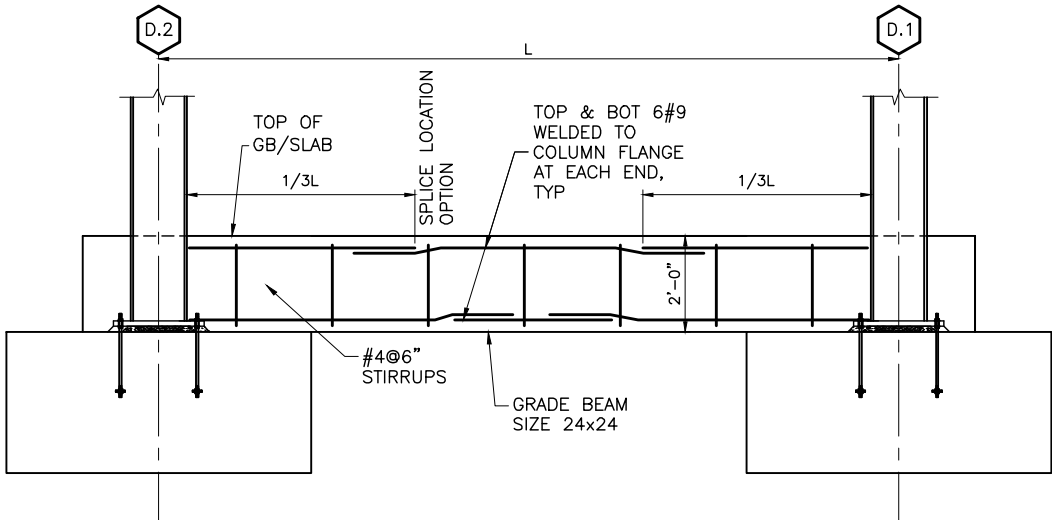

GRADE BEAM ELEVATION

SCALE: NTS

DB-S125

NOTE TO REVIEWER(S):  
DO NOT REVIEW AREAS DESIGNATED AS

Santa Clara Valley Transportation Authority

NO EXCEPTIONS TAKEN (NET)  
MAKE CORRECTIONS NOTED (MCN)  
AMEND AND RESUBMIT (A/R)


Any action shown above is subject to the terms of the contract and does not relieve the Contractor of any of its obligations under the contract, including design and detailing.

Contract No.: DB11002F

By: Date:

Jul 05, 2013 - 1:56pm P:\BART Berryessa Extension Line\AS - STRUCTURAL MILPITAS WORK\_6-10-2012\CT00-S-DB-S750.dwg

02-07-2013						DESIGNED BY J. REBER, S.E.
						DRAWN BY P. DIAZ
						CHECKED BY M. TARAZI
	0	20130710				IN CHARGE M. TARAZI
	0	20130531				DATE 20130710
	REV	DATE	BY	SUB	APP	DESCRIPTION

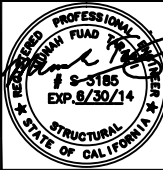

Skanska  
Shimmick  
Herzog


1436 California Circle  
Milpitas, California 95035  
A Joint Venture

MFT CONSULTING ENGINEERS, INC. Anil Verma Associates, Inc.  
1773 San Pablo Ave., Suite A3 (510) 222-4100  
Palo Alto, CA 94304 Fax (650) 323-8410

Loeferwood, Andrews & Newman, Inc.  
A LEO A DALY COMPANY

T-Y-LIN INTERNATIONAL

APPROVED

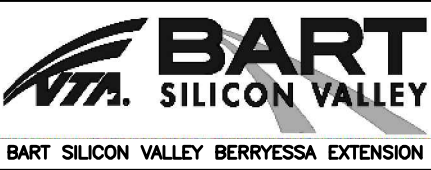

LINE, TRACK, STATIONS AND SYSTEMS  
DESIGN UNIT 023  
MILPITAS STATION  
FOUNDATION SCHEDULE  
AND DETAILS  
SHEET 1 OF 1

CADD FILENAME		
C700-S-DB-S750.dwg		
SIZE	SCALE	
D	AS NOTED	
CONTRACT NO.		REV.
C700		0
AREA CODE	SHEET NO.	PAGE NO.
DB	S750	0252















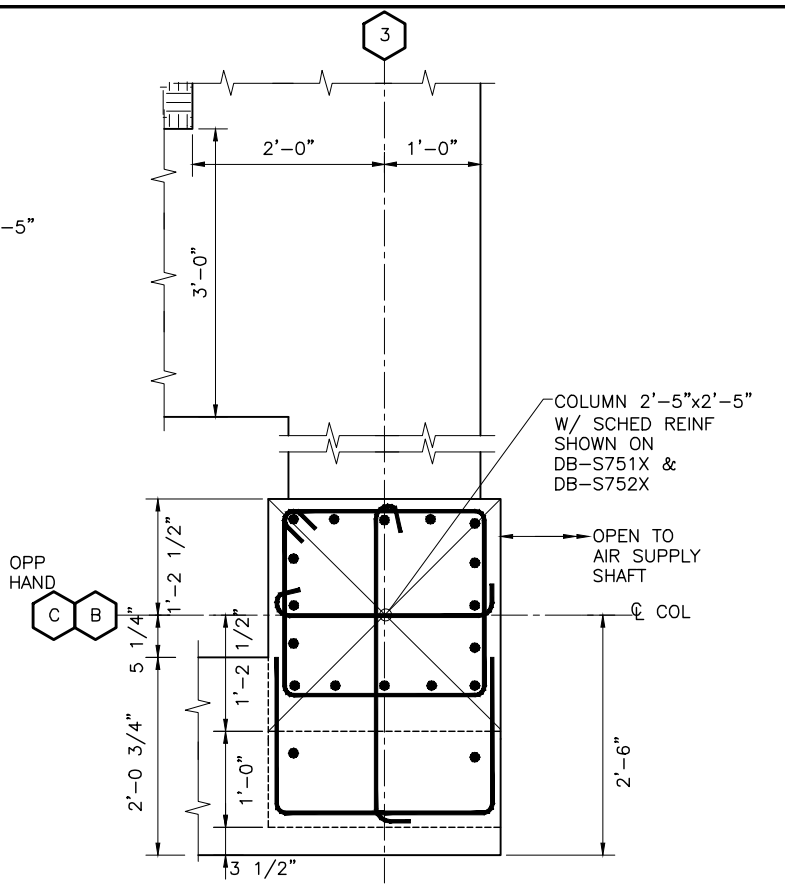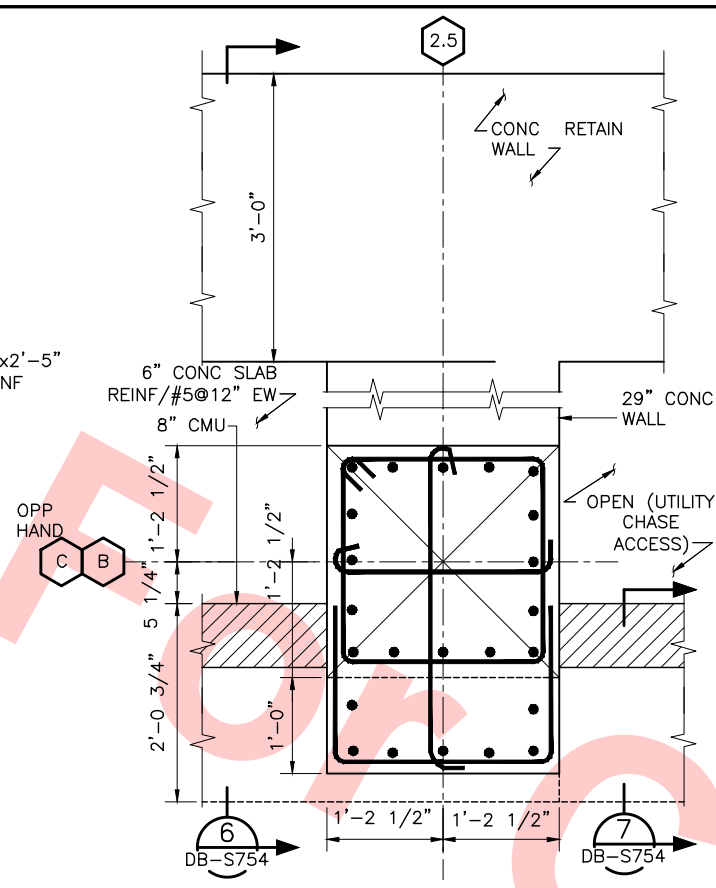

DETAIL @ PLATFORM LEVEL 2  
SCALE: 1"=1'-0" DB-S753 DB-S111

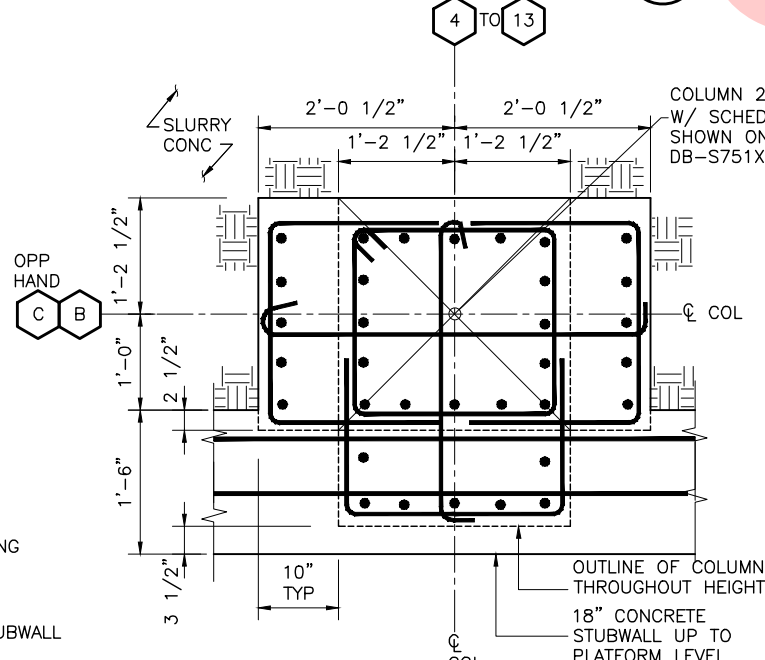


DETAIL © MAT FOUNDATION 6  
SCALE: 1"=1'-0" DB-S753 DB-S071 DB-S072 DB-S073 DB-S074

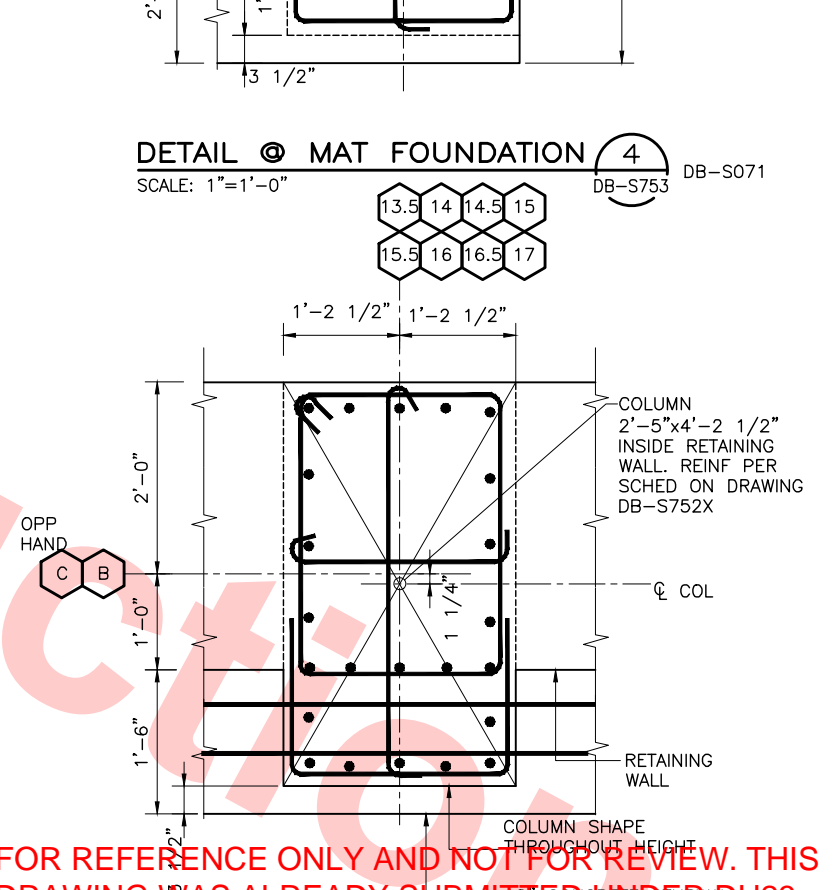

**DETAIL @ MAT FOUNDATION**  DB-S074  
SCALE: 1"=1'-0" DB-S075

Jul 05, 2013 - 3:37pm P:\BART Berryessa Extension Line\S - STRUCTURAL MILPITAS\WORK\_6-10-2012\C700-S-DB-S753.dwg



1436 California Circle  
Milpitas, California 95035


A Joint Venture

---

**LN** Lockwood, Andrews  
& Newnam, Inc.  
A LEO A DALY COMPANY




**T-Y-LIN INTERNATIONAL**

APPROVED \_\_\_\_\_

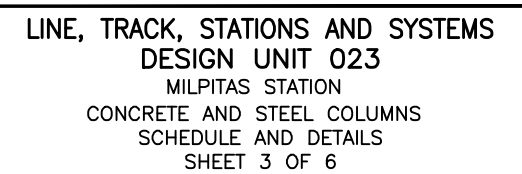


CADD FILENAME C700-S-DB-S753.dwg		
SIZE D	SCALE AS NOTED	
CONTRACT NO. C700		REV. 0
AREA CODE DB	SHEET NO. S753	PAGE NO. 0255



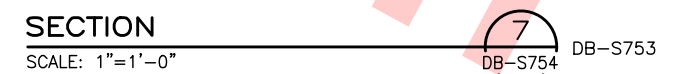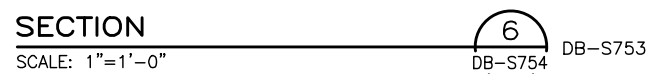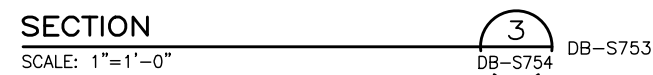

cad-02 Jul 05, 2013 - 1:57pm P:\BART Berryessa Extension Line\5 - STRUCTURAL MILPITAS\WORK\_6-10-2012\C700-S-DB-S754.dwg




**Lockwood, Andrews & Newnam, Inc.** | **T-Y-LIN INTERNATIONAL**



CADD FILENAME C700-S-DB-S754.dwg		
SIZE D	SCALE NONE	
CONTRACT NO. C700		REV. 0
AREA CODE DB	SHEET NO. S754	PAGE NO. 0256



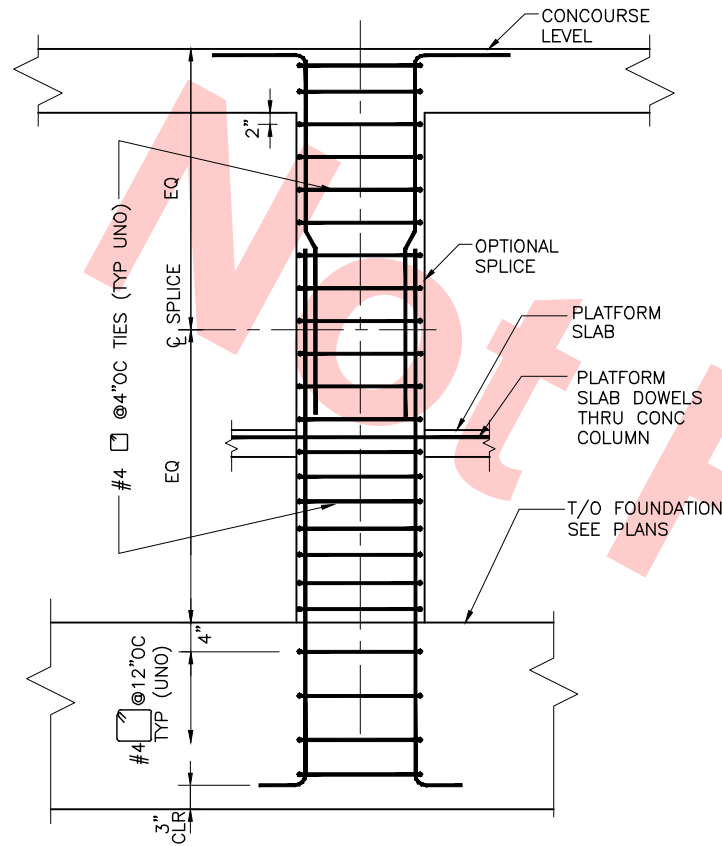


**TYPICAL COLUMN**

SCALE: NTS

1  
DB-S755

DB-S751X

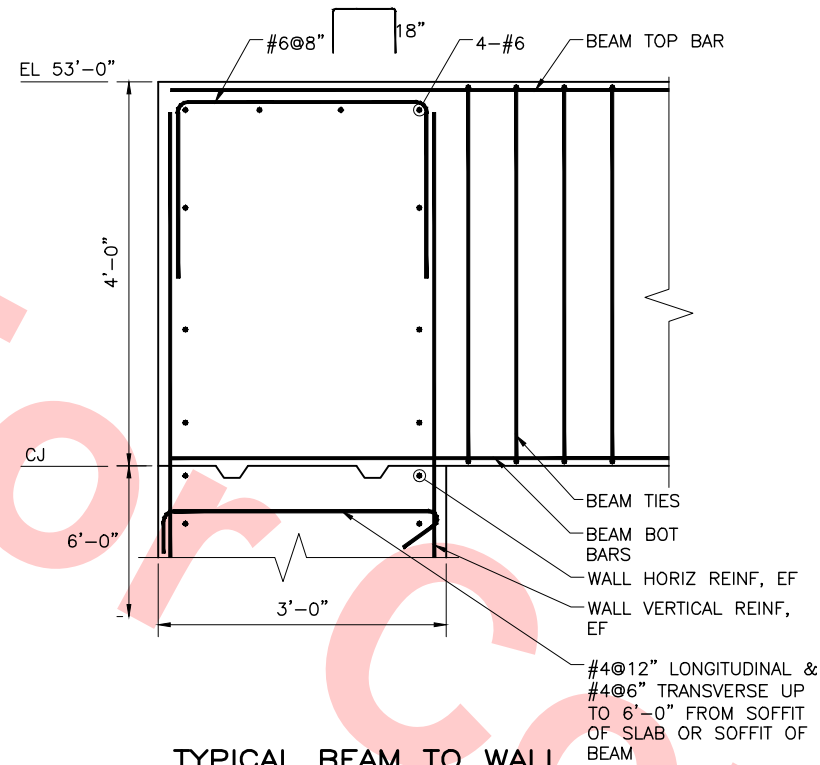


**TYPICAL BEAM TO WALL CONNECTION**

SCALE: NTS

2  
DB-S755

DB-S121  
DB-S122  
DB-S123  
DB-S124  
DB-S125  
DB-S126  
DB-S127

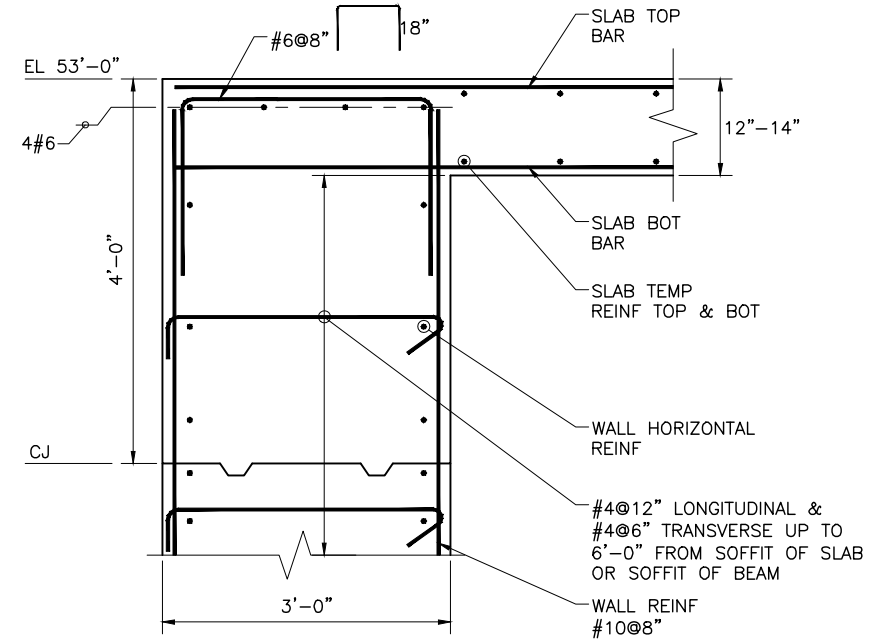


**TYPICAL SLAB TO WALL CONNECTION**

SCALE: NTS

3  
DB-S755

DB-S121  
DB-S122  
DB-S124  
DB-S125  
DB-S126  
DB-S127  
DB-S644

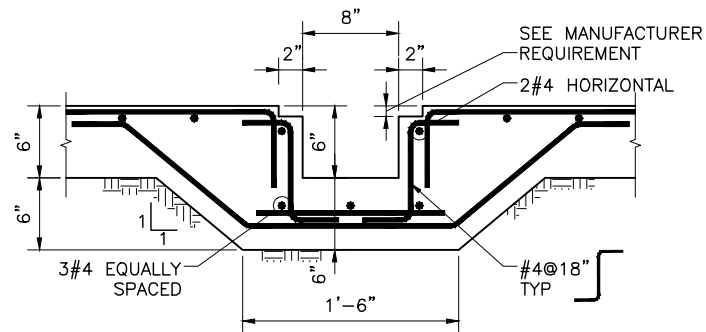

**SECTION @ GUTTER**

SCALE: 1 1/2"=1'-0"

4  
DB-S755


DB-S212

FOR REFERENCE ONLY AND NOT FOR REVIEW. THIS DRAWING WAS ALREADY SUBMITTED UNDER DU23-WP08 RFC TRENCH PACKAGE.

04-02 Jul 05, 2013 1:57pm P:\BART Berryessa Extension Line\AS - STRUCTURAL MILPITAS WORK\6-10-2012\0700-S-DB-S755.dwg

DESIGNED BY J. REBER, S.E.	
DRAWN BY P. DIAZ	
CHECKED BY M. TARAZI	
IN CHARGE M. TARAZI	
DATE 20130531	

0	20130531					READINESS FOR CONSTRUCTION
REV	DATE	BY	SUB	APP		DESCRIPTION

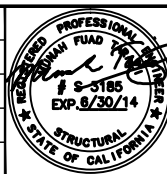

**Skanska Shimmick Herzog**

1436 California Circle  
Milpitas, California 95035  
A Joint Venture

MFT CONSULTING ENGINEERS, Inc. Anil Verma Associates, Inc.  
1773 San Pablo Ave., Suite A3 (510) 222-4100  
Palo Alto, CA 94304 Fax (650) 222-8410

SUBMITTED *[Signature]*

**Loeblwood, Andrews & Newman, Inc.**  
A LEAD & RALLY COMPANY

T-Y-LIN INTERNATIONAL

APPROVED *[Signature]*


**BART SILICON VALLEY**

BART SILICON VALLEY BERRYESSA EXTENSION

LINE, TRACK, STATIONS AND SYSTEMS DESIGN UNIT 023 MILPITAS STATION CONCRETE AND STEEL COLUMNS SCHEDULE AND DETAILS SHEET 5 OF 6			
--	--	--	--

CADD FILENAME C700-S-DB-S755.dwg			
SIZE D	SCALE NONE		
CONTRACT NO. C700	REV. 0		
AREA CODE DB	SHEET NO. S755	PAGE NO. 0257	



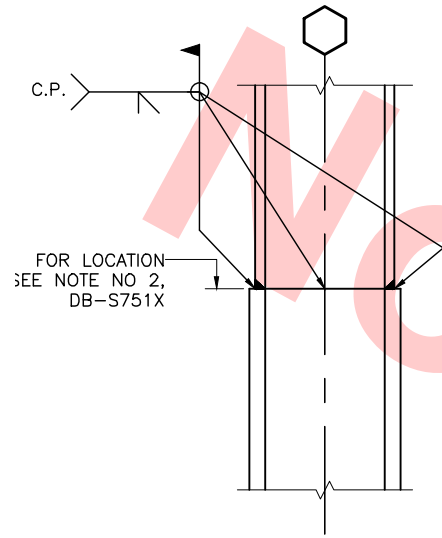


**TYPICAL COLUMN SPLICE**

SCALE: 3/4"=1'-0"

1  
DB-S756

DB-S751X

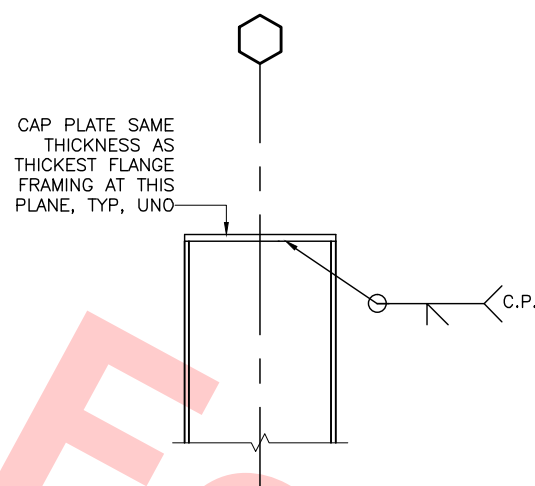


**TYPICAL COLUMN CAP PLATE**

SCALE: 3/4"=1'-0"

2  
DB-S756

DB-S751X

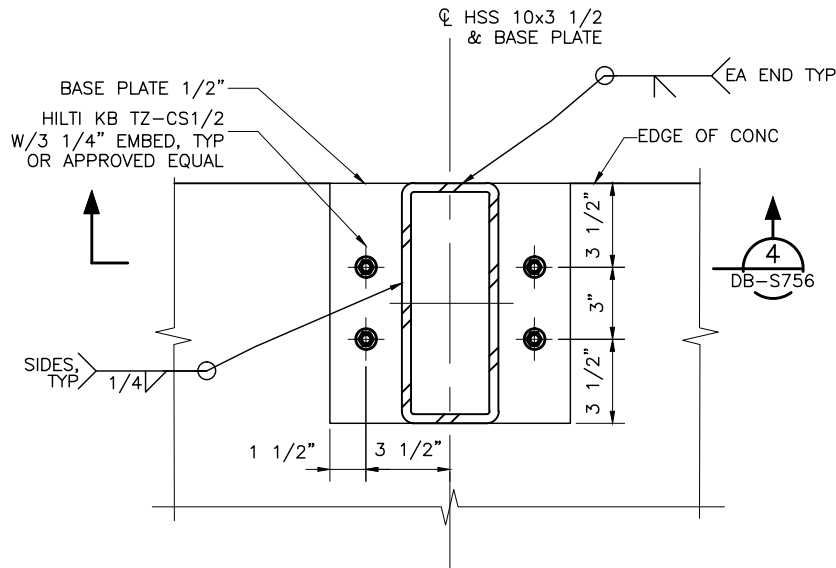


**BASE PLATE PLAN DETAIL**

SCALE: 3"=1'-0"

3  
DB-S756

DB-S122  
DB-S123  
DB-S124  
DB-S125

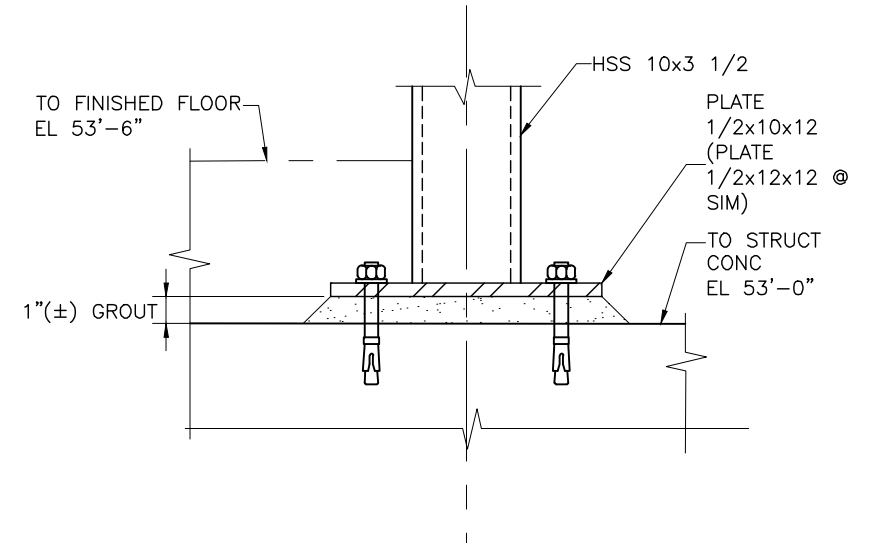


**SECTION**

SCALE: 3"=1'-0"

4  
DB-S756

DB-S122  
DB-S756  
DB-S520

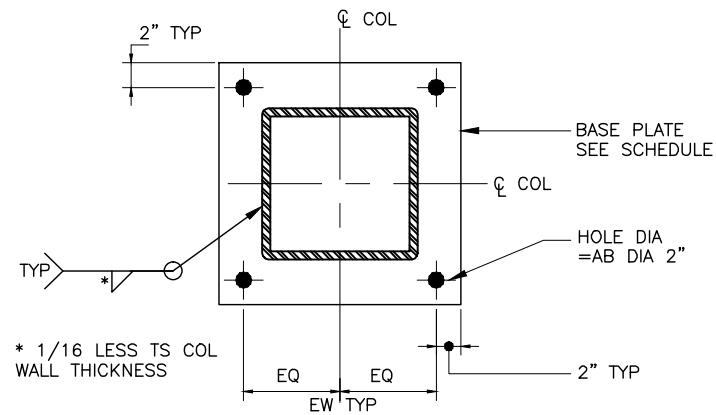

**TYPICAL BASE PLATE FOR HSS COLUMN**

SCALE: 1"=1'-0"

5  
DB-S756

DB-S751X

**Santa Clara Valley Transportation Authority**

NO EXCEPTIONS TAKEN (NET)  
MAKE CORRECTIONS NOTED (MCN)  
AMEND AND RESUBMIT (A/R)

Any action shown above is subject to the terms of the contract and does not relieve the Contractor of any of its obligations under the contract, including design and detailing.


Contract No.: DB11002F

By: \_\_\_\_\_ Date: \_\_\_\_\_


Jul 05, 2013 - 1:57pm P:\BART Berryessa Extension Line\AS - STRUCTURAL MILPITAS WORK\6-10-2012\0700-S-DB-S756.dwg

DESIGNED BY J. REBER, S.E.	
DRAWN BY P. DIAZ	
CHECKED BY M. TARAZI	
IN CHARGE M. TARAZI	
DATE 20130710	

REV	DATE	BY	SUB	APP	DESCRIPTION
0	20130710				READINESS FOR CONSTRUCTION

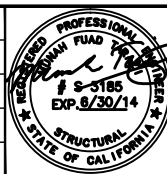

<b>Skanska Shimmick Herzog</b>	1436 California Circle Milpitas, California 95035 A Joint Venture
<b>MFT CONSULTING ENGINEERS, Inc.</b> 1773 San Pablo Ave., Suite A3 Pinole, CA 94664 (916) 222-4100 Fax (916) 222-8410	<b>Lealwood, Andrews &amp; Newman, Inc.</b> A LEAD A BALLY COMPANY
SUBMITTED <i>[Signature]</i>	APPROVED <i>[Signature]</i>

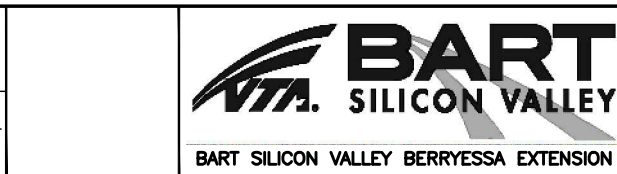

<b>LINE, TRACK, STATIONS AND SYSTEMS</b>			
<b>DESIGN UNIT 023</b>			
MILPITAS STATION			
CONCRETE AND STEEL COLUMNS			
SCHEDULE AND DETAILS			
SHEET 6 OF 6			

CADD FILENAME C700-S-DB-S756.dwg	SIZE D	SCALE AS NOTED
CONTRACT NO. C700	SHEET NO. S756	REV. 0
AREA CODE DB	PAGE NO. 0258	



004-02 Jul 05, 2013 - 1:57pm P:\BART Berryessa Extension Line\AS - STRUCTURAL MILPITAS WORK\_6-10-2012\0700-S-DB-S761.dwg

SLAB SCHEDULE

MARK	DIMEN- SIONS	TYPE	REINFORCING					REMARKS
	DEPTH (INCHES)		BOTTOM BARS		TOP BARS			
			(A)	(B)	(C)	(D)	(E)	
S1	10	E	#6@6" OC		#6@6" OC			
S2	10	I	#6@6" OC		#6@6" OC	#6@6" OC		
S3	10	E	#6@6" OC		#6@6" OC			WHERE CONTINUES EAST OF GRID B CONTINUE T AND B REINF AND TERMINATE W/ STANDARD HOOK @ "CONC RETAINING WALL BELOW"
S4	14	E	#6@6" OC		#6@6" OC			
S5	14	I	#6@6" OC		#7@6" OC	#7@6" OC		
S6	14	E	#7@6" OC		#6@6" OC			BTW GRID 3.5 AND 4 CONTINUE T AND B REINF EAST OF GRID B AND TERMINATE W/ STANDARD HOOK @ "CONC WALL BELOW"
S7	14	E	#6@6" OC		#6@6" OC		#6@6" OC	WHERE SLAB CONTINUES PAST CB-18, CONTINUE T AND B REINF AND TERMINATE W/ STANDARD HOOK @ BEAM BEYOND
S8	14	E	#6@6" OC		#6@6" OC			
S9	10	E	#5@6" OC		#5@6" OC		#6@6" OC	
S10	12	E	#6@6" OC		#6@6" OC			
S11	10	E	#5@6" OC		#5@6" OC			WHERE SLAB CONTINUES PAST CB-20, CONTINUE T+B REINF AND TERMINATE W/ STANDARD HOOK @ BEAM BEYOND
S12	12	I	#6@6" OC		#6@6" OC	#6@6" OC		
S13	12	E	#6@6" OC		#6@6" OC			
S14	12	E	#6@6" OC		#6@6" OC			
S15	12	I	#6@6" OC		#6@6" OC			
S16	12	I	#6@6" OC		#6@6" OC			
S17	12	I	#6@6" OC		#6@6" OC	#6@6" OC		
S18	12	E	#6@6" OC		#6@6" OC			
S19	12	E	#6@6" OC		#6@6" OC			
S20	12	I	#6@6" OC		#6@6" OC			
S21	12	I	#6@6" OC		#6@6" OC			
S22	12	I	#6@6" OC		#6@6" OC	#6@6" OC		
S23	12	E	#6@6" OC		#6@6" OC			
S24	12	E	#5@6" OC		#5@6" OC		#5@6" OC	EXTEND "A" AND "E" BARS TO BM SUPPORT BEYOND
S25	12	E	#6@10" OC		#6@10" OC			USE # 4 @ 12" OC LONGITUDINAL TOP & # 7 @ 8" OC LONGITUDINAL BOTTOM IN LIEU OF REINF SPECIFIED IN NOTE 3 ON DB-S762. SEE 1/DB-S763 FOR REINF CONFIG.
S26	12	E	#6@10" OC		#6@10" OC			
S27	12	E	#6@10" OC		#6@10" OC			
S28	12	I	#6@10" OC		#6@10" OC			
S29	12	I	#6@10" OC		#6@10" OC			
S30	12	E	#6@10" OC		#6@10" OC			
S100	10	S	#5@6"o.c.		#5@6"o.c.	#5@6"o.c.		SEE NOTE 2
S600	27	S	#10@6"o.c.		#8@6"o.c.			USE # 8 @ 12" TOP AND BOTTOM IN LIEU OF REINF SPECIFIED IN NOTE 3 ON DB-S762

- NOTES:
- SEE DRAWING DB-S762 FOR REINFORCEMENT LOCATION FOR SLAB TYPES
  - EXTEND BARS MARKED "A" AND "C" INTO CANTILEVER PORTION OF SLAB SIMILAR TO DETAIL 4/DB-S762.

FOR REFERENCE ONLY AND NOT FOR REVIEW. THIS DRAWING WAS ALREADY SUBMITTED UNDER DU23-WP08 RFC TRENCH PACKAGE.

0

20130531

REV

DATE

BY

SUB

APP

DESCRIPTION

DESIGNED BY  
J. REBER, S.E.

DRAWN BY  
P. DIAZ

CHECKED BY  
M. TARAZI

IN CHARGE  
M. TARAZI

DATE  
20130531

REGISTERED PROFESSIONAL  
MECHANICAL ENGINEER  
# S 3185  
EXP. 9/30/14  
STATE OF CALIFORNIA

Skanska  
Shimmick  
Herzog

1436 California Circle  
Milpitas, California 95035  
A Joint Venture

MFT CONSULTING ENGINEERS, INC. Anil Verma Associates, Inc.  
1773 San Pablo Ave., Suite A3 (510) 222-4106  
Pinole, CA 94664 Fax (510) 222-6419

Lealwood, Andrews  
& Newman, Inc.  
A LEO A DALY COMPANY

T-Y-LIN INTERNATIONAL

BART

SILICON VALLEY

BART SILICON VALLEY BERRYESSA EXTENSION

LINE, TRACK, STATIONS AND SYSTEMS

DESIGN UNIT 023

MILPITAS STATION

CONCRETE SLAB

SCHEDULE AND DETAILS

SHEET 1 OF 3

CADD FILENAME  
C700-S-DB-S761.dwg

SIZE SCALE  
D NONE

CONTRACT NO.  
C700


REV.  
0

AREA CODE  
DB

SHEET NO.  
S761

PAGE NO.  
0259



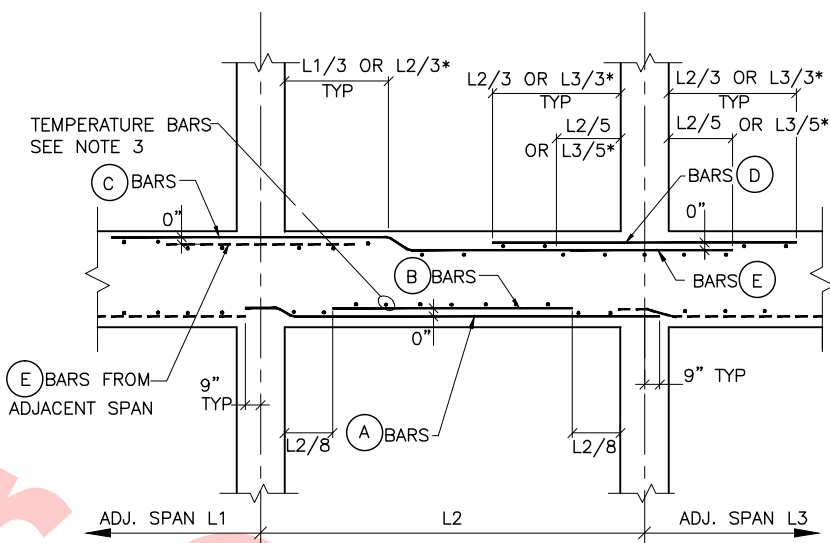

INTERIOR SPAN (TYPE I)  DB-S761  
SCALE: NTS \*WHICH EVER IS GREATER DB-S762




1. SLABS ARE MARKED ON THE FRAMING PLANS THUS.  $\leftarrow S_1 \rightarrow$  ETC. FOR ONE-WAY SLABS. TO INDICATE THE DIRECTION OF THE MAIN REINFORCING.
2. SEE PLANS FOR SLAB ORIENTATION, END SPAN AND CANTILEVER CONDITIONS MAY BE OPPOSITE HAND WITHOUT SO BEING NOTED.
3. WHERE ONE WAY SLAB ARE SHOWN, UNLESS OTHERWISE NOTED, IN SCHEDULE PROVIDE TEMPERATURE BARS PERPENDICULAR TO SCHEDULE REINFORCEMENT THUS:
  - 6" THICK SLABS - #4 @ 16" OC
  - 8" THICK SLABS - #4 @ 16" OC T&B
  - 10" THICK SLABS - #4 @ 16" OC T&B
  - 12" THICK SLABS - #4 @ 16" OC T&B
  - 14" THICK SLABS - #4 @ 12" OC T&B

**SLAB REINFORCEMENT NOTES**

SCALE: N.T.S.

6  
DB-S762

DESIGNED BY	J. REBER, S.E.
DRAWN BY	P. DIAZ
CHECKED BY	M. TARAZI
IN CHARGE	M. TARAZI
DATE	20130531

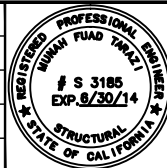

Skanska  
Shimmick  
Herzog

1436 California Circle  
Milpitas, California 95035  
A Joint Venture

**MFT CONSULTING ENGINEERS, INC.** Anil Verma Associates, Inc.  
1773 San Pablo Ave., Suite A3 (510) 222-4106  
Pinole, CA 94564 Fax (510) 222-6418

**LAN** Lockwood, Andrews & Newnam, Inc. **T-Y-LIN INTERNATIONAL**




BART SILICON VALLEY BERRYESSA EXTENSION

LINE, TRACK, STATIONS AND SYSTEMS  
DESIGN UNIT 023  
MILPITAS STATION  
CONCRETE SLAB  
SCHEDULE AND DETAILS  
SHEET 2 OF 3

CADD FILENAME C700-S-DB-S762.dwg		
SIZE D	SCALE NONE	
CONTRACT NO. C700		REV. 0
AREA CODE DB	SHEET NO. S762	PAGE NO. 0260



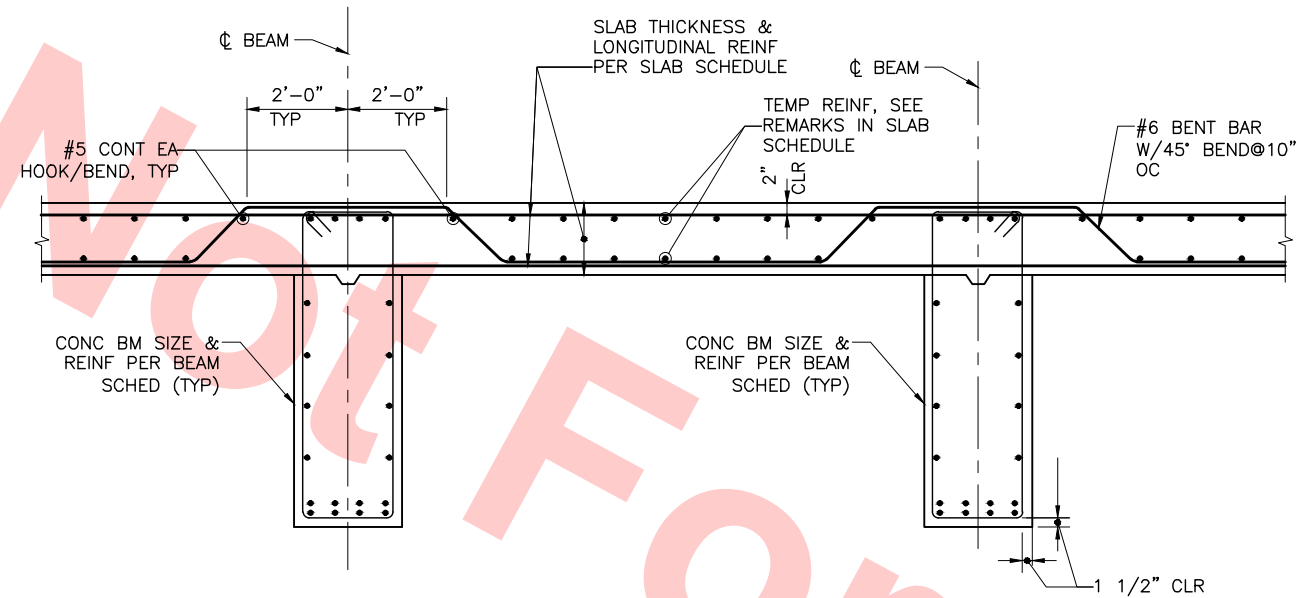

TYPICAL SLAB SHEAR  
REINF. @ S25 THRU S30  
SCALE: NTS

1  
DB-S763

DB-S643

FOR REFERENCE ONLY AND NOT FOR REVIEW. THIS  
DRAWING WAS ALREADY SUBMITTED UNDER DU23-  
WP08 RFC TRENCH PACKAGE.


						DESIGNED BY J. REBER, S.E.		<div>Skanska Shimmick Herzog</div> <div>1436 California Circle Milpitas, California 95035 A Joint Venture</div>	<div> MFT CONSULTING ENGINEERS, INC. Anil Verma Associates, Inc. 1773 San Pablo Ave., Suite A3 (510) 222-4166 Pinole, CA 94564 Fax (510) 222-6419</div> <div>SUBMITTED _____</div>	<div> Lealwood, Andrews &amp; Newman, Inc. A LEO A RALY COMPANY</div> <div>APPROVED _____</div>	<div> T-Y-LIN INTERNATIONAL</div>	<div> BART SILICON VALLEY BERRYESSA EXTENSION</div>	LINE, TRACK, STATIONS AND SYSTEMS DESIGN UNIT 023 MILPITAS STATION CONCRETE SLAB SCHEDULE AND DETAILS SHEET 3 OF 3	CADD FILENAME C700-S-DB-S763.dwg		
					DRAWN BY P. DIAZ	SIZE D								SCALE AS NOTED	CONTRACT NO. C700	REV. 0
					CHECKED BY M. TARAZI											
					IN CHARGE M. TARAZI											
0	20130531				READINESS FOR CONSTRUCTION	DATE 20130531										
REV	DATE	BY	SUB	APP	DESCRIPTION											

04-02 Jul 05, 2013 1:57pm P:\BART Berryessa Extension Line\AS - STRUCTURAL MILPITAS WORK\_6-10-2012\C700-S-DB-S763.dwg



[illegible]

1. SEE DRAWING DB-S767 FOR REINFORCEMENT LOCATION FOR BEAM TYPES, AND STIRRUP TYPES.
2. SEE 7/DB-S767 FOR SIZE, QUANTITY AND LOCATION OF SIDE BARS.
3. SEE DRAWING DB-S766 FOR CONTINUATION OF CONCRETE BEAM SCHEDULE.

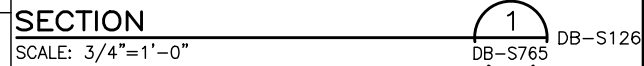

cad-02 Jul 05, 2013 - 1:57pm P:\BART Berryessa Extension Line\S - STRUCTURAL MILPITAS\WORK\_6-10-2012\C700-S-DB-S765.dwg

					DESIGNED BY J. REBER, S.E. DRAWN BY P. DIAZ CHECKED BY M. TARAZI IN CHARGE M. TARAZI DATE 20130531		Skanska Shimmick Herzog 1436 California Circle Milpitas, California 95035 A Joint Venture		LINE, TRACK, STATIONS AND SYSTEMS DESIGN UNIT 023 MILPITAS STATION CONCRETE BEAM/GIRDER SCHEDULE SHEET 1 OF 2	CADD FILENAME C700-S-DB-S765.dwg SIZE D SCALE AS NOTED CONTRACT NO. C700 REV. 0 AREA CODE DB SHEET NO. S765 PAGE NO. 0262
0	20130531				READINESS FOR CONSTRUCTION		 MFT CONSULTING ENGINEERS, INC. Anil Verma Associates, Inc. 1773 San Pablo Ave., Suite A3 (510) 222-4106 Pinole, CA 94964 Fax (510) 222-6418	 Lockwood, Andrews & Newnam, Inc. A L&N & W&N COMPANY T-Y-LIN INTERNATIONAL		
REV	DATE	BY	SUB	APP	DESCRIPTION		SUBMITTED	APPROVED		




04-02 Jul 05, 2013 - 3:42pm P:\BART Berryessa Extension Line\AS - STRUCTURAL MILPITAS WORK\6-10-2012\0700-S-DB-S766.dwg

CONCRETE BEAM SCHEDULE CONCOURSE LEVEL


MARK	DIMENSIONS		TYPE	REINFORCING					STIRRUPS			REMARKS		
	WIDTH	DEPTH		BOTTOM BARS		TOP BARS			(SEE NOTE 2) SIDE BARS E.F.	SIZE & TYPE	SPACING			
				Ⓐ	Ⓑ	Ⓒ	Ⓓ	Ⓔ			G1		G2	B
CB27	24	38	S	5#8		4#8				4A			12"	ARCH BEAM. SEE A/DB-S770 FOR REINFORCEMENT SIZE AND LOCATION.
CB28	29	48												
CB29	29	VARIES												
CB30	29	48												
CB31	29	48												ARCH BEAM. SEE B/DB-S769 FOR REINFORCEMENT SIZE AND LOCATION.
CB32	29	VARIES												
CB33	29	48												
CB34	24	24	S											HOLD FOR ELEVATOR LOADS
CB35	24	38	S	5#9	2#9	4#8	2#8		4A				12"	EXTENDED "A" & "C" BARS TO FAR END AT BM MARK CB27 & TERMINATE W/ STANDARD HOOK. LOCATE "B" & "D" BARS IN 2ND LAYER.
CB36	29	32												ARCH BEAM. SEE B/DB-S770 FOR REINFORCEMENT SIZE & LOCATION.
CB37	29	VARIES												
CB38	29	32												
CB39	24	36	S	5#8		5#8				4A			12"	
CB40	26	54	E	4#10		4#10				4A			12"	
CB41	26	54	I	7#10	7#10	7#10	7#10	7#10		4C	24@6"		12"	LOCATE "B" & "E" BARS IN 2ND LAYER.
CB42	26	54	E	4#10		4#10				4A			12"	
CB43	26	54	E	4#10		4#10				4A			12"	
CB44	26	54	I	7#10	7#10	7#10	7#10	7#10		4C	24@6"		12"	LOCATE "B" & "E" BARS IN 2ND LAYER.
CB45	26	54	E	4#10		4#10				4A			12"	
CB46	26	54	E	4#10		4#10				4A			12"	
CB47	26	VARIES	I	7#10	4#8	8#10	8#10			4C	33@6"		12"	ARCH BEAM. SEE B/DB-S770. LOCATE "B" & "D" BARS IN SECOND LAYER.
CB48	26	54	E	4#10		4#10				4A			12"	
CB49	26	54	S	9#11	7#10	9#11	7#10			4C	24@6"		12"	
CB50	26	54	S	6#9	2#9	6#9	2#9			4A	14@6"		12"	LOCATE "B" & "E" BARS IN 2ND LAYER.
CB100	18	24	S	3#7		3#7				4A			12"	
CB101	18	38	S	3#7		3#7				4A			12"	
CB51	24	38	S	5#10	2#9	5#9				4A			10"	LOCATE "B" BARS IN 2ND LAYER.
CB52	20	24	S											HOLD FOR ELEVATOR LOADS
CB53	29	48												ARCH BEAM. SEE A/DB-S768 FOR REINFORCEMENT SIZE & LOCATION.
CB54	29	VARIES												
CB55	29	48												

- NOTES:
- SEE DRAWING DB-S767 FOR REINFORCEMENT LOCATION FOR BEAM TYPES, AND STIRRUP TYPES.
  - SEE DWG 7/DB-S767 FOR SIZE, QUANTITY AND LOCATION OF SIDE BARS.

FOR REFERENCE ONLY AND NOT FOR REVIEW. THIS DRAWING WAS ALREADY SUBMITTED UNDER DU23-WP08 RFC TRENCH PACKAGE.

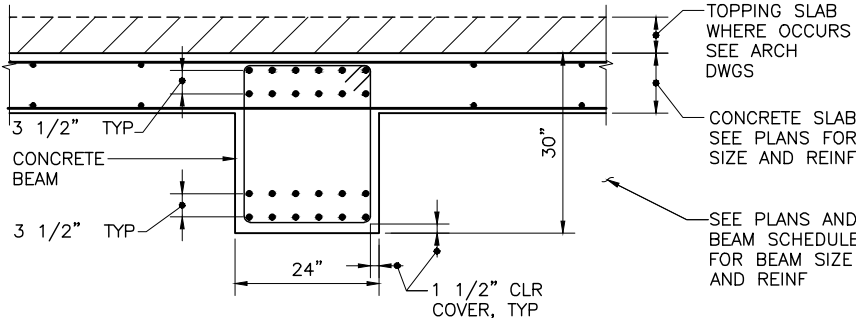

SECTION 1  
SLAB TO BEAM CROSS-SECTION  
SCALE: 3/4"=1'-0" DB-S766

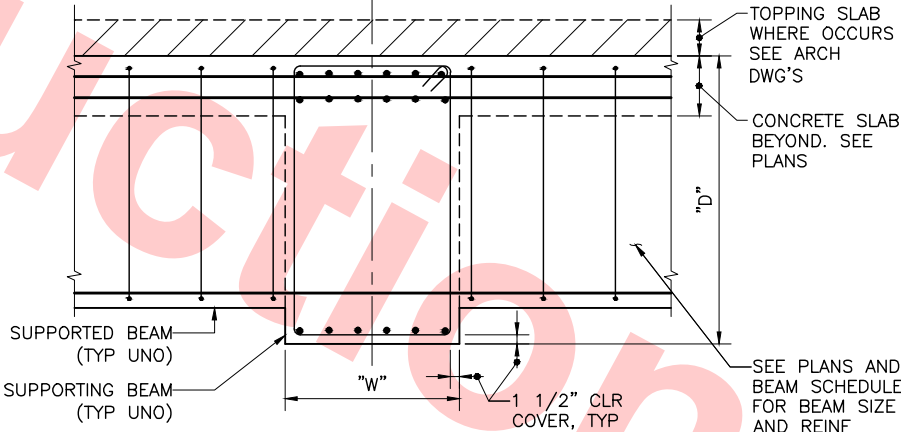

SECTION 2  
BEAM TO BEAM CROSS-SECTION  
SCALE: 3/4"=1'-0" DB-S766 DB-S641

DESIGNED BY  
J. REBER, S.E.  
DRAWN BY  
P. DIAZ  
CHECKED BY  
M. TARAZI  
IN CHARGE  
M. TARAZI  
DATE  
20130531



Skanska  
Shimmick  
Herzog  
1436 California Circle  
Milpitas, California 95035  
A Joint Venture  
MFT CONSULTING ENGINEERS, INC. Anil Verma Associates, Inc.  
1773 San Pablo Ave., Suite A3 (510) 222-4166  
Pinole, CA 94664 Fax (510) 222-6419


Lealwood, Andrews  
& Newman, Inc.  
A LEA A BALLY COMPANY  
T-Y-LIN INTERNATIONAL



LINE, TRACK, STATIONS AND SYSTEMS  
DESIGN UNIT 023  
MILPITAS STATION  
CONCRETE BEAM/GIRDER  
SCHEDULE  
SHEET 2 OF 2


CADD FILENAME  
C700-S-DB-S766.dwg  
SIZE SCALE  
D AS NOTED  
CONTRACT NO. C700 REV. 0  
AREA CODE SHEET NO. PAGE NO.  
DB S766 0263



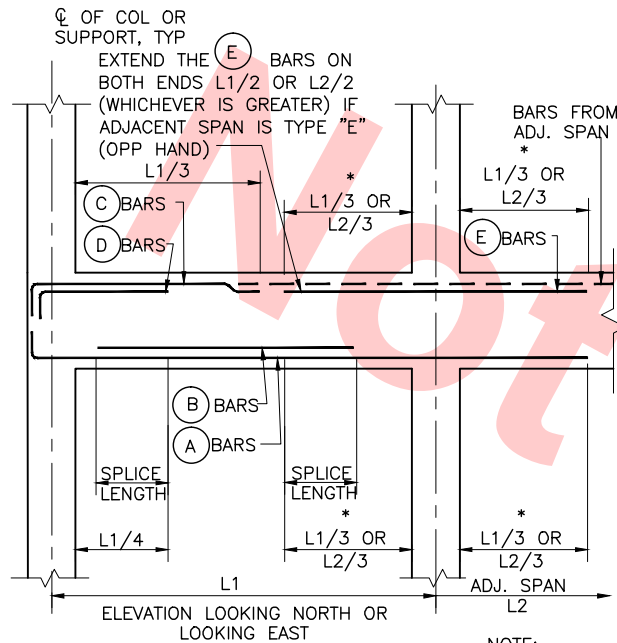


**END SPAN (TYPE E)**  
SCALE: NTS

1  
DB-S767

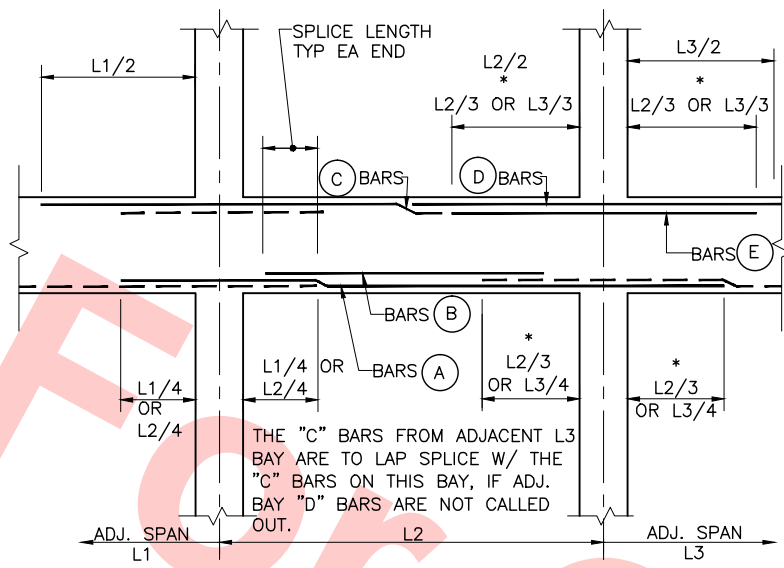


**INTERIOR SPAN (TYPE I)**  
SCALE: NTS

2  
DB-S767

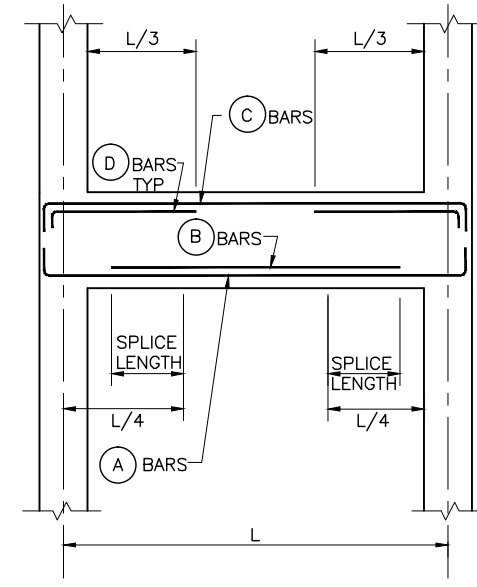


**SIMPLE SPAN (TYPE S)**  
SCALE: NTS

3  
DB-S767

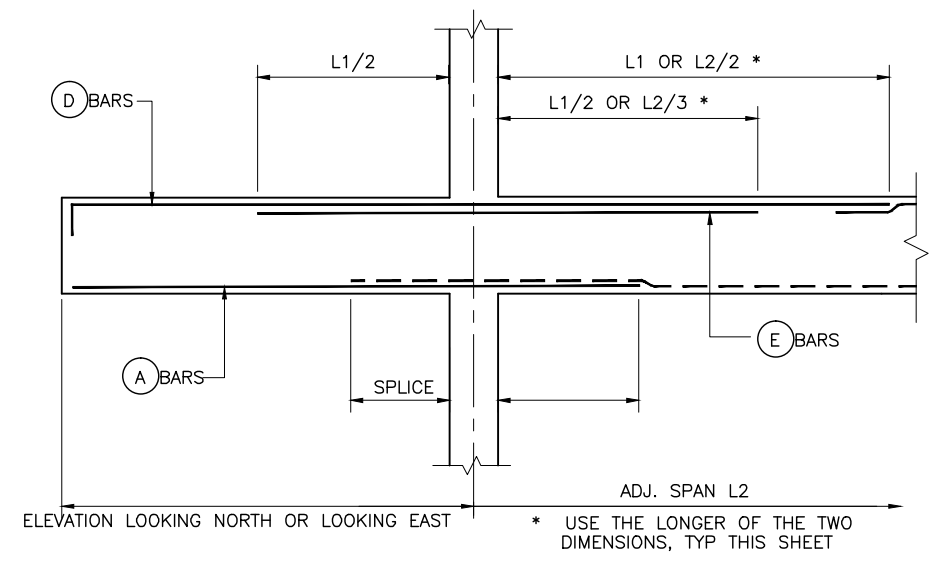


**CANTILEVER SPAN (TYPE C)**  
SCALE: NTS

4  
DB-S767

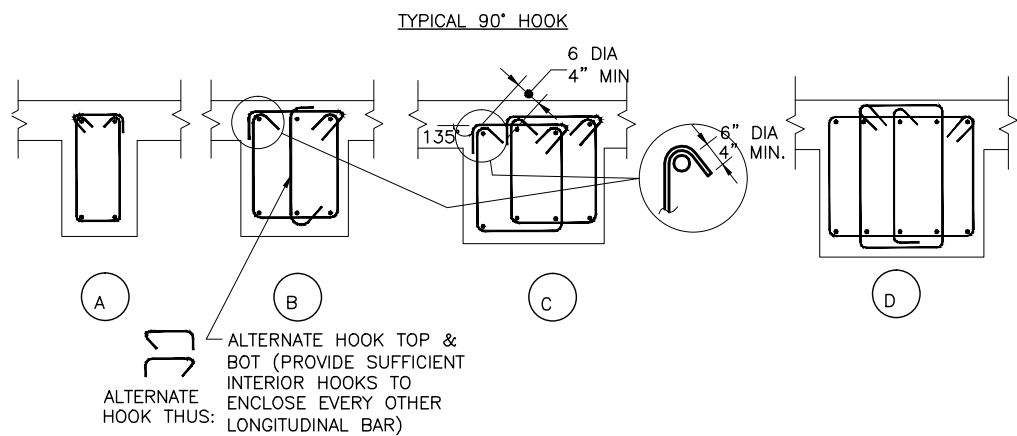


**STIRRUP TYPES**  
SCALE: NTS

5  
DB-S767

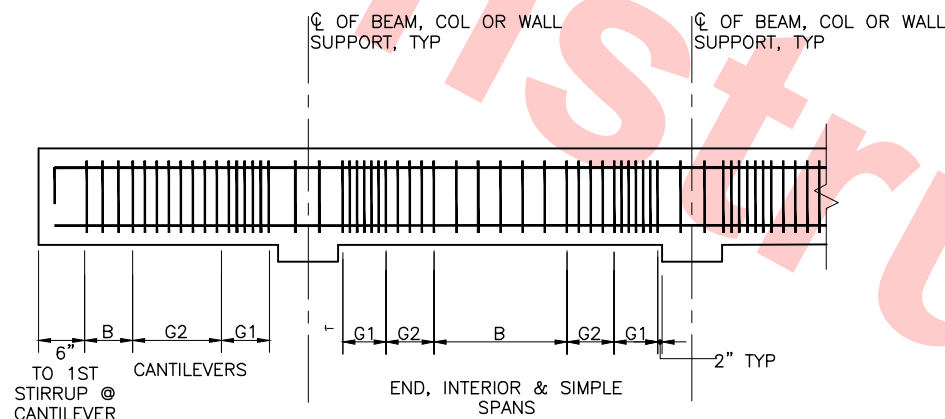

**STIRRUP SPACING LAYOUT**  
SCALE: NTS

6  
DB-S767

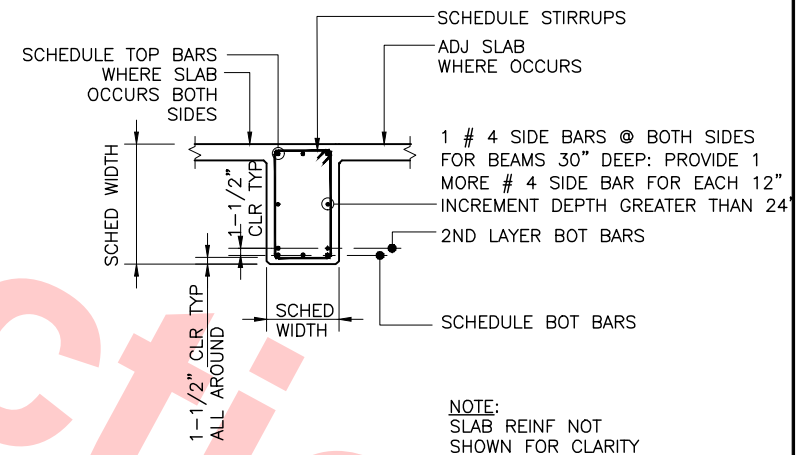

**TYPICAL SECTION**  
SCALE: NTS


7  
DB-S767

FOR REFERENCE ONLY AND NOT FOR REVIEW. THIS  
DRAWING WAS ALREADY SUBMITTED UNDER DU23-  
WP08 RFC TRENCH PACKAGE.

004-02 Jul 05, 2013 1:57pm P:\BART Berryessa Extension Line\AS - STRUCTURAL\MILPITAS WORK\6-10-2012\0700-S-DB-S767.dwg

REV	DATE	BY	SUB	APP	DESCRIPTION
0	20130710				READINESS FOR CONSTRUCTION

DESIGNED BY  
J. REBER, S.E.  
DRAWN BY  
P. DIAZ  
CHECKED BY  
M. TARAZI  
IN CHARGE  
M. TARAZI  
DATE  
20130531

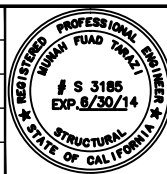

Skanska  
Shimmick  
Herzog  
1436 California Circle  
Milpitas, California 95035  
A Joint Venture  
MFT CONSULTING ENGINEERS, INC. Anil Verma Associates, Inc.  
1773 San Pablo Ave., Suite A3 (510) 222-4166  
Pinole, CA 94664 Fax (510) 222-6419

Lealwood, Andrews  
& Newman, Inc.  
A LEO A DALY COMPANY  
T-Y-LIN INTERNATIONAL




LINE, TRACK, STATIONS AND SYSTEMS  
DESIGN UNIT 023  
MILPITAS STATION  
CONCRETE BEAM/GIRDER  
DETAILS  
SHEET 1 OF 4

CADD FILENAME C700-S-DB-S767.dwg	REV.
SIZE D	0
SCALE NONE	
CONTRACT NO. C700	
AREA CODE DB	
SHEET NO. S767	
PAGE NO. 0264	




Jul 05, 2013 - 1:57pm P:\BART Berryessa Extension Line\AS - STRUCTURAL MILPITAS WORK\6-10-2012\0700-S-DB-S768.dwg

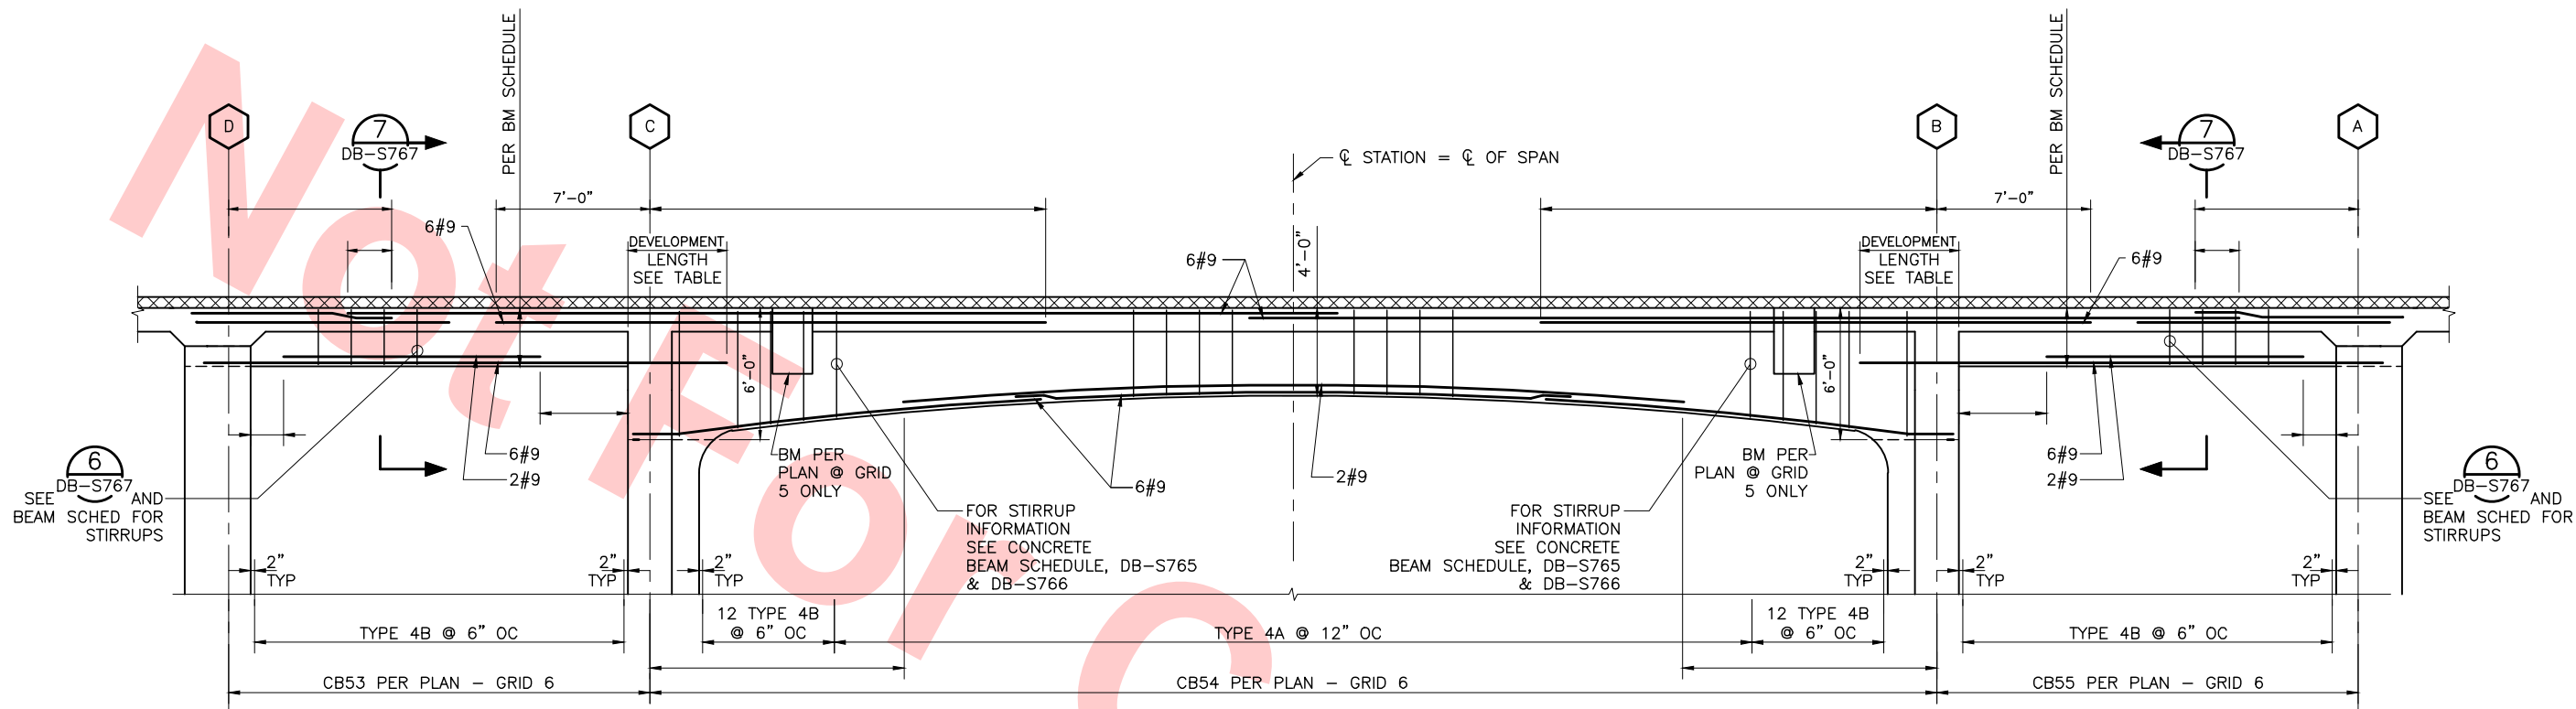


FOR REFERENCE ONLY AND NOT FOR REVIEW. THIS DRAWING WAS ALREADY SUBMITTED UNDER DU23-WP08 RFC TRENCH PACKAGE.

SECTION @ ARCH GIRDER GRID 6 DB-S766  
CONCRETE GIRDER REINFORCEMENT DIAGRAM  
SCALE: 1/4"=1'-0"

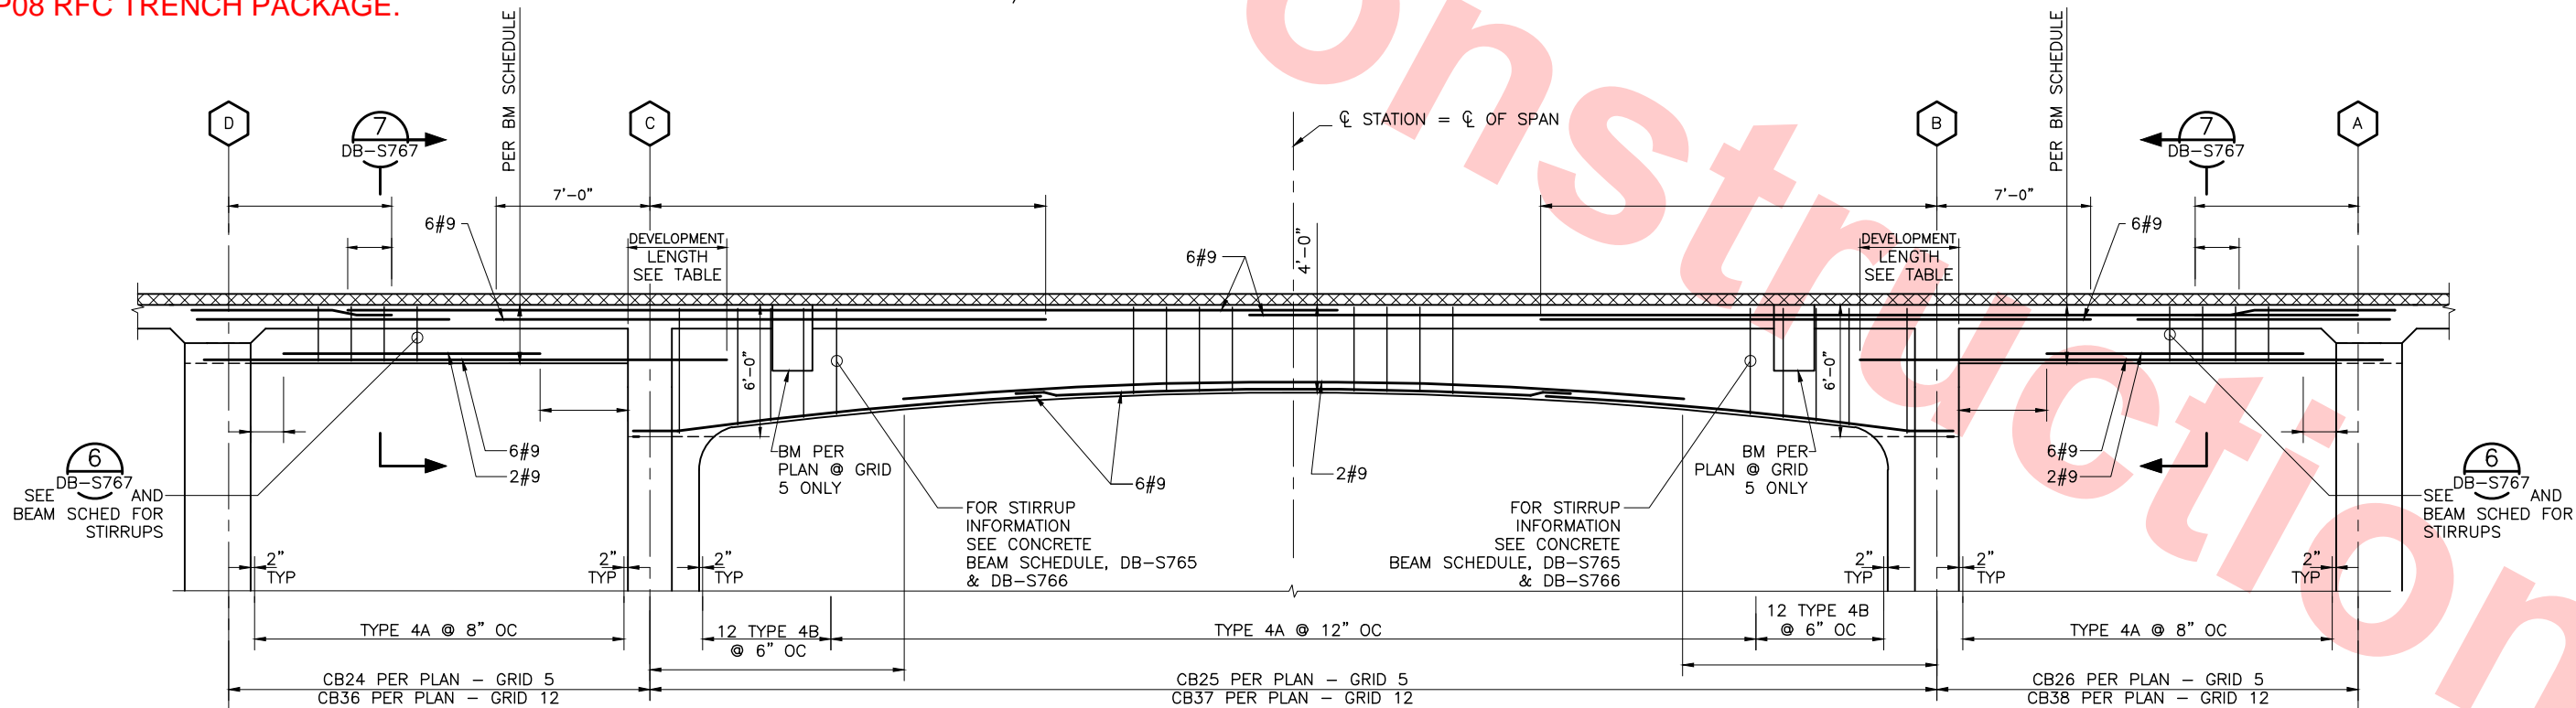

SECTION @ ARCH GIRDERS GRIDS 5 & 12 DB-S768  
CONCRETE GIRDER REINFORCEMENT DIAGRAM  
SCALE: 1/4"=1'-0"

DESIGNED BY J. REBER, S.E.	0	20130710	BY	SUB	APP	READINESS FOR CONSTRUCTION
DRAWN BY P. DIAZ	REV	DATE	BY	SUB	APP	DESCRIPTION
CHECKED BY M. TARAZI						
IN CHARGE M. TARAZI						
DATE 20130710						

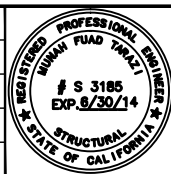

Skanska  
Shimmick  
Herzog

1436 California Circle  
Milpitas, California 95035  
A Joint Venture

MFT CONSULTING ENGINEERS, INC. Anil Verma Associates, Inc.  
1773 San Pablo Ave., Suite A3  
Pinole, CA 94664  
(916) 222-4166  
Fax (916) 222-6419

Lealwood, Andrews  
& Newman, Inc.

A LEO A DALY COMPANY


T-Y-LIN INTERNATIONAL

APPROVED




LINE, TRACK, STATIONS AND SYSTEMS DESIGN UNIT 023 MILPITAS STATION CONCRETE BEAM/GIRDER DETAILS SHEET 2 OF 4	CADD FILENAME C700-S-DB-S768.dwg
SIZE D	SCALE 1/4" = 1'-0"
CONTRACT NO. C700	REV. 0
AREA CODE DB	SHEET NO. S768
PAGE NO. 0265	



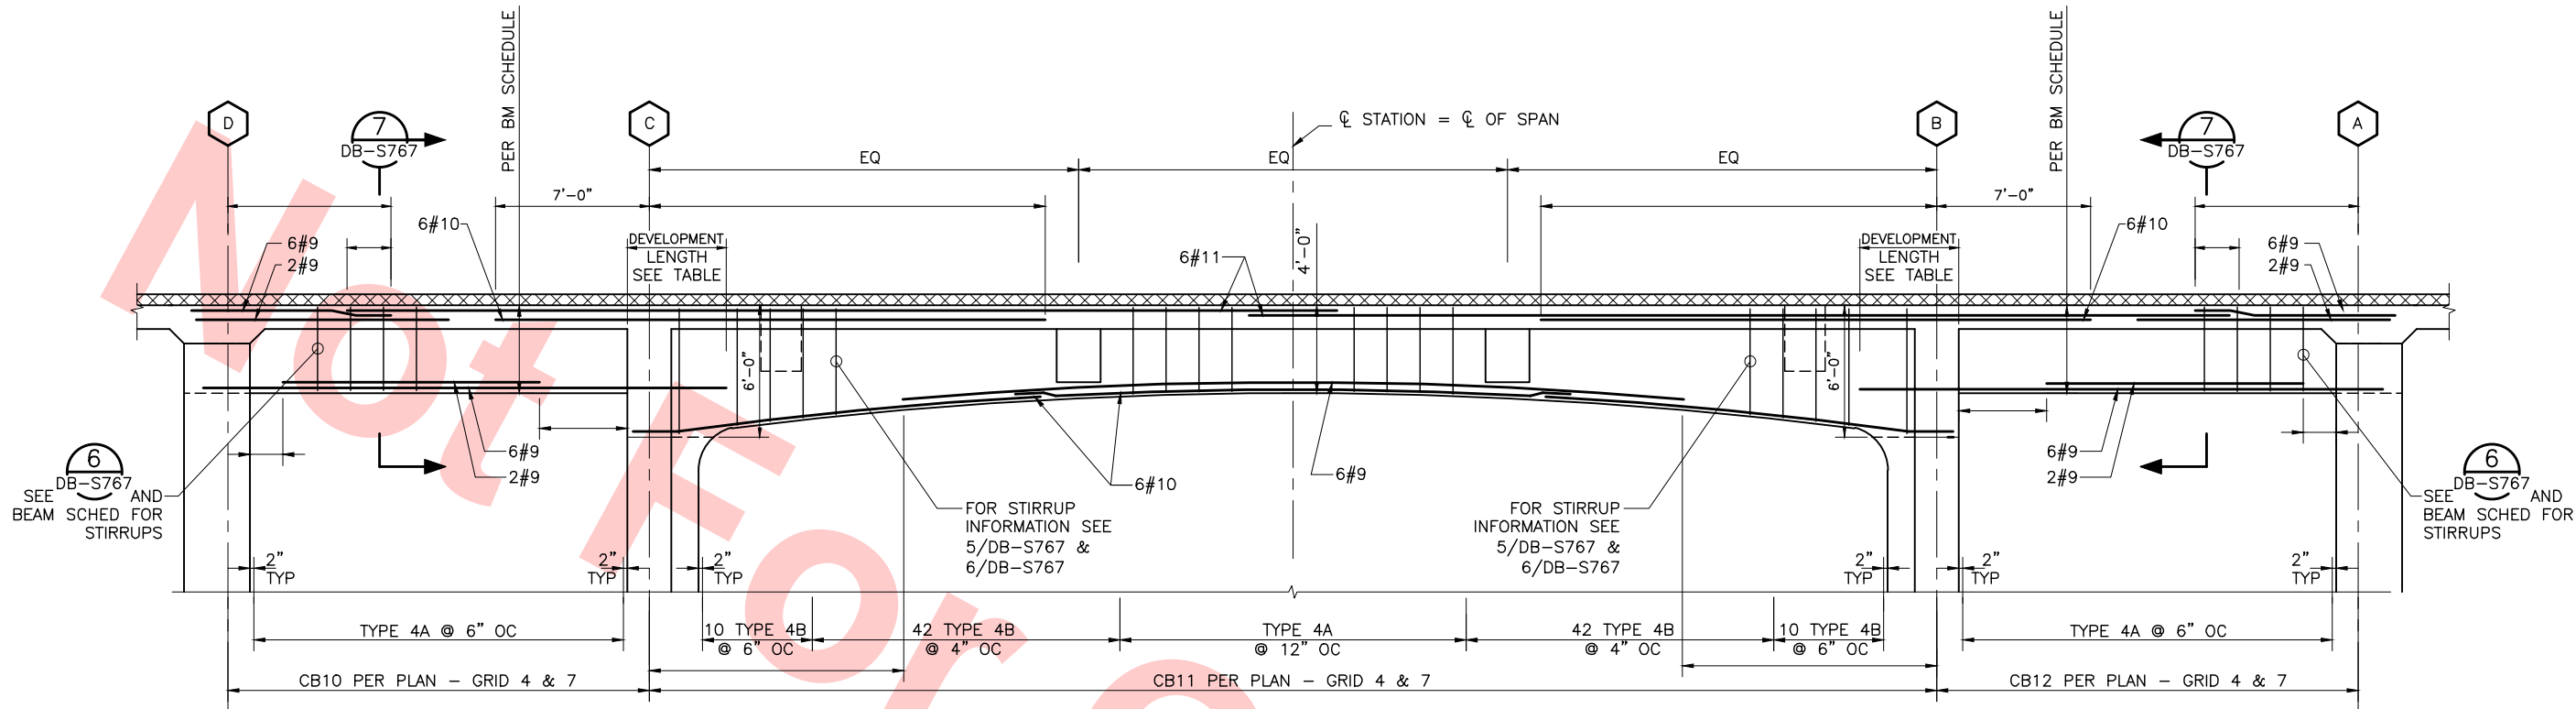

FOR REFERENCE ONLY AND NOT FOR REVIEW. THIS DRAWING WAS ALREADY SUBMITTED UNDER DU23-WP08 RFC TRENCH PACKAGE.


**SECTION @ ARCH GIRDERS GRIDS 4 & 7 (A)**  
 CONCRETE GIRDER REINFORCEMENT DIAGRAM  
 SCALE: 1/4"=1'-0"

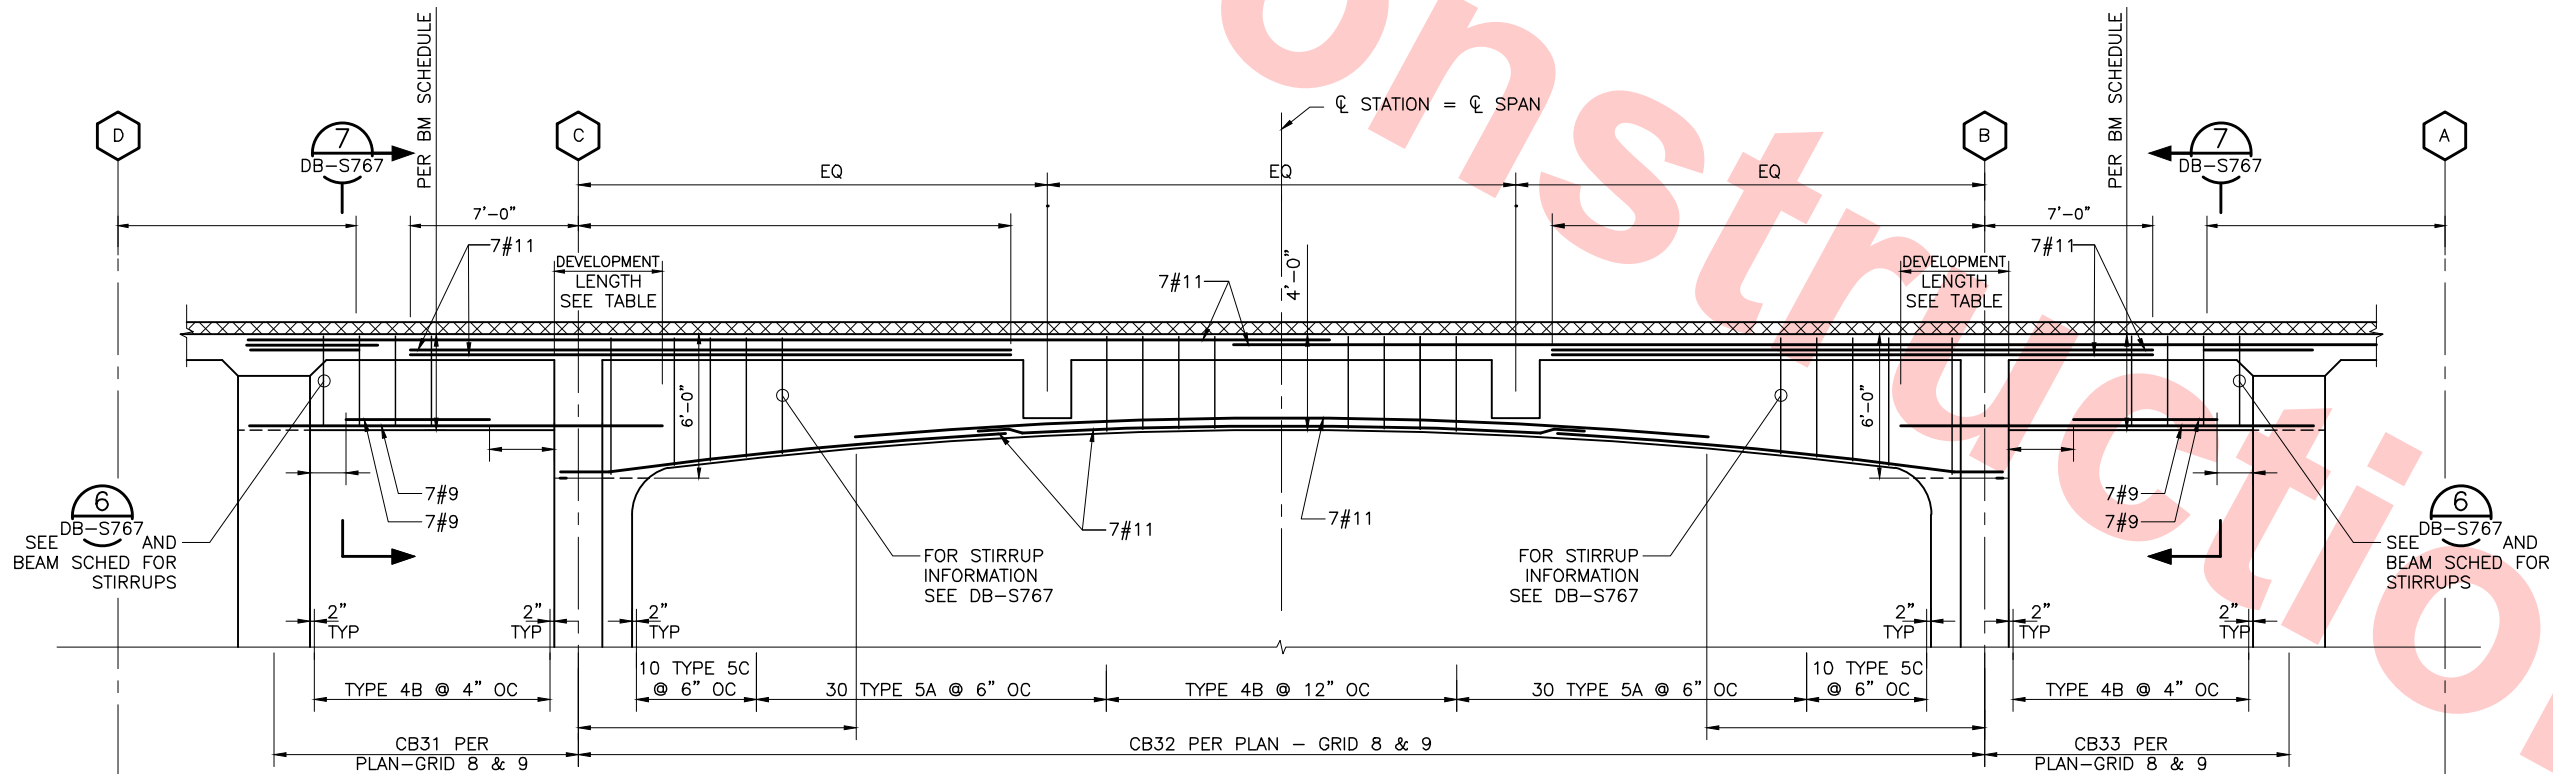

**SECTION @ ARCH GIRDERS GRIDS 8 & 9 (B)**  
 CONCRETE GIRDER REINFORCEMENT DIAGRAM  
 SCALE: 1/4"=1'-0"

Jul 05, 2013 1:57pm P:\BART Berryessa Extension Line\AS - STRUCTURAL MILPITAS WORK\_8-10-2012\0700-S-DB-S769.dwg

DESIGNED BY J. REBER, S.E.	0	20130710	BY	APP	READINESS FOR CONSTRUCTION
DRAWN BY P. DIAZ	REV	DATE	BY	SUB	DESCRIPTION
CHECKED BY M. TARAZI					
IN CHARGE M. TARAZI					
DATE 20130710					

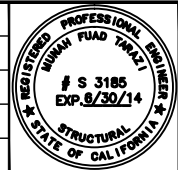

**Skanska Shimmick Herzog**  
 1436 California Circle  
 Milpitas, California 95035  
 A Joint Venture  
 MFT CONSULTING ENGINEERS, INC. Anil Verma Associates, Inc.  
 1773 San Pablo Ave., Suite A3 (510) 222-4166  
 Pinole, CA 94664 Fax (510) 222-6418

**Lealwood, Andrews & Newman, Inc.**  
 A LEAD & BARRY COMPANY  
**T-Y-LIN INTERNATIONAL**




**LINE, TRACK, STATIONS AND SYSTEMS**  
**DESIGN UNIT 023**  
 MILPITAS STATION  
 CONCRETE BEAM/GIRDER  
 DETAILS  
 SHEET 3 OF 4


CADD FILENAME C700-S-DB-S769.dwg	CONTRACT NO. C700	REV. 0
SIZE D	SHEET NO. S769	PAGE NO. 0266
SCALE 1/4" = 1'-0"	AREA CODE DB	



Jul 05, 2013 1:57pm P:\BART Berryessa Extension Line\AS - STRUCTURAL MILPITAS WORK\6-10-2012\CT00-S-DB-S770.dwg

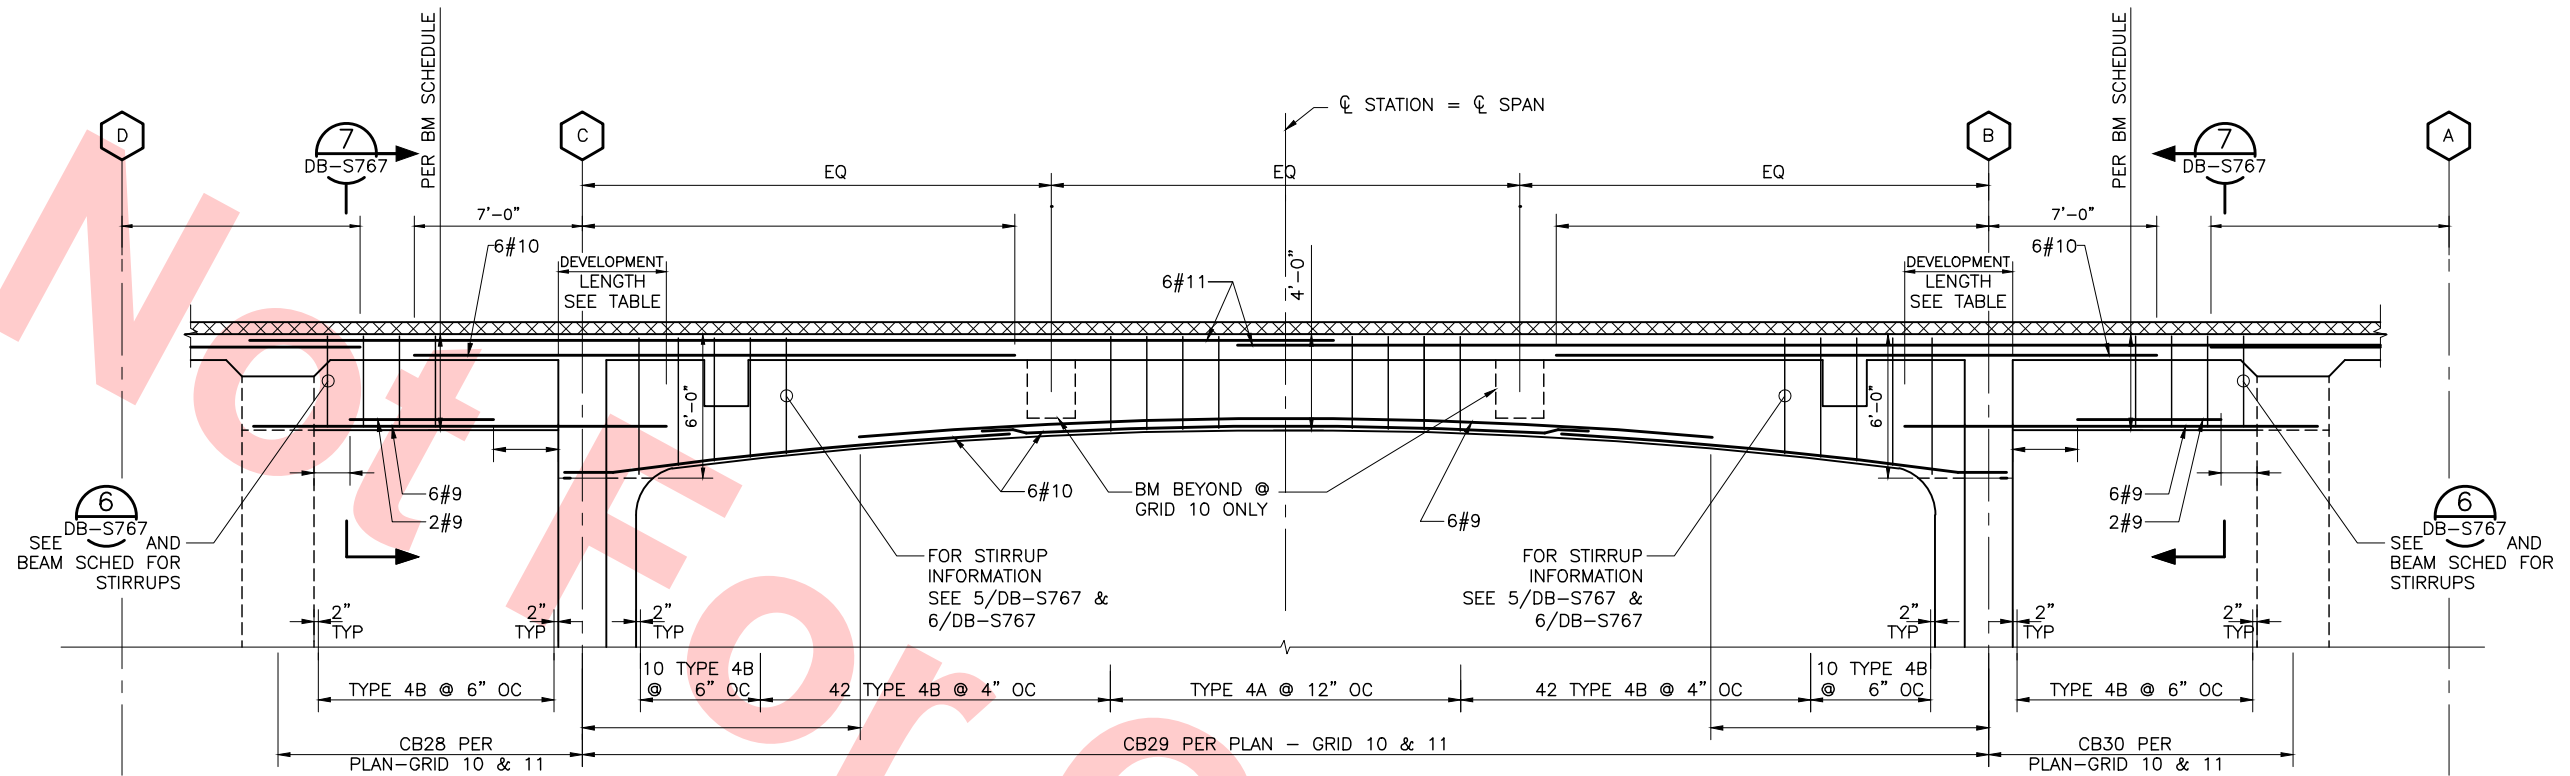


SECTION @ ARCH GIRDERS GRIDS 10 & 11  
CONCRETE GIRDER REINFORCEMENT DIAGRAM  
SCALE: 1/4"=1'-0"

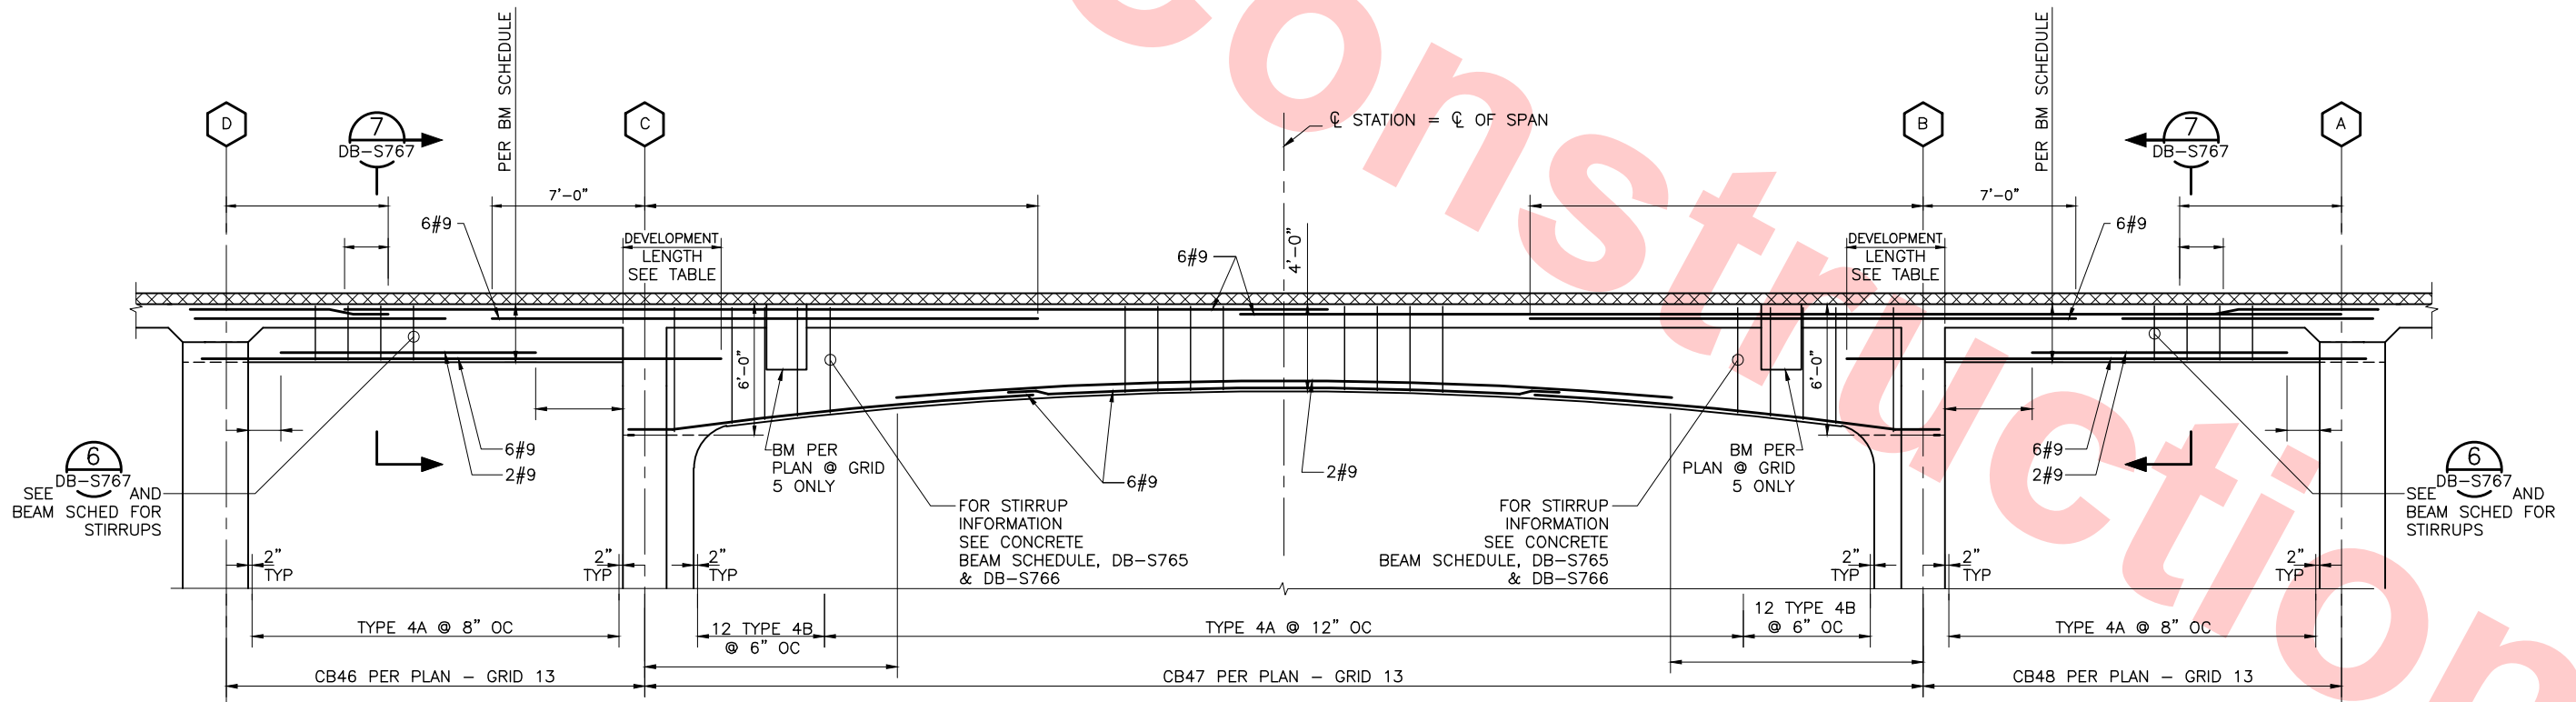

SECTION @ ARCH GIRDER GRIDS 13  
CONCRETE GIRDER REINFORCEMENT DIAGRAM  
SCALE: 1/4"=1'-0"

FOR REFERENCE ONLY AND NOT FOR REVIEW. THIS  
DRAWING WAS ALREADY SUBMITTED UNDER DU23-  
WP08 RFC TRENCH PACKAGE.

DESIGNED BY J. REBER, S.E.	0	20130710	BY	APP	READINESS FOR CONSTRUCTION
DRAWN BY P. DIAZ	REV	DATE	BY	SUB	DESCRIPTION
CHECKED BY M. TARAZI					
IN CHARGE M. TARAZI					
DATE 20130710					

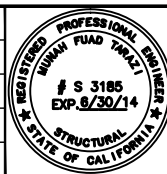

Skanska  
Shimmick  
Herzog

MFT CONSULTING ENGINEERS, INC. Anil Verma Associates, Inc.  
1773 San Pablo Ave., Suite A3  
Pinole, CA 94564  
(916) 222-4166  
Fax (916) 222-6419

1436 California Circle  
Milpitas, California 95035  
A Joint Venture

Lealwood, Andrews  
& Newman, Inc.  
A LEO A DALY COMPANY


T-Y-LIN INTERNATIONAL



LINE, TRACK, STATIONS AND SYSTEMS  
DESIGN UNIT 024  
MILPITAS STATION  
CONCRETE BEAM/GIRDER  
DETAILS  
SHEET 4 OF 4

CADD FILENAME C700-S-DB-S770.dwg	REV.	0
SIZE D	SCALE 1/4" = 1'-0"	
CONTRACT NO. C700	SHEET NO. S770	PAGE NO. 0267
AREA CODE DB		




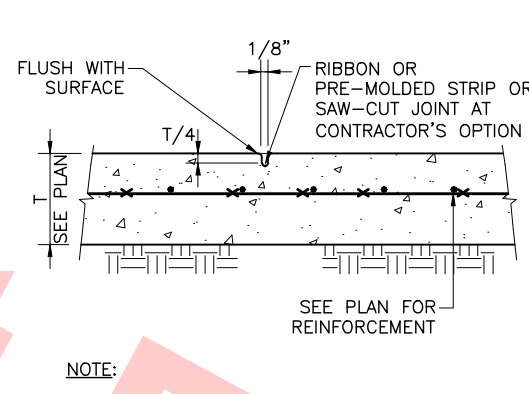

1. CONTROL JOINTS SHALL BE LOCATED AT 10'-0" CENTER TO CENTER EACH WAY AND SHALL BE LOCATED BETWEEN CONSTRUCTION JOINTS.

SLAB ON GRADE  
CONTROL JOINT


SCALE: NTS

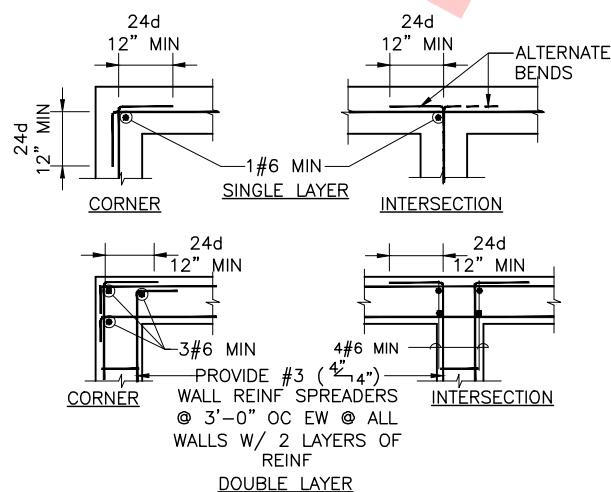

- NOTE:**
1. SEE OTHER DETAILS & NOTES FOR SIZE & SPACING OF REINF
  2. LAP & HOOK FTG BARS AT CORNERS & INTERSECTIONS SAME AS FOR WALLS, EXCEPT THAT ADDED VERTICALS AT CORNERS ARE NOT REQUIRED

## TYPICAL DETAILS OF CONCRETE WALLS REINFORCEMENT


SCALE: NTS

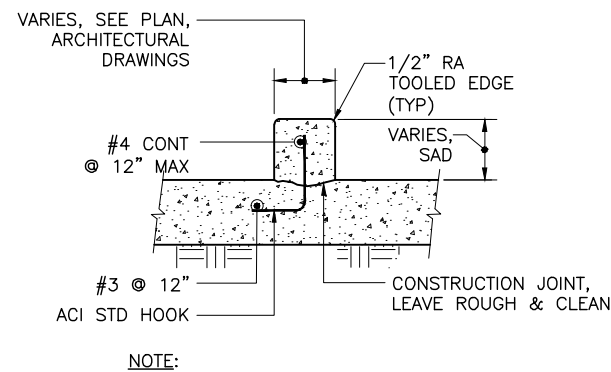

1. AT CONTRACTOR'S OPTION, #3 DOWELS MAY BE EPOXY GROUTED INTO SLAB, DEPTH=2/3 OF SLAB THICKNESS.

### CONCRETE CURB


SCALE: NTS

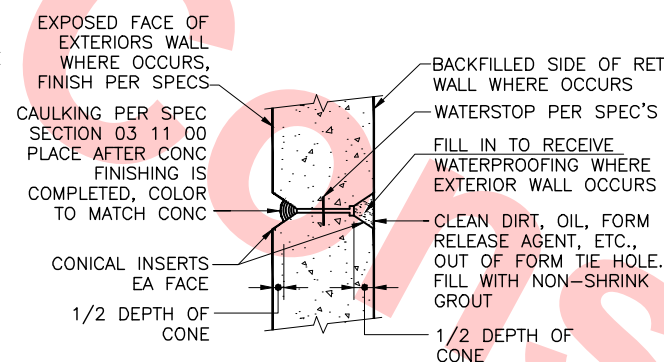

- NOTE:**
1. THE SPACING OF FORM TIES ON EXPOSED PORTIONS OF WALLS SHALL BE PROXIMATELY EQUAL HORIZONTALLY & VERTICALLY & SHALL BE UNIFORM IN EACH DIRECTION
  2. WHERE CAULKING IS NOT SPECIFIED OR SHOWN, CLEAN FORM TIE HOLES AS NOTED FOR NON-SHRINK GROUT AND DRY PACK WITH PATCHING MORTAR PER SPECS WITH COLOR MORTAR TO MATCH COLOR OF CONCRETE.
  3. DRY PACK METHOD SHALL BE AS SPECIFIED USING STEEL TOOLS.

FORM SNAP-TIE HOLE


SCALE: NTS

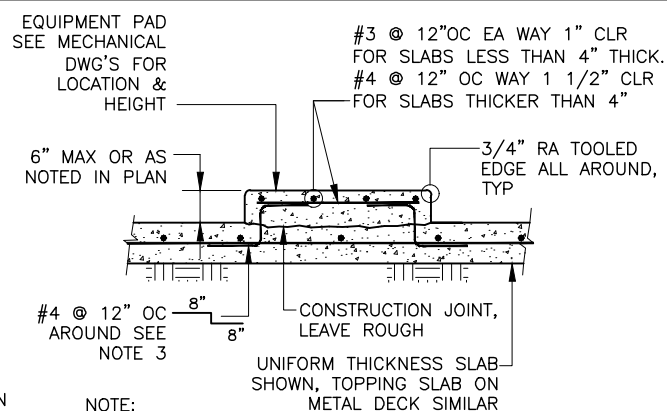

- NOTE: METAL DECK SIMILAR
1. PAD SIZE SHALL BE MINIMUM AS NOTED ON THE PLANS OR AS INDICATED BY THE EQUIPMENT MFR. AND APPROVED BY THE ENGINEER.
  2. EQUIPMENT BASES SHALL BE INSTALLED LEVEL UNLESS SPECIFIED OTHERWISE.
  3. AT CONTRACTOR'S OPINION, #4 DOWELS MAY EPOXY GROUTED INTO THE SLAB (DEPTH=2/3 OF SLAB THICKNESS OR TOPPING SLAB THICKNESS) AT DECK FLUTE.

## EQUIPMENT PAD


SCALE: NTS

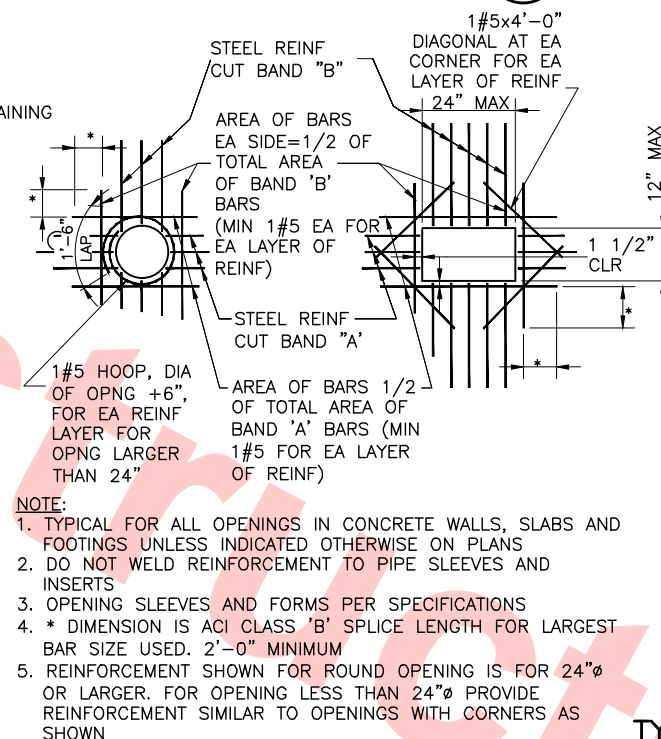

- NOTE:**
1. TYPICAL FOR ALL OPENINGS IN CONCRETE WALLS, SLABS AND FOOTINGS UNLESS INDICATED OTHERWISE ON PLANS
  2. DO NOT WELD REINFORCEMENT TO PIPE SLEEVES AND INSERTS
  3. OPENING SLEEVES AND FORMS PER SPECIFICATIONS
  4. \* DIMENSION IS ACI CLASS 'B' SPLICE LENGTH FOR LARGEST BAR SIZE USED. 2'-0" MINIMUM
  5. REINFORCEMENT SHOWN FOR ROUND OPENING IS FOR 24"Ø OR LARGER. FOR OPENING LESS THAN 24"Ø PROVIDE REINFORCEMENT SIMILAR TO OPENINGS WITH CORNERS AS SHOWN

## OPENING REINFORCEMENT


SCALE: NTS

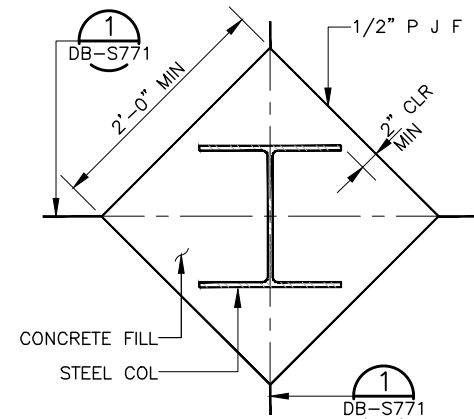

- NOTE:  
HOLD PJF 1/2" BELOW TOC @ JOINTS  
REQUIREMENTS SEALANT

## ISOLATION JONT @ COLUMN 5

SCALE: NTS

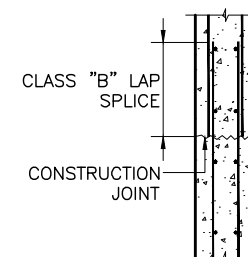


- NOTE:**
1. JOINT SURFACE SHALL BE CLEAN AND FREE OF LAITANCE AND ROUGHENED TO EXPOSE AGGREGATE TO FULL 1/4" AMPLITUDE
  2. JOINT OF WALL TO FOOTING AND JOINT OF CONC SLAB TO WALL ARE SIMILAR

TYPICAL HORIZONTAL  
CONSTRUCTION JOINT IN  
CONCRETE WALL

SCALE: NTS

Jul 05, 2013						DESIGNED BY J. REBER, S.E.
						DRAWN BY P. DIAZ
						CHECKED BY M. TARAZI
						IN CHARGE M. TARAZI
0	20130531				READINESS FOR CONSTRUCTION	DATE 20130531
REV	DATE	BY	SUB	APP	DESCRIPTION	



**Skanska Shimmick Herzog**

1436 California Circle  
Milpitas, California 95035  
A Joint Venture

**MFT CONSULTING ENGINEERS, INC.** And Verma Associates, Inc.  
1773 San Pablo Ave., Suite A3 (510) 222-6196  
Pinole, CA 94664 Fax (510) 222-6418

**Lockwood, Andrews & Newnam, Inc.**  
A T-10 X T-10 COMPANY

**T-Y-LIN INTERNATIONAL**

**BART SILICON VALLEY**

**BART SILICON VALLEY BERRYESSA EXTENSION**

**LINE, TRACK, STATIONS AND SYSTEMS**

**DESIGN UNIT 023**

MILPITAS STATION

TYPICAL CONCRETE

SECTIONS AND DETAILS

SHEET 1 OF 3


CADD FILENAME  
C700-S-DB-S771.dwg

SIZE D SCALE NONE

CONTRACT NO. **C700** REV. **C**

AREA CODE **DB** SHEET NO. **S771** PAGE NO. **0268**




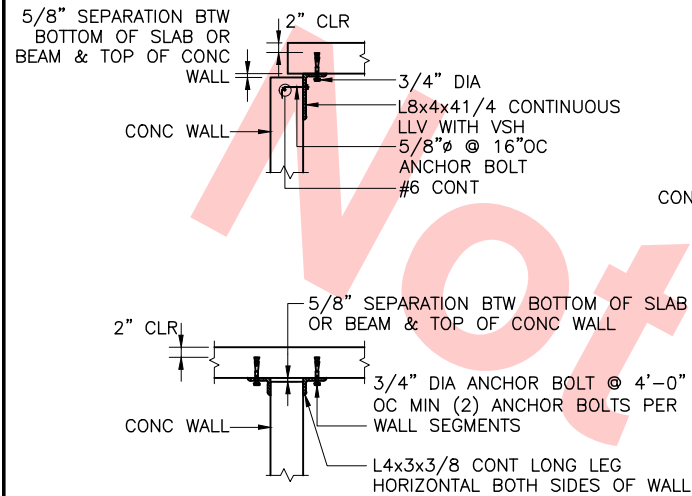

**TYPICAL TOP OF CONCRETE WALL WITH SEPARATION JOINTS**

SCALE: NTS


1  
DB-S772

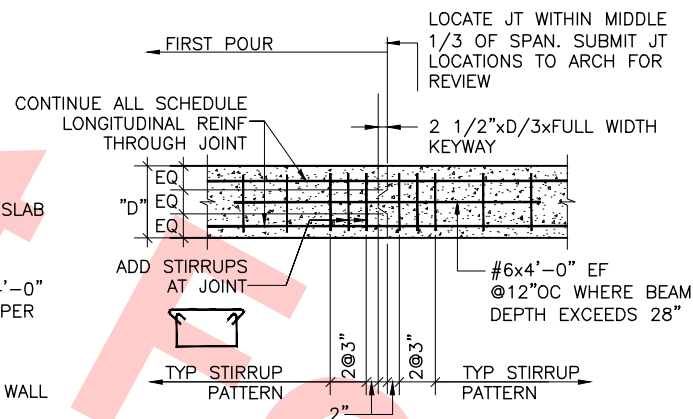

**TYPICAL CONSTRUCTION JOINT IN CONCRETE BEAM OR GRADE BEAM OR CONT. FOOTING**


SCALE: NTS

2  
DB-S772

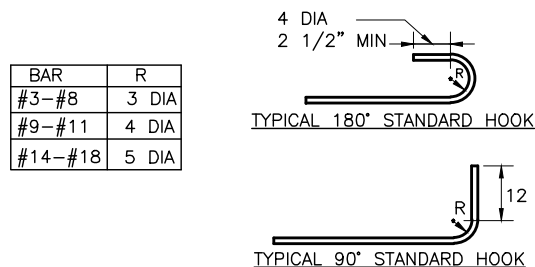

**TYPICAL 180° STANDARD HOOK**

**TYPICAL 90° STANDARD HOOK**

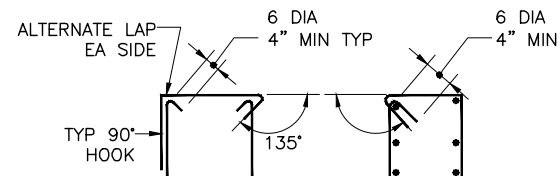

TYP. STIRRUP CAN BE USED AT CONTRACTORS OPTION, EXCEPT IN COLUMNS AND WHEN CLOSED STIRRUPS ARE NOTED

TYP. COLUMN TIE OR CLOSED STIRRUPS

**TYP. REINFORCEMENT BAR HOOKS BENDS, STIRRUPS AND TIES**


SCALE: NTS

6  
DB-S772

**SLAB ON GRADE EXPANSION**

SCALE: NTS

7  
DB-S772

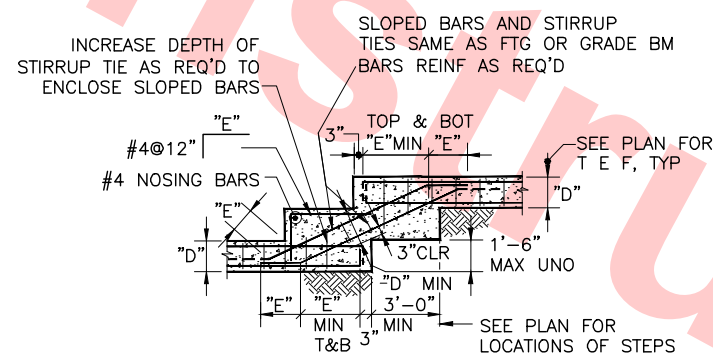


NOTE: "E" = DEVELOPMENT LENGTH  $l_d$  HOOK, AS REQ'D TO PROVIDE SPEC'S EMBEDMENT

**TYP. STEPPED FTG. OR GRADE BEAM**

SCALE: NTS


8  
DB-S772

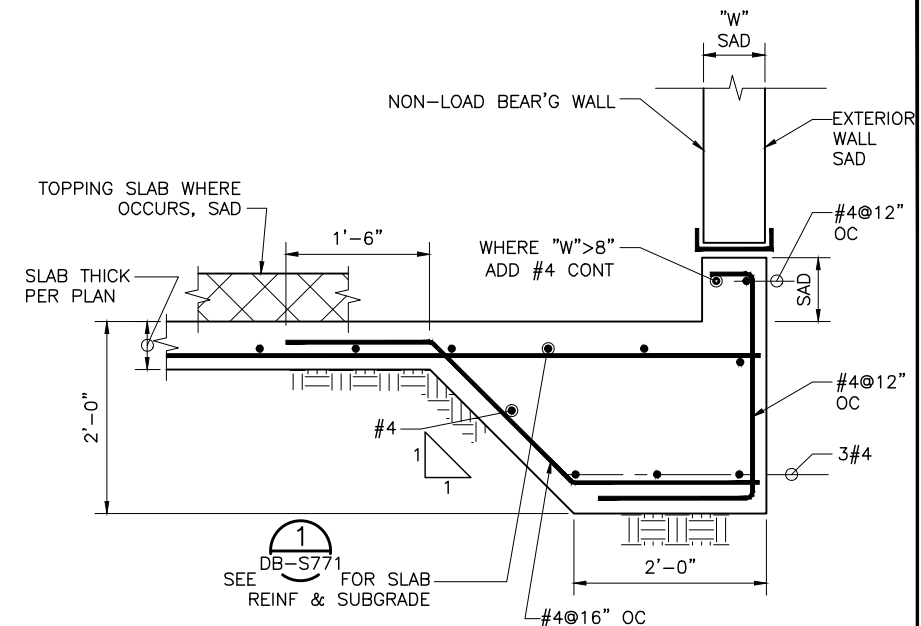

**SLAB ON GRADE @ EDGE**

SCALE: 3/4" = 1'-0"

4  
DB-S121

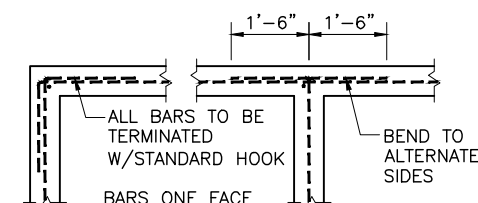

NOTE: TYPICAL FOOTING BARS RUN CONTINUOUS WITH LAPS PER THE GENERAL NOTES. PROVIDE ADDITIONAL BARS AT STEP-DOWN CONDITIONS

**CONC. FOOTING AND WALL**

SCALE: NTS


9  
DB-S772

**FOR REFERENCE ONLY AND NOT FOR REVIEW. THIS DRAWING WAS ALREADY SUBMITTED UNDER DU23-WP08 RFC TRENCH PACKAGE.**

04-02 Jul 05, 2013 1:57pm P:\BART Berryessa Extension Line\5 - STRUCTURAL MILPITAS WORK\6-10-2012\0700-S-DB-S772.dwg

REV	DATE	BY	SUB	APP	DESCRIPTION
0	20130531				READINESS FOR CONSTRUCTION

DESIGNED BY  
J. REBER, S.E.  
DRAWN BY  
P. DIAZ  
CHECKED BY  
M. TARAZI  
IN CHARGE  
M. TARAZI  
DATE  
20130531

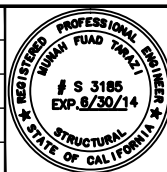

Skanska  
Shimmick  
Herzog  
1436 California Circle  
Milpitas, California 95035  
A Joint Venture  
MFT CONSULTING ENGINEERS, INC. Anil Verma Associates, Inc.  
1773 San Pablo Ave., Suite A3 (510) 222-4166  
Palo Alto, CA 94304 Fax (510) 222-6419

Lealwood, Andrews & Newman, Inc.  
A LEO A DALY COMPANY  
T-Y-LIN INTERNATIONAL  
APPROVED

**BART**  
SILICON VALLEY  
BART SILICON VALLEY BERRYESSA EXTENSION

LINE, TRACK, STATIONS AND SYSTEMS  
DESIGN UNIT 023  
MILPITAS STATION  
TYPICAL CONCRETE  
SECTIONS AND DETAILS  
SHEET 2 OF 3

CADD FILENAME C700-S-DB-S772.dwg	SIZE D	SCALE AS NOTED
CONTRACT NO. C700	SHEET NO. S772	REV. 0
AREA CODE DB	PAGE NO. 0269	



004-02 Jul 05, 2013 - 1:57pm P:\BART Berryessa Extension Line\5 - STRUCTURAL MILPITAS WORK\6-10-2012\0700-S-DB-S773.dwg

DEVELOPMENT LENGTH $l_d$ AND SPLICE LENGTH FOR GRADE 60, UNCOATED IN NORMAL WEIGHT CONCRETE									
	$f'_c$ PSI	DEVELOPMENT LENGTH				SPLICE LENGTH			
		No 6 AND SMALLER BARS AND DEFORMED WIRES		No 7 AND LARGER BARS		No 6 AND SMALLER BARS		No 7 AND LARGER BARS	
		TOP	BOT.	TOP	BOT.	TOP	BOT.	TOP	BOT.
CASE 1	3,000	58 $\phi_b$	44 $\phi_b$	72 $\phi_b$	55 $\phi_b$	75 $\phi_b$	58 $\phi_b$	93 $\phi_b$	72 $\phi_b$
	4,000	50 $\phi_b$	38 $\phi_b$	62 $\phi_b$	47 $\phi_b$	65 $\phi_b$	50 $\phi_b$	80 $\phi_b$	62 $\phi_b$
	5,000	45 $\phi_b$	34 $\phi_b$	55 $\phi_b$	42 $\phi_b$	58 $\phi_b$	45 $\phi_b$	71 $\phi_b$	55 $\phi_b$
	6,000	41 $\phi_b$	31 $\phi_b$	51 $\phi_b$	39 $\phi_b$	53 $\phi_b$	41 $\phi_b$	66 $\phi_b$	51 $\phi_b$
	8,000	36 $\phi_b$	27 $\phi_b$	45 $\phi_b$	34 $\phi_b$	46 $\phi_b$	36 $\phi_b$	58 $\phi_b$	45 $\phi_b$
	10,000	32 $\phi_b$	24 $\phi_b$	39 $\phi_b$	30 $\phi_b$	41 $\phi_b$	32 $\phi_b$	51 $\phi_b$	39 $\phi_b$
CASE 2	3,000	86 $\phi_b$	66 $\phi_b$	106 $\phi_b$	82 $\phi_b$	112 $\phi_b$	86 $\phi_b$	139 $\phi_b$	107 $\phi_b$
	4,000	75 $\phi_b$	57 $\phi_b$	93 $\phi_b$	71 $\phi_b$	97 $\phi_b$	75 $\phi_b$	120 $\phi_b$	93 $\phi_b$
	5,000	66 $\phi_b$	51 $\phi_b$	83 $\phi_b$	64 $\phi_b$	86 $\phi_b$	66 $\phi_b$	108 $\phi_b$	83 $\phi_b$
	6,000	60 $\phi_b$	46 $\phi_b$	76 $\phi_b$	58 $\phi_b$	78 $\phi_b$	60 $\phi_b$	98 $\phi_b$	76 $\phi_b$
	8,000	52 $\phi_b$	40 $\phi_b$	65 $\phi_b$	50 $\phi_b$	68 $\phi_b$	52 $\phi_b$	85 $\phi_b$	65 $\phi_b$
	10,000	47 $\phi_b$	36 $\phi_b$	59 $\phi_b$	45 $\phi_b$	61 $\phi_b$	47 $\phi_b$	76 $\phi_b$	59 $\phi_b$

DEVELOPMENT LENGTH $l_d$ AND SPLICE LENGTH FOR GRADE 60, EPOXY COATED BARS IN NORMAL WEIGHT CONCRETE									
	$f'_c$ PSI	DEVELOPMENT LENGTH				SPLICE LENGTH			
		No 6 AND SMALLER BARS		No 7 AND LARGER BARS		No 6 AND SMALLER BARS		No 7 AND LARGER BARS	
		TOP	BOT.	TOP	BOT.	TOP	BOT.	TOP	BOT.
CASE 1	4,000	61 $\phi_b$	54 $\phi_b$	77 $\phi_b$	68 $\phi_b$	80 $\phi_b$	71 $\phi_b$	101 $\phi_b$	89 $\phi_b$
CASE 2	4,500	92 $\phi_b$	81 $\phi_b$	115 $\phi_b$	88 $\phi_b$	120 $\phi_b$	106 $\phi_b$	150 $\phi_b$	115 $\phi_b$

NOTES:

1. AT WALLS, COLUMNS, BEAMS, AND SLABS, USE EMBEDMENT SHOWN ABOVE FOR ALL UNCOATED BARS IN NORMAL WEIGHT CONCRETE WITH CLEAR SPACING BETWEEN BARS GREATER THAN OR EQUAL TO 4 BAR DIAMETERS.
2. TOP BARS ARE HORIZONTAL BARS WITH 12" OR MORE OF CONCRETE CAST BELOW THEM.
3. CASE 1  
CONCRETE COVER NOT LESS THAN  $\phi_b$ ,  
& CLEAR SPACING NOT LESS THAN  $2\phi_b$   
OR  
CONCRETE COVER NOT LESS THAN  $\phi_b$  AND  
CLEAR SPACING OF BARS NOT LESS THAN  $\phi_b$  &  
WITH STIRRUPS OR TIES THROUGHOUT  $l_d$  NOT  
LESS THAN THE CODE MINIMUM.
4. CASE 2  
WHEN BAR SPACING AND COVER DO NOT  
MEET CASE 1 REQUIREMENTS
5. SEE CBC 2010 FOR OTHER CONDITIONS

TYPICAL REINFORCEMENT  
BAR DEVELOPMENT LENGTH  
AND SPLICES

SCALE: NTS

1  
DB-S773

DEVELOPMENT LENGTH $l_{dh}$ (INCHES) OF STANDARD HOOKS FOR UNCOATED GRADE 60 BARS						
BAR SIZE #	$f'_c$ (NORMAL WEIGHT CONCRETE), PSI					
	3,000	4,000	5,000	6,000	8,000	10,000
3	9	8	7	6	6	5
4	12	10	9	8	7	7
5	14	12	11	10	9	8
6	17	15	13	12	11	9
7	20	17	15	14	12	11
8	22	20	18	16	14	12
9	25	22	20	18	16	14
10	28	25	22	20	18	16
11	31	27	24	22	19	17
14	38	33	29	27	23	21
18	50	43	39	35	31	28

DEVELOPMENT LENGTH $l_{dh}$ (INCHES) OF STANDARD HOOKS FOR EPOXY COATED GRADE 60 BARS						
BAR SIZE #	$f'_c$ (NORMAL WEIGHT CONCRETE), PSI					
	4,500					
3	11					
4	14					
5	17					
6	21					
7	24					
8	27					
9	31					
10	35					
11	38					
14	46					
18	61					

TYPICAL REINFORCEMENT  
BAR DEVELOPMENT LENGTH  
FOR STANDARD HOOKS

SCALE: NTS

2  
DB-S773

DEVELOPMENT LENGTH $l_{dt}$ (INCHES) OF HEADED DEFORMED BARS FOR UNCOATED 60 BARS					
BAR SIZE #	$f'_c$ (NORMAL WEIGHT CONCRETE), PSI				
	3,000	4,000	5,000	6,000	OR LARGER
3	7	6	6	5	
4	9	8	7	7	
5	11	10	9	8	
6	14	12	11	10	
7	16	14	12	11	
8	18	16	14	13	
9	20	18	16	15	
10	23	20	18	16	
11	25	22	20	18	

TYPICAL REINFORCEMENT  
BAR DEVELOPMENT LENGTH  
FOR HEADED STUDS

SCALE: NTS

3  
DB-S773

CONCRETE WALL REINFORCEMENT SCHEDULE			
WALL THICKNESS	# OF LAYERS	VERTICAL REINFORCEMENT @ EACH LAYER	HORIZONTAL REINFORCEMENT @ EACH LAYER
24"	2	#7@12"	#8@12"
18"	2	#6@12"	#7@12"
12"	2	#5@12"	#6@12"
10"	2	#5@12"	#5@12"
8"	1	#5@12"	#7@12"
6"	1	#5@12"	#7@12"

TYPICAL CONCRETE WALL  
REINFORCEMENT SCHEDULE

SCALE: NTS

4  
DB-S773

Santa Clara Valley Transportation Authority

NO EXCEPTIONS TAKEN (NET)  
MAKE CORRECTIONS NOTED (MCN)  
AMEND AND RESUBMIT (A/R)


Any action shown above is subject to the terms of the contract  
and does not relieve the Contractor of any of its obligations  
under the contract, including design and detailing.

Contract No.: DB11002F

By: Date:

REV	DATE	BY	SUB	APP	DESCRIPTION
0	20130710				READINESS FOR CONSTRUCTION
0	20130531				READINESS FOR CONSTRUCTION

DESIGNED BY J. REBER, S.E.
DRAWN BY P. DIAZ
CHECKED BY M. TARAZI
IN CHARGE M. TARAZI
DATE 20130531

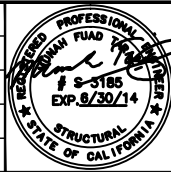


SUBMITTED		APPROVED	
MFT CONSULTING ENGINEERS, INC. Anil Verma Associates, Inc. 1773 San Pablo Ave., Suite A3 Pinole, CA 94664 (916) 222-4100 Fax (916) 222-8410		T-Y-LIN INTERNATIONAL A LEO A DALY COMPANY	

1436 California Circle Milpitas, California 95035 A Joint Venture		BART SILICON VALLEY BERRYESSA EXTENSION	
---	--	---	--

BART SILICON VALLEY BERRYESSA EXTENSION		BART SILICON VALLEY BERRYESSA EXTENSION	
---	--	---	--

LINE, TRACK, STATIONS AND SYSTEMS DESIGN UNIT 023 MILPITAS STATION TYPICAL CONCRETE SECTIONS AND DETAILS SHEET 3 OF 3				CADD FILENAME C700-S-DB-S773.dwg	
SIZE D		SCALE NONE		CONTRACT NO. C700	
AREA CODE DB		SHEET NO. S773		REV. 0	
				PAGE NO. 0270	



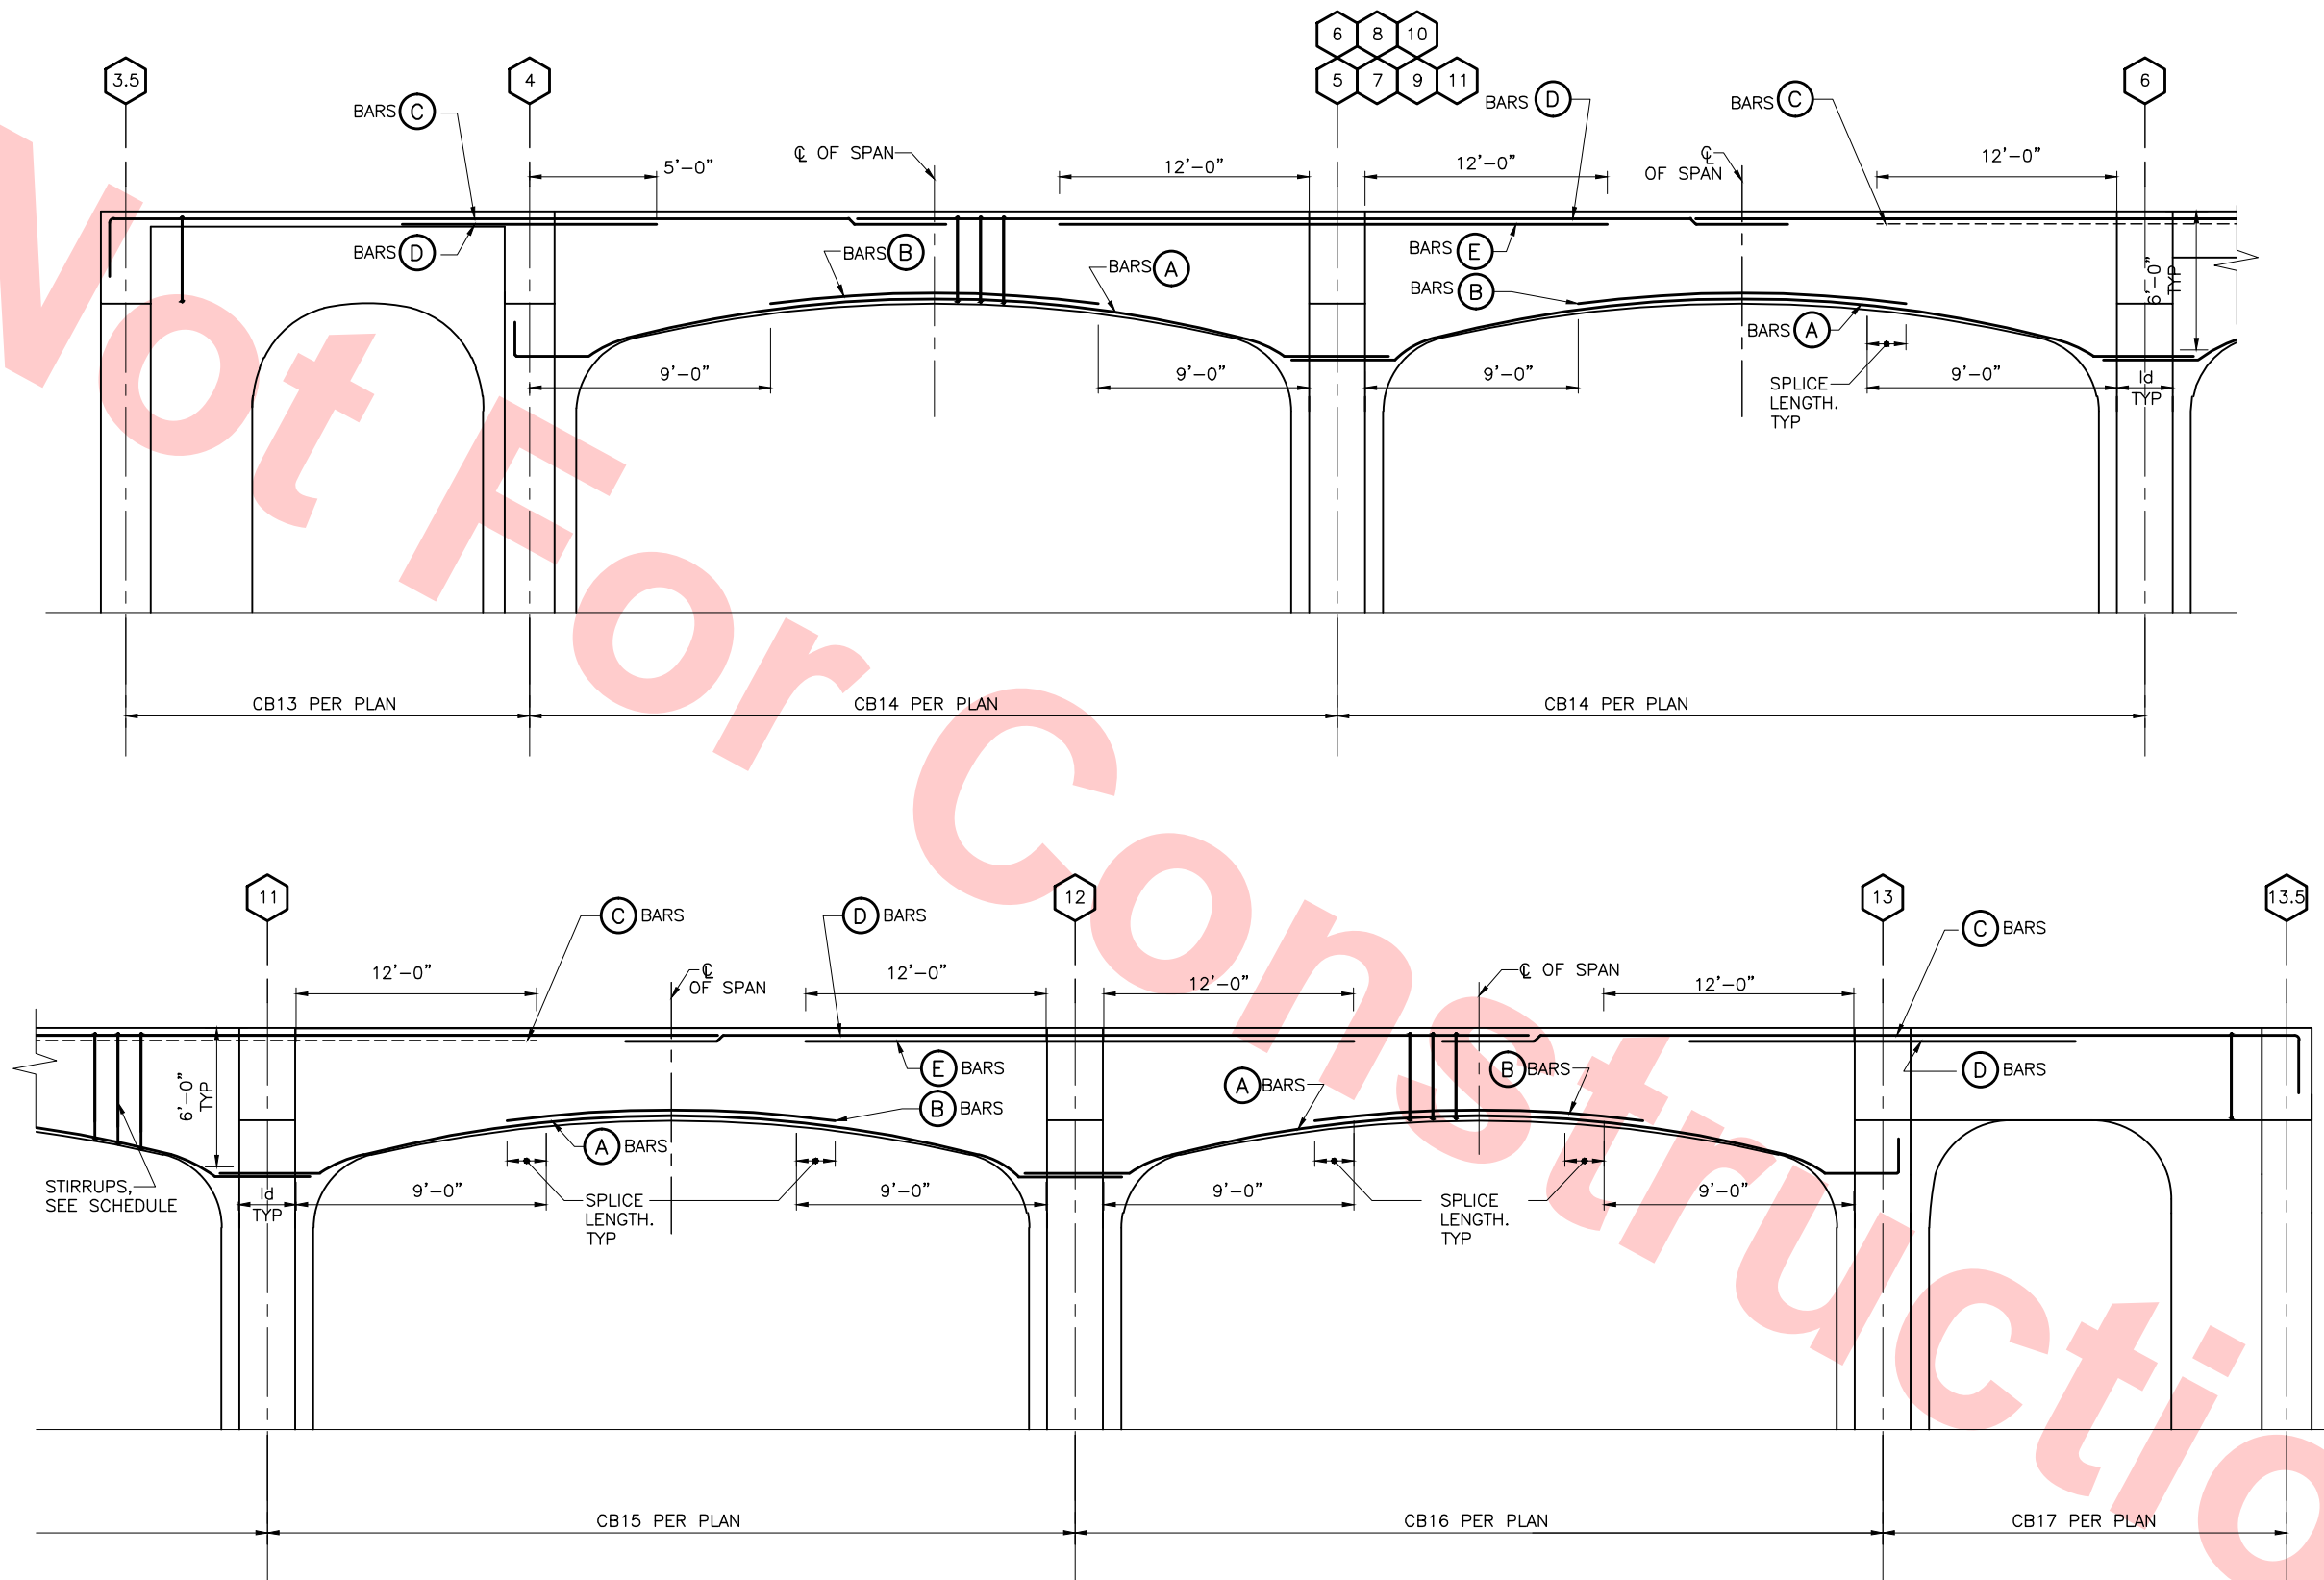


FOR REFERENCE ONLY AND NOT FOR REVIEW. THIS  
DRAWING WAS ALREADY SUBMITTED UNDER DU23-  
WP08 RFC TRENCH PACKAGE.

SECTION @ ARCH GIRDERS GRIDS B & C  
CONCRETE GIRDER REINFORCEMENT DIAGRAM  
SCALE: 1/4"=1'-0"

DB-S774 DB-S765

REV	DATE	BY	SUB	APP	DESCRIPTION
0	20130710				READINESS FOR CONSTRUCTION

DESIGNED BY  
J. REBER, S.E.  
DRAWN BY  
P. DIAZ  
CHECKED BY  
M. TARAZI  
IN CHARGE  
M. TARAZI  
DATE  
20130710

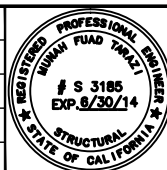

Skanska  
Shimmick  
Herzog  
1436 California Circle  
Milpitas, California 95035  
A Joint Venture  
MFT CONSULTING ENGINEERS, INC. Anil Verma Associates, Inc.  
1773 San Pablo Ave., Suite A3 (510) 222-4166  
Palo Alto, CA 94304 Fax (510) 222-6419

Lealwood, Andrews  
& Newman, Inc.  
A LEO A DALY COMPANY  
T-Y-LIN INTERNATIONAL




LINE, TRACK, STATIONS AND SYSTEMS  
DESIGN UNIT 023  
MILPITAS STATION  
CONCRETE BEAM/GIRDER  
DETAILS  
SHEET 1 OF 1

CADD FILENAME C700-S-DB-S774.dwg	CONTRACT NO. C700	REV. 0
SIZE D	SCALE 1/4" = 1'-0"	AREA CODE DB
SHEET NO. S774	PAGE NO. 0271	




CONTROL JOINTS SHALL OCCUR AT 40'-0" OC (MAXIMUM) OR AS SHOWN ON PLANS. JOINT SHALL BE CONTINUOUS FROM TOP OF FOOTING TO TOP OF WALL. CHORD STEEL SHALL PASS THROUGH JOINT WITHOUT INTERRUPTION. CHORD STEEL LAPS SHALL NOT OCCUR WITHIN 4'-0" OF A MASONRY CONTROL JOINT. VERIFY THE LOCATION OF ALL JOINTS WITH THE ARCHITECTURAL DRAWINGS PRIOR TO THE COMMENCEMENT OF WORK.

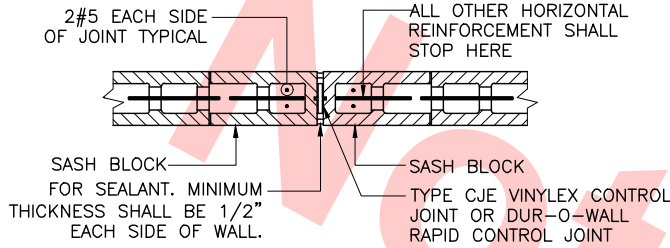



ALSO REFERENCE SPECIFICATIONS FOR ACCEPTABLE MANUFACTURERS AND ALTERNATES. SEE OTHER DETAILS FOR HORIZONTAL REINFORCING REQUIREMENTS, SPACING(S), ETC

MASONRY CONTROL JOINTS 1  
SCALE: NTS DB-S775

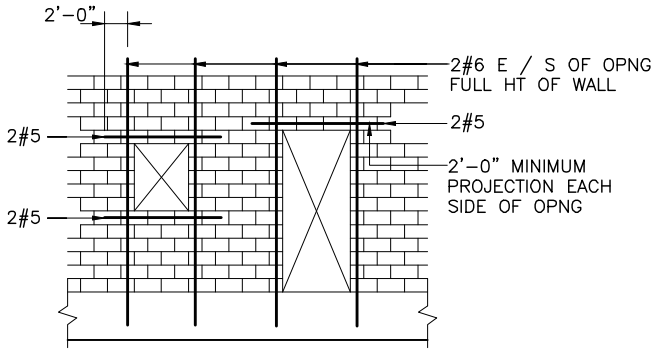


VERTICAL STEEL SHALL BE FULL HEIGHT EACH SIDE OF OPNG. PROVIDE FOOTING DOWELS TO MATCH VERTICAL STEEL. HORIZONTAL STEEL SHALL BE IN BOND BEAMS OR LINTEL UNITS OR BOTH AND SHALL PROJECT 2'-0" MINIMUM BEYOND THE EDGES OF THE OPENINGS UNO

MIN. REINF. AROUND OPEN'G 2  
SCALE: NTS DB-S775

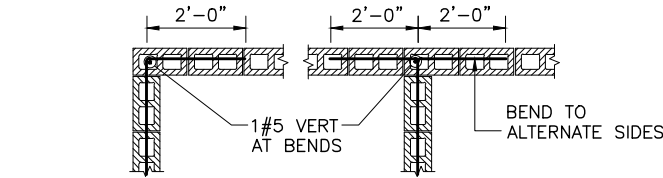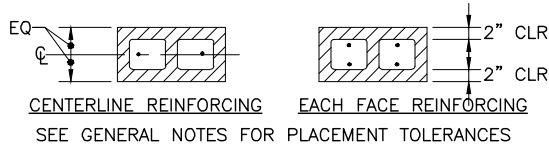

ALL MASONRY WALLS SHALL BE GROUTED SOLID UNLESS SPECIFICALLY NOTED OTHERWISE ON THE FOUNDATION PLAN. AT LEAST ONE #5 SHALL BE PLACED AT ALL CORNERS AND INTERSECTIONS IN ADDITION TO THE REGULAR WALL STEEL. SEE CONCRETE WALL INTERSECTION DETAIL FOR DOUBLE CURTAIN REINFORCING CONDITION, DO SIMILAR.


MASONRY WALL REINF. 3  
SCALE: NTS DB-S775

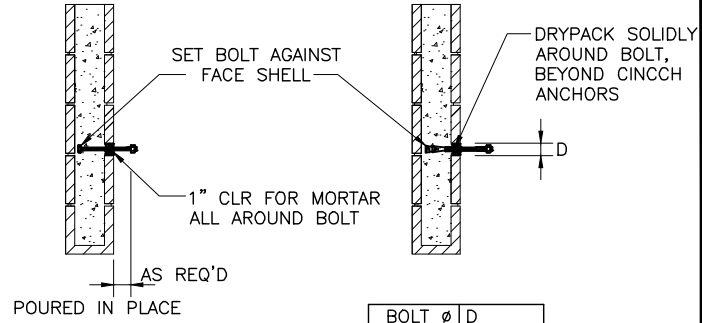

BOLT	Ø	D
1/2"	1"	
3/8"	1-1/8"	
3/4"	1-3/8"	
7/8"	1-1/2"	


IN EXPANSION ANCHORS

BOLTS IN CONCRETE BLOCK 4  
SCALE: NTS DB-S775

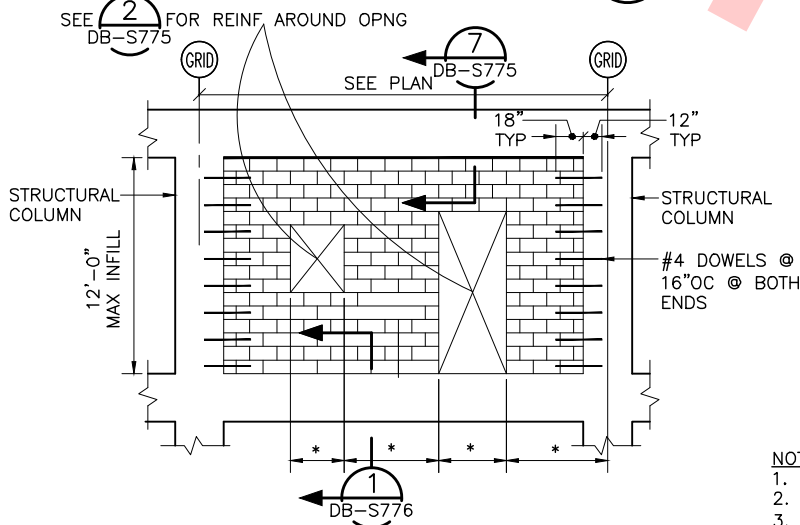


\*-SEE ARCHITECTURAL PLANS FOR OPENING SIZES AND LOCATIONS

TYP. INFILL MASONRY WALLS 5  
SCALE: NTS DB-S775

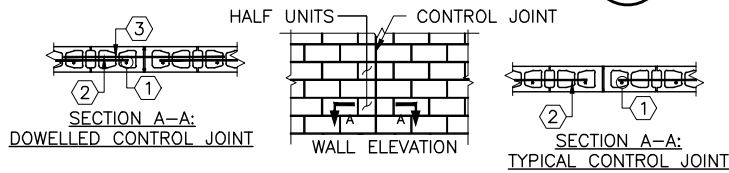


CMU WALL REINF. SCHEDULE 6  
SCALE: NTS DB-S775

CONTROL JOINTS SHALL OCCUR AT 40'-0" OC (MAXIMUM) OR AS SHOWN ON PLANS. JOINT SHALL BE CONTINUOUS FROM TOP OF FOOTING TO TOP OF WALL. CHORD STEEL SHALL PASS THROUGH JOINT WITHOUT INTERRUPTION. CHORD STEEL LAPS SHALL NOT OCCUR WITHIN 4'-0" OF A MASONRY CONTROL JOINT. VERIFY THE LOCATION OF ALL JOINTS WITH THE ARCHITECTURAL DRAWINGS PRIOR TO THE COMMENCEMENT OF WORK.

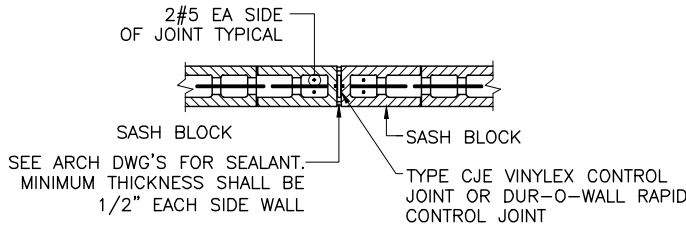

TYP. C.J. IN CONCRETE MASONRY WALLS 9  
SCALE: NTS DB-S775

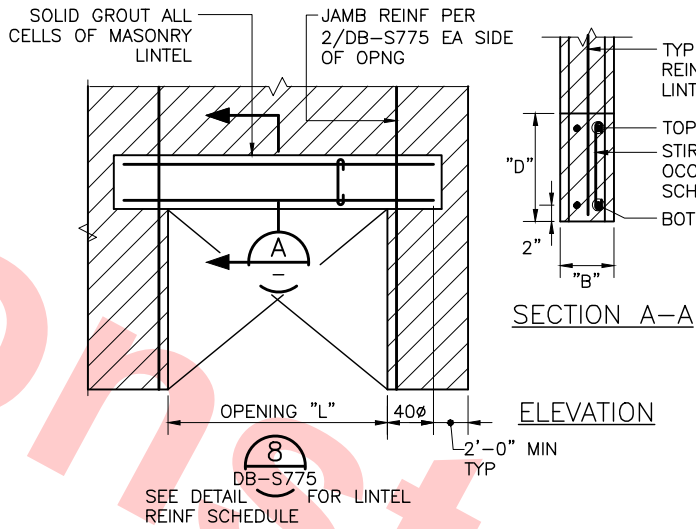


LINTEL DETAIL 7  
SCALE: NTS DB-S775

FOR REFERENCE ONLY AND NOT FOR REVIEW. THIS DRAWING WAS ALREADY SUBMITTED UNDER DU23-WP08 RFC TRENCH PACKAGE.


MARK	MASONRY ROUGH OPENING	NORMAL LINTEL SIZE	REINFORCING			COMMENTS
	MAX "L"	"B" x "D"	BOT BARS	STIRRUPS	STOP BARS	
L1						
L2						
L3						

NOTES:  
1. SEE DETAIL 7 FOR DEFINITION OF "L", "B", "D" & STANDARD LINTEL DETAIL GROUT ALL LINTELS SOLID.  
2. STIRRUPS MAY BE SINGLE LEG W/180 HOOK EA END

MASONRY LINTEL SCHEDULE 8  
SCALE: N.T.S. DB-S775

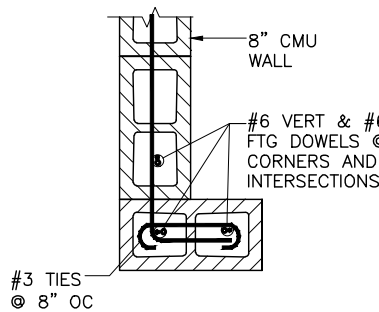

PLAN DETAIL 10  
SCALE: NTS DB-S775

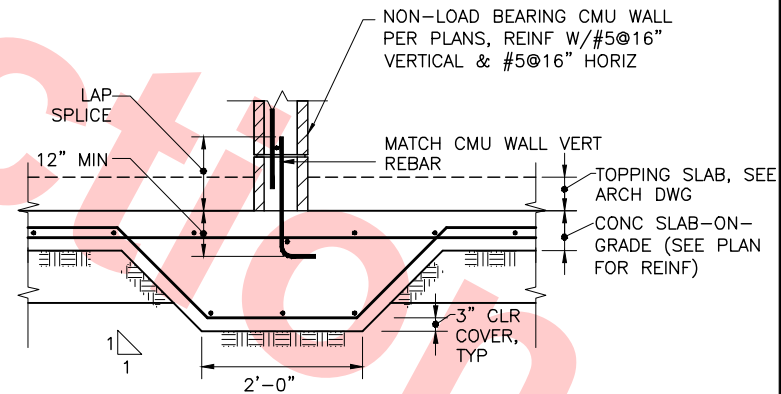

CMU WALL FOOTING 11  
SCALE: NTS DB-S775

04-02 Jul 05, 2013 1:57pm P:\BART Berryessa Extension Line\AS - STRUCTURAL\MILPITAS WORK\6-10-2012\0700-S-DB-S775.dwg

DESIGNED BY J. REBER, S.E.	
DRAWN BY P. DIAZ	
CHECKED BY M. TARAZI	
IN CHARGE M. TARAZI	
DATE 20130531	

0	20130531				READINESS FOR CONSTRUCTION
REV	DATE	BY	SUB	APP	DESCRIPTION



Skanska Shimmick Herzog	1436 California Circle Milpitas, California 95035 A Joint Venture
MFT CONSULTING ENGINEERS, Inc. Anil Verma Associates, Inc. 1773 San Pablo Ave., Suite A3 (510) 222-4166 Pinole, CA 94664 Fax (510) 222-6419	Leewood, Andrews & Newman, Inc. A LEO A DALY COMPANY T-Y-LIN INTERNATIONAL
SUBMITTED	APPROVED




LINE, TRACK, STATIONS AND SYSTEMS DESIGN UNIT 023 MILPITAS STATION TYPICAL MASONRY SECTIONS AND DETAILS SHEET 1 OF 2			
CADD FILENAME C700-S-DB-S775.dwg	SIZE D	SCALE NONE	REV. 0
CONTRACT NO. C700	SHEET NO. S775	AREA CODE DB	PAGE NO. 0272







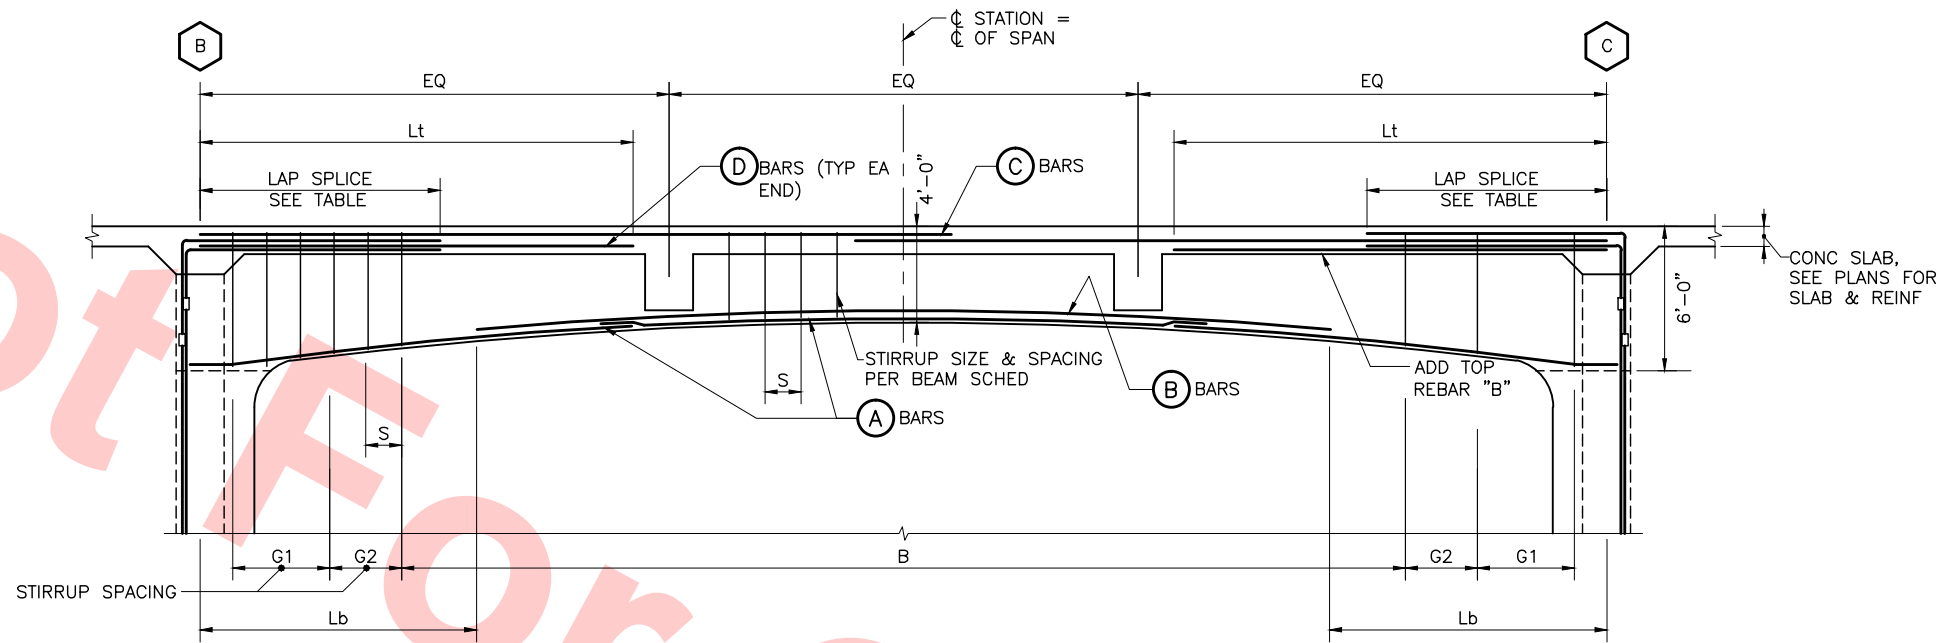



SECTION @ ARCH GIRDERS GRIDS 2 & 3  
 CONCRETE GIRDER REINFORCEMENT DIAGRAM  
 SCALE: 1/4"=1'-0"

(A) DB-S777 DB-S766

FOR REFERENCE ONLY AND NOT FOR REVIEW. THIS  
 DRAWING WAS ALREADY SUBMITTED UNDER DU23-  
 WP08 RFC TRENCH PACKAGE.

04-02 Jul 05, 2013 1:57pm P:\BART Berryessa Extension Line\AS - STRUCTURAL MILPITAS WORK\_6-10-2012\C700-S-DB-S777.dwg

					DESIGNED BY J. REBER, S.E.		<div>Skanska Shimmick Herzog</div> <div>1436 California Circle Milpitas, California 95035 A Joint Venture</div>		 <div>BART SILICON VALLEY</div>	LINE, TRACK, STATIONS AND SYSTEMS DESIGN UNIT 024 MILPITAS STATION CONCRETE BEAM/GIRDER DETAILS SHEET 1 OF 1			CADD FILENAME C700-S-DB-S777.dwg	
					DRAWN BY P. DIAZ								SIZE SCALE D 1/4" = 1'-0"	
					CHECKED BY M. TARAZI								CONTRACT NO. C700	REV. 0
					IN CHARGE M. TARAZI								AREA CODE DB	SHEET NO. S777
0	20130710				DATE 20130710	SUBMITTED _____		APPROVED _____						
REV	DATE	BY	SUB	APP	DESCRIPTION	MFT CONSULTING ENGINEERS, Inc. Anil Verma Associates, Inc. 1773 San Pablo Ave., Suite A3 (510) 222-4166 Pinole, CA 94564 Fax (510) 222-6418		Lealwood, Andrews & Newman, Inc. T-Y-LIN INTERNATIONAL A LEO A DALY COMPANY						




004-02 Jul 05, 2013 - 1:56pm P:\BART Berryessa Extension Line\AS - STRUCTURAL\MILPITAS WORK\6-10-2012\0700-S-DB-S781.dwg


A DECK WELDING SCHEDULE						
DECK TYPE	DEPTH & GAUGE	PERPENDICULAR SUPPORTS	PARALLEL SUPPORTS	SIDE LAPS	DIAPHRAGM SHEAR CAPACITY	
VERSA-DECK 3.5 LS ACOUSTICAL ROOF DECK	3 1/2"x 18GA	6 PW PER SHEET	PW @ 12" CC	SSW @ 12" CC	988 #/ft AT 10'-0" SPAN	
PLB-36 ROOF DECK	1 1/2" x 18" GA	7 PW PER SHEET	PW @ 12" CC	VSC @ 12" CC	977 #/ft AT 10'-0" SPAN	
W3 FORMLOK FLOOR DECK	3"x18" GA	4 PW PER SHEET	PW @ 8" CC	TSW @ 12" OC	2080#/ft AT 10'-0" SPAN	
1. PW = 3/4" DIAMETER (1/2" EFFECTIVE DIA) PUDDLE WELD; TSW = 1 1/2" MIN TOP SEAM WELD; BP = BUTTON PUNCH; VSV= VERCO SIDE LAP CONNECTION (PUNCHLOK) OR EQUIVALENT; X-ENP = HILTI X-ENP-19-L15: #10=#10 SCREWS; FW=1 1/2" LONG FILLET WELDS						
2. METAL DECK (D1) SHALL BE CONSOLIDATED SYSTEMS, INC OR APPROVED EQUAL, OF TYPE AND GAUGE SHOWN ON PLANS AND WELDED AS SHOWN ABOVE.						
3. METAL DECK (D2) & (D3) SHALL BE VERCO OR APPROVED EQUAL, OF TYPE AND GAUGE SHOWN ON PLANS AND WELDED AS SHOWN ABOVE.						
4. SEE (B) DB-S781 FOR TYPICAL WELD PATTERNS.						
5. FOR METAL DECK WELDING AT STRUCTURAL STEEL SUPPORT SEE (1) DB-S781 AND (7) FOR DECK (D1) AND (D2), (1) FOR (D3) DB-S784						
6. ALL METAL DECK SHALL HAVE TWO SPANS MINIMUM.						
7. PROVIDE SHORING AS REQUIRED AT ALL DECKS PER MFR RECOMMENDATIONS.						

B METAL DECK WELD PATTERNS		
DECK TYPE	DECK PROFILE AND WELD	NO 3/4" Ø PW PER SHEET
VERSA-DECK 3.5LS ACOUSTICAL		6
PLB-36		7
W3 FORMLOK		4


C MINIMUM STRUCTURAL PROPERTIES OF METAL DECK			
DECK TYPE (DEPTH & GAUGE)	I ( in <sup>4</sup> ) (PER FOOT)	+S ( in <sup>3</sup> ) (PER FOOT)	- S ( in <sup>3</sup> ) (PER FOOT)
VERSA-DECK 3.5LS ACOUSTICAL	2.48	1.08	1.181
PLB-36	0.302	0.322	0.335
W3 FORMLOK	1.203	0.767	0.767
NOTE: 1. SEE "METAL DECK NOTES" ON DB-S001X FOR TYPICAL MATERIAL PROPERTIES (Fy) & FINISHES.			

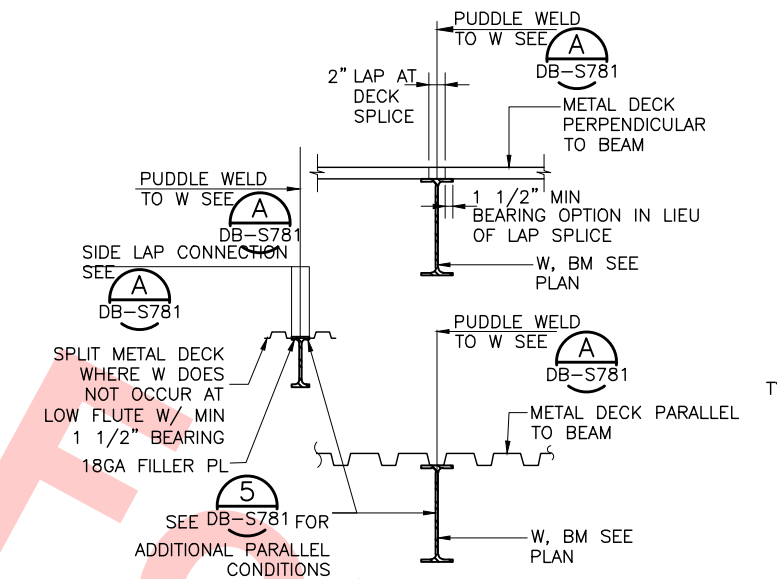


METAL DECK WITHOUT CONC TO WF BM. (1) DB-S781  
SCALE: NTS

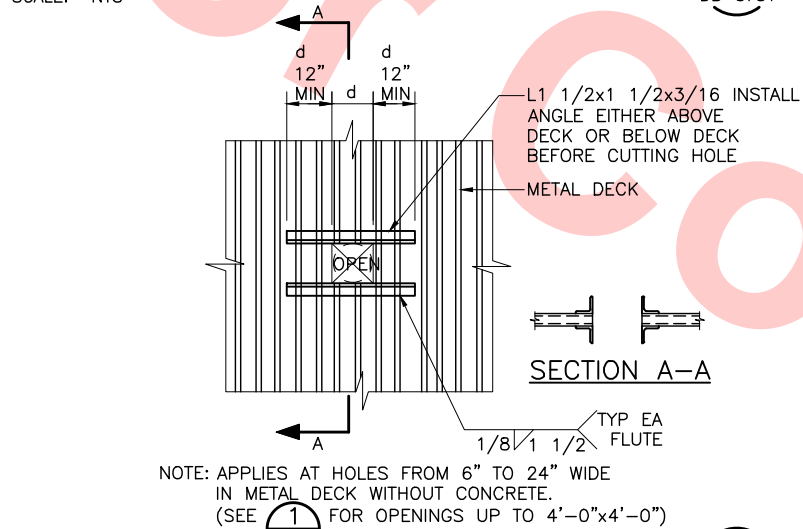


DETAIL (4) DB-S781  
SCALE: NTS

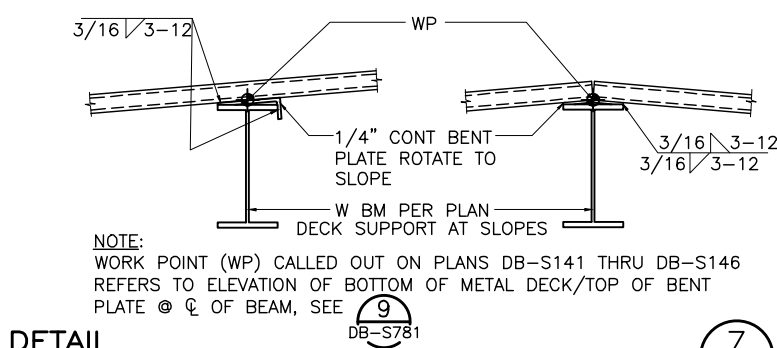


DETAIL (7) DB-S781  
SCALE: NTS

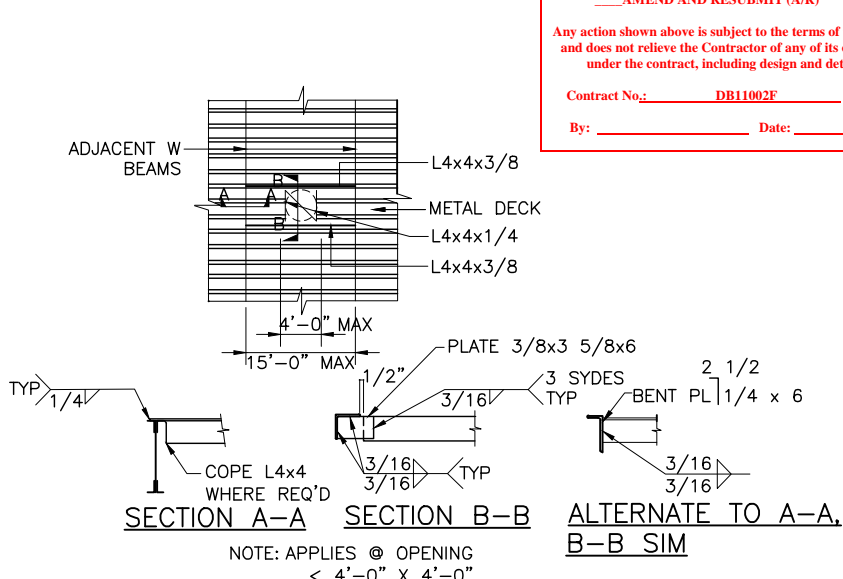


METAL DECK SUPPORT TO WF COL'S. (2) DB-S781  
SCALE: NTS

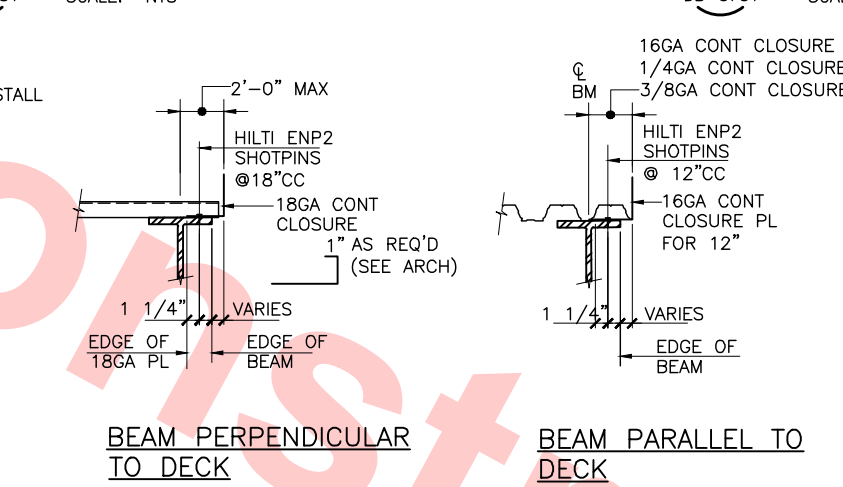


METAL DECK WITHOUT CONC. EDGE (5) DB-S781  
SCALE: NTS

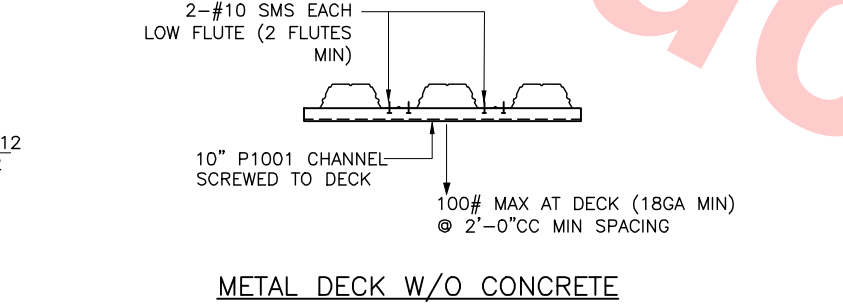


DETAIL (8) DB-S781  
SCALE: NTS

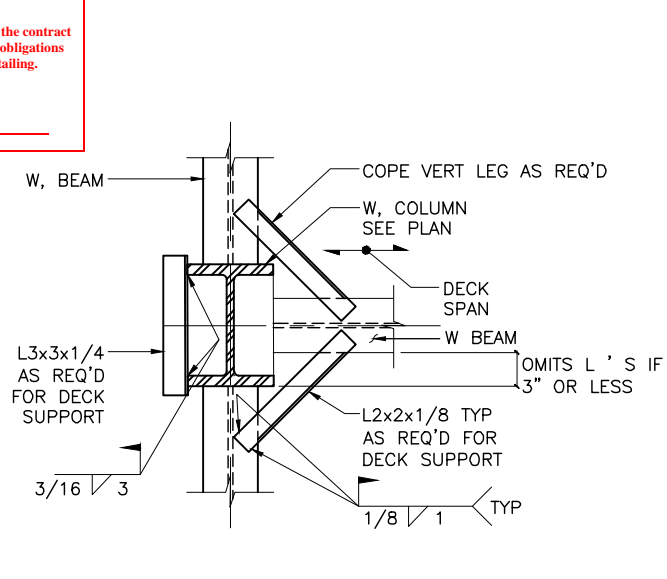

METAL DECK SUPPORT TO WF COL'S. (3) DB-S781  
SCALE: NTS

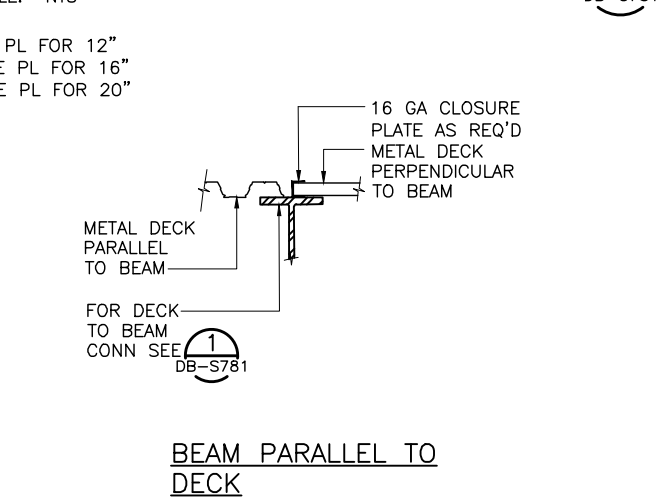


DETAIL (6) DB-S781  
SCALE: NTS

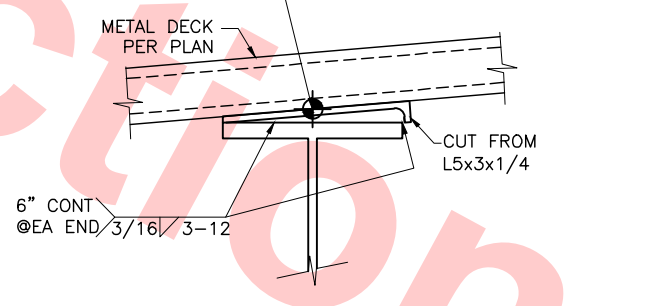

DETAIL (9) DB-S781  
SCALE: NTS

Santa Clara Valley Transportation Authority  
NO EXCEPTIONS TAKEN (NET)  
MAKE CORRECTIONS NOTED (MCN)  
AMEND AND RESUBMIT (A/R)  
Any action shown above is subject to the terms of the contract and does not relieve the Contractor of any of its obligations under the contract, including design and detailing.  
Contract No.: DB11002F  
By: \_\_\_\_\_ Date: \_\_\_\_\_

02	Jul 05, 2013								DESIGNED BY J. REBER, S.E.
									DRAWN BY P. DIAZ
									CHECKED BY M. TARAZI
									IN CHARGE M. TARAZI
									DATE 20130710
	0	20130710						READINESS FOR CONSTRUCTION	
	REV	DATE	BY	SUB	APP	DESCRIPTION			

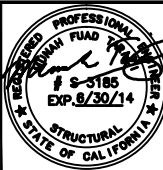



Skanska  
Shimmick  
Herzog  
1436 California Circle  
Milpitas, California 95035  
A Joint Venture  
MFT CONSULTING ENGINEERS, INC. Anil Verma Associates, Inc.  
1773 San Pablo Ave., Suite A3 (510) 222-4100  
Pinole, CA 94664 Fax (916) 223-8410

Lealwood, Andrews & Newman, Inc.  
A LEO A DALY COMPANY  
T-Y-LIN INTERNATIONAL  
APPROVED



LINE, TRACK, STATIONS AND SYSTEMS DESIGN UNIT 023 MILPITAS STATION TYPICAL METAL DECK SECTIONS AND DETAILS SHEET 1 OF 4				CADD FILENAME C700-S-DB-S781.dwg
SIZE D	SCALE NONE	CONTRACT NO. C700	REV. 0	
AREA CODE DB	SHEET NO. S781	PAGE NO. 0275		





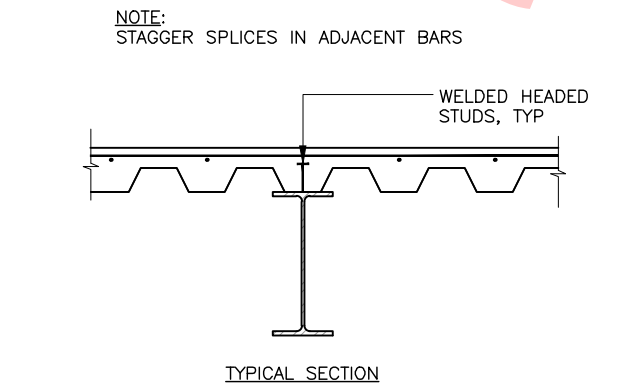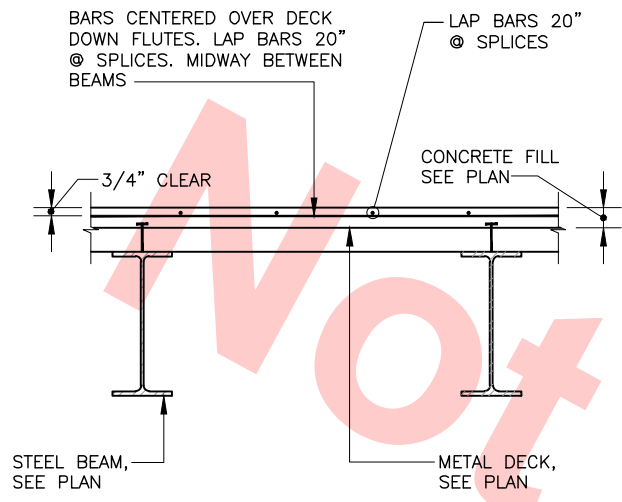

**TYP. REINFORCEMENT FOR CONC. FILL OVER METAL DECK**

SCALE: 1"=1'-0"


1 DB-S782

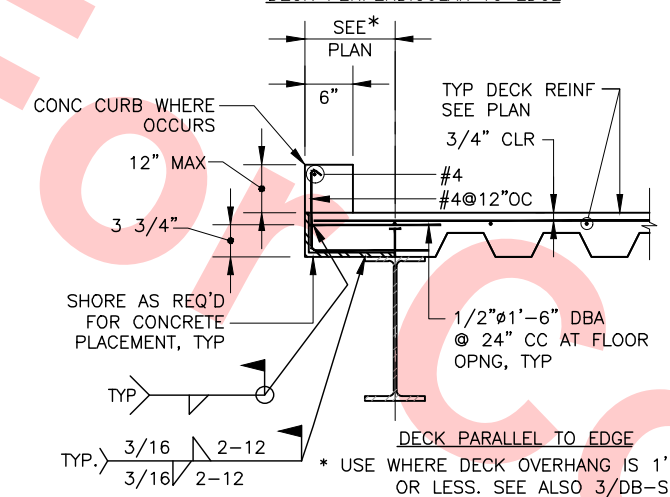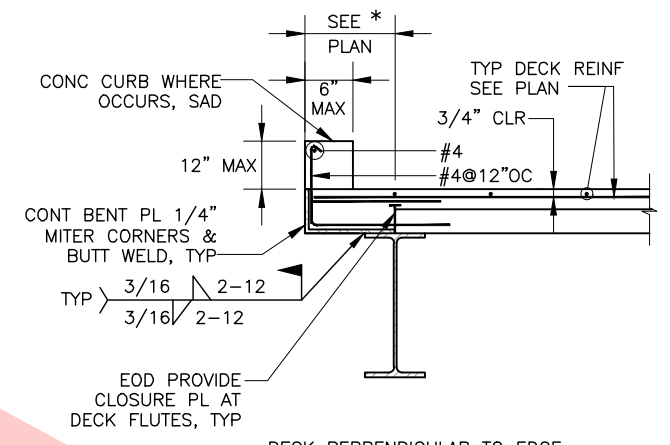

**TYP. EDGE OF DECK DETAILS**

SCALE: 1"=1'-0"


2 DB-S782

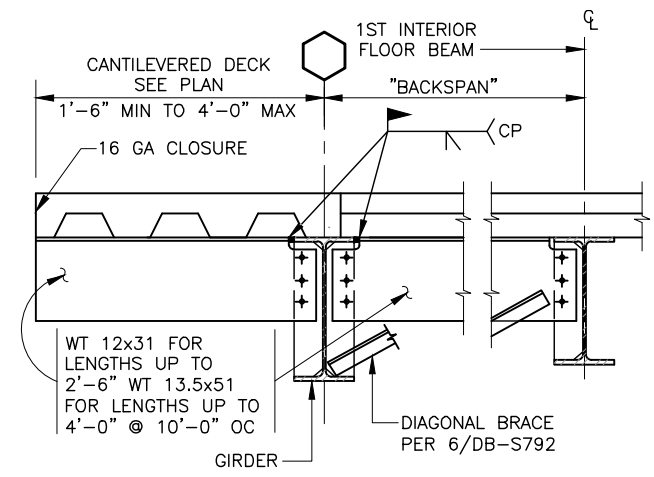

**TYP. EDGE OF DECK**

SCALE: 1"=1'-0"


3 DB-S782

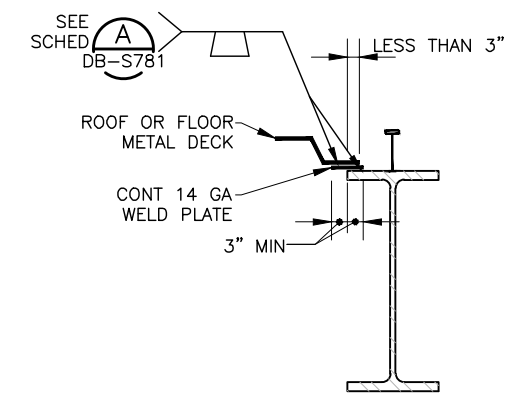

**TYP. WELDS PARALLEL TO DECK WHERE SIDE BEARING IS LESS THAN 3"**

SCALE: 1"=1'-0"


4 DB-S782

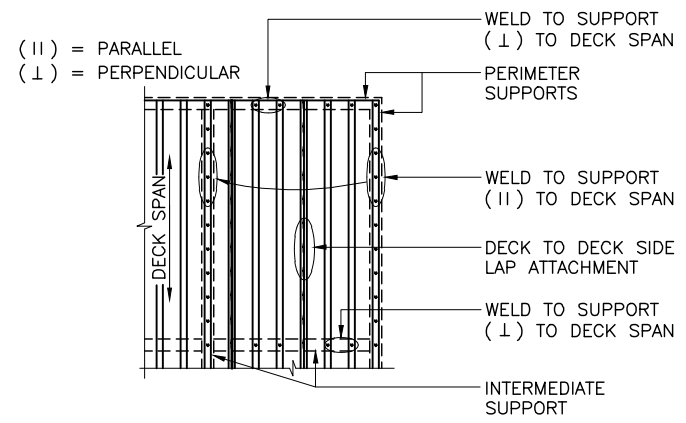

**TYP. WELDS PARALLEL TO DECK WHERE SIDE BEARING IS LESS THAN 2"**

SCALE: 1"=1'-0"

6 DB-S782

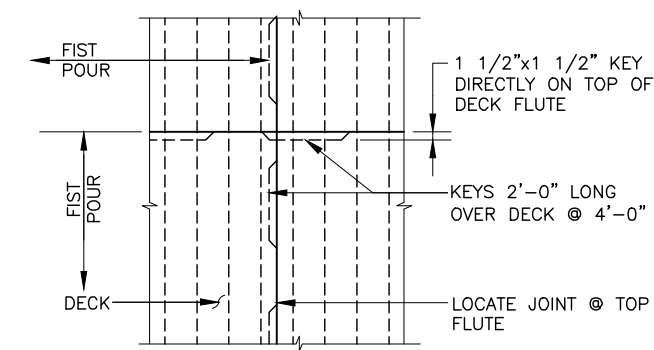

**CONSTRUCTION JOINT IN CONCRETE FILL OVER DECK**

SCALE: 1"=1'-0"

7 DB-S782

**Santa Clara Valley Transportation Authority**

NO EXCEPTIONS TAKEN (NET)

MAKE CORRECTIONS NOTED (MCN)

AMEND AND RESUBMIT (A/R)


Any action shown above is subject to the terms of the contract and does not relieve the Contractor of any of its obligations under the contract, including design and detailing.

Contract No.: DB11002F

By: \_\_\_\_\_ Date: \_\_\_\_\_

Jul 05, 2013 1:56pm P:\BART Berryessa Extension Line\AS - STRUCTURAL\MILPITAS WORK\6-10-2012\0700-S-DB-S782.dwg

DESIGNED BY	J. REBER, S.E.
DRAWN BY	P. DIAZ
CHECKED BY	M. TARAZI
IN CHARGE	M. TARAZI
DATE	20130710
REV	0
DATE	20130710
BY	
SUB	
APP	
DESCRIPTION	READINESS FOR CONSTRUCTION

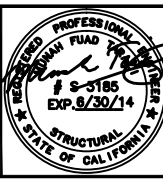

**Skanska Shimmick Herzog**

1436 California Circle  
Milpitas, California 95035  
A Joint Venture

**MFT CONSULTING ENGINEERS, INC.** Anil Verma Associates, Inc.  
1773 San Pablo Ave., Suite A3 (510) 222-4100  
Palo Alto, CA 94304 Fax (650) 222-4110

**Lealwood, Andrews & Newman, Inc.** A LEAD & BALLY COMPANY

**T-Y-LIN INTERNATIONAL**

APPROVED \_\_\_\_\_

**BART SILICON VALLEY**

**BART SILICON VALLEY BERRYESSA EXTENSION**

**LINE, TRACK, STATIONS AND SYSTEMS**

**DESIGN UNIT 023**

MILPITAS STATION

TYPICAL METAL DECK


SECTIONS AND DETAILS

SHEET 2 OF 4


CADD FILENAME	C700-S-DB-S782.dwg
SIZE	D
SCALE	AS NOTED
CONTRACT NO.	C700
REV.	0
AREA CODE	DB
SHEET NO.	S782
PAGE NO.	0276




Jul 05, 2013 1:56pm P:\BART Berryessa Extension Line\1 - STRUCTURAL MILPITAS WORK\6-10-2012\0700-S-DB-S783.dwg

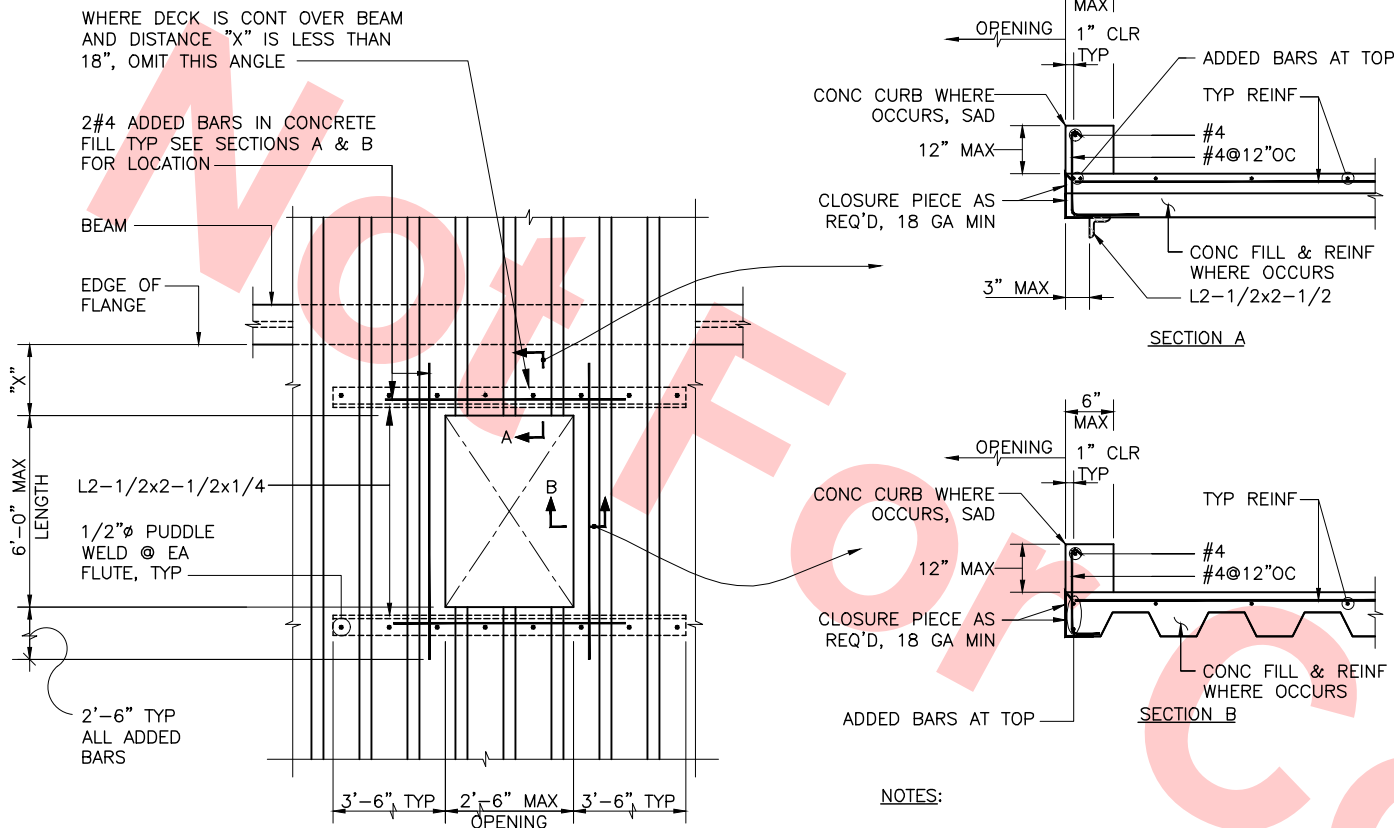


**SMALL OPENING IN METAL DECK** 1  
SCALE: 1"=1'-0" DB-S783

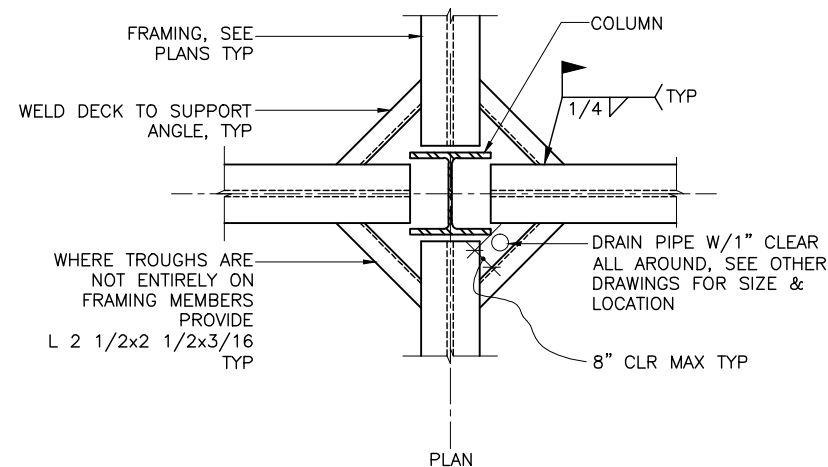

**DECK SUPPORT AT COLUMN** 3  
SCALE: 1"=1'-0" DB-S783

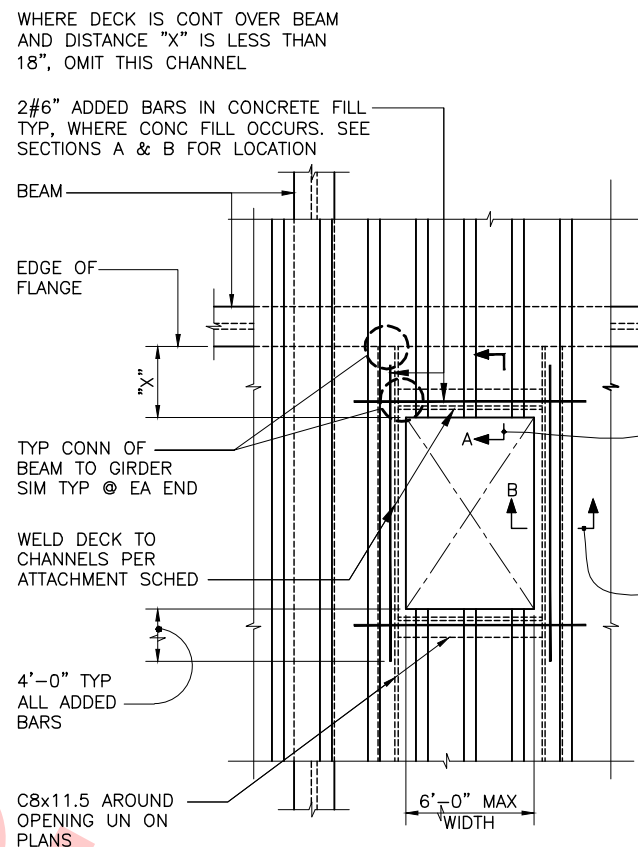

**LARGE OPENING IN METAL DECK** 2  
SCALE: 1"=1'-0" DB-S783

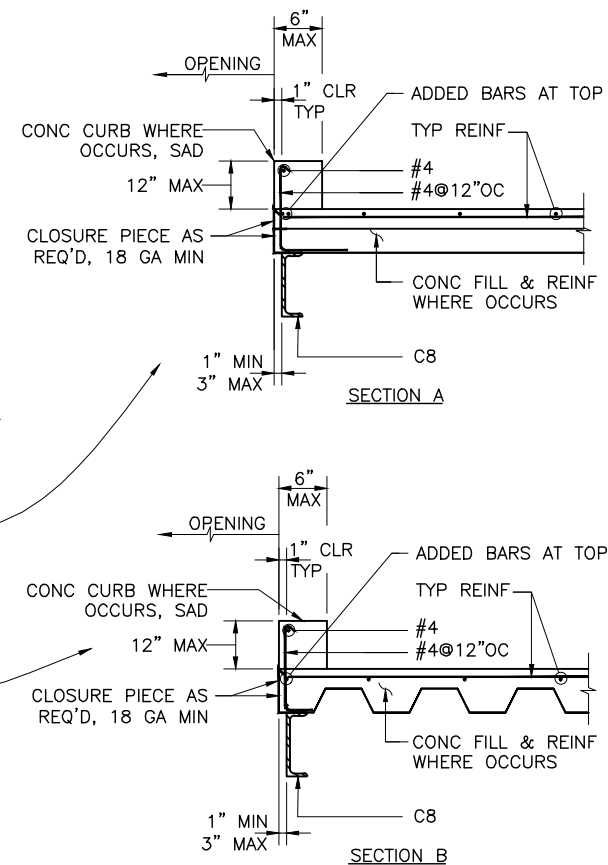

- NOTES:
1. FOR ADDITIONAL INFORMATION SEE GENERAL NOTES AND SPECIFICATIONS.
  2. SEE PLANS FOR THICKNESS OF CONCRETE FILL OVER DECK
  3. UNLESS NOTED ON PLANS OR IN DECK SPECIFICATIONS, THE DETAILS AND NOTES ON THIS SHEET SHALL BE INCORPORATED INTO THE PROJECT AT ALL LOCATIONS WHERE METAL DECK IS USED, WHETHER SPECIFICALLY CALLED OUT OR NOT.
  4. WHEREVER POSSIBLE, DECK LAYOUT SHALL, PROVIDE SHEETS OF SUFFICIENT LENGTH TO CONTINUOUSLY SPAN AT LEAST THREE SPANS.
  5. SHORING MAY BE REQUIRED FOR METAL DECK. CONTRACTOR MAY USE A HEAVIER GAGE AS REQUIRED BY APPROVED MANUFACTURER TO AVOID SHORING.
  6. DECK SHALL HAVE A MINIMUM OF 2" BEARING AT ALL SUPPORTING MEMBERS PERPENDICULAR AND PARALLEL TO DECK SPAN.
  7. WHERE TWO ADJACENT DECK SHEETS ARE SUPPORTED BY ONE FRAMING MEMBER, EACH SHEET SHALL INDIVIDUALLY SATISFY THE REQUIREMENTS OF NOTE 6 AND OF THE ATTACHMENT REQUIREMENTS PER THESE NOTES.
  8. SEE DETAIL 8/DB-S781 SUSPENDING CEILING, PIPING, LIGHT, FIXTURES, CONDUITS OR OTHER UTILITIES FROM DECK, AND DO NOT PLACE CONDUITS OR OTHER PIPES IN CONCRETE FILL OVER DECK.
  9. ALL HEADED STUDS ARE 3/4" DIA WITH A HEIGHT OF TOTAL SLAB THICKNESS MINUS ONE INCH COVER, UNO.
  10. DO NOT PROVIDE SHEAR STUDS @ GUSSET PLATES OF BRACED FRAMES.

Santa Clara Valley Transportation Authority

\_\_\_NO EXCEPTIONS TAKEN (NET)  
\_\_\_MAKE CORRECTIONS NOTED (MCN)  
\_\_\_AMEND AND RESUBMIT (A/R)


Any action shown above is subject to the terms of the contract and does not relieve the Contractor of any of its obligations under the contract, including design and detailing.

Contract No.: DB11002F

By: Date:

DESIGNED BY	J. REBER, S.E.
DRAWN BY	P. DIAZ
CHECKED BY	M. TARAZI
IN CHARGE	M. TARAZI
DATE	20130710

REV	DATE	BY	SUB	APP	DESCRIPTION
0	20130710				READINESS FOR CONSTRUCTION

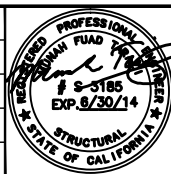

Skanska  
Shimmick  
Herzog

1436 California Circle  
Milpitas, California 95035  
A Joint Venture

MFT CONSULTING ENGINEERS, INC. Anil Verma Associates, Inc.  
1773 San Pablo Ave., Suite A3 (510) 222-4100  
Palo Alto, CA 94304 Fax (415) 222-8410

Lealwood, Andrews & Newman, Inc.  
T-Y-LIN INTERNATIONAL


APPROVED




LINE, TRACK, STATIONS AND SYSTEMS  
DESIGN UNIT 023  
MILPITAS STATION  
TYPICAL METAL DECK  
SECTIONS AND DETAILS  
SHEET 3 OF 4

CADD FILENAME		
C700-S-DB-S783.dwg		
SIZE	SCALE	
D	AS NOTED	
CONTRACT NO.		REV.
C700		0
AREA CODE	SHEET NO.	PAGE NO.
DB	S783	027



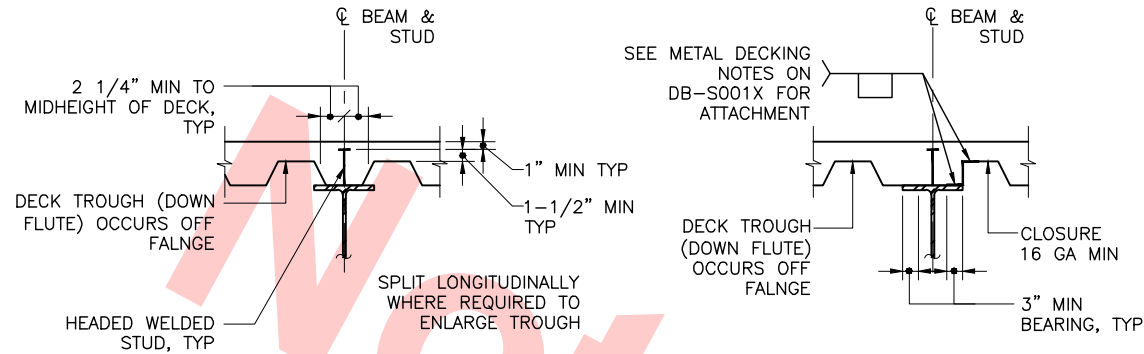

TYPICAL SECTIONS

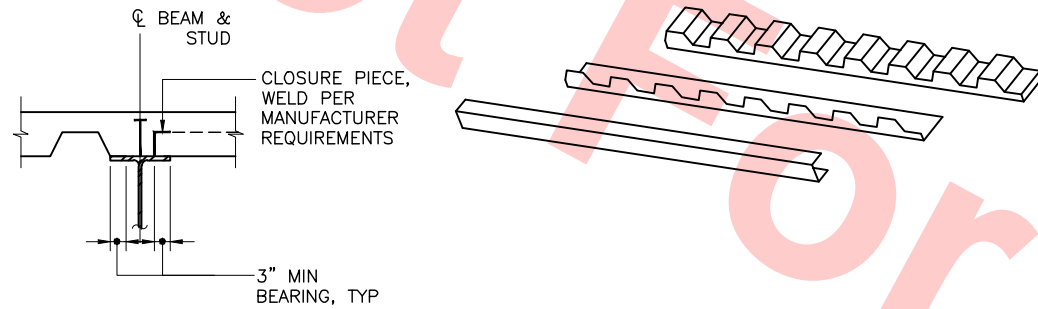


SECTION AT CHANGE OF DECK DIRECTION

## DECK AND SHEAR STUD PLACEMENT

SCALE: 1"=1'-0"

1  
DB-S784

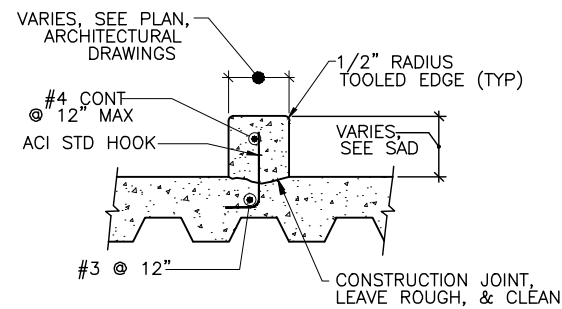


### NOTES:

1. AT CONTRACTOR'S OPTION, #3 DOWELS MAY BE EPOXY GROUTED INTO SLAB, DEPTH=2/3 OF TOPPING SLAB THICKNESS AT DECK FLUTE.

## CONCRETE CURB

SCALE: NTS

4  
DB-S784

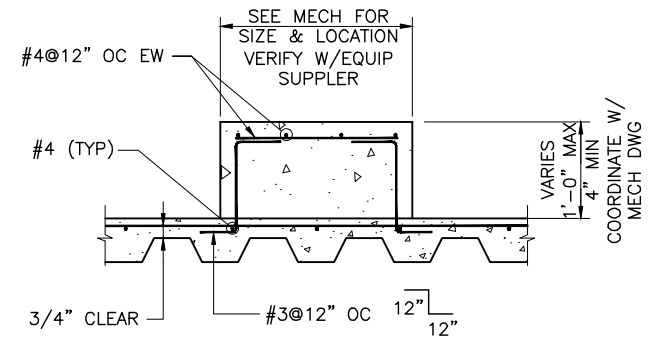

### NOTE:

PLACE PAD AFTER SLAB HAS REACHED STRENGTH DESIGN

## HOUSE KEEPING CONCRETE PAD

SCALE: NTS

3  
DB-784

Santa Clara Valley Transportation Authority

NO EXCEPTIONS TAKEN (NET)  
MAKE CORRECTIONS NOTED (MCN)  
AMEND AND RESUBMIT (A/R)


Any action shown above is subject to the terms of the contract and does not relieve the Contractor of any of its obligations under the contract, including design and detailing.

Contract No.: DB11002F

By: Date:

REV	DATE	BY	SUB	APP	DESCRIPTION
0	20130710				READINESS FOR CONSTRUCTION

DESIGNED BY  
J. REBER, S.E.  
DRAWN BY  
P. DIAZ  
CHECKED BY  
M. TARAZI  
IN CHARGE  
M. TARAZI  
DATE  
20130710

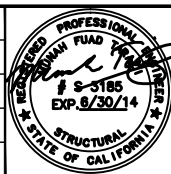

Skanska  
Shimmick  
Herzog  
1436 California Circle  
Milpitas, California 95035  
A Joint Venture  
MFT CONSULTING ENGINEERS, INC. Anil Verma Associates, Inc.  
1773 San Pablo Ave., Suite A3 (510) 222-4100  
Palo Alto, CA 94304 Fax (650) 222-8410


Lealwood, Andrews  
& Newman, Inc.  
T-Y-LIN INTERNATIONAL  
APPROVED

**BART**  
SILICON VALLEY  
BART SILICON VALLEY BERRYESSA EXTENSION

LINE, TRACK, STATIONS AND SYSTEMS  
DESIGN UNIT 023  
MILPITAS STATION  
TYPICAL METAL DECK  
SECTIONS AND DETAILS  
SHEET 4 OF 4


CADD FILENAME C700-S-DB-S784.dwg	SIZE D	SCALE AS NOTED
CONTRACT NO. C700	SHEET NO. S784	REV. 0
AREA CODE DB	PAGE NO. 0278	



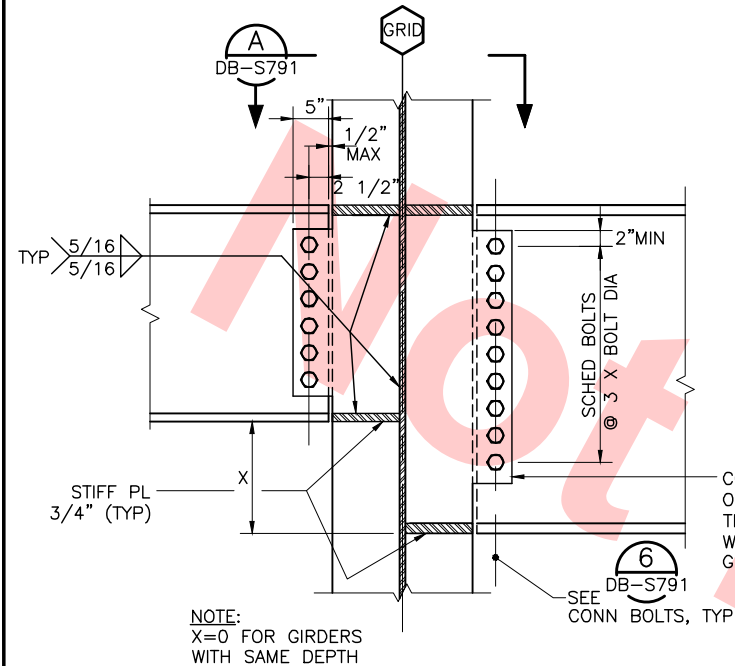


TYPICAL CONNECTION GIRDER TO COLUMN WEB (NON-MOMENT)

SCALE: 1"=1'-0"

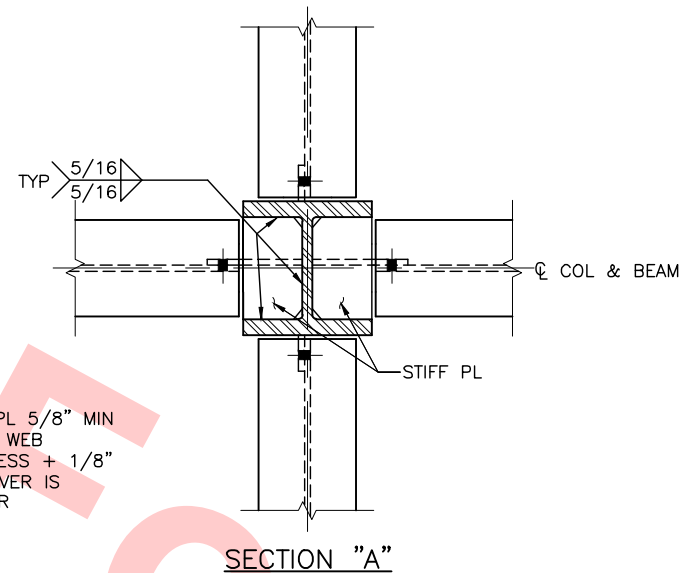


SECTION "A"

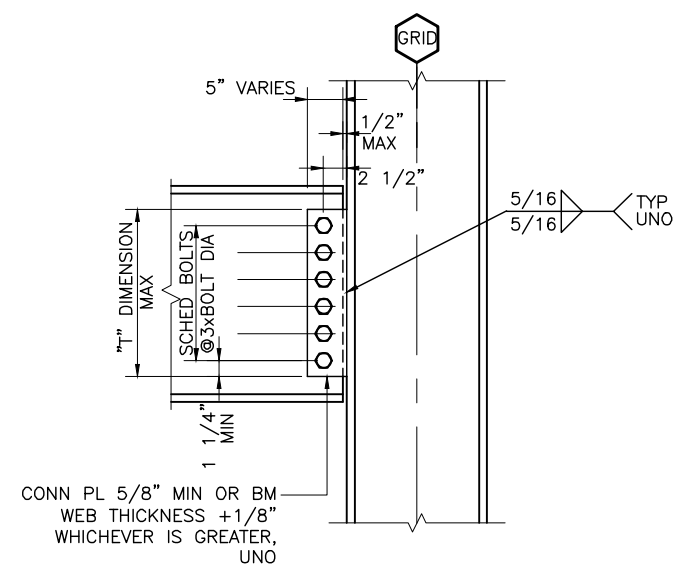


TYPICAL GIRDER TO COLUMN FLANGE (NON-MOMENT)

SCALE: 1"=1'-0"

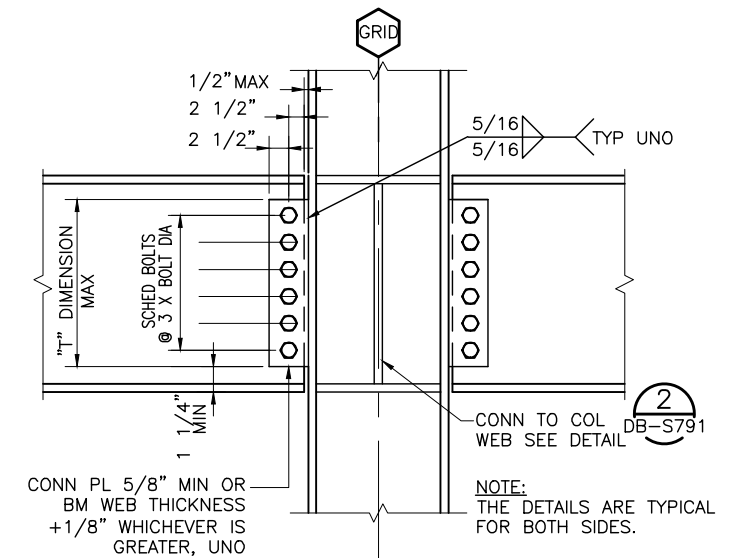


TYPICAL GIRDER TO COLUMN FLANGE CONN. (NON-MOMENT) TWO SIDES

SCALE: 1"=1'-0"

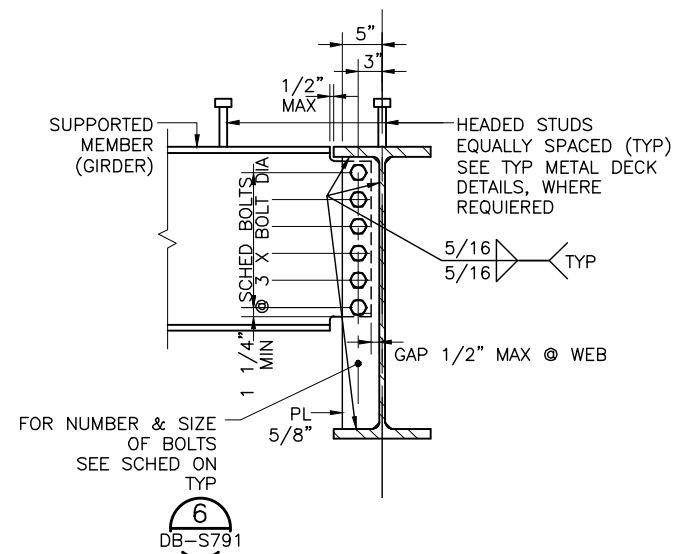

TYPICAL BEAM TO GIRDER ONE SIDE (NON-MOMENT)

SCALE: 1"=1'-0"

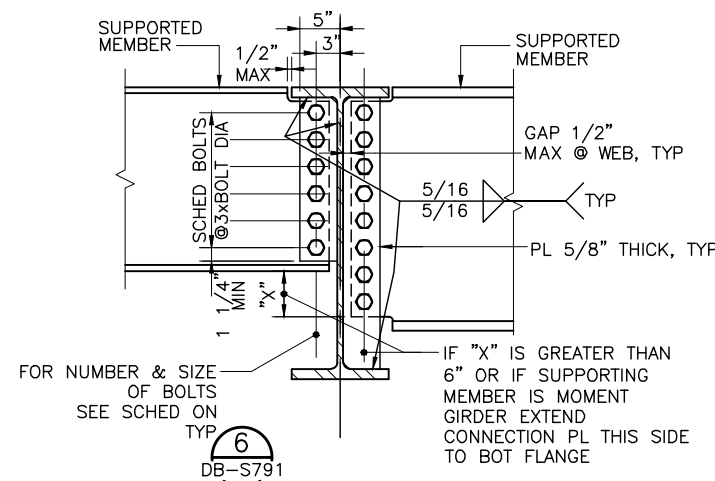

TYPICAL BEAM TO GIRDER TWO SIDES (NON-MOMENT)

SCALE: 1"=1'-0"

DEPTH OF GIRDER	NUMBER OF 7/8" BOLT DIAMETER A325N
W36 (UP TO W36x256)	11
W33	10
W30	9
W27	8
W24	7
W21	6
W18	5
W16	4
W14	3
W12	3
W10	2
W8, W6	2 - 3/4" Ø

BOLT SCHEDULE FOR NON-MOMENT CONNS.

SCALE: NTS

Santa Clara Valley Transportation Authority

NO EXCEPTIONS TAKEN (NET)  
MAKE CORRECTIONS NOTED (MCN)  
AMEND AND RESUBMIT (A/R)

Any action shown above is subject to the terms of the contract and does not relieve the Contractor of any of its obligations under the contract, including design and detailing.


Contract No.: DB11002F

By: \_\_\_\_\_ Date: \_\_\_\_\_

Jul 05, 2013 1:56pm P:\BART Berryessa Extension Line\AS - STRUCTURAL\MILPITAS WORK\6-10-2012\0700-S-DB-S791.dwg

REV	DATE	BY	SUB	APP	DESCRIPTION
0	20130710				READINESS FOR CONSTRUCTION

DESIGNED BY  
J. REBER, S.E.  
DRAWN BY  
P. DIAZ  
CHECKED BY  
M. TARAZI  
IN CHARGE  
M. TARAZI  
DATE  
20130710

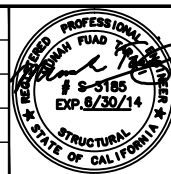

Skanska  
Shimmick  
Herzog

1436 California Circle  
Milpitas, California 95035  
A Joint Venture

MFT CONSULTING ENGINEERS, INC. Anil Verma Associates, Inc.  
1773 San Pablo Ave., Suite A3 (510) 222-4100  
Palo Alto, CA 94304 Fax (415) 222-8410


Lealwood, Andrews & Newman, Inc.  
T-Y-LIN INTERNATIONAL




LINE, TRACK, STATIONS AND SYSTEMS  
DESIGN UNIT 023  
MILPITAS STATION  
TYPICAL STEEL  
SECTIONS AND DETAILS  
SHEET 1 OF 8

CADD FILENAME C700-S-DB-S791.dwg	CONTRACT NO. C700	REV. 0
SIZE D	SCALE AS NOTED	PAGE NO. 0279
AREA CODE DB	SHEET NO. S791	




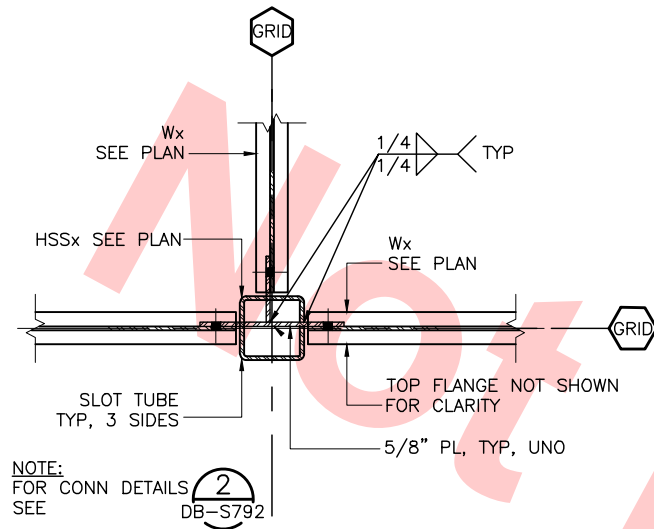


**TYPICAL TUBE CONNECTION** (1)  
SCALE: 1"=1'-0" DB-S792

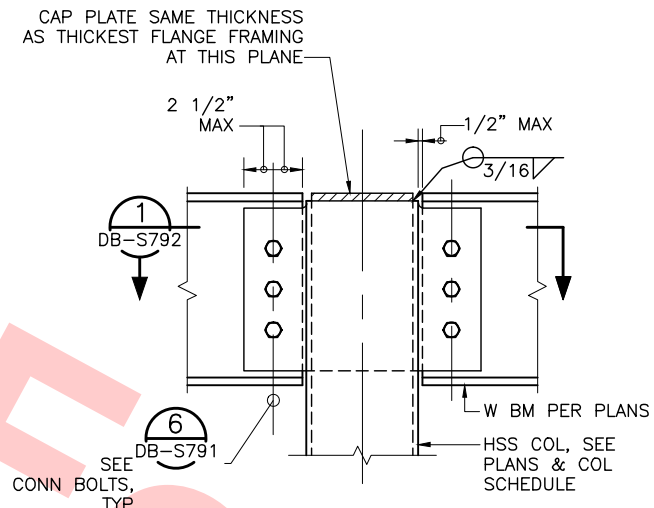

**TYPICAL WF BEAM TO HSS COLUMN** (2)  
SCALE: NTS DB-S792

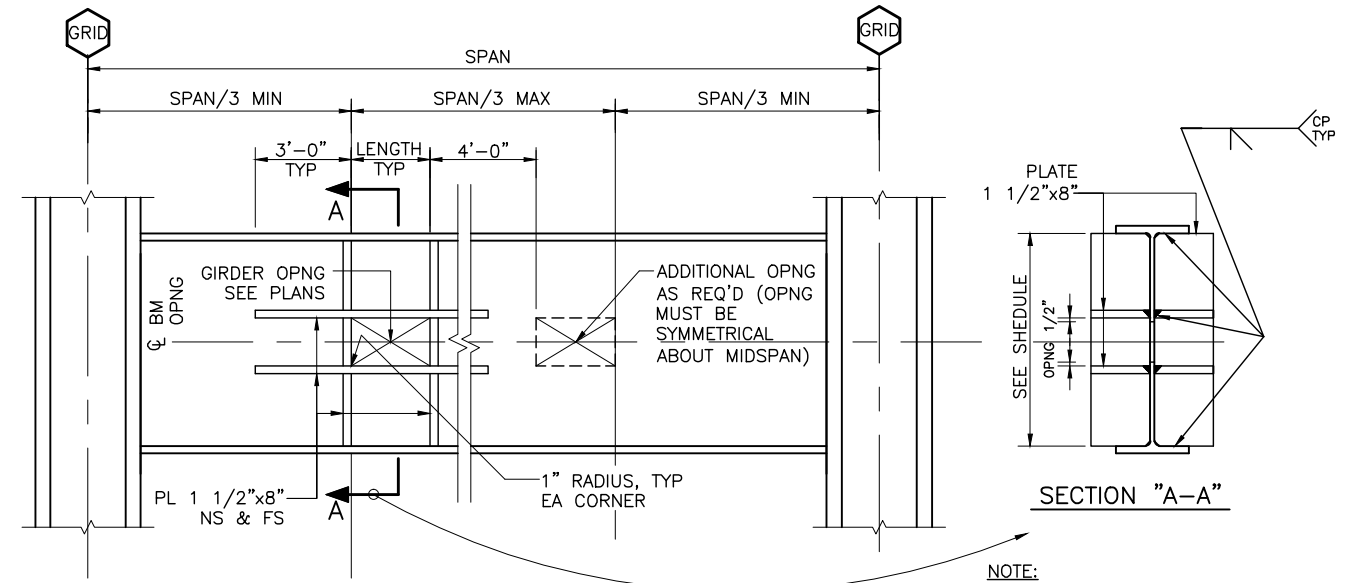

**TYPICAL OPENING IN GIRDER** (4)  
SCALE: 1"=1'-0" DB-S792

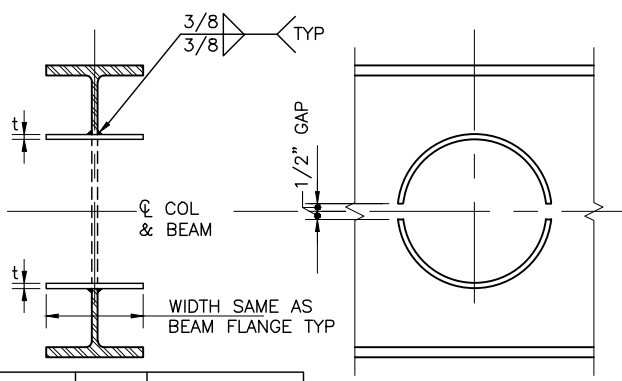

**TYPICAL SLEEVE DETAIL** (3)  
SCALE: NTS DB-S792

BEAM SIZE	OPNG DIA	CIRCULAR PLATE REINF "t" THICKNESS
W12	6"	1/2"
W14	7"	1/2"
W16	8"	1/2"
W18	9"	1/2"
W21	10"	5/8"
W24	12"	5/8"
W27	13"	5/8"
W30	15"	5/8"
W33	16"	5/8"
W36	17"	5/8"

- NOTES:**
- PIPE SLEEVES SHALL BE INSTALLED WHERE PLUMBING LINES PENETRATE THE STEEL BEAMS. PROVIDE SLEEVE OPNG PER SCHED IN MIDDLE 1/3 SPAN ONLY.
  - FOR MULTIPLE SLEEVES THE CLEAR OUTSIDE DIMENSION BETWEEN SLEEVES, SHALL BE THE LARGEST SLEEVE DIAMETER.


**Santa Clara Valley Transportation Authority**

**NO EXCEPTIONS TAKEN (NET)**  
**MAKE CORRECTIONS NOTED (MCN)**  
**AMEND AND RESUBMIT (A/R)**

Any action shown above is subject to the terms of the contract and does not relieve the Contractor of any of its obligations under the contract, including design and detailing.

Contract No.: **DB11002F**

By: \_\_\_\_\_ Date: \_\_\_\_\_

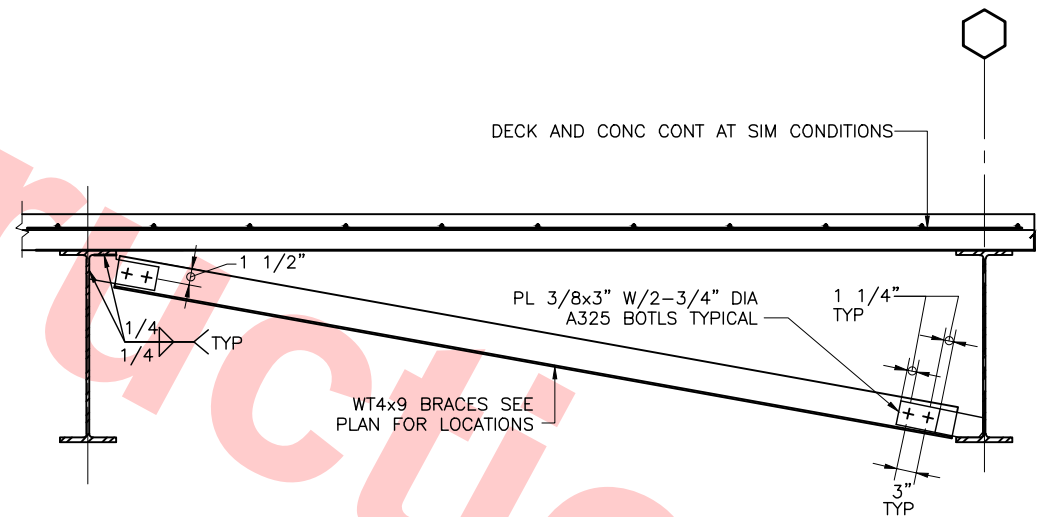


**TYPICAL DIAGONAL BRACING** (7)  
SCALE: 1"=1'-0" DB-S792

Jul 05, 2013 1:56pm P:\BART Berryessa Extension Line\AS - STRUCTURAL\MILPITAS WORK\_6-10-2012\CT00-S-DB-S792.dwg

DESIGNED BY J. REBER, S.E.	
DRAWN BY P. DIAZ	
CHECKED BY M. TARAZI	
IN CHARGE M. TARAZI	
DATE 20130710	

0	20130710				READINESS FOR CONSTRUCTION
REV	DATE	BY	SUB	APP	DESCRIPTION

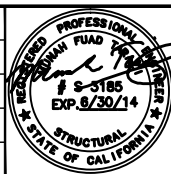

**Skanska Shimmick Herzog**

1436 California Circle  
Milpitas, California 95035  
A Joint Venture

MFT CONSULTING ENGINEERS, INC. Anil Verma Associates, Inc.  
1773 San Pablo Ave., Suite A3 (510) 222-4100  
Palo Alto, CA 94304 Fax (650) 222-8410

**Lealwood, Andrews & Newman, Inc.**  
A LEAD A BALLY COMPANY

**T-Y-LIN INTERNATIONAL**

**BART SILICON VALLEY**

**BART SILICON VALLEY BERRYESSA EXTENSION**

**LINE, TRACK, STATIONS AND SYSTEMS**

**DESIGN UNIT 023**


**MILPITAS STATION**

**TYPICAL STEEL SECTIONS AND DETAILS**

**SHEET 2 OF 8**

CADD FILENAME C700-S-DB-S792.dwg	
SIZE D	SCALE AS NOTED
CONTRACT NO. C700	REV. 0
AREA CODE DB	SHEET NO. S792
	PAGE NO. 0280




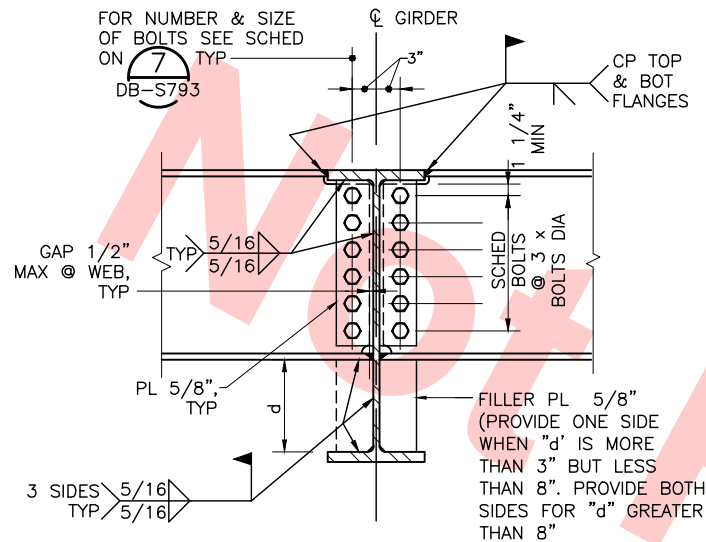

**TYPICAL BEAM TO GIRDER  
MOMENT CONNECTION**

SCALE: 1"=1'-0"


1  
DB-S793

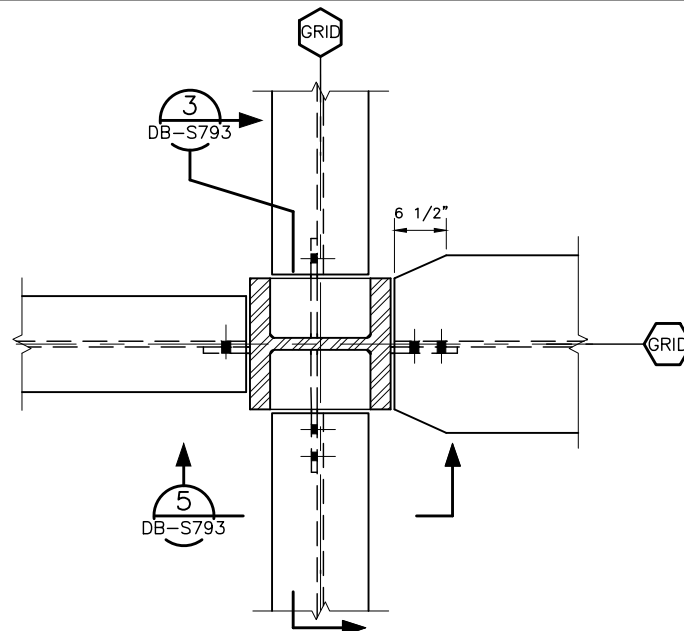

**PLAN DETAIL TYPICAL  
MOMENT CONNECTION**

SCALE: 1"=1'-0"


2  
DB-S793

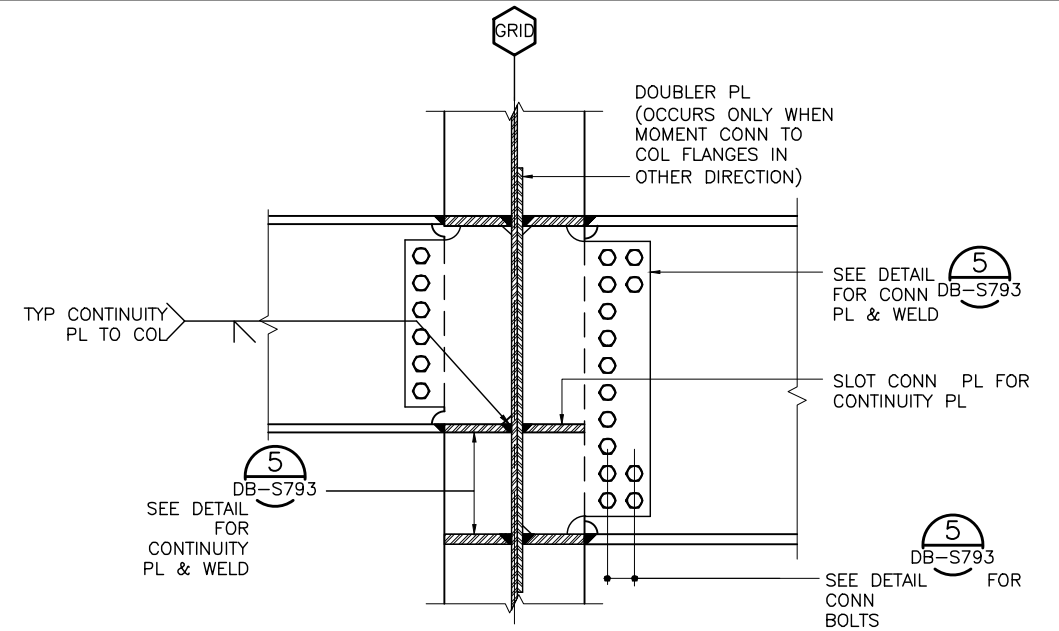

**TYPICAL MOMENT  
CONNECTION-GIRDER TO  
COLUMN WEB**

SCALE: 1"=1'-0"

3  
DB-S793

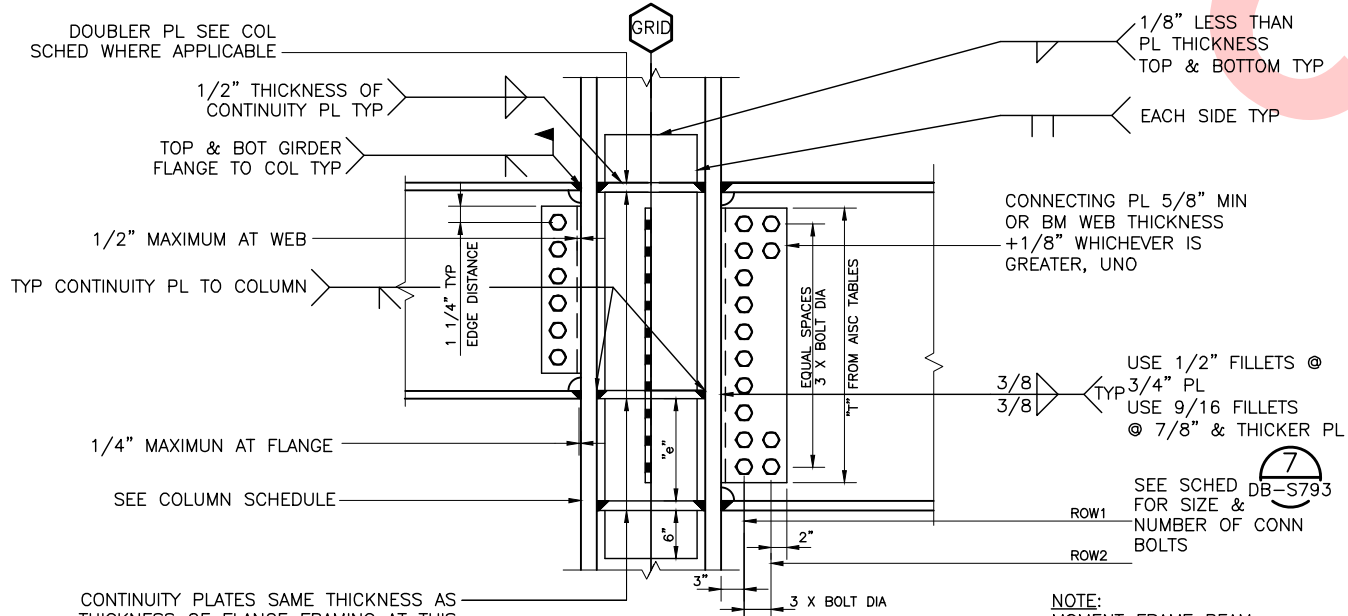

**TYPICAL MOMENT  
CONNECTION GIRDER TO  
COLUMN FLANGE**

SCALE: 1"=1'-0"


5  
DB-S793

MAXIMUM SIZE OF GIRDER	NUMBER OF 7/8" BOLT DIAMETER A325X
W36x256	11
W33x367	10
W30x391	9
W27x539	8
W24x370	7
W21x201	6
W18x311	5
W16x100	4
W14x145	3
W12x65	3
W10x112	2

**BOLT SCHEDULE FOR  
MOMENT CONNECTIONS**

SCALE: NTS

7  
DB-S793

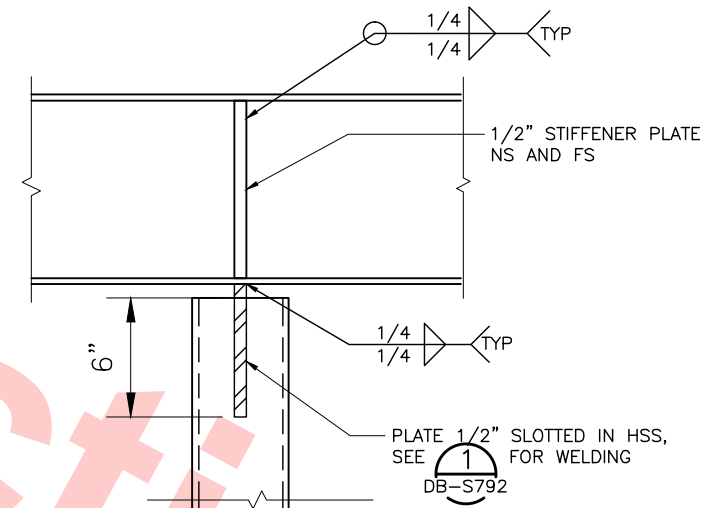

**DETAIL**

SCALE: NTS

8  
DB-S793

Santa Clara Valley Transportation Authority

NO EXCEPTIONS TAKEN (NET)  
MAKE CORRECTIONS NOTED (MCN)  
AMEND AND RESUBMIT (A/R)

Any action shown above is subject to the terms of the contract and does not relieve the Contractor of any of its obligations under the contract, including design and detailing.


Contract No.: DB11002F

By: \_\_\_\_\_ Date: \_\_\_\_\_

Jul 05, 2013 1:56pm P:\BART Berryessa Extension Line\AS - STRUCTURAL\MILPITAS WORK\6-10-2012\CT00-S-DB-S793.dwg

DESIGNED BY J. REBER, S.E.	
DRAWN BY P. DIAZ	
CHECKED BY M. TARAZI	
IN CHARGE M. TARAZI	
DATE 20130710	

0	20130710				READINESS FOR CONSTRUCTION
REV	DATE	BY	SUB	APP	DESCRIPTION

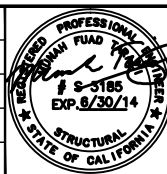

Skanska  
Shimmick  
Herzog

1436 California Circle  
Milpitas, California 95035  
A Joint Venture

MFT CONSULTING ENGINEERS, INC. Anil Verma Associates, Inc.  
1773 San Pablo Ave., Suite A3 (510) 222-4100  
Palo Alto, CA 94304 Fax (650) 222-8410

Lealwood, Andrews  
& Newman, Inc.  
A LEAD & BALLY COMPANY

T-Y-LIN INTERNATIONAL

**BART**  
SILICON VALLEY


BART SILICON VALLEY BERRYESSA EXTENSION

LINE, TRACK, STATIONS AND SYSTEMS DESIGN UNIT 023 MILPITAS STATION TYPICAL STEEL SECTIONS AND DETAILS SHEET 3 OF 8			
---	--	--	--

CADD FILENAME C700-S-DB-S793.dwg	
SIZE D	SCALE AS NOTED
CONTRACT NO. C700	REV. 0
AREA CODE DB	SHEET NO. S793
PAGE NO. 0281	




04-02 Jul 05, 2013 1:56pm P:\BART Berryessa Extension Line\AS - STRUCTURAL\MILPITAS WORK\6-10-2012\0700-S-DB-S794.dwg

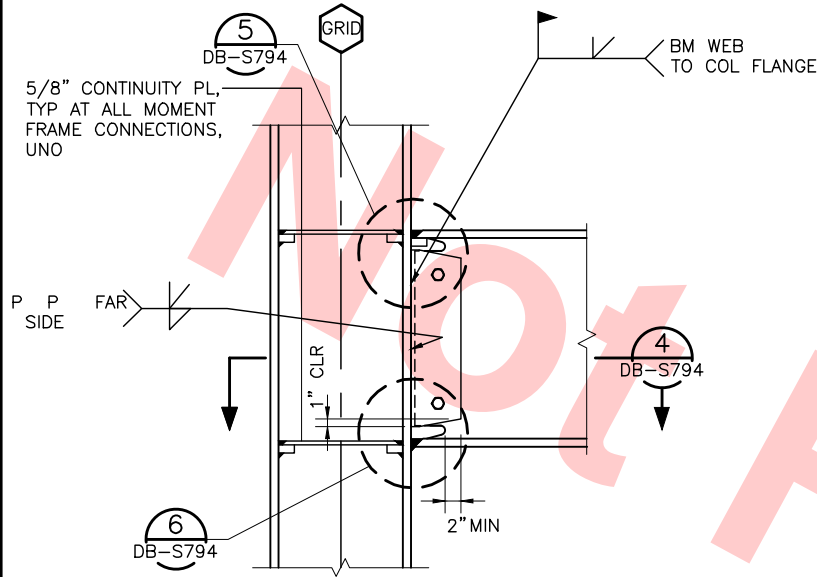


WUF-W MOMENT  
CONNECTION ONE SIDE  
SCALE: 1"=1'-0"

1  
DB-S794

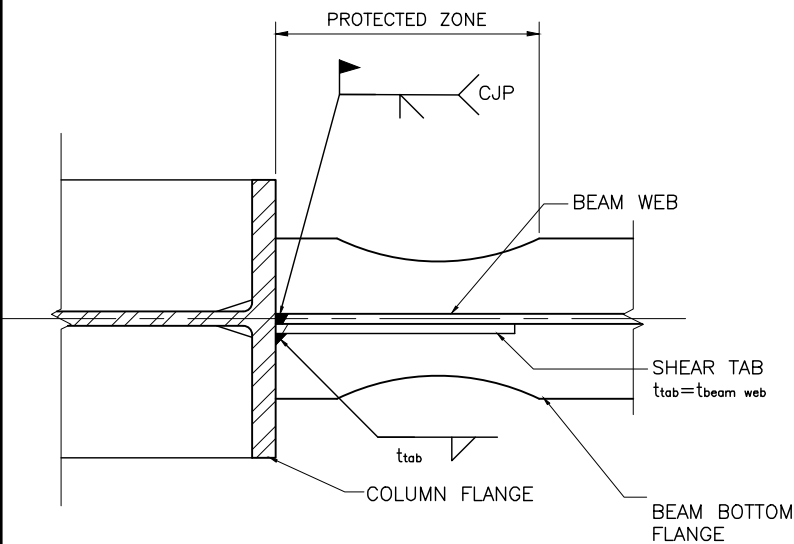


TYPICAL BM. WEB TO  
COLUMN FLANGE  
CONNECTION  
SCALE: NTS

4  
DB-S794

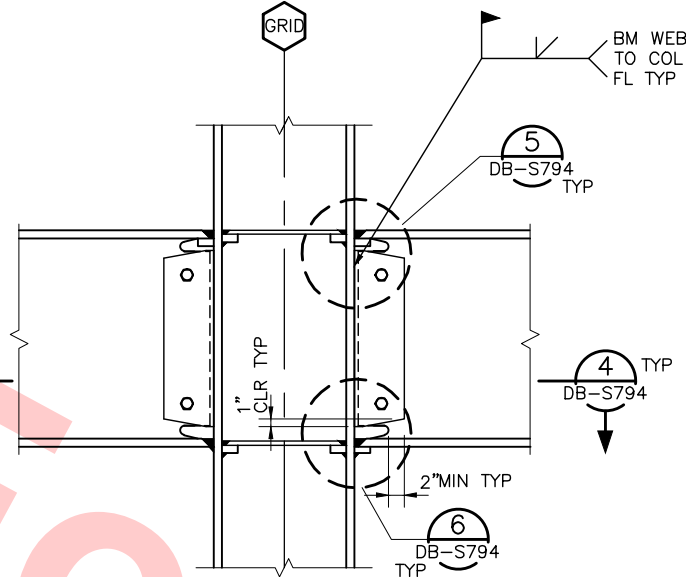


WUF-W MOMENT  
CONNECTION TWO SIDE  
SCALE: 1"=1'-0"

2  
DB-S794

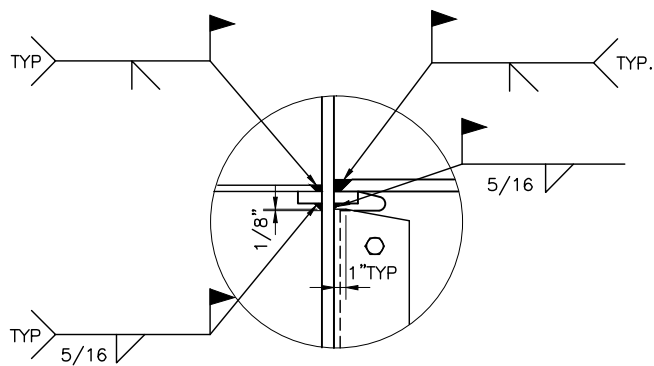

WUF-W MOMENT  
CONNECTION  
SCALE: 1 1/2"=1'-0"

5  
DB-S794

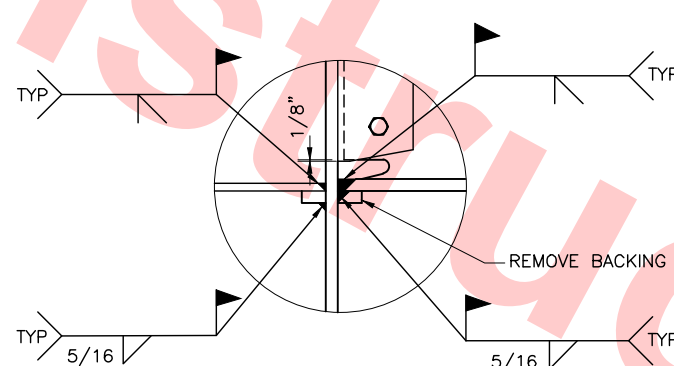

WUF-W MOMENT  
CONNECTION  
SCALE: 1 1/2"=1'-0"

6  
DB-S794


Santa Clara Valley Transportation Authority

NO EXCEPTIONS TAKEN (NET)  
MAKE CORRECTIONS NOTED (MCN)  
AMEND AND RESUBMIT (A/R)

Any action shown above is subject to the terms of the contract and does not relieve the Contractor of any of its obligations under the contract, including design and detailing.

Contract No.: DB11002F

By: Date:

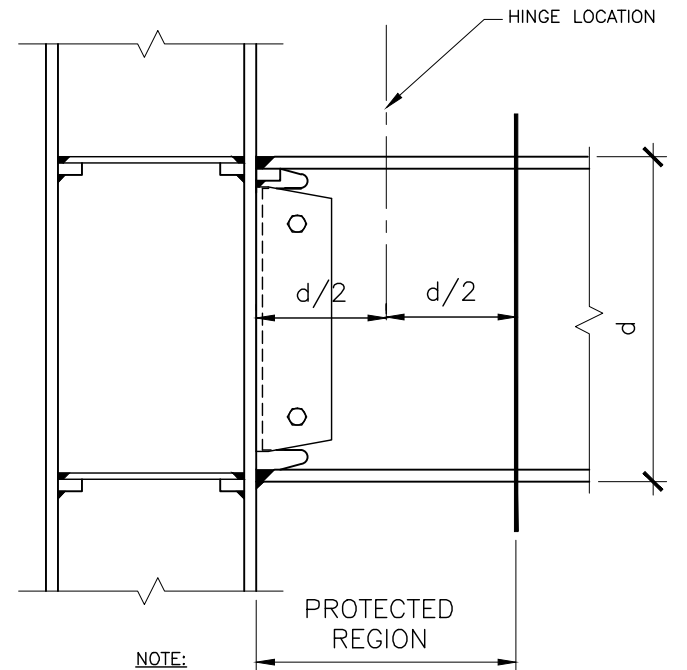

NOTE:

PER SECTION 3.3.3.4 OF FEMA 350, WELDED OR BOLTED ATTACHMENT FOR EXTERIOR FACADES, PARTITIONS, DUCTWORK, PIPING, OR OTHER CONSTRUCTION SHOULD NOT BE PLACED IN THE HINGING AREA OF MOMENT FRAME BEAMS. THE HINGING AREA IS THE PROTECTED REGION LOCATED ONE BEAM DEPTH (d) FROM THE COLUMN FACE.

THIS NOTE IS APPLICABLE TO ALL DRAWINGS.


PROTECTED  
REGION/HINGING AREA OF  
WUF-W MOMENT  
CONNECTION BMS  
SCALE: 1 1/2"=1'-0"

3  
DB-S794

- NOTES:
- SEE 7/DB-S795 FOR FEMA 350 REQUIREMENTS FOR WUF-W MOMENT CONNECTIONS.
  - USE TWO 1" DIAMETER A307 ERECTION BOLTS IN WUF-W MOMENT CONNECTIONS. REFER TO ITEM 7, DETAIL 7/DB-S795
  - THE WUF-W MOMENT CONNECTIONS SHALL BE COMPLETED, INCLUDING WELDING, PER FEMA 350, FIGURE 3-8 (SHOWN IN 7/DB-S795).

DESIGNED BY J. REBER, S.E.	
DRAWN BY P. DIAZ	
CHECKED BY M. TARAZI	
IN CHARGE M. TARAZI	
DATE 20130710	

0	20130710				READINESS FOR CONSTRUCTION
REV	DATE	BY	SUB	APP	DESCRIPTION

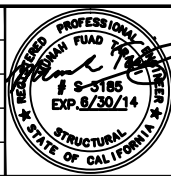

Skanska Shimmick Herzog	1436 California Circle Milpitas, California 95035 A Joint Venture
MFT CONSULTING ENGINEERS, INC. Anil Verma Associates, Inc. 1773 San Pablo Ave., Suite A3 Pinole, CA 94664 (916) 222-4100 Fax: (916) 222-8410	Loeblwood, Andrews & Newman, Inc. A LEO A DALY COMPANY
SUBMITTED	APPROVED



LINE, TRACK, STATIONS AND SYSTEMS  
DESIGN UNIT 023  
MILPITAS STATION  
TYPICAL STEEL  
SECTIONS AND DETAILS  
SHEET 4 OF 8





CADD FILENAME C700-S-DB-S794.dwg	
SIZE D	SCALE AS NOTED
CONTRACT NO. C700	REV. 0
AREA CODE DB	SHEET NO. S794
	PAGE NO. 0282







04-02 Jul 05, 2013 1:56pm P:\BART Berryessa Extension Line\AS - STRUCTURAL MILPITAS WORK\_6-10-2012\CT00-S-DB-S796.dwg

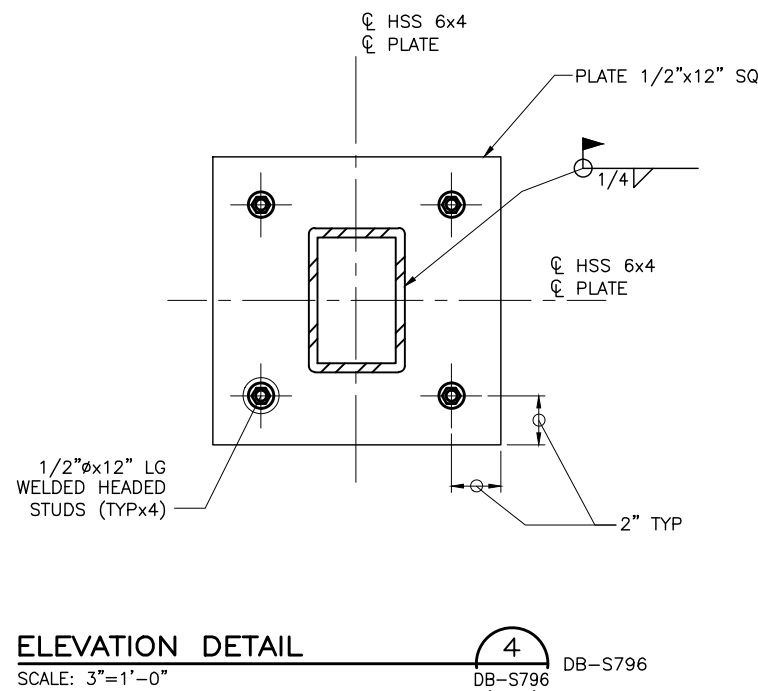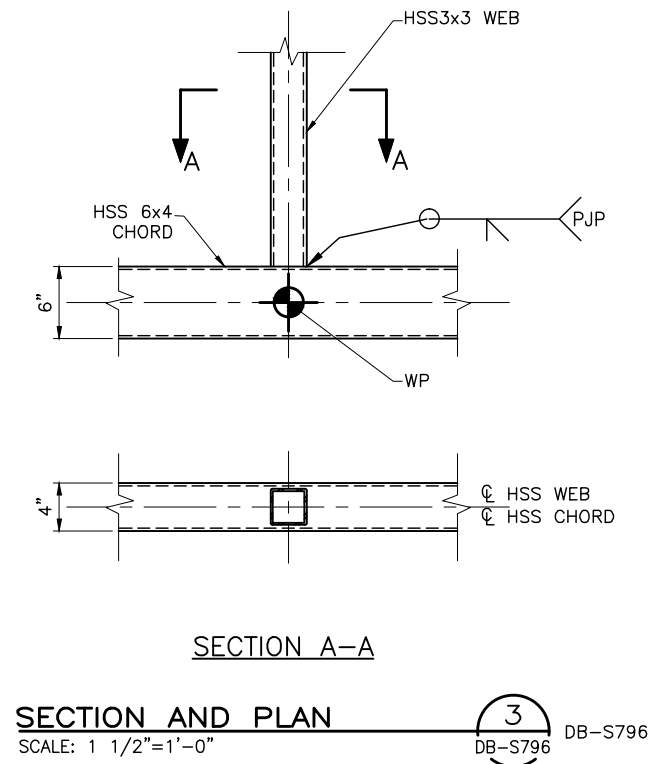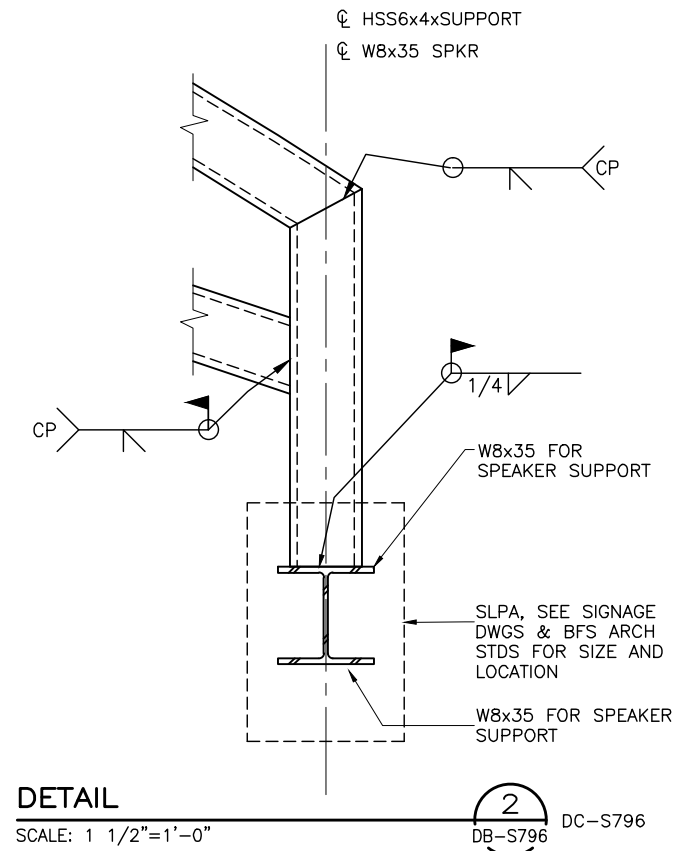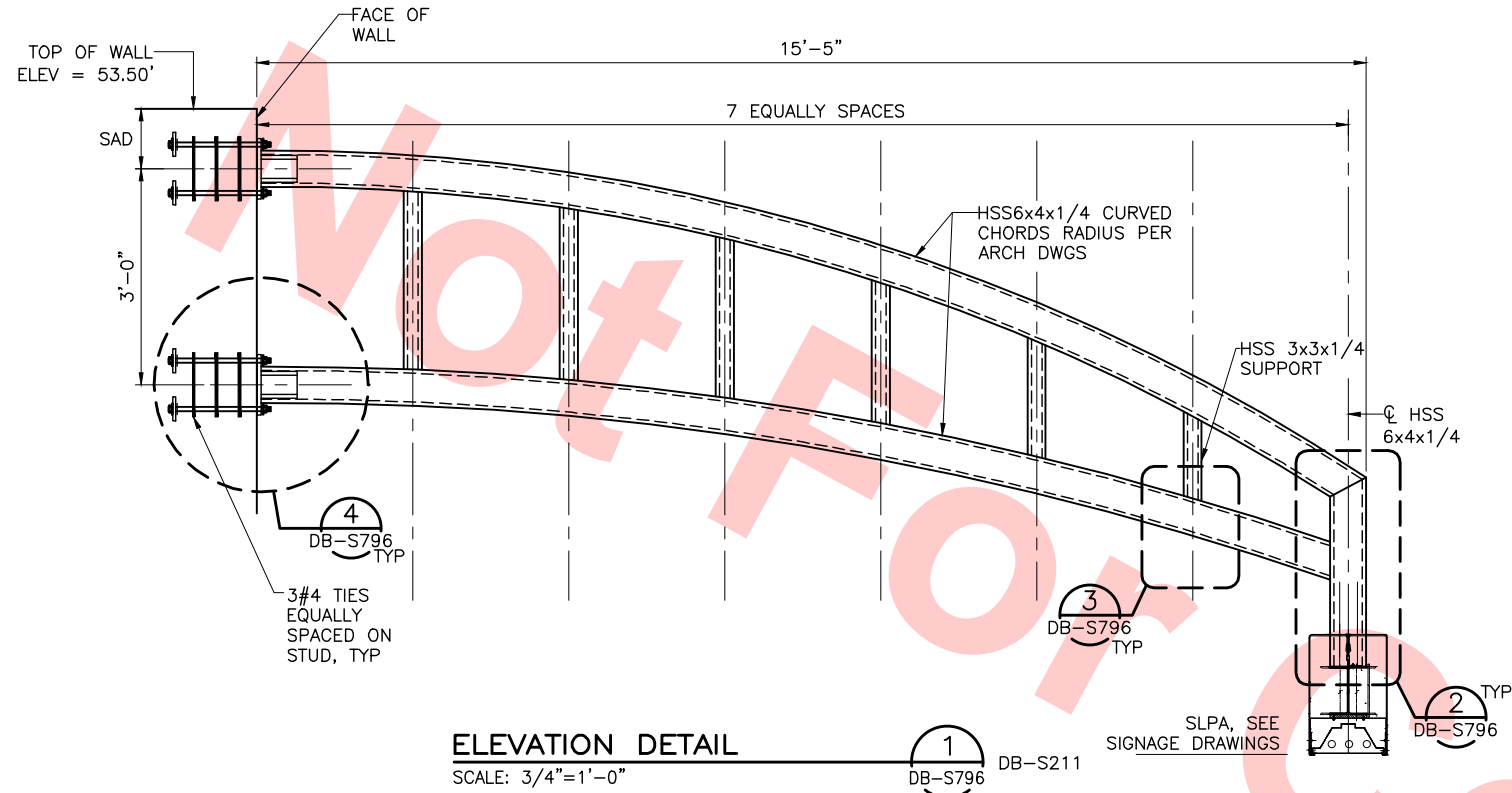

Santa Clara Valley Transportation Authority

NO EXCEPTIONS TAKEN (NET)  
MAKE CORRECTIONS NOTED (MCN)  
AMEND AND RESUBMIT (A/R)


Any action shown above is subject to the terms of the contract and does not relieve the Contractor of any of its obligations under the contract, including design and detailing.

Contract No.: DB11002F

By: Date:

REV	DATE	BY	SUB	APP	DESCRIPTION
0	20130710				READINESS FOR CONSTRUCTION
0	20130531				READINESS FOR CONSTRUCTION

DESIGNED BY  
C. BRADBURY  
DRAWN BY  
P. DIAZ  
CHECKED BY  
M. TARAZI  
IN CHARGE  
M. TARAZI  
DATE  
20130710

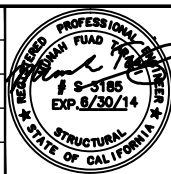

Skanska  
Shimmick  
Herzog

1436 California Circle  
Milpitas, California 95035  
A Joint Venture

MFT CONSULTING ENGINEERS, Inc. Anil Verma Associates, Inc.  
1773 San Pablo Ave., Suite A3 (510) 222-4100  
Palo Alto, CA 94304 Fax (650) 222-8410

Lealwood, Andrews  
& Newman, Inc.  
A LEAD A RALLY COMPANY

T-Y-LIN INTERNATIONAL




LINE, TRACK, STATIONS AND SYSTEMS  
DESIGN UNIT 023  
MILPITAS STATION  
TYPICAL STEEL  
SECTIONS AND DETAILS  
SHEET 6 OF 8

CADD FILENAME C700-S-DB-S796.dwg	SIZE D	SCALE AS NOTED
CONTRACT NO. C700	SHEET NO. S796	REV. 0
AREA CODE DB	PAGE NO. 0284	



04-02 Jul 05, 2013 - 1:56pm P:\BART Berryessa Extension Line\AS - STRUCTURAL MILPITAS WORK\_6-10-2012\CT00-S-DB-S798.dwg

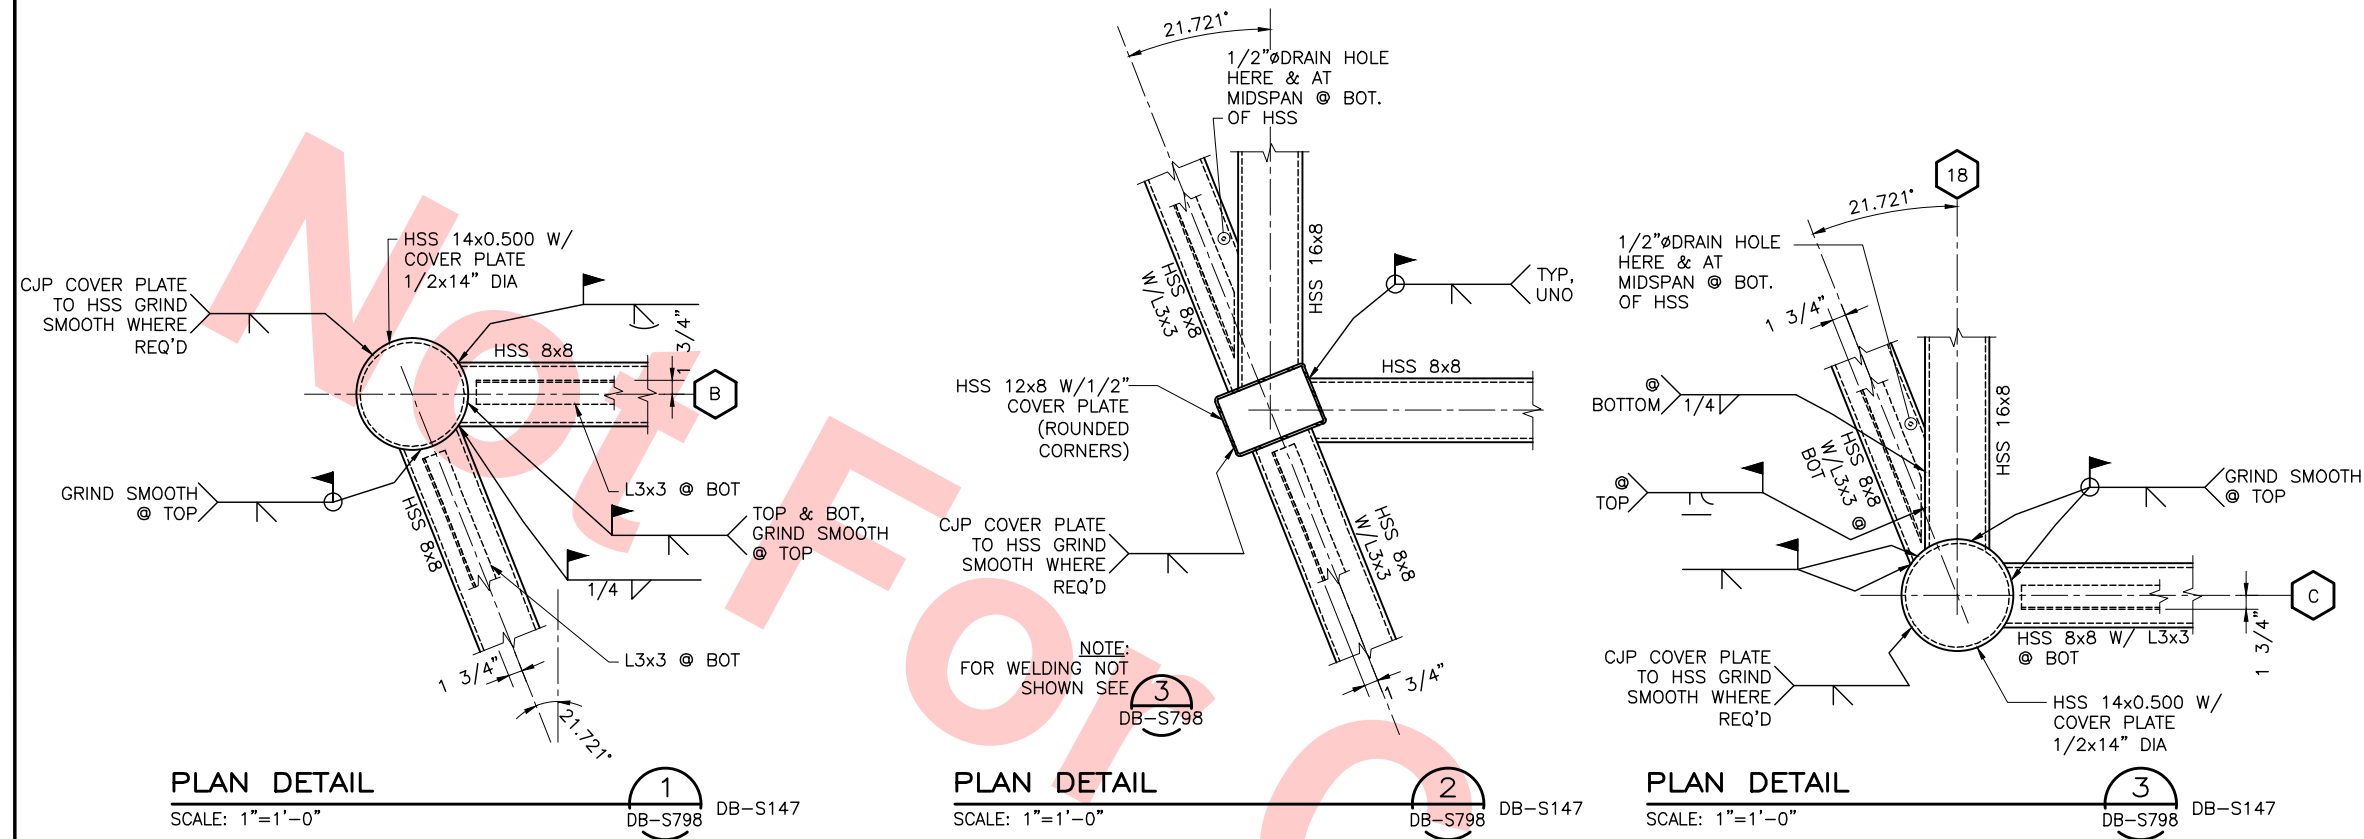

Santa Clara Valley Transportation Authority

☐ NO EXCEPTIONS TAKEN (NET)  
☐ MAKE CORRECTIONS NOTED (MCN)  
☐ AMEND AND RESUBMIT (A/R)


Any action shown above is subject to the terms of the contract and does not relieve the Contractor of any of its obligations under the contract, including design and detailing.

Contract No.: DB11002F

By: \_\_\_\_\_ Date: \_\_\_\_\_

REV	DATE	BY	SUB	APP	DESCRIPTION
0	20130710				READINESS FOR CONSTRUCTION

DESIGNED BY C. BRADBURY	DRAWN BY P. DIAZ	CHECKED BY M. TARAZI	IN CHARGE M. TARAZI
DATE 20130710			

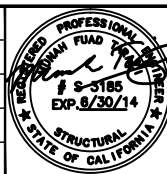

<b>Skanska Shimmick Herzog</b> 1436 California Circle Milpitas, California 95035 A Joint Venture	<b>MFT CONSULTING ENGINEERS, Inc.</b> Anil Verma Associates, Inc. 1773 San Pablo Ave., Suite A3 Pinole, CA 94664 (916) 222-4100 Fax (916) 222-8410	<b>Lealwood, Andrews &amp; Newman, Inc.</b> A LEAD A BALLY COMPANY T-Y-LIN INTERNATIONAL
SUBMITTED <i>[Signature]</i>	APPROVED <i>[Signature]</i>	







LINE, TRACK, STATIONS AND SYSTEMS  
DESIGN UNIT 023  
MILPITAS STATION  
TYPICAL STEEL  
SECTIONS AND DETAILS  
SHEET 7 OF 8

CADD FILENAME C700-S-DB-S798.dwg	SIZE D	SCALE 1" = 1'-0"
CONTRACT NO. C700	SHEET NO. S798	PAGE NO. 0285



Jul 05, 2013 - 1:56pm P:\BART Berryessa Extension Line\AS - STRUCTURAL MILPITAS WORK\6-10-2012\0700-S-DB-S799.dwg  
c04-02

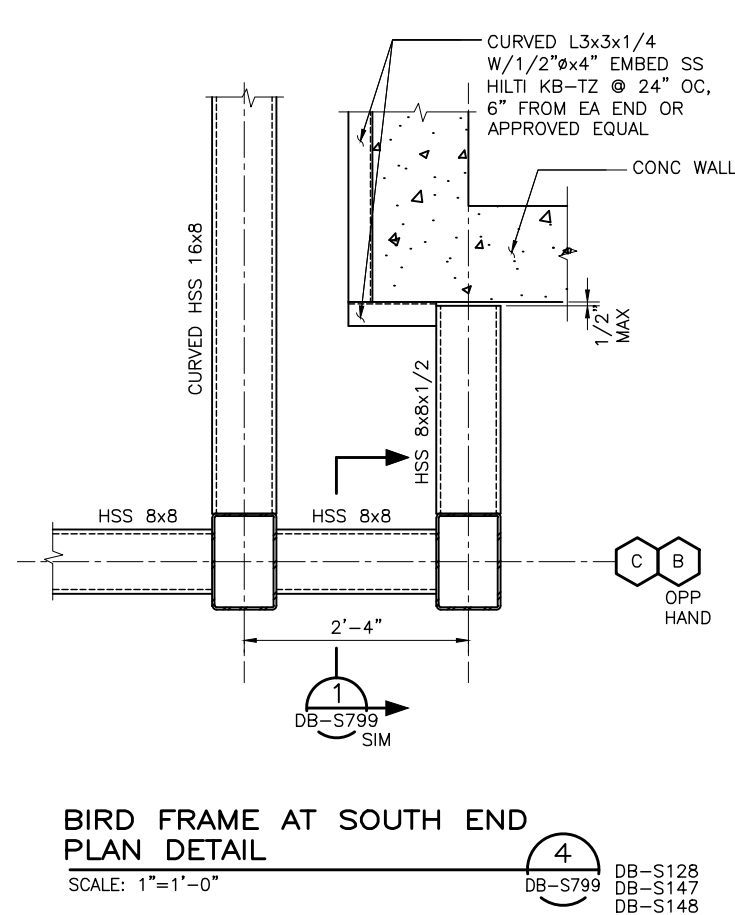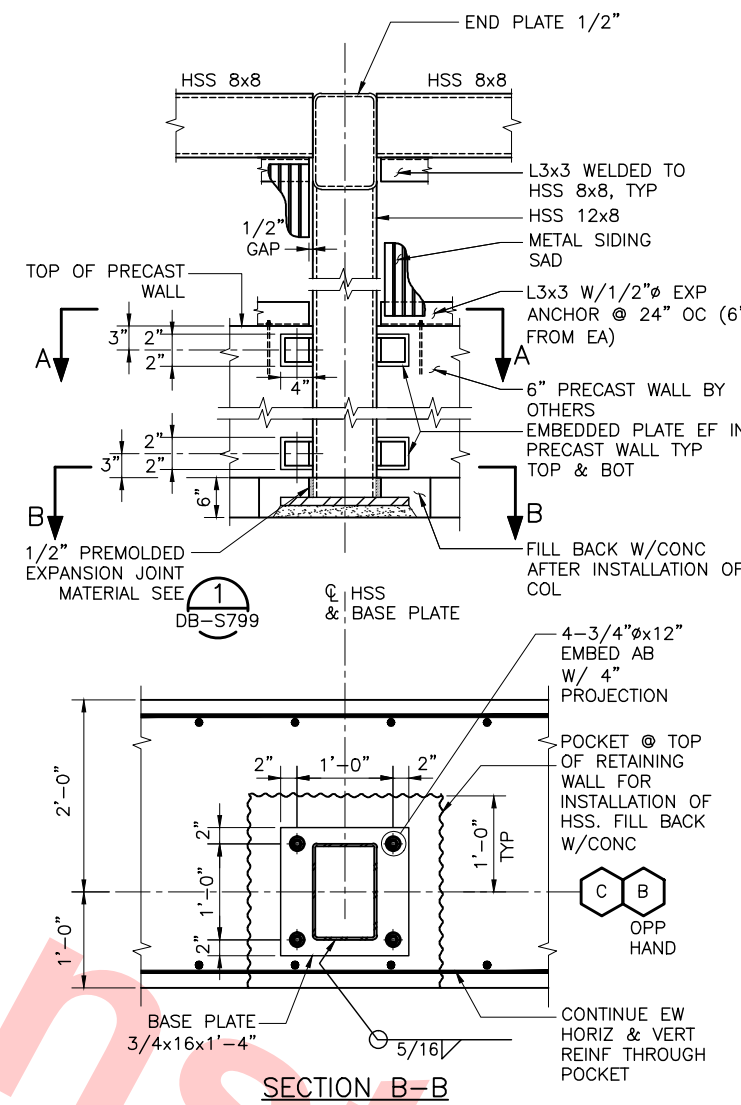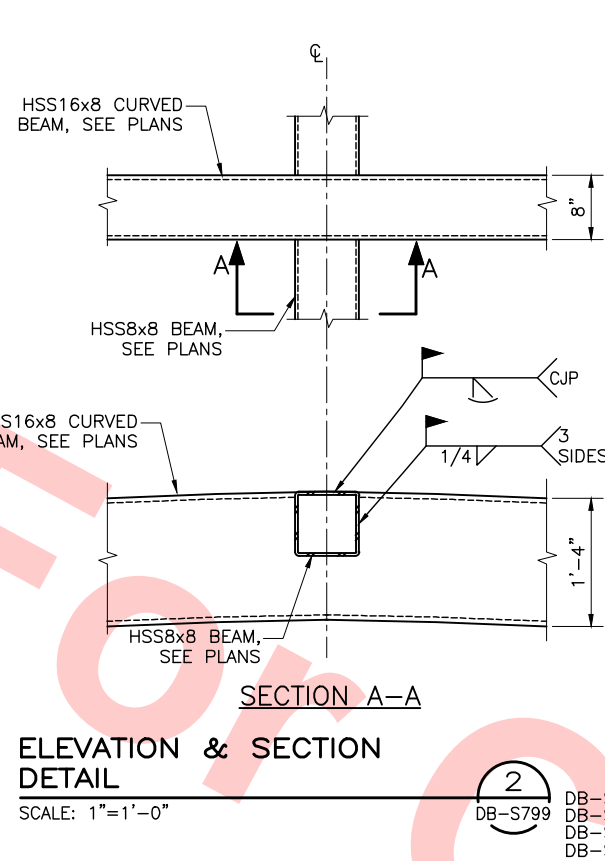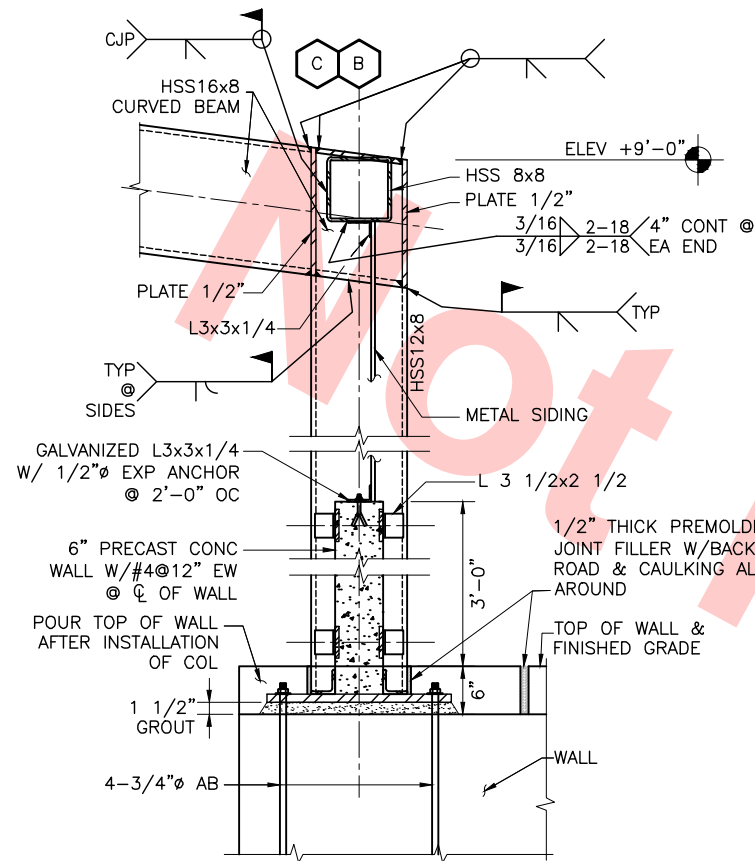

**Santa Clara Valley Transportation Authority**


**NO EXCEPTIONS TAKEN (NET)**  
**MAKE CORRECTIONS NOTED (MCN)**  
**AMEND AND RESUBMIT (A/R)**

Any action shown above is subject to the terms of the contract and does not relieve the Contractor of any of its obligations under the contract, including design and detailing.

Contract No.: **DB11002F**

By: \_\_\_\_\_ Date: \_\_\_\_\_

DESIGNED BY C. BRADBURY	1	2	3	100
DRAWN BY P. DIAZ	1	2	3	100
CHECKED BY M. TARAZI	1	2	3	100
IN CHARGE M. TARAZI	1	2	3	100
DATE 20130710	1	2	3	100

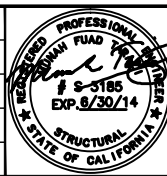

**Skanska Shimmick Herzog**

1436 California Circle  
Milpitas, California 95035  
A Joint Venture

MFT CONSULTING ENGINEERS, INC. Anil Verma Associates, Inc.  
1773 San Pablo Ave., Suite A3 (510) 222-4100  
Palo Alto, CA 94304 Fax (650) 222-8410

**Leonwood, Andrews & Newman, Inc.**  
A LEAD & BALLY COMPANY

**T-Y-LIN INTERNATIONAL**

**BART SILICON VALLEY**

BART SILICON VALLEY BERRYESSA EXTENSION

**LINE, TRACK, STATIONS AND SYSTEMS**

**DESIGN UNIT 023**

MILPITAS STATION  
TYPICAL STEEL  
SECTIONS AND DETAILS  
SHEET 8 OF 8

CADD FILENAME  
C700-S-DB-S799.dwg

SIZE SCALE  
D 1" = 1'-0"

CONTRACT NO. **C700** REV. **0**

AREA CODE **DB** SHEET NO. **S799** PAGE NO. **0286**



Jun 26, 2013 4:29pm C:\Current Projects\Bart-Berryessa Extension Project\Station - Milpitas\CAD Drawings\04\13-0710 C700 Milpitas Station - RFG Submit\C700-S-DB-S809.dwg JosephK

GENERAL NOTES FOR ANCILLARY BUILDING

1. INTENT OF DRAWINGS

- A. THE GENERAL NOTES APPLY TO ALL STRUCTURAL WORK EXCEPT WHERE THEY CONFLICT WITH DETAILS AND NOTES SPECIFICALLY SHOWN AND NOTED.
- B. ITEMS IN THE CONSTRUCTION SPECIFICATIONS, BUT NOT SHOWN ON THE DRAWINGS, SHALL BE CONSIDERED AS BEING PART OF THE DRAWINGS.
- C. RESOLVE ALL CONFLICTS AND AMBIGUITIES ON THE PLANS AND SPECIFICATIONS WITH THE VTA BEFORE PROCEEDING WITH CONSTRUCTION.
- D. ALL REQUIRED DETAILS OR DIMENSIONS NOT SHOWN SPECIFICALLY SHALL BE OF SIMILAR CHARACTER AS SHOWN FOR SIMILAR CONDITIONS.
- E. THE STRUCTURAL DRAWINGS SHOW ONLY A PRELIMINARY DESIGN. THE DB CONTRACTOR SHALL REVIEW AND FINALIZE THE DESIGN AND STRUCTURAL DRAWINGS. REFER TO ARCHITECTURAL, CIVIL, MECHANICAL, ELECTRICAL AND COMMUNICATIONS/SYSTEMS DRAWINGS FOR ITEMS WHICH REQUIRE COORDINATION DURING THE DESIGN AND CONSTRUCTION OF THE STRUCTURE.

2. BASIS OF DESIGN

- A. BART FACILITIES STANDARDS (BFS), RELEASE 2.1A
- B. BART FACILITIES DESIGN GUIDELINES, RELEASE 2.1A
- C. BART FACILITIES DESIGN CRITERIA, RELEASE 2.1A
- D. BART STANDARD PLANS, RELEASE 2.1A
- E. BART FACILITIES SPECIFICATIONS, RELEASE 2.1A
- F. BUILDING CODE REQUIREMENTS FOR MASONRY STRUCTURES, ACI 530-05/ASCE 6-05/TMS 602-05
- G. CALIFORNIA BUILDING CODE, 2010
- H. AMERICAN CONCRETE INSTITUTE, BUILDING CODE AND COMMENTARY, 318-05
- I. AMERICAN INSTITUTE OF STEEL CONSTRUCTION, MANUAL OF STEEL CONSTRUCTION, 13th EDITION.
- J. AMERICAN WELDING SOCIETY: ANSI/AWS D1.1 2004

3. EXISTING CONDITIIONS

- THE CONTRACTOR SHALL FIELD VERIFY EXISTING CONDITIONS PERTINENT TO THE WORK PRIOR TO MATERIAL FABRICATION AND/OR CONSTRUCTION. FIELD CONDITIONS DIFFERENT FROM THOSE NOTED ON THE CONSTRUCTION DRAWINGS SHALL BE PROMPTLY BROUGHT TO THE ATTENTION OF THE VTA. ITEMS TO BE FIELD VERIFIED INCLUDE BUT ARE NOT LIMITED TO:
- A. LOCATION, DIMENSIONS, AND ELEVATIONS OF EXISTING STRUCTURES, STRUCTURAL ELEMENTS, EQUIPMENT AND UTILITIES, WHICH HAVE BEEN SHOWN AS REFERENCE ON THE DRAWINGS AND MAY AFFECT NEW CONSTRUCTION.
  - B. HORIZONTAL AND VERTICAL CLEARANCES.
  - C. HORIZONTAL AND VERTICAL TIE-IN POINTS.

4. DESIGN LOADS

- A. ROOF DEAD LOAD = 17 PSF
- B. ROOF LIVE LOAD = 20 PSF (REDUCIBLE)
- C. WIND LOAD
  - WIND SPEED = 85 MPH
  - EXPOSURE = C
  - IMPORTANCE FACTOR = 1.15
- D. SEISMIC LOAD
  - REDUNDANCE FACTOR = 85 MPH
  - IMPORTANCE FACTOR = 1.25
  - SEISMIC DESIGN CATEGORY = C









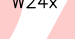
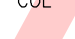

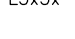
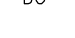
5. MATERIAL STRENGTHS:

- A. CONCRETE:
  - 1. f'c = 3,000 PSI (TYPICAL)
  - 2. f'c = 60,000 PSI
- B. MASONRY:
  - 1. f'm = 1,500 PSI
  - 2. f'g = 2,500 PSI
  - 3. fy = 60,000 PSI
- C. STRUCTURAL STEEL:
  - 1. WF AND WT SHAPES, ASTM A992 GRADE 50
  - 2. C, MC, L AND 2L SHAPES, ASTM A36
  - 3. HSS SHAPES, ASTM A500 GRADE B

REINFORCED MASONRY NOTES:

- A. CONCRETE MASONRY UNITS (CMU) SHALL CONFORM TO ASCM C90.
- B. ALL MORTAR MATERIALS SHALL CONFORM TO ASTM C 270.
- C. TYPE M OR S GROUT SHALL CONFORM TO ASTM C476.
- D. ALL CELLS IN CONCRETE BLOCK CONSTRUCTION SHALL BE GROUTED SOLID.
- E. CONCRETE BLOCK CONSTRUCTION SHALL BE RUNNING BOND WITH OPEN ENDED BLOCKS.
- F. CONTINOUS INSPECTION IS REQUIRED DURING CONSTRUCTION OF MASONRY.
- G. ALL BOLTS EMBEDDED IN CONCRETE BLOCK SHALL HAVE A MINIMUM OF 1" OF GROUT BETWEEN THE BOLT AND THE CONCRET BLOCK ON ALL SIDES.

STRUCTURAL LEGEND:

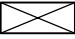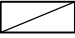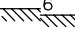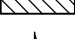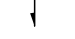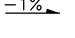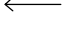-  INDICATES OPENING
-  INDICATES BLOCKOUT
-  INDICATES GRADE BREAK
-  INDICATES CMU WALL
-  INDICATES DIRECTION OF RIBS IN METAL DECK
-  INDICATES CROSS SLOPE
-  INDICATES SLOPED SURFACE
-  INDICATES BRACED FRAME
-  INDICATES STRUCTURAL STEEL WIDE FLANGE BEAM AND SIZE
-  INDICATES STRUCTURAL STEEL COLUMN
-  INDICATES BRACE DIRECTION
-  INDICATES STRUCTURAL STEEL ANGLE AND SIZE
-  INDICATES BEAM IDENTICAL TO ADJACENT MEMBER

STRUCTURAL ABBREVIATIONS:

- |      |  |
|------|--|
| BFS  | BART FACILITY STANDARDS  |
| BTWN | BETWEEN  |
| CL   | CENTERLINE   |
| CIP  | CAST-IN-PLACE  |
| CMU  | CONCRETE MASONRY UNIT  |
| EQ   | EQUAL  |
| EW   | EACH WAY   |
| f'c  | SPECIFIED COMPRESSIVE STRENGTH OF STRUCTURAL CONCRETE AT 28 DAYS |
| fy   | SPECIFIED YIELD STRENGTH OF REINFORCEMENT                        |
| fu   | ULTIMATE STRENGTH OF STEEL                                       |
| f'm  | SPECIFIED COMPRESSIVE STRENGTH OF MASONRY AT 28 DAYS             |
| f'g  | SPECIFIED COMPRESSIVE STRENGTH OF CMU GROUT                      |
| KSI  | KIPS PER SQUARE INCH   |
| LBS  | POUNDS   |
| PCF  | POUNDS PER CUBIC FOOT  |
| PSF  | POUNDS PER SQUARE FOOT   |
| PSI  | POUNDS PER SQUARE INCH   |
| P/S  | PRESTRESSED  |
| Ø    | DIAMETER   |
| NIC  | NOT IN CONTRACT  |
| ©    | AT   |

Santa Clara Valley Transportation Authority

- NO EXCEPTIONS TAKEN (NET)
- MAKE CORRECTIONS NOTED (MCN)
- AMEND AND RESUBMIT (A/R)

Any action shown above is subject to the terms of the contract and does not relieve the Contractor of any of its obligations under the contract, including design and detailing.

Contract No.: DB11002F

By: Date:

REV	DATE	BY	SUB	APP	DESCRIPTION
0	20130710				READINESS FOR CONSTRUCTION

DESIGNED BY  
E. MAMOYAC  
DRAWN BY  
S. DE GUZMAN  
CHECKED BY  
S. SENGUPTA  
IN CHARGE  
R. BARLAAN  
DATE  
20130710



Skanska  
Shimmick  
Herzog

1436 California Circle  
Milpitas, California 95035  
A Joint Venture


Anil Verma Associates, Inc.

1970 Broadway, Suite 525  
Oakland, CA 94612  
Phone: (510) 835-2537 Fax: (810) 535-2338

Lookwood, Andrews  
& Newman, Inc.

A LEED A RATED COMPANY

T-Y LIN INTERNATIONAL

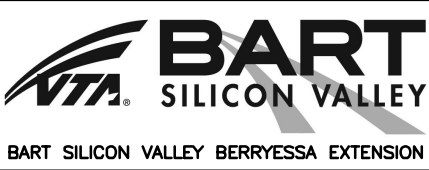


LINE, TRACK, STATIONS AND SYSTEMS  
DESIGN UNIT 023  
ANCILLARY BUILDING  
STRUCTURAL GENERAL NOTES

CADD FILENAME C700-S-DB-S809.dwg		
SIZE D	SCALE NONE	
CONTRACT NO. C700	REV. 0	
AREA CODE DB	SHEET NO. S809	PAGE NO. 0287



Jun 26, 2013 - 4:30pm G:\Current Projects\Berrysessa Extension Project\Station - Milpitas\CAD Drawings Out\13-0710 C700 Milpitas Station - RFC Submit\700-S-DB-S810.dwg

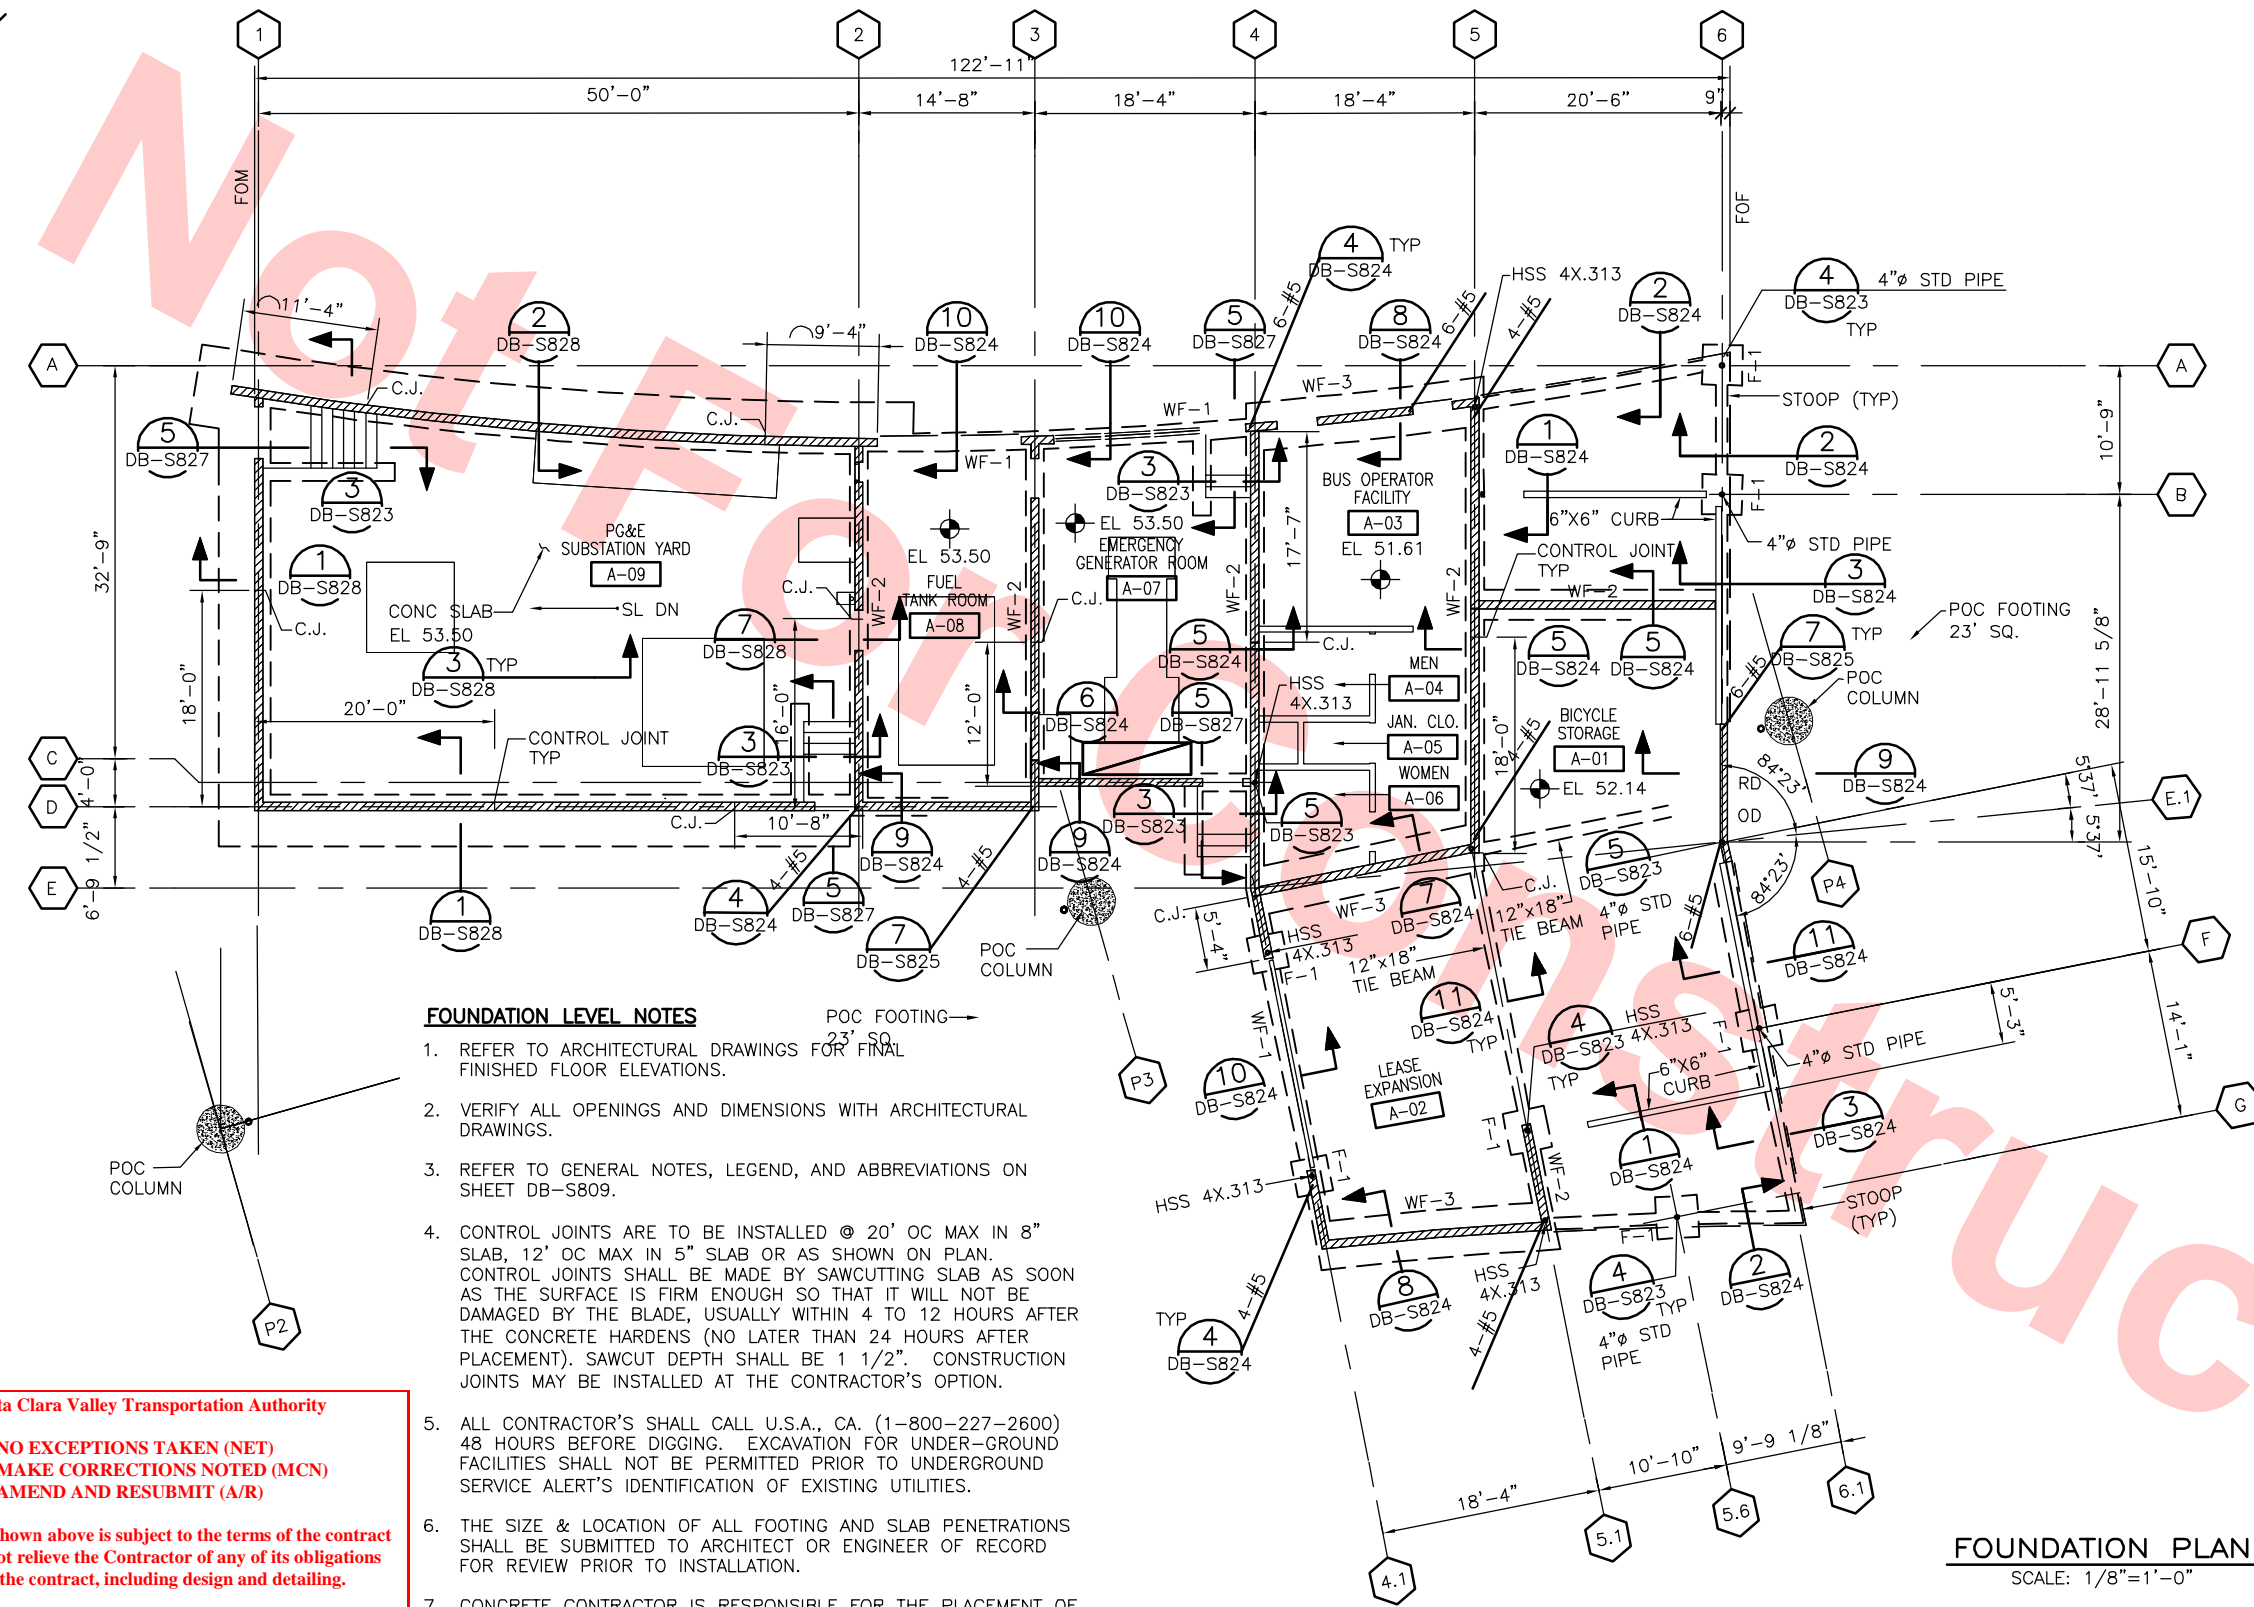

- FOUNDATION LEVEL NOTES**
- REFER TO ARCHITECTURAL DRAWINGS FOR FINAL FINISHED FLOOR ELEVATIONS.
  - VERIFY ALL OPENINGS AND DIMENSIONS WITH ARCHITECTURAL DRAWINGS.
  - REFER TO GENERAL NOTES, LEGEND, AND ABBREVIATIONS ON SHEET DB-S809.
  - CONTROL JOINTS ARE TO BE INSTALLED @ 20' OC MAX IN 8" SLAB, 12' OC MAX IN 5" SLAB OR AS SHOWN ON PLAN. CONTROL JOINTS SHALL BE MADE BY SAWCUTTING SLAB AS SOON AS THE SURFACE IS FIRM ENOUGH SO THAT IT WILL NOT BE DAMAGED BY THE BLADE, USUALLY WITHIN 4 TO 12 HOURS AFTER THE CONCRETE HARDENS (NO LATER THAN 24 HOURS AFTER PLACEMENT). SAWCUT DEPTH SHALL BE 1 1/2". CONSTRUCTION JOINTS MAY BE INSTALLED AT THE CONTRACTOR'S OPTION.
  - ALL CONTRACTOR'S SHALL CALL U.S.A., CA. (1-800-227-2600) 48 HOURS BEFORE DIGGING. EXCAVATION FOR UNDER-GROUND FACILITIES SHALL NOT BE PERMITTED PRIOR TO UNDERGROUND SERVICE ALERT'S IDENTIFICATION OF EXISTING UTILITIES.
  - THE SIZE & LOCATION OF ALL FOOTING AND SLAB PENETRATIONS SHALL BE SUBMITTED TO ARCHITECT OR ENGINEER OF RECORD FOR REVIEW PRIOR TO INSTALLATION.
  - CONCRETE CONTRACTOR IS RESPONSIBLE FOR THE PLACEMENT OF ALL EMBEDDED ITEMS.
  - ALL DIMENSIONS ARE TO CENTERLINE OF COLUMNS OR FACE OF CONCRETE, TYP UNLESS NOTED OTHERWISE.

**Santa Clara Valley Transportation Authority**

\_\_\_NO EXCEPTIONS TAKEN (NET)  
\_\_\_MAKE CORRECTIONS NOTED (MCN)  
\_\_\_AMEND AND RESUBMIT (A/R)

Any action shown above is subject to the terms of the contract and does not relieve the Contractor of any of its obligations under the contract, including design and detailing.

Contract No.: **DB11002F**

By: \_\_\_\_\_ Date: \_\_\_\_\_

NOTES


- CONCRETE SLAB SHALL BE 5" THICK WITH #4 @ 18" O.C. AT MID DEPTH
- CMU WALLS:  
A. INTERIOR AND EXTERIOR WALLS- 8" CMU WITH ONE ROW OF #5 @ 24" O.C. VERTICAL BARS AND #5 @ 32" O.C. HORIZONTAL BARS  
  
B. SUBSTATION WALLS (EXCEPT LINE 2) - 8" CMU WITH TWO ROWS OF #5 @ 24" O.C. VERTICAL BARS AND #5 @ 32" O.C. HORIZONTAL BARS
- PROVIDE 2-#5 JAMB BARS PER 12/DB-S824 @ ALL WALL ENDS U.N.O.

WALL FOOTING SCHEDULE


MARK	WIDTH	THICKNESS	REINFORCEMENT	
			LONGITUDINAL	TRANSVERSE
WF-1	1'-6"	12"	2 - #5	#4 @ 12" BOTTOM ONLY
WF-2	2'-6"	18"	2 - #5	#4 @ 12" TOP & BOTTOM
WF-3	4'-0"	12"	2 - #5	#4 @ 12" TOP & BOTTOM

FOOTING SCHEDULE

MARK	WIDTH	LENGTH	THICKNESS	REINFORCEMENT
F-1	3'-0"	3'-0"	12"	4-#5

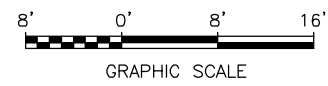


KEY PLAN

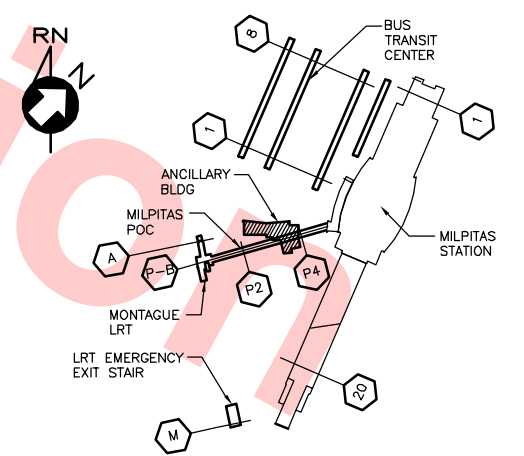

**FOUNDATION PLAN**  
SCALE: 1/8"=1'-0"

REV	DATE	BY	SUB	APP	DESCRIPTION
0	20130710				READINESS FOR CONSTRUCTION

DESIGNED BY  
E. MAMOYAC  
DRAWN BY  
H. ANGELES  
CHECKED BY  
S. SENGUPTA  
IN CHARGE  
R. BARLAAN  
DATE  
20130710

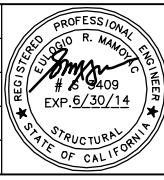

**Skanska Shimmick Herzog**

**Anil Verma Associates, Inc.**  
1970 Broadway, Suite 525  
Oakland, CA 94612  
Phone: (510) 835-2527 Fax: (510) 835-2338

1436 California Circle  
Milpitas, California 95035  
A Joint Venture

**Lookwood, Andrews & Newman, Inc.**  
A L&A B&N COMPANY

**T-Y LIN INTERNATIONAL**




LINE, TRACK, STATIONS AND SYSTEMS  
DESIGN UNIT 023  
ANCILLARY BUILDING



FOUNDATION PLAN



CADD FILENAME C700-S-DB-810.dwg	REV.	0
SIZE D	SCALE 1/8"=1'-0"	
CONTRACT NO. C700	SHEET NO. S810	PAGE NO. 0288

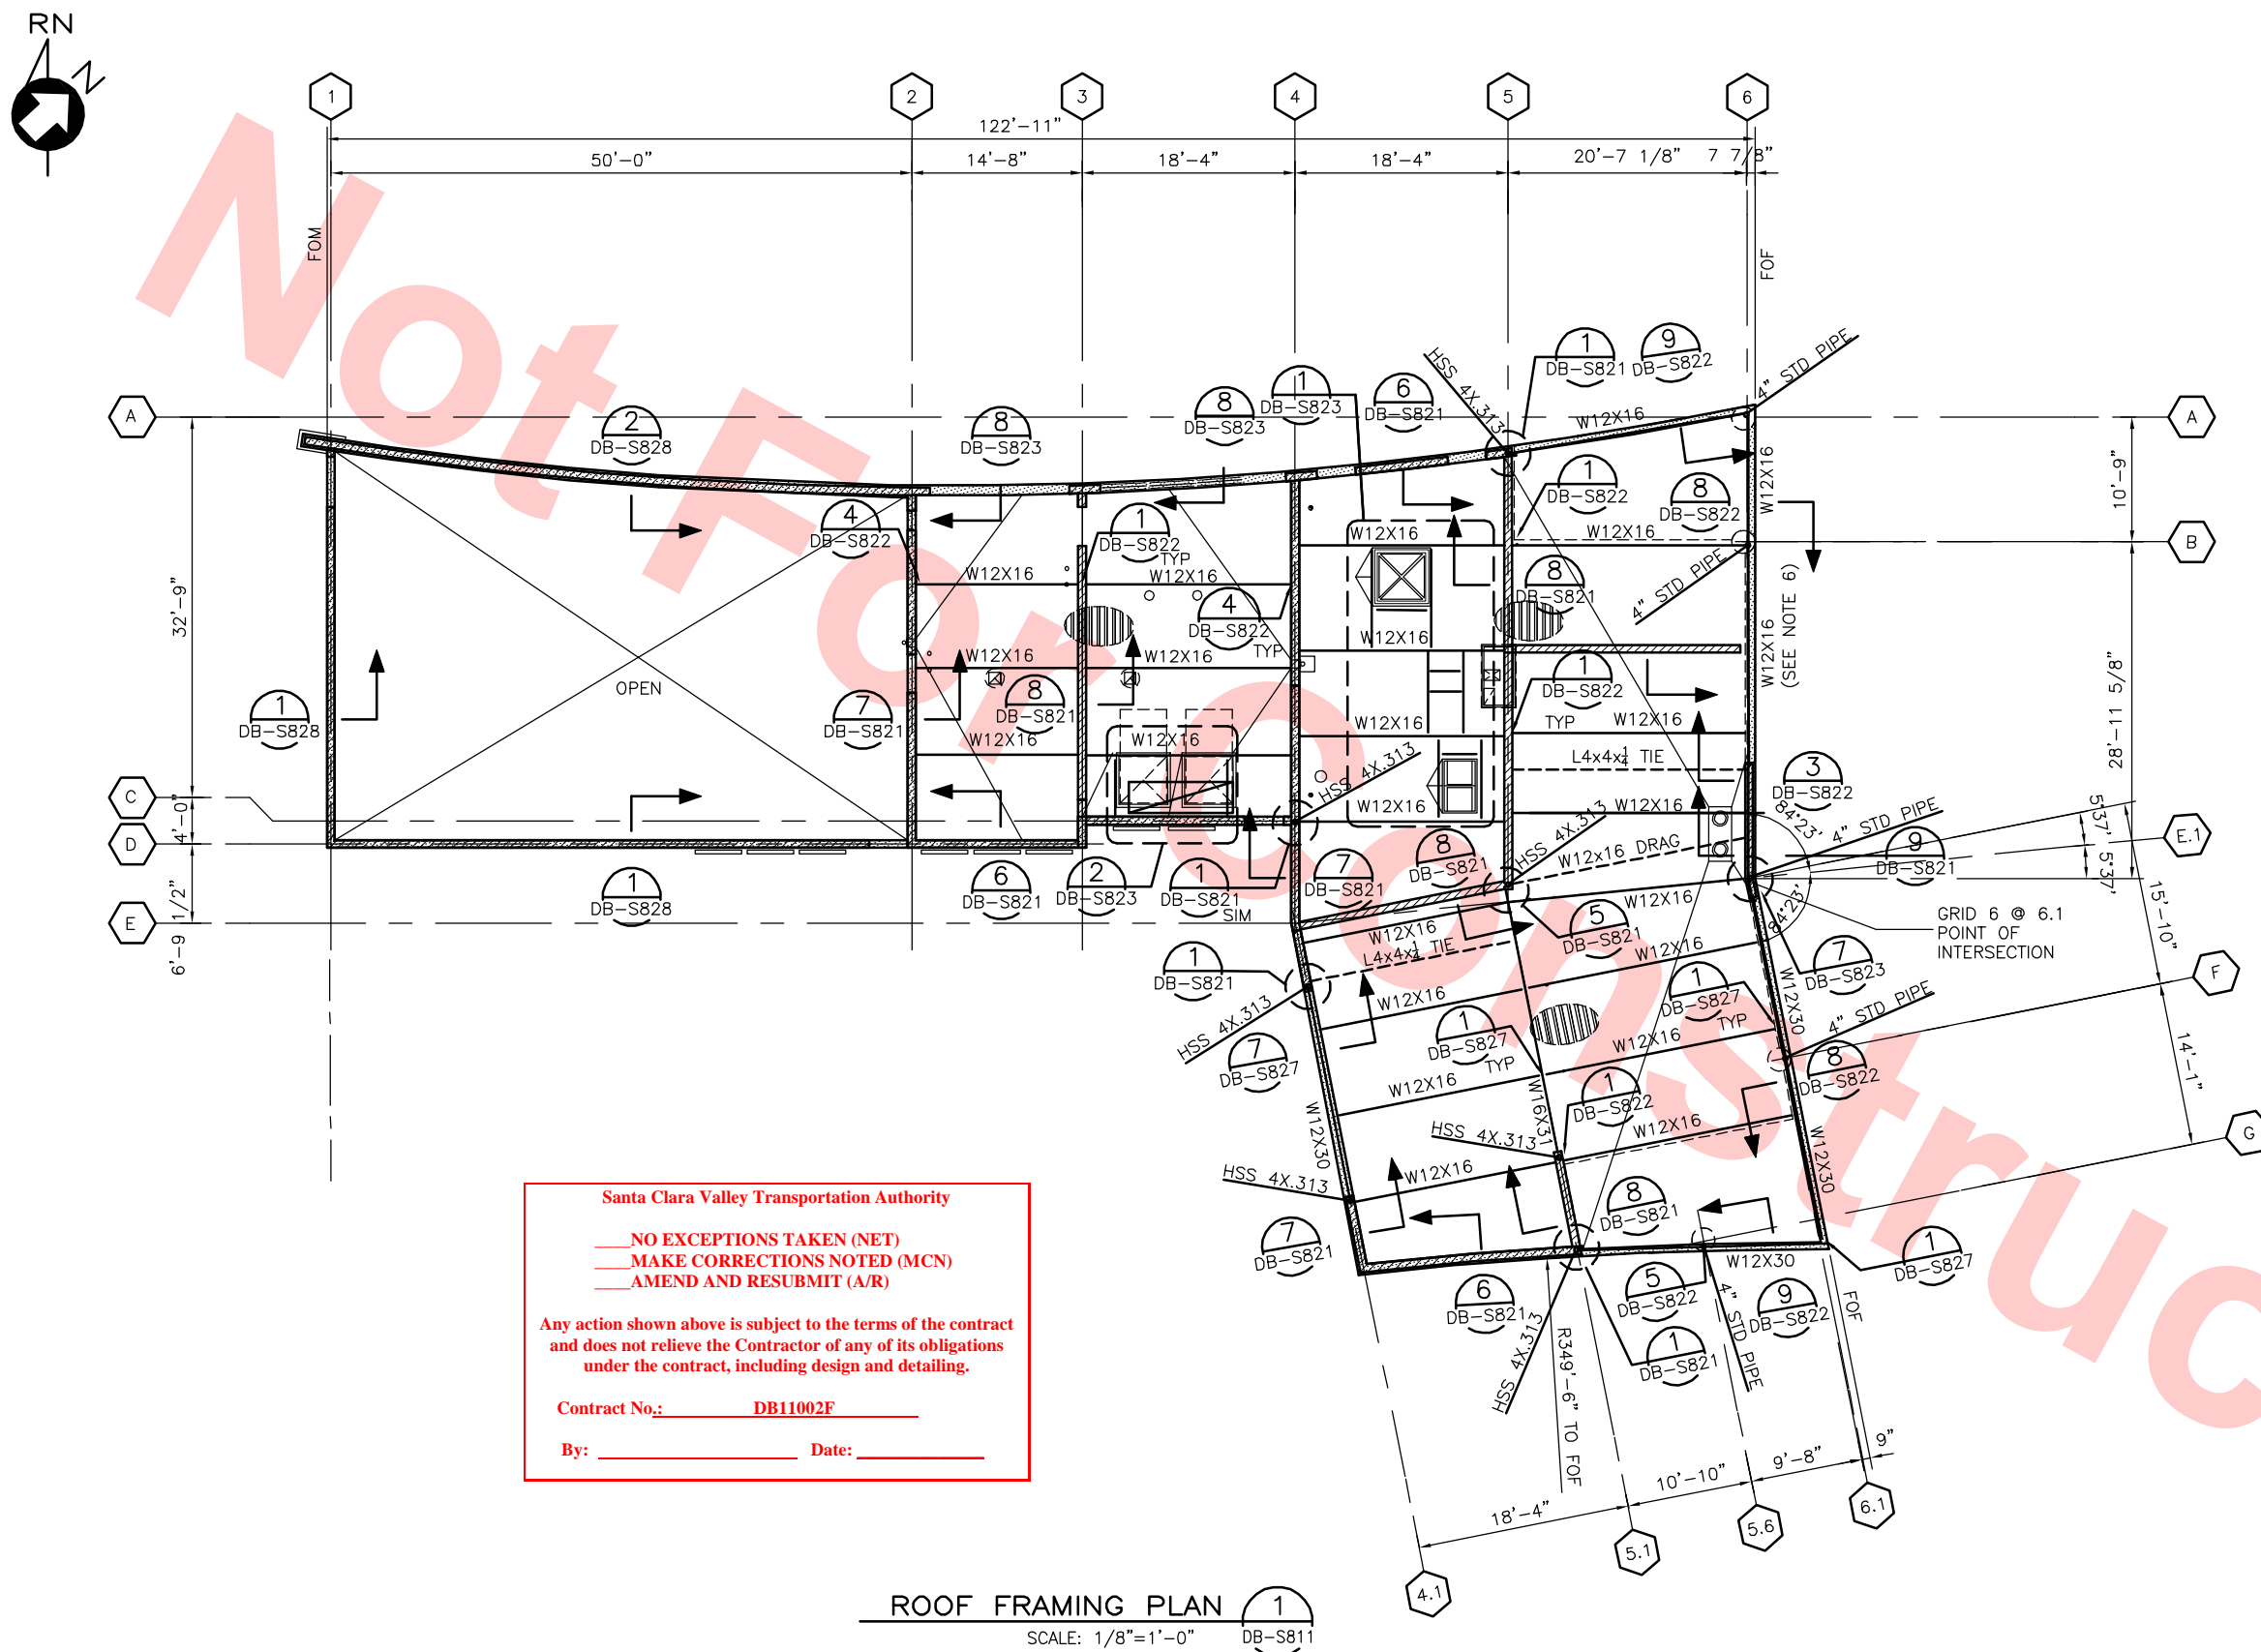




- # NOTES
1. REFER TO GENERAL NOTES, LEGEND AND ABBREVIATIONS ON SHEET DB-S003.
  2. CONTRACTOR TO VERIFY ALL DIMENSIONS & ELEVATIONS SHOWN WITH ARCH DWGS AND INFORM ARCHITECT AND/OR ENGINEER OF RECORD OF ANY DISCREPANCY.
  3. SEE ARCH DWGS FOR SIZE & LOCATION OF DECK PENETRATIONS.
  4. NO MECH EQUIP, DUCTWORK, PIPING, ETC SHALL BE HUNG FROM METAL DECKING UNLESS APPROVED BY THE ARCHITECT OR ENGINEER OF RECORD.
  5. SEE ARCH DWGS FOR EDGE OF DECK LOCATIONS.
  6. DRAG BEAM SHALL BE CONTINUOUS FROM GRID E.1 TO B

- | LEGEND  |   |
|---|---|
|  | GA 16 CORR. METAL DECK MODEL<br>"N FORMLOK" BY VERO DECKING, INC.<br>(ICC ESR-1735P) CONTINUOUS OVER<br>INTERIOR BEAMS OR SUPPORTS. |
|  | ROOF DRAIN  |

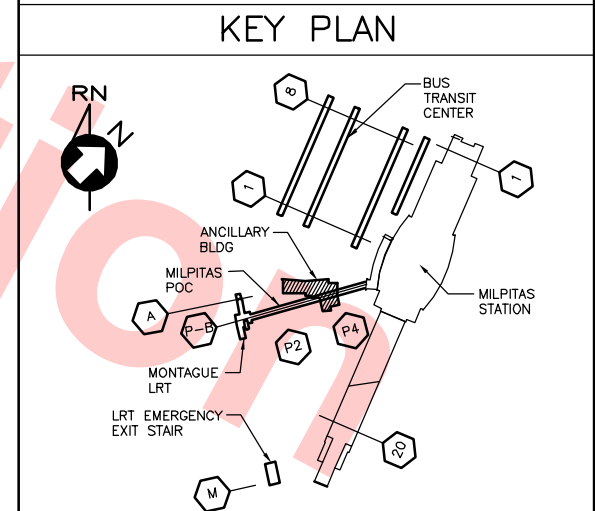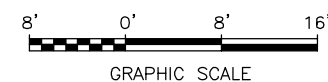
[illegible]




Jun 26, 2013 4:32pm C:\Current Projects\Bart-Berryessa Extension Project\Station - Milpitas\CAD Drawings\Out\13-0710 C700 Milpitas Station - RFC Submittal\700-S-DB-S821.dwg

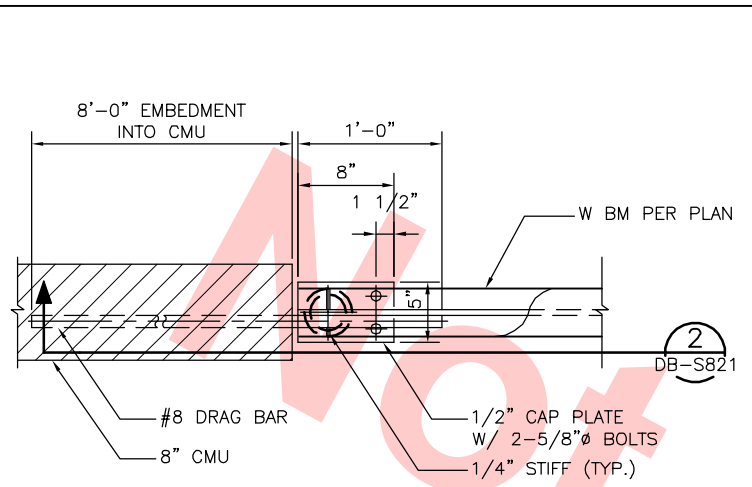

**DRAG STRUT DETAIL**  
SCALE: 1 1/2" = 1'-0"  
DB-S821

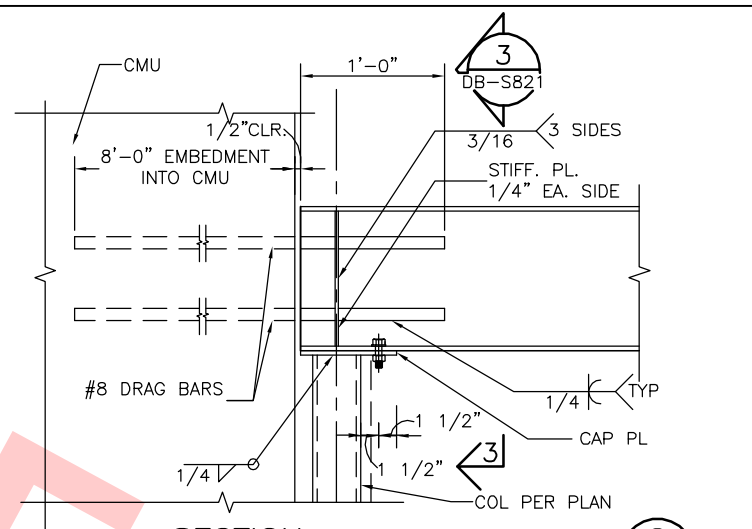


**SECTION**  
SCALE: 1 1/2" = 1'-0"  
DB-S821  
DB-S810

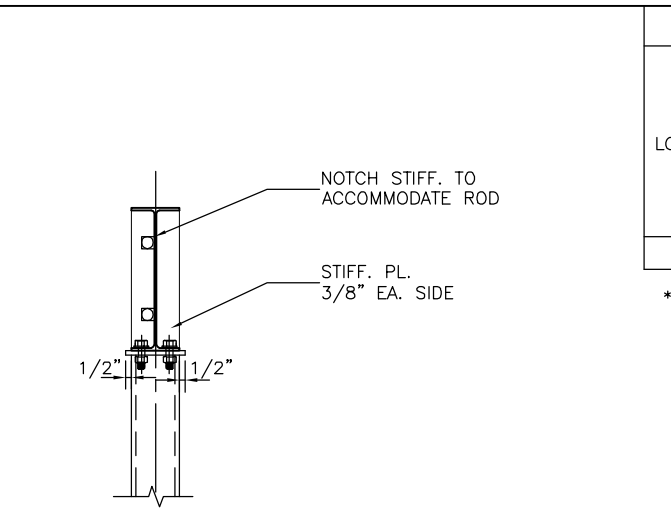


**SECTION**  
SCALE: 1 1/2" = 1'-0"  
DB-S821

METAL DECK WELDING SCHEDULE						
LOCATION	MEMBERS PERPENDICULAR TO DECK SPAN * (PUDDLE WELDS)		MEMBERS PARALLEL TO DECK SPAN * (PUDDLE WELDS)		SEAM ATTACHMENT (1-1/2 TOP SEAM WELDS)	
	EFFECTIVE DIAMETER (INCH)	NO OF WELDS PER UNIT EA SUPPORT	LOCATION (FLUTE NO PER UNIT)	EFFECTIVE DIAMETER (INCH)	SPACING (INCH)	SPACING (INCH)
ROOF	1/2	4	1,2,3,4	1/2	12	24


\* METAL DECKING SHALL BE ATTACHED TO ALL SUPPORTING FRAMING MEMBERS

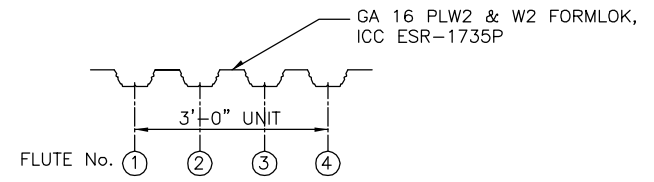

**TYP. ROOF DECK CONSTRUCTION**  
SCALE: 1 1/2" = 1'-0"  
DB-S821

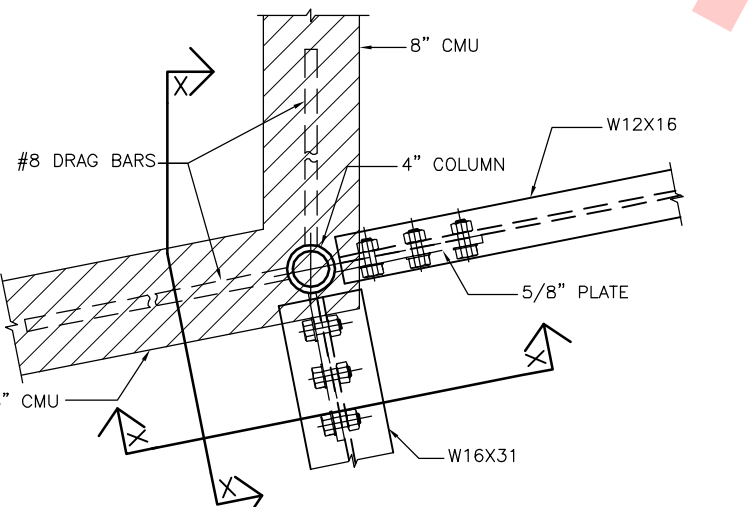


**DRAG STRUT DETAIL**  
SCALE: 1 1/2" = 1'-0"  
DB-S821  
DB-S811

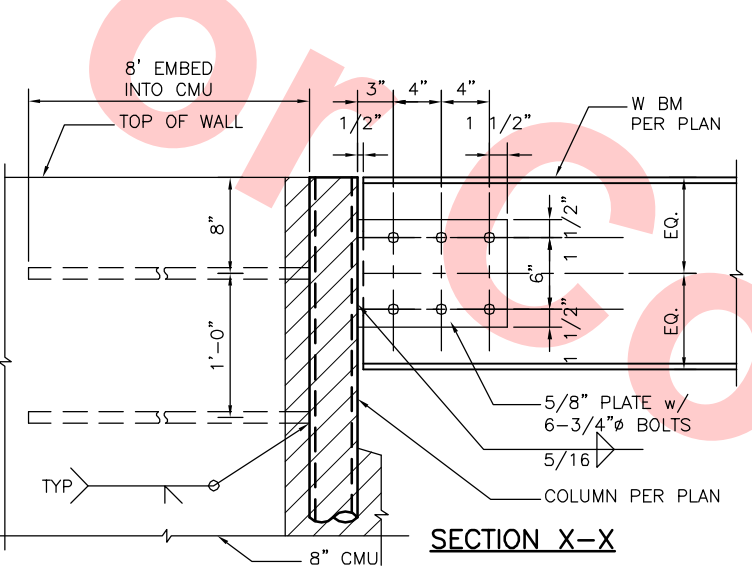


**SECTION X-X**


**Santa Clara Valley Transportation Authority**  
**NO EXCEPTIONS TAKEN (NET)**  
**MAKE CORRECTIONS NOTED (MCN)**  
**AMEND AND RESUBMIT (A/R)**  
  
Any action shown above is subject to the terms of the contract and does not relieve the Contractor of any of its obligations under the contract, including design and detailing.  
  
Contract No.: **DB11002F**  
By: \_\_\_\_\_ Date: \_\_\_\_\_

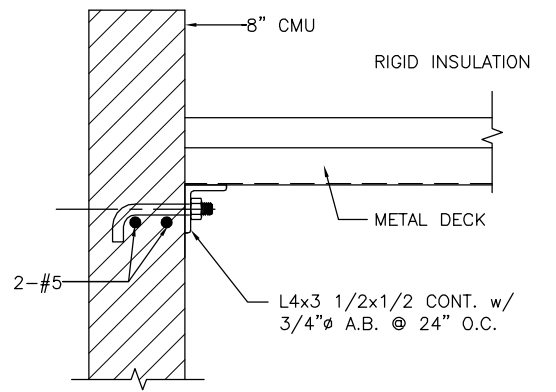


**TYPICAL DETAIL**  
SCALE: 1 1/2" = 1'-0"  
DB-S821

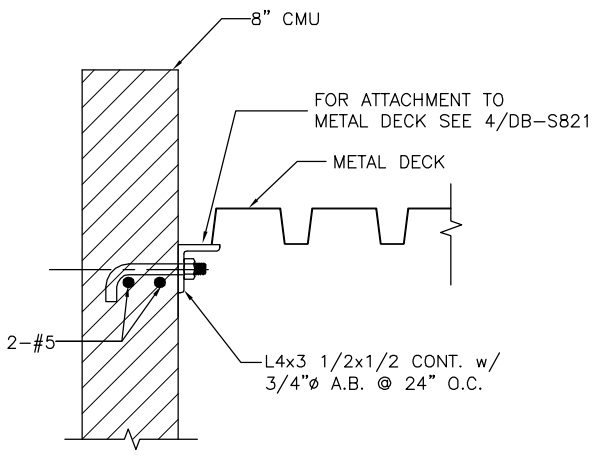


**TYPICAL DETAIL**  
SCALE: 1 1/2" = 1'-0"  
DB-S821  
DB-S811

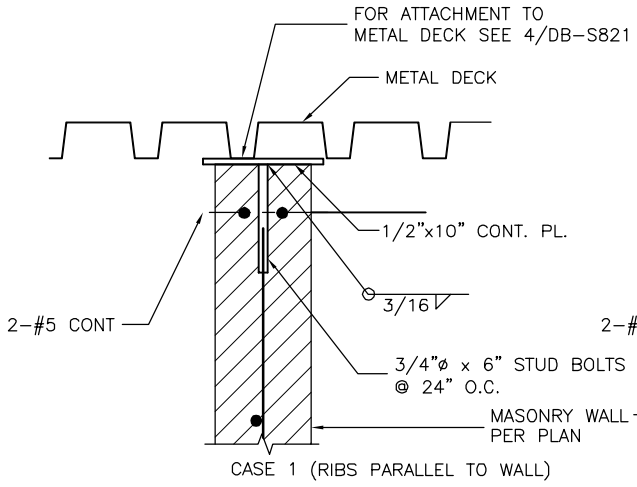

**TYPICAL MASONRY WALL TOP**  
SCALE: 1 1/2" = 1'-0"  
DB-S821

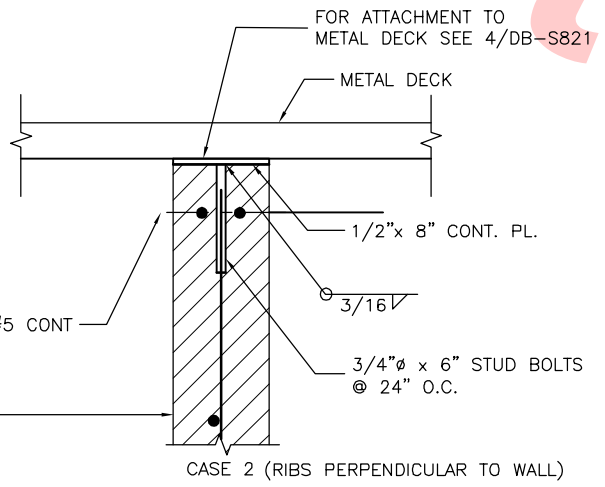


**SECTION**  
SCALE: 1 1/2" = 1'-0"  
DB-S821

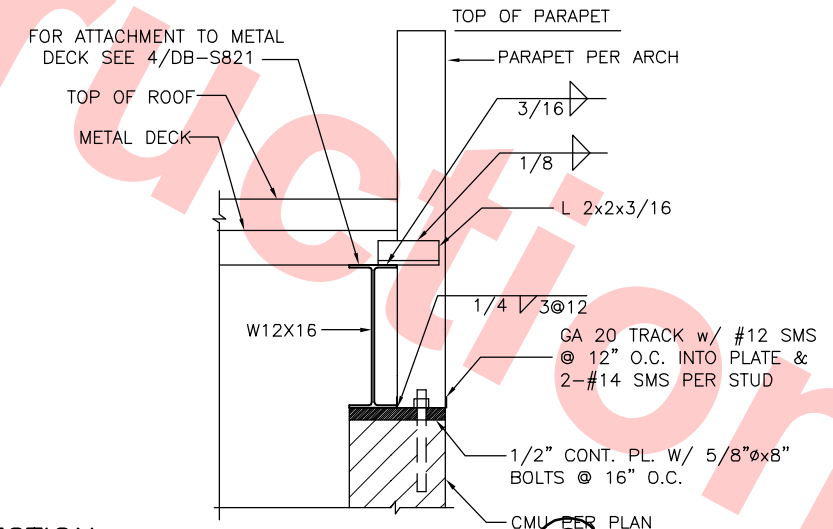

**SECTION**  
SCALE: 1 1/2" = 1'-0"  
DB-S821  
DB-S811

REV	DATE	BY	SUB	APP	DESCRIPTION
0	20130710				READINESS FOR CONSTRUCTION

DESIGNED BY  
E. MAMOYAC  
DRAWN BY  
R. COLLADO  
CHECKED BY  
S. SENGUPTA  
IN CHARGE  
R. BARLAAN  
DATE  
20130710

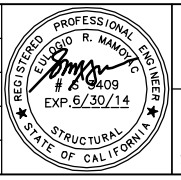

**Skanska Shimmick Herzog**  
1436 California Circle  
Milpitas, California 95035  
A Joint Venture  
**Anil Verma Associates, Inc.**  
1970 Broadway, Suite 525  
Oakland, CA 94612  
Phone: (510) 835-2537 Fax: (510) 835-2338

**Lookwood, Andrews & Newman, Inc.**  
A L&A B&N COMPANY  
**T-Y-LIN INTERNATIONAL**




**LINE, TRACK, STATIONS, AND SYSTEMS**  
**DESIGN UNIT 023**  
**ANCILLARY BUILDING**  
**MISCELLANEOUS DETAILS**

CADD FILENAME C700-S-DB-S821.dwg		
SIZE   SCALE D AS NOTED		
CONTRACT NO. C700	REV. 0	
AREA CODE DB	SHEET NO. S821	PAGE NO. 0290





SCALE: 1 1/2" = 1'-0"

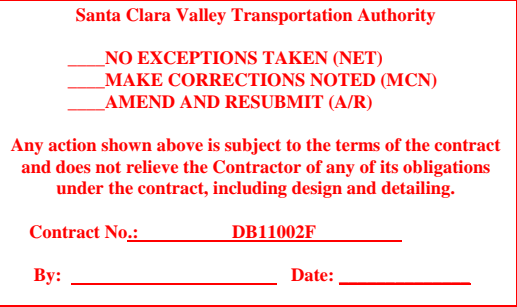

SCALE: 1 1/2" = 1'-0"



 
SCALE: 1 1/2" = 1'-0"



SCALE: 1 1/2" = 1'-0"



SCALE: 1 1/2" = 1'-0"



SCALE: 1" = 1'-0"



SCALE: 1 1/2" = 1'-0"



SCALE: 1 1/2" = 1'-0"




SCALE: 1 1/2" = 1'-0"


CADD FILENAME C700-S-DB-S822.dwg		
SIZE D	SCALE AS NOTED	
CONTRACT NO. C700		REV. 0
AREA CODE DB	SHEET NO. S822	PAGE NO. 0291




Jun 26, 2013 - 4:34pm G:\Current Projects\BART-Berryessa Extension Project\Station - Milpitas\CAD Drawings Out\13-0710 C700 Milpitas Station - RFG Submit\700-S-DB-S823.dwg

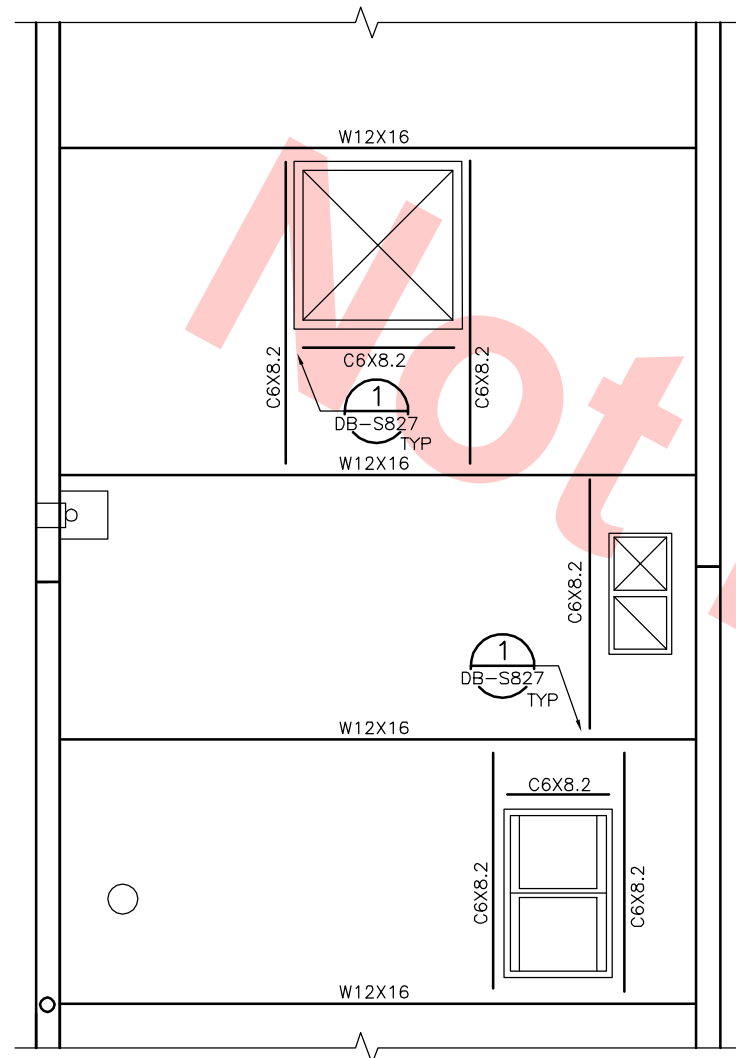


**INTERIOR ROOF OPENING**  
SCALE: 3/8" = 1'-0"  
DB-S823

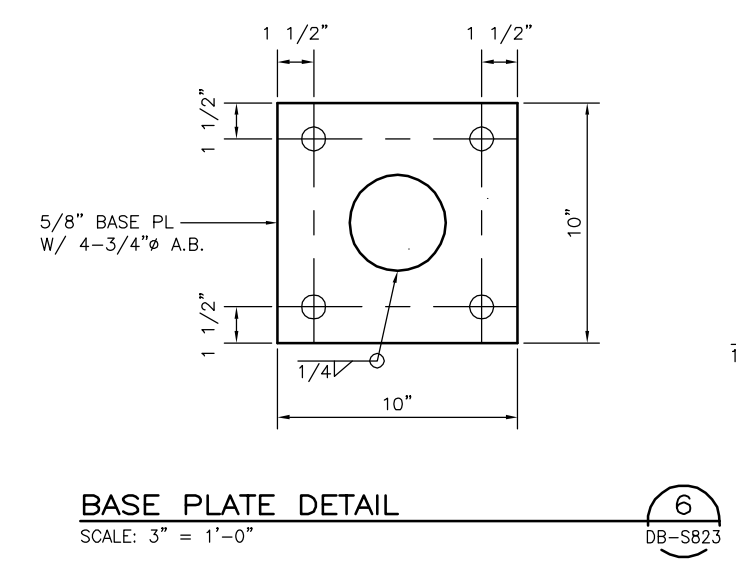


**BASE PLATE DETAIL**  
SCALE: 3" = 1'-0"  
DB-S823

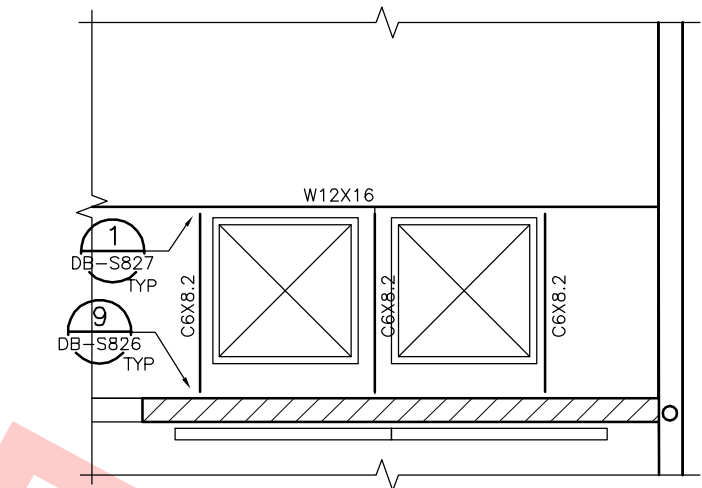


**ROOF OPENING AT OR NEAR CMU WALL**  
SCALE: 3/8" = 1'-0"  
DB-S823

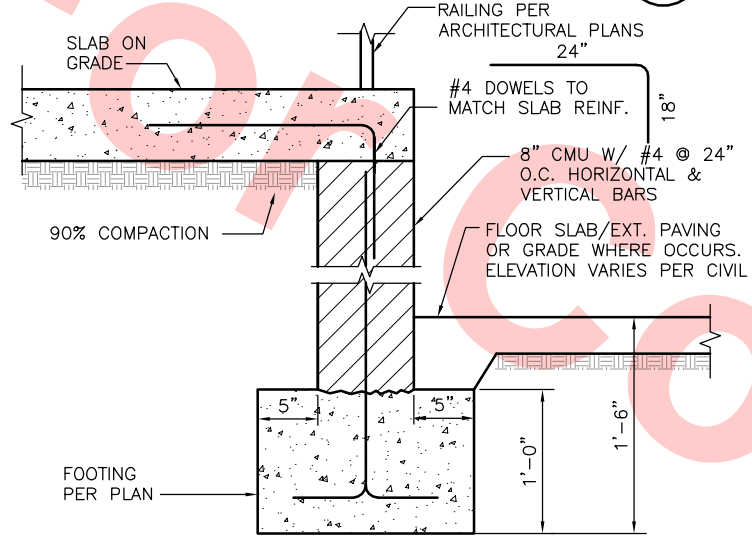


**DETAIL**  
SCALE: 1 1/2" = 1'-0"  
DB-S823

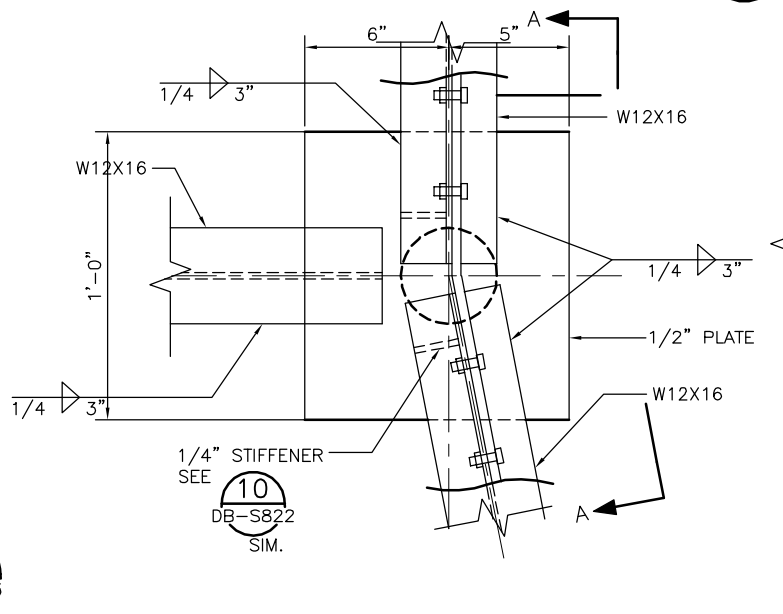


**SECTION A-A**  
SCALE: 3" = 1'-0"  
DB-S823

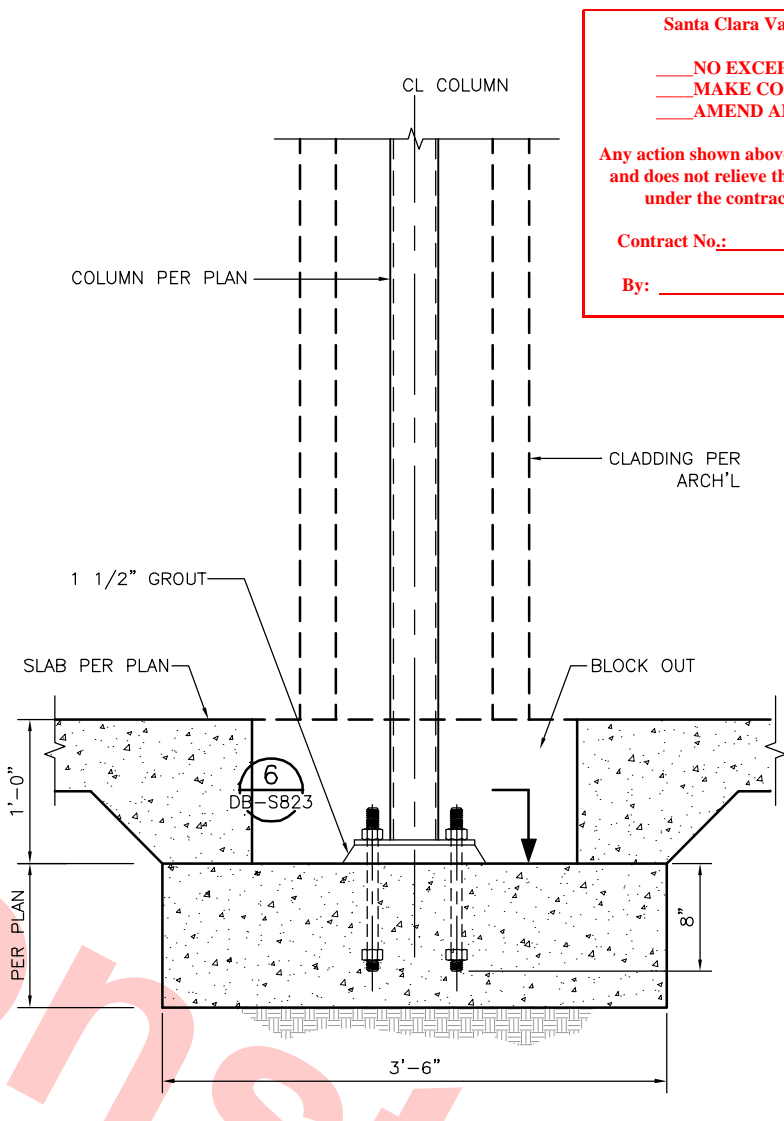


**TYPICAL COLUMN DETAIL**  
SCALE: 1 1/2" = 1'-0"  
DB-S823

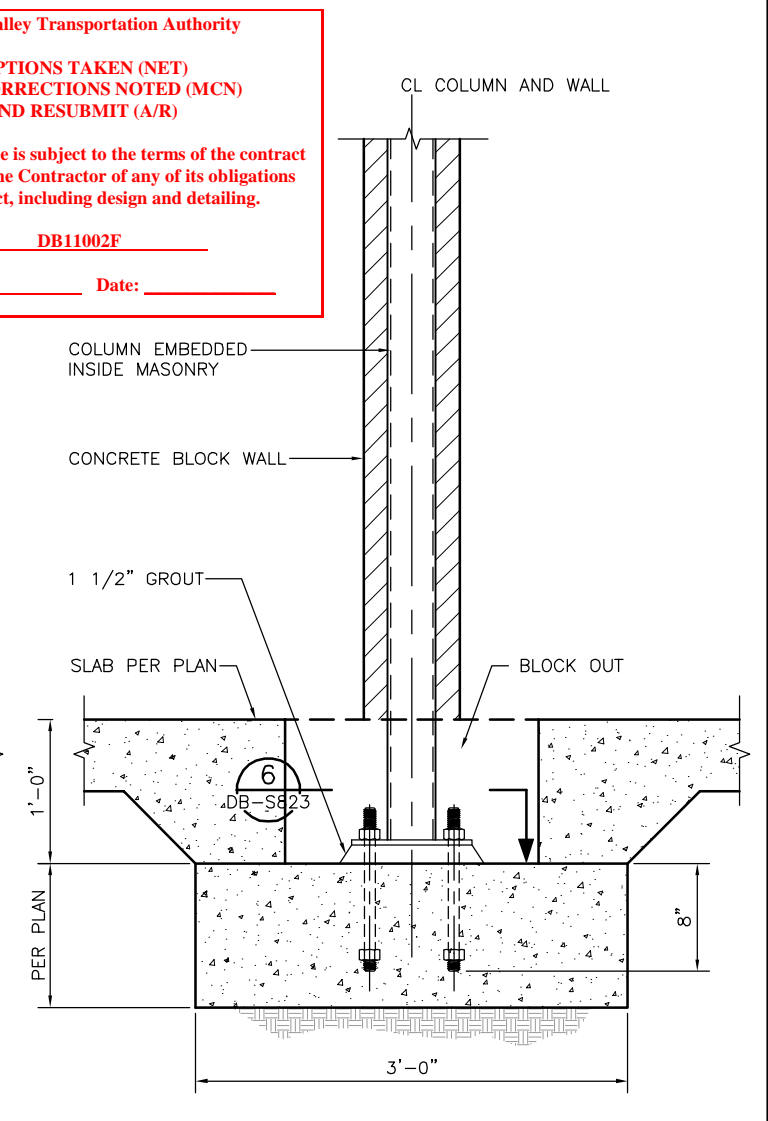

**TYPICAL COLUMN INSIDE MASONRY**  
SCALE: 1 1/2" = 1'-0"  
DB-S823

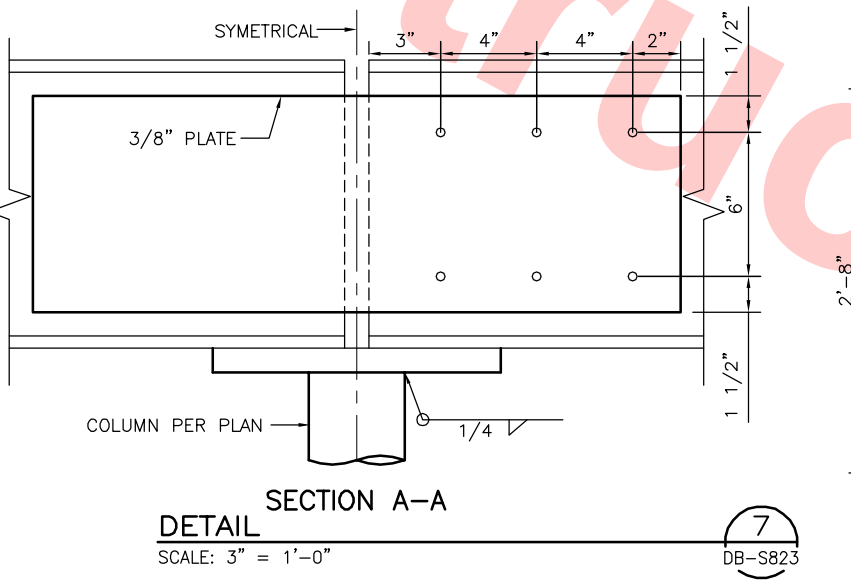

**SECTION A-A**  
SCALE: 3" = 1'-0"  
DB-S823

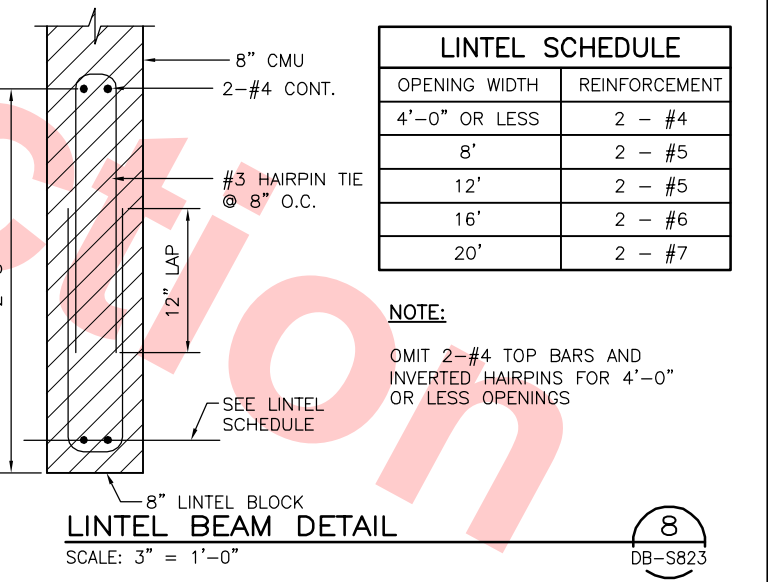

**LINTEL BEAM DETAIL**  
SCALE: 3" = 1'-0"  
DB-S823


LINTEL SCHEDULE	
OPENING WIDTH	REINFORCEMENT
4'-0" OR LESS	2 - #4
8'	2 - #5
12'	2 - #5
16'	2 - #6
20'	2 - #7

**NOTE:**  
OMIT 2-#4 TOP BARS AND INVERTED HAIRPINS FOR 4'-0" OR LESS OPENINGS

Santa Clara Valley Transportation Authority  
NO EXCEPTIONS TAKEN (NET)  
MAKE CORRECTIONS NOTED (MCN)  
AMEND AND RESUBMIT (A/R)  
Any action shown above is subject to the terms of the contract and does not relieve the Contractor of any of its obligations under the contract, including design and detailing.  
Contract No.: DB11002F  
By: \_\_\_\_\_ Date: \_\_\_\_\_


REV	DATE	BY	SUB	APP	DESCRIPTION
0	20130710				READINESS FOR CONSTRUCTION

DESIGNED BY  
E. MAMOYAC  
DRAWN BY  
P. NG  
CHECKED BY  
S. SENGUPTA  
IN CHARGE  
R. BARLAAN  
DATE  
20130710

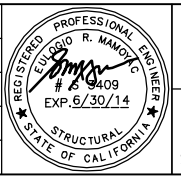

Skanska  
Shimmick  
Herzog  
Anil Verma Associates, Inc.  
1970 Broadway, Suite 525  
Oakland, CA 94612  
Phone: (510) 835-2537 Fax: (510) 535-2338


1436 California Circle  
Milpitas, California 95035  
A Joint Venture  
Lookwood, Andrews & Newman, Inc.  
T-Y-LIN INTERNATIONAL

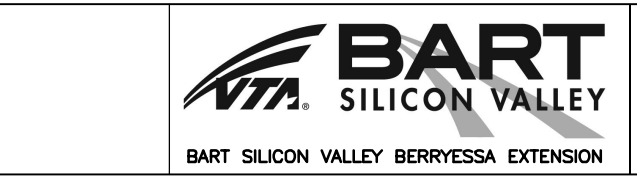

LINE, TRACK, STATIONS, AND SYSTEMS  
DESIGN UNIT 023  
ANCILLARY BUILDING  
MISCELLANEOUS DETAILS

CADD FILENAME C700-S-DB-S823.dwg		
SIZE	SCALE	AS NOTED
CONTRACT NO.	C700	REV. 0
AREA CODE	DB	SHEET NO. S823
		PAGE NO. 0292




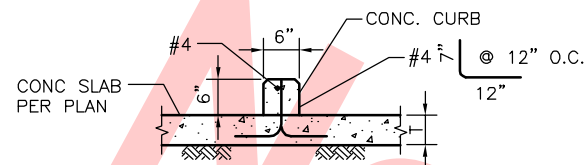

**CONCRETE CURB**

SCALE: 3/4" = 1'-0"


1  
DB-S824

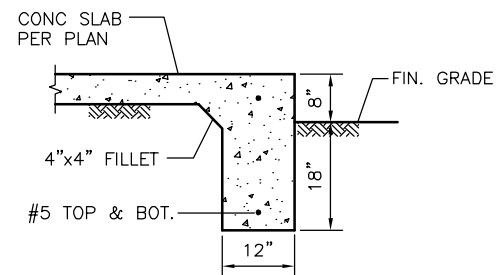

**DETAIL**

SCALE: 3/4" = 1'-0"


2  
DB-S824

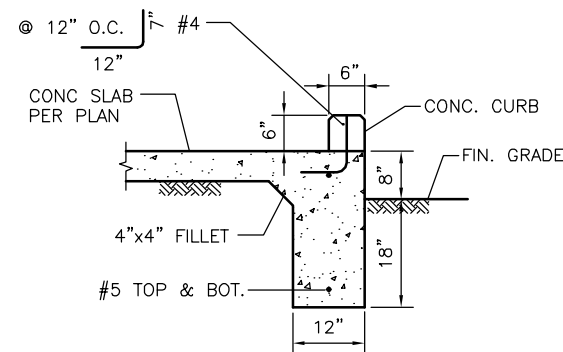

**DETAIL**

SCALE: 3/4" = 1'-0"


3  
DB-S824

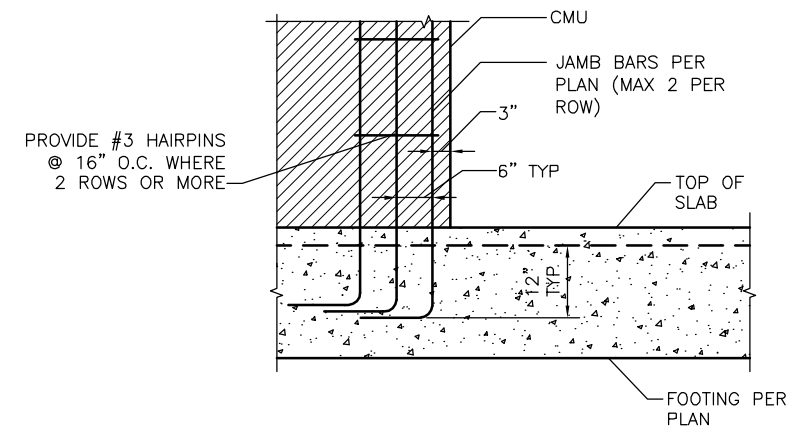

**JAMB BAR DETAIL**

SCALE: 3/4" = 1'-0"


4  
DB-S824

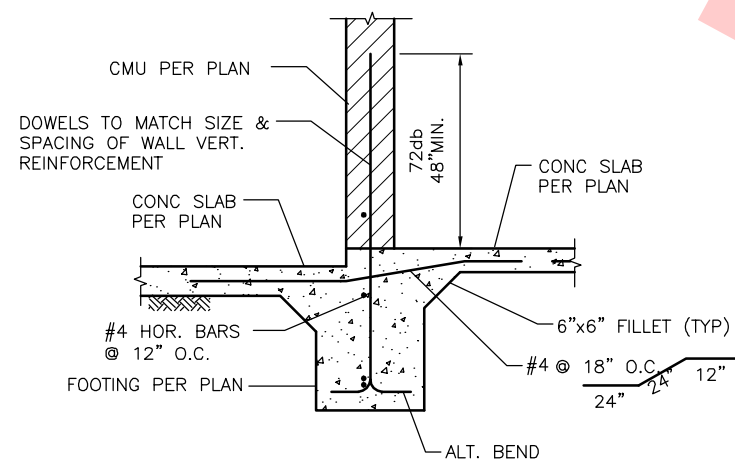

**INTERIOR WALL FOOTING DETAIL**

SCALE: 3/4" = 1'-0"


5  
DB-S824

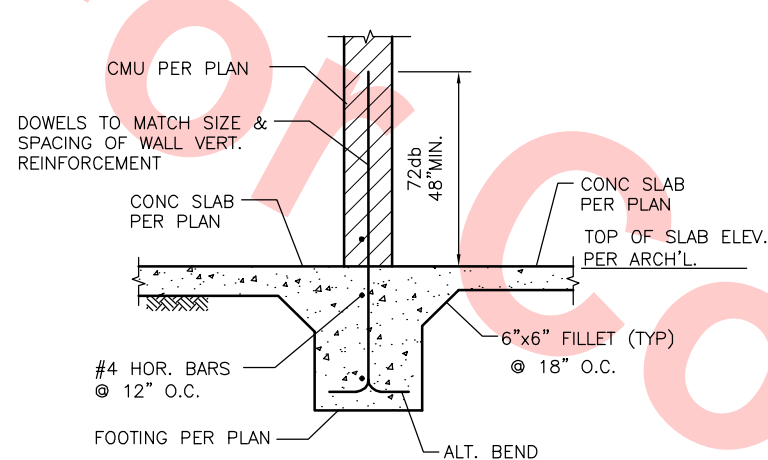

**INTERIOR WALL FOOTING DETAIL**

SCALE: 3/4" = 1'-0"


6  
DB-S824

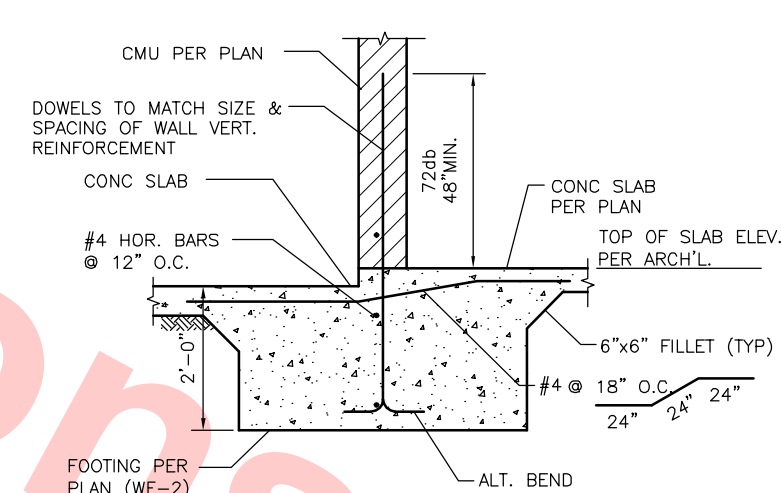

**INTERIOR WALL FOOTING DETAIL AT SHEAR WALL**

SCALE: 3/4" = 1'-0"


7  
DB-S824

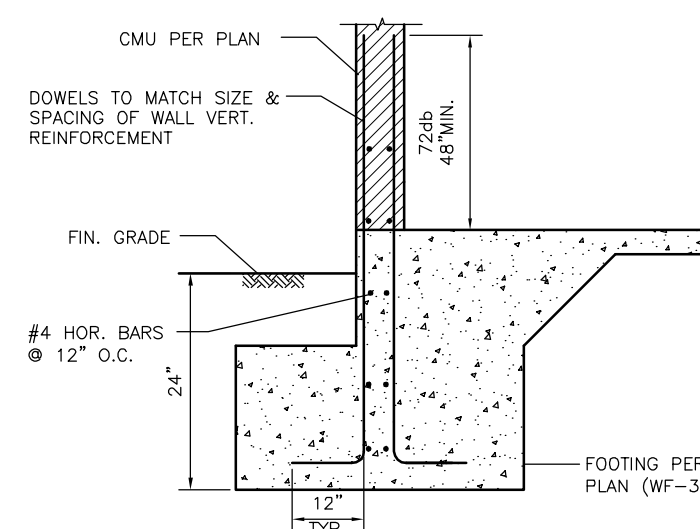

**EXTERIOR WALL FOOTING DETAIL**

SCALE: 3/4" = 1'-0"


8  
DB-S824

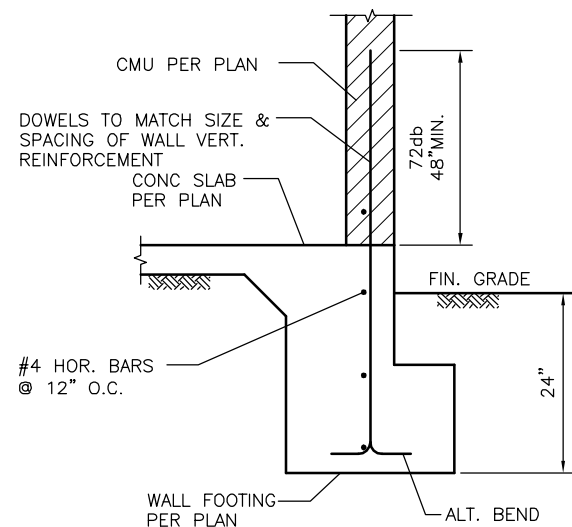

**EXTERIOR WALL FOOTING DETAIL**

SCALE: 3/4" = 1'-0"


9  
DB-S824

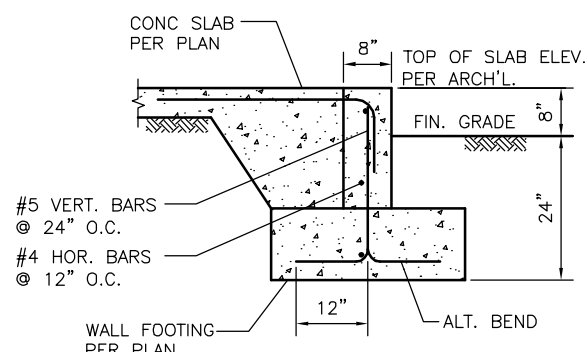

**EXTERIOR WALL FOOTING DETAIL**

SCALE: 3/4" = 1'-0"

10  
DB-S824

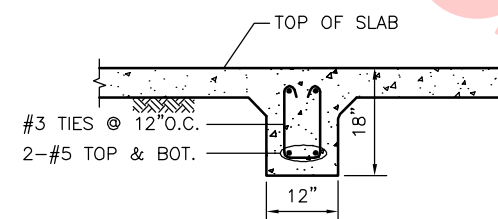

**TIE BEAM**

SCALE: 3/4" = 1'-0"

11  
DB-S824

**Santa Clara Valley Transportation Authority**

**NO EXCEPTIONS TAKEN (NET)  
MAKE CORRECTIONS NOTED (MCN)  
AMEND AND RESUBMIT (A/R)**

**Any action shown above is subject to the terms of the contract and does not relieve the Contractor of any of its obligations under the contract, including design and detailing.**


**Contract No.: DB11002F**

**By: \_\_\_\_\_ Date: \_\_\_\_\_**

Jun 26, 2013 4:34pm C:\Current Projects\Berrysa Extension Project\Station - Milpitas\CAD Drawings Out\13-0710 C700 Milpitas Station - RFC Submit\700-S-DB-S824.dwg

REV	DATE	BY	SUB	APP	DESCRIPTION
0	20130710				READINESS FOR CONSTRUCTION

DESIGNED BY  
E. MAMOYAC  
DRAWN BY  
S. DE GUZMAN  
CHECKED BY  
S. SENGUPTA  
IN CHARGE  
R. BARLAAN  
DATE  
20130710

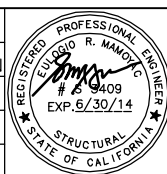

**Skanska Shimmick Herzog**  
1436 California Circle  
Milpitas, California 95035  
A Joint Venture  
**Anil Verma Associates, Inc.**  
1970 Broadway, Suite 525  
Oakland, CA 94612  
Phone: (510) 835-2537 Fax: (510) 835-2338





**Lookwood, Andrews & Newman, Inc.**  
A LEO A DALY COMPANY  
**T-Y-LIN INTERNATIONAL**

**BART SILICON VALLEY**  
BART SILICON VALLEY BERRYESSA EXTENSION

**LINE, TRACK, STATIONS, AND SYSTEMS  
DESIGN UNIT 023  
ANCILLARY BUILDING  
MISCELLANEOUS DETAILS**

CADD FILENAME C700-S-DB-S824.dwg	SIZE D	SCALE 3/4"=1'-0"
CONTRACT NO. C700	SHEET NO. S824	REV. 0
AREA CODE DB	PAGE NO. 0293	








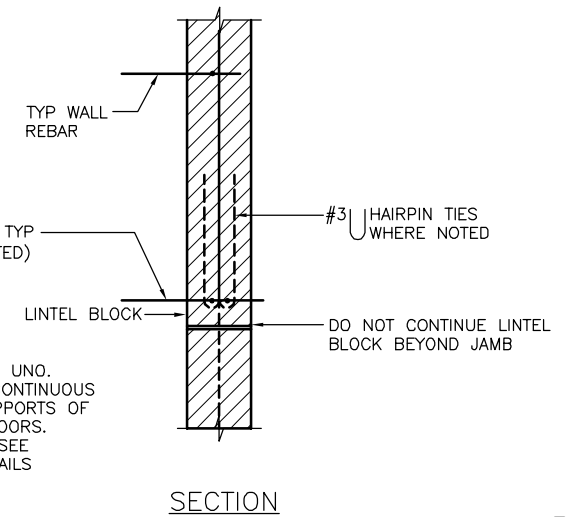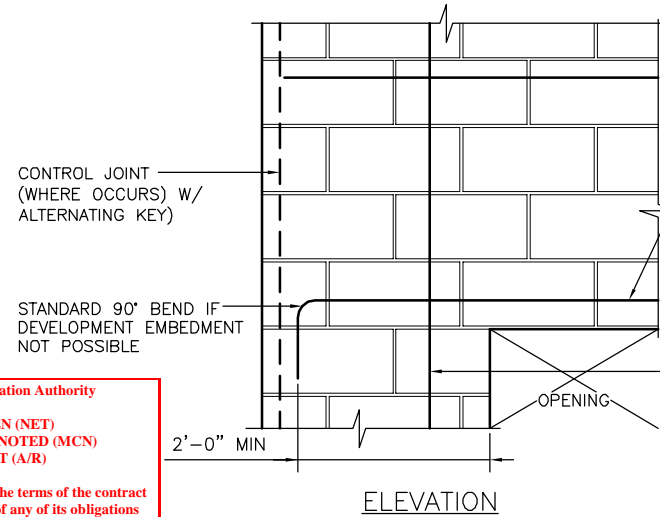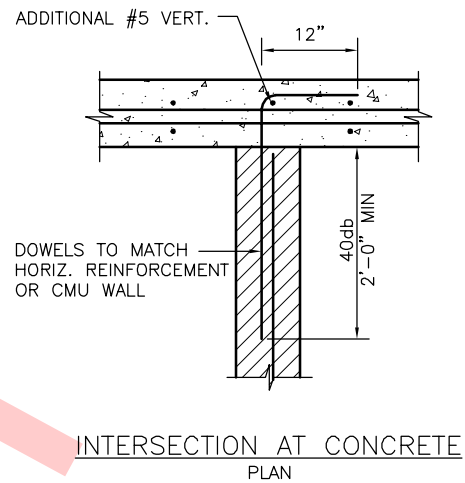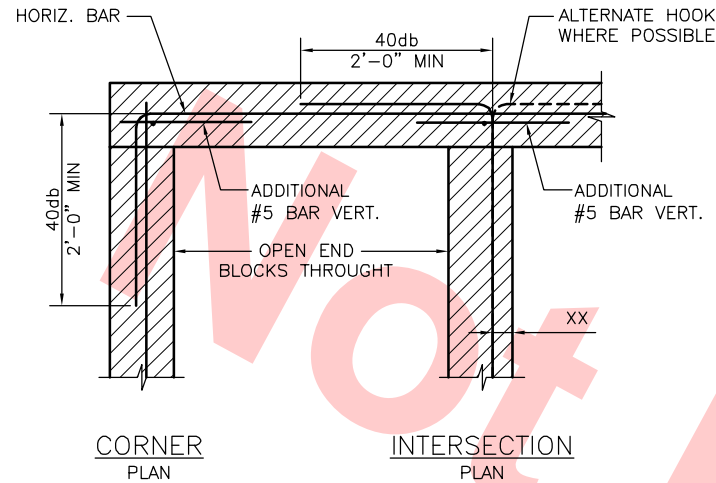

REBAR AT CMU WALL OPENING DETAIL (2)  
SCALE: 1"=1'-0" DB-S825





**NOTE:**

PLACE VERT. REBAR AT CENTER LINE OF WALL UNLESS NOTED OTHERWISE (UNO)

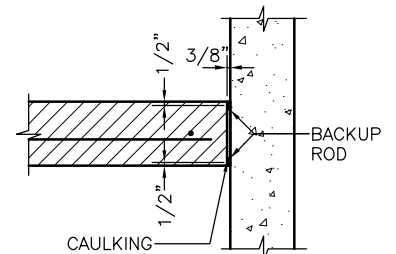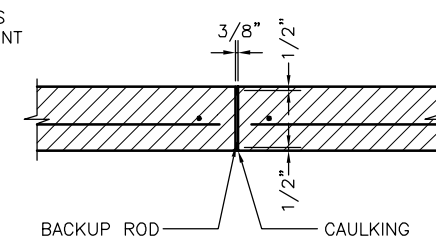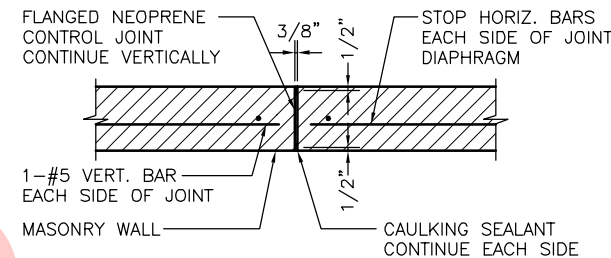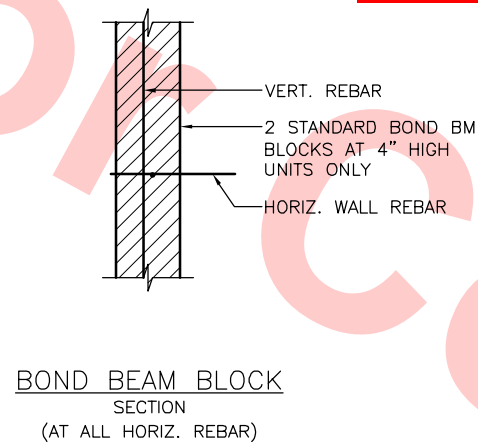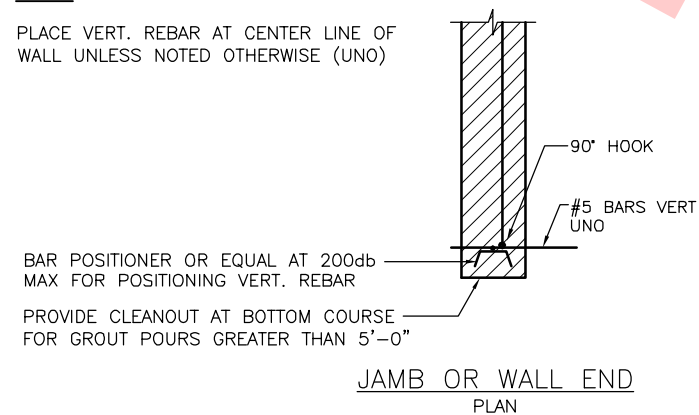

CONCRETE BLOCK WALL DETAILS (1)  
SCALE: 1"=1'-0" DB-S825

MASONRY CONTROL JOINT DETAILS (3)  
SCALE: 1"=1'-0" DB-S825

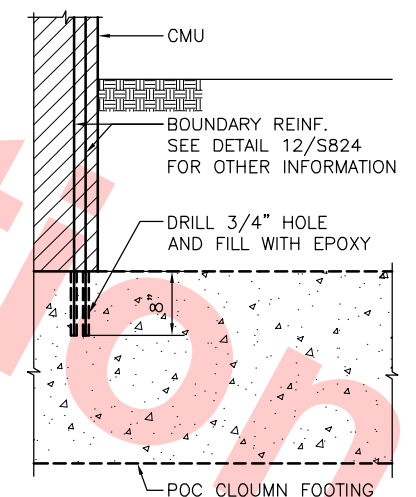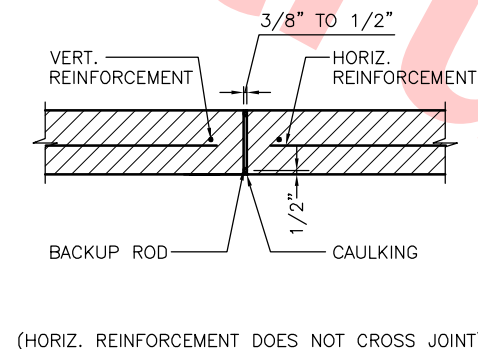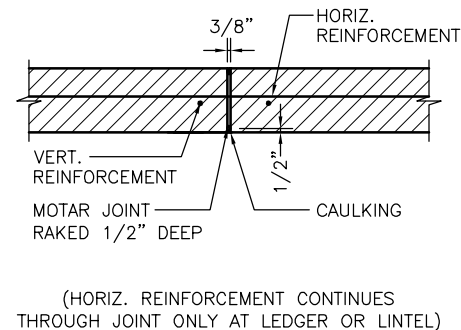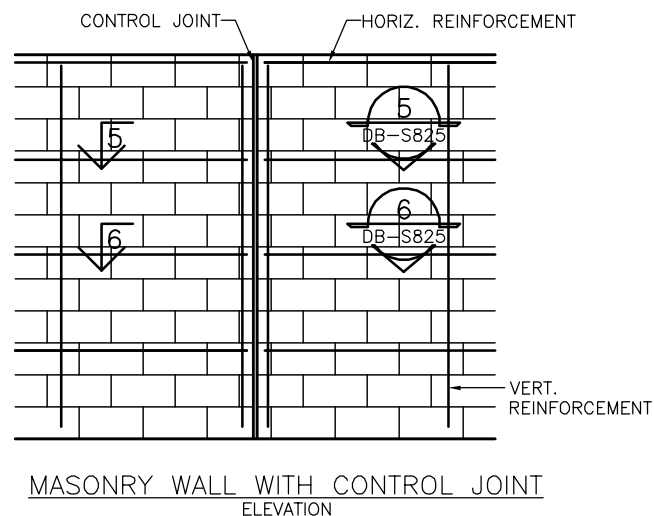

CONTROL JOINT DETAIL (4)  
SCALE: 1/2"=1'-0" DB-S825

SECTION (5)  
SCALE: 1"=1'-0" DB-S825


SECTION (6)  
SCALE: 1"=1'-0" DB-S825

BOUNDARY BARS ON EXIST. CONC. (7)  
SCALE: 1"=1'-0" DB-S825

Jun 26, 2013 4:35pm C:\Current Projects\Bart-Berryessa Extension Project\Station - Milpitas\CAD Drawings Out\13-0710 C700 Milpitas Station - RFC Submit\C700-S-DB-S825.dwg

REV	DATE	BY	SUB	APP	DESCRIPTION
0	20130710				READINESS FOR CONSTRUCTION

DESIGNED BY  
E. MAMOYAC  
DRAWN BY  
P. NG  
CHECKED BY  
S. SENGUPTA  
IN CHARGE  
R. BARLAAN  
DATE  
20130710

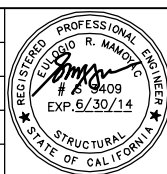

Skanska  
Shimmick  
Herzog  
Anil Verma Associates, Inc.  
1970 Broadway, Suite 525  
Milpitas, California 95035  
Phone: (510) 835-2537 Fax: (810) 535-2338

1436 California Circle  
Milpitas, California 95035  
A Joint Venture  
Lookwood, Andrews & Newman, Inc.  
T-Y-LIN INTERNATIONAL  
APPROVED


**BART**  
VTA SILICON VALLEY  
BART SILICON VALLEY BERRYESSA EXTENSION

LINE, TRACK, STATIONS, AND SYSTEMS  
DESIGN UNIT 023  
ANCILLARY BUILDING  
MISCELLANEOUS DETAILS

CADD FILENAME C700-S-DB-S825.dwg	SIZE D	SCALE AS NOTED
CONTRACT NO. C700	SHEET NO. S825	REV. 0
AREA CODE DB	PAGE NO. 0294	



BOLT DIAMETER	VERT BOLT EMBEDMENT LENGTH	HORIZ BOLT EMBEDMENT LENGTH	HEADED STUD FILLET WELD SIZE, "S".
1/2"	6"	4"	1/4"
5/8"	6"	4"	5/16"
3/4"	7"	5"	5/16"
7/8"	8"	6"	5/16"
1"	9"	7"	3/8"
1 1/8"	10"	8"	---
1 1/4"	11"	9"	---

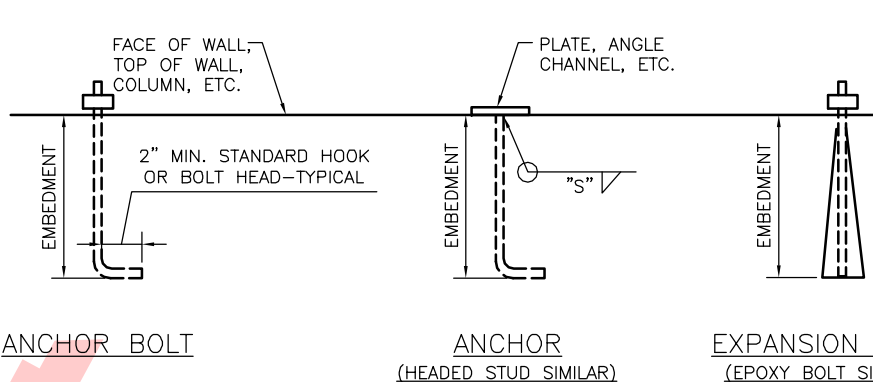



Santa Clara Valley Transportation Authority

NO EXCEPTIONS TAKEN (NET)  
MAKE CORRECTIONS NOTED (MCN)  
AMEND AND RESUBMIT (A/R)


Any action shown above is subject to the terms of the contract and does not relieve the Contractor of any of its obligations under the contract, including design and detailing.

Contract No: DB11002F

By: \_\_\_\_\_ Date: \_\_\_\_\_

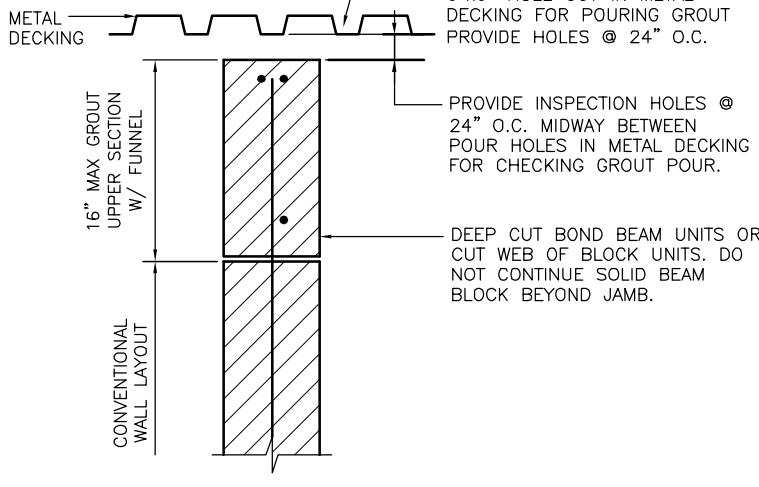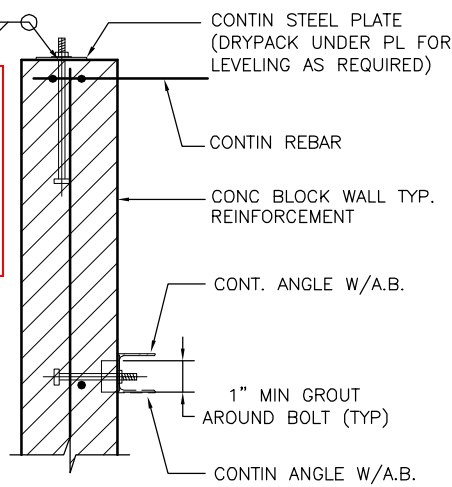

- NOTES:
1. PROVIDE ANCHORS, ANCHOR BOLTS AND EXPANSION BOLTS PER THIS SCHEDULE UNLESS NOTED ON PLANS OR DETAILS.
  2. EXPANSION OR ADHESIVE BOLTS USED IN MASONRY SHALL HAVE I.C.C APPROVAL IN MASONRY.
  3. AT "ANCHORS" USE 3/16" FILLET WELD("S").
  4. THICKNESS OF DRYPACK DOES NOT APPLY TOWARDS EMBEDMENT.

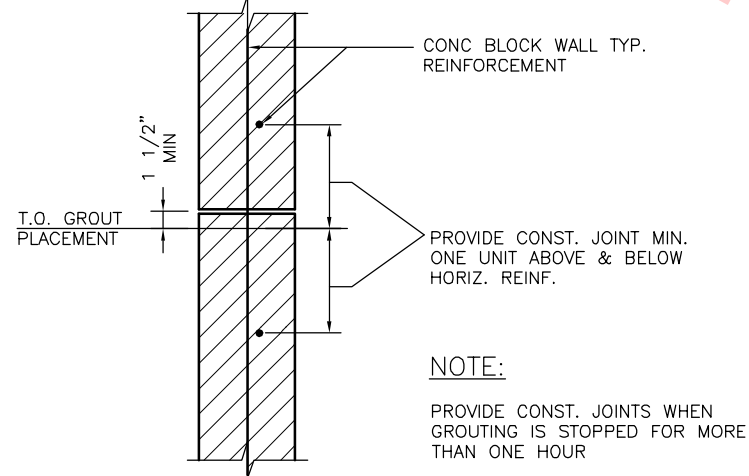

TYP. ANCHOR, ANCHOR BOLT & EXPANSION BOLT SCEDULE (UNO)


SCALE: NTS

ANCHOR BOLTS AT BLOCK WALLS

SCALE: 1 1/2"=1'-0"


GROUT POUR AT TOP OF WALL

SCALE: 1 1/2"=1'-0"

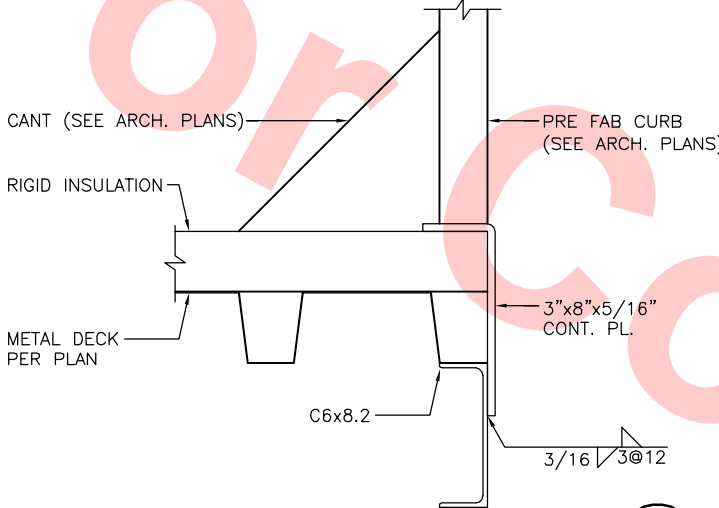


DETAIL

SCALE: 3"=1'-0"

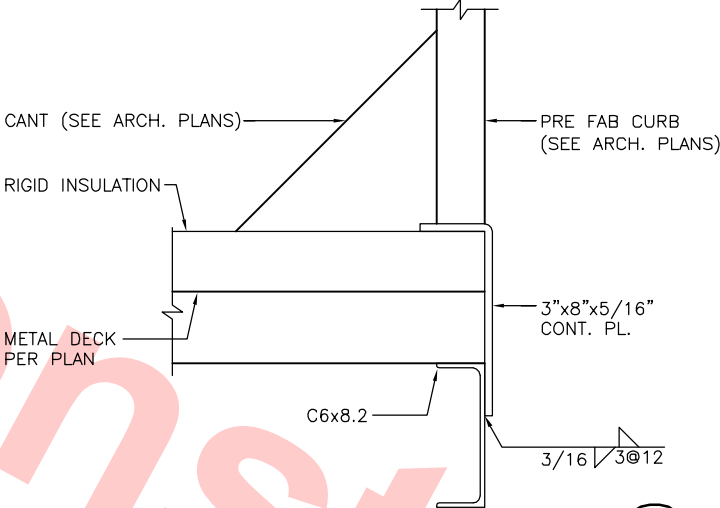

DETAIL

SCALE: 3"=1'-0"

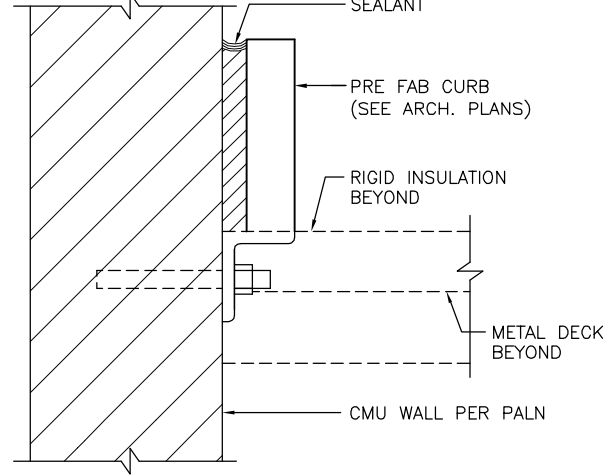


DETAIL

SCALE: 3"=1'-0"


TYPICAL HORIZ. CONSTRUCTION JOINT

SCALE: 1 1/2"=1'-0"

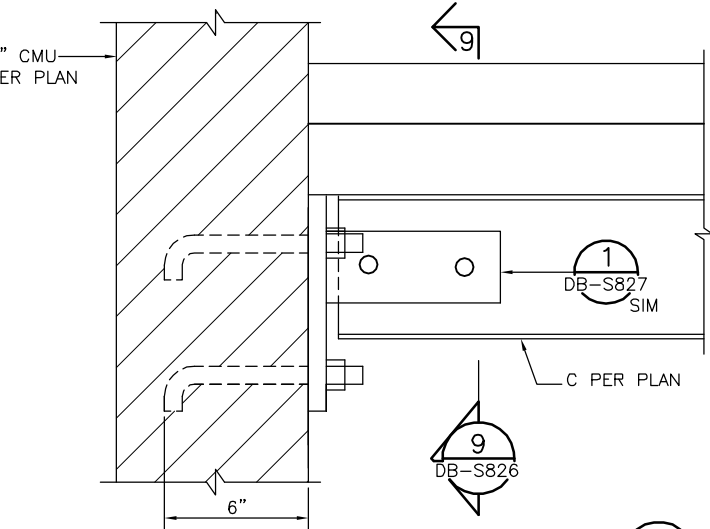


DETAIL

SCALE: 3"=1'-0"

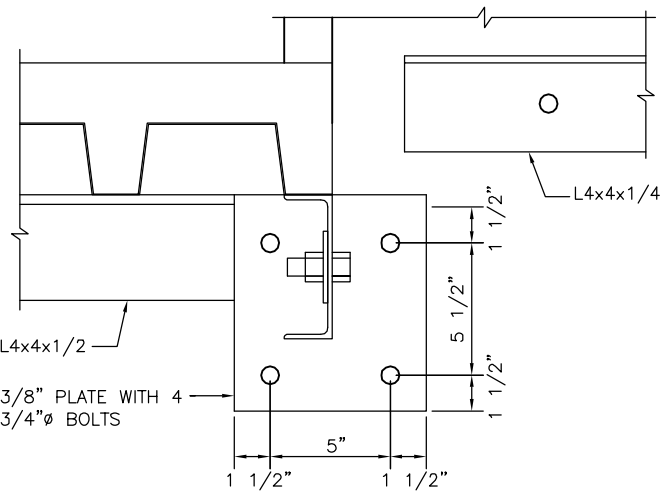


SECTION

SCALE: 3"=1'-0"

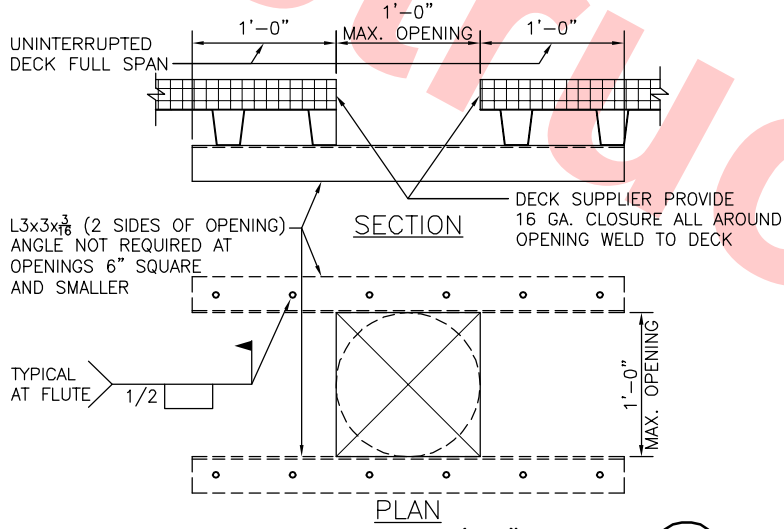

OPENING IN ROOF UP TO 1'-0" SQUARE

SCALE: 1 1/2"=1'-0"

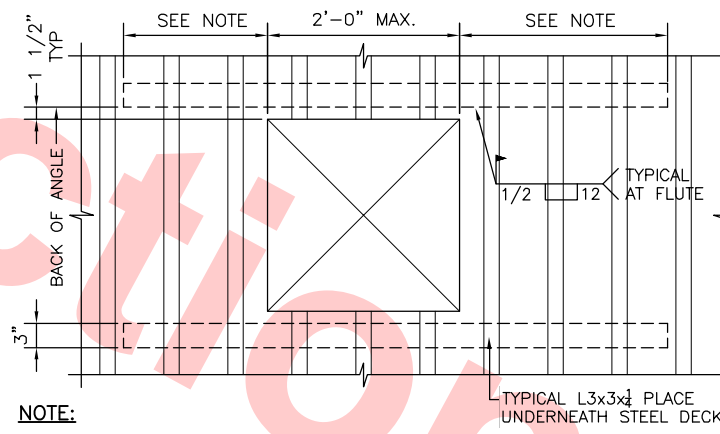

NOTE:

LENGTH OF TUBE OR ANGLE IS DETERMINED BY THE NUMBER OF WELDS PROVIDED AT BEARING FLUTES PAST EDGE OF OPENING. PROVIDE THE MINIMUM NUMBER OF WELDS PAST THE EDGE OF OPENINGS AS FOLLOWS  
A. 3" DECK.....2 WELDS / B. 1 1/2" AND 2" DECK.....3 WELDS

OPENING IN ROOF (1'-0" - 2'-0" MAX.)

SCALE: 1"=1'-0"

Jun 26, 2013 4:36pm C:\Current Projects\BART-Berryessa Extension Project\Station - Milpitas\CAD Drawings Out\13-0710 C700 Milpitas Station - RFC Submit\C700-S-DB-S826.dwg

REV	DATE	BY	SUB	APP	DESCRIPTION
0	20130710				READINESS FOR CONSTRUCTION


DESIGNED BY  
E. MAMOYAC

DRAWN BY  
P. NG

CHECKED BY  
S. SENGUPTA

IN CHARGE  
R. BARLAAN

DATE  
20130710

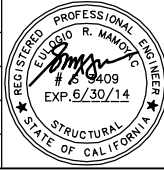

Skanska  
Shimmick  
Herzog

Anil Verma Associates, Inc.  
1970 Broadway, Suite 525  
Milpitas, California 95035  
Phone: (510) 855-2537 Fax: (810) 535-2338

1436 California Circle  
Milpitas, California 95035  
A Joint Venture

Lookwood, Andrews & Newman, Inc.  
A LEO A DALY COMPANY

T-Y-LIN INTERNATIONAL



LINE, TRACK, STATIONS, AND SYSTEMS  
DESIGN UNIT 023  
ANCILLARY BUILDING

MISCELLANEOUS DETAILS


CADD FILENAME C700-S-DB-S826.dwg	SIZE D	SCALE AS NOTED
CONTRACT NO. C700	SHEET NO. S826	REV. 0
AREA CODE DB	PAGE NO. 0295	









Jun 26, 2013 4:37pm C:\Current Projects\Berrysa Extension Project\Station - Milpitas\CAD Drawings Out\13-0710 C700 Milpitas Station - RFC Submittal\700-S-DB-S828.dwg

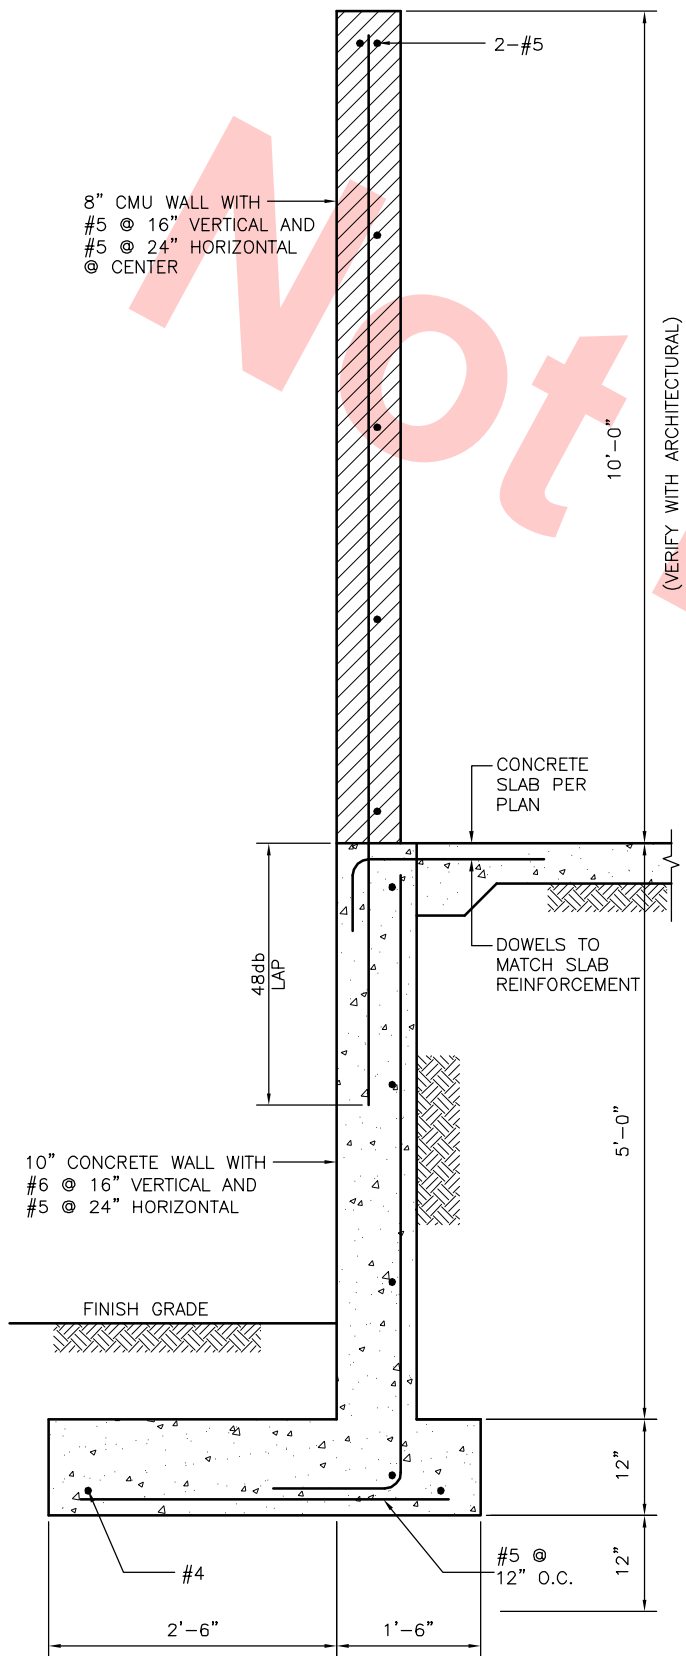


DETAIL 1  
SCALE: 1"=1'-0"  
DB-S828

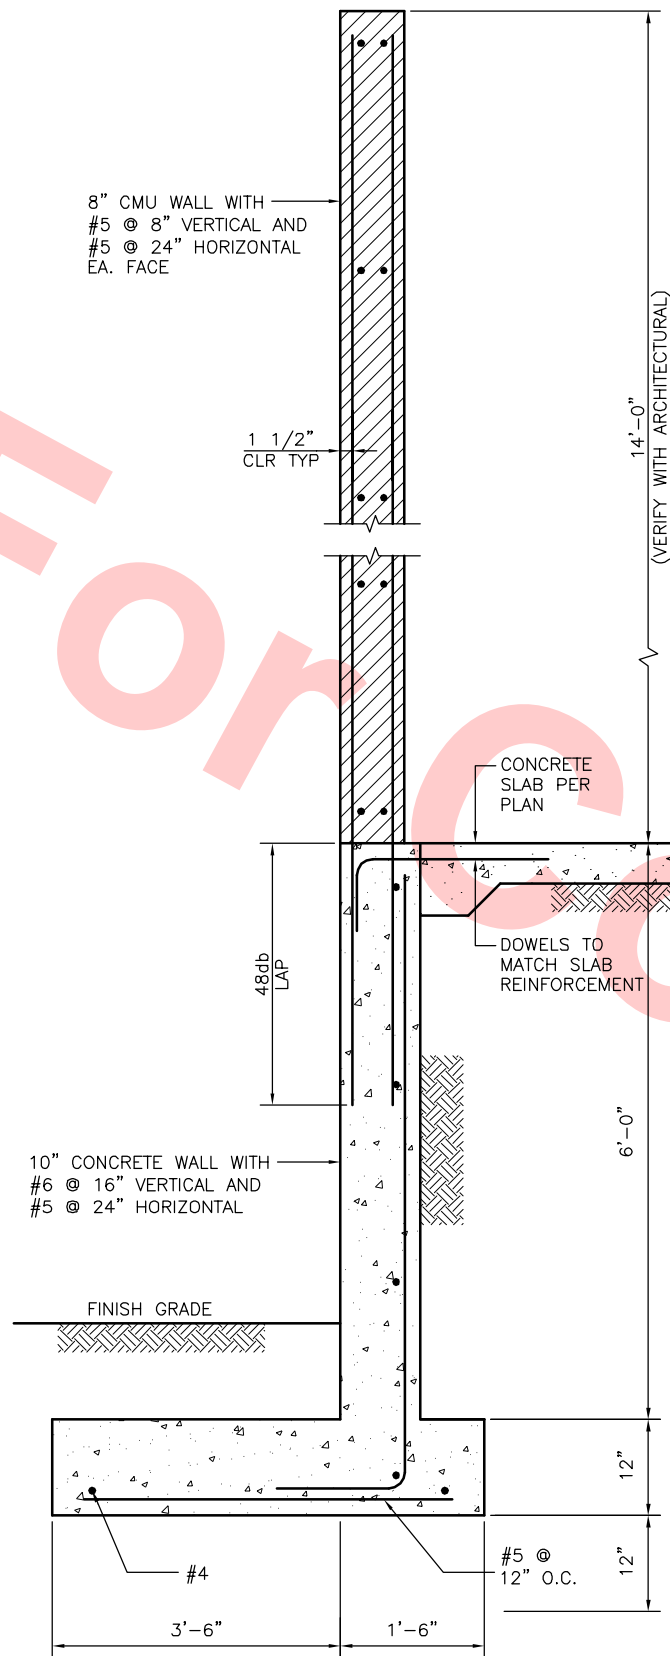

DETAIL 2  
SCALE: 1"=1'-0"  
DB-S828

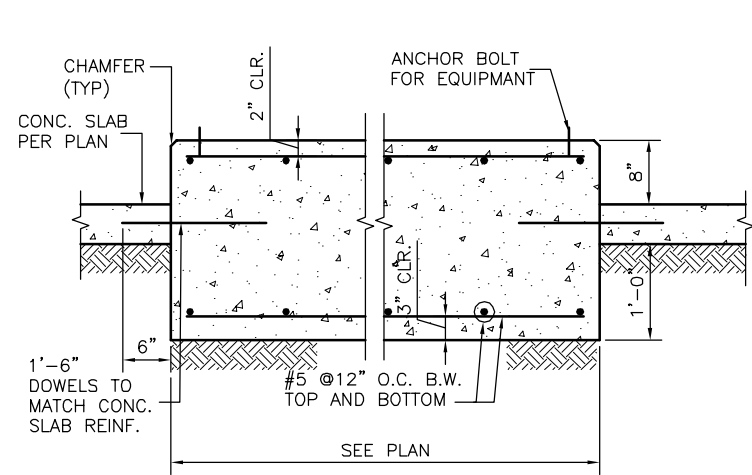

EQUIPMENT FOUNDATION  
SCALE: 1"=1'-0"  
DB-S828

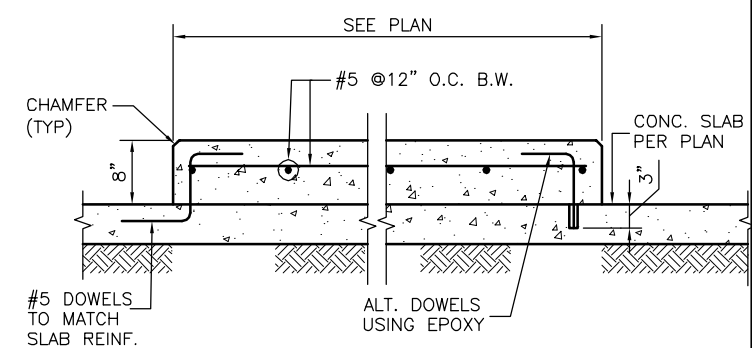

HOUSEKEEPING PAD  
SCALE: 1"=1'-0"  
DB-S828

Santa Clara Valley Transportation Authority

- NO EXCEPTIONS TAKEN (NET)
- MAKE CORRECTIONS NOTED (MCN)
- AMEND AND RESUBMIT (A/R)


Any action shown above is subject to the terms of the contract and does not relieve the Contractor of any of its obligations under the contract, including design and detailing.

Contract No.: DB11002F

By: Date:

REV	DATE	BY	SUB	APP	DESCRIPTION
0	20130710				READINESS FOR CONSTRUCTION

DESIGNED BY  
E. MAMOYAC  
DRAWN BY  
P. NG  
CHECKED BY  
S. SENGUPTA  
IN CHARGE  
R. BARLAAN  
DATE  
20130710

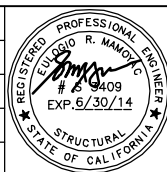

Skanska  
Shimmick  
Herzog  
Anil Verma Associates, Inc.  
1970 Broadway, Suite 525  
Milpitas, California 95035  
Phone: (510) 835-2537 Fax: (810) 835-2338

1436 California Circle  
Milpitas, California 95035  
A Joint Venture  
Lookwood, Andrews & Newman, Inc.  
T-Y LIN INTERNATIONAL  
APPROVED




LINE, TRACK, STATIONS, AND SYSTEMS  
DESIGN UNIT 023  
ANCILLARY BUILDING  
MISCELLANEOUS DETAILS


CADD FILENAME C700-S-DB-S828.dwg	SIZE D	SCALE AS NOTED
CONTRACT NO. C700	REV. 0	
AREA CODE DB	SHEET NO. S828	PAGE NO. 0297



Jun 26, 2013 - 4:48pm G:\Current Projects\Berrysa Extension Project\Station - Milpitas\CAD Drawings\Out\13-0710 C700 Milpitas Station - RFC Submit\C700-S-DB-S851.dwg

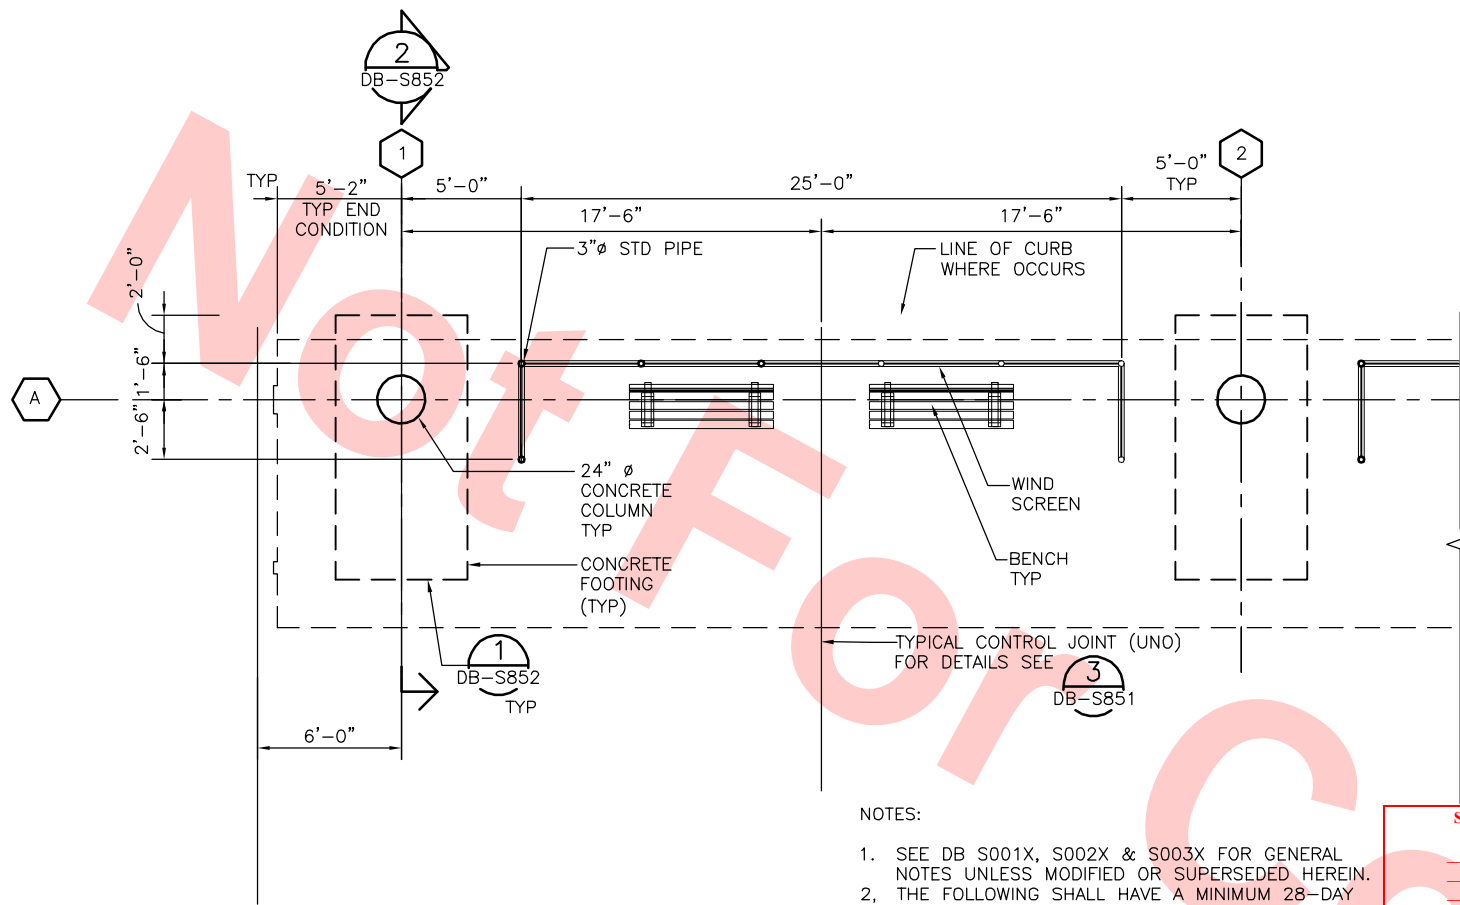

TYPICAL FOUNDATION PLAN 1  
SCALE: 1/4"=1'-0"

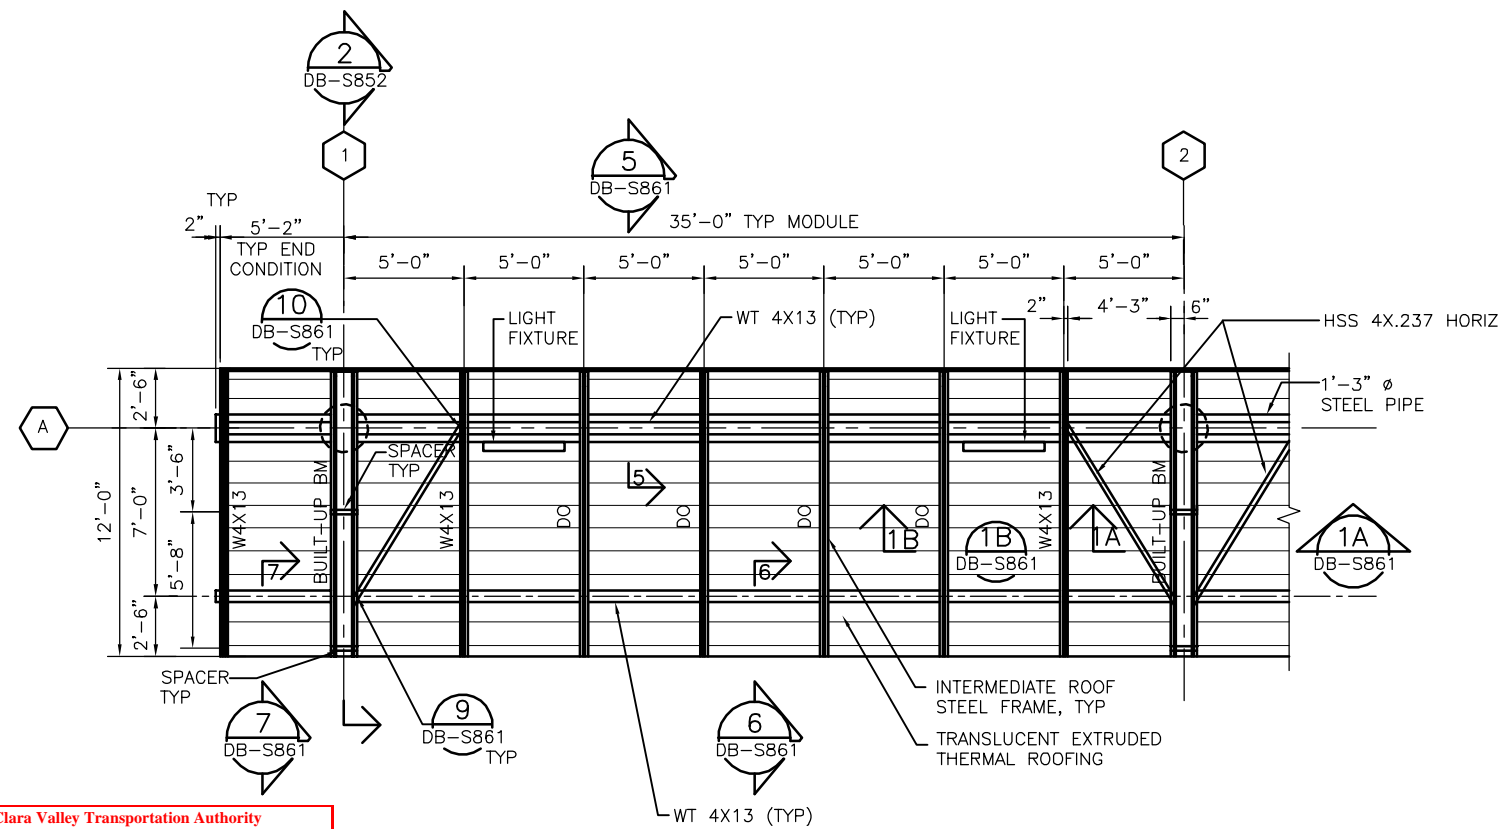

TYPICAL PARTIAL ROOF FRAMING PLAN 2  
SCALE: 1/4"=1'-0"

NOTES:

- SEE DB S001X, S002X & S003X FOR GENERAL NOTES UNLESS MODIFIED OR SUPERSEDED HEREIN.
- THE FOLLOWING SHALL HAVE A MINIMUM 28-DAY COMPRESSIVE STRENGTH  $f'_c$ :  
A. COLUMN 4,000 PSI  
B. FOUNDATION 3,000 PSI  
C. SLAB 2,000 PSI
- ANCHOR BOLTS AT TOP OF CONC. SHALL BE ASTM 1554 GR 36
- BASE PLATE AND OTHER STEEL PLATES SHALL BE ASTM A572 GR 50

Santa Clara Valley Transportation Authority

- NO EXCEPTIONS TAKEN (NET)
- MAKE CORRECTIONS NOTED (MCN)
- AMEND AND RESUBMIT (A/R)

Any action shown above is subject to the terms of the contract and does not relieve the Contractor of any of its obligations under the contract, including design and detailing.

Contract No.: DB11002F





By: \_\_\_\_\_ Date: \_\_\_\_\_

- 1 CONCRETE STRENGTH AT 28 DAYS SHALL BE 2500 PSI. MAXIMUM SLUMP SHALL BE 4 INCHES.

- 2 SLAB POUR SEQUENCE  
POUR SLAB IN STRIPS 12'-0" WIDE OR IF LARGER STRIPS USED THEN PROVIDE ADDITIONAL CONTROL JOINTS PER 4

- 3 CONSTRUCTION JOINT

- 4 CONTROL JOINTS  
PROVIDE CONTROL JOINTS AT A MAXIMUM OF 12 FT. CONTROL JOINTS SHALL BE PLACED PERPENDICULAR TO CONSTRUCTION JOINTS. 3/4" TO 1" "SOFT-CUT" SAW CUT FILLED WITH A CEMENT GROUT AFTER 28 DAYS DRYING SAW CUT WITH A DIAMOND, WET BLADE.

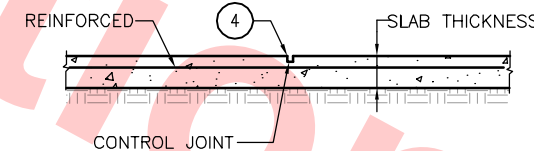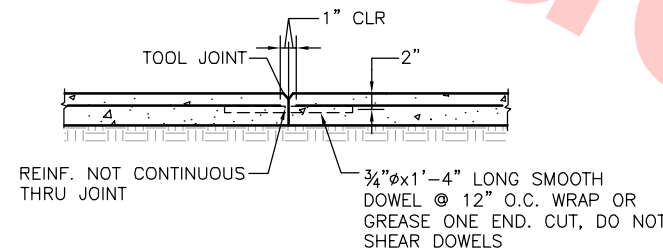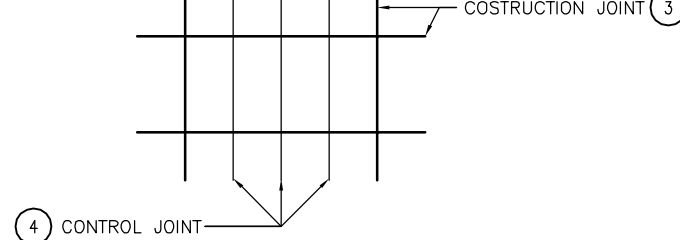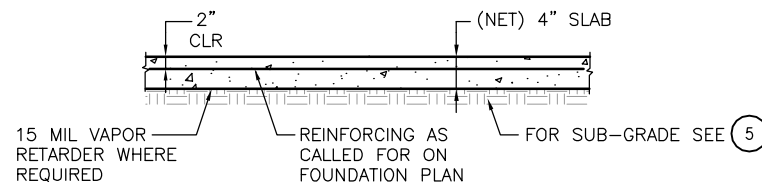


- 5 SLAB SUB GRADE SHALL BE COMPACTED TO A MINIMUM OF 90% WITH NO LOOSE SOIL ON TOP.
- 6 DO NOT PLACE CONCRETE WHEN THE TEMPERATURE EXCEEDS 90°F.
- 7 SLABS SHALL BE WET CURED FOR 7 DAYS MINIMUM.

TYP. CONC. SLAB ON GRADE 3  
SCALE: NTS

REV	DATE	BY	SUB	APP	DESCRIPTION
0	20130710				READINESS FOR CONSTRUCTION

DESIGNED BY  
E. MAMOYAC  
DRAWN BY  
K. STEPANIAN  
CHECKED BY  
S. SENGUPTA  
IN CHARGE  
R. BARLAAN  
DATE  
20130710

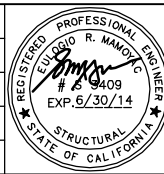

Skanska  
Shimmick  
Herzog  
Anil Verma Associates, Inc.  
1970 Broadway, Suite 525  
Milpitas, California 95035  
Phone: (510) 835-2527 Fax: (810) 535-2338


1436 California Circle  
Milpitas, California 95035  
A Joint Venture  
Lookwood, Andrews & Newman, Inc.  
T-Y-LIN INTERNATIONAL



LINE, TRACK, STATIONS, AND SYSTEMS DESIGN UNIT 023 TRANSIT CENTER BUS SHELTER			
BUS CANOPY FOUNDATION AND ROOF FRAMING PLAN			
CADD FILENAME C700-S-DB-S851.dwg	SIZE D	SCALE AS NOTED	CONTRACT NO. C700
AREA CODE DB	SHEET NO. S851	PAGE NO. 0298	REV. 0




Jun 26, 2013 4:48pm G:\Current Projects\BART-Berryessa Extension Project\Station - Milpitas\CAD Drawings Out\13-0710 C700 Milpitas Station - RFC Submittal\700-S-DB-S852.dwg

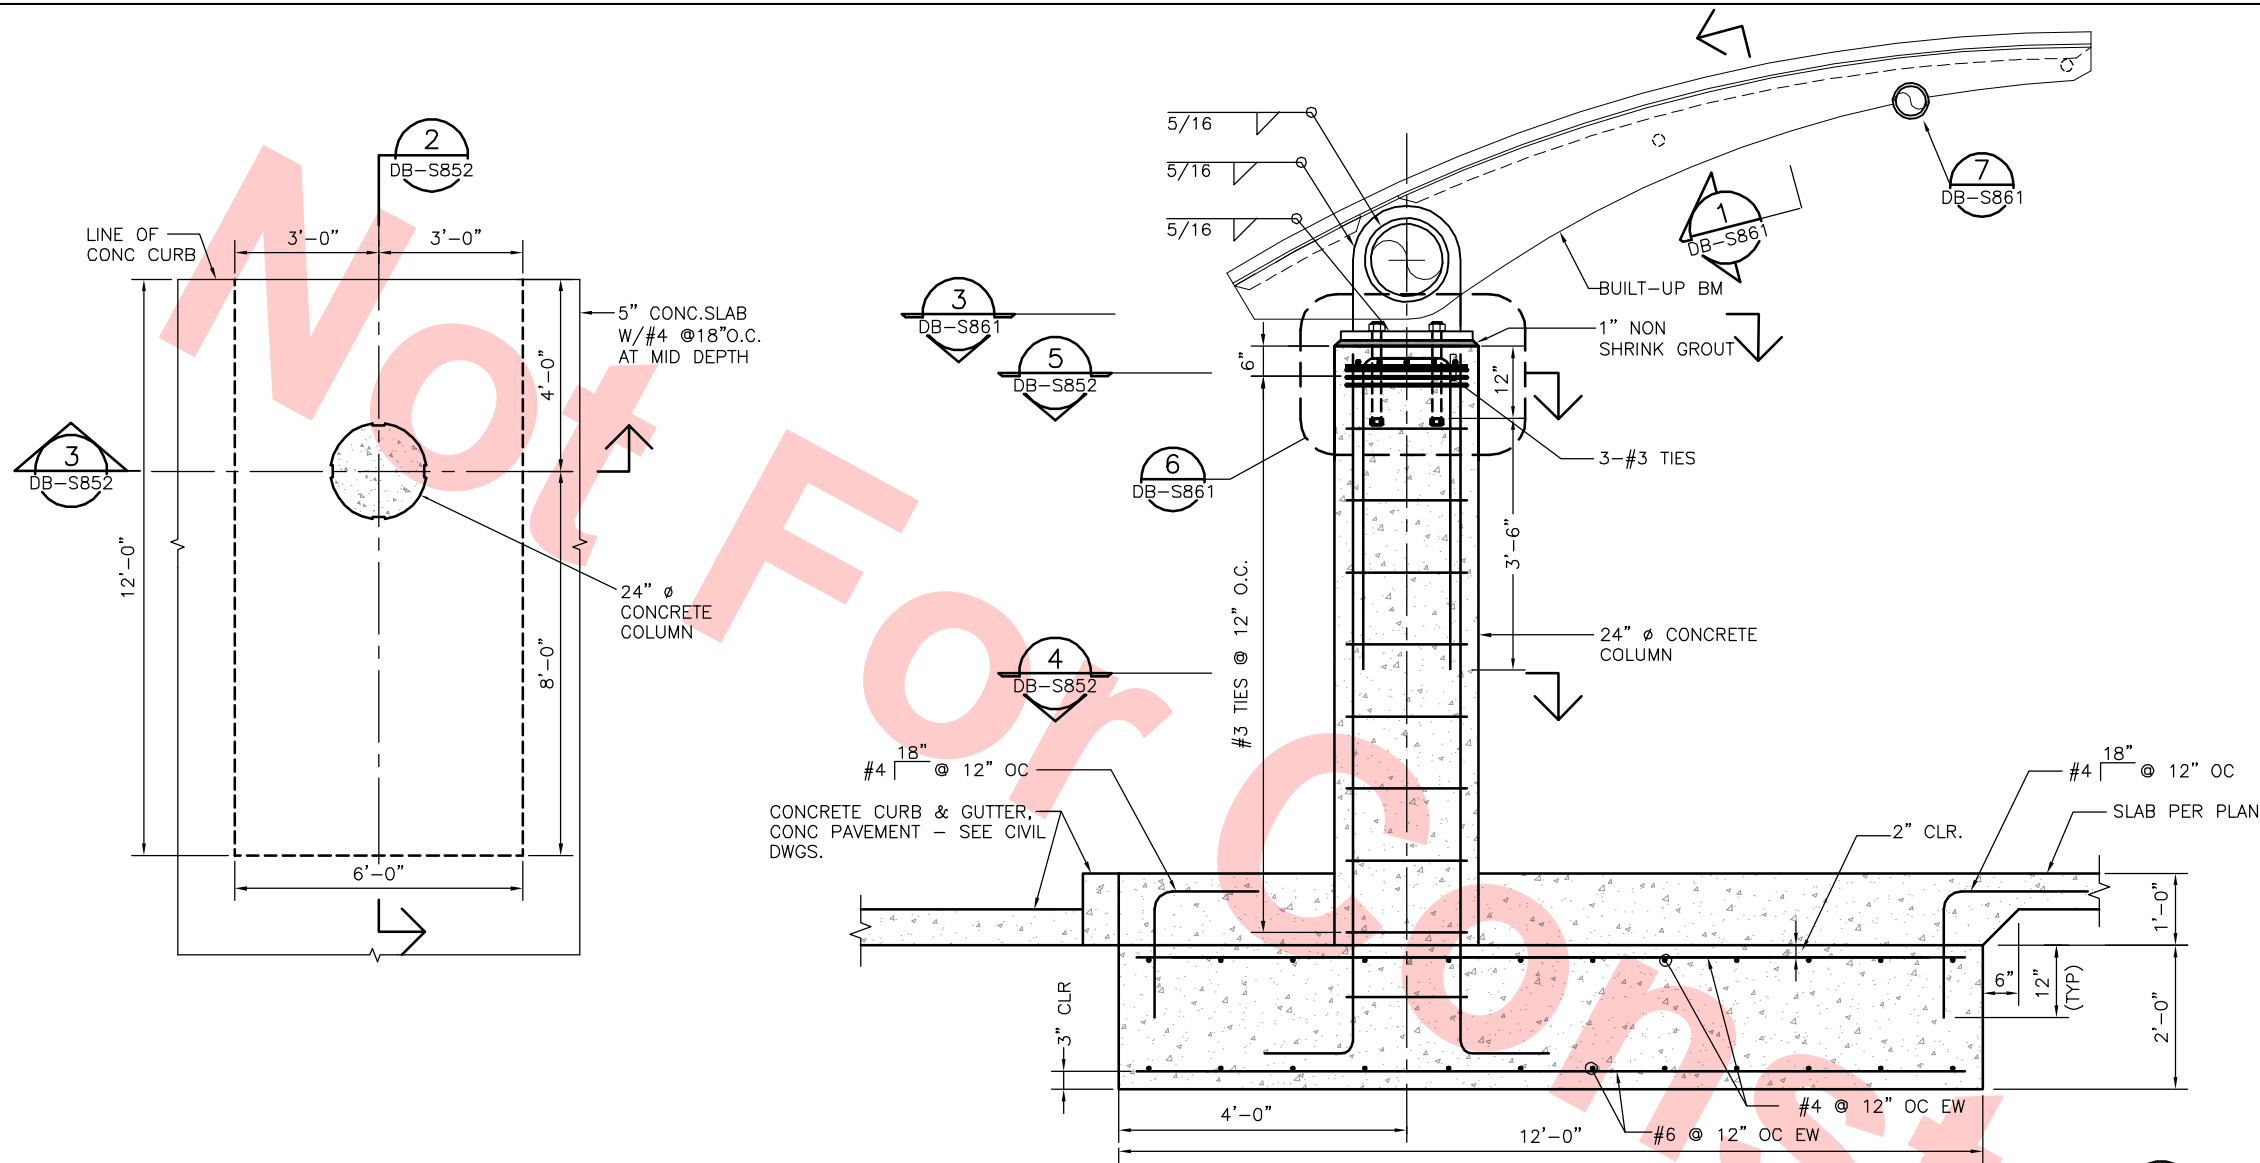


CANOPY FOUNDATION DETAIL  
SCALE: 1/2" = 1'-0"  
DB-S852  
DB-S851


CANOPY SUPPORT DETAIL  
SCALE: 3/4" = 1'-0"  
DB-S852

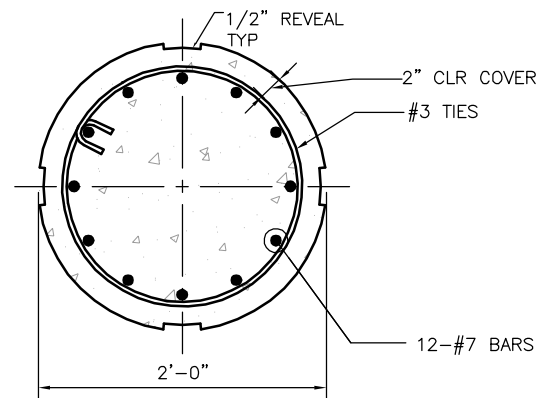


SECTION  
SCALE: 1 1/2" = 1'-0"  
DB-S852  
DB-S851

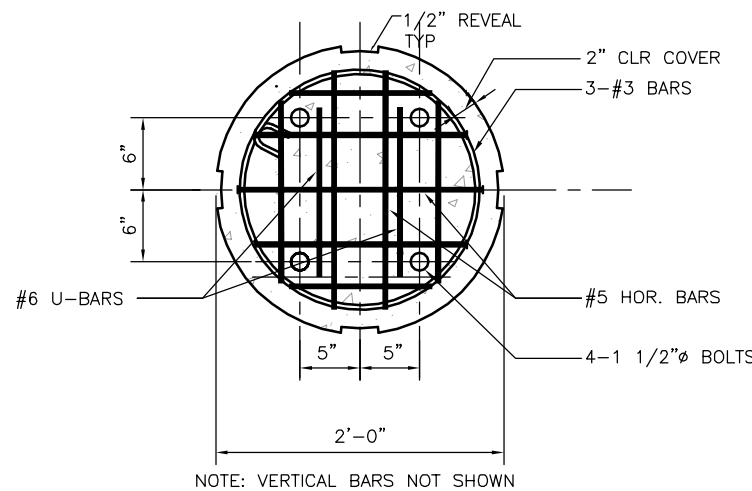

SECTION  
SCALE: 1 1/2" = 1'-0"  
DB-S852  
DB-S851

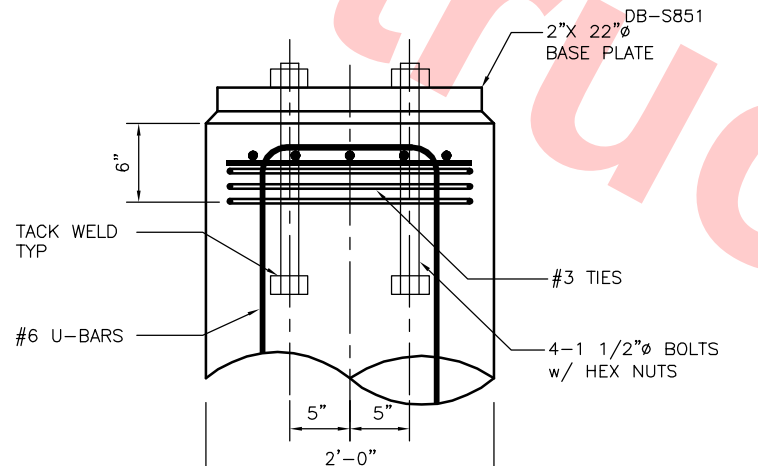

SECTION  
SCALE: 1 1/2" = 1'-0"  
DB-S852  
DB-S851

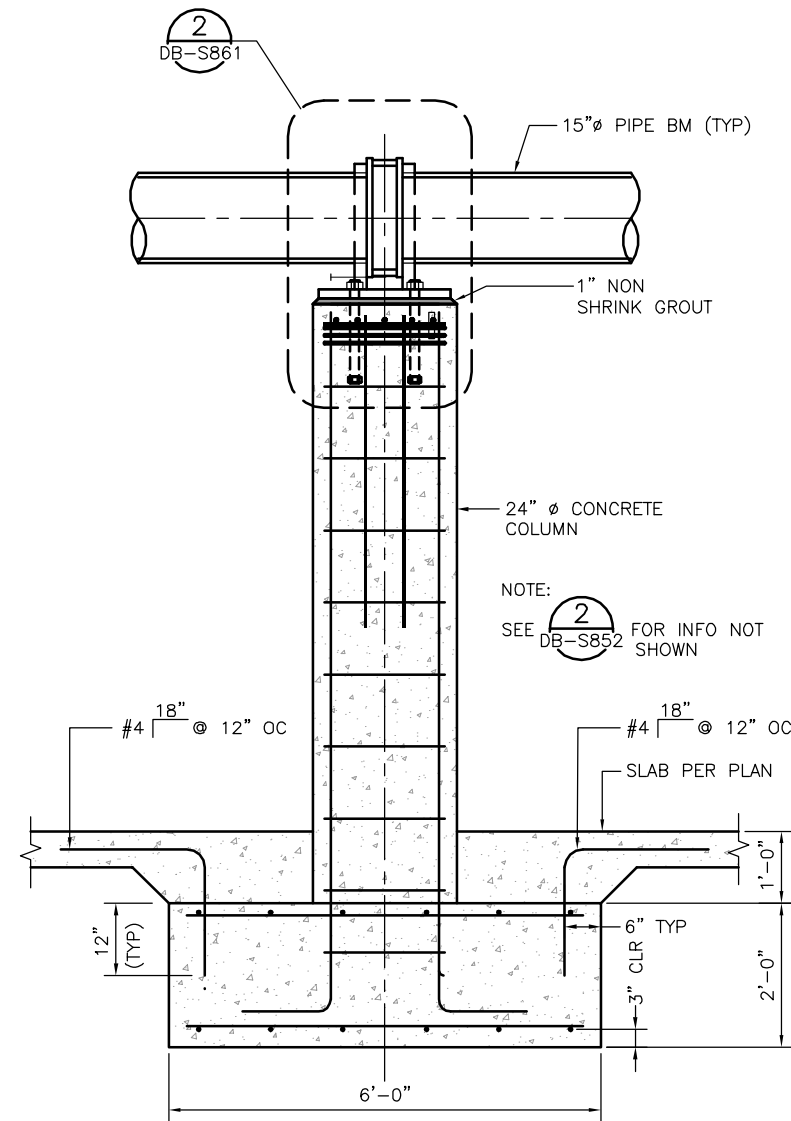

SECTION  
SCALE: 3/4" = 1'-0"  
DB-S852

Santa Clara Valley Transportation Authority

NO EXCEPTIONS TAKEN (NET)  
MAKE CORRECTIONS NOTED (MCN)  
AMEND AND RESUBMIT (A/R)


Any action shown above is subject to the terms of the contract and does not relieve the Contractor of any of its obligations under the contract, including design and detailing.

Contract No.: DB11002F

By: \_\_\_\_\_ Date: \_\_\_\_\_

REV	DATE	BY	SUB	APP	DESCRIPTION
0	20130710				READINESS FOR CONSTRUCTION

DESIGNED BY E. MAMOYAC	
DRAWN BY S. DE GUZMAN	
CHECKED BY S. SENGUPTA	
IN CHARGE R. BARLAAN	
DATE 20130710	

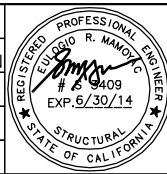

Skanska  
Shimmick  
Herzog

Anil Verma Associates, Inc.  
1970 Broadway, Suite 225  
Milpitas, California 95035  
Phone: (510) 835-2537 Fax: (810) 835-2338

1436 California Circle  
Milpitas, California 95035  
A Joint Venture

Lookwood, Andrews  
& Newman, Inc.  
A T-Y-LIN COMPANY

T-Y-LIN INTERNATIONAL


NOT FOR  
CONSTRUCTION




LINE, TRACK, STATIONS, AND SYSTEMS DESIGN UNIT 023 TRANSIT CENTER BUS SHELTER			
BUS CANOPY FOUNDATION AND SECTION DETAILS			

CADD FILENAME C700-S-DB-S852.dwg	SIZE D	SCALE AS NOTED
CONTRACT NO. C700	SHEET NO. S852	REV. 0
AREA CODE DB	PAGE NO. 0299	




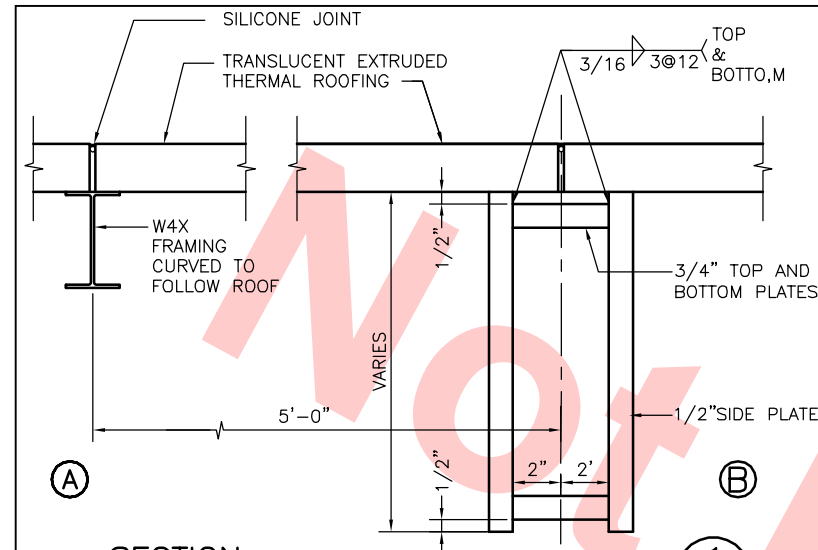


**SECTION**  
SCALE: 3" = 1'-0"

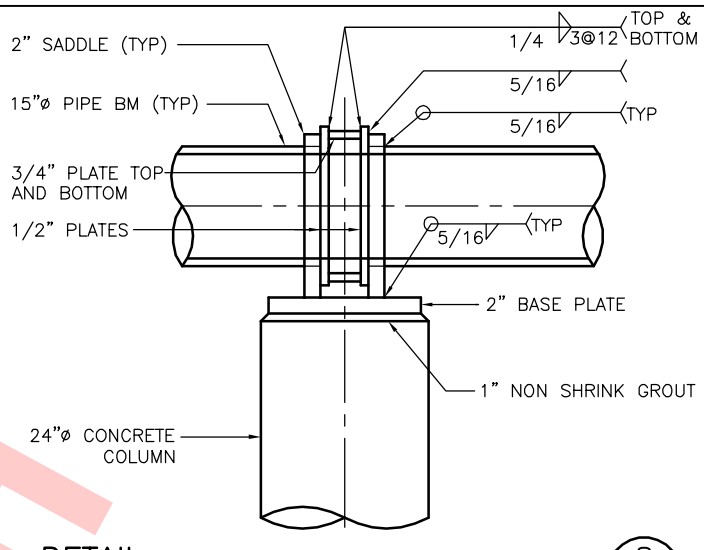


**DETAIL**  
SCALE: 1 1/2" = 1'-0"

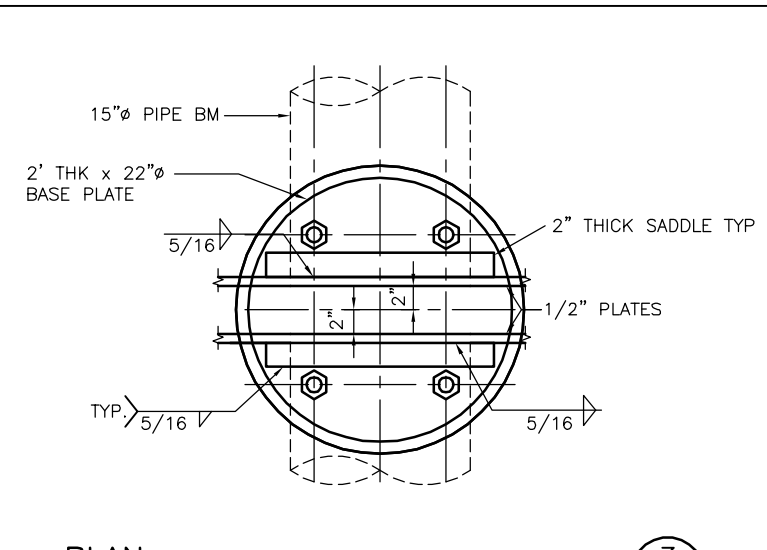


**PLAN**  
SCALE: 1 1/2" = 1'-0"

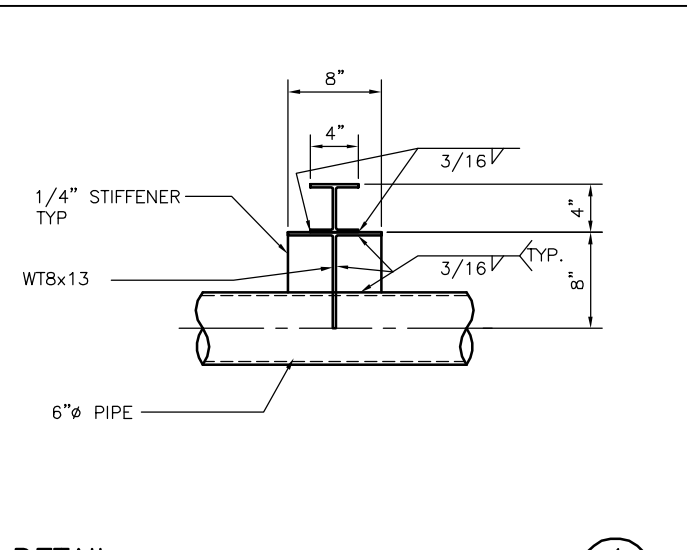


**DETAIL**  
SCALE: 1 1/2" = 1'-0"

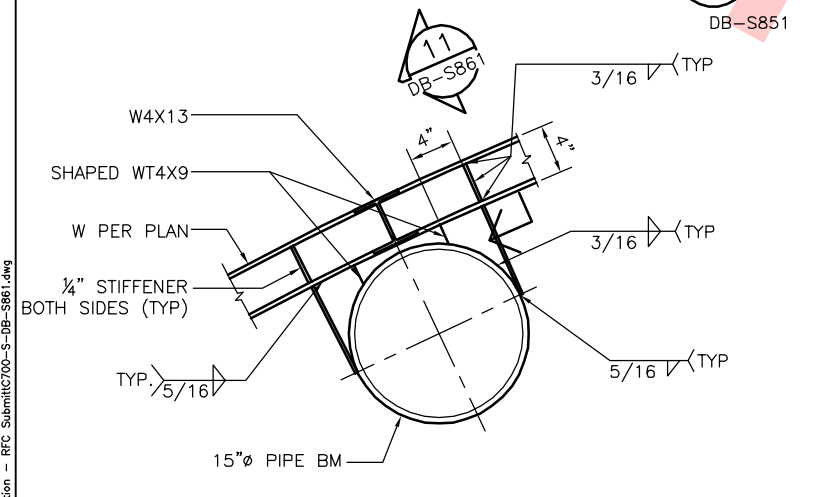


**SECTION**  
SCALE: 1 1/2" = 1'-0"

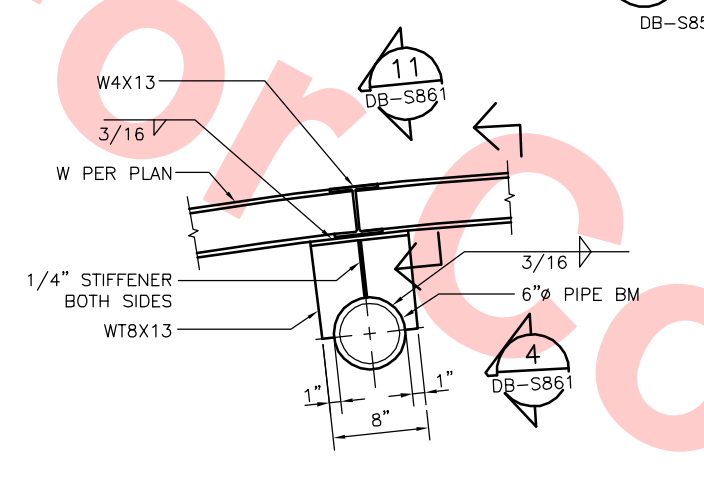


**SECTION**  
SCALE: 1 1/2" = 1'-0"

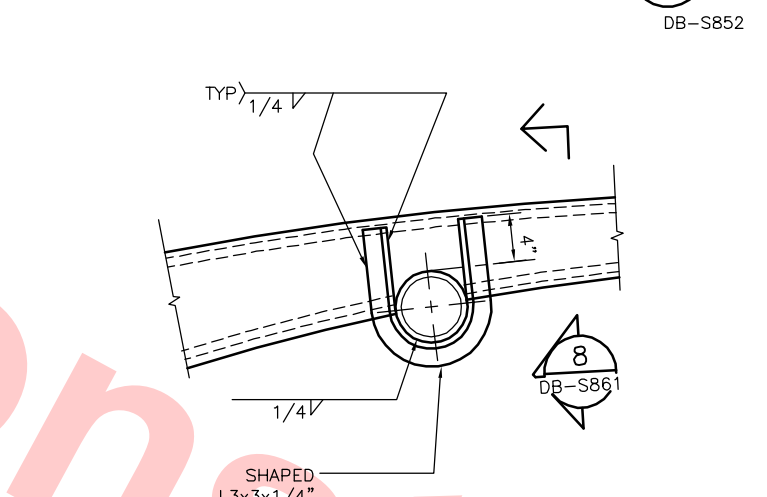


**SECTION**  
SCALE: 1 1/2" = 1'-0"

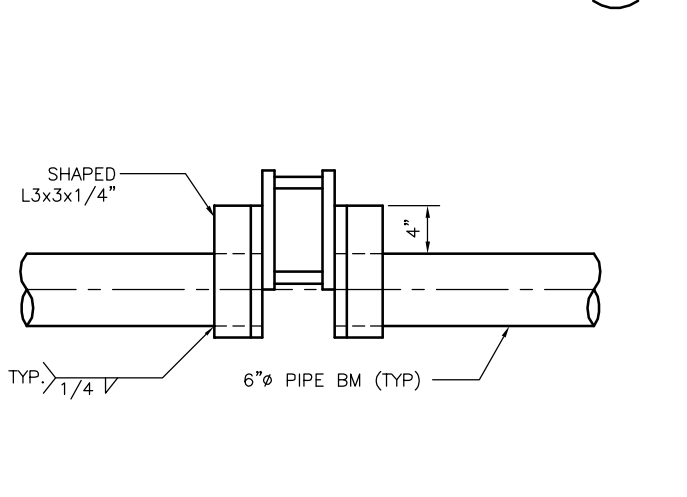


**SECTION**  
SCALE: 1 1/2" = 1'-0"

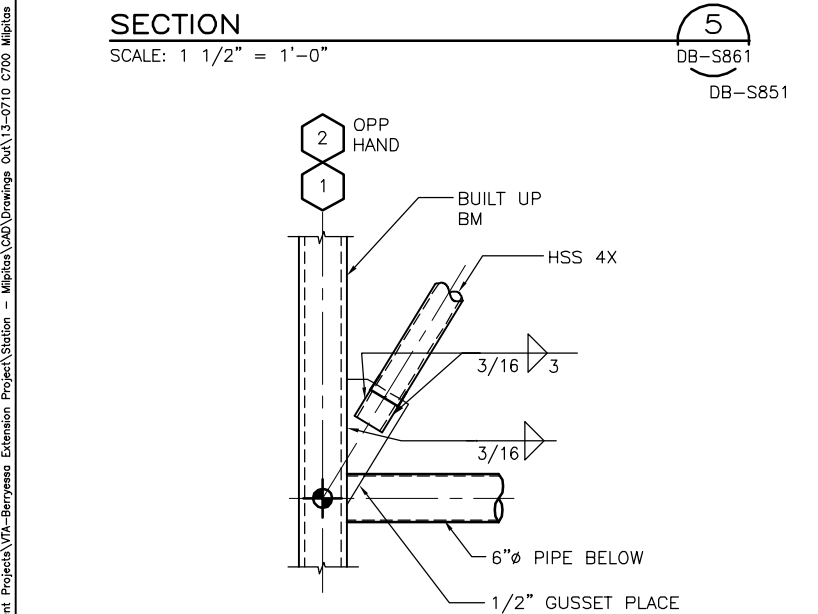


**DETAIL**  
SCALE: 1" = 1'-0"

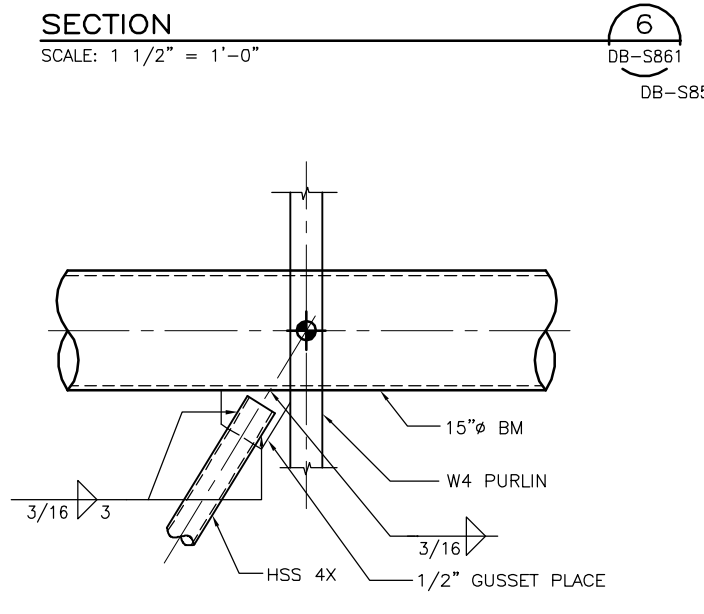

**DETAIL**  
SCALE: 1" = 1'-0"

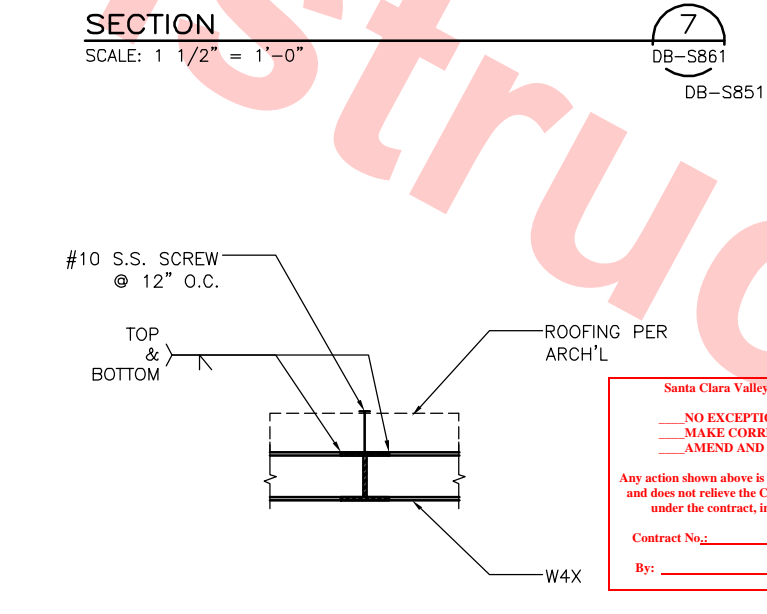


**DETAIL**  
SCALE: 1" = 1'-0"

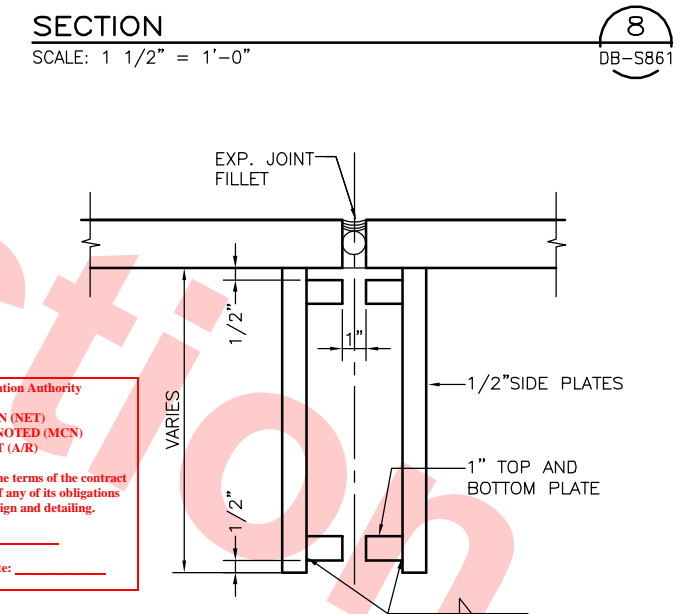

**EXPANSION JOINT DETAIL**  
SCALE: 3" = 1'-0"

REV	DATE	BY	SUB	APP	DESCRIPTION
0	20130710				READINESS FOR CONSTRUCTION

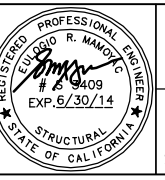

**Skanska Shimmick Herzog**

1436 California Circle  
Milpitas, California 95035  
A Joint Venture

**Anil Verma Associates, Inc.**  
1970 Broadway, Suite 525  
Oakland, CA 94612  
Phone: (510) 835-2537 Fax: (510) 835-2338

**Lookwood, Andrews & Newman, Inc.**  
A L&A B&N COMPANY

**T-Y LIN INTERNATIONAL**

**BART SILICON VALLEY**

**BART SILICON VALLEY BERRYESSA EXTENSION**

**LINE, TRACK, STATIONS, AND SYSTEMS**

**DESIGN UNIT 023**


**TRANSIT CENTER BUS SHELTER**

**BUS CANOPY**

**MISCELLANEOUS DETAILS**

CADD FILENAME C700-S-DB-S861.dwg	SIZE D	SCALE AS NOTED
CONTRACT NO. C700	SHEET NO. S861	REV. 0
AREA CODE DB	PAGE NO. 0300	



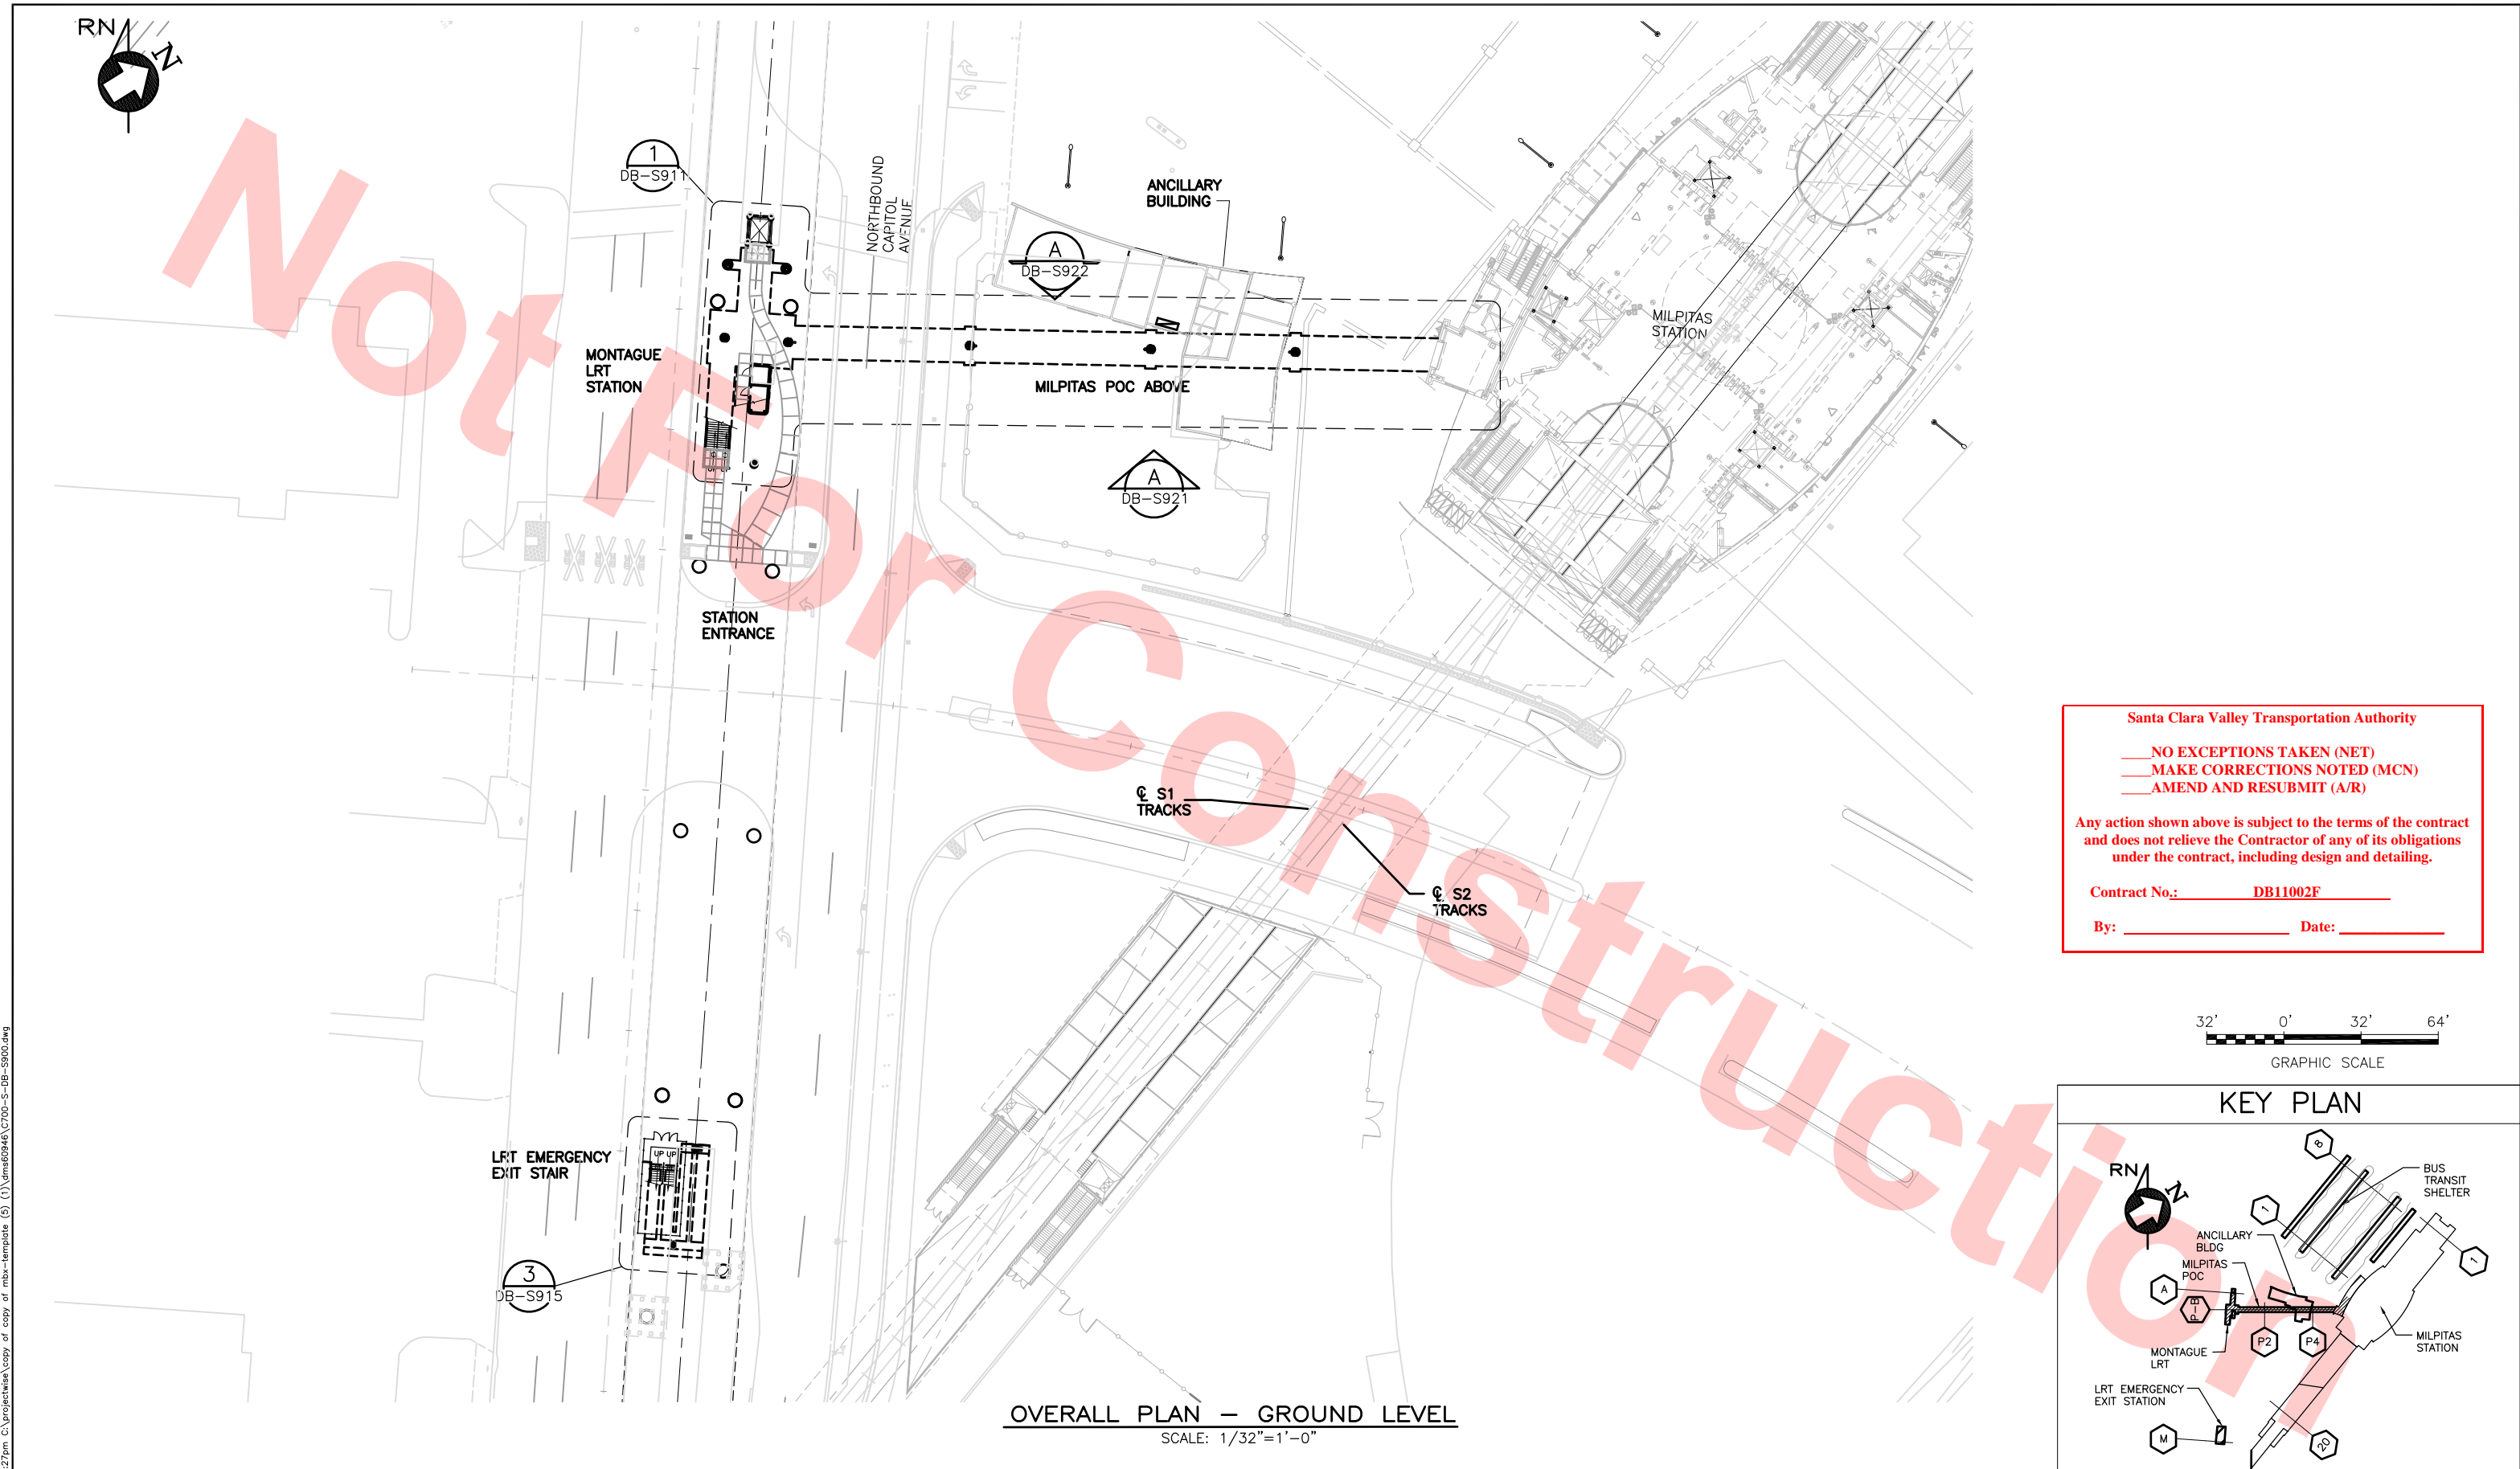


Santa Clara Valley Transportation Authority

\_\_\_ NO EXCEPTIONS TAKEN (NET)  
\_\_\_ MAKE CORRECTIONS NOTED (MCN)  
\_\_\_ AMEND AND RESUBMIT (A/R)

Any action shown above is subject to the terms of the contract and does not relieve the Contractor of any of its obligations under the contract, including design and detailing.

Contract No.: DB11002F

By: \_\_\_\_\_ Date: \_\_\_\_\_

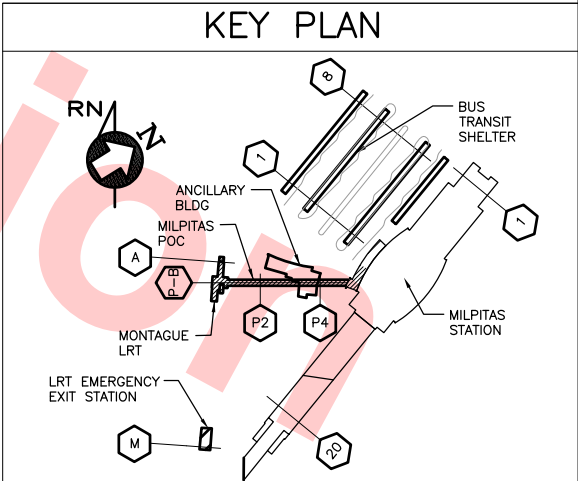

OVERALL PLAN — GROUND LEVEL  
SCALE: 1/32"=1'-0"

					DESIGNED BY J. DUNLEA		<b>Skanska Shimmick Herzog</b> 1436 California Circle Milpitas, California 95035 A Joint Venture			<b>T-Y LIN INTERNATIONAL</b> <i>By: [Signature]</i>	 BART SILICON VALLEY BERRYESSA EXTENSION	LINE, TRACK, STATIONS AND SYSTEMS DESIGN UNIT 023 MONTAGUE LRT AND MILPITAS POC	CADD FILENAME C700-S-DB-S900.dwg			
					DRAWN BY J. DUNLEA								SIZE SCALE D 1/32"=1'-0"	CONTRACT NO. <b>C700</b>	REV. <b>0</b>	
					CHECKED BY S. DEBNATH								AREA CODE SHEET NO.			
					IN CHARGE R. BARLAAN								DB S900		PAGE NO. 0301	
0	20130710				READINESS FOR CONSTRUCTION	DATE 20130710	SUBMITTED	APPROVED				OVERALL PLAN GROUND LEVEL				
REV	DATE	BY	SUB	APP	DESCRIPTION											

Jun 28, 2013 12:27pm C:\projects\wss\copy of copy of mxb-template (5) (1)\ms60946\c700-s-db-s900.dwg





1  
DB-S912

B  
DB-S922

A  
DB-S921

2  
DB-S915

MONTAGUE  
LRT STATION

LRT  
LANDING

LRT  
LANDING

ANCILLARY BUILDING  
ROOF BELOW

MILPITAS POC

POC  
LANDING

MILPITAS  
STATION

MONTAGUE  
LRT  
EMERGENCY  
EXIT STAIR

OVERALL PLAN — POC LEVEL  
SCALE: 1/32"=1'-0"


Santa Clara Valley Transportation Authority

NO EXCEPTIONS TAKEN (NET)  
MAKE CORRECTIONS NOTED (MCN)  
AMEND AND RESUBMIT (A/R)


Any action shown above is subject to the terms of the contract  
and does not relieve the Contractor of any of its obligations  
under the contract, including design and detailing.

Contract No.: DB11002F

By: Date:

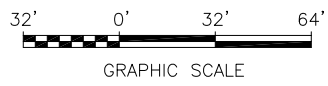


KEY PLAN

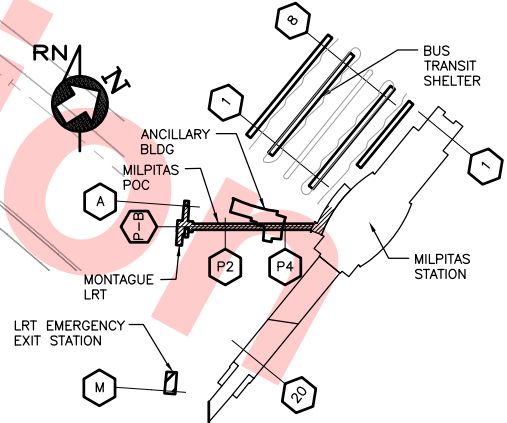

Jun 28, 2013 12:31pm C:\projects\wss\copy of copy of mbx-template (5) (1)\vms60946\CT00-S-DB-S901.dwg

REV	DATE	BY	SUB	APP	DESCRIPTION
0	20130710				READINESS FOR CONSTRUCTION

DESIGNED BY  
J. DUNLEA  
DRAWN BY  
J. DUNLEA  
CHECKED BY  
S. DEBNATH  
IN CHARGE  
R. BARLAAN  
DATE  
20130710

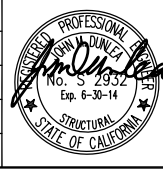

Skanska  
Shimmick  
Herzog  
Anil Verma Associates, Inc.  
1970 Broadway, Suite 525  
Milpitas, California 95035  
Phone: (510) 855-2537 Fax: (510) 535-2339  
SUBMITTED


1436 California Circle  
Milpitas, California 95035  
A Joint Venture  
Lookwood, Andrews  
& Newman, Inc.  
T-Y-LIN INTERNATIONAL  
APPROVED



LINE, TRACK, STATIONS AND SYSTEMS  
DESIGN UNIT 023  
MONTAGUE LRT AND MILPITAS POC  
OVERALL PLAN  
POC LEVEL

CADD FILENAME C700-S-DB-S901.dwg	REV. 0
SIZE SCALE D 1/32"=1'-0"	
CONTRACT NO. C700	
AREA CODE DB	SHEET NO. S901
	PAGE NO. 0302



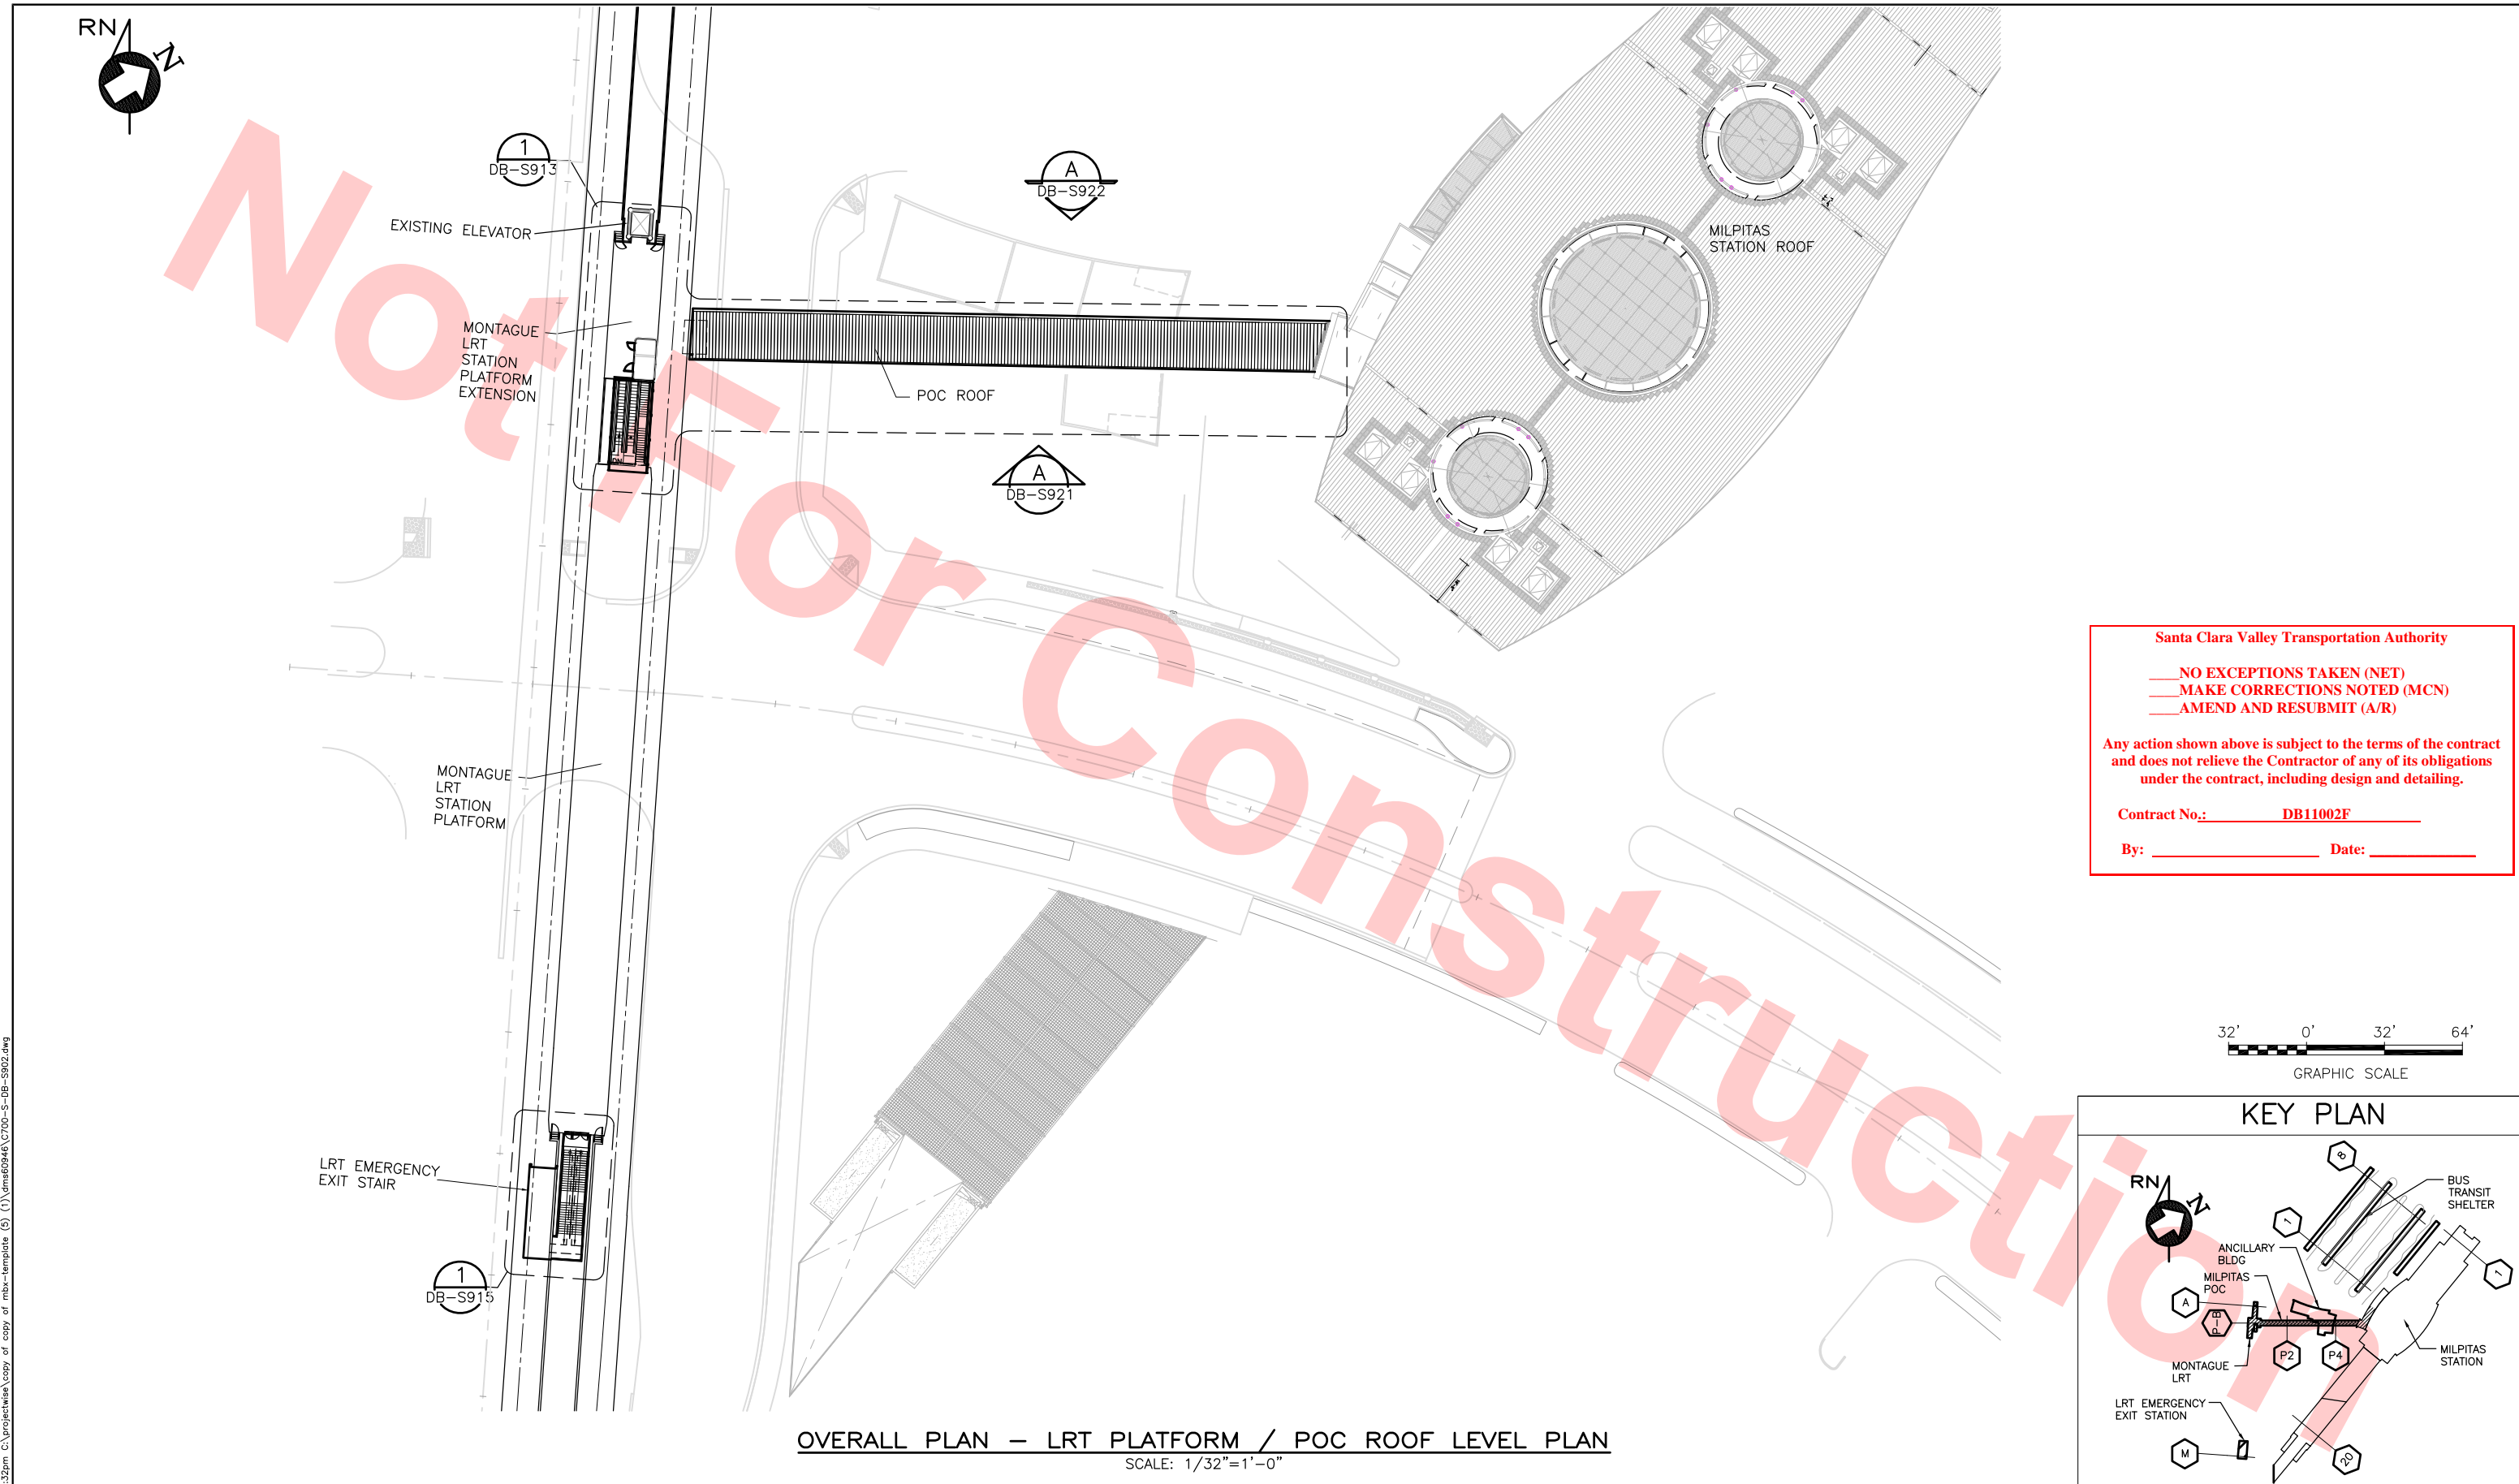

OVERALL PLAN - LRT PLATFORM / POC ROOF LEVEL PLAN  
SCALE: 1/32"=1'-0"



Santa Clara Valley Transportation Authority

NO EXCEPTIONS TAKEN (NET)  
MAKE CORRECTIONS NOTED (MCN)  
AMEND AND RESUBMIT (A/R)

Any action shown above is subject to the terms of the contract and does not relieve the Contractor of any of its obligations under the contract, including design and detailing.

Contract No.: DB11002F

By: \_\_\_\_\_ Date: \_\_\_\_\_

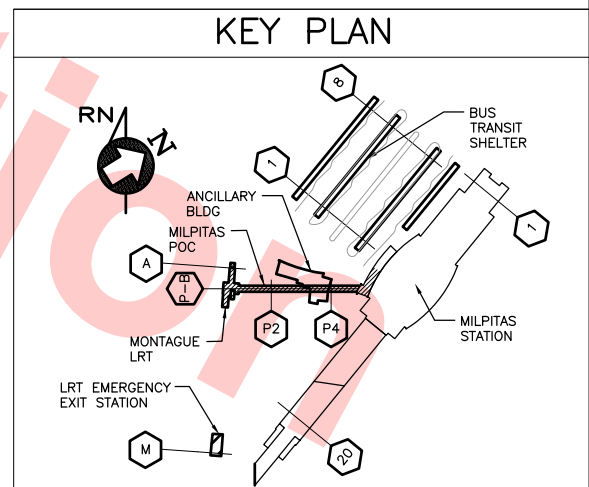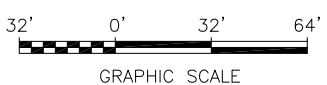


--	--	
Jun 28, 2013 12:32pm C:\projects\wss\copy of copy of mba-template (5) (1)\ms60946\CT00-S-DB-S902.dwg



Jun 28, 2013 12:35pm C:\projects\copy of copy of mba-template (5) (1)\ms60946\CT00-S-DB-S911.dwg

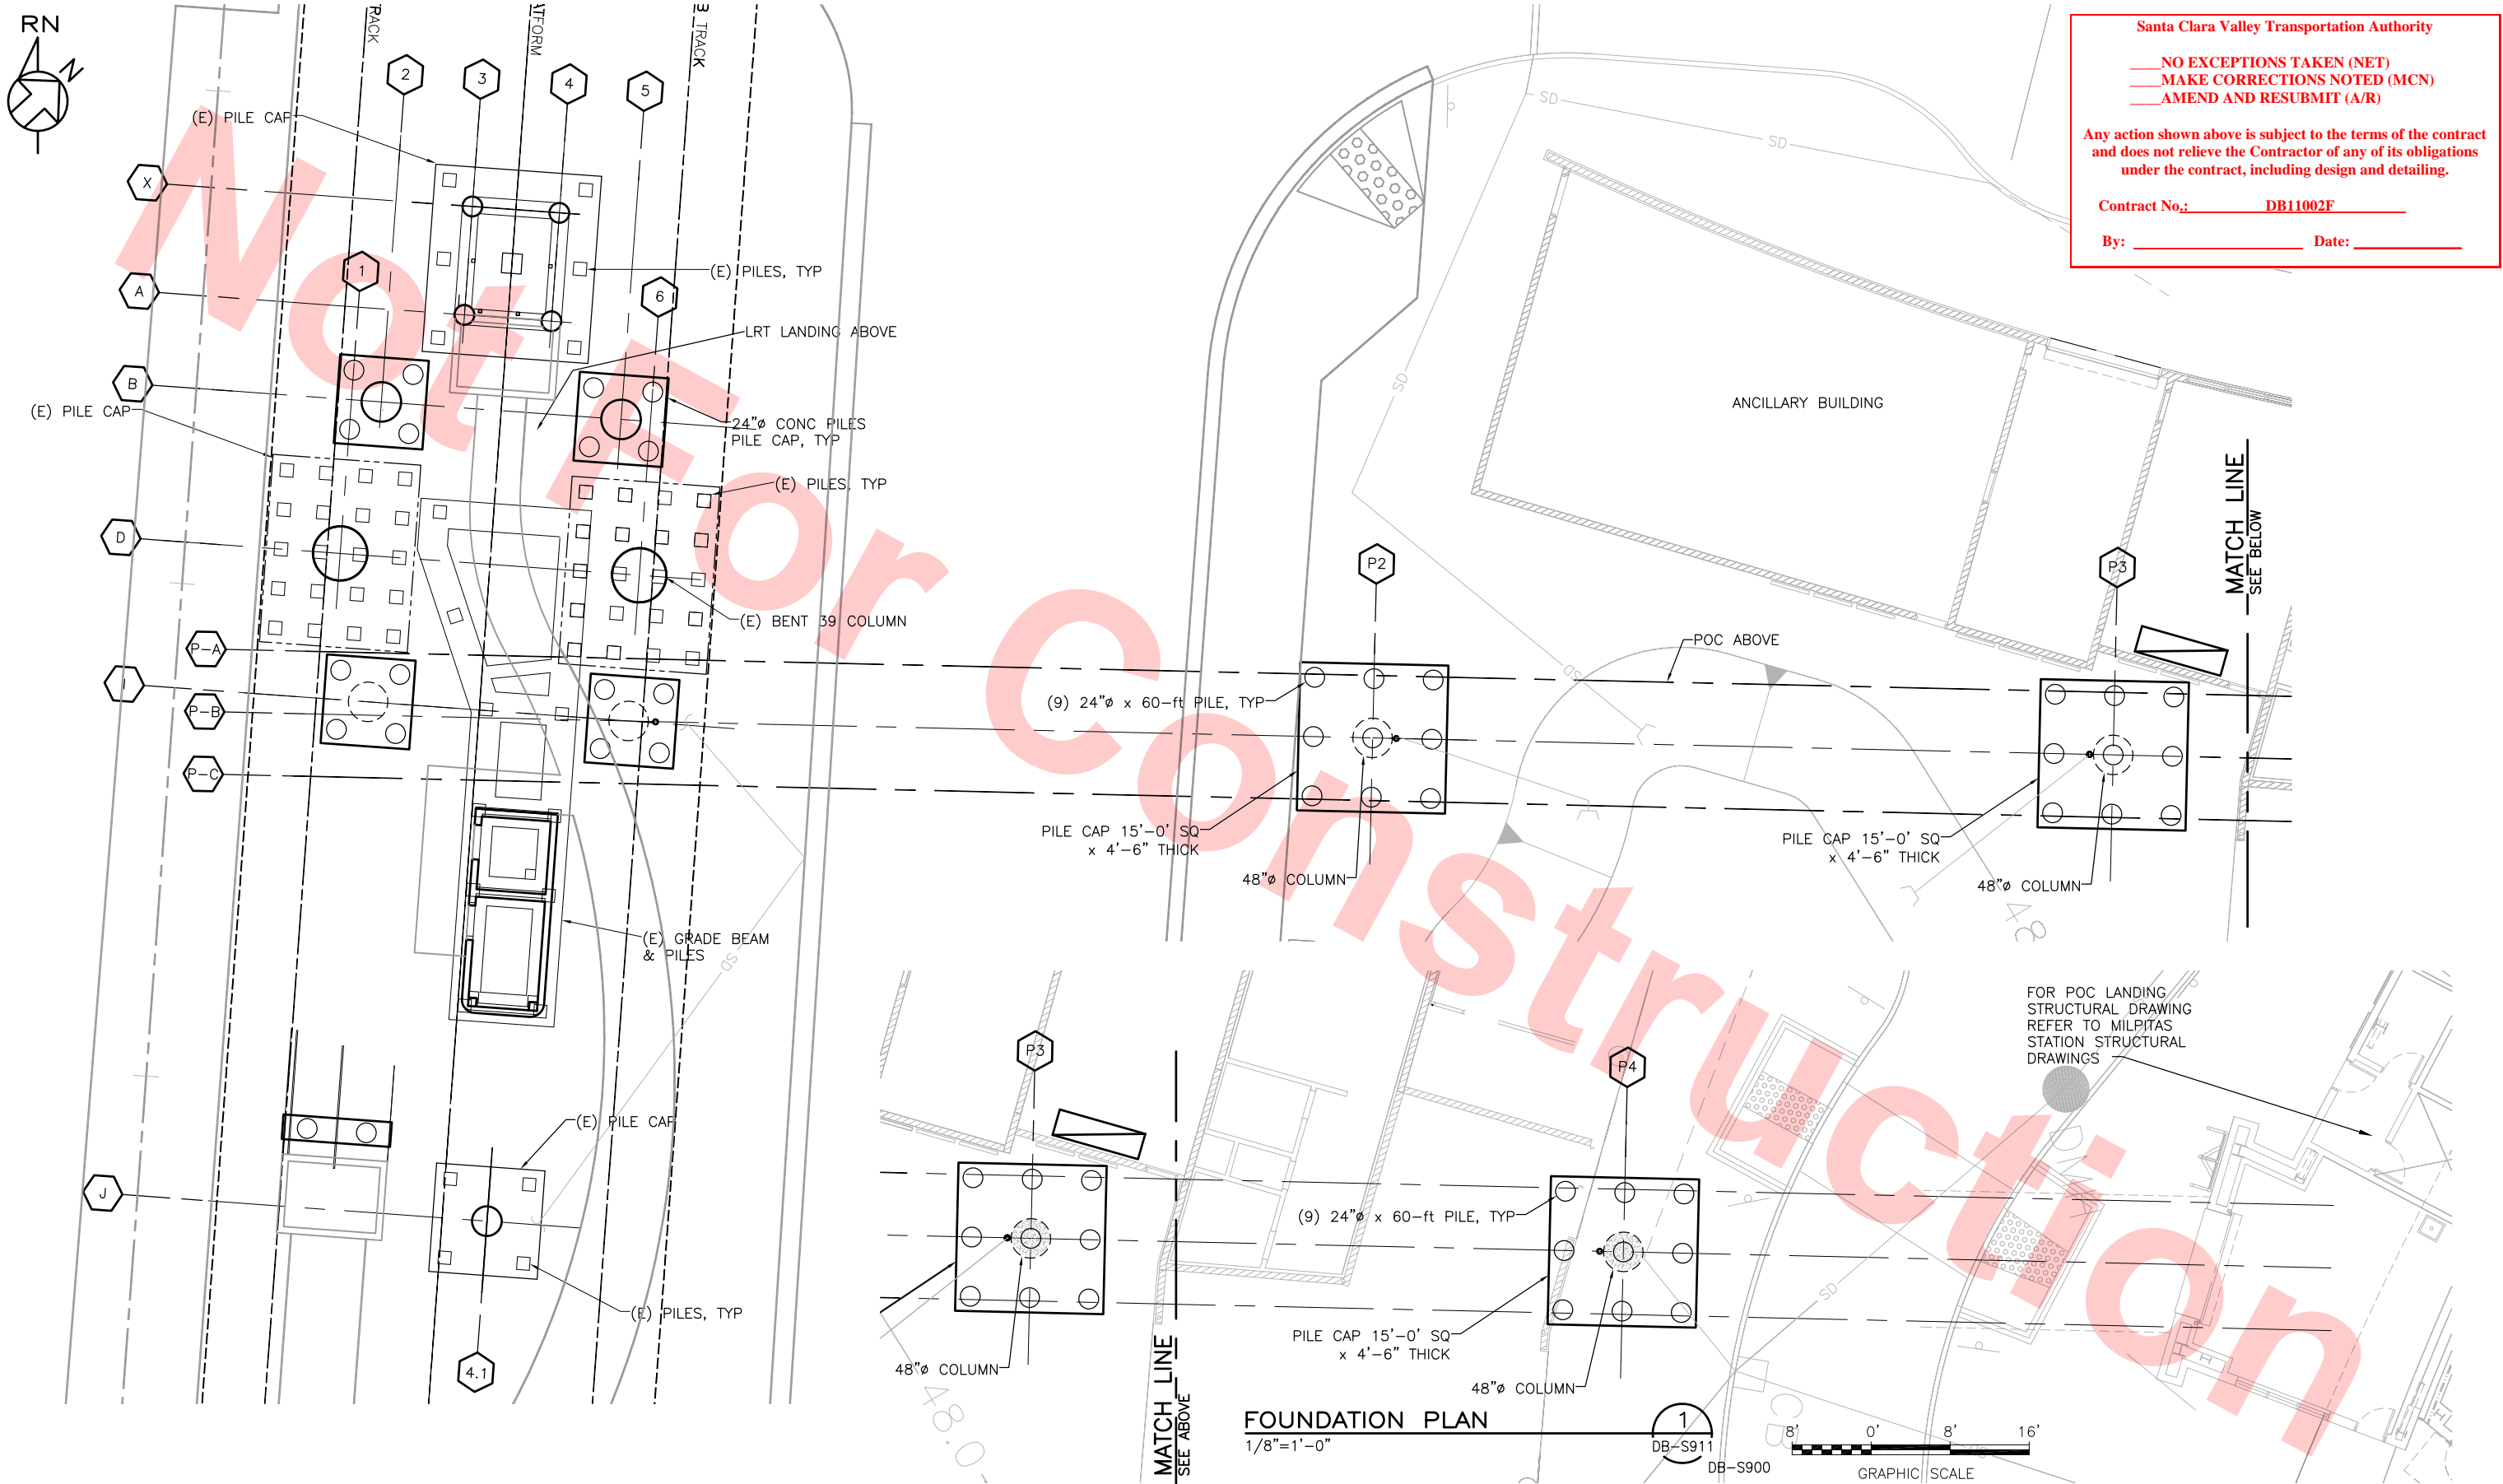

Santa Clara Valley Transportation Authority


NO EXCEPTIONS TAKEN (NET)  
MAKE CORRECTIONS NOTED (MCN)  
AMEND AND RESUBMIT (A/R)

Any action shown above is subject to the terms of the contract and does not relieve the Contractor of any of its obligations under the contract, including design and detailing.

Contract No.: DB11002F

By: \_\_\_\_\_ Date: \_\_\_\_\_

REV	DATE	BY	SUB	APP	DESCRIPTION
0	20130710				READINESS FOR CONSTRUCTION

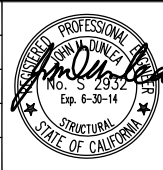

DESIGNED BY  
J. DUNLEA

DRAWN BY  
J. DUNLEA

CHECKED BY  
S. DEBNATH

IN CHARGE  
R. BARLAAN

DATE  
20130710

Skanska  
Shimmick  
Herzog

1436 California Circle  
Milpitas, California 95035  
A Joint Venture

1970 Broadway, Suite 525  
Oakland, CA 94612  
Phone: (510) 855-2537 Fax: (510) 535-2339

Lookwood, Andrews  
& Newnam, Inc.  
A LEOP A BULLY COMPANY

T-Y-LIN INTERNATIONAL

APPROVED  
*[Signature]*

BART  
SILICON VALLEY


BART SILICON VALLEY BERRYESSA EXTENSION

LINE, TRACK, STATIONS AND SYSTEMS  
DESIGN UNIT 023  
MONTAGUE LRT AND MILPITAS POC

FOUNDATION PLAN

CADD FILENAME C700-S-DB-S911.dwg	REV. 0
SIZE SCALE D 1/8"=1'-0"	
CONTRACT NO. C700	
AREA CODE DB	PAGE NO. 0304



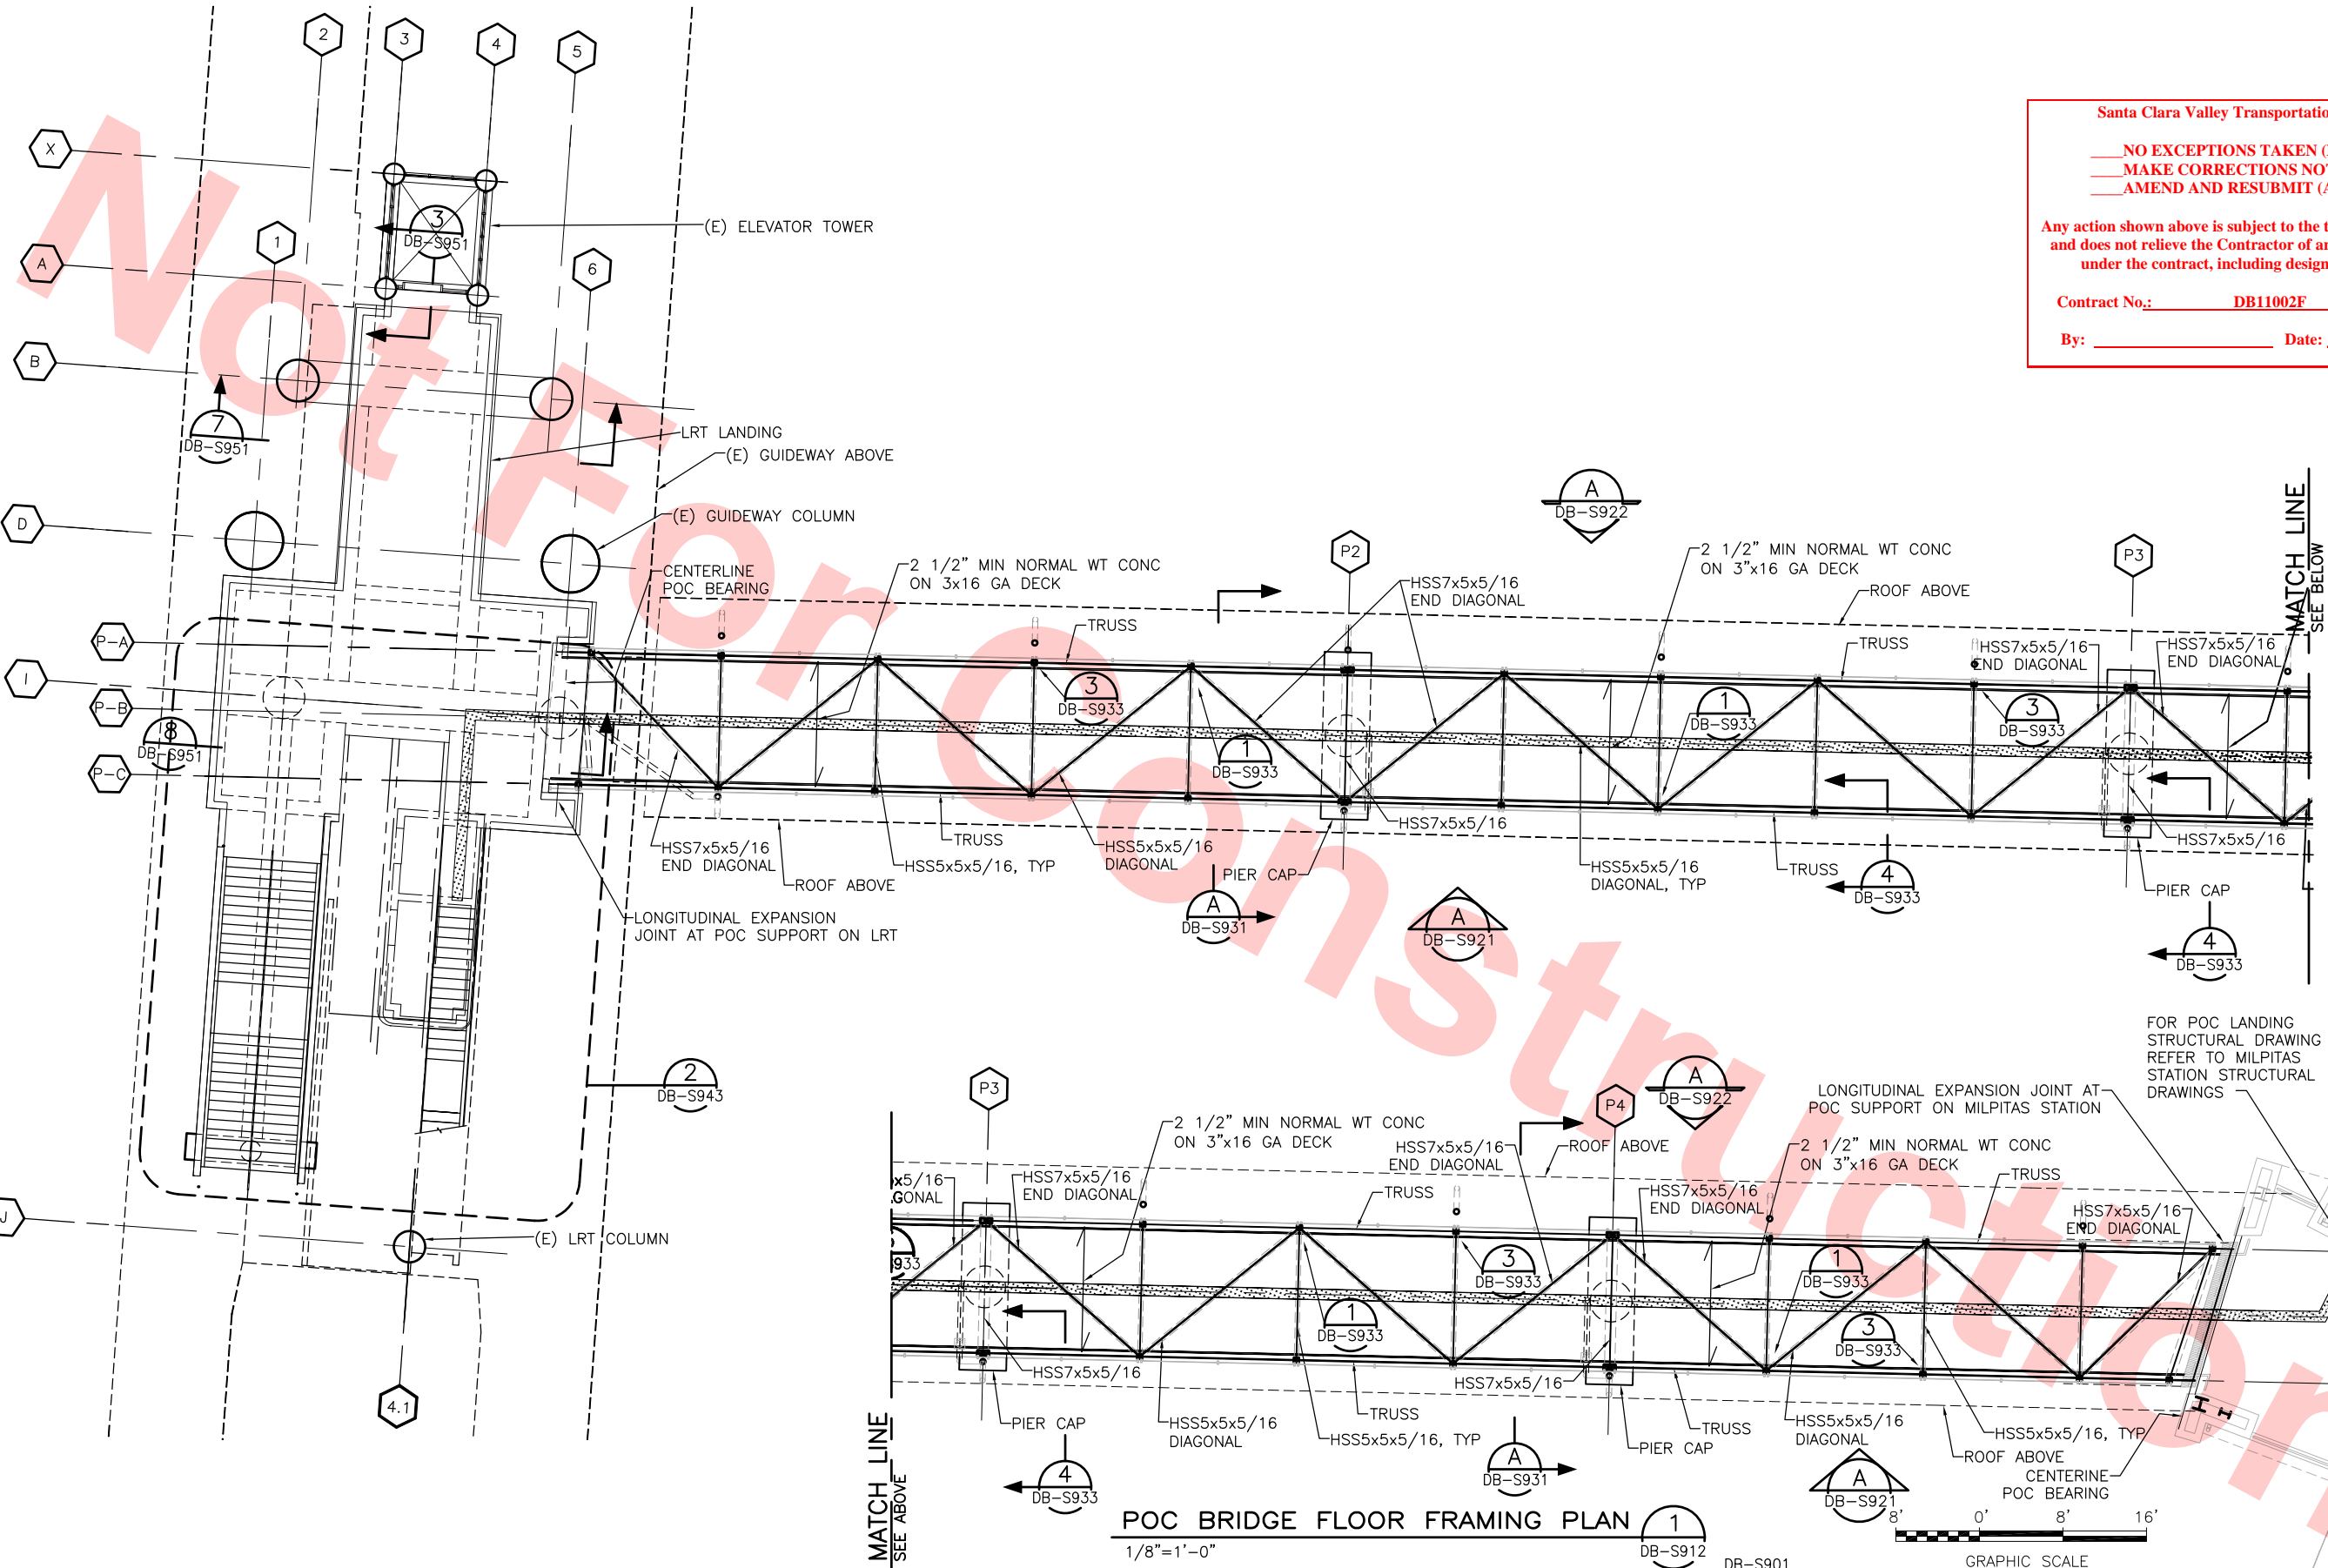

Santa Clara Valley Transportation Authority

NO EXCEPTIONS TAKEN (NET)  
MAKE CORRECTIONS NOTED (MCN)  
AMEND AND RESUBMIT (A/R)

Any action shown above is subject to the terms of the contract and does not relieve the Contractor of any of its obligations under the contract, including design and detailing.


Contract No.: DB11002F

By: \_\_\_\_\_ Date: \_\_\_\_\_

Jun 28, 2013 12:37pm C:\projects\mva\copy of copy of mva-template (5) (1)\mva60946\7100-S-DB-S912.dwg

REV	DATE	BY	SUB	APP	DESCRIPTION
0	20130710				READINESS FOR CONSTRUCTION

DESIGNED BY  
J. DUNLEA  
DRAWN BY  
J. DUNLEA  
CHECKED BY  
S. DEBNATH  
IN CHARGE  
R. BARLAAN  
DATE  
20130710

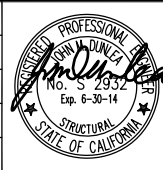

Skanska  
Shimmick  
Herzog

Anil Verma Associates, Inc.  
1970 Broadway, Suite 525  
Milpitas, California 95035  
A Joint Venture  
SUBMITTED

1436 California Circle  
Milpitas, California 95035  
A Joint Venture

Lookwood, Andrews  
& Newman, Inc.  
A LEOP A BALLY COMPANY  
T-Y-LIN INTERNATIONAL  
APPROVED




LINE, TRACK, STATIONS AND SYSTEMS  
DESIGN UNIT 023  
MONTAGUE LRT AND MILPITAS POC  
POC BRIDGE FLOOR FRAMING PLAN

CADD FILENAME C700-S-DB-S912.dwg	REV. 0
SIZE D	SCALE 1/8"=1'-0"
CONTRACT NO. C700	PAGE NO. 0305
AREA CODE DB	SHEET NO. S912



Jun 28, 2013 12:37pm C:\projects\mcs\copy of copy of mcs-template (5) (1)\mcs60946\CT00-S-DB-S913.dwg

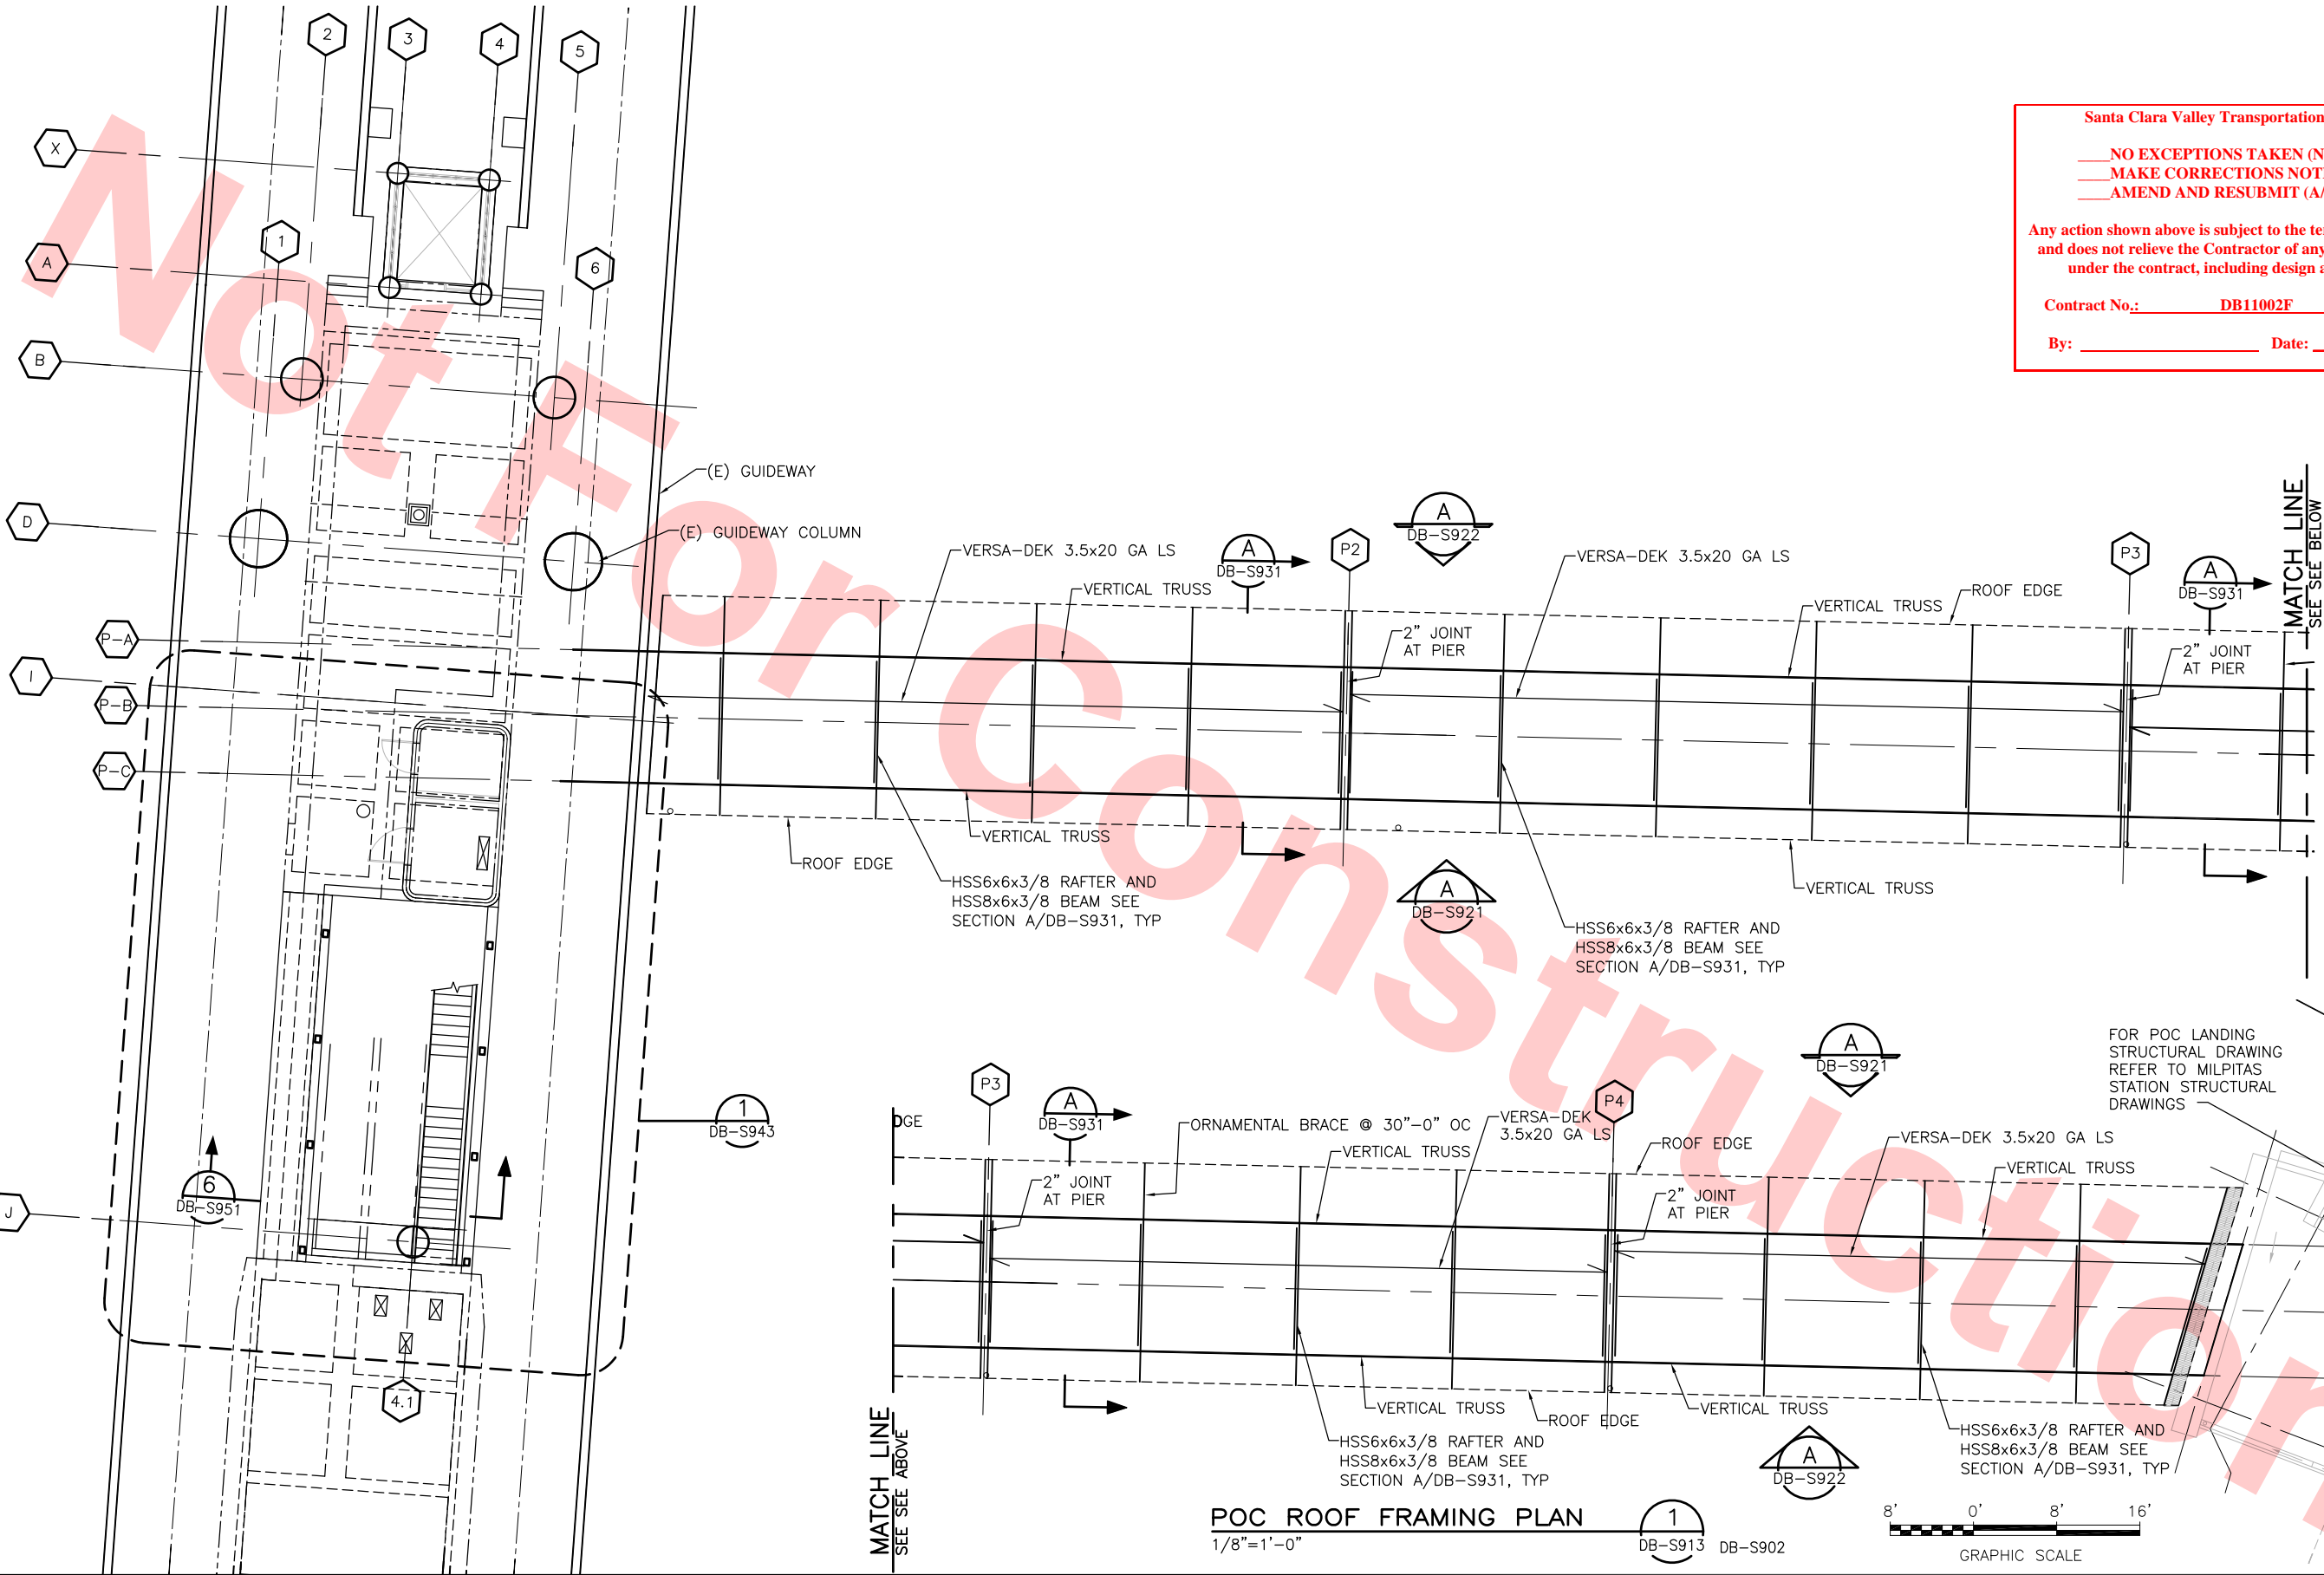

Santa Clara Valley Transportation Authority

NO EXCEPTIONS TAKEN (NET)

MAKE CORRECTIONS NOTED (MCN)


AMEND AND RESUBMIT (A/R)

Any action shown above is subject to the terms of the contract and does not relieve the Contractor of any of its obligations under the contract, including design and detailing.

Contract No.: DB11002F

By: \_\_\_\_\_ Date: \_\_\_\_\_

REV	DATE	BY	SUB	APP	DESCRIPTION
0	20130710				READINESS FOR CONSTRUCTION

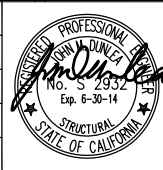

Skanska  
Shimmick  
Herzog

1436 California Circle  
Milpitas, California 95035  
A Joint Venture

Anil Verma Associates, Inc.  
1970 Broadway, Suite 525  
Oakland, CA 94612  
Phone: (510) 455-2537 Fax: (510) 535-2339

Lookwood, Andrews  
& Newnam, Inc.  
A LEO A DALY COMPANY

T-Y-LIN INTERNATIONAL

APPROVED  
*[Signature]*


BART SILICON VALLEY BERRYESSA EXTENSION

LINE, TRACK, STATIONS AND SYSTEMS  
DESIGN UNIT 023  
MONTAGUE LRT AND MILPITAS POC

POC ROOF FRAMING PLAN

CADD FILENAME C700-S-DB-S913.dwg	REV.	0
SIZE D	SCALE 1/8"=1'-0"	
CONTRACT NO. C700	SHEET NO. S913	PAGE NO. 0306



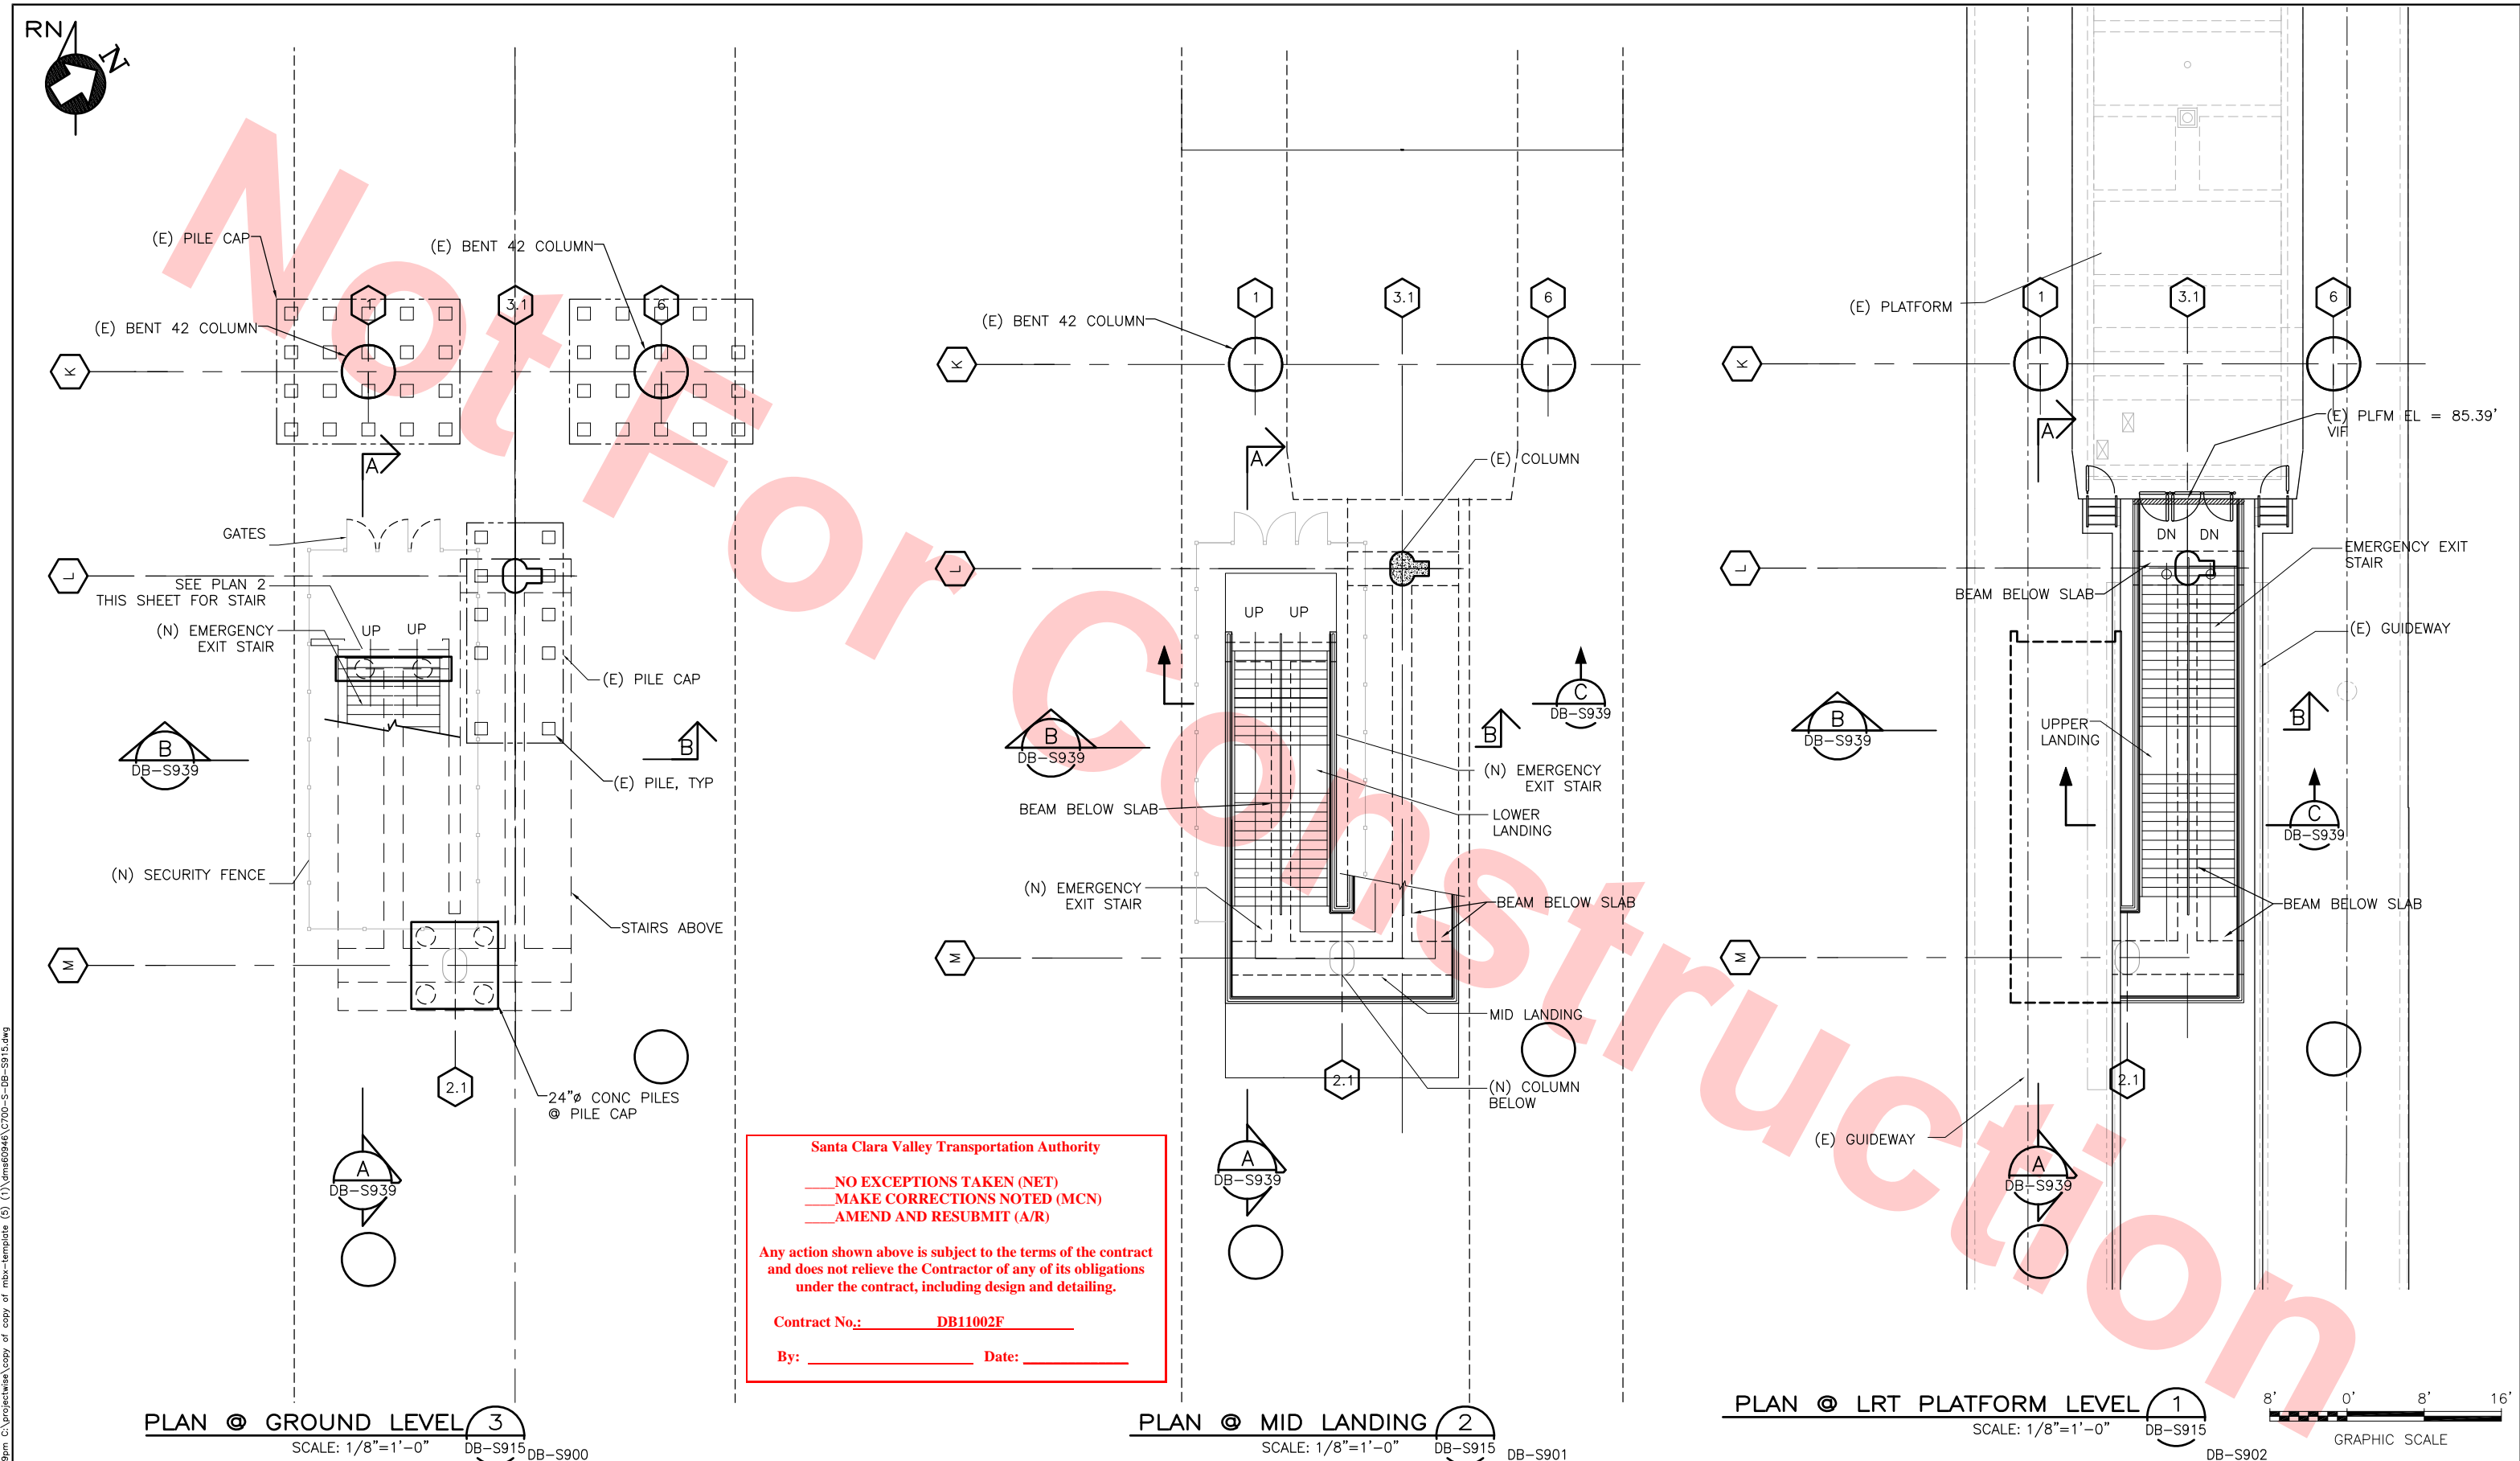

Santa Clara Valley Transportation Authority


NO EXCEPTIONS TAKEN (NET)  
MAKE CORRECTIONS NOTED (MCN)  
AMEND AND RESUBMIT (A/R)

Any action shown above is subject to the terms of the contract and does not relieve the Contractor of any of its obligations under the contract, including design and detailing.

Contract No.: DB11002F

By: \_\_\_\_\_ Date: \_\_\_\_\_

DESIGNED BY J. DUNLEA				
DRAWN BY J. DUNLEA				
CHECKED BY S. DEBNATH				
IN CHARGE R. BARLAAN				
DATE 20130710				
0	20130710			READINESS FOR CONSTRUCTION
REV	DATE	BY	SUB	APP

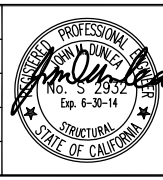

**Skanska Shimmick Herzog**

1436 California Circle  
Milpitas, California 95035  
A Joint Venture

**Anil Verma Associates, Inc.**

1970 Broadway, Suite 525 Oakland, CA 94612  
Phone: (510) 455-2537 Fax: (510) 535-2339

**Lookwood, Andrews & Newman, Inc.**

A LEED A RATED COMPANY

**T-Y LIN INTERNATIONAL**

SUBMITTED

APPROVED

**BART SILICON VALLEY**


BART SILICON VALLEY BERRYESSA EXTENSION

LINE, TRACK, STATIONS AND SYSTEMS  
DESIGN UNIT 023  
MONTAGUE LRT AND MILPITAS POC  
LRT EMERGENCY EXIT STAIRS PLANS

CADD FILENAME C700-S-DB-S915.dwg		
SIZE	SCALE	
D	1/8"=1'-0"	
CONTRACT NO.	C700	REV. 0
AREA CODE	DB	SHEET NO. S915
		PAGE NO. 0307




Jun 28, 2013 12:41 pm C:\projects\mva\copy of copy of mva-template (5) (1)\mva60946\CT00-S-DB-S921.dwg

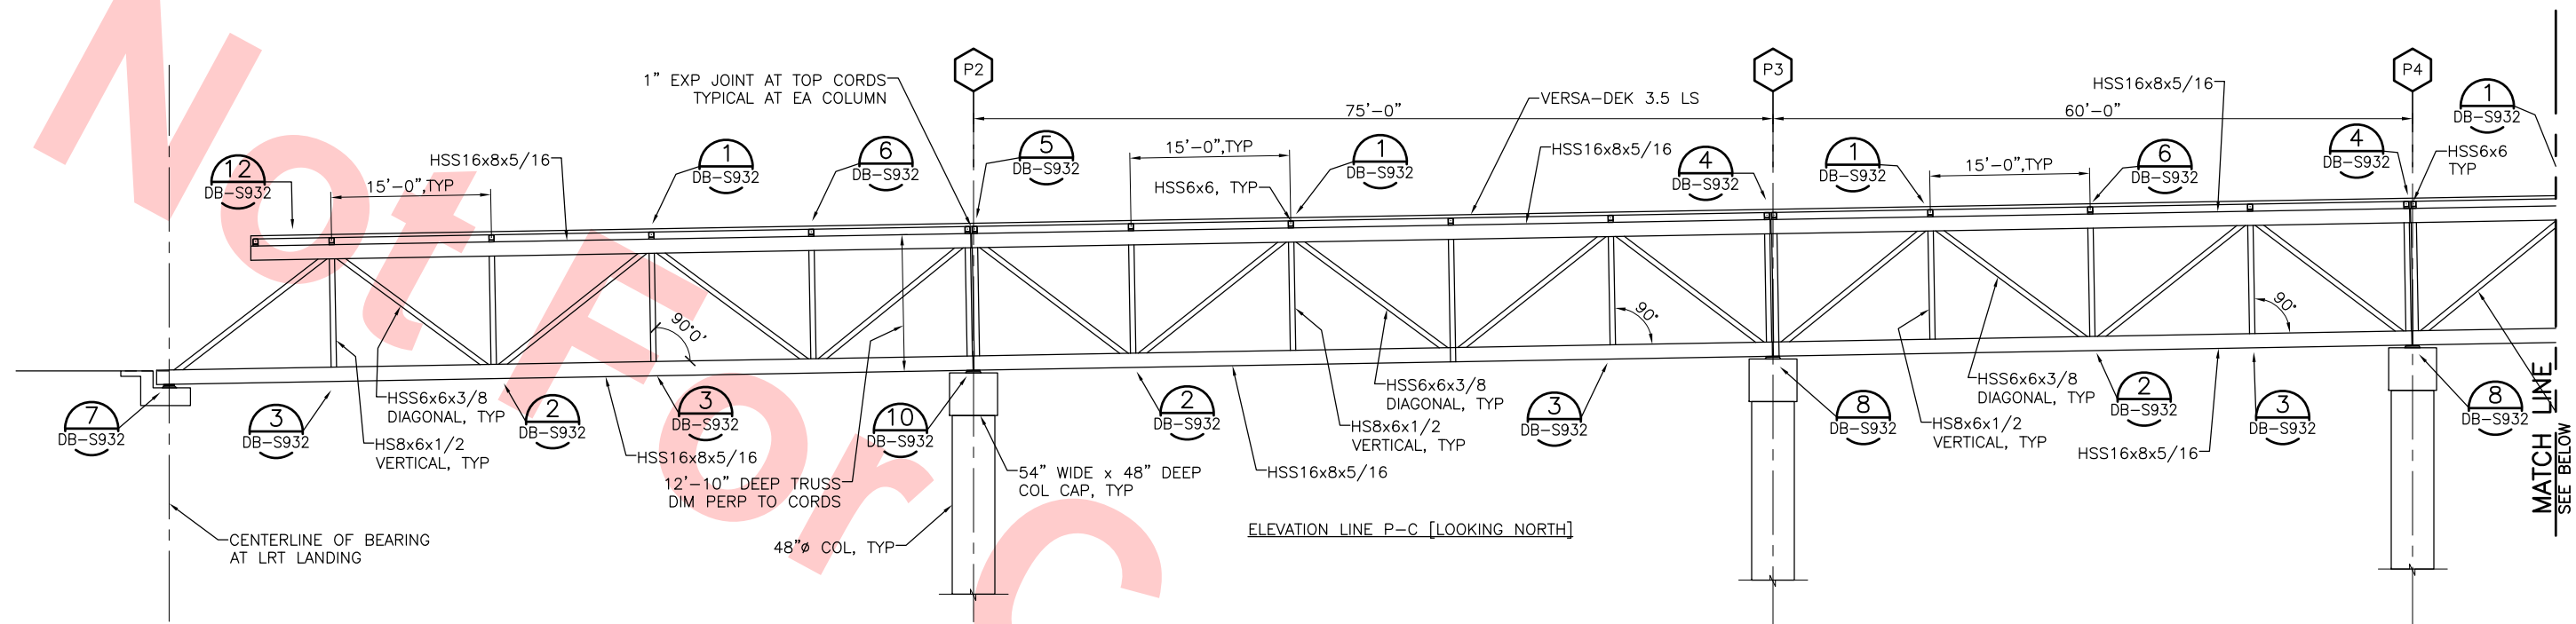

NOTES:

1. TRUSS CONNECTION DETAILS ON THIS SHEET ARE DRAWN OPPOSITE HAND ON DB-S932.

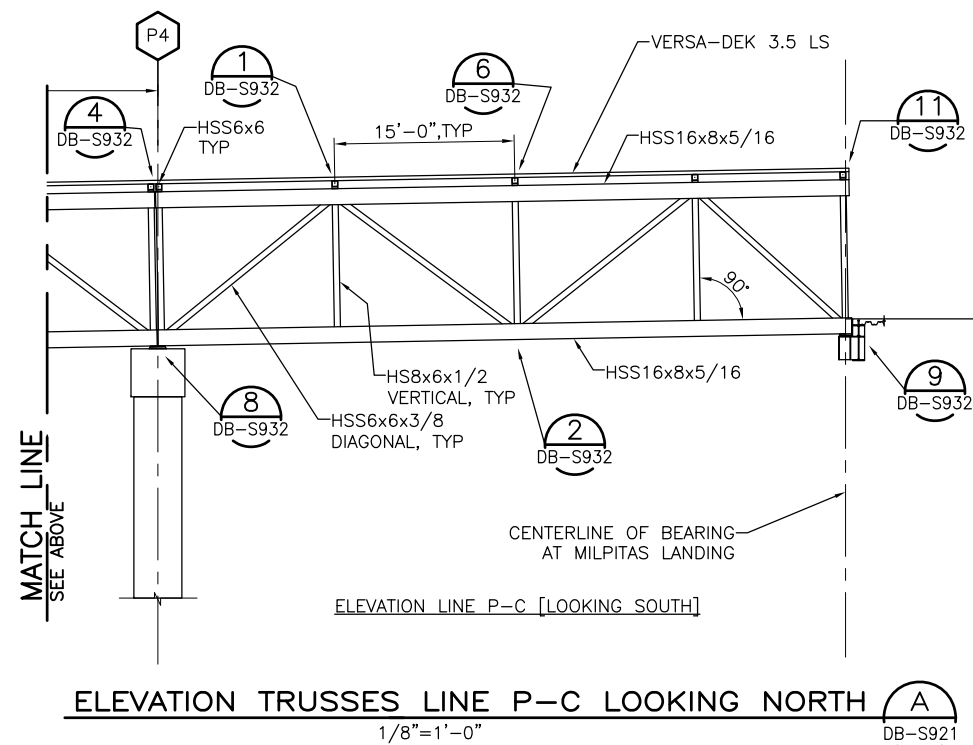

ELEVATION TRUSSES LINE P-C LOOKING NORTH

1/8"=1'-0"

A

DB-S900  
DB-S901  
DB-S902  
DB-S912  
DB-S913

Santa Clara Valley Transportation Authority

- NO EXCEPTIONS TAKEN (NET)
- MAKE CORRECTIONS NOTED (MCN)
- AMEND AND RESUBMIT (A/R)

Any action shown above is subject to the terms of the contract and does not relieve the Contractor of any of its obligations under the contract, including design and detailing.

Contract No.: DB11002F

By: \_\_\_\_\_ Date: \_\_\_\_\_



GRAPHIC SCALE

REV	DATE	BY	SUB	APP	DESCRIPTION
0	20130710				READINESS FOR CONSTRUCTION

DESIGNED BY  
J. DUNLEA  
DRAWN BY  
J. DUNLEA  
CHECKED BY  
S. DEBNATH  
IN CHARGE  
R. BARLAAN  
DATE  
20130710



Skanska  
Shimmick  
Herzog  
Anil Verma Associates, Inc.  
1970 Broadway, Suite 525  
Milpitas, California 95035  
Phone: (510) 855-2537 Fax: (510) 855-2339  
SUBMITTED

1436 California Circle  
Milpitas, California 95035  
A Joint Venture  
Lookwood, Andrews  
& Newman, Inc.  
A LEOP A BALLY COMPANY  
T-Y LIN INTERNATIONAL  
APPROVED



BART SILICON VALLEY BERRYESSA EXTENSION



LINE, TRACK, STATIONS AND SYSTEMS  
DESIGN UNIT 023  
MONTAGUE LRT AND MILPITAS POC

ELEVATION TRUSSES LINE P-C

CADD FILENAME C700-S-DB-S921.dwg	REV. 0
SIZE D	SCALE 1/8"=1'-0"
CONTRACT NO. C700	SHEET NO. S921
AREA CODE DB	PAGE NO. 0308



Jun 28, 2013 - 12:42pm C:\projects\mva\copy of copy of mva-template (5) (1)\mva60946\CT00-S-DB-S922.dwg

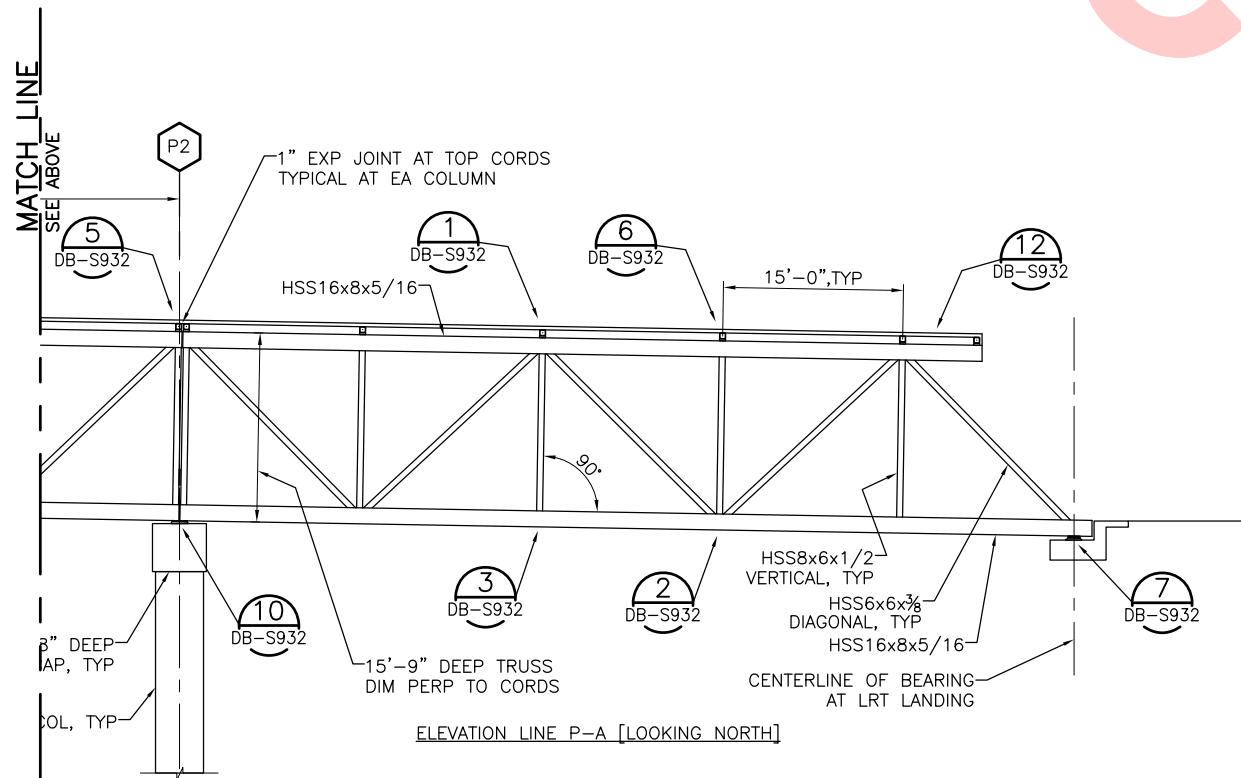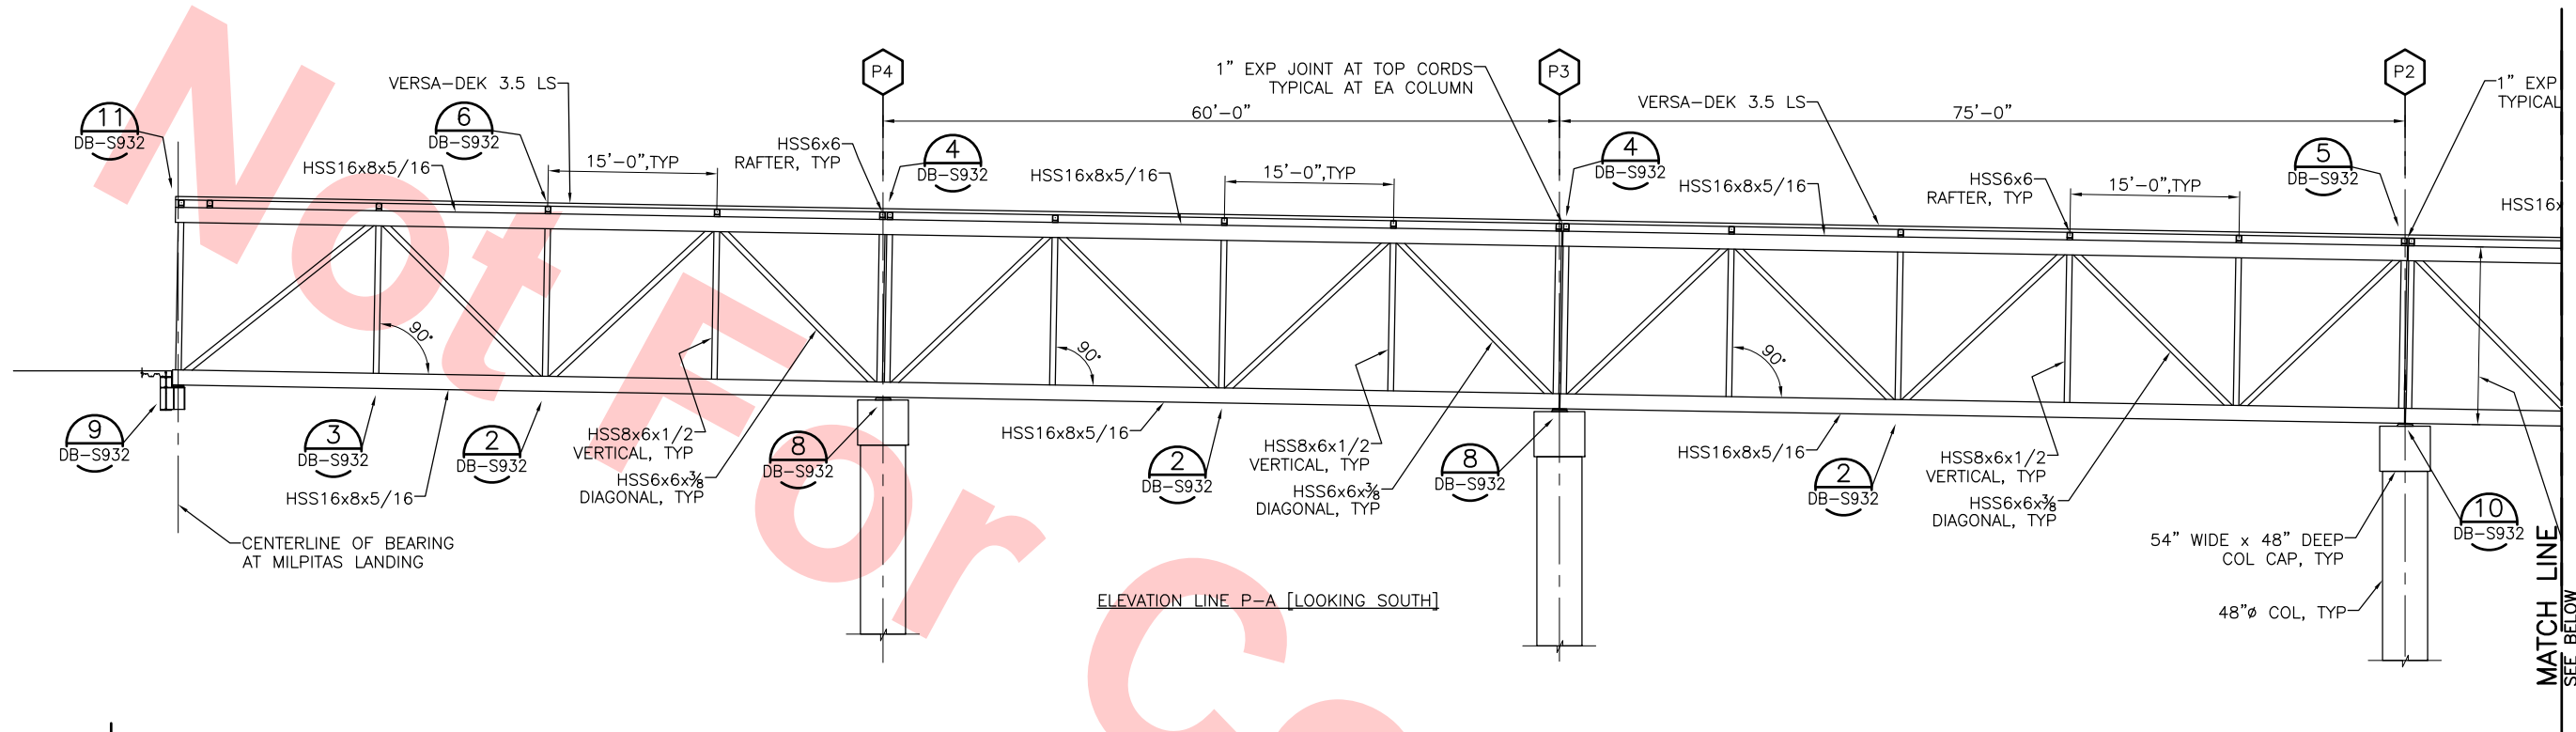

ELEVATION TRUSSES LINE P-A LOOKING SOUTH  
1/8"=1'-0"


DB-S900  
DB-S901  
DB-S902  
DB-S912  
DB-S913

Santa Clara Valley Transportation Authority

NO EXCEPTIONS TAKEN (NET)  
MAKE CORRECTIONS NOTED (MCN)  
AMEND AND RESUBMIT (A/R)


Any action shown above is subject to the terms of the contract and does not relieve the Contractor of any of its obligations under the contract, including design and detailing.

Contract No.: DB11002F  
By: \_\_\_\_\_ Date: \_\_\_\_\_

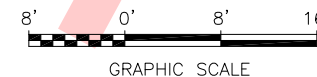

REV	DATE	BY	SUB	APP	DESCRIPTION
0	20130710				READINESS FOR CONSTRUCTION

DESIGNED BY  
J. DUNLEA  
DRAWN BY  
J. DUNLEA  
CHECKED BY  
S. DEBNATH  
IN CHARGE  
R. BARLAAN  
DATE  
20130710

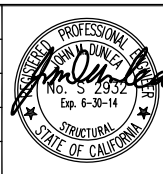

Skanska  
Shimmick  
Herzog

Anil Verma Associates, Inc.  
1970 Broadway, Suite 525  
Milpitas, California 95035  
Phone: (510) 855-2537 Fax: (510) 855-2339

1436 California Circle  
Milpitas, California 95035  
A Joint Venture

Lookwood, Andrews  
& Newnam, Inc.  
Exp. 6-30-14



T-Y-LIN INTERNATIONAL



LINE, TRACK, STATIONS AND SYSTEMS  
DESIGN UNIT 023  
MONTAGUE LRT AND MILPITAS POC  
ELEVATION TRUSSES LINE P-A

CADD FILENAME C700-S-DB-S922.dwg	REV. 0
SIZE D	SCALE 1/8"=1'-0"
CONTRACT NO. C700	SHEET NO. S922
AREA CODE DB	PAGE NO. 0309



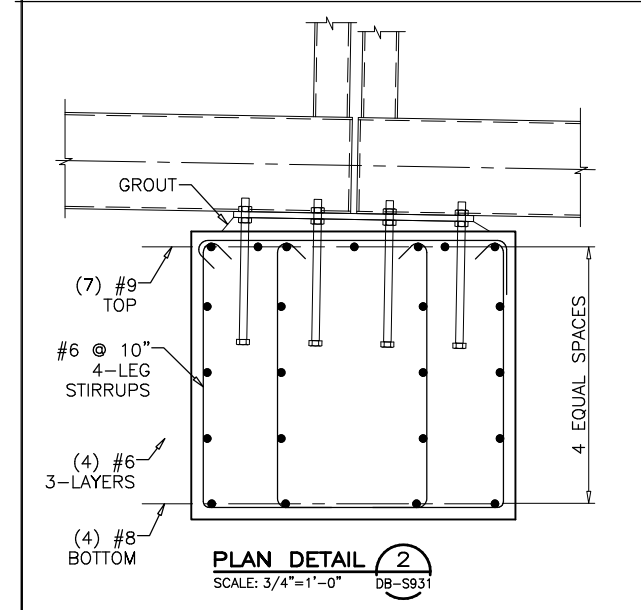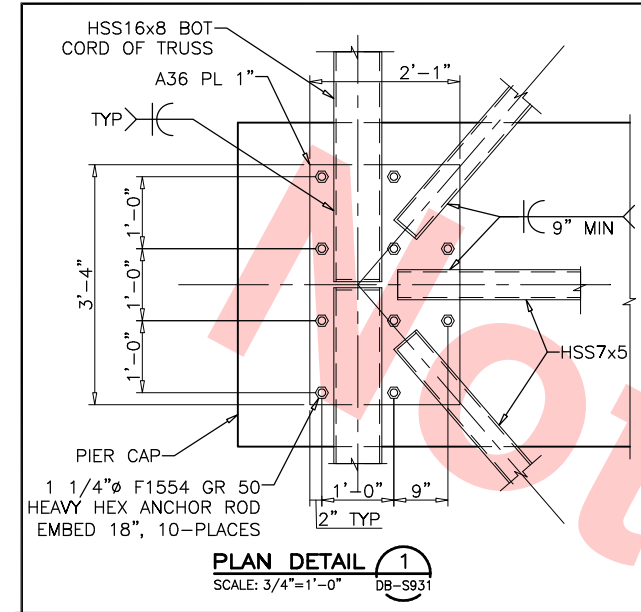

**Santa Clara Valley Transportation Authority**



NO EXCEPTIONS TAKEN (NET)  
MAKE CORRECTIONS NOTED (MCN)  
AMEND AND RESUBMIT (A/R)

Any action shown above is subject to the terms of the contract and does not relieve the Contractor of any of its obligations under the contract, including design and detailing.

Contract No.: DB11002F

By: \_\_\_\_\_ Date: \_\_\_\_\_

REV	DATE	BY	SUB	APP	DESCRIPTION
0	20130710				READINESS FOR CONSTRUCTION

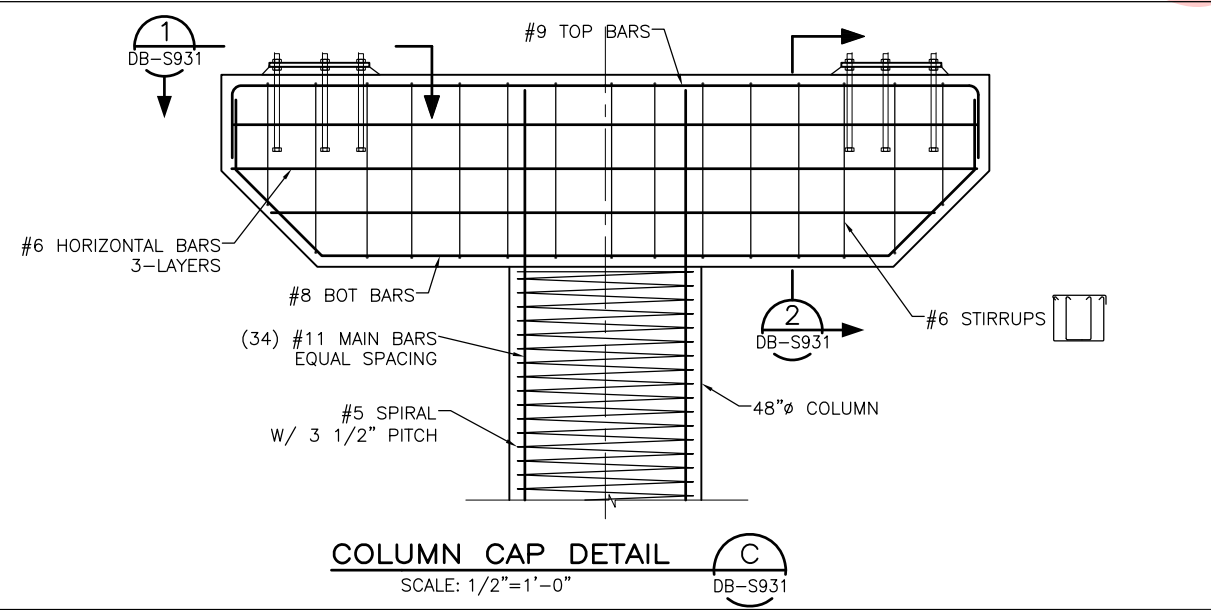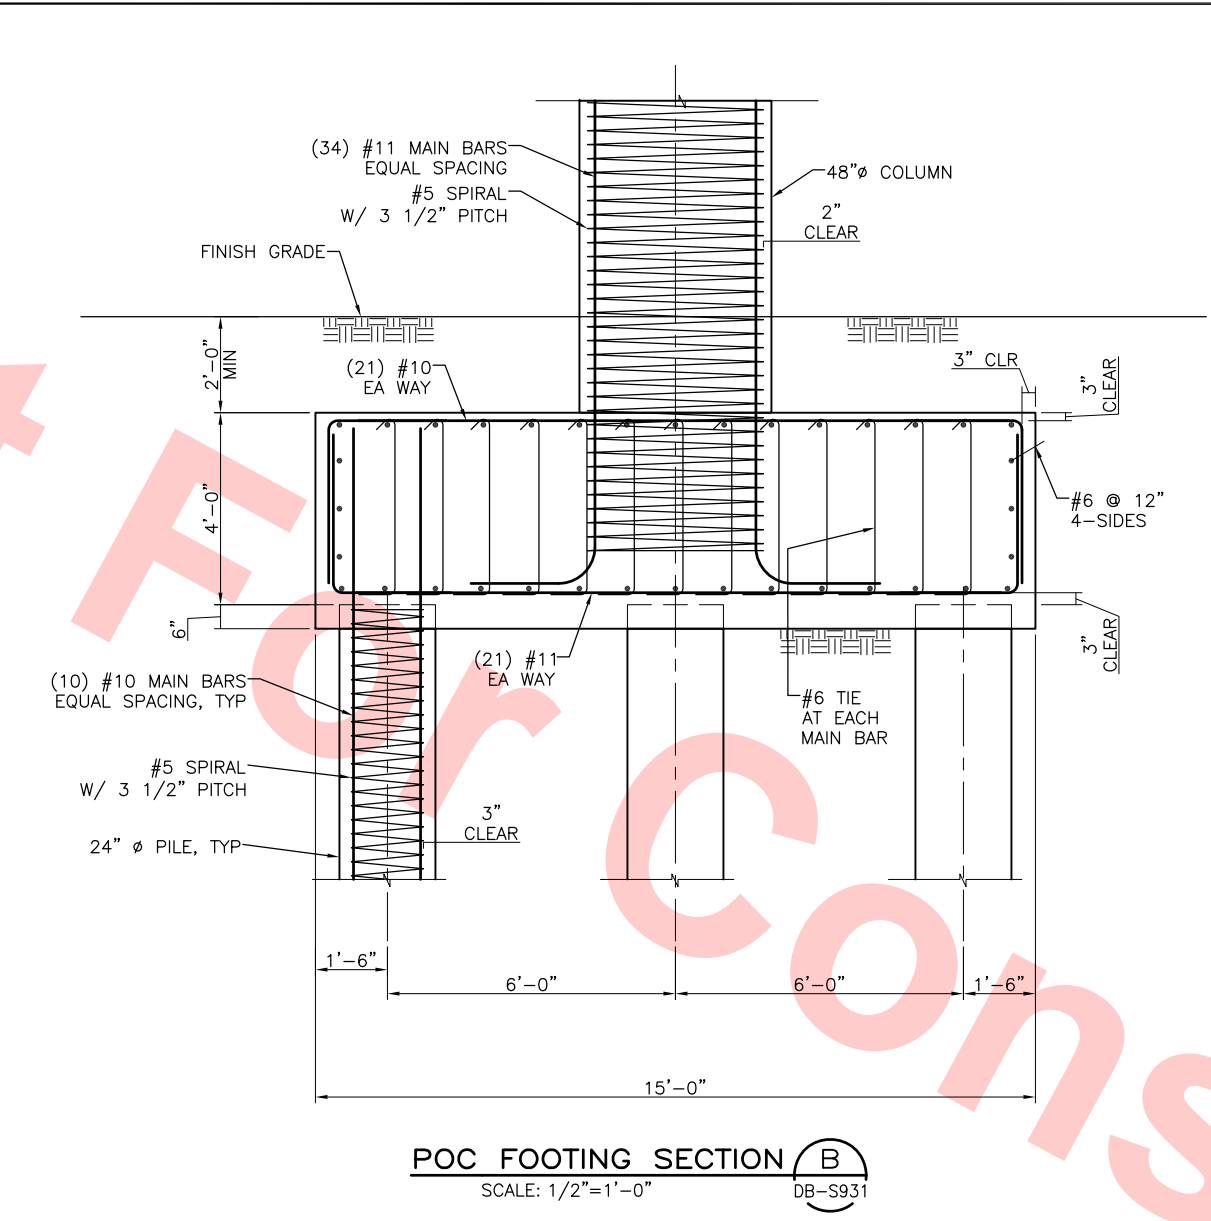

DESIGNED BY  
J. DUNLEA

DRAWN BY  
J. DUNLEA

CHECKED BY  
S. DEBNATH

IN CHARGE  
R. BARLAAN

DATE  
20130710


**Skanska Shimmick Herzog**

1436 California Circle  
Milpitas, California 95035  
A Joint Venture

**Anil Verma Associates, Inc.**  
1970 Broadway, Suite 525  
Oakland, CA 94612  
Phone: (510) 855-2537 Fax: (510) 855-2339

**Lookwood, Andrews & Newman, Inc.**  
A LEOPOLD & WOLFF COMPANY

**T-Y LIN INTERNATIONAL**

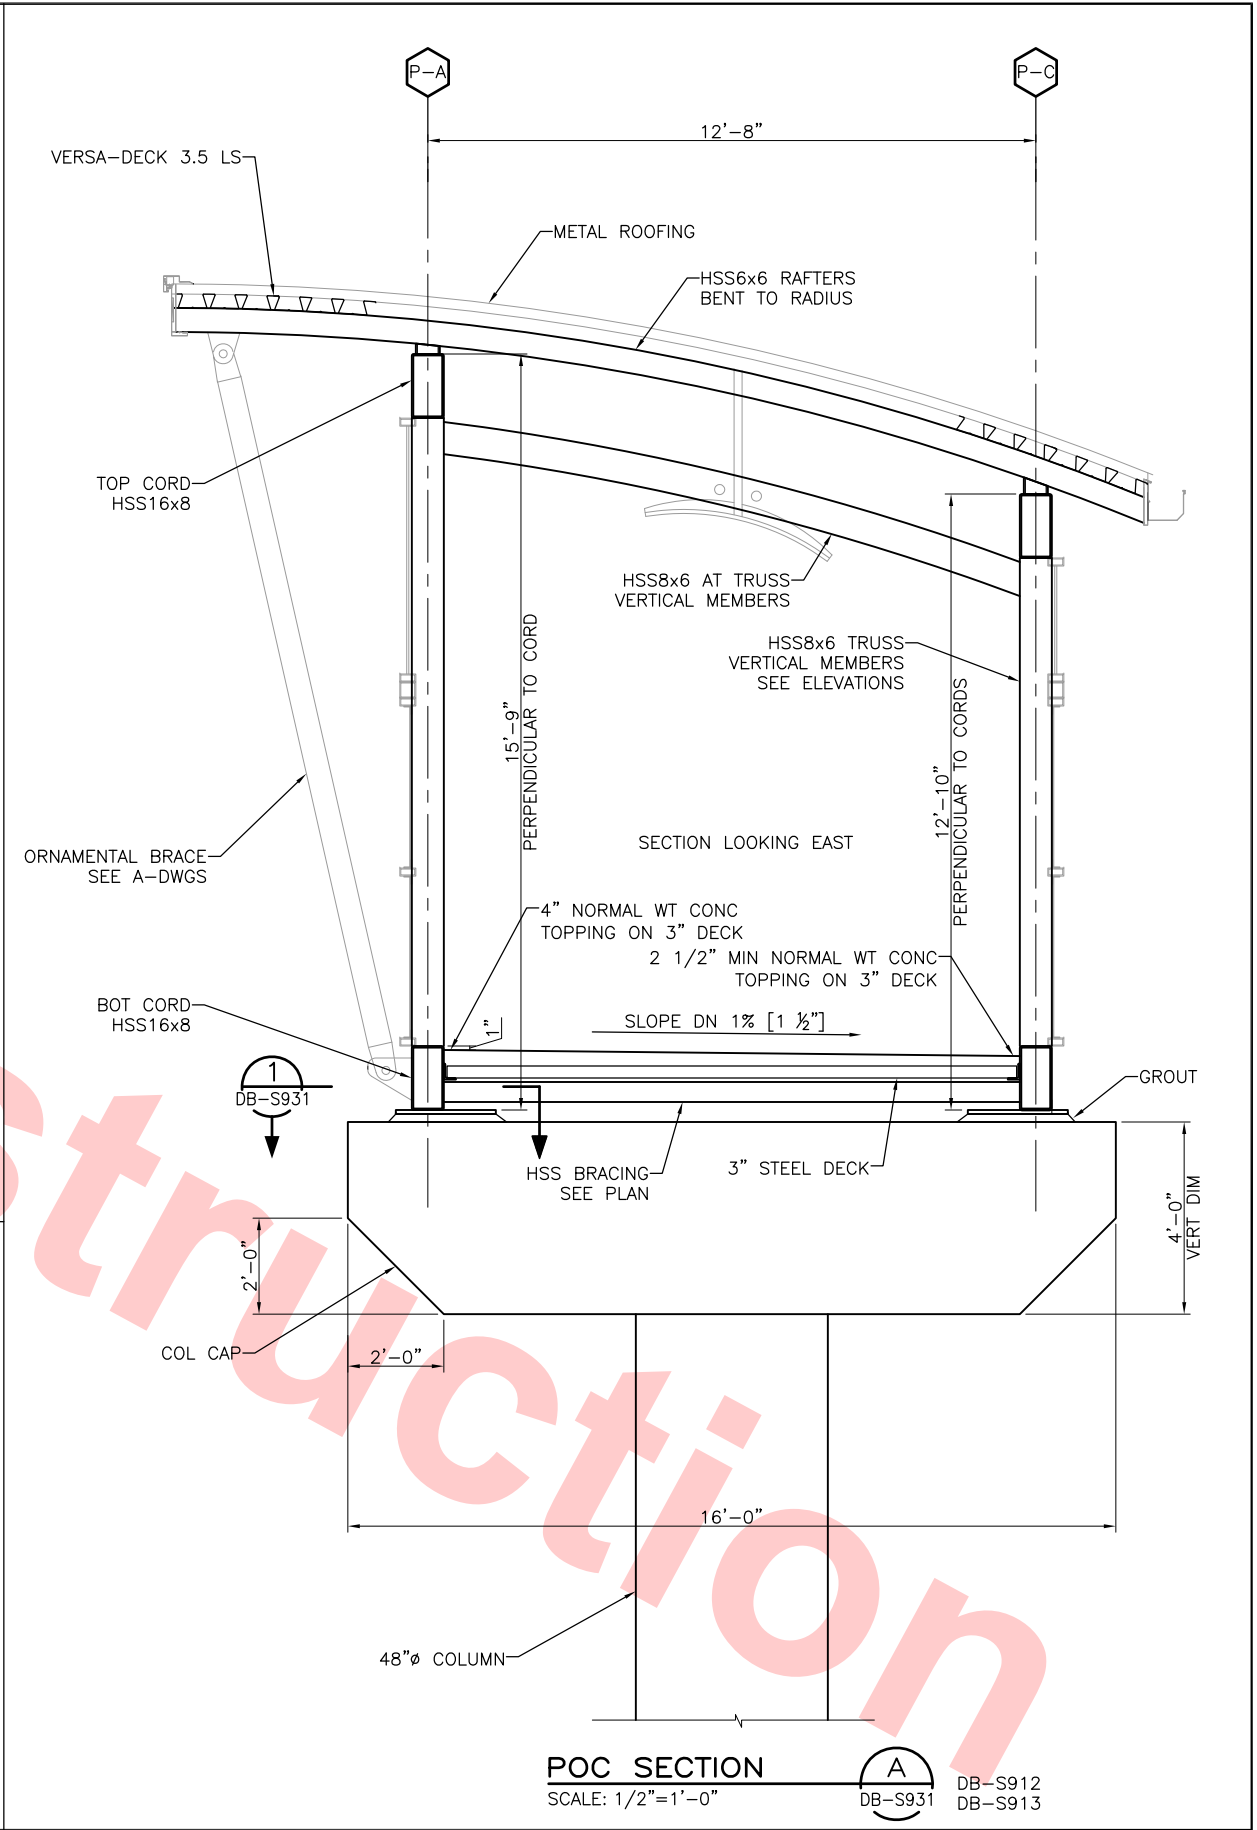

**BART SILICON VALLEY**

BART SILICON VALLEY BERRYESSA EXTENSION

**LINE, TRACK, STATIONS AND SYSTEMS**

DESIGN UNIT 023

MONTAGUE LRT AND MILPITAS POC

SECTIONS

SHEET 1 OF 2

CADD FILENAME  
C700-S-DB-S931.dwg

SIZE SCALE  
D 1/8"=1'-0"



CONTRACT NO.  
C700

AREA CODE SHEET NO. PAGE NO.  
DB S931 0310

REV. 0



Jun 28, 2013 12:45pm C:\projects\mva\copy of copy of mva-template (5) (1)\mva60946\CT00-S-DB-S932.dwg

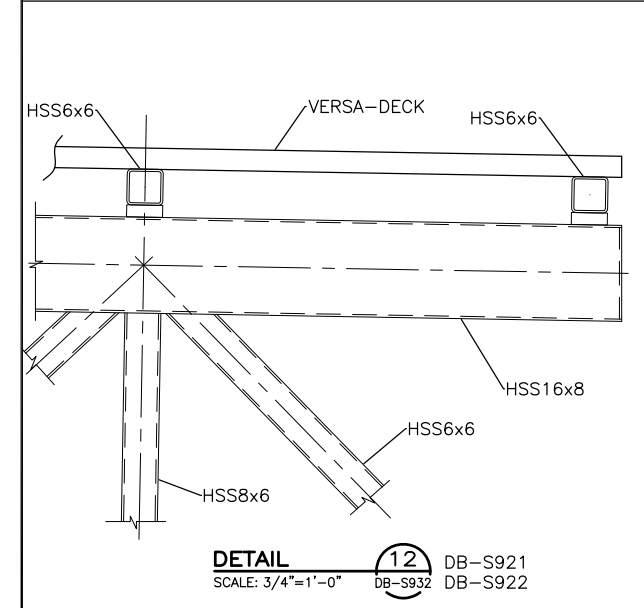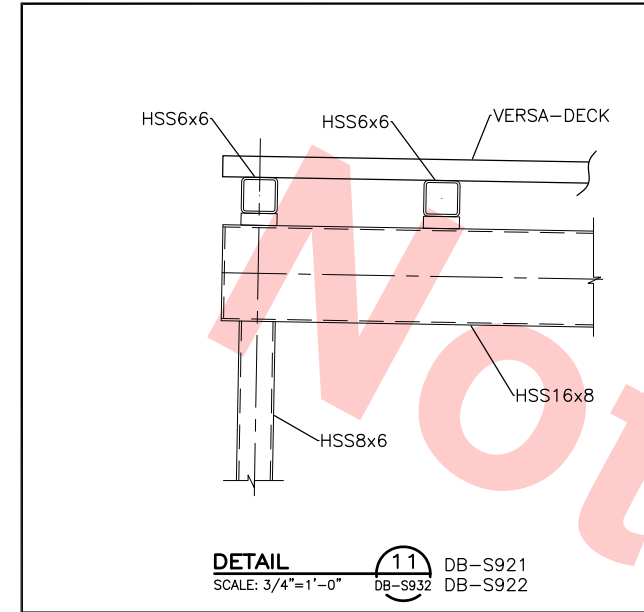









**Santa Clara Valley Transportation Authority**

\_\_\_NO EXCEPTIONS TAKEN (NET)  
\_\_\_MAKE CORRECTIONS NOTED (MCN)  
\_\_\_AMEND AND RESUBMIT (A/R)

Any action shown above is subject to the terms of the contract and does not relieve the Contractor of any of its obligations under the contract, including design and detailing.


Contract No.: DB11002F

By: \_\_\_\_\_ Date: \_\_\_\_\_

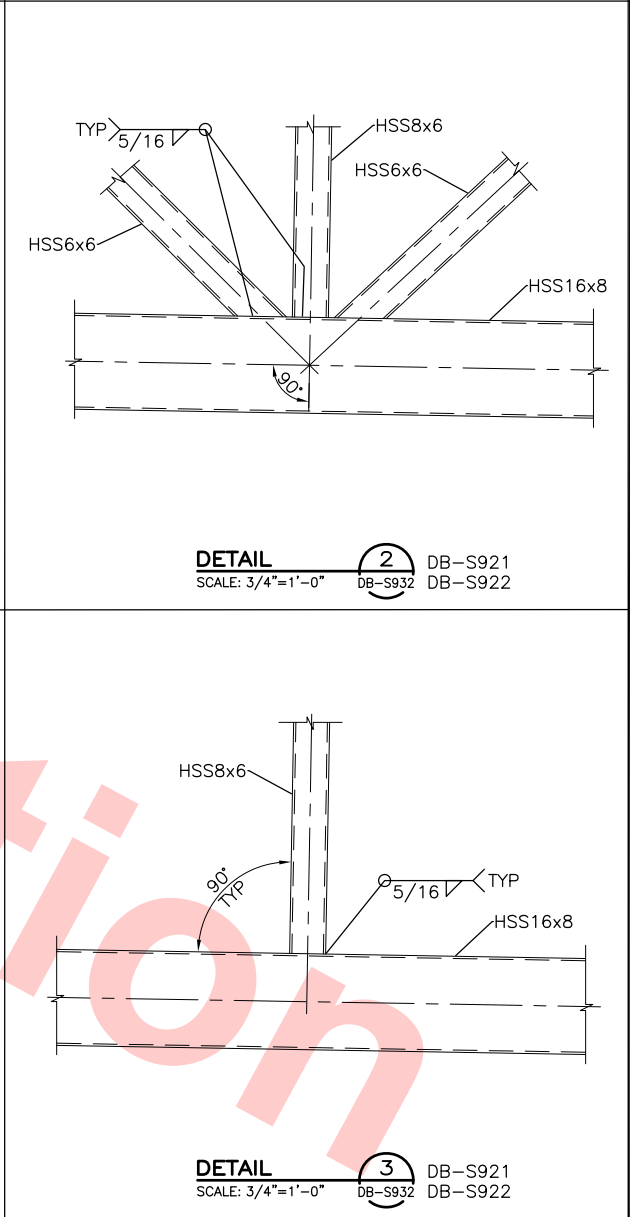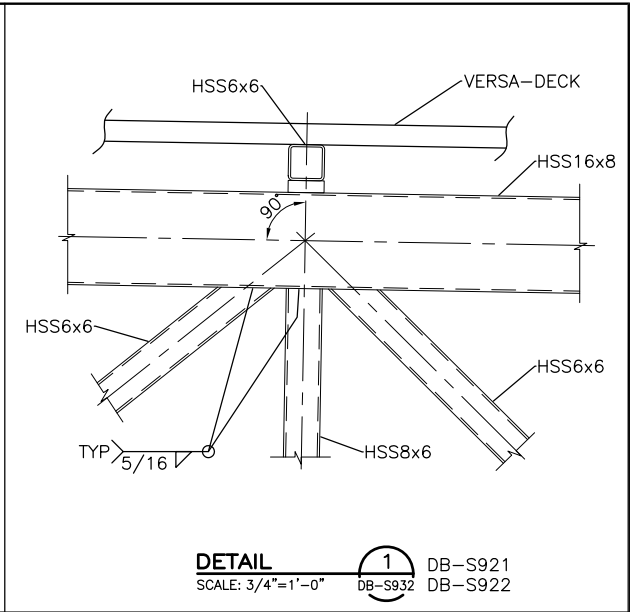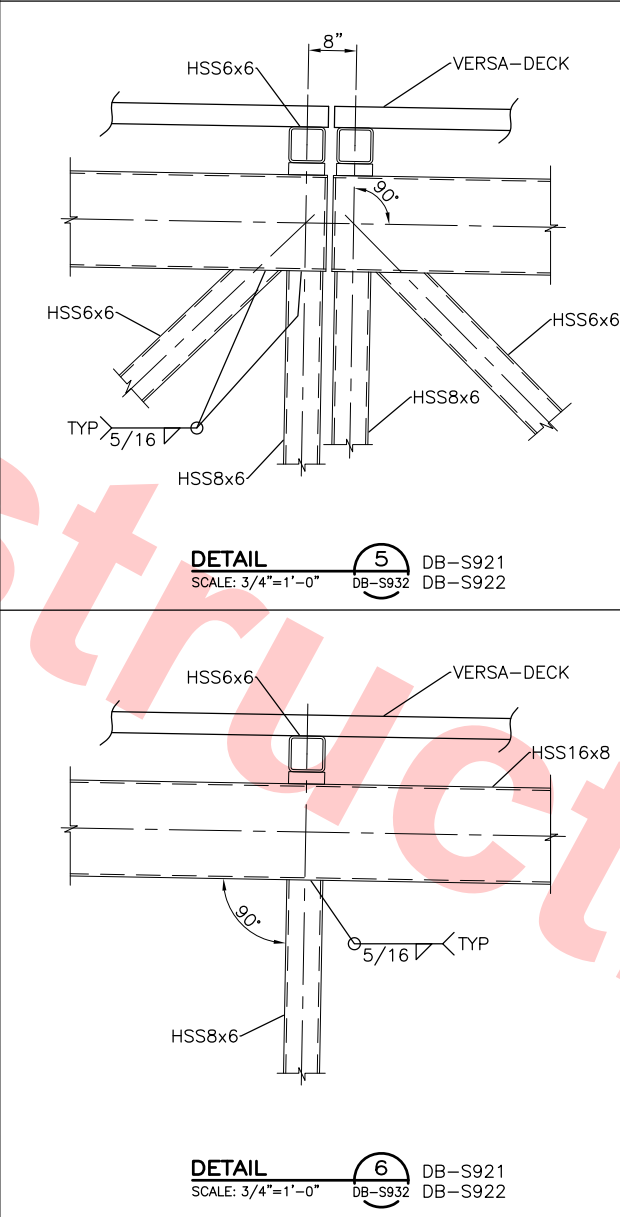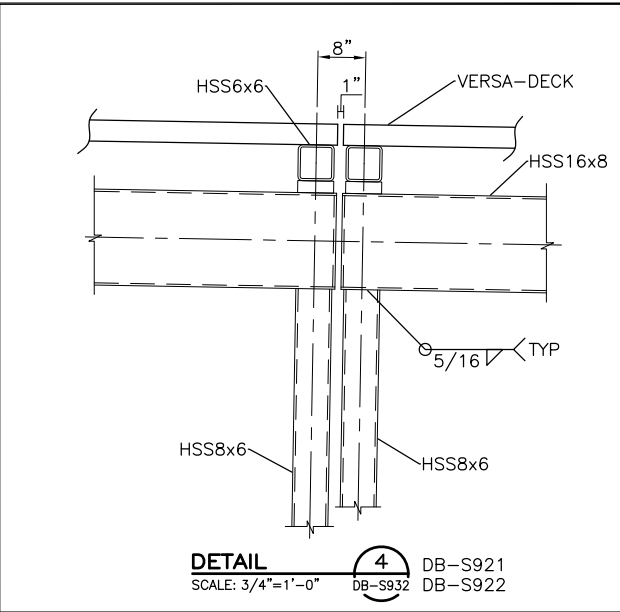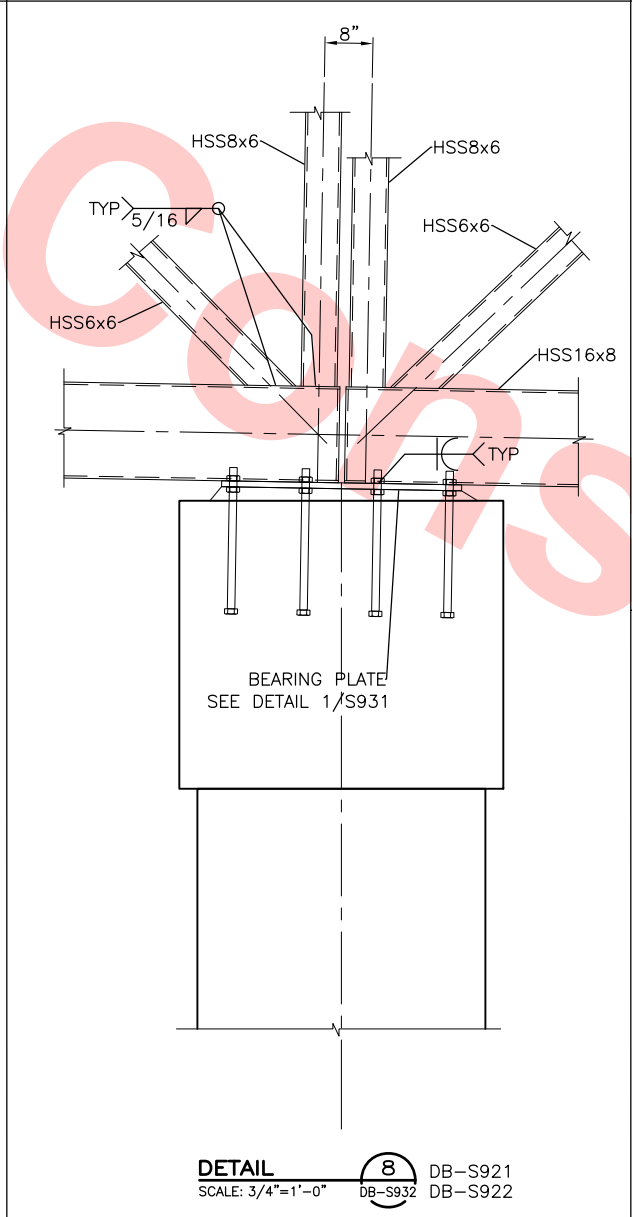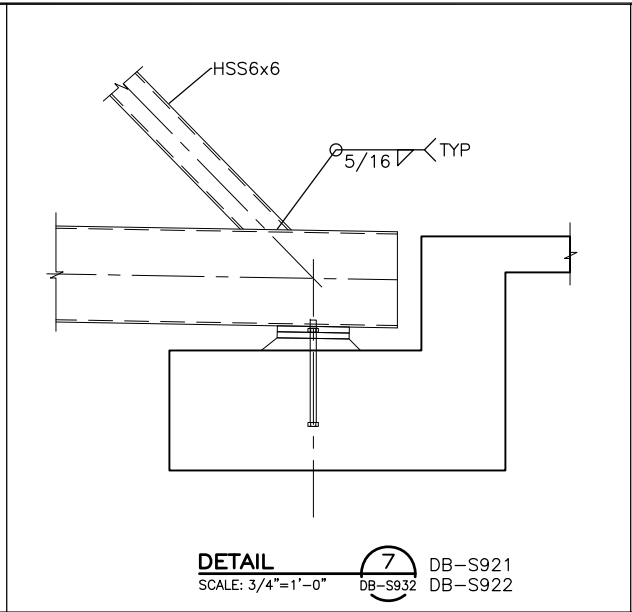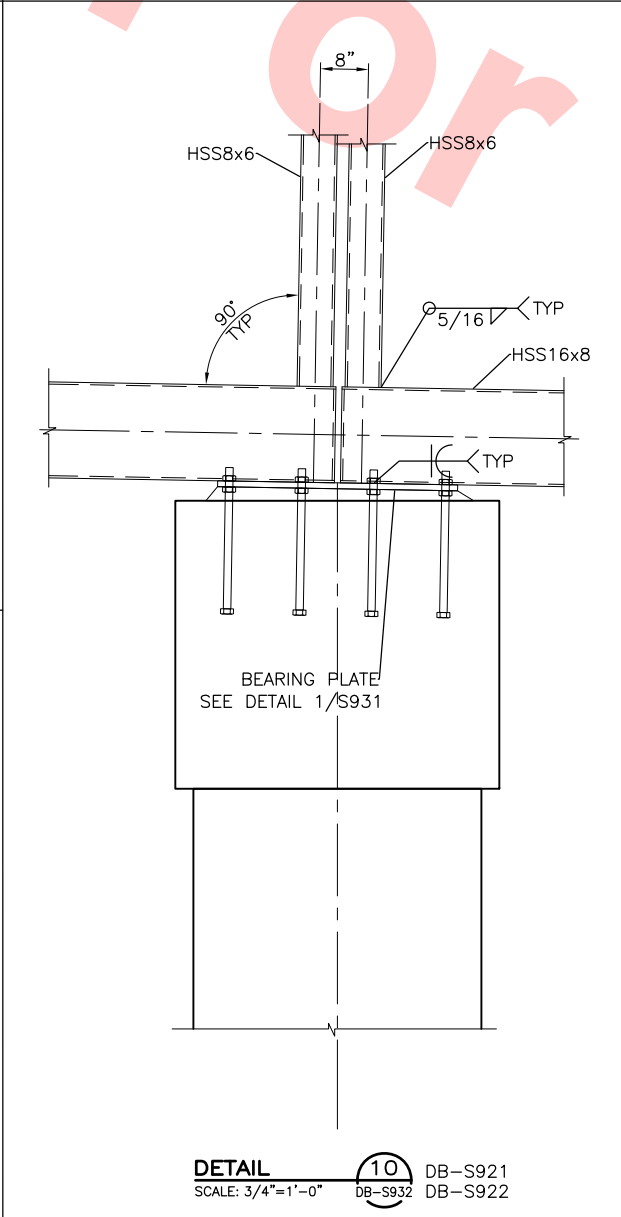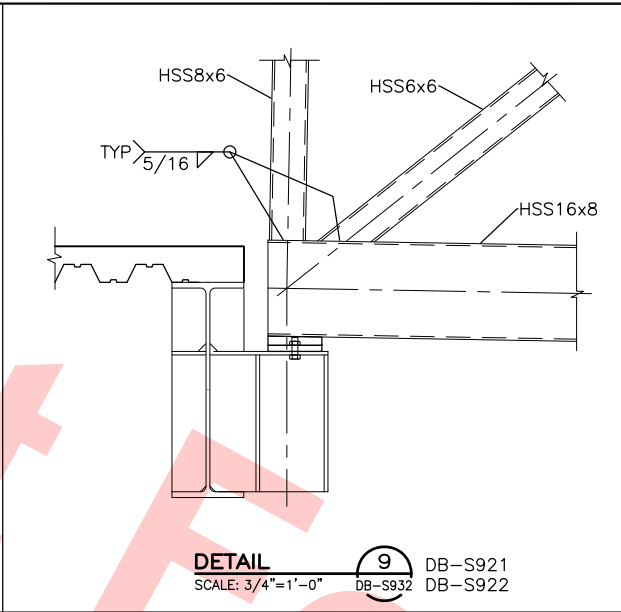

REV	DATE	BY	SUB	APP	DESCRIPTION
0	20130710				READINESS FOR CONSTRUCTION

DESIGNED BY  
J. DUNLEA  
DRAWN BY  
J. DUNLEA  
CHECKED BY  
S. DEBNATH  
IN CHARGE  
R. BARLAAN  
DATE  
20130710

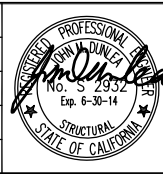


**Skanska Shimmick Herzog**

**Anil Verma Associates, Inc.**  
1970 Broadway, Suite 525 Oakland, CA 94612  
Phone: (510) 855-2537 Fax: (510) 535-2339

1436 California Circle  
Milpitas, California 95035  
A Joint Venture

**Lookwood, Andrews & Newman, Inc.**  
T-Y LIN INTERNATIONAL  
A LEOPALDY COMPANY

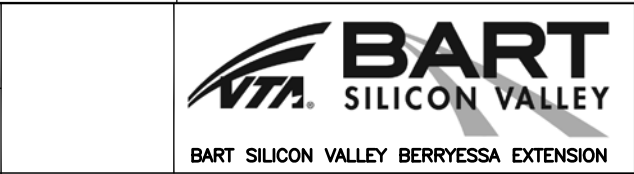

LINE, TRACK, STATIONS AND SYSTEMS  
DESIGN UNIT 023  
MONTAGUE LRT AND MILPITAS POC

SECTIONS, SHEET 2 OF 2

CADD FILENAME  
C700-S-DB-S932.dwg  
SIZE SCALE  
D 3/4"=1'-0"  
CONTRACT NO.  
C700  
REV.  
0  
AREA CODE SHEET NO. PAGE NO.  
DB S932 0311



			<div><p><b>SECTION 4</b> SCALE: 3/4"=1'-0" DB-S912</p></div>	<div><p><b>PLAN DETAIL 1</b> SCALE: 3/4"=1'-0" DB-S912</p></div>
			<div><p><b>SECTION 2</b> SCALE: 3/4"=1'-0" DB-S933</p></div>	
		<div><p>Santa Clara Valley Transportation Authority</p><p><input type="checkbox"/> NO EXCEPTIONS TAKEN (NET) <input type="checkbox"/> MAKE CORRECTIONS NOTED (MCN) <input type="checkbox"/> AMEND AND RESUBMIT (A/R)</p><p>Any action shown above is subject to the terms of the contract and does not relieve the Contractor of any of its obligations under the contract, including design and detailing.</p><p>Contract No.: <u>DB11002F</u></p><p>By: _____ Date: _____</p></div>	<div><p><b>PLAN DETAIL 3</b> SCALE: 3/4"=1'-0" DB-S912</p></div>	

						DESIGNED BY J. DUNLEA
						DRAWN BY J. DUNLEA
						CHECKED BY S. DEBNATH
						IN CHARGE R. BARLAAN
O	20130710				READINESS FOR CONSTRUCTION	DATE 20130710
REV	DATE	BY	SUB	APP	DESCRIPTION	

**Anil Verma Associates, Inc.**  
 1970 Broadway, Suite 525 Oakland, CA 94612  
 Phone: (510) 485-7533 Fax: (510) 435-2339  
 SUBMITTED \_\_\_\_\_  
  
 APPROVED \_\_\_\_\_

**Skanska Shimmick Herzog**

1436 California Circle  
Milpitas, California 95035  
A Joint Venture

**BART SILICON VALLEY**  
 BART SILICON VALLEY BERRYESSA EXTENSION

# LINE, TRACK, STATIONS AND SYSTEMS

## DESIGN UNIT 023

### MONTAGUE LRT AND MILPITAS POC


POC DETAILS

CADD FILENAME C700-S-DB-S932.dwg	
SIZE	SCALE D      3/4"=1'-0"
CONTRACT NO. <b>C700</b>	REV. <b>0</b>
AREA CODE <b>DB</b>	PAGE NO. <b>S933 0312</b>








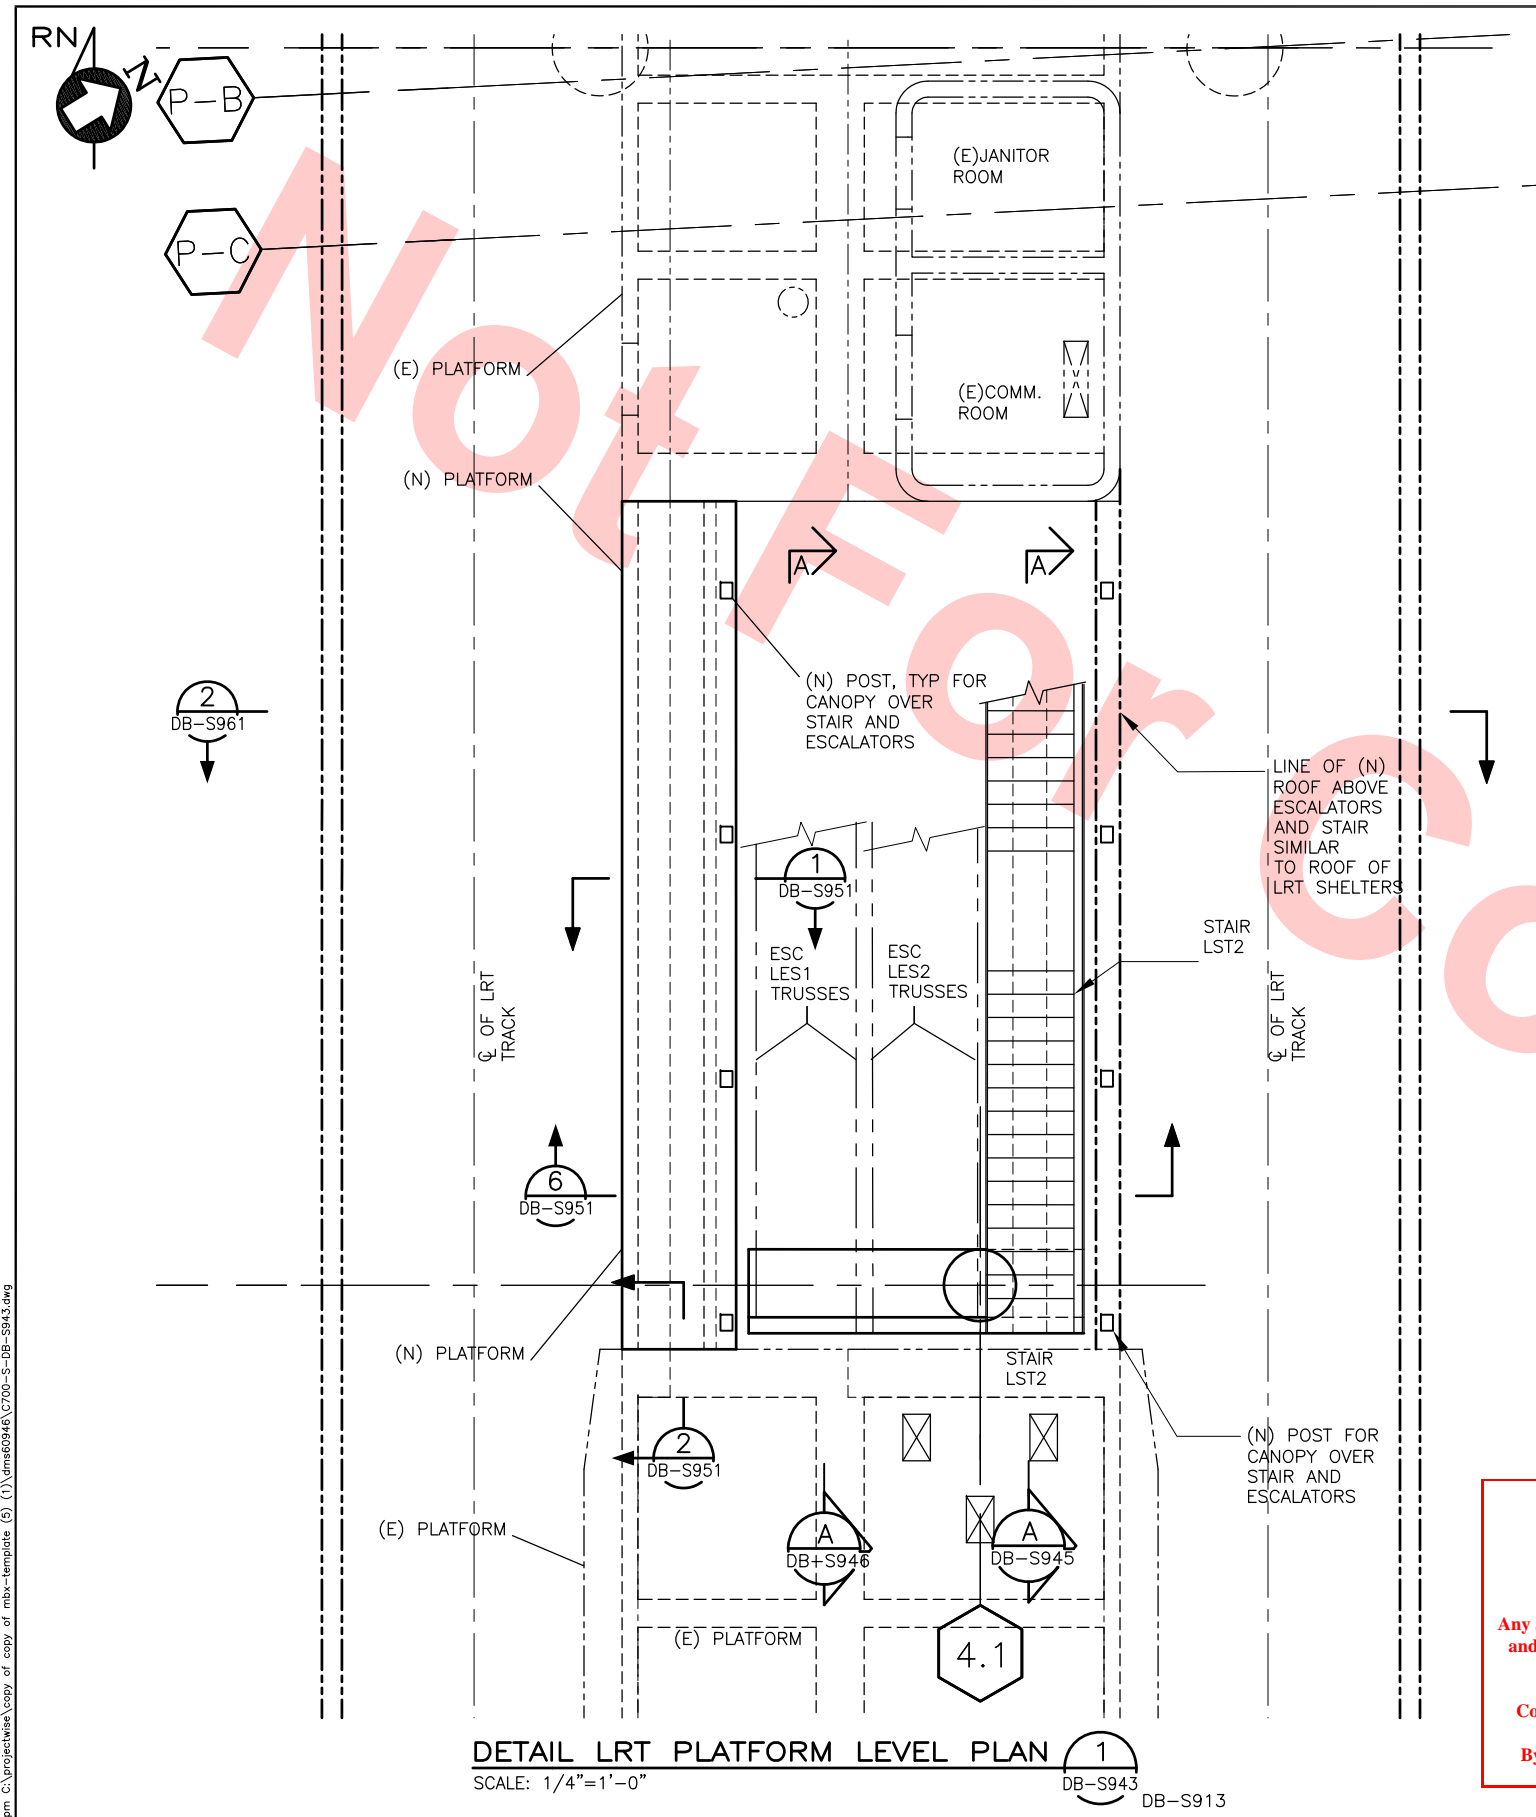

**DETAIL LRT PLATFORM LEVEL PLAN 1**  
SCALE: 1/4"=1'-0"

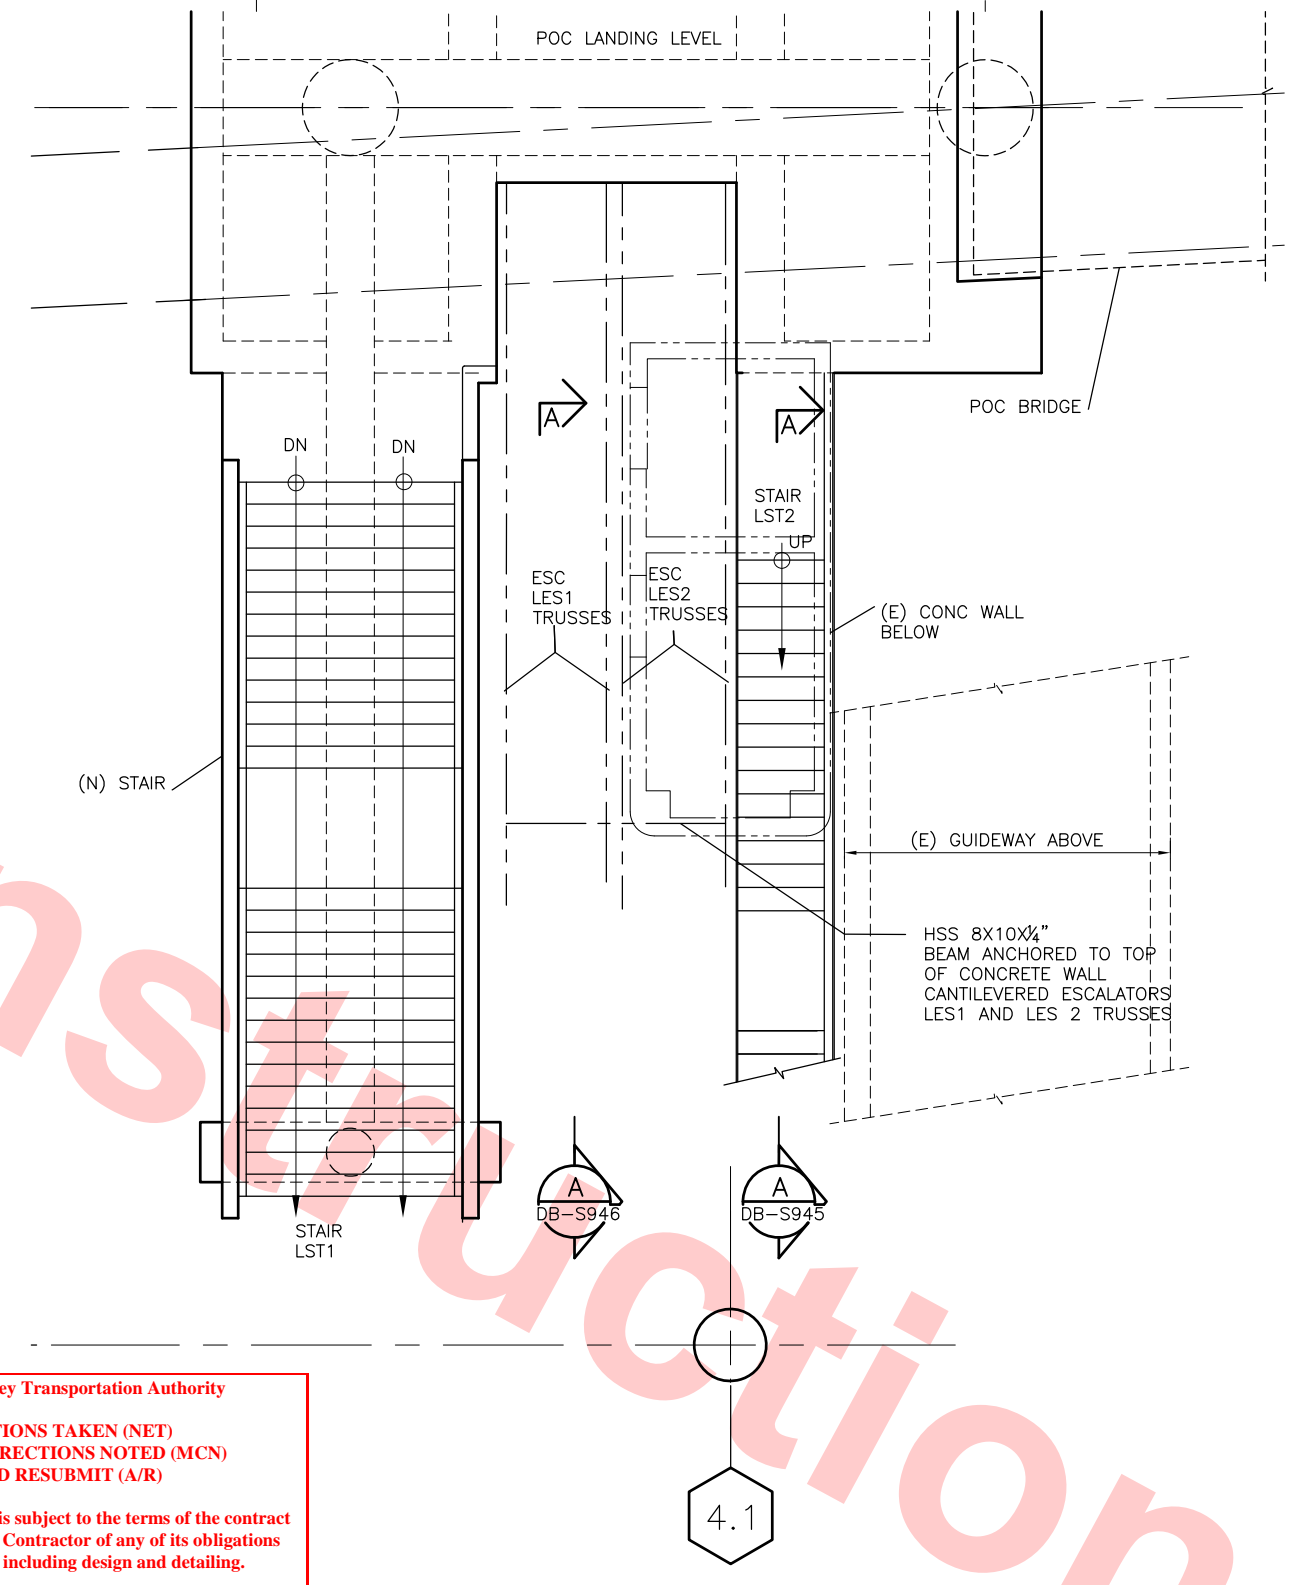

**DETAIL LRT BRIDGE LEVEL PLAN 2**  
SCALE: 1/4"=1'-0"

**Santa Clara Valley Transportation Authority**


**NO EXCEPTIONS TAKEN (NET)**  
**MAKE CORRECTIONS NOTED (MCN)**  
**AMEND AND RESUBMIT (A/R)**

Any action shown above is subject to the terms of the contract and does not relieve the Contractor of any of its obligations under the contract, including design and detailing.

Contract No.: **DB11002F**

By: \_\_\_\_\_ Date: \_\_\_\_\_

REV	DATE	BY	SUB	APP	DESCRIPTION
0	20130710				READINESS FOR CONSTRUCTION

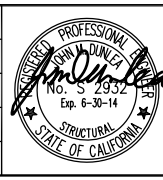

**Skanska Shimmick Herzog**

1436 California Circle  
Milpitas, California 95035  
A Joint Venture

**Anil Verma Associates, Inc.**  
1970 Broadway, Suite 525  
Oakland, CA 94612  
Phone: (510) 455-2537 Fax: (510) 535-2339

**Lookwood, Andrews & Newman, Inc.**  
A LEOP A WALY COMPANY

**T-Y LIN INTERNATIONAL**




**LINE, TRACK, STATIONS AND SYSTEMS DESIGN UNIT 023**  
**MONTAGUE LRT AND MILPITAS POC**

**LRT STAIR AND ESCALATORS PLATFORM & BRIDGE LEVEL DETAIL PLANS**

CADD FILENAME C700-S-DB-S943.dwg	REV. 0
SIZE D	SCALE 1/4"=1'-0"
CONTRACT NO. C700	SHEET NO. S943
AREA CODE DB	PAGE NO. 0314


Jun 28, 2013 1:03pm C:\projects\copy of copy of mty-template (5) (1)\vms0946\700-S-DB-S943.dwg



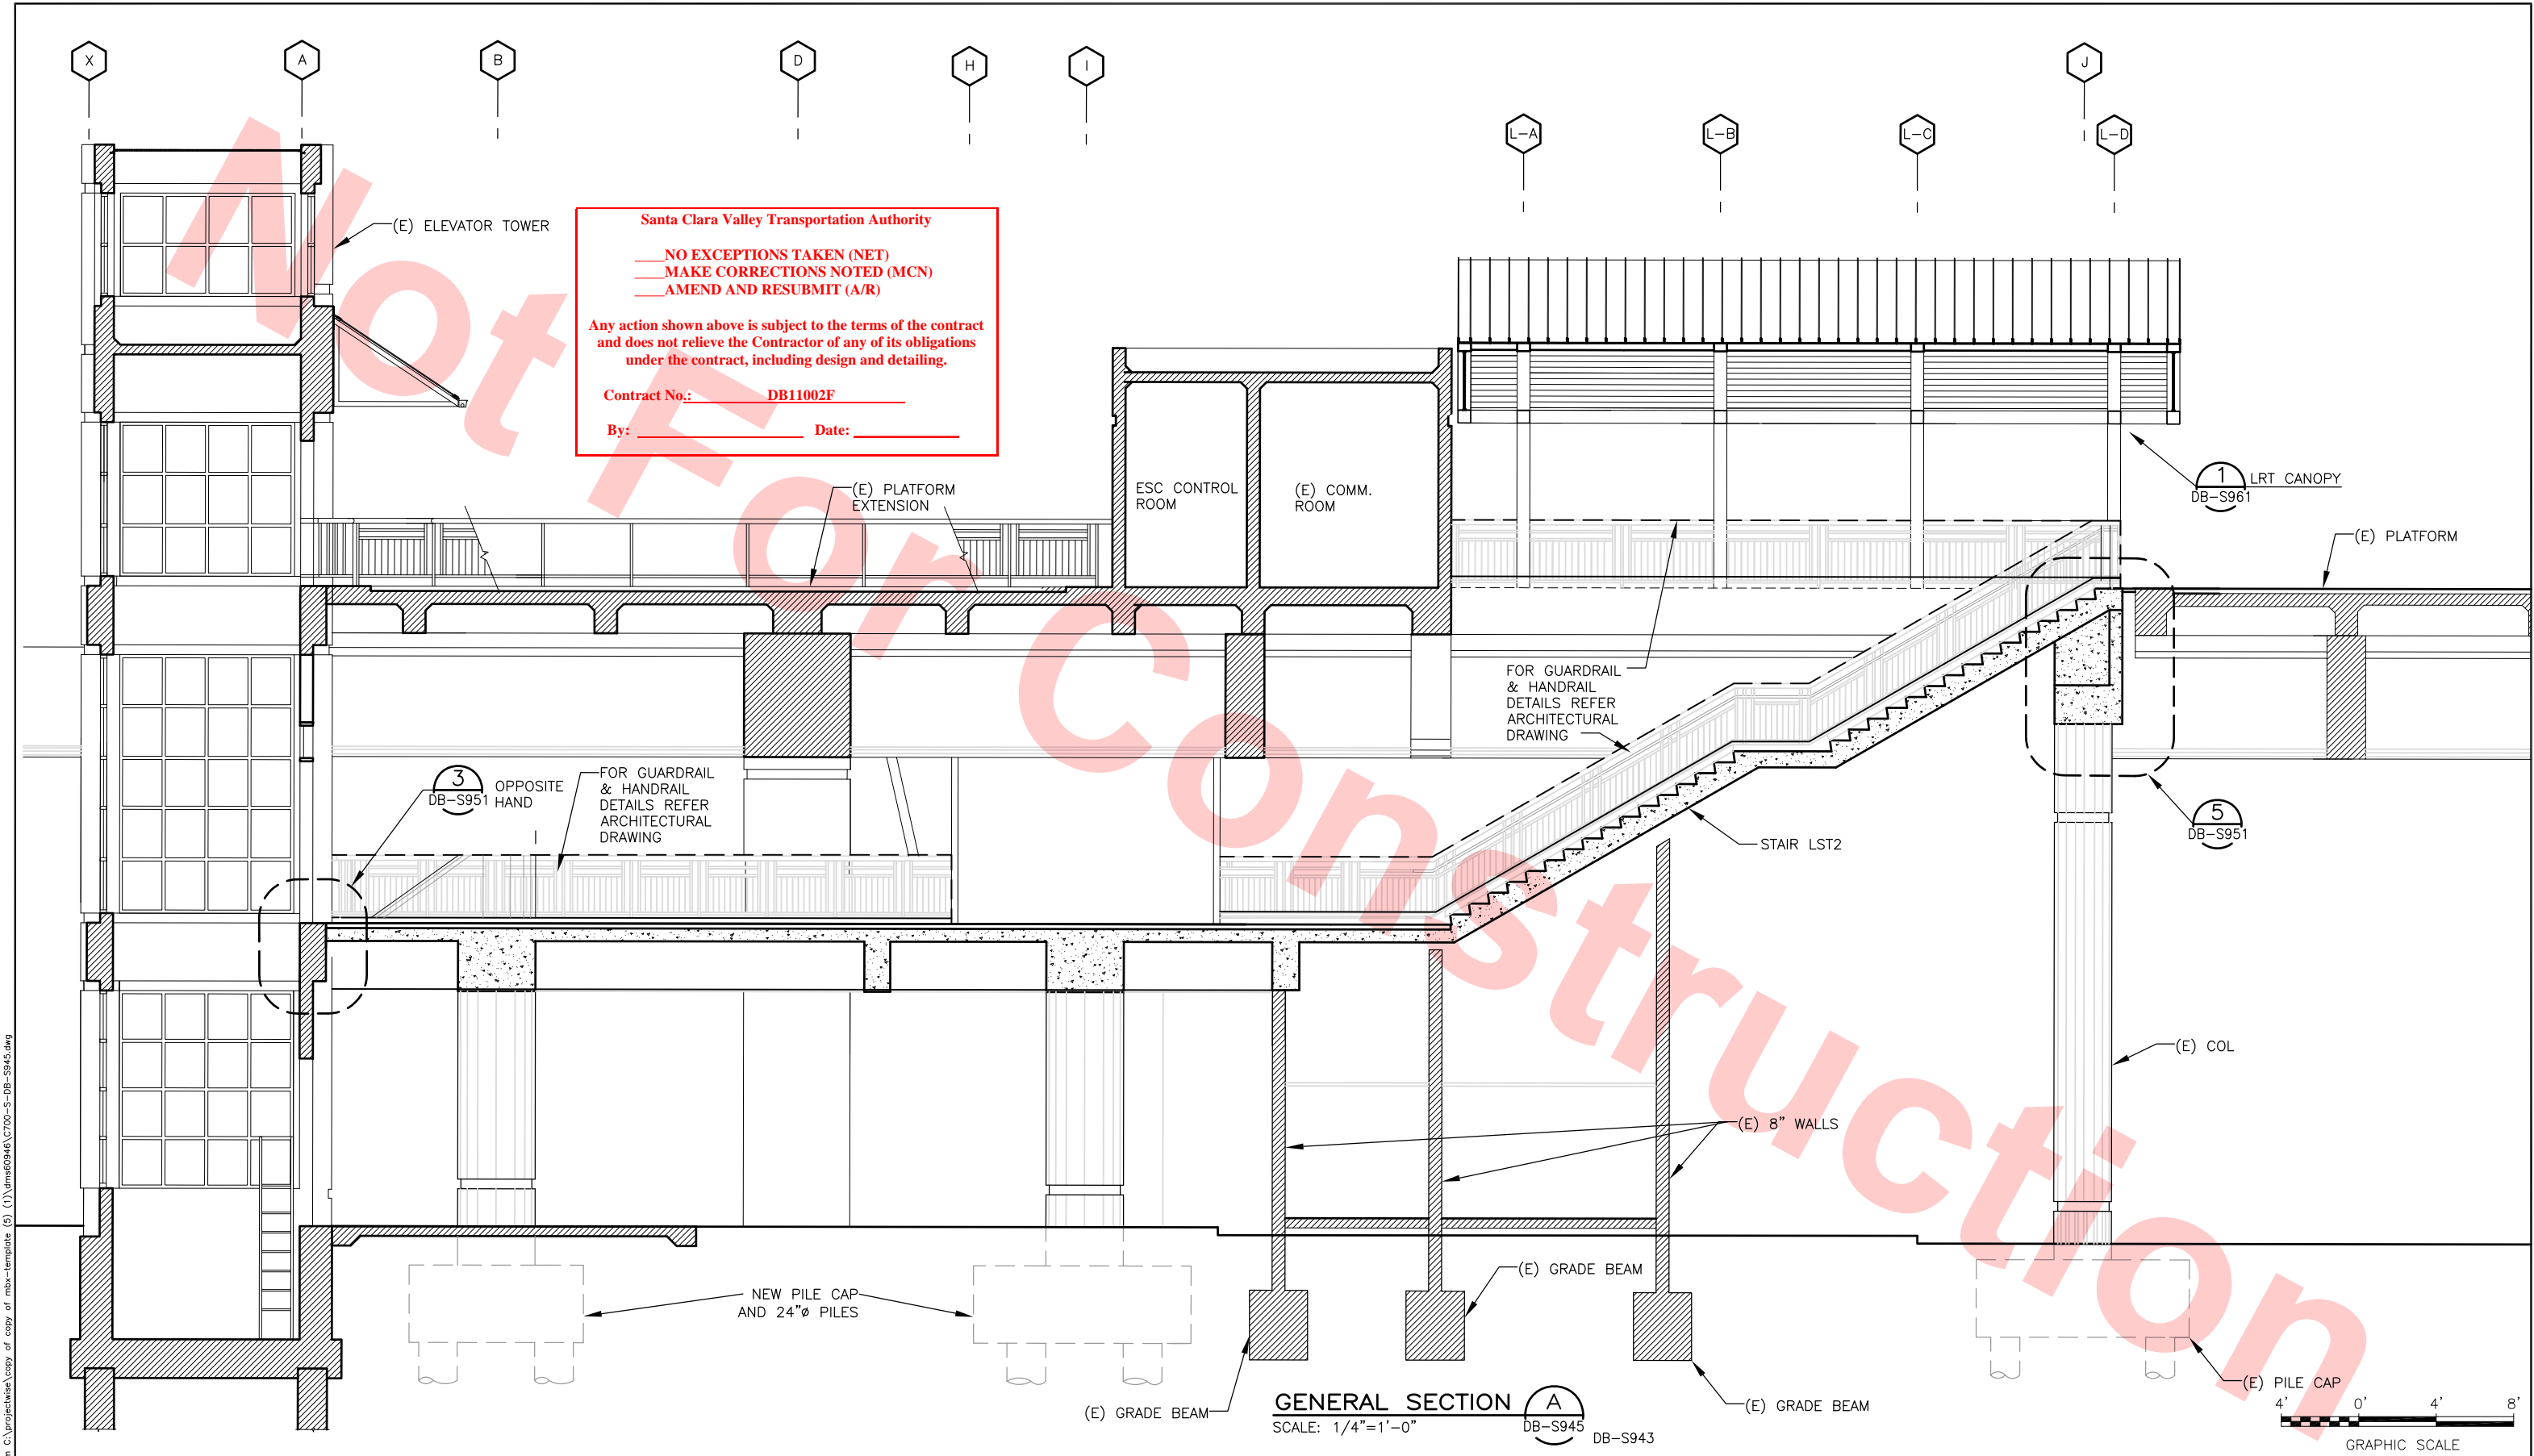

REV	DATE	BY	SUB	APP	DESCRIPTION
0	20130710				READINESS FOR CONSTRUCTION

DESIGNED BY  
J. DUNLEA  
DRAWN BY  
J. DUNLEA  
CHECKED BY  
S. DEBNATH  
IN CHARGE  
R. BARLAAN  
DATE  
20130710

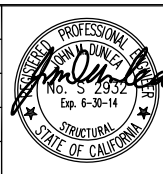

**Skanska Shimmick Herzog**  
1436 California Circle  
Milpitas, California 95035  
A Joint Venture  
**Anil Verma Associates, Inc.**  
1970 Broadway, Suite 525  
Oakland, CA 94612  
Phone: (510) 455-2537 Fax: (510) 535-2339

**Lookwood, Andrews & Newnam, Inc.**  
A LEOP A RALLY COMPANY  
**T-Y LIN INTERNATIONAL**  
APPROVED *Ray Apolunth*




LINE, TRACK, STATIONS AND SYSTEMS  
DESIGN UNIT 023  
MONTAGUE LRT AND MILPITAS POC  
LRT STAIR LST 2  
DETAIL SECTION

CADD FILENAME C700-S-DB-S945.dwg	REV. 0
SIZE D SCALE 1/4"=1'-0"	
CONTRACT NO. C700	
AREA CODE DB	SHEET NO. S945
	PAGE NO. 0315



Jun 28, 2013 - 1:01pm C:\projects\copy of copy of mnt-template (5) (1)\vms0946 (700-S-DB-S946.dwg

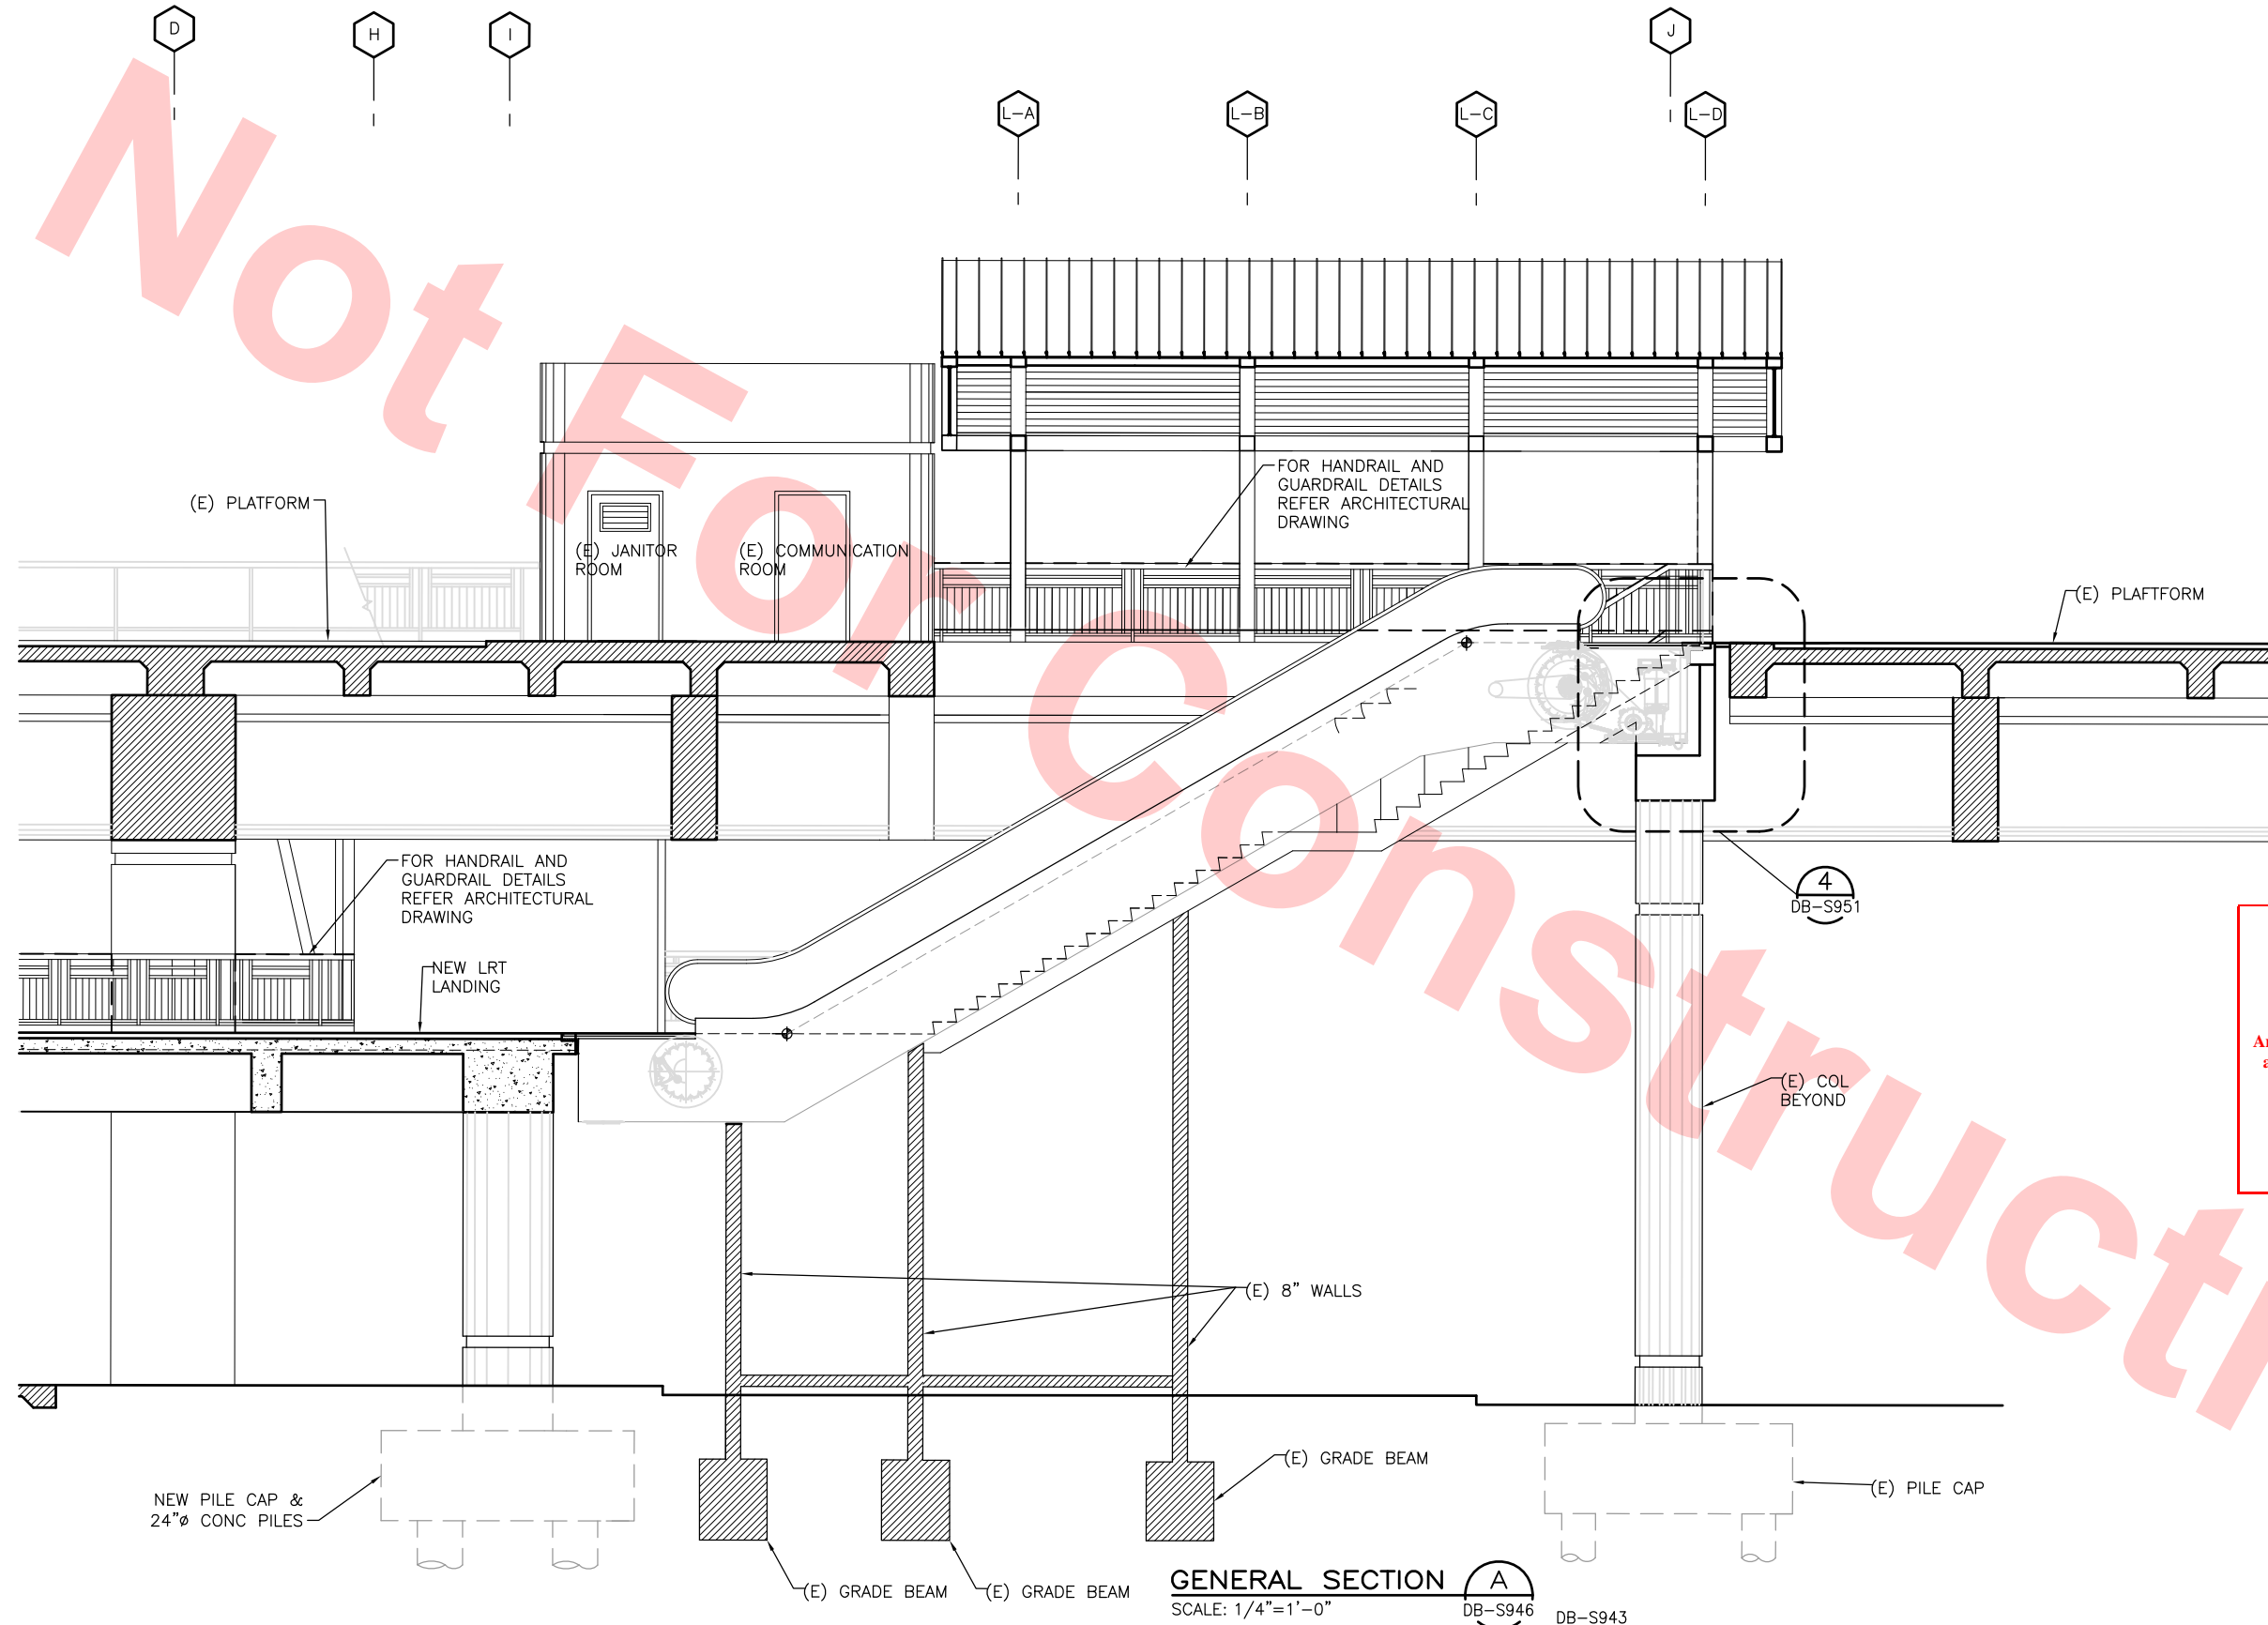

Santa Clara Valley Transportation Authority


NO EXCEPTIONS TAKEN (NET)  
MAKE CORRECTIONS NOTED (MCN)  
AMEND AND RESUBMIT (A/R)

Any action shown above is subject to the terms of the contract and does not relieve the Contractor of any of its obligations under the contract, including design and detailing.

Contract No.: DB11002F

By: \_\_\_\_\_ Date: \_\_\_\_\_

REV	DATE	BY	SUB	APP	DESCRIPTION
0	20130710				READINESS FOR CONSTRUCTION

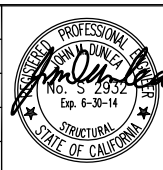

DESIGNED BY  
J. DUNLEA  
DRAWN BY  
J. DUNLEA  
CHECKED BY  
S. DEBNATH  
IN CHARGE  
R. BARLAAN  
DATE  
20130710


Skanska  
Shimmick  
Herzog

1436 California Circle  
Milpitas, California 95035  
A Joint Venture

Anil Verma Associates, Inc.  
1970 Broadway, Suite 525  
Oakland, CA 94612  
Phone: (510) 455-2537 Fax: (510) 535-2339

Lookwood, Andrews  
& Newman, Inc.  
A LEOPOLD & WALKER COMPANY

T-Y LIN INTERNATIONAL

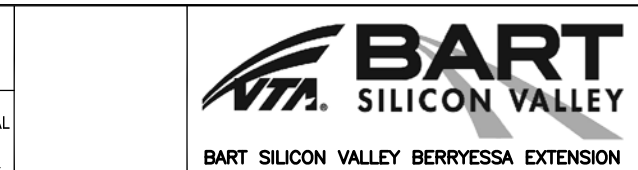




LINE, TRACK, STATIONS AND SYSTEMS  
DESIGN UNIT 023  
MONTAGUE LRT AND MILPITAS POC

LRT ESCALATOR LES 1  
DETAIL SECTION

CADD FILENAME C700-S-DB-S946.dwg	REV. 0
SIZE D	SCALE 1/4"=1'-0"
CONTRACT NO. C700	SHEET NO. S946
AREA CODE DB	PAGE NO. 0316



By: \_\_\_\_\_ Date: \_\_\_\_\_

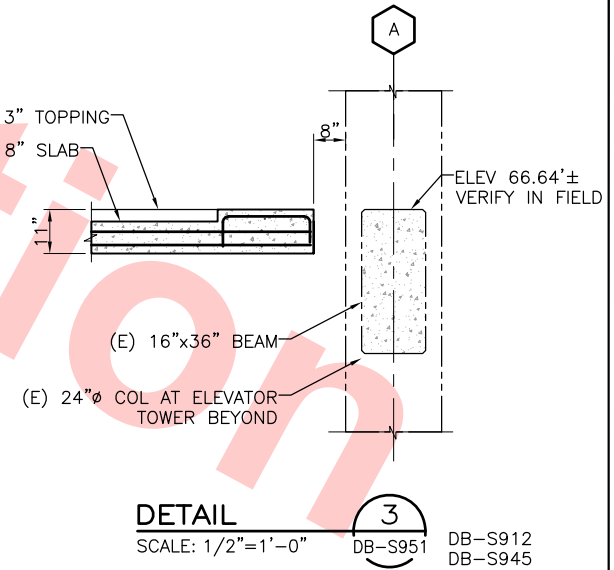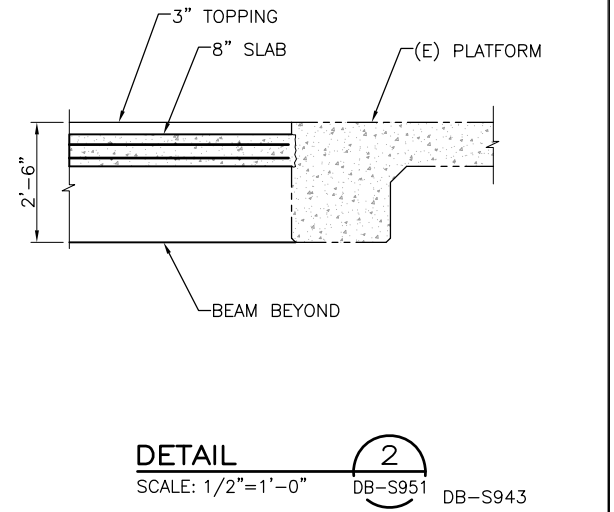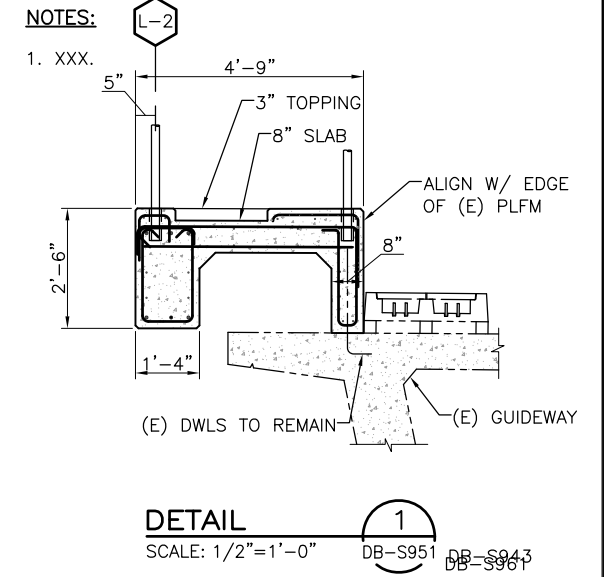

CADD FILENAME C700-S-DB-S951.dwg			
SIZE D	SCALE AS NOTED		
CONTRACT NO. C700		REV. 0	
AREA CODE DB	SHEET NO. S951	PAGE NO. 0317	



SOFFIT 10'-0" ABOVE FLOOR

(E) 8" WALL &  
(E) COL EA END

(E) ELECTRICAL EQUIP ROOM

(E) 8" WALL


(E) ELEVATOR EQUIP ROOM

(E) 8"

**1**

SCALE: 1/2"=1'-0"

DB-S952

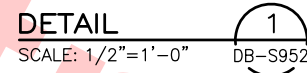


\_\_\_ NO EXCEPTIONS TAKEN (NET)  
\_\_\_ MAKE CORRECTIONS NOTED (MCN)  
\_\_\_ AMEND AND RESUBMIT (A/R)

**By:** \_\_\_\_\_ **Date:** \_\_\_\_\_

CADD FILENAME C700-S-DB-S952.dwg		
SIZE D	SCALE AS NOTED	
CONTRACT NO. C700		REV. 0
AREA CODE DB	SHEET NO. S952	PAGE NO. 0318



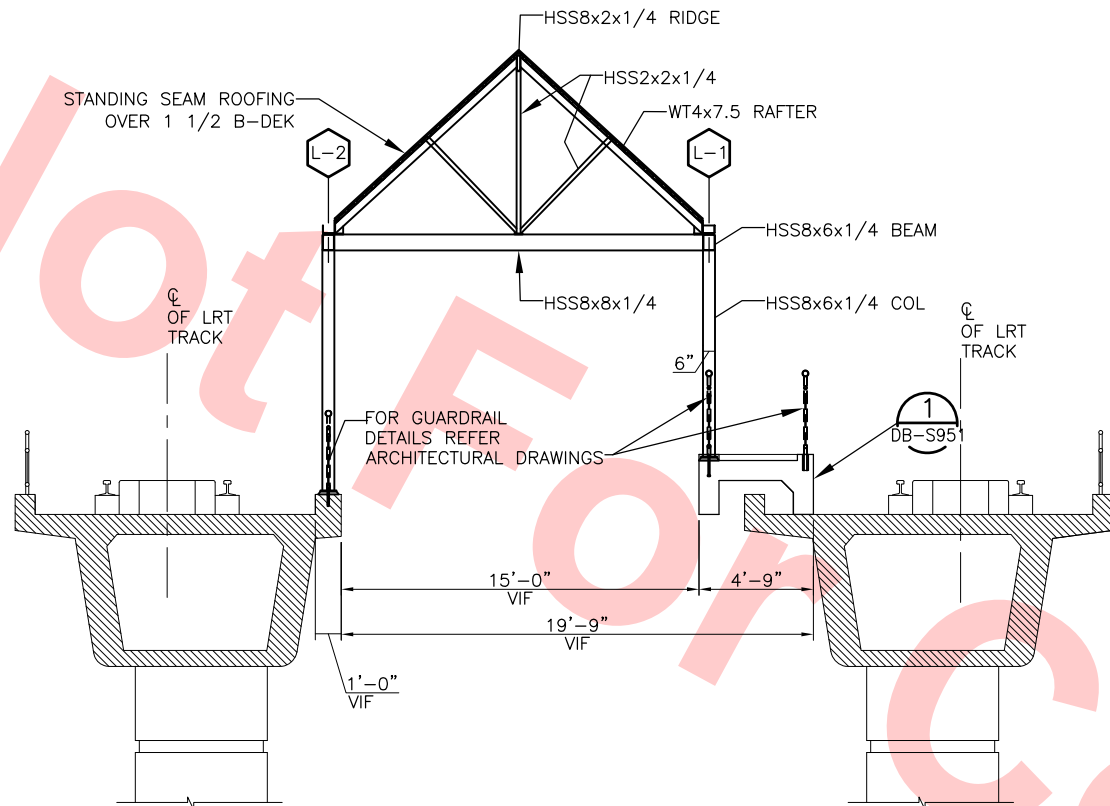

LRT CANOPY SECTION

SCALE: 1/4"=1'-0"

2  
DB-S961

DB-S943  
DB-S945


Santa Clara Valley Transportation Authority

- NO EXCEPTIONS TAKEN (NET)
- MAKE CORRECTIONS NOTED (MCN)
- AMEND AND RESUBMIT (A/R)

Any action shown above is subject to the terms of the contract and does not relieve the Contractor of any of its obligations under the contract, including design and detailing.

Contract No.: DB11002F

By: \_\_\_\_\_ Date: \_\_\_\_\_

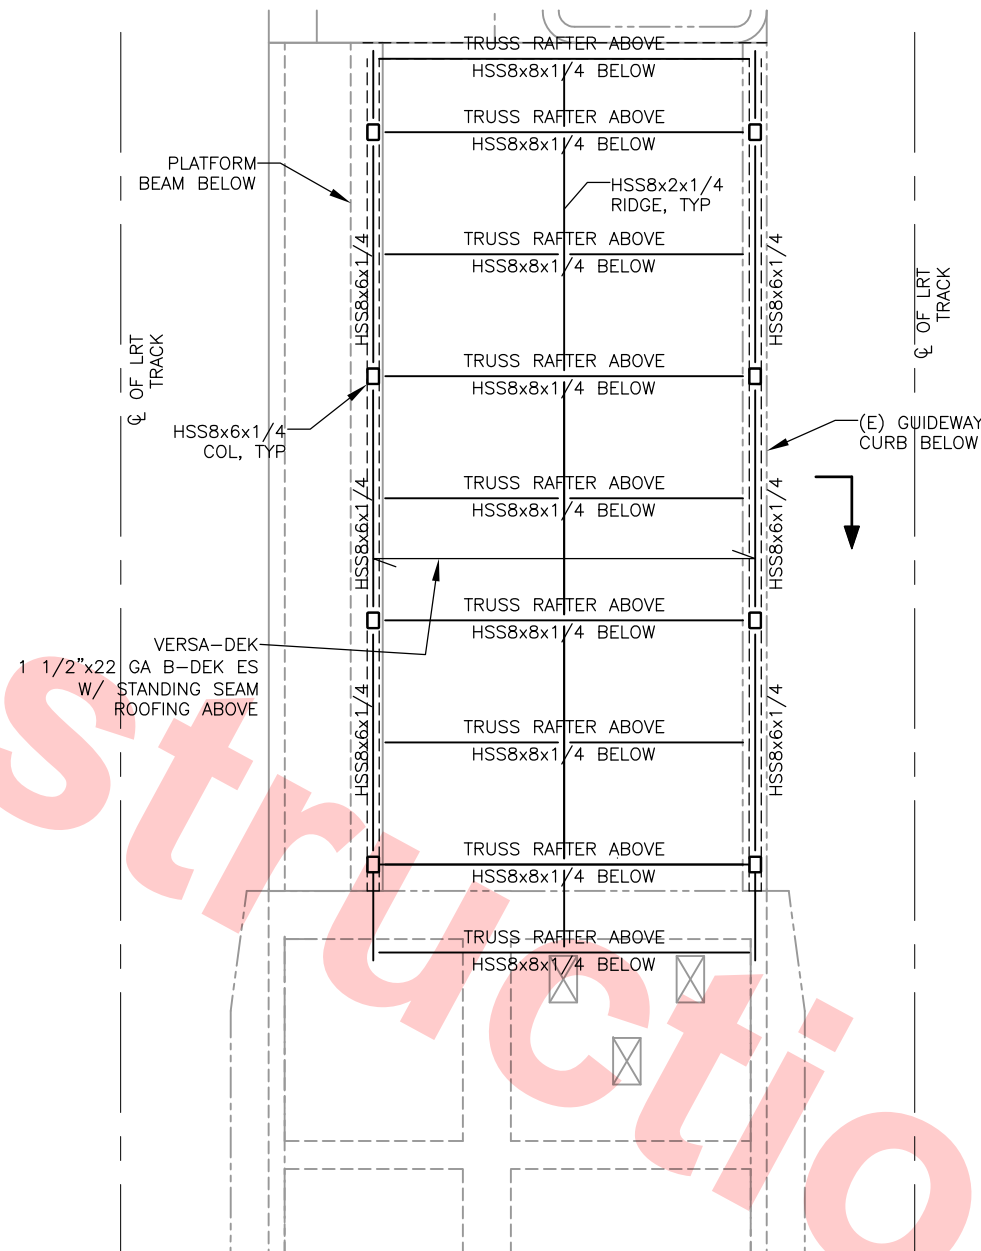

LRT CANOPY ROOF PLAN

SCALE: 1/4"=1'-0"

1  
DB-S961

DB-S945




GRAPHIC SCALE

Jun 28, 2013 12:48pm C:\projects\mbox-template (5) (1)\ms60945\c700-s-db-s961.dwg

REV	DATE	BY	SUB	APP	DESCRIPTION
0	20130710				READINESS FOR CONSTRUCTION

DESIGNED BY  
J. DUNLEA  
DRAWN BY  
J. DUNLEA  
CHECKED BY  
S. DEBNATH  
IN CHARGE  
R. BARLAAN  
DATE  
20130710

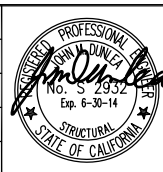

Skanska  
Shimmick  
Herzog  
Anil Verma Associates, Inc.  
1970 Broadway, Suite 525, Oakland, CA 94612  
Phone: (510) 455-2537 Fax: (510) 535-2339

1436 California Circle  
Milpitas, California 95035  
A Joint Venture  
Lookwood, Andrews & Newman, Inc.  
T-Y LIN INTERNATIONAL  
APPROVED



LINE, TRACK, STATIONS AND SYSTEMS  
DESIGN UNIT 023  
MONTAGUE LRT AND MILPITAS POC  
LRT CANOPY  
PLAN AND DETAILS

CADD FILENAME C700-S-DB-S961.dwg	REV. 0
SIZE SCALE D 1/4"=1'-0"	
CONTRACT NO. C700	
AREA CODE DB	SHEET NO. S961
	PAGE NO. 0319