


TYPE DD: PEDESTRIAN DIRECTIONAL


EXTERIOR / SITE SIGN FAMILY






TYPE A: BUILDING ID, BUILDING MOUNTED TYPE B: VINYL MESSAGES

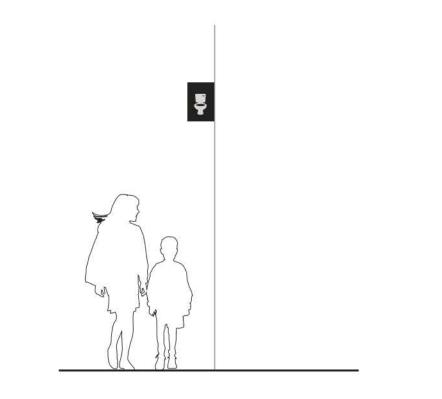

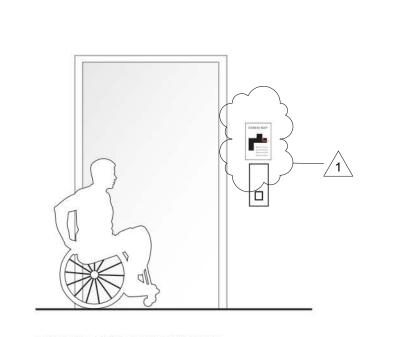

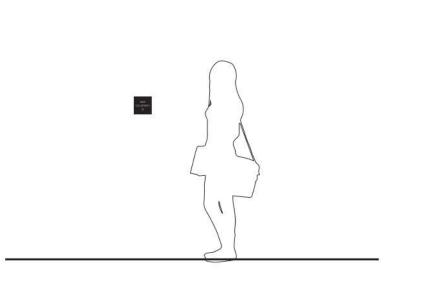

TYPE C: ROOM ID, FIXED MESSAGE

2 BUILDING / INTERIOR SIGN FAMILY

3/8" = 1'-0"

SIGN FAMILY

SK, SB, KK

**SEATTLE** / Pier 56, 1201 Alaskan Way, #200 Seattle, WA 98101 / 206.623.3344

SAN FRANCISCO / 660 Market Street, #300 San Francisco, CA 94104 / 415.956.0688

**SKANSKA** 

LOS ANGELES / 5837 Adams Blvd Culver City, CA 90232 / 323.937.2150

**PORTLAND** / 1010 NW Flanders St, #500 Portland, OR 97209 / 503.382.0900

usa.skanska.com

Mayer/Reed, Inc. 319 SW Washington St.

Suite 820

503.223.5953

PROJECT

**BUILDING** 

PREPARED FOR

LOCATION

 ${\bf Mayer/Reed}$ 

Portland, Oregon 97204

CDHY - ACADEMIC &

611 GRAND BLVD

PHYSICAL EDUCATION


VANCOUVER, WA 98661

**CENTER FOR DEAF AND** 

HARD OF HEARING

YOUTH (CDHY)



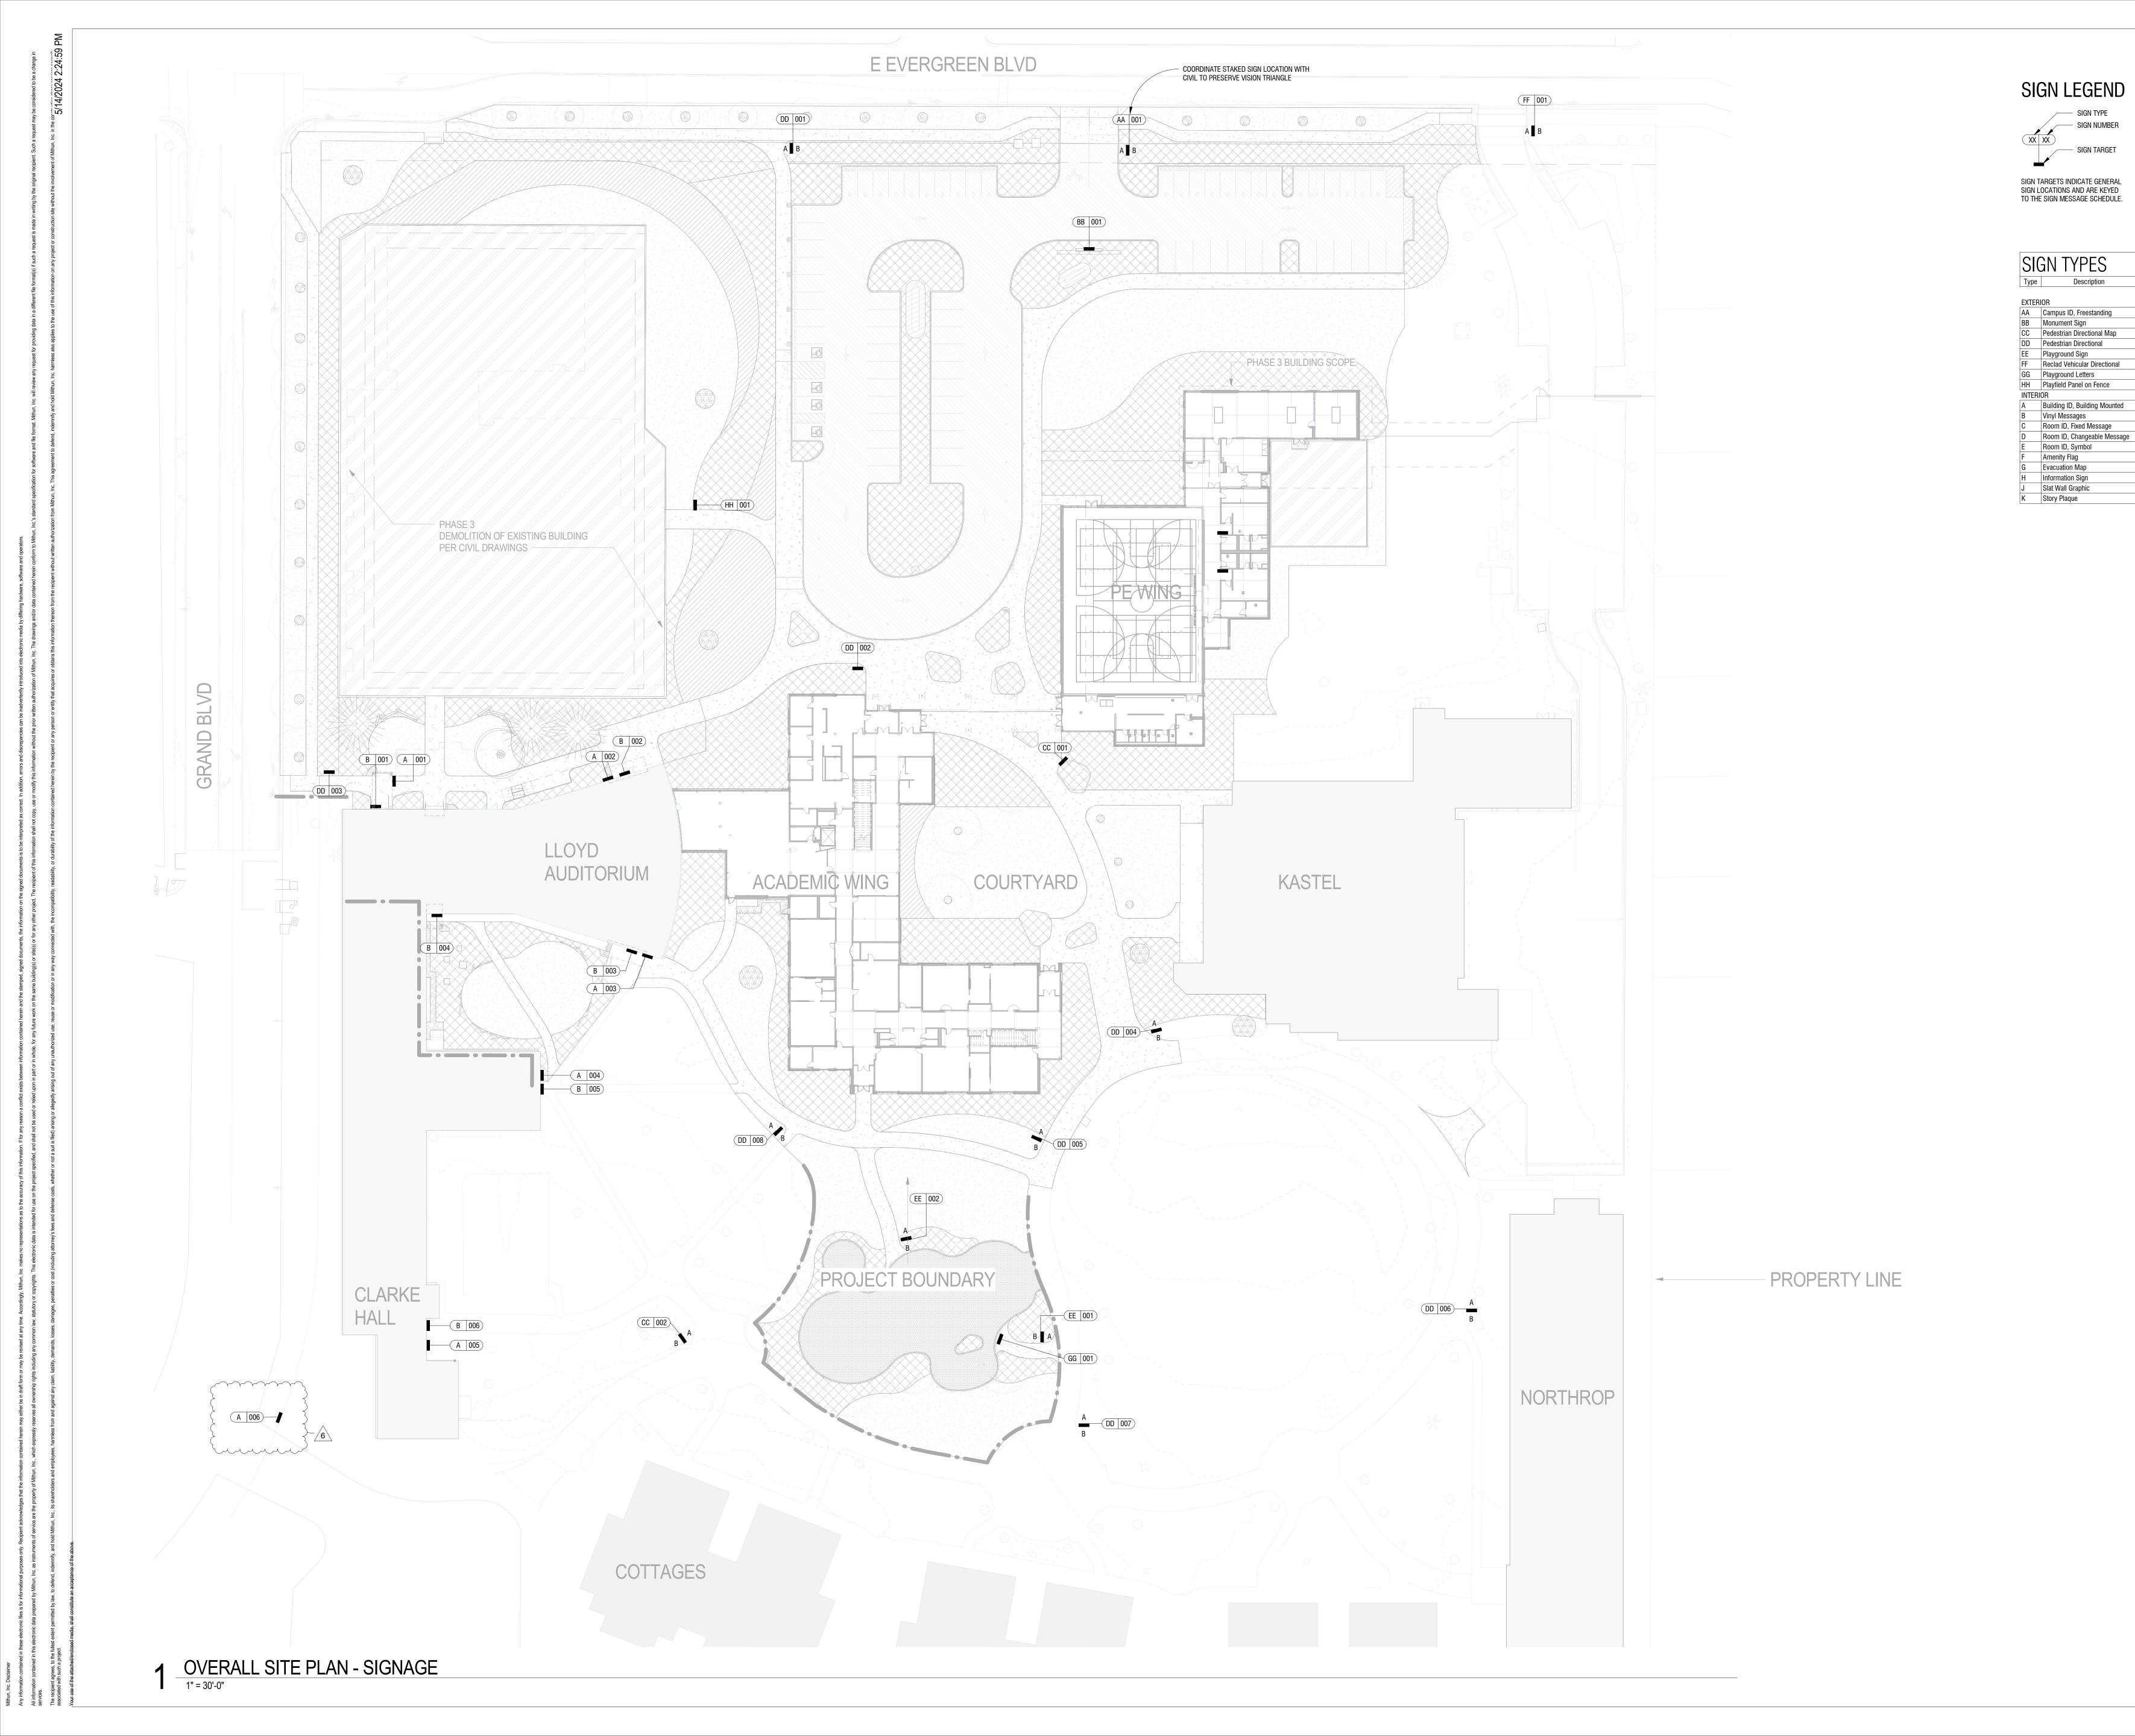

**SEATTLE** / Pier 56, 1201 Alaskan Way, #200 Seattle, WA 98101 / 206.623.3344 **SAN FRANCISCO** / 660 Market Street, #300 San Francisco, CA 94104 / 415.956.0688 LOS ANGELES / 5837 Adams Blvd Culver City, CA 90232 / 323.937.2150 mithun.com

## **SKANSKA**

**PORTLAND** / 1010 NW Flanders St, #500 Portland, OR 97209 / 503.382.0900 usa.skanska.com

#### Mayer/Reed

#### Mayer/Reed, Inc.

Portland, Oregon 97204

#### 319 SW Washington St. Suite 820

503.223.5953

#### PROJECT **CDHY - ACADEMIC &**


PHYSICAL EDUCATION **BUILDING** 

#### LOCATION 611 GRAND BLVD VANCOUVER, WA 98661

PREPARED FOR **CENTER FOR DEAF AND** HARD OF HEARING YOUTH (CDHY)

DES PROJECT NO.



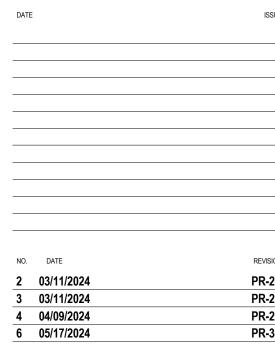


SK, SB, KK

SIGN LOCATION PLAN -OVERALL SITE PLAN

2122700 01/12/2024

© 2022 MITHUN, INC.

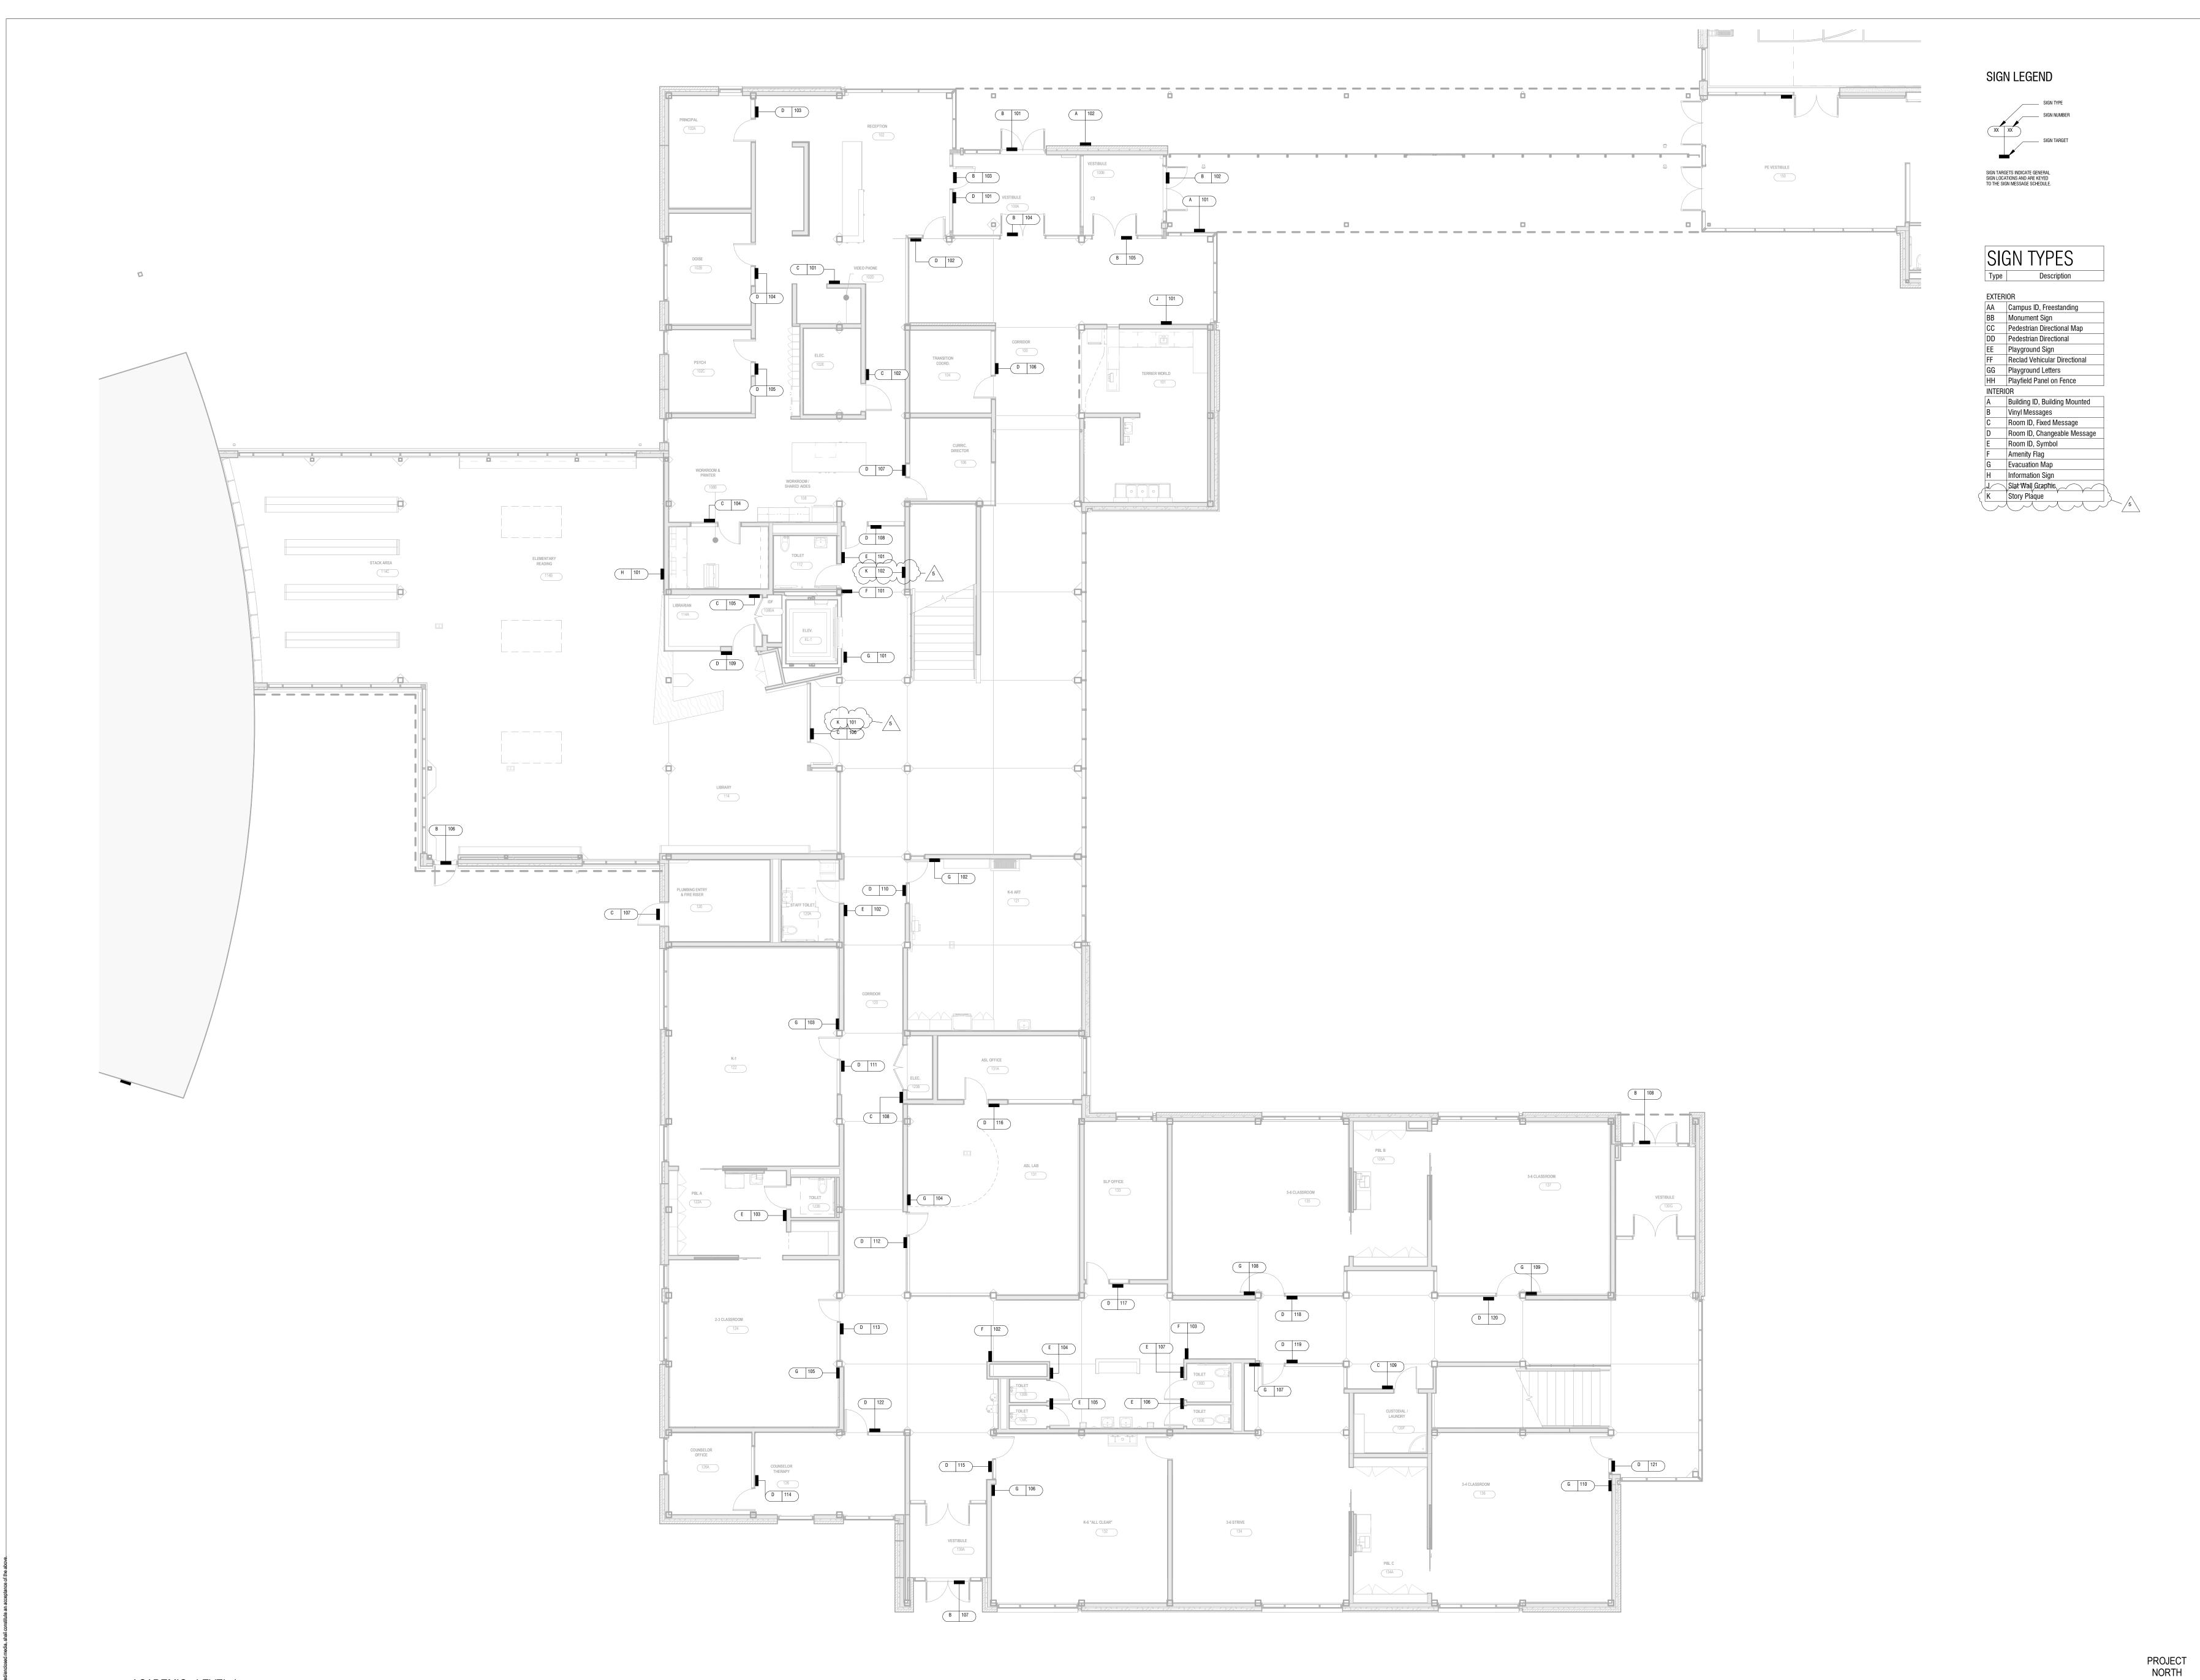

ACADEMIC - LEVEL 1

**SEATTLE** / Pier 56, 1201 Alaskan Way, #200 Seattle, WA 98101 / 206.623.3344 SAN FRANCISCO / 660 Market Street, #300 San Francisco, CA 94104 / 415.956.0688 LOS ANGELES / 5837 Adams Blvd Culver City, CA 90232 / 323.937.2150 mithun.com

## **SKANSKA**

**PORTLAND** / 1010 NW Flanders St, #500 Portland, OR 97209 / 503.382.0900 usa.skanska.com

#### Mayer/Reed

503.223.5953

Mayer/Reed, Inc. 319 SW Washington St. Suite 820 Portland, Oregon 97204

PROJECT CDHY - ACADEMIC & PHYSICAL EDUCATION BUILDING

LOCATION

611 GRAND BLVD VANCOUVER, WA 98661

PREPARED FOR CENTER FOR DEAF AND HARD OF HEARING YOUTH (CDHY)

DES PROJECT NO. 2018-713




1 1/12/2024 2 03/11/2024 3 03/11/2024 4 04/09/2024

5 04/26/2024


SIGN LOCATION PLAN -LEVEL 1 - ACADEMIC

2122700 04/26/2024

© 2024 MITHUN, INC.

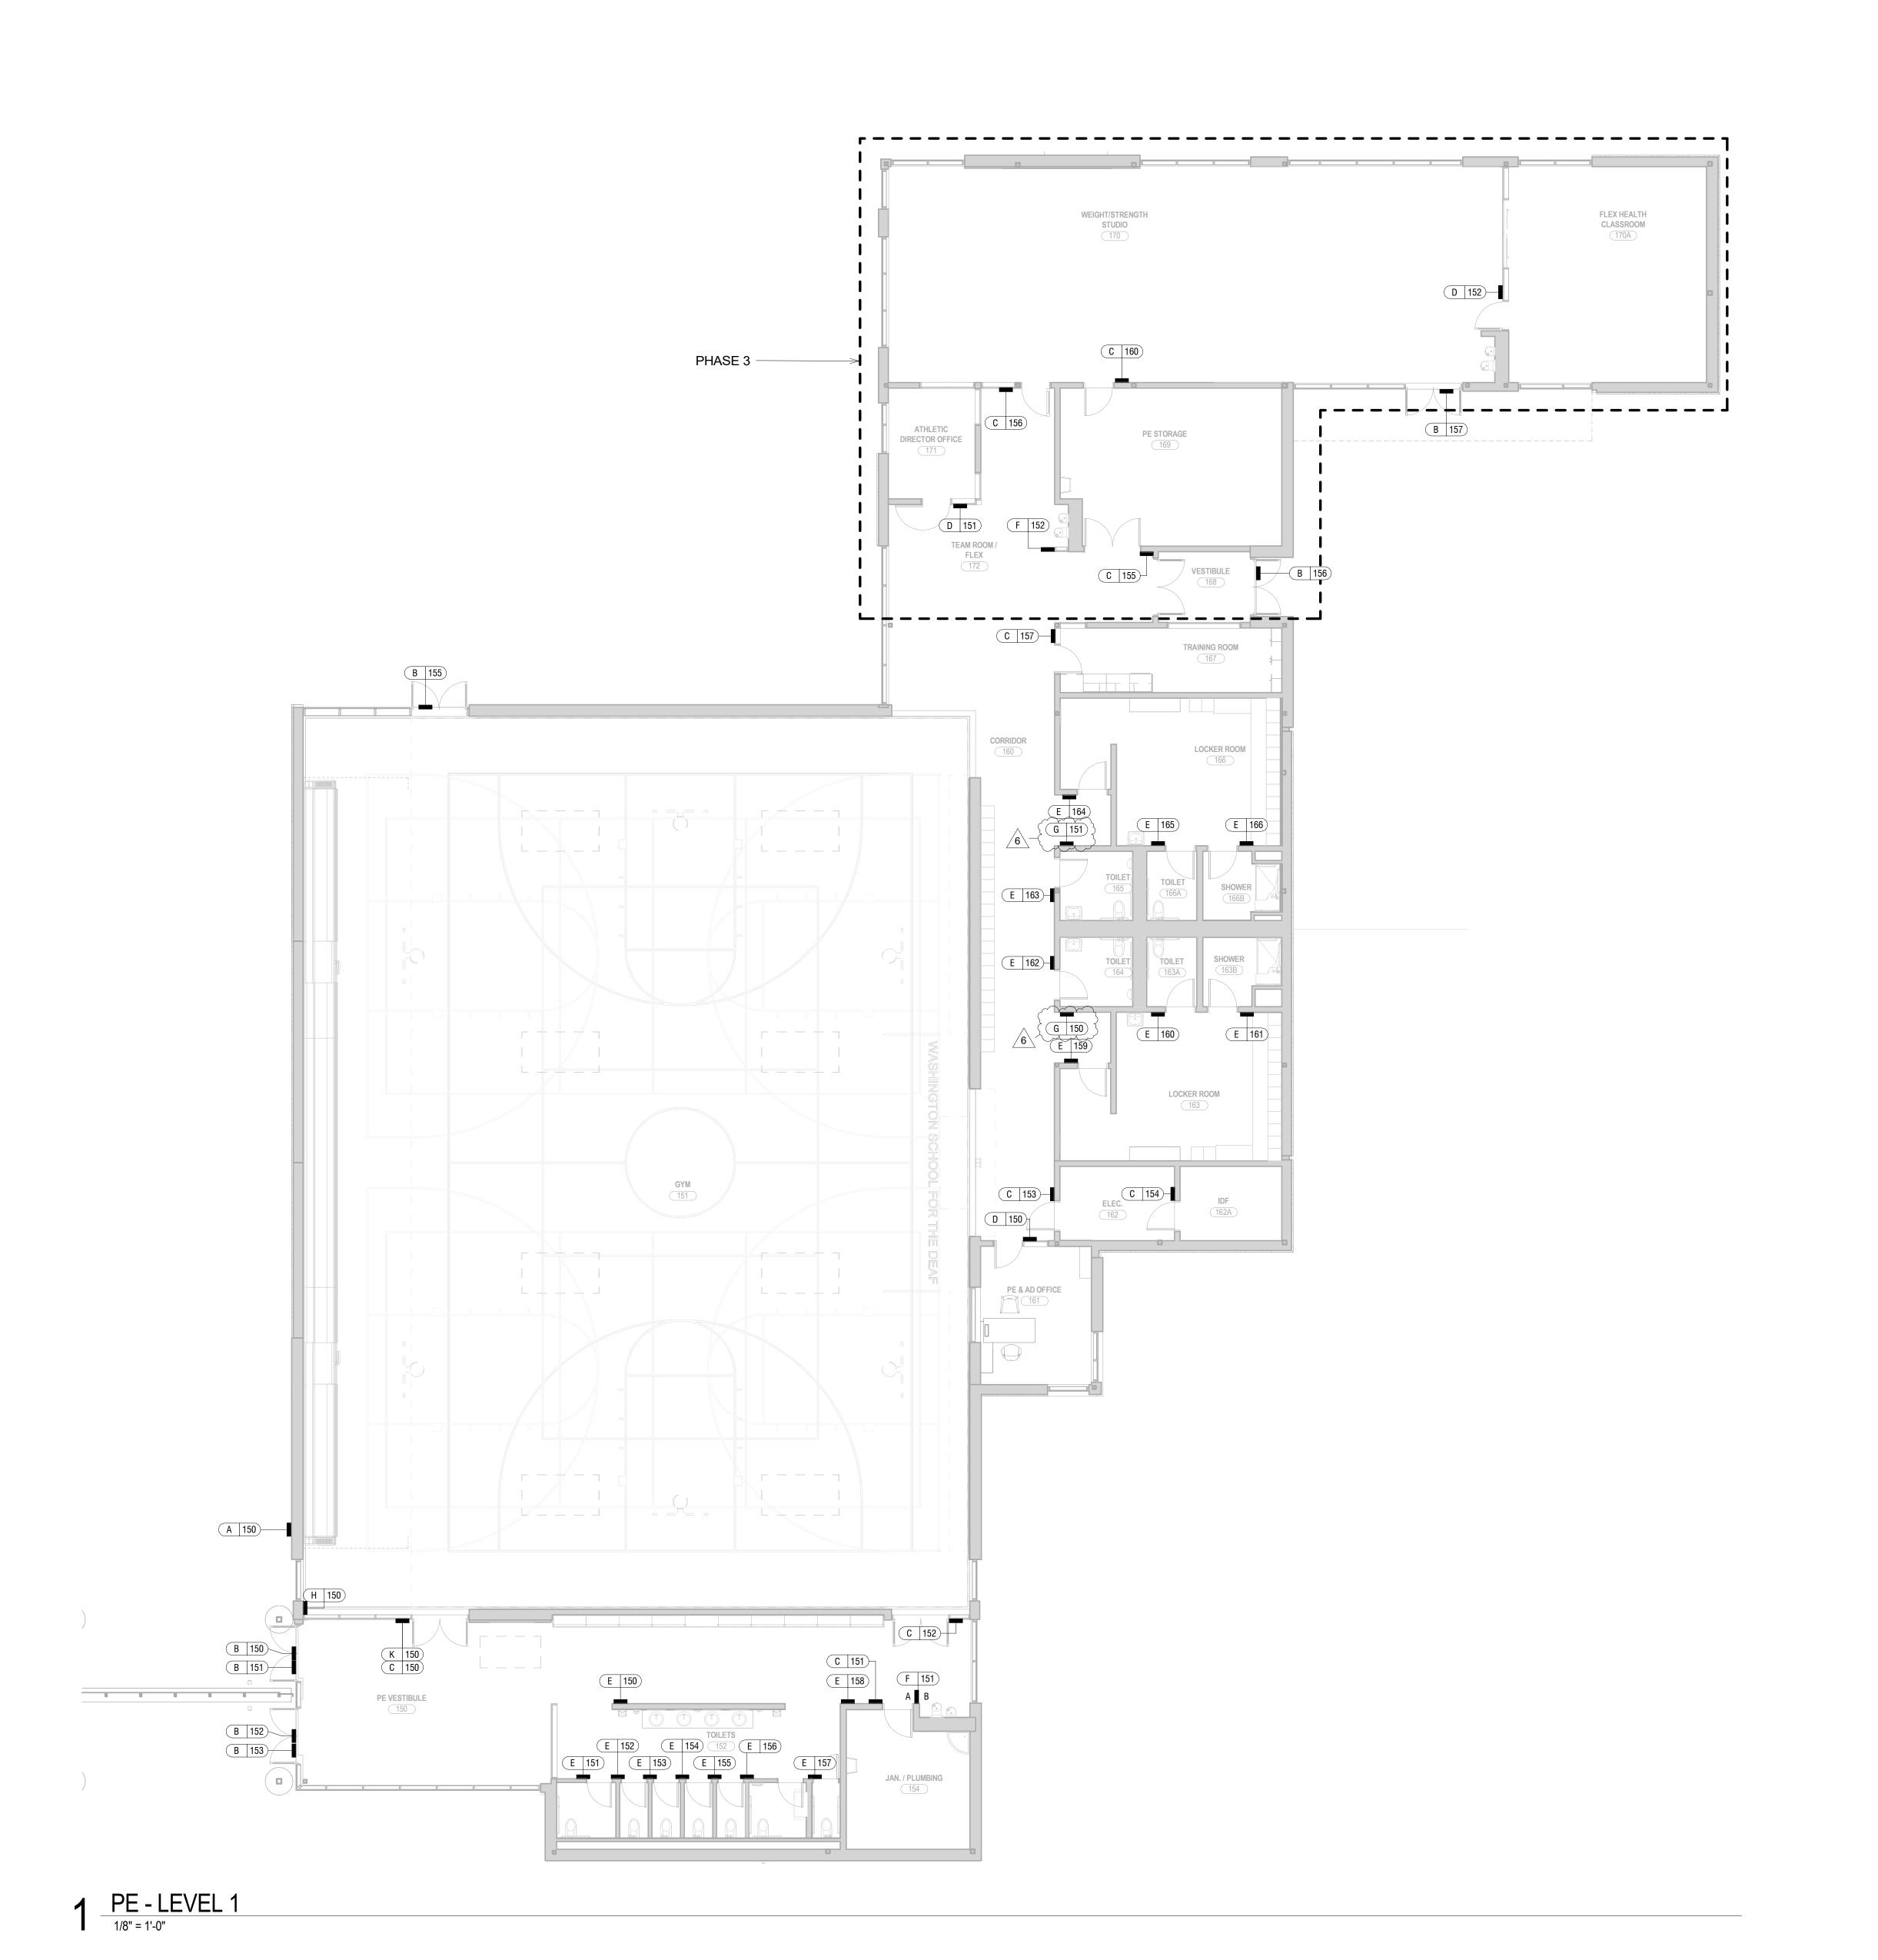



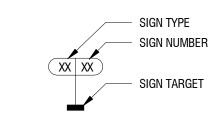

SIGN TARGETS INDICATE GENERAL SIGN LOCATIONS AND ARE KEYED TO THE SIGN MESSAGE SCHEDULE.

AA Campus ID, Freestanding BB Monument Sign Pedestrian Directional Map Pedestrian Directional Playground Sign Reclad Vehicular Directional Playground Letters

HH Playfield Panel on Fence Building ID, Building Mounted Vinyl Messages Room ID, Fixed Message

Room ID, Changeable Message Room ID, Symbol Amenity Flag Evacuation Map Information Sign Slat Wall Graphic

K Story Plaque

**SEATTLE** / Pier 56, 1201 Alaskan Way, #200 Seattle, WA 98101 / 206.623.3344 SAN FRANCISCO / 660 Market Street, #300 San Francisco, CA 94104 / 415.956.0688 LOS ANGELES / 5837 Adams Blvd Culver City, CA 90232 / 323.937.2150 mithun.com

## **SKANSKA**

**PORTLAND** / 1010 NW Flanders St, #500 Portland, OR 97209 / 503.382.0900

Mayer/Reed

usa.skanska.com

Mayer/Reed, Inc. 319 SW Washington St.

Suite 820

Portland, Oregon 97204 503.223.5953 PROJECT **CDHY - ACADEMIC &** 


PHYSICAL EDUCATION **BUILDING** 

LOCATION 611 GRAND BLVD VANCOUVER, WA 98661

PREPARED FOR **CENTER FOR DEAF AND** HARD OF HEARING YOUTH (CDHY)

DES PROJECT NO.



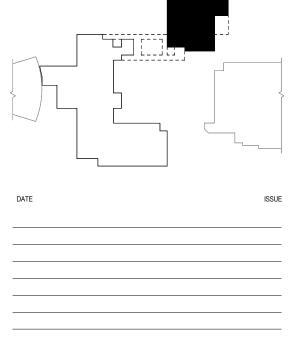

PROJECT ARCHITECT

SK, SB, KK CHECK KB

SIGN LOCATION PLAN -LEVEL 1 - PE

01/12/2024





AITHUN<sup>®</sup>

SEATTLE / Pier 56, 1201 Alaskan Way, #200 Seattle, WA 98101 / 206.623.3344

SAN FRANCISCO / 660 Market Street, #300 San Francisco, CA 94104 / 415.956.0688

LOS ANGELES / 5837 Adams Blvd Culver City, CA 90232 / 323.937.2150

mithun.com

## SKANSKA

PORTLAND / 1010 NW Flanders St, #500 Portland, OR 97209 / 503.382.0900 usa.skanska.com

#### Mayer/Reed

Mayer/Reed, Inc. 319 SW Washington St. Suite 820 Portland, Oregon 97204

PROJECT
CDHY - ACADEMIC &
PHYSICAL EDUCATION

BUILDING

LOCATION 611 GRAND BLVD VANCOUVER, WA 98661

YOUTH (CDHY)


PREPARED FOR

CENTER FOR DEAF AND

HARD OF HEARING

DES PROJECT NO.

2018-713

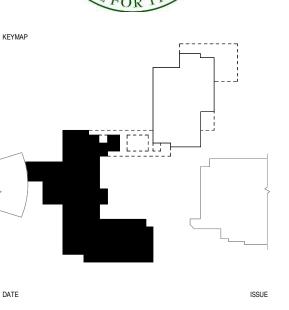

TE REVI

GN PARTNER

PROJECT MANAGER
JL
PROJECT ARCHITECT
CH

JW
PROJECT TEAM MEMBER
SK, SB, KK
CHECK

ARCHITECT SEAL

SIGN LOCATION PLAN -LEVEL 2 - ACADEMIC

2122700 DATE 04/26/2024

PROJECT NORTH SG2.12A

© 2024 MITHUN, INC.

		Message	Building Level	
AA	001	A: 3107	SITE LEVEL 01	
		[HANDS] Washington School for the Deaf		
		CDHY B:		
		3107		
		[HANDS] Washington School for the Deaf		
3B	001	CDHY HOME OF THE TERRIERS	SITE LEVEL 01	
		[ARROW RIGHT] Main Entry, Drop-off [ARROW LEFT] Additional Parking		
OC	001	[TERRIER LOGO] (SEE LAYOUT)	SITE LEVEL 01	
CC	002	(SEE LAYOUT)	SITE LEVEL 01	
DD DD	001	(SEE LAYOUT) (SEE LAYOUT)	SITE LEVEL 01 SITE LEVEL 01	
DD	003	(SEE LAYOUT)	SITE LEVEL 01	
DD DD	004	(SEE LAYOUT) (SEE LAYOUT)	SITE LEVEL 01 SITE LEVEL 01	
DD	006	(SEE LAYOUT)	SITE LEVEL 01	CONFIRM WITH ARCHITECT/GC ON BEST LOCATION TO AVOID
				TREE
DD DD	007	(SEE LAYOUT) (SEE LAYOUT)	SITE LEVEL 01 SITE LEVEL 01	
E	001	(SEE LAYOUT)	SITE LEVEL 01	COORDINATE LOCATION WITH L
EE F	002	(SEE LAYOUT) A:	SITE LEVEL 01 SITE LEVEL 01	COORDINATE LOCATION WITH LEFABRICATOR TO FIELD VERIFY
		DELIVERIES 3109		EXISTING SIGN DIMENSIONS AN SIZE TEXT ACCORDINGLY
		Evergreen Blvd B:		CIZE TEXT //CCGTIBINGET
		DELIVERIES		
		3109 Evergreen Blvd		
GG HH	001	DESPO'S PLAYGROUND DIVINE PLAYFIELD	SITE LEVEL 01 SITE LEVEL 01	EMBED LETTERS INTO CONCRE MOUNT TO FENCE
4	001	CLARKE HALL	SITE LEVEL 01	
A A	002 003	LLOYD AUDITORIUM LLOYD AUDITORIUM	SITE LEVEL 01 SITE LEVEL 01	
4	004	ROBERTS HEALTH CENTER	SITE LEVEL 01	CLIENT TO CONFIRM NAME
<del>\</del>	005	CLARKE HALL CDHY ADMINISTRATION	SITE LEVEL 01	
٠,		ESTABLISHED 1886		
4	101	WASHINGTON SCHOOL FOR THE DEAF	ACADEMIC - LEVEL 1	RELOCATED TO FASCIA NEAR ROOF
<i>\</i>	102 150	DIVINE ACADEMIC HUNTER GYMNASIUM	ACADEMIC - LEVEL 1 PE - LEVEL 1	
<del>1</del> 3	001	Clarke Hall	SITE LEVEL 01	
3	002	(ENTRY RESTRICTIONS) Lloyd Auditorium	SITE LEVEL 01	
		(ENTRY RESTRICTIONS)		
3	003	Lloyd Auditorium (ENTRY RESTRICTIONS)	SITE LEVEL 01	
3	004	Clarke Hall	SITE LEVEL 01	
В	005	(ENTRY RESTRICTIONS)  Roberts Health Center	SITE LEVEL 01	
 B	006	(ENTRY RESTRICTIONS)  Clarke Hall	SITE LEVEL 01	
		(ENTRY RESTRICTIONS)		
В	101	Divine Academic (ENTRY RESTRICTIONS)	ACADEMIC - LEVEL 1	
В	102	Divine Academic (ENTRY RESTRICTIONS)	ACADEMIC - LEVEL 1	ON GLASS
В	103	Please Check-In at Reception	ACADEMIC - LEVEL 1	ON GLASS
В В	104 105	Please Check-In at Reception  To Hunter Gymnasium	ACADEMIC - LEVEL 1 ACADEMIC - LEVEL 1	ON GLASS ON GLASS
В	106	EMERGENCY EXIT ONLY	ACADEMIC - LEVEL 1	ON GLASS
В	107	Divine Academic (ENTRY RESTRICTIONS)	ACADEMIC - LEVEL 1	ON GLASS
В	108	Divine Academic (ENTRY RESTRICTIONS)	ACADEMIC - LEVEL 1	ON GLASS
3	150	HOME OF THE TERRIERS	PE - LEVEL 1	ON GLASS
3	151	Hunter Gymnasium (ENTRY RESTRICTIONS)	PE - LEVEL 1	ON GLASS
3	152	HOME OF THE TERRIERS	PE - LEVEL 1	ON GLASS
3	153	Hunter Gymnasium (ENTRY RESTRICTIONS)	PE - LEVEL 1	ON GLASS
3	155	Hunter Gymnasium (ENTRY RESTRICTIONS)	PE - LEVEL 1	ON GLASS
3	156	Hunter Gymnasium	PE - LEVEL 1	ON GLASS
3	157	(ENTRY RESTRICTIONS) Hunter Gymnasium	PE - LEVEL 1	ON GLASS
3	201	(ENTRY RESTRICTIONS)  MULHOLLAND CONFERENCE	ACADEMIC - LEVEL 2	ON GLASS
3	101	102D	ACADEMIC - LEVEL 2  ACADEMIC - LEVEL 1	ON GENOU
	102	VIDEO PHONE 102E	ACADEMIC - LEVEL 1	
		ELECTRICAL		ONICLACC
C	104	108B WORKROOM	ACADEMIC - LEVEL 1	ON GLASS
3	105	108BA IDF	ACADEMIC - LEVEL 1	
3	106	114	ACADEMIC - LEVEL 1	ON GLASS
<u> </u>	107	MCGILL LIBRARY 120	ACADEMIC - LEVEL 1	USE EXTERIOR GRADE
		PLUMBING & FIRE RISER		MATERIALS
)	108	120B	ACADEMIC - LEVEL 1	
	109	ELECTRICAL 130F	ACADEMIC - LEVEL 1	
		CUSTODIAL		ONICLACO
) 	150	151 GYMNASIUM	PE - LEVEL 1	ON GLASS
)	151	154 CUSTODIAL	PE - LEVEL 1	
<u> </u>	152	151	PE - LEVEL 1	ON GLASS
 C	153	GYMNASIUM 162	PE - LEVEL 1	
		ELECTRICAL		
C	154	162A IDF	PE - LEVEL 1	
)	155	169 STORAGE	PE - LEVEL 1	
3	156	170	PE - LEVEL 1	ON GLASS. VERIFY ROOM NAM
 C	157	STRENGTH STUDIO 167	PE - LEVEL 1	ON GLASS
		TRAINING ROOM		
3	160	169 STORAGE	PE - LEVEL 1	
		202A	ACADEMIC - LEVEL 2	

^	000	0004	404D=1110 :=	
С	202	202A STORAGE	ACADEMIC - LEVEL 2	01101100
С	203	201 CONFERENCE	ACADEMIC - LEVEL 2	ON GLASS
С	204	212 CUSTODIAL	ACADEMIC - LEVEL 2	
С	205	212C ELEVATOR CONTROL	ACADEMIC - LEVEL 2	
С	206	212A MDF	ACADEMIC - LEVEL 2	
C	207	ROOF ACCESS 212B	ACADEMIC - LEVEL 2 ACADEMIC - LEVEL 2	
С	209	ELECTRICAL 223	ACADEMIC - LEVEL 2	ON GLASS
С	210	PRINT ROOM 223A	ACADEMIC - LEVEL 2	
С	211	ELECTRICAL 239	ACADEMIC - LEVEL 2	ON GLASS
С	212	STAFF LOUNGE 223	ACADEMIC - LEVEL 2	ON GLASS
D	101	PRINT ROOM	ACADEMIC - LEVEL 1	ON GLASS
D	102	(NAME INSERT)	ACADEMIC - LEVEL 1	ON GLASS
D	102	(NAME INSERT)	ACADEMIC - LEVEL 1	ON GLASS
D	103	(NAME INSERT)	ACADEMIC - LEVEL 1	ON GLASS
		(NAME INSERT)		
D	105	102C (NAME INSERT)	ACADEMIC - LEVEL 1	ON GLASS
D	106	104 (NAME INSERT)	ACADEMIC - LEVEL 1	ON GLASS
D	107	106 (NAME INSERT)	ACADEMIC - LEVEL 1	ON GLASS
D	108	108 (NAME INSERT)	ACADEMIC - LEVEL 1	ON GLASS
D	109	114A (NAME INSERT)	ACADEMIC - LEVEL 1	
D	110	121 (NAME INSERT)	ACADEMIC - LEVEL 1	ON GLASS
D	111	122 (NAME INSERT)	ACADEMIC - LEVEL 1	ON GLASS
D	112	131 (NAME INSERT)	ACADEMIC - LEVEL 1	ON GLASS
D	113	124 (NAME INSERT)	ACADEMIC - LEVEL 1	ON GLASS
D	114	126A (NAME INSERT)	ACADEMIC - LEVEL 1	ON GLASS
D	115	132 (NAME INSERT)	ACADEMIC - LEVEL 1	ON GLASS
D	116	131A (NAME INSERT)	ACADEMIC - LEVEL 1	ON GLASS
D	117	133 (NAME INSERT)	ACADEMIC - LEVEL 1	ON GLASS
D	118	135	ACADEMIC - LEVEL 1	ON GLASS
D	119	(NAME INSERT)  134	ACADEMIC - LEVEL 1	ON GLASS
D	120	(NAME INSERT)  137	ACADEMIC - LEVEL 1	ON GLASS
D	121	(NAME INSERT) 136	ACADEMIC - LEVEL 1	ON GLASS
D	122	(NAME INSERT) 126	ACADEMIC - LEVEL 1	ON GLASS
D	150	(NAME INSERT) 161	PE - LEVEL 1	ON GLASS
D	151	(NAME INSERT) 171	PE - LEVEL 1	ON GLASS
D	152	(NAME INSERT) 170A	PE - LEVEL 1	ON GLASS
E	101	[TOILET] [ACCESSIBLE] RESTROOM	ACADEMIC - LEVEL 1	
E	102	[TOILET] [ACCESSIBLE] STAFF ONLY	ACADEMIC - LEVEL 1	
E	103	[TOILET] [ACCESSIBLE] TOILET	ACADEMIC - LEVEL 1	
E	104	[TOILET]	ACADEMIC - LEVEL 1	
E	105	TOILET [TOILET]	ACADEMIC - LEVEL 1	
E	106	TOILET [TOILET]	ACADEMIC - LEVEL 1	
E	107	TOILET [ACCESSIBLE]	ACADEMIC - LEVEL 1	
E	150	TOILET [ACCESSIBLE]	PE - LEVEL 1	
E	151	RESTROOM  [TOILET] [ACCESSIBLE]	PE - LEVEL 1	
E	152	TOILET [ACCESSIBLE] [TOILET]	PE - LEVEL 1	
	IJZ	TOILET		

	Number	Message	Building Level	Comments
				Commonte
E	154	[TOILET] TOILET	PE - LEVEL 1	
E	155	[TOILET] TOILET	PE - LEVEL 1	
E	156	[TOILET] TOILET	PE - LEVEL 1	
E	157	[TOILET] [ACCESSIBLE]	PE - LEVEL 1	
E	158	TOILET [ACCESSIBLE]	PE - LEVEL 1	
E	159	RESTROOM [WOMEN] [TOILET] [ACCESSIBLE SHOWER]	PE - LEVEL 1	INCLUDE ADDITIONAL INS
		WOMEN'S LOCKER ROOM		WINDOW. VERIFY ROOM DESIGNATION.
E	160	[TOILET] [ACCESSIBLE] RESTROOM	PE - LEVEL 1	
E	161	[ACCESSIBLE SHOWER]	PE - LEVEL 1	
E	162	SHOWER [TOILET] [ACCESSIBLE]	PE - LEVEL 1	
E	163	RESTROOM [TOILET] [ACCESSIBLE]	PE - LEVEL 1	
		RESTROOM		INCLUSE ADDITIONAL INC
E	164	[MEN] [TOILET] [ACCESSIBLE SHOWER] MEN'S	PE - LEVEL 1	INCLUDE ADDITIONAL INS WINDOW. VERIFY ROOM
E	165	LOCKER ROOM [TOILET] [ACCESSIBLE]	PE - LEVEL 1	DESIGNATION.
		RESTROOM		
E	166	[ACCESSIBLE SHOWER] SHOWER	PE - LEVEL 1	
E	201	[TOILET] [ACCESSIBLE] RESTROOM	ACADEMIC - LEVEL 2	
E	202	[TOILET] [ACCESSIBLE] RESTROOM	ACADEMIC - LEVEL 2	
E	203	[TOILET] [ACCESSIBLE]	ACADEMIC - LEVEL 2	
E	204	RESTROOM [TOILET] [ACCESSIBLE]	ACADEMIC - LEVEL 2	
E	205	RESTROOM [TOILET] [ACCESSIBLE]	ACADEMIC - LEVEL 2	
		STAFF ONLY		
F	101	A: [TOILET]	ACADEMIC - LEVEL 1	
		B: [TOILET]		
F	102	A: [DRINKING FOUNTAIN]	ACADEMIC - LEVEL 1	
		[WATER FILLING STATION]		
		B: [DRINKING FOUNTAIN]		
F	103	[WATER FILLING STATION] A:	ACADEMIC - LEVEL 1	
		[DRINKING FOUNTAIN] [WATER FILLING STATION]		
		B: [DRINKING FOUNTAIN]		
_	454	[WATER FILLING STATION]	DE LEVEL 4	
F	151	A: [ARROW LEFT]	PE - LEVEL 1	
		LOCKER ROOMS [DRINKING FOUNTAIN]		
		[WATER FILLING STATION] B:		
F	152	(BLANK) A:	PE - LEVEL 1	
	.52	[DRINKING FOUNTAIN] [WATER FILLING STATION]		
		B:		
		[DRINKING FOUNTAIN] [WATER FILLING STATION]		
F	201	A: [TOILET]	ACADEMIC - LEVEL 2	
		B: [TOILET]		
F	202	A:	ACADEMIC - LEVEL 2	
		[TOILET] B:		
G	101	[TOILET] (EVACUATION MAP)	ACADEMIC - LEVEL 1	
G G	102 103	(EVACUATION MAP) (EVACUATION MAP)	ACADEMIC - LEVEL 1 ACADEMIC - LEVEL 1	
G	104	(EVACUATION MAP)	ACADEMIC - LEVEL 1	
G G	105 106	(EVACUATION MAP) (EVACUATION MAP)	ACADEMIC - LEVEL 1 ACADEMIC - LEVEL 1	
G	107	(EVACUATION MAP)	ACADEMIC - LEVEL 1	
G G	108	(EVACUATION MAP) (EVACUATION MAP)	ACADEMIC - LEVEL 1 ACADEMIC - LEVEL 1	
G	110	(EVACUATION MAP)	ACADEMIC - LEVEL 1	
G Ģ	150 151	(EVACUATION MAP) (EVACUATION MAP)	PE - LEVEL 1	
G G	201	(EVACUATION MAP)	ACADEMIC - LEVEL 2 ACADEMIC - LEVEL 2	
G	202	(EVACUATION MAP) (EVACUATION MAP)	ACADEMIC - LEVEL 2	
G G	204	(EVACUATION MAP) (EVACUATION MAP)	ACADEMIC - LEVEL 2 ACADEMIC - LEVEL 2	
G	206	(EVACUATION MAP)	ACADEMIC - LEVEL 2	
G G	207 208	(EVACUATION MAP) (EVACUATION MAP)	ACADEMIC - LEVEL 2 ACADEMIC - LEVEL 2	
G	209	(EVACUATION MAP)	ACADEMIC - LEVEL 2	
G G	210 211	(EVACUATION MAP) (EVACUATION MAP)	ACADEMIC - LEVEL 2 ACADEMIC - LEVEL 2	
G	212	(EVACUATION MAP)	ACADEMIC - LEVEL 2	
G H	213 101	(EVACUATION MAP) MAXIMUM OCCUPANCY 50	ACADEMIC - LEVEL 2 ACADEMIC - LEVEL 1	
Н	150	MAXIMUM OCCUPANCY 1007	PE - LEVEL 1	
J K	101	(MCGILL TEXT - SEE LAYOUT)	ACADEMIC - LEVEL 1 ACADEMIC - LEVEL 1	ON GLASS
1	1.01	\ \ \\ \\ \\ \\ \\ \\ \\		

K 150 (HUNTER TEXT - SEE LAYOUT)

PE - LEVEL 1

K 201 (MULHOLLAND TEXT - SEE LAYOUT) ACADEMIC - LEVEL 2 ON GLASS

[ ] = SYMBOL( ) = NOTES

Type	Description	Count
EXTER	IOR	
AA	Campus ID, Freestanding	1
BB	Monument Sign	1
CC	Pedestrian Directional Map	2
DD	Pedestrian Directional	8
EE	Playground Sign	2
FF	Reclad Vehicular Directional	1
GG	Playground Letters	1
HH	Playfield Panel on Fence	1
INTER	IOR .	$\overline{}$
Α	Building ID, Building Mounted	(9)
В	Vinyl Messages	22
С	Room ID, Fixed Message	29
D	Room ID, Changeable Message	41
E	Room ID, Symbol	29
F	Amenity Flag	7
G	Evacuation Map	25 }
Н	Information Sign	2
J	Slat Wall Graphic	1
K	Story Plaque	4

SEATTLE / Pier 56, 1201 Alaskan Way, #200

SEATTLE / Pier 56, 1201 Alaskan Way, #200 Seattle, WA 98101 / 206.623.3344

SAN FRANCISCO / 660 Market Street, #300 San Francisco, CA 94104 / 415.956.0688

LOS ANGELES / 5837 Adams Blvd Culver City, CA 90232 / 323.937.2150

mithun.com

#### SKANSKA

PORTLAND / 1010 NW Flanders St, #500 Portland, OR 97209 / 503.382.0900 usa.skanska.com

Mayer/Reed

Mayer/Reed, Inc. 319 SW Washington St. Suite 820

Suite 820
Portland, Oregon 97204
503.223.5953
PROJECT

CDHY - ACADEMIC &
PHYSICAL EDUCATION

BUILDING
LOCATION
611 GRAND BLVD

PREPARED FOR

CENTER FOR DEAF AND

HARD OF HEARING

YOUTH (CDHY)

VANCOUVER, WA 98661

2018-713

DES PROJECT NO.



NO. DATE REVISIO 1 1/12/2024 PR-24 2 03/11/2024 PR-27

DESIGN PARTNER
BC
PROJECT MANAGER
JL
PROJECT ARCHITECT
CH

4 04/09/2024 5 04/26/2024

PROJECT DESIGNER

JW

PROJECT TEAM MEMBERS

SK, SB, KK

CHECK


KB


ARCHITECT SEAL


SIGN MESSAGE SCHEDULE

2122700 DATE 01/12/2024



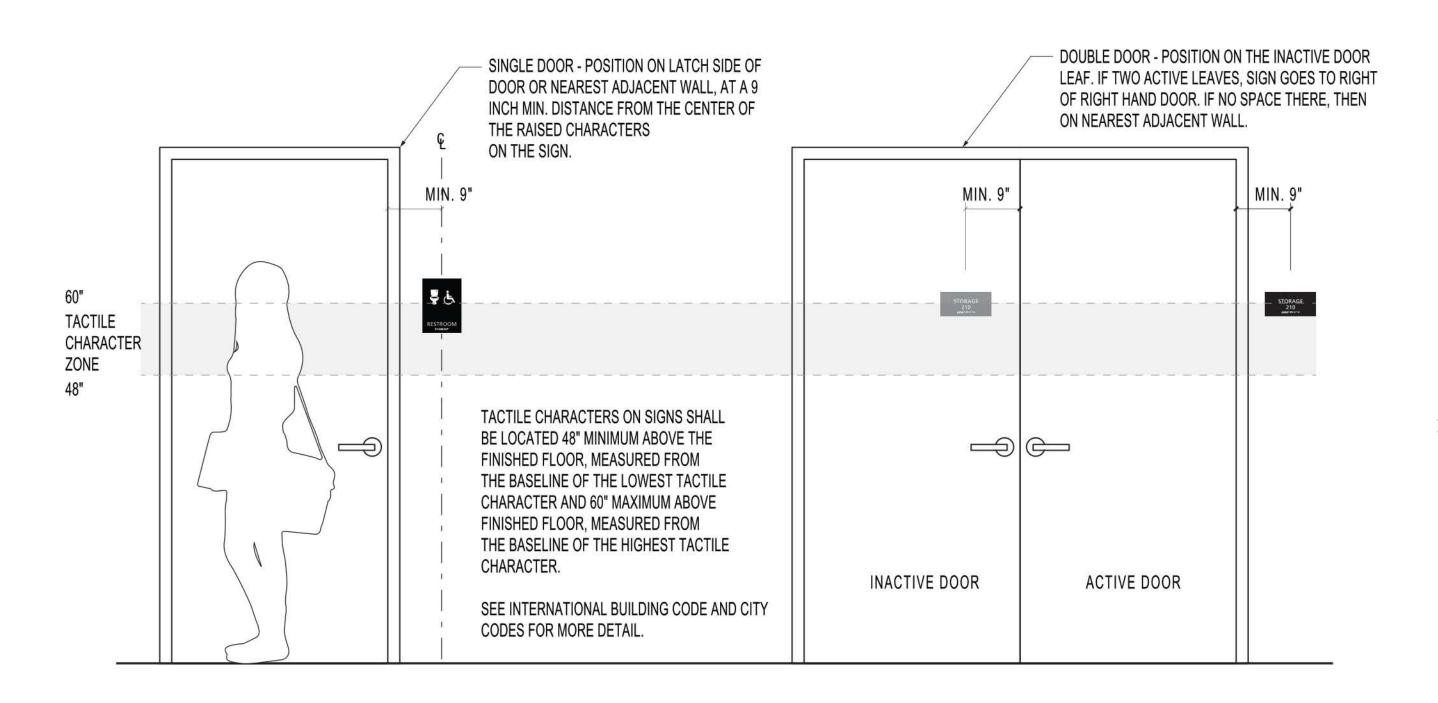

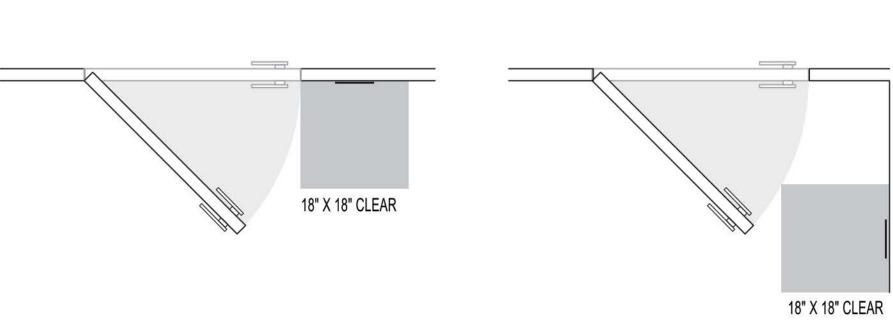

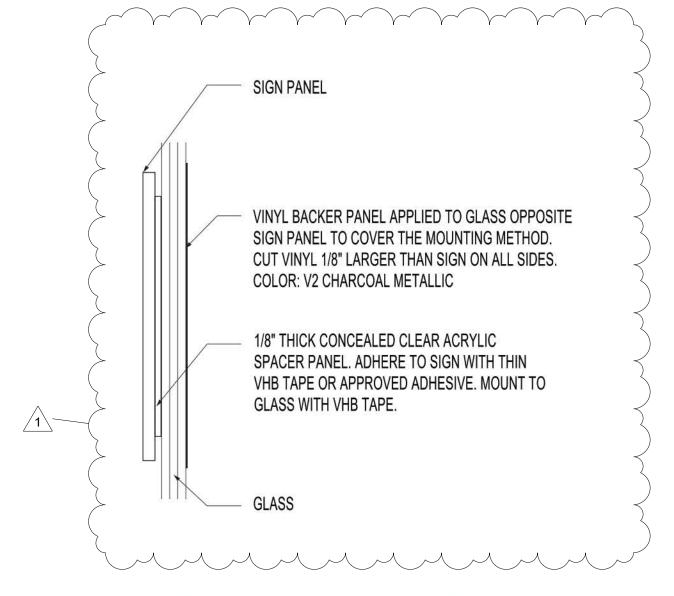

ROOM ID - ELEVATIONS - CODE REQUIRED MOUNTING LOCATION

2 ROOM ID - PLAN - CODE REQUIRED TACTILE CHARACTER CLEARANCE

3 MOUNTING CONDITION - GLASS

**GENERAL NOTES:** 1. PROVIDE SATIN FINISH CLEARCOAT OVER ALL PAINTED FINISHES AND CUT VINYL GRAPHICS. (VINYL MESSAGES) (TEXT COLOR) (SITE SIGN & INTERIOR (VINYL BACKER FOR GLASS MT) **ORACAL CHARCOAL METALLIC 937** MATCH ARCHITECT MATCH ARCHITECT SATIN FINISH MATTE FINISH CONTROL SAMPLE MATCH ARCHITECT

4 COLOR KEY

5 SYMBOLS



ABCDEFGHIJKLMNOPQRSTUVWXYZ abcdefghijklmnopqrstuvwxyz 0123456789

ABCDEFGHIJKLMNOPQRSTUVWXYZ abcdefghijklmnopqrstuvwxyz 0123456789

SIGNS CONTAINING TACTILE CHARACTERS

SHALL BE LOCATED SO THAT A CLEAR FLOOR

CENTERED ON THE TACTILE CHARACTERS, IS

PROVIDED BEYOND THE ARC OF ANY DOOR

SWING BETWEEN THE CLOSED POSITION

AND 45 DEGREE OPEN POSITION.

**ABCDEFGHIJKLMNOPQRSTUVWXYZ** abcdefghijklmnopqrstwxyz 0123456789

**ABCDEFGHIJKLMNOPQRSTUVWXYZ** abcdefghijklmnopqrstwxyz 0123456789

**ABCDEFGHIJKLMNOPQRSTUVWXYZ** abcdefghijklmnopqrstuvwxyz 0123456789

PROXIMA NOVA EXTRABOLD

6 TYPEFACES

Seattle, WA 98101 / 206.623.3344

SAN FRANCISCO / 660 Market Street. #300 San Francisco, CA 94104 / 415.956.0688 LOS ANGELES / 5837 Adams Blvd Culver City, CA 90232 / 323.937.2150

## SKANSKA

PORTLAND / 1010 NW Flanders St, #500 Portland, OR 97209 / 503.382.0900

Mayer/Reed

Mayer/Reed, Inc. 319 SW Washington St.

Portland, Oregon 97204 503.223.5953

PROJECT **CDHY - ACADEMIC &** PHYSICAL EDUCATION **BUILDING** 

LOCATION 611 GRAND BLVD VANCOUVER, WA 98661


PREPARED FOR **CENTER FOR DEAF AND** HARD OF HEARING YOUTH (CDHY)

DES PROJECT NO. 2018-713



SIGN GRAPHIC **STANDARDS** 



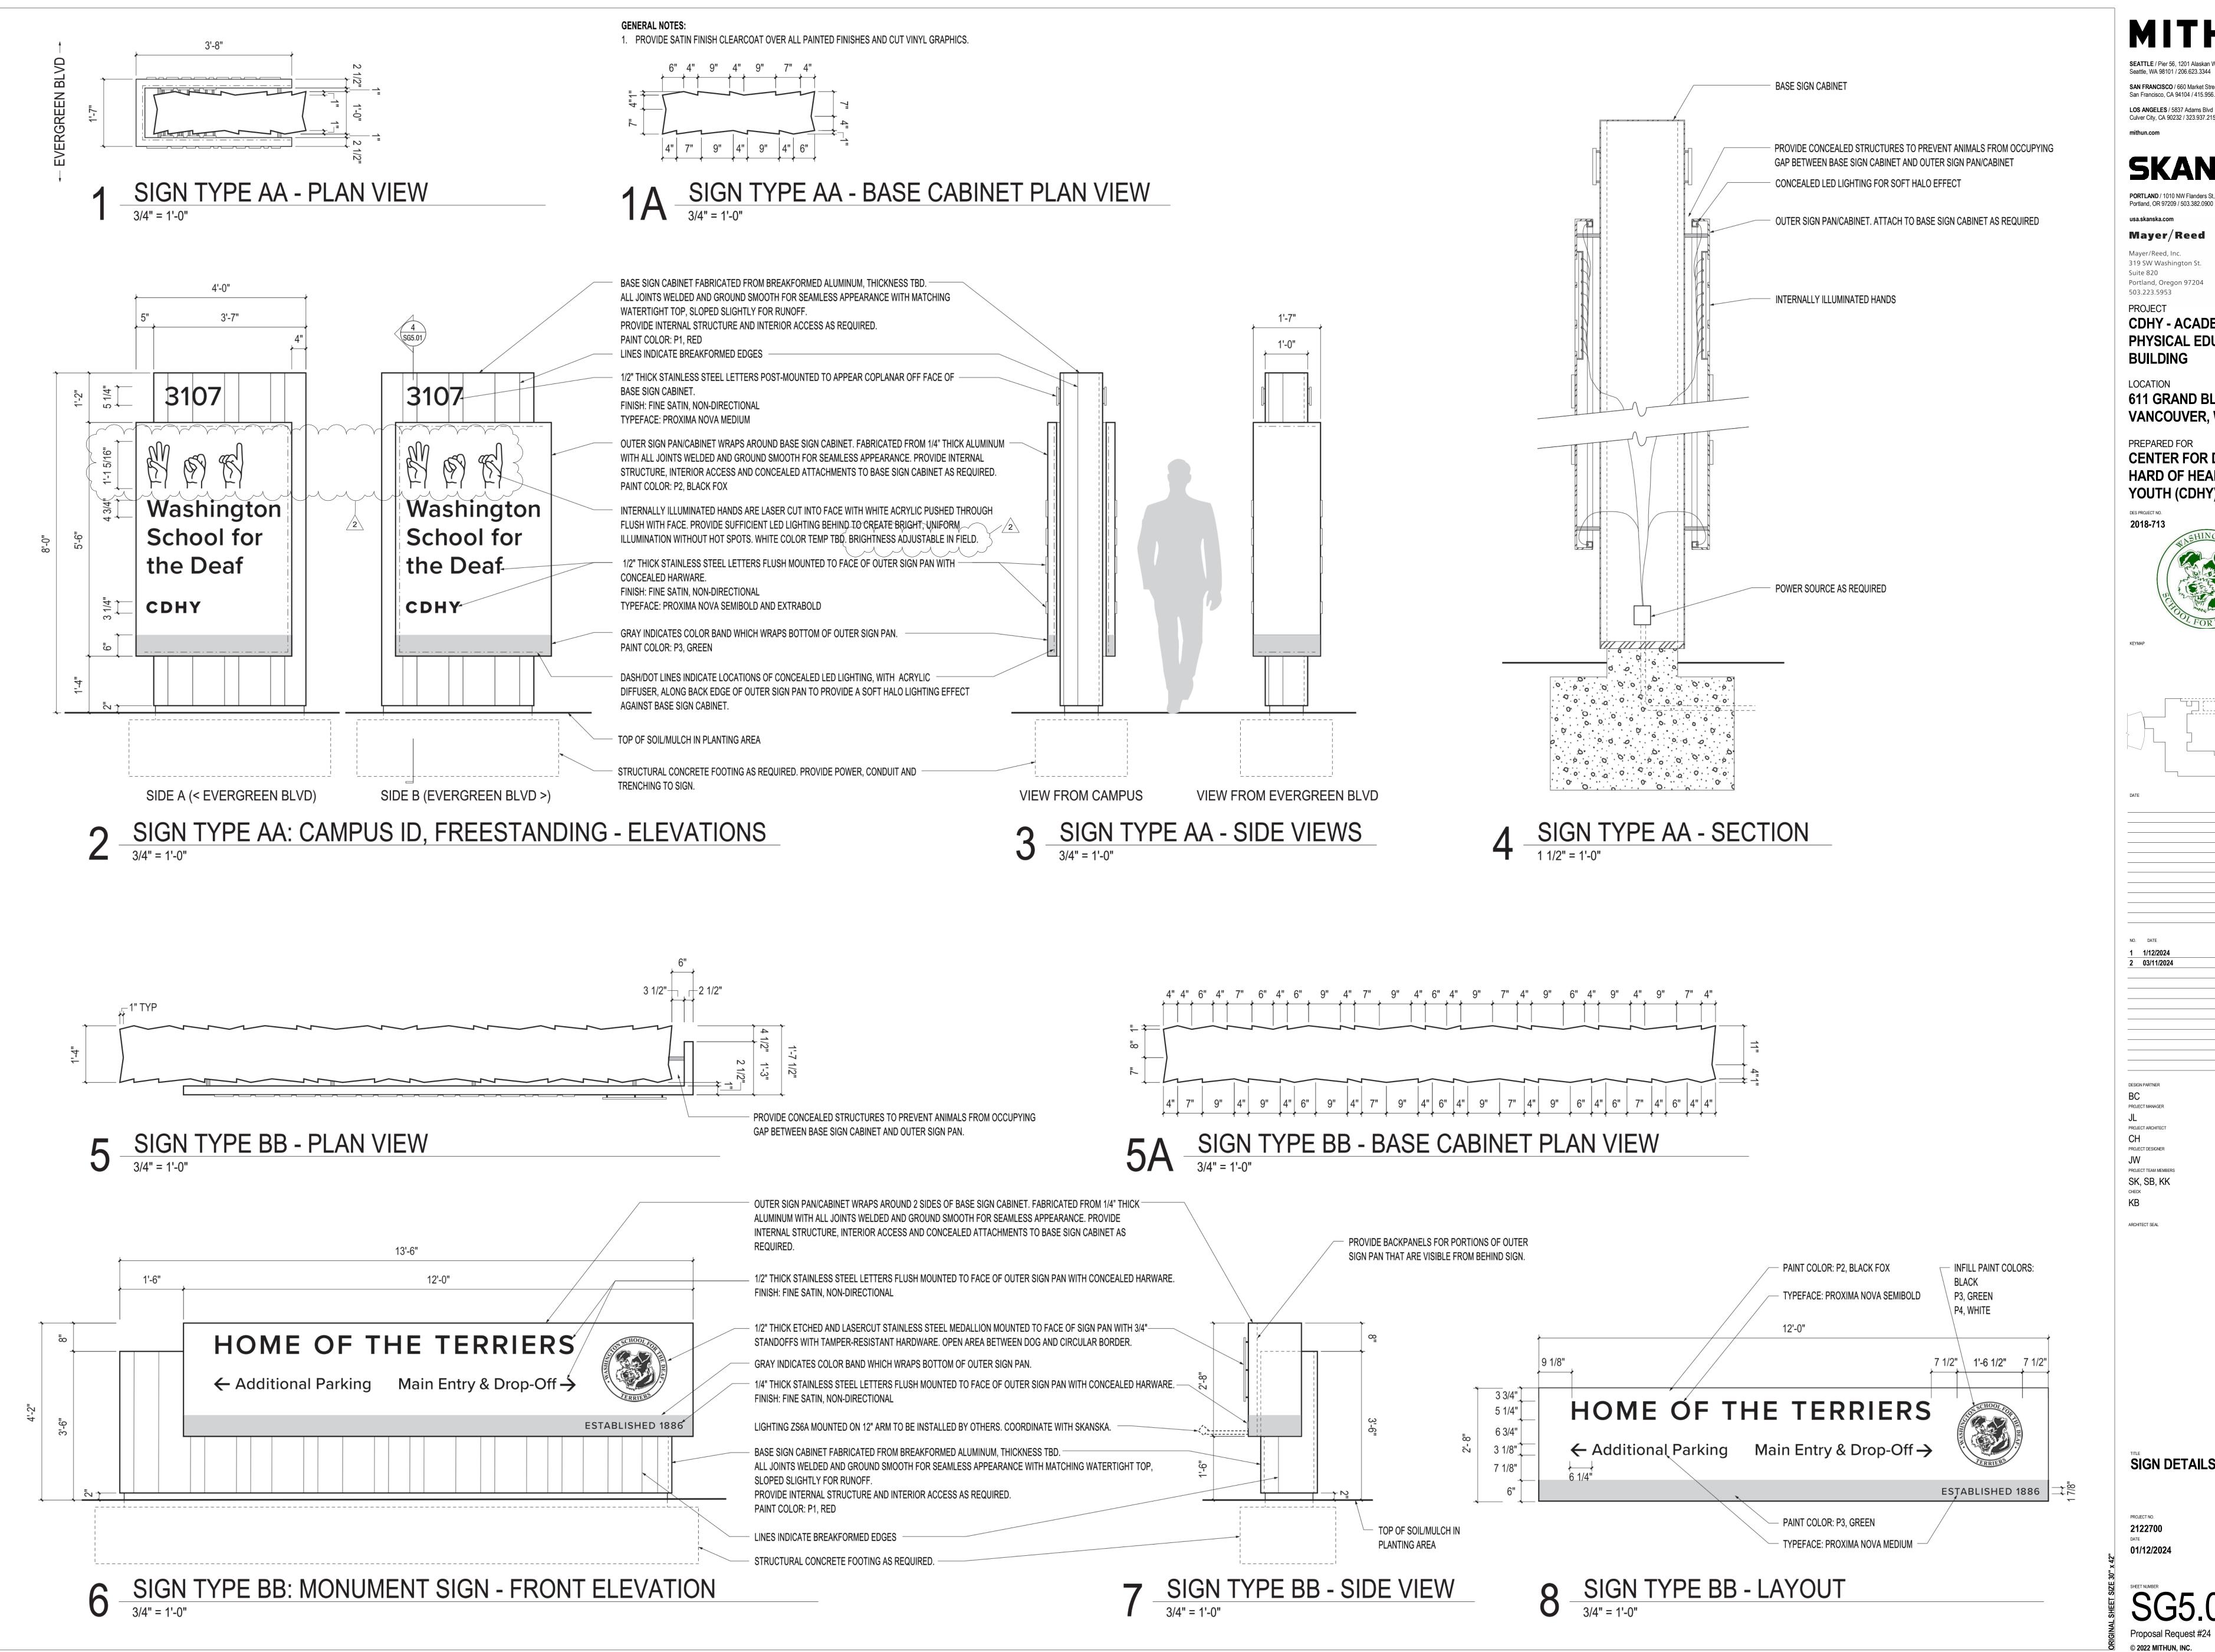

MITHUN

SAN FRANCISCO / 660 Market Street, #300 LOS ANGELES / 5837 Adams Blvd Culver City, CA 90232 / 323.937.2150

**SKANSKA** 

Mayer/Reed

Portland, Oregon 97204

**CDHY - ACADEMIC &** PHYSICAL EDUCATION


611 GRAND BLVD VANCOUVER, WA 98661

PREPARED FOR **CENTER FOR DEAF AND** HARD OF HEARING YOUTH (CDHY)



**SIGN DETAILS 1** 

SG5.01

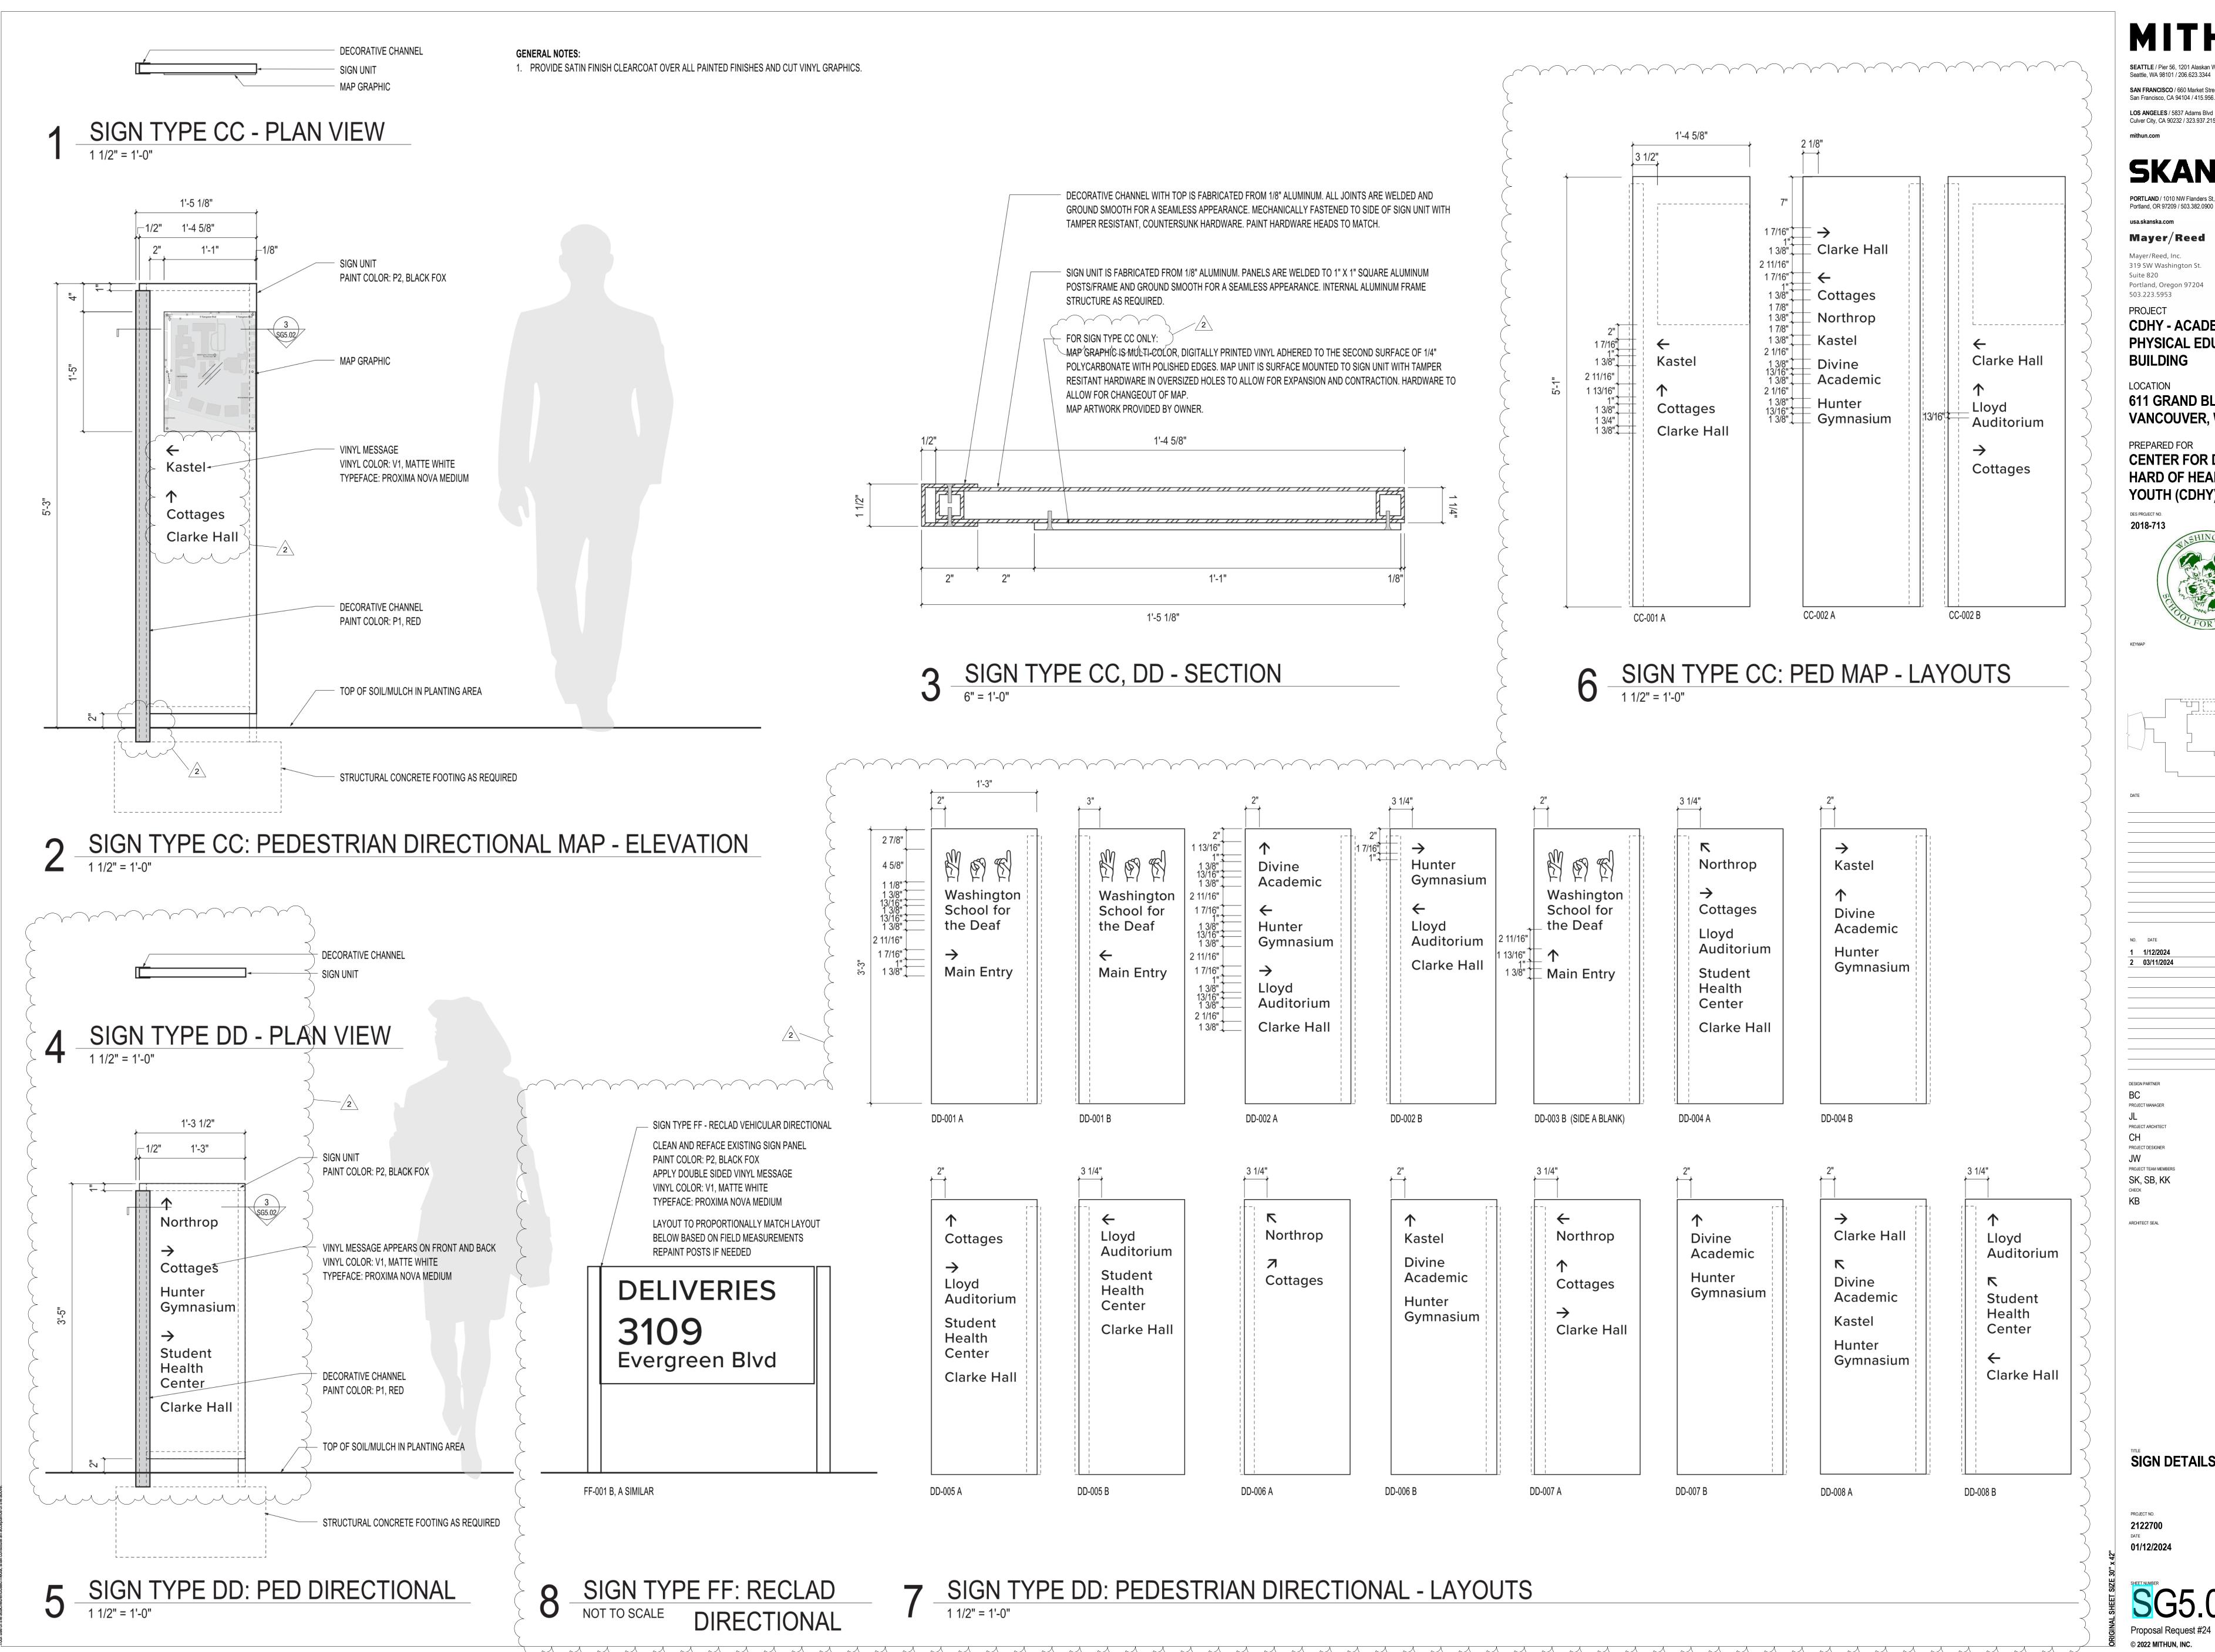

SAN FRANCISCO / 660 Market Street, #300 San Francisco, CA 94104 / 415.956.0688 LOS ANGELES / 5837 Adams Blvd Culver City, CA 90232 / 323.937.2150

SKANSKA


Portland, Oregon 97204

**CDHY - ACADEMIC &** PHYSICAL EDUCATION

611 GRAND BLVD VANCOUVER, WA 98661 **CENTER FOR DEAF AND** 

HARD OF HEARING YOUTH (CDHY)

**SIGN DETAILS 2** 

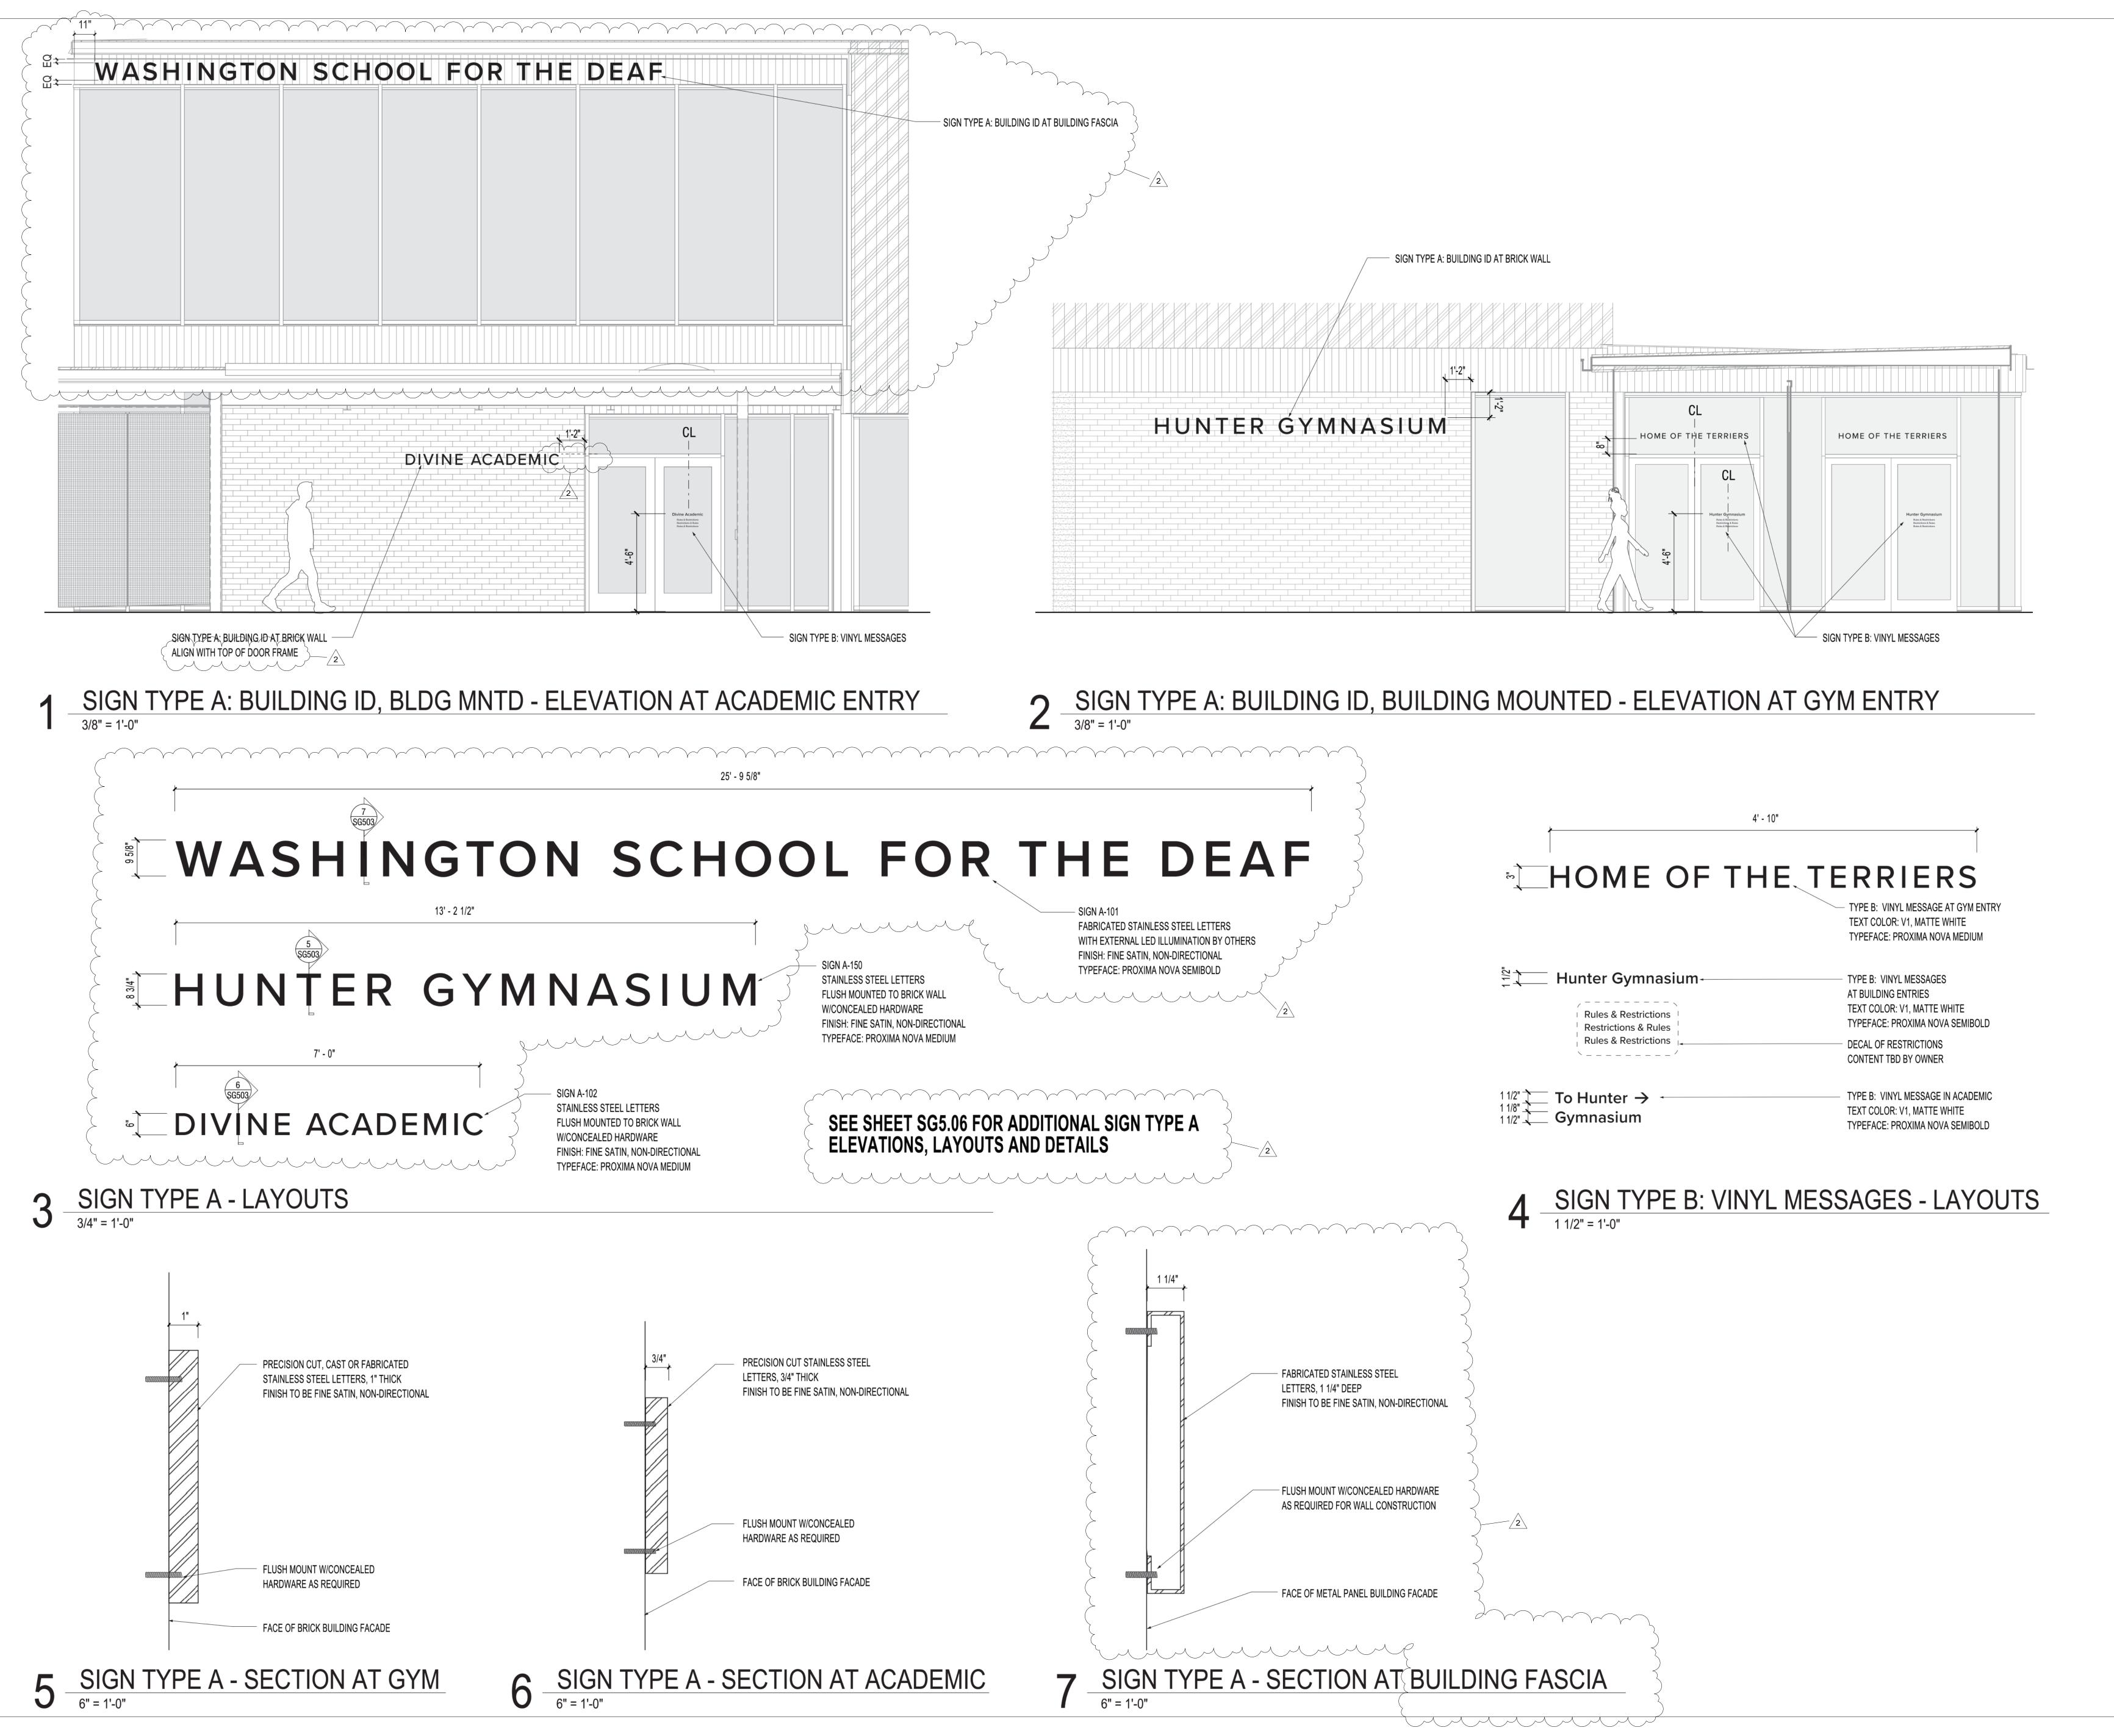

Culver City, CA 90232 / 323.937.2150

#### **SKANSKA**

Portland, OR 97209 / 503.382.0900

Mayer/Reed

Portland, Oregon 97204 503.223.5953

**CDHY - ACADEMIC &** PHYSICAL EDUCATION **BUILDING** 

611 GRAND BLVD VANCOUVER, WA 98661

PREPARED FOR **CENTER FOR DEAF AND** HARD OF HEARING YOUTH (CDHY)



2 03/11/2024

PROJECT MANAGER PROJECT ARCHITECT


PROJECT DESIGNER PROJECT TEAM MEMBERS SK, SB, KK

**SIGN DETAILS 3** 

2122700 01/12/2024




SIGN TYPE C, D - TYPICAL MOUNTING CONDITIONS 1/2" = 1'-0"

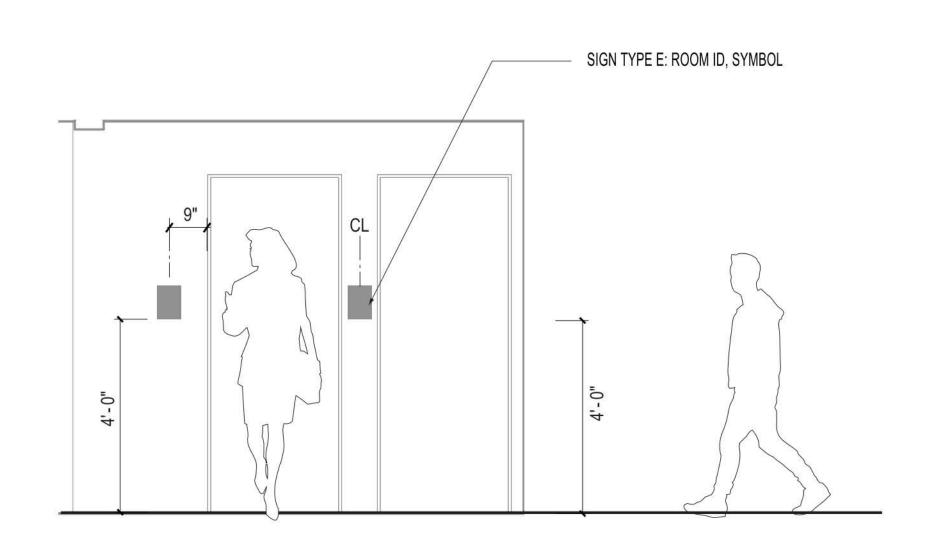


2 SIGN TYPE E - TYPICAL MOUNTING CONDITIONS

1/2" = 1'-0"

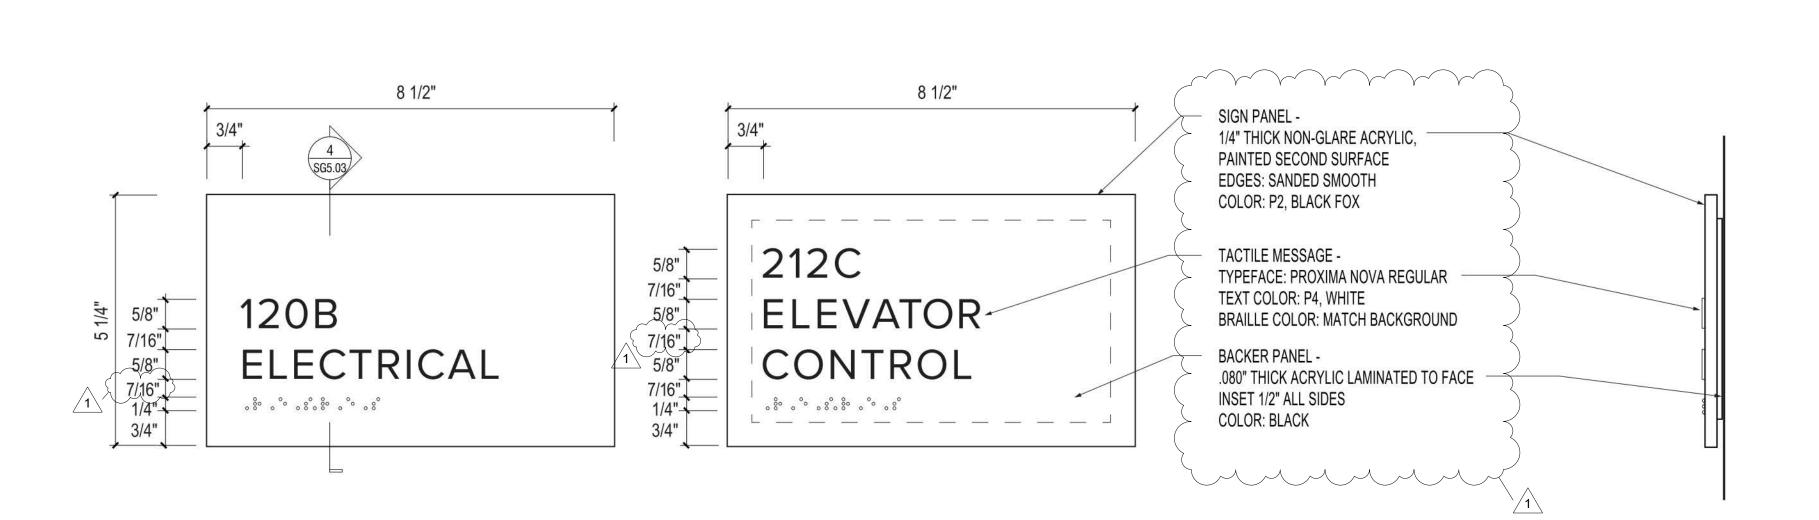


3 SIGN TYPE C: ROOM ID, FIXED - ELEVATION & TYPICAL LAYOUTS
HALF FULL SCALE

4 SIGN TYPE C - SECTION
HALF FULL SCALE

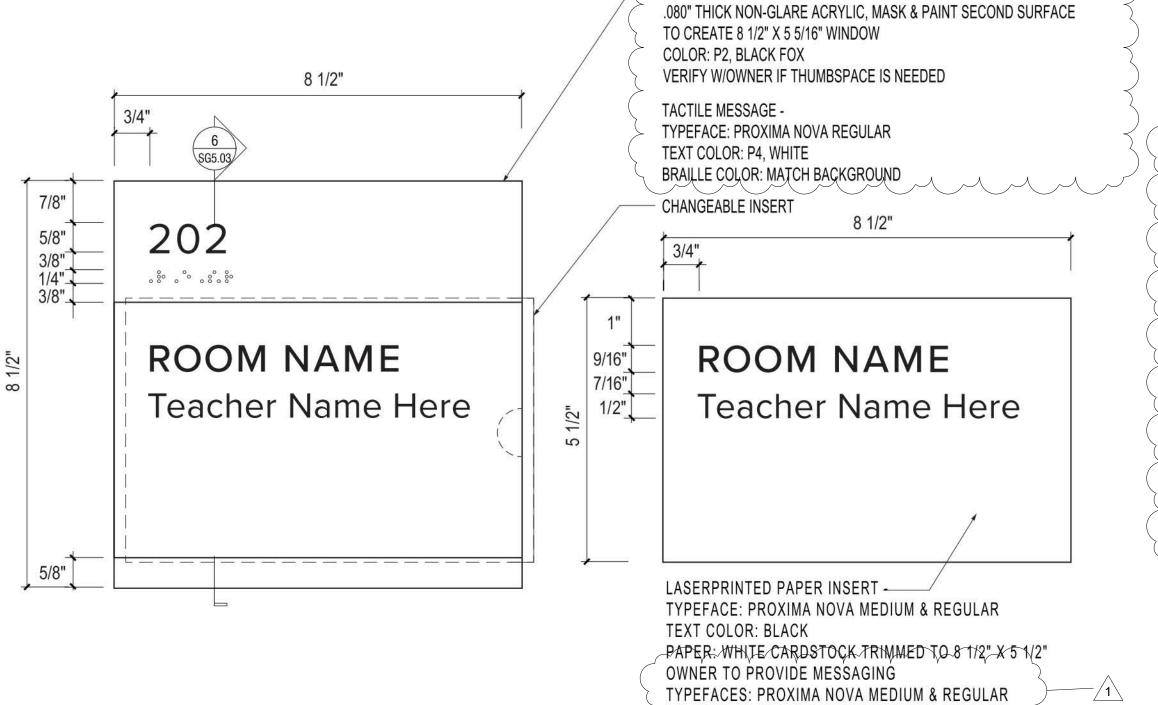

SIGN PANEL -

5 SIGN TYPE D: ROOM ID, CHANGEABLE - ELEVATION & TYPICAL LAYOUT

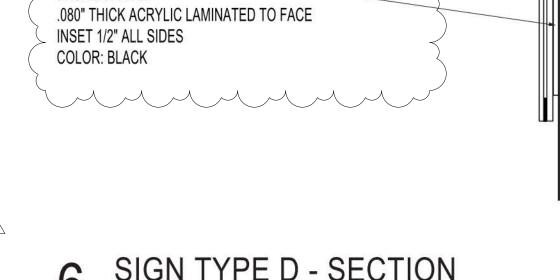

6 SIGN TYPE D - SECTION
HALF FULL SCALE

.080" THICK NON-GLARE ACRYLIC

MASK & PAINT SECOND SURFACE

**EDGES: SANDED SMOOTH** 

CLEAR WINDOW TO DISPLAY

8 1/2" X 5 1/2" PAPER INSERT

INSTALL WITH ALL D SIGNS


BACKER PANEL -

TACTILE MESSAGE

TO CREATE 8 1/2" X 5 5/16" WINDOW


1/16" SPACER TO ALLOW ROOM FOR CHANGEABLE


.080" ACRYLIC PANEL LAMINATED TO BACKER

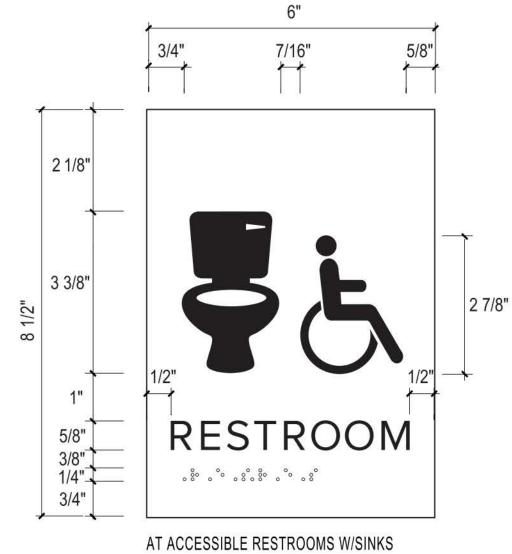






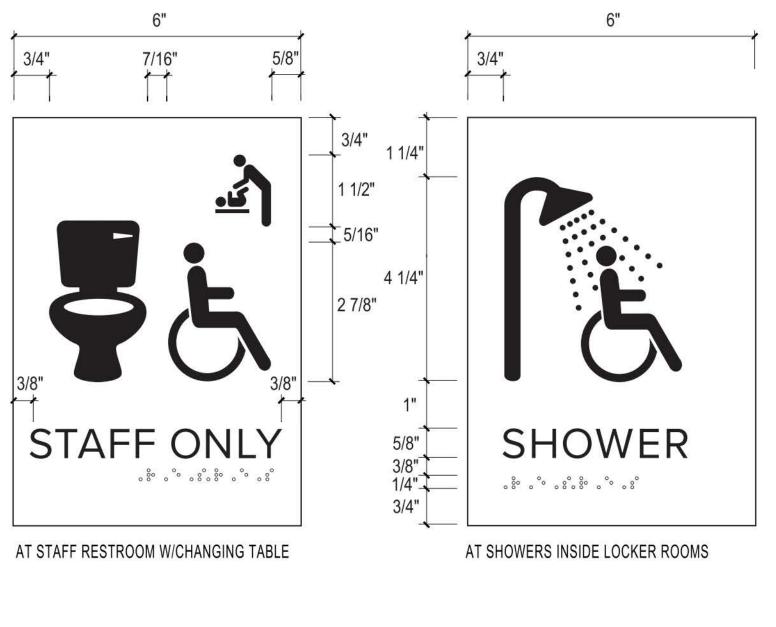

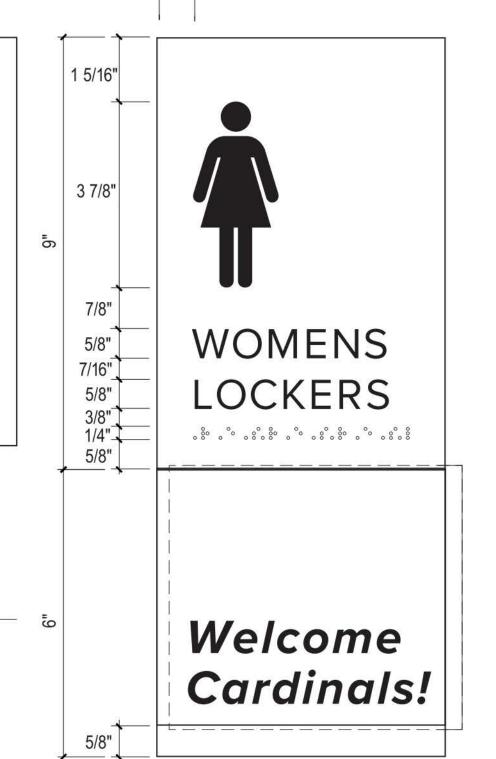

AT ENTRY TO WOMEN'S LOCKER ROOM

AT ENTRY TO MEN'S LOCKER ROOM

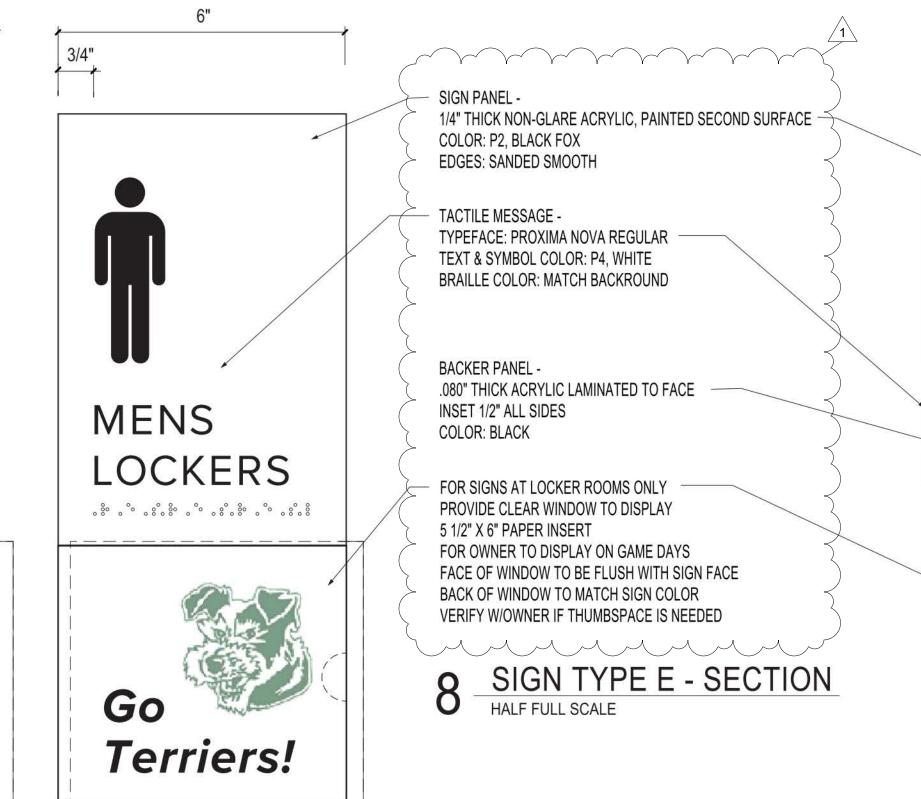

**SEATTLE** / Pier 56, 1201 Alaskan Way, #200 Seattle, WA 98101 / 206.623.3344 SAN FRANCISCO / 660 Market Street, #300 San Francisco, CA 94104 / 415.956.0688 LOS ANGELES / 5837 Adams Blvd Culver City, CA 90232 / 323.937.2150

### **SKANSKA**

PORTLAND / 1010 NW Flanders St, #500 Portland, OR 97209 / 503.382.0900 usa.skanska.com

Mayer/Reed

Mayer/Reed, Inc. 319 SW Washington St Suite 820

Portland, Oregon 97204 503.223.5953 PROJECT

**CDHY - ACADEMIC &** PHYSICAL EDUCATION **BUILDING** 

LOCATION 611 GRAND BLVD **VANCOUVER, WA 98661** 

PREPARED FOR **CENTER FOR DEAF AND** HARD OF HEARING YOUTH (CDHY)



PROJECT ARCHITECT PROJECT DESIGNER PROJECT TEAM MEMBERS SK, SB, KK

PROJECT MANAGER


ARCHITECT SEAL

**SIGN DETAILS 4** 

01/12/2024


SG5.04 © 2024 MITHUN, INC.

SIGN TYPE E: ROOM ID, SYMBOL - ELEVATION & LAYOUTS

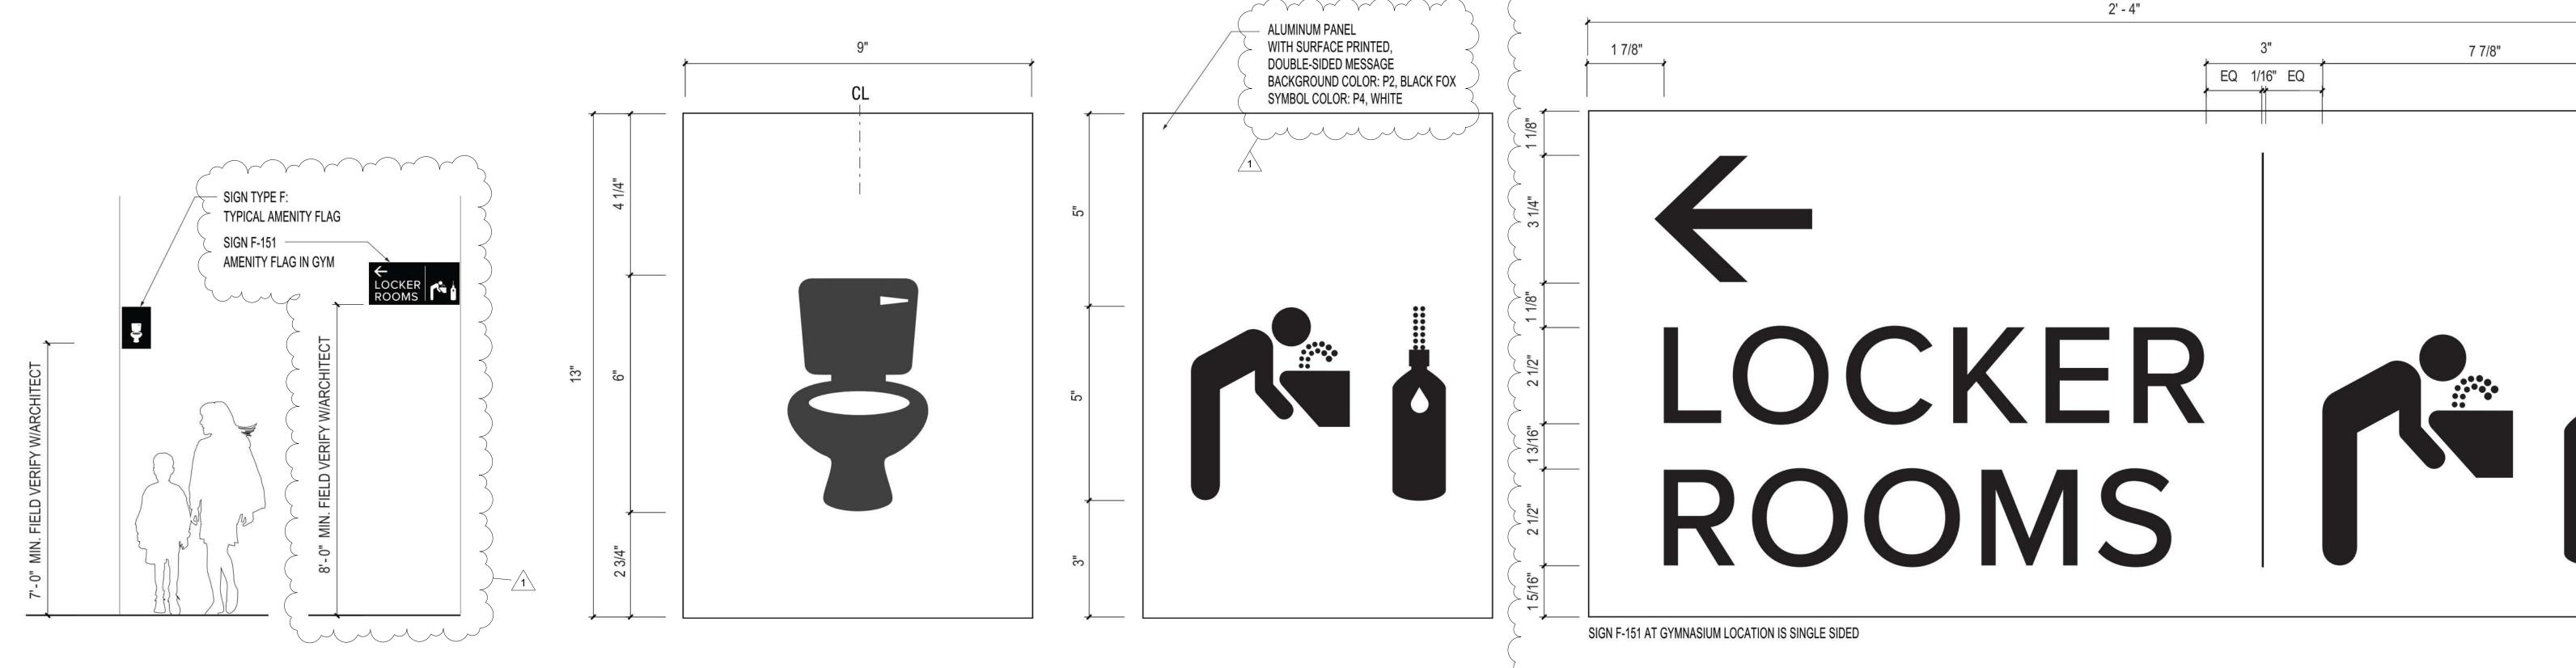

1 SIGN TYPE F - MOUNTING CONDITION


2 SIGN TYPE F: AMENITY FLAG - ELEVATION & LAYOUTS
HALF FULL SCALE

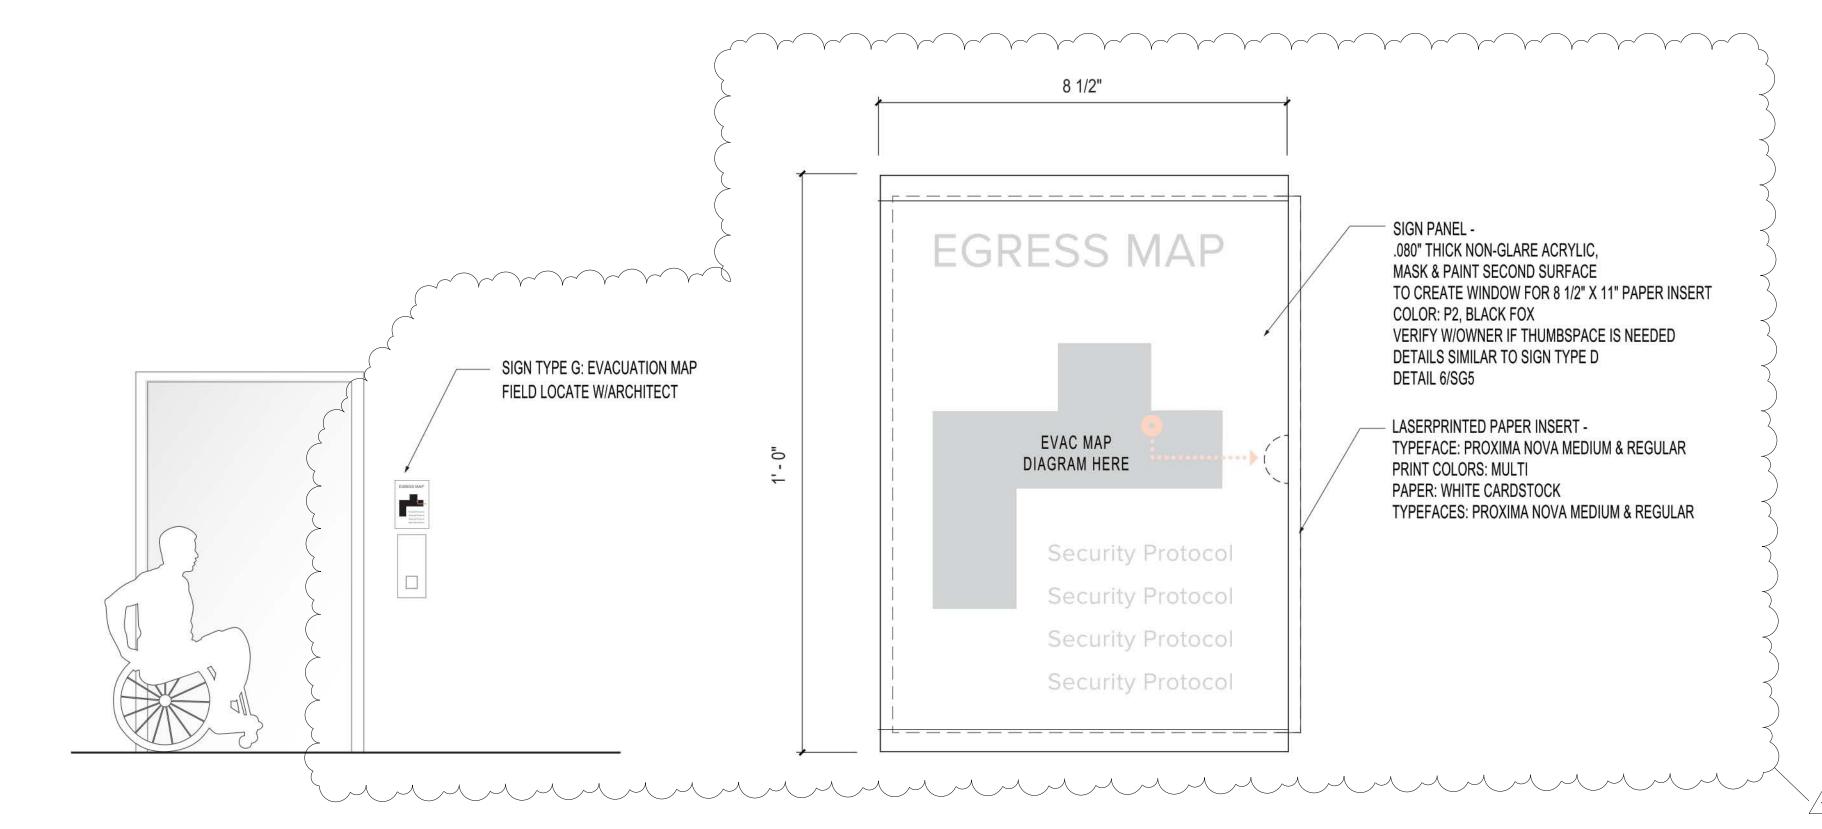

3 SIGN TYPE G - MOUNTING CONDITION


SIGN TYPE H: INFORMATION SIGNS

4 SIGN TYPE G: EVACUATION MAP - ELEVATION
HALF FULL SCALE

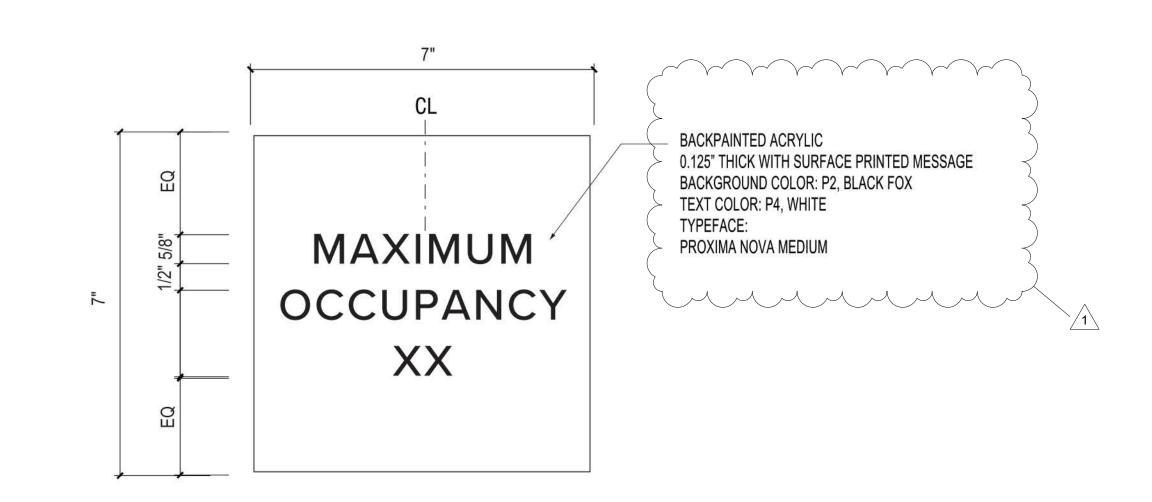

6 SIGN TYPE H - MOUNTING CONDITION

7 SIGN TYPE H: INFORMATION SIGN - ELEVATION & LAYOUT HALF FULL SCALE

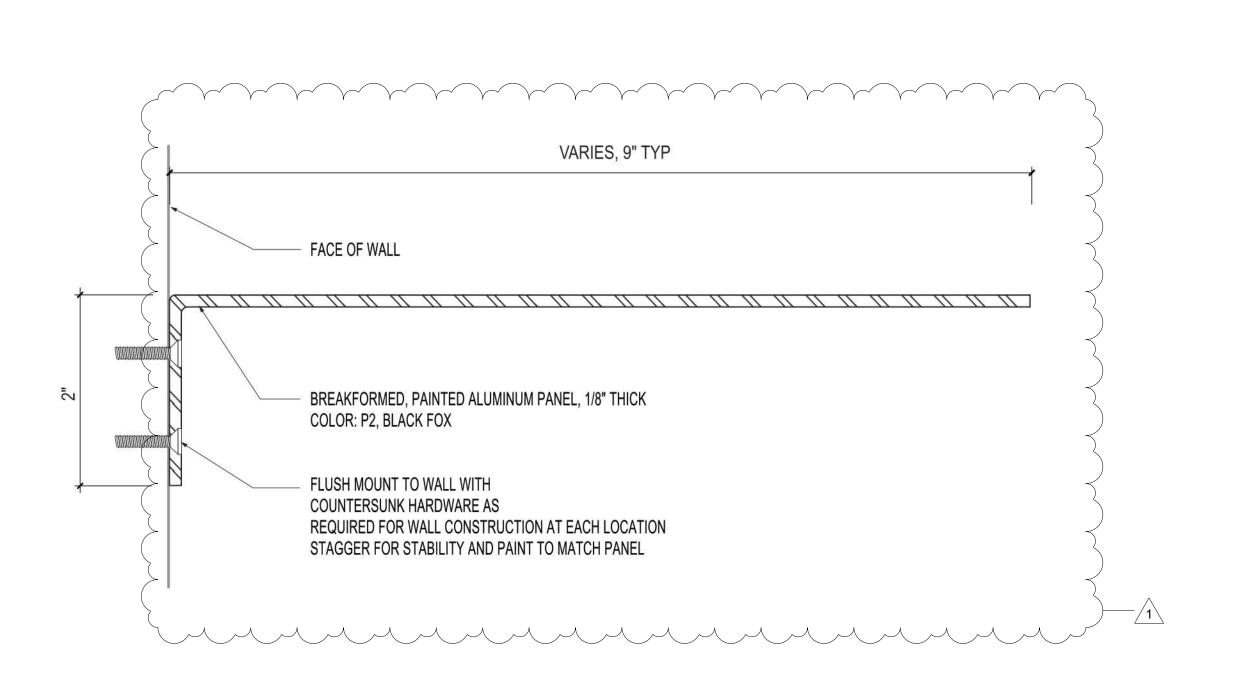

5 SIGN TYPE F - SECTION FULL SCALE

MITHŪN

SEATTLE / Pier 56, 1201 Alaskan Way, #200 Seattle, WA 98101 / 206.623.3344

SAN FRANCISCO / 660 Market Street, #300 San Francisco, CA 94104 / 415.956.0688

LOS ANGELES / 5837 Adams Blvd Culver City, CA 90232 / 323.937.2150

mithun.com

1 1/4"

### SKANSKA

PORTLAND / 1010 NW Flanders St, #500 Portland, OR 97209 / 503.382.0900

Mayer/Reed

Mayer/Reed, Inc. 319 SW Washington St.

Mayer/Reed, Inc. 319 SW Washington St. Suite 820 Portland, Oregon 97204

PROJECT
CDHY - ACADEMIC &

PHYSICAL EDUCATION
BUILDING

LOCATION
611 GRAND BLVD
VANCOUVER, WA 98661

PREPARED FOR

CENTER FOR DEAF AND

HARD OF HEARING

YOUTH (CDHY)

DES PROJECT NO. **2018-713** 



DATE

NO. DATE

1 1/12/2024

PR

DESIGN PARTNER

BC

SK, SB, KK CHECK KB

PROJECT MANAGER

PROJECT ARCHITECT

PROJECT DESIGNER

PROJECT TEAM MEMBERS

SIGN DETAILS 5

PROJECT NO.

2122700


DATE

01/12/202


SHEET NUMBER

SG5.05


Proposal Request #24
© 2024 MITHUN, INC.

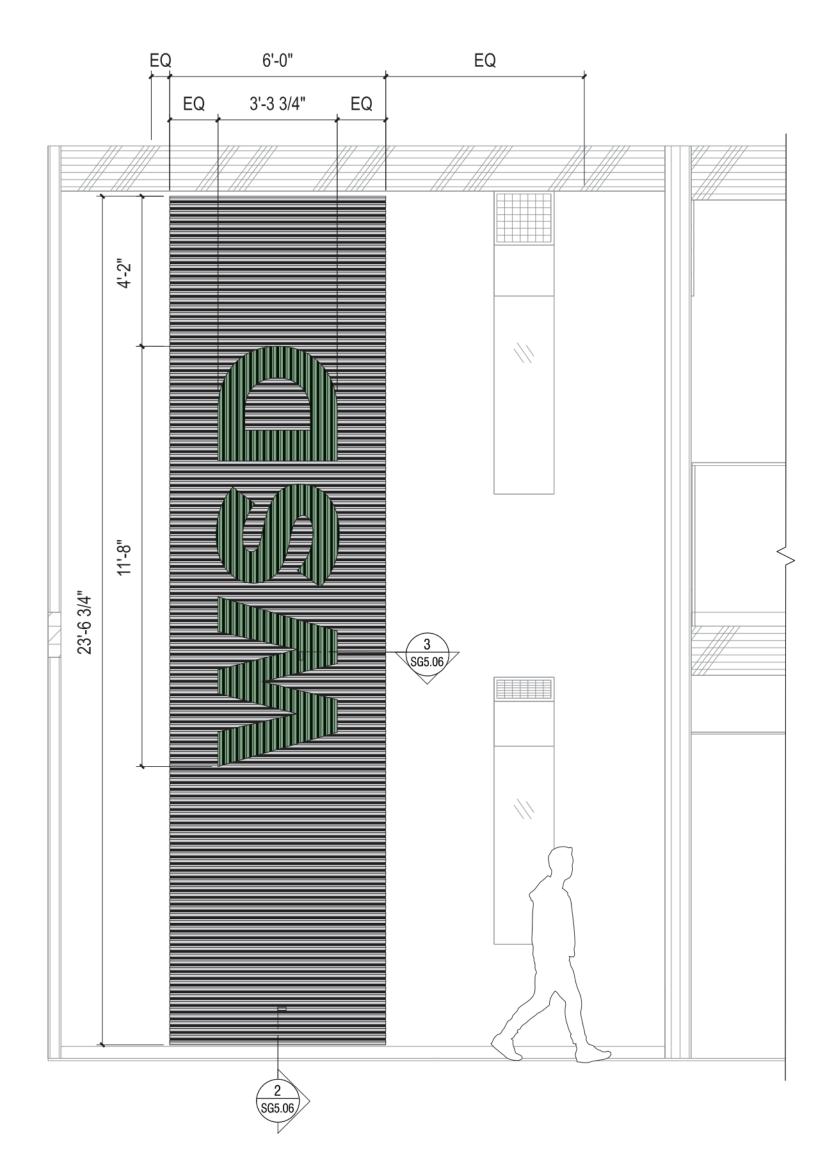


1 SIGN TYPE J: SLAT WALL GRAPHIC - ELEVATION
3/8" = 1-0"

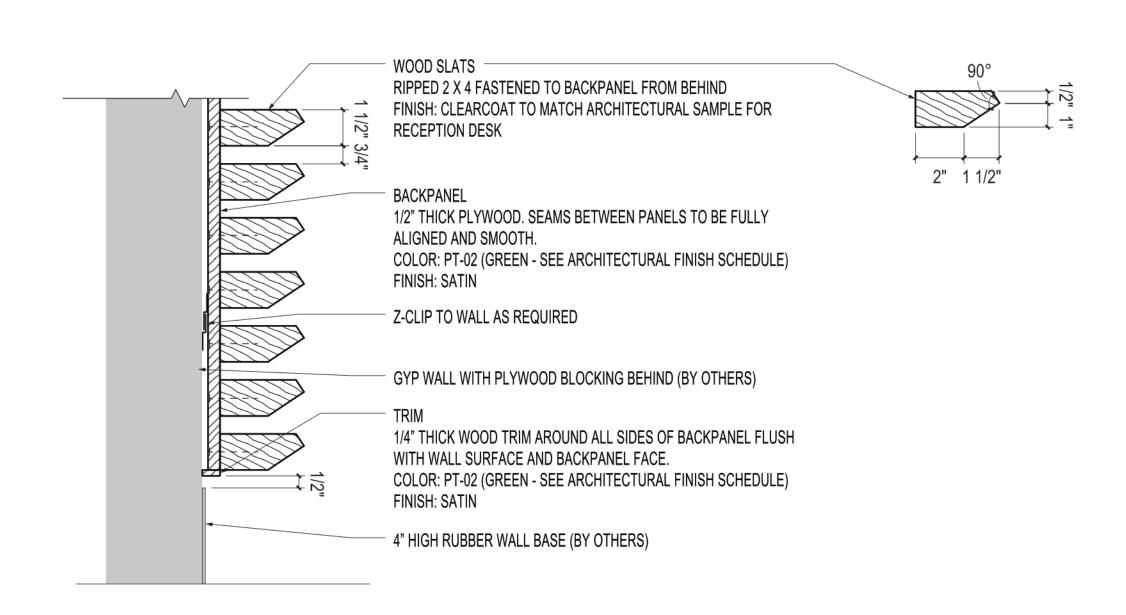


2 SIGN TYPE J - SECTION AT HORIZONTAL SLATS
3" = 1-0"

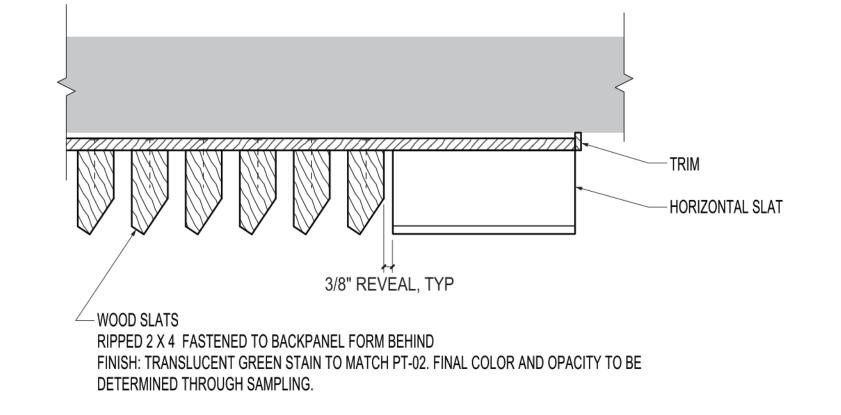

3 SIGN TYPE J - SECTION AT VERTICAL SLATS "WSD"

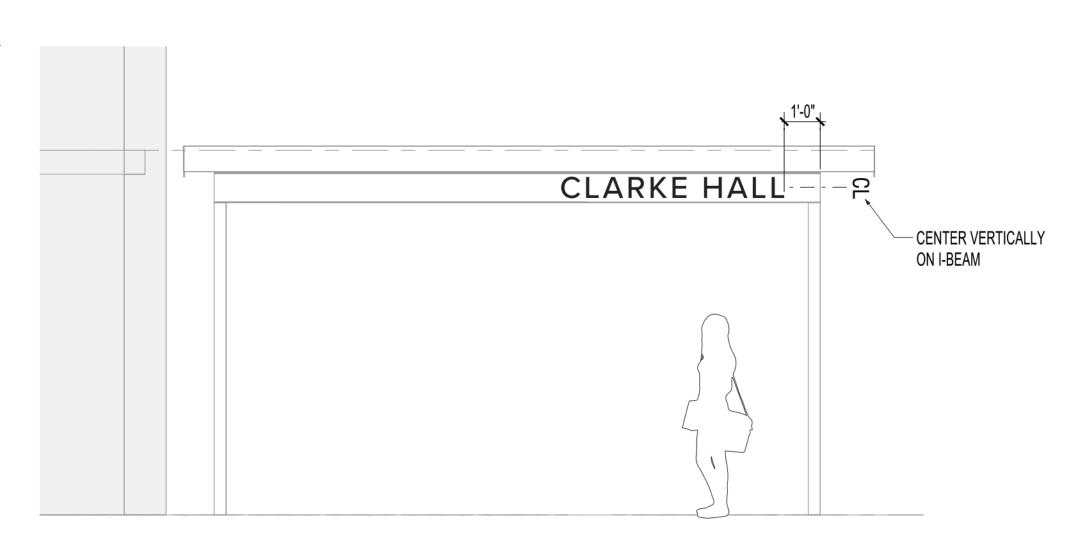


6 SIGN TYPE A: BUILDING ID - ELEVATION AT CLARKE NORTH

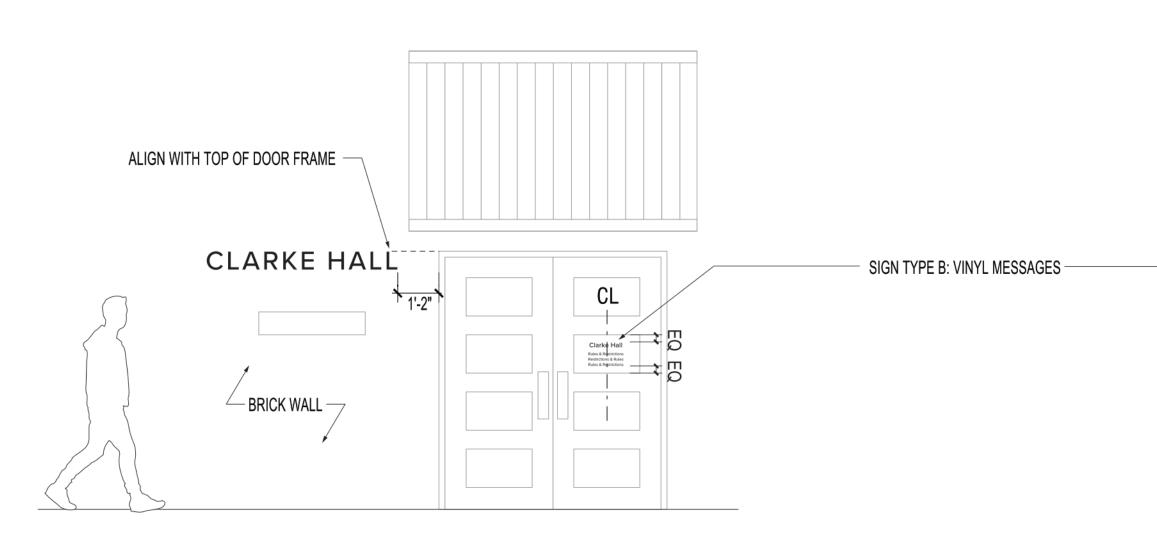


7 SIGN TYPE A: BUILDING ID - ELEVATION AT CLARKE SOUTH

3/8" = 1'-0"

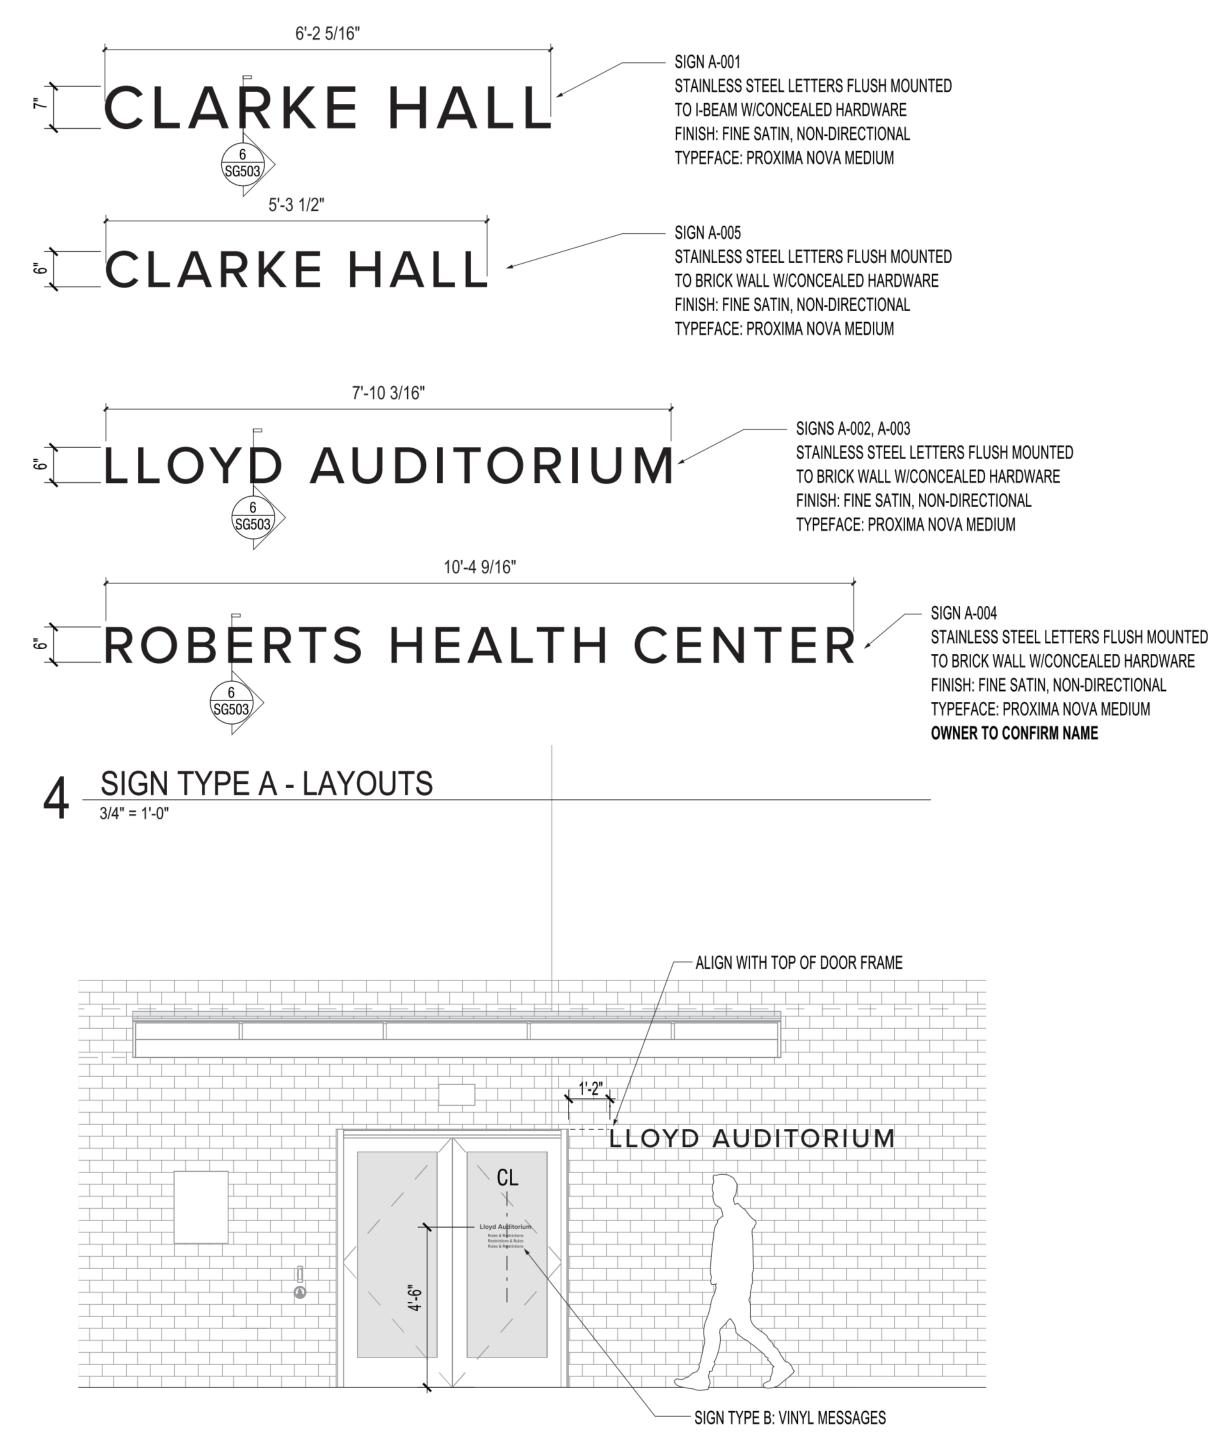

5 SIGN TYPE A: BUILDING ID - ELEVATION AT LLOYD NORTH, SOUTH SIMILAR

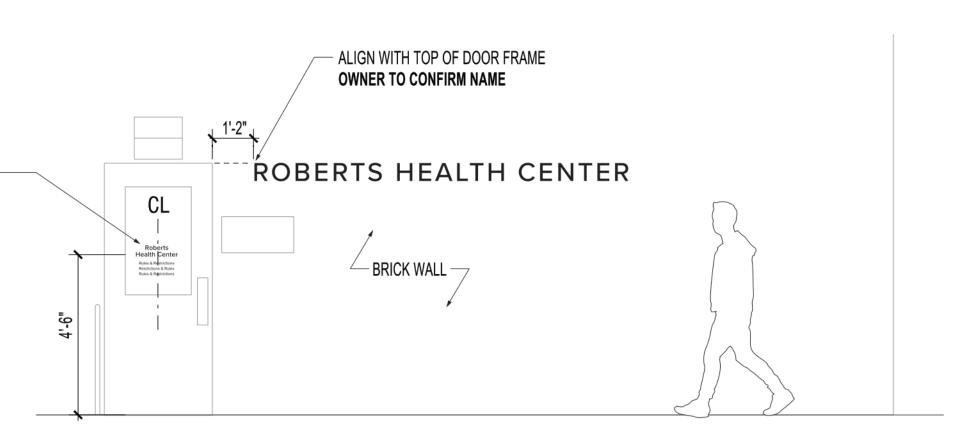

8 SIGN TYPE A: BUILDING ID - ELEVATION AT HEALTH CENTER

SEATTLE / Pier 56, 1201 Alaskan Way, #200
Seattle, WA 98101 / 206.623.3344

SAN FRANCISCO / 660 Market Street, #300
San Francisco, CA 94104 / 415.956.0688

LOS ANGELES / 5837 Adams Blvd
Culver City, CA 90232 / 323.937.2150

mithun.com

SKANSKA

PORTLAND / 1010 NW Flanders St, #500
Portland, OR 97209 / 503.382.0900

Mayer/Reed

319 SW Washington St.

Portland, Oregon 97204

**CDHY - ACADEMIC &** 

611 GRAND BLVD

PHYSICAL EDUCATION

**VANCOUVER, WA 98661** 

**CENTER FOR DEAF AND** 

HARD OF HEARING

YOUTH (CDHY)

Mayer/Reed, Inc.

503.223.5953

**BUILDING** 

PREPARED FOR

LOCATION

2018-713


SIGN DETAILS 6

PROJECT TEAM MEMBERS


2122700 DATE 03/05/24

SHEET NUMBER SC 5.06

Proposal Request #24

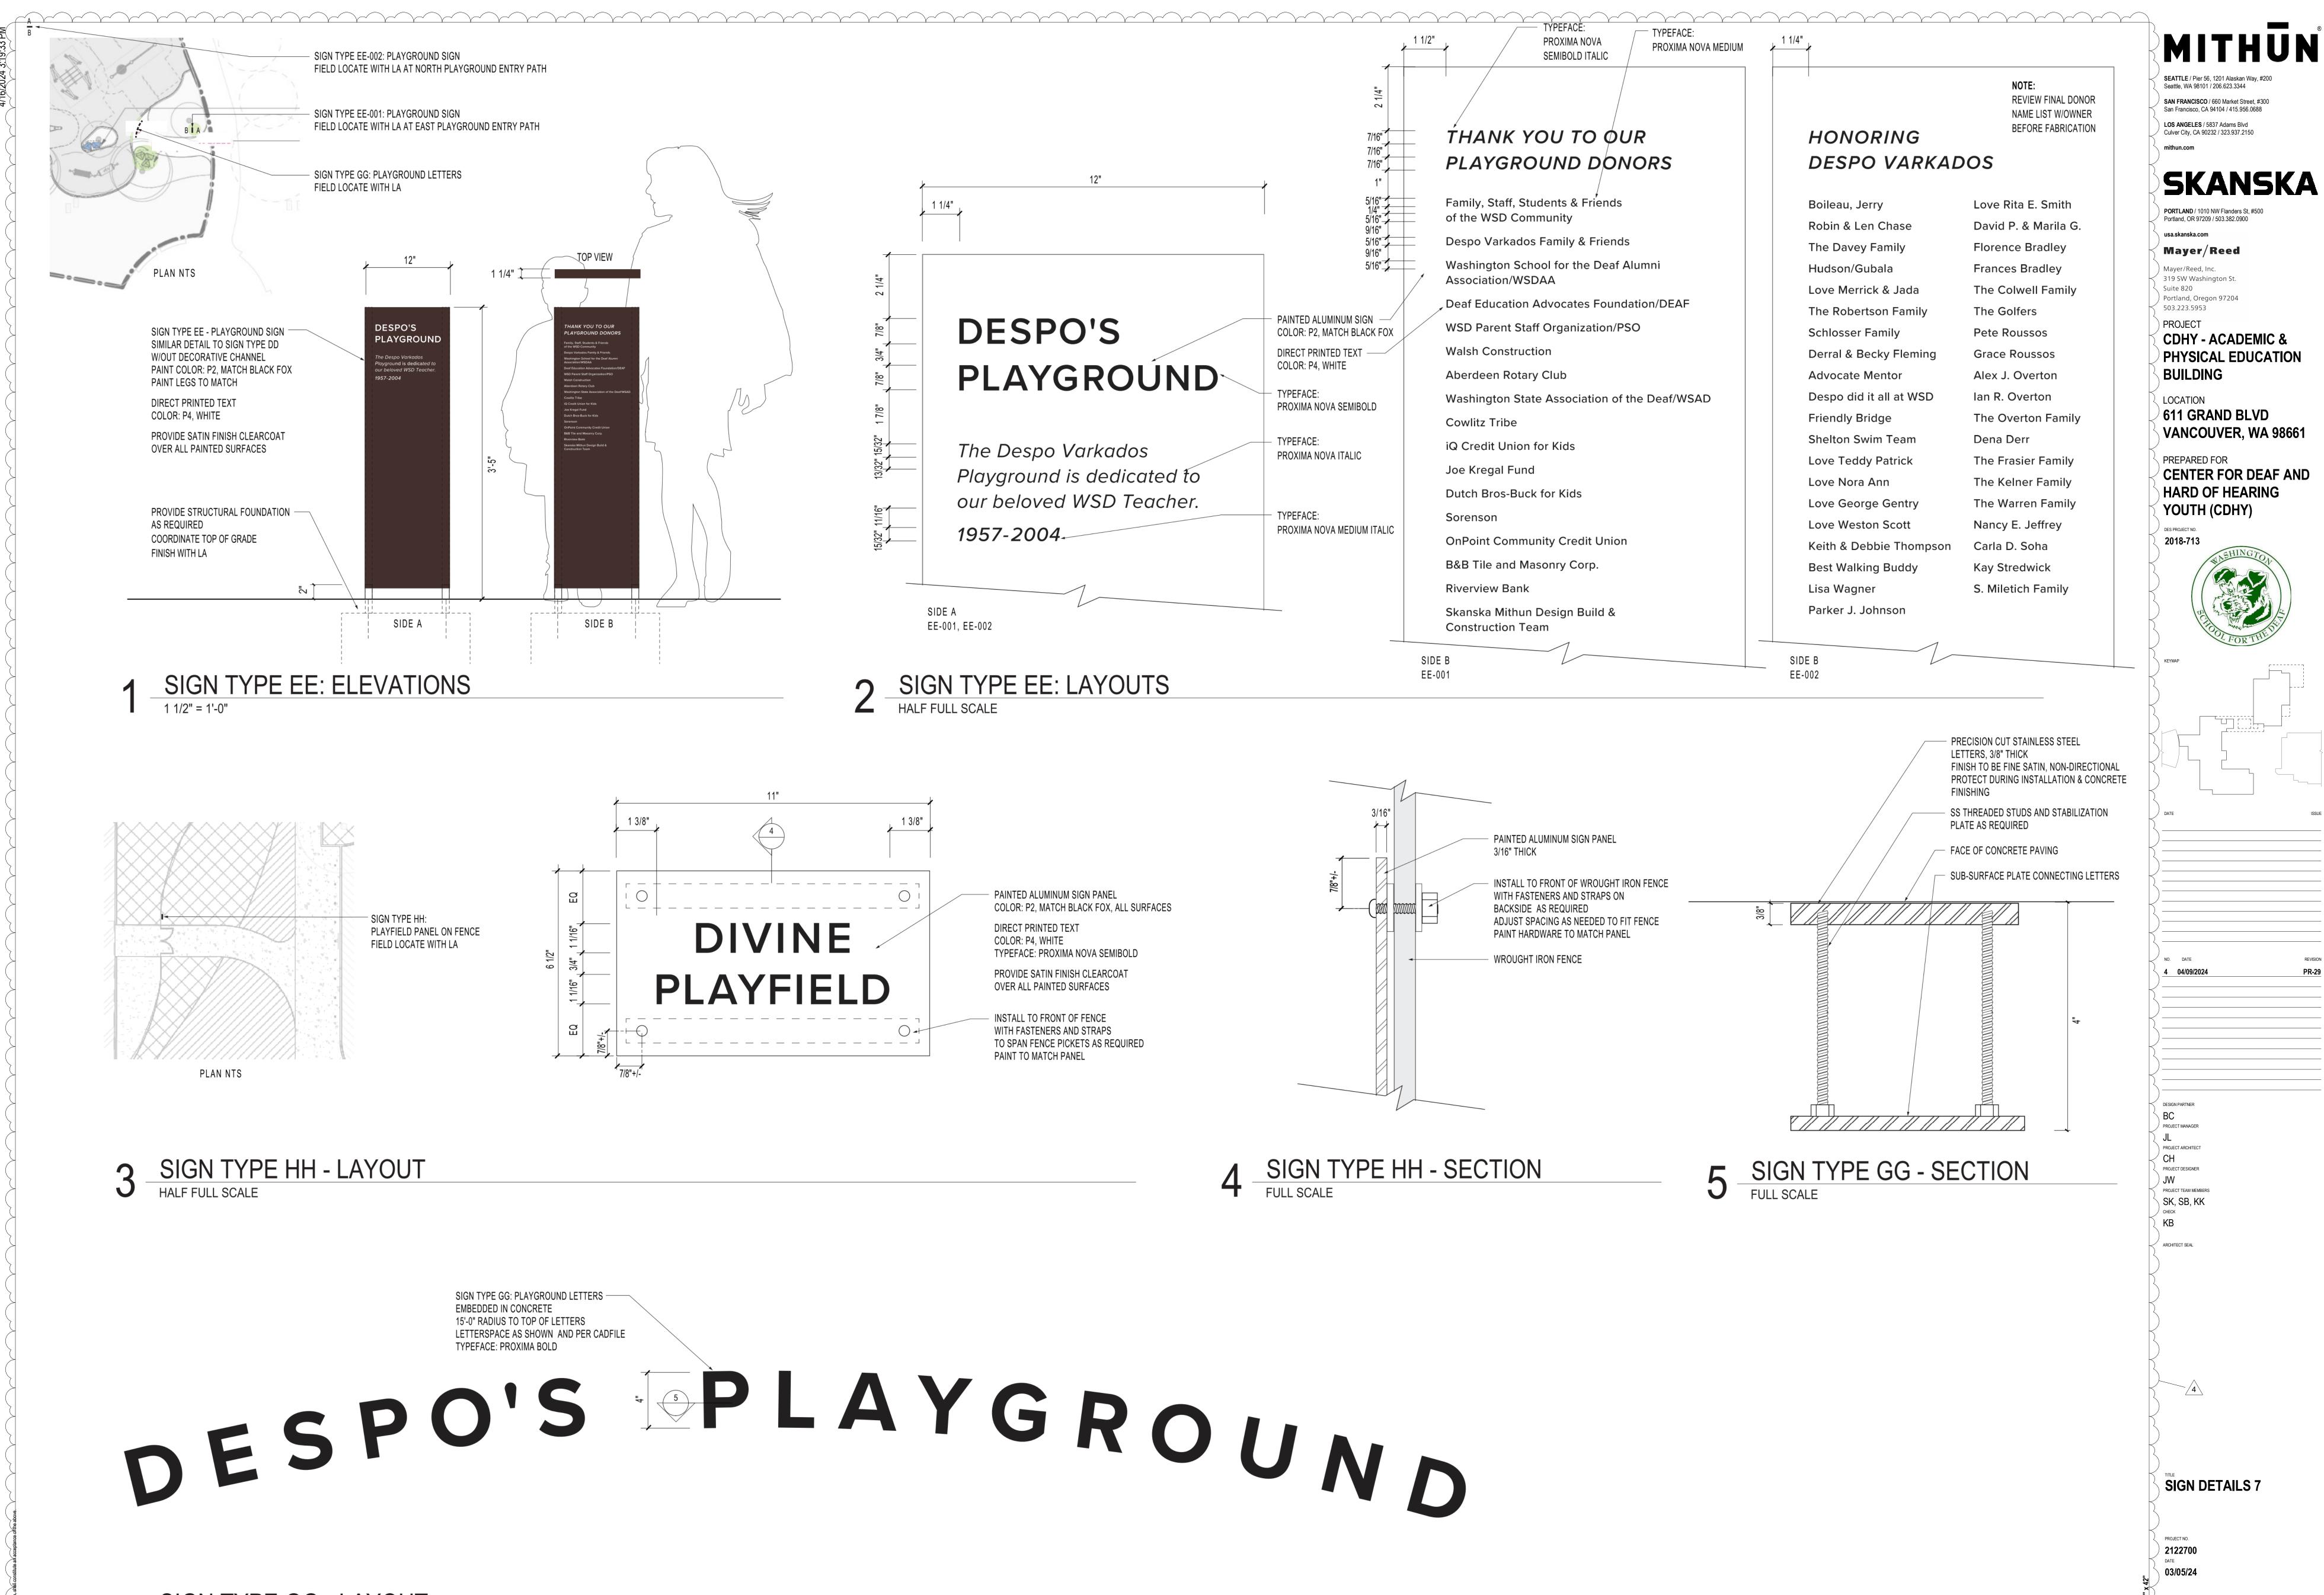

Proposal Request #24
© 2022 MITHUN, INC.

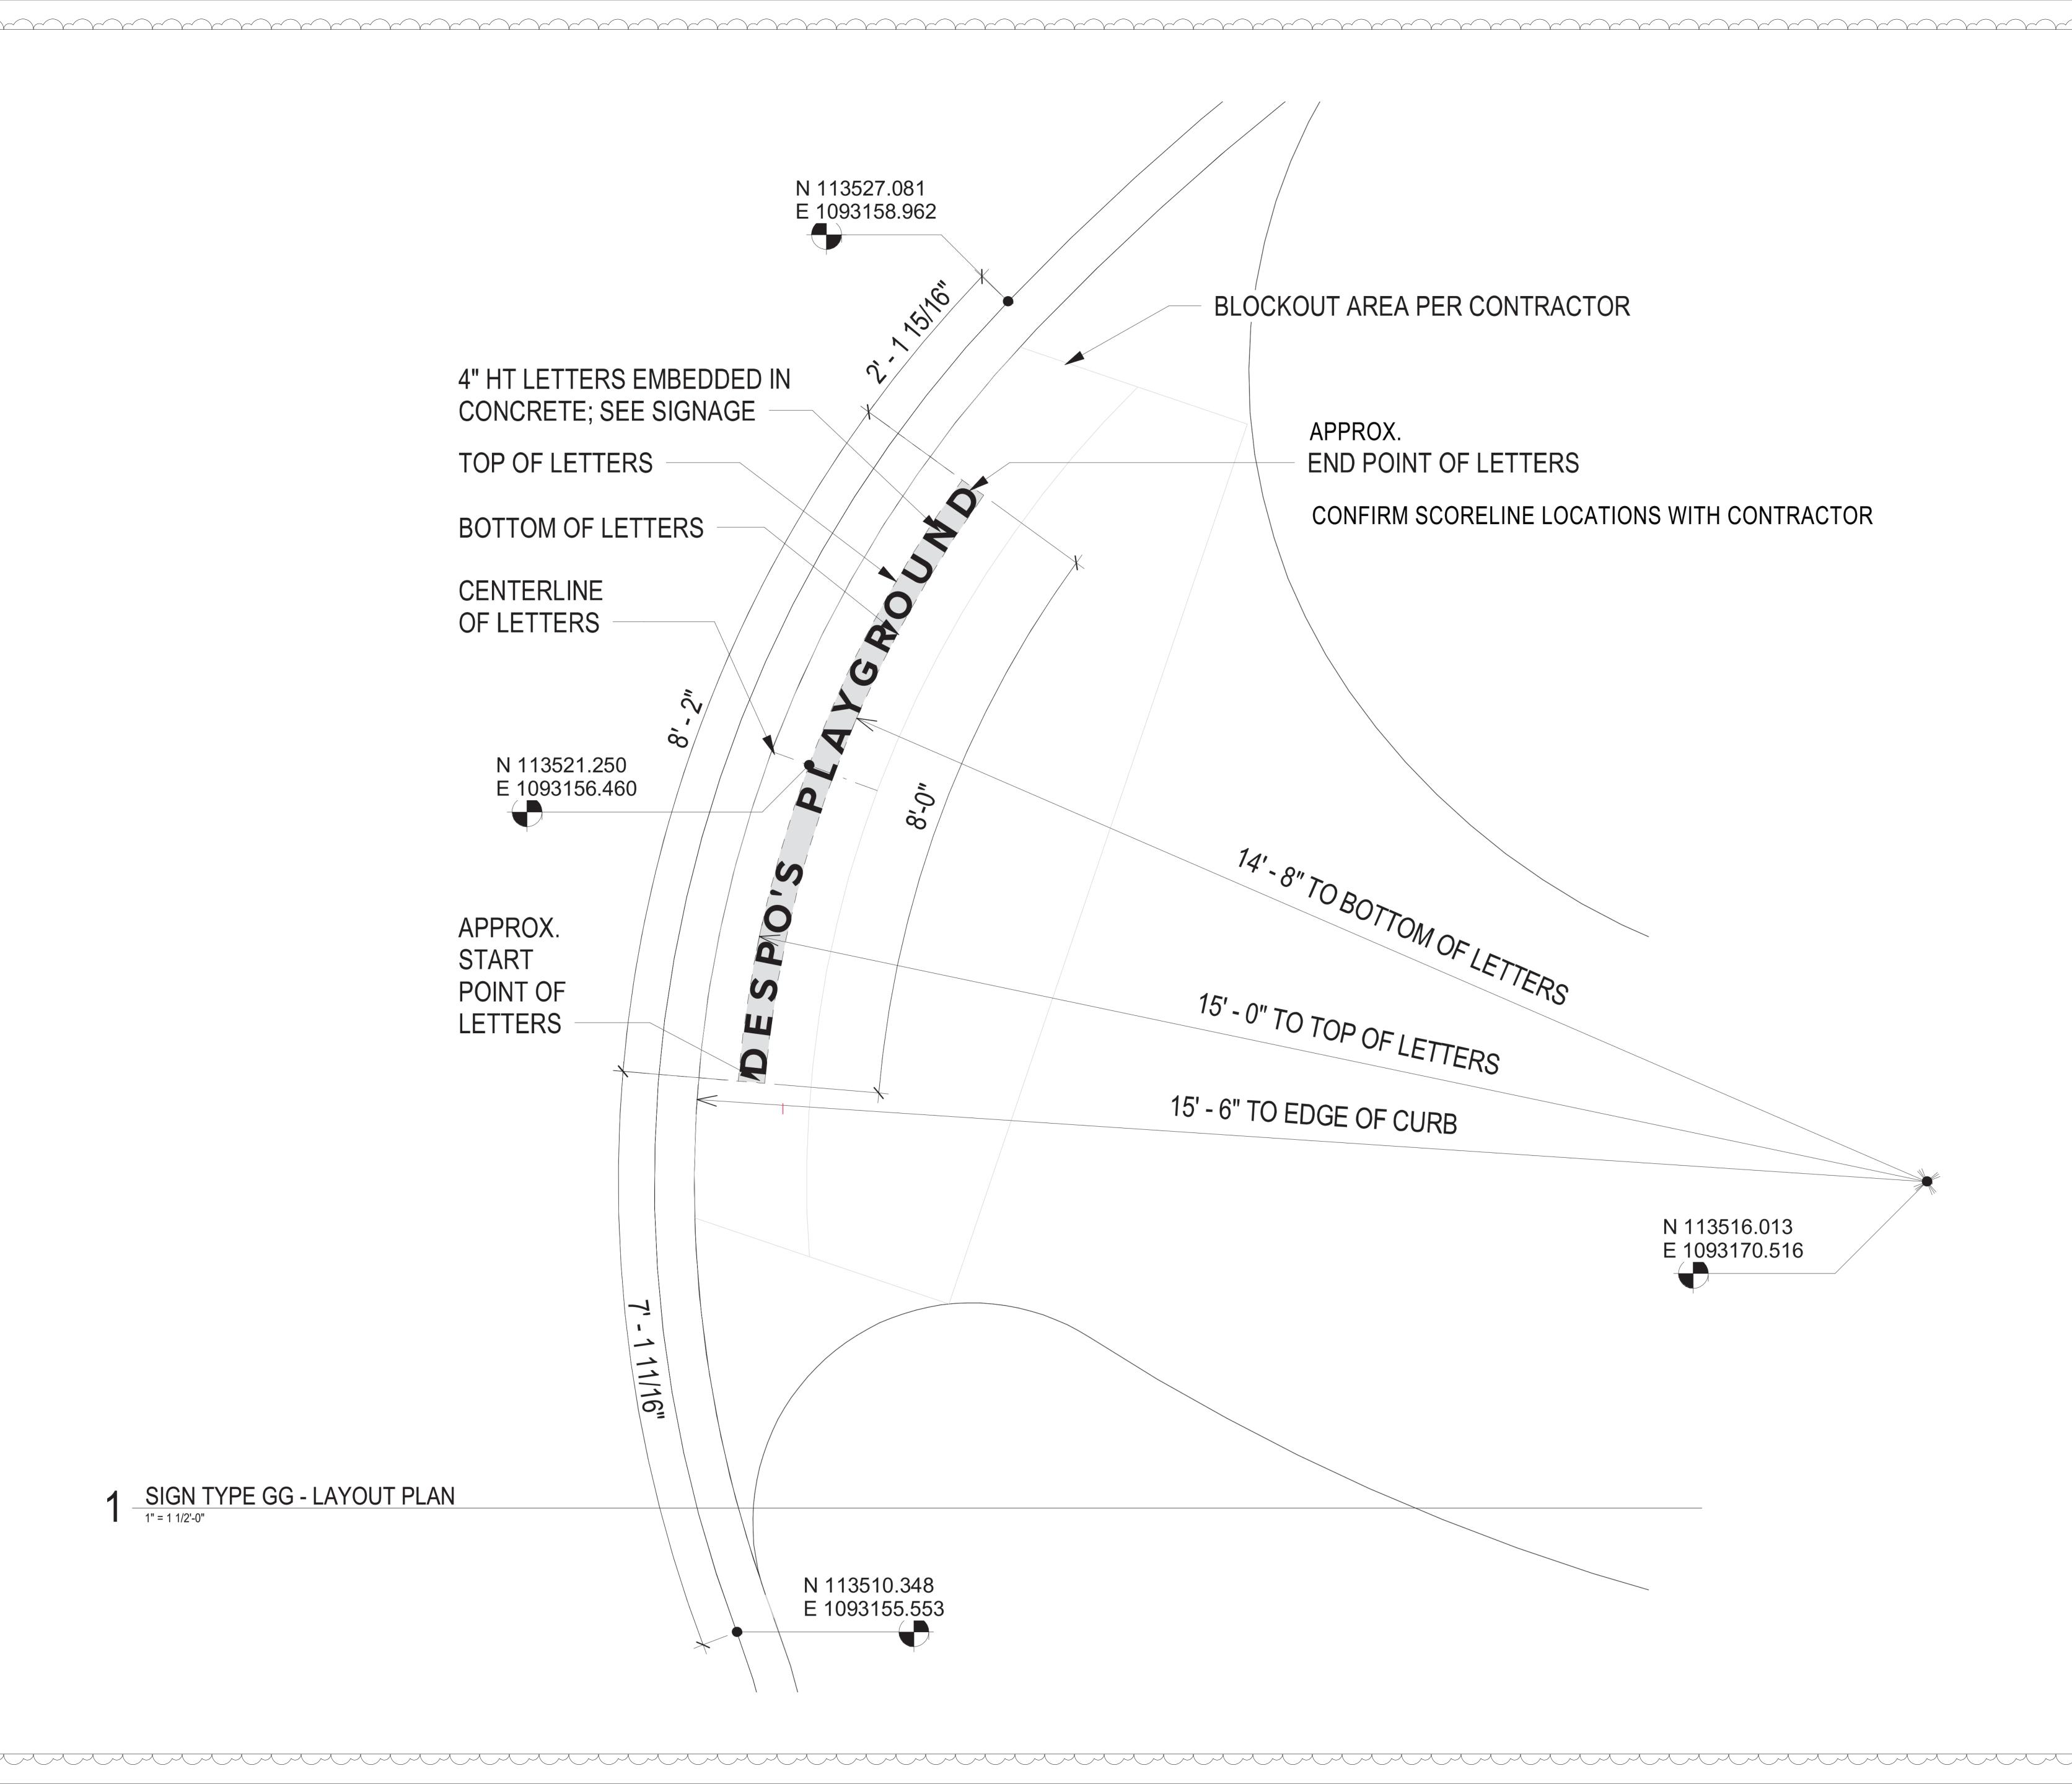



SEATTLE / Pier 56, 1201 Alaskan Way, #200 Seattle, WA 98101 / 206.623.3344

SAN FRANCISCO / 660 Market Street, #300 San Francisco, CA 94104 / 415.956.0688

LOS ANGELES / 5837 Adams Blvd Culver City, CA 90232 / 323.937.2150

#### SKANSKA

PORTLAND / 1010 NW Flanders St, #500 Portland, OR 97209 / 503.382.0900 usa.skanska.com

Mayer/Reed

Mayer/Reed, Inc.

Mayer/Reed, Inc. 319 SW Washington St. Suite 820 Portland, Oregon 97204 503.223.5953

PROJECT
CDHY - ACADEMIC &
PHYSICAL EDUCATION
BUILDING

LOCATION
611 GRAND BLVD
VANCOUVER, WA 98661

PREPARED FOR
CENTER FOR DEAF AND
HARD OF HEARING
YOUTH (CDHY)

DES PROJECT NO. 2018-713



KEYMAP

NO. DATE

4 04/09/2024

DESIGN PARTNER

PROJECT MANAGER

JL

PROJECT ARCHITECT

CH

PROJECT DESIGNER


JW
PROJECT TEAM MEMBERS
SK, SB, KK
CHECK
KB

ARCHITECT SEAL

SIGN DETAILS 8

2122 DATE 03/0


SHEET NUMBER SHEET

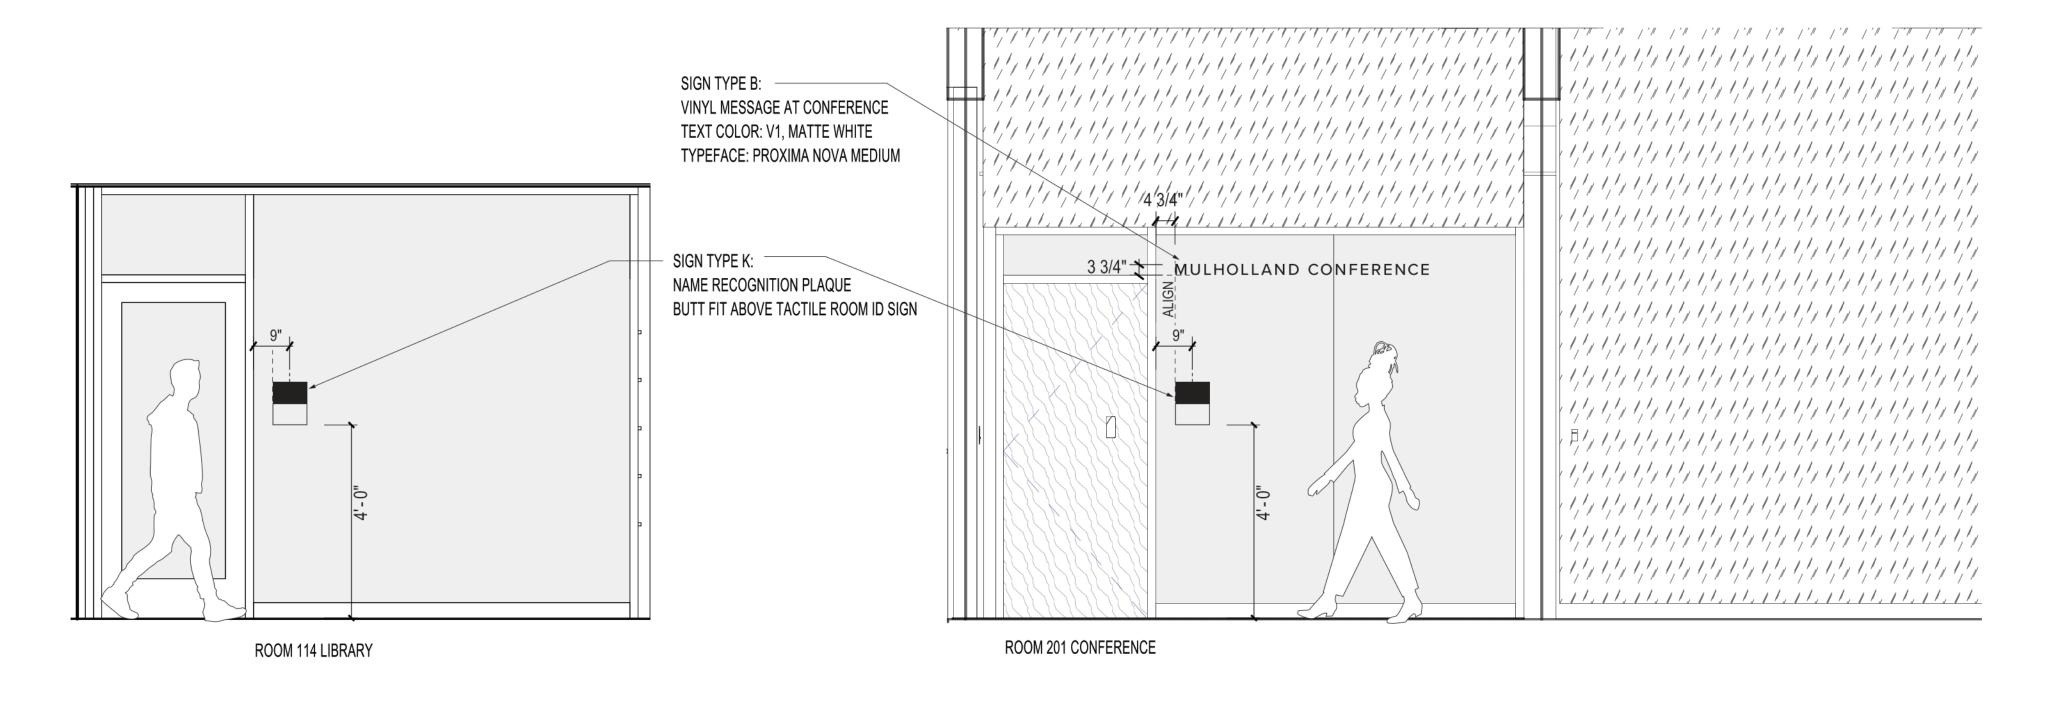

1 SIGN TYPES K, B: MOUNTING CONDITIONS


## TYPEFACE: PROXIMA NOVA MEDIUM LETTRSPACE AROUND JOINT AS SHOWN

3 SIGN TYPE B: VINYL MESSAGE - LAYOUT

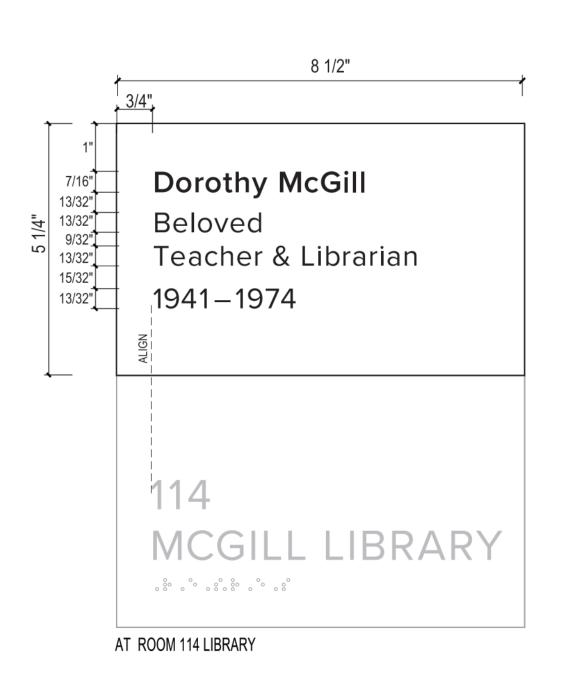

Jane Mulholland, the first female superintendent of WSD, is responsible for establishing the ASL-English bilingual instructional approach used in our classrooms.

A strong advocate and ally, Jane was a much-loved superintendent leading our school from 2009-2016.

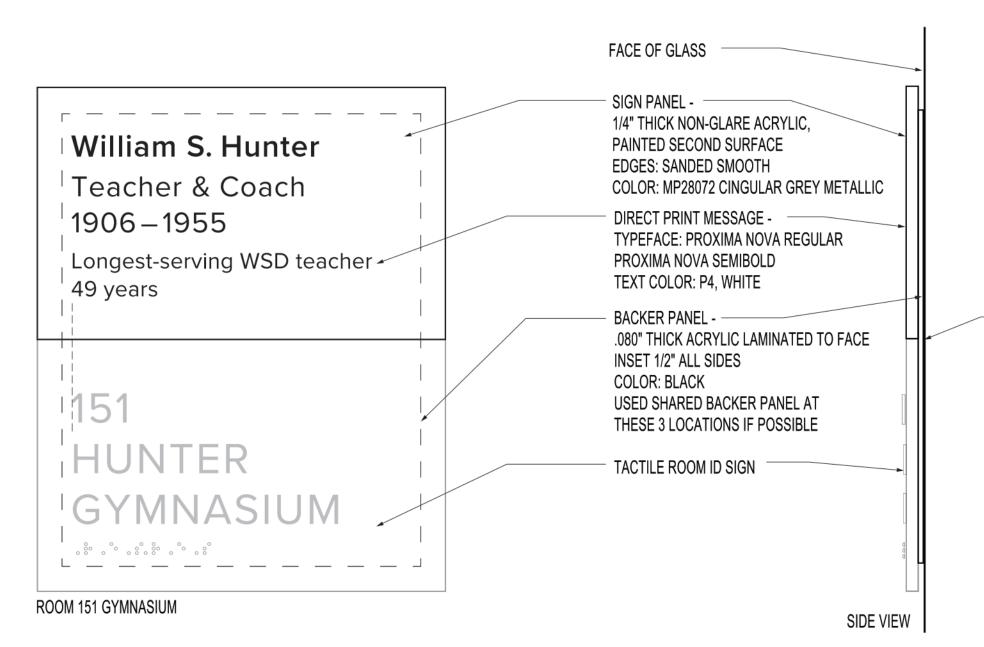


TYPE B: VINYL MESSAGE AT CONFERENCE


TEXT COLOR: V1, MATTE WHITE

BUTT FIT TO
TACTILE ROOM ID SIGN
USED SHARED BACKER PANEL AT
THESE 3 LOCATIONS IF POSSIBLE
ADD MATCHING VINYL BACKER
ON SECOND SURFACE OF GLASS
TO HIDE MOUNTING ADHESIVE

SIGN TYPE K: NAME RECOGNITION PLAQUE LAYOUTS

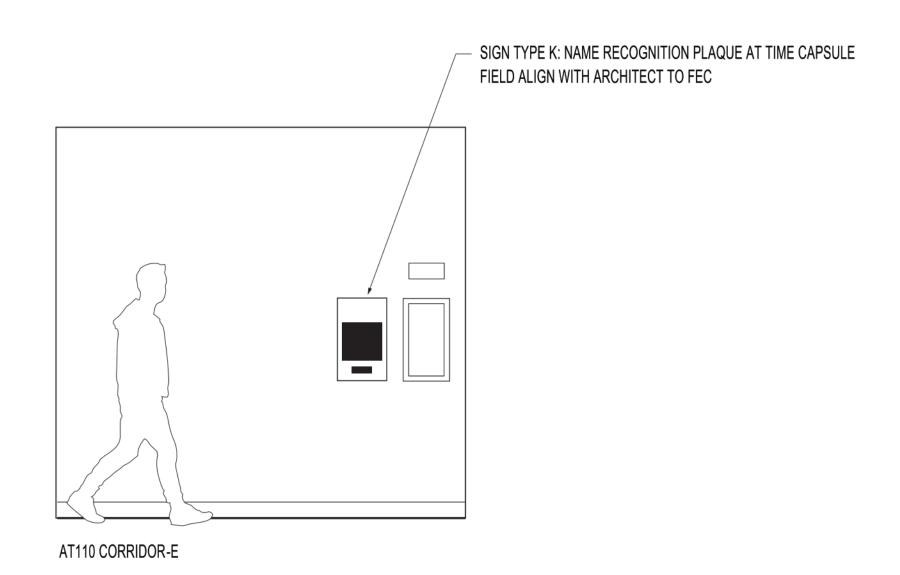

## 2 SIGN TYPE K - TIME CAPSULE

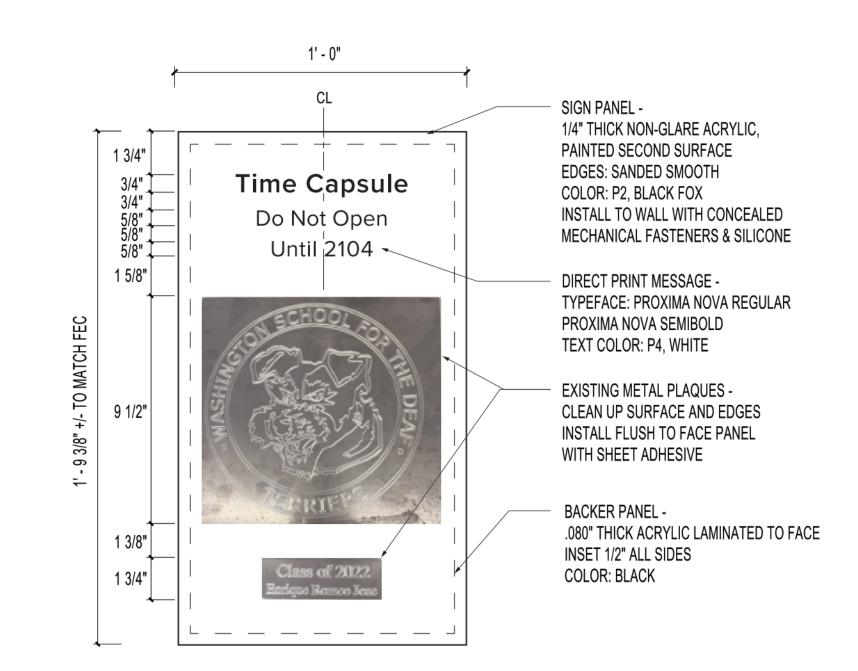

4 SIGN TYPE K: TIME CAPSULE LAYOUT

SEATTLE / Pier 56, 1201 Alaskan Way, #200
Seattle, WA 98101 / 206.623.3344

SAN FRANCISCO / 660 Market Street, #300
San Francisco, CA 94104 / 415.956.0688

LOS ANGELES / 5837 Adams Blvd
Culver City, CA 90232 / 323.937.2150

mithun.com

SKANSKA SANSELA SA

Mayer/Reed

319 SW Washington St

Portland, Oregon 97204

CDHY - ACADEMIC & PHYSICAL EDUCATION

Mayer/Reed, Inc.

503.223.5953

PROJECT

BUILDING

LOCATION

611 GRAND BLVD

PREPARED FOR

HARD OF HEARING YOUTH (CDHY)

2018-713

5 04/26/2024

PROJECT MANAGER

PROJECT ARCHITECT

PROJECT DESIGNER

PROJECT TEAM MEMBERS

SK, SB, KK

VANCOUVER, WA 98661


CENTER FOR DEAF AND

SIGN DETAILS 9

2122700 DATE 04/26/2024


SG5.09

PROPOSAL REQUEST #

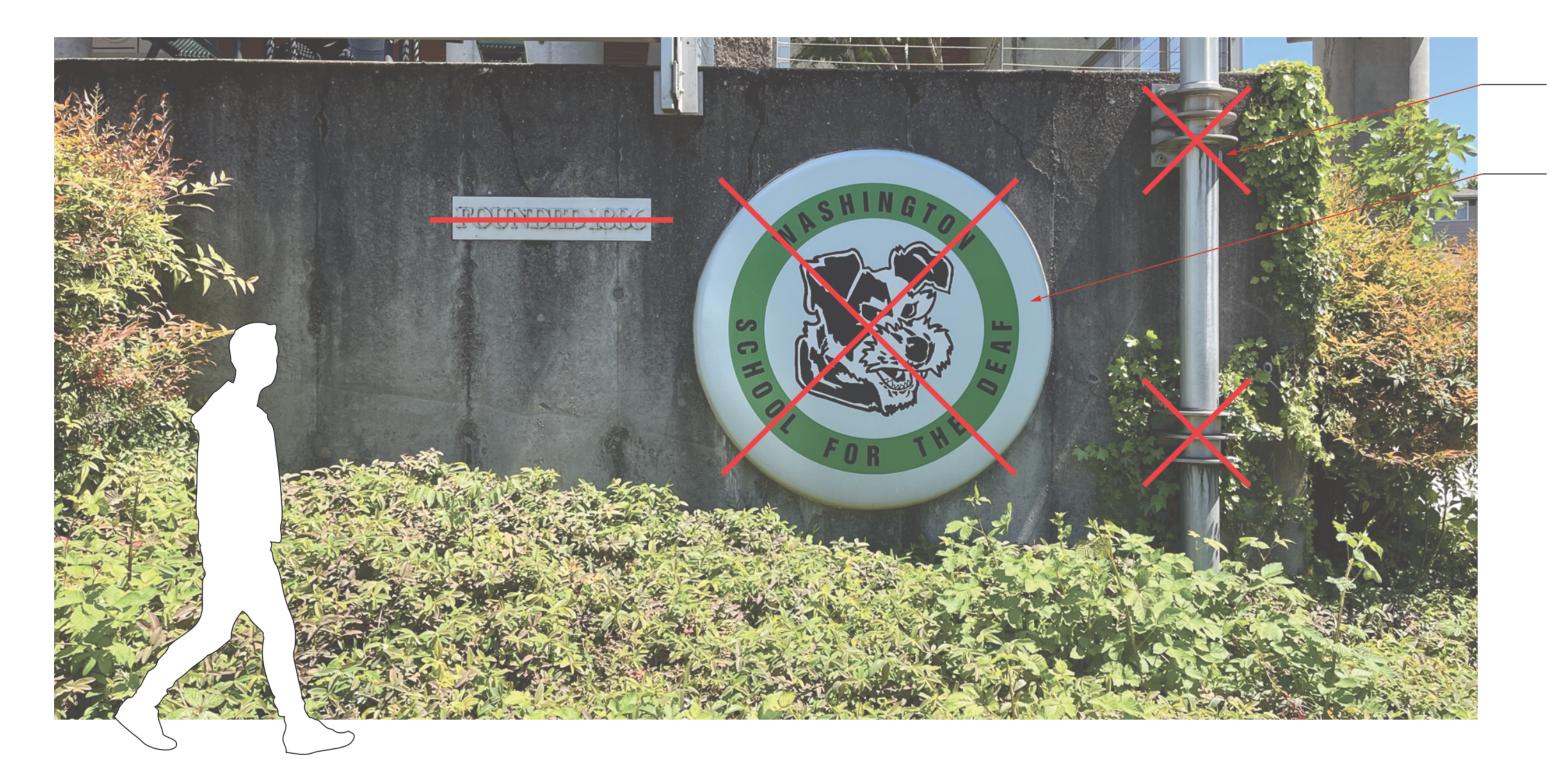

REMOVE EXISTING FLAGPOLE, BRACKETS AND HARDWARE PATCH HOLES FROM ANCHORS; MATCH EXISTING CONCRETE

REMOVE EXISTING SCHOOL MEDALLION & "FOUNDED 1886" SIGN SALVAGE AND PROVIDE TO OWNER PATCH HOLES FROM ANCHORS; MATCH EXISTING CONCRETE

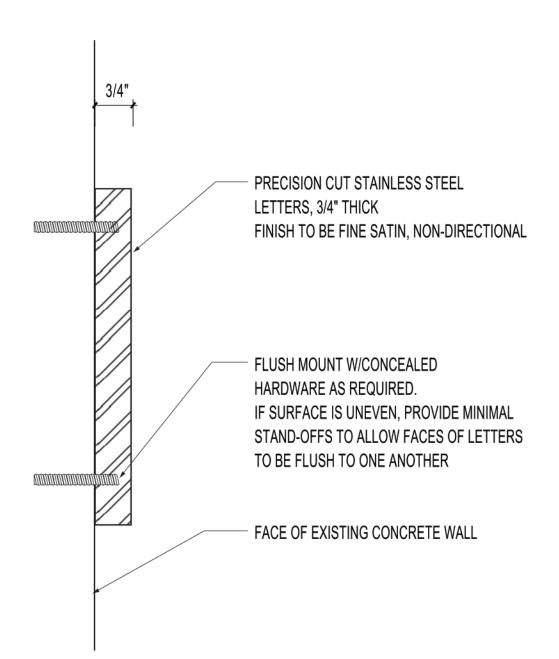

EXISTING CONDITIONS - ELEVATION AT ADMIN WALL

2 SIGN TYPE A - SECTION AT ADMIN WALL



FLUSH MOUNTED TO FACE OF CONCRETE WALL WITH CONCEALED HARDWARE

MITHUN **SEATTLE** / Pier 56, 1201 Alaskan Way, #200 Seattle, WA 98101 / 206.623.3344 SAN FRANCISCO / 660 Market Street, #300 San Francisco, CA 94104 / 415.956.0688 LOS ANGELES / 5837 Adams Blvd

SKANSKA

Culver City, CA 90232 / 323.937.2150

Portland, OR 97209 / 503.382.0900

Mayer/Reed

319 SW Washington St. Portland, Oregon 97204

503.223.5953

CDHY - ACADEMIC & PHYSICAL EDUCATION **BUILDING** 

611 GRAND BLVD VANCOUVER, WA 98661 PREPARED FOR

**CENTER FOR DEAF AND** HARD OF HEARING YOUTH (CDHY)



**SIGNM DETAILS 10** 



SIGN A-006: BUILDING ID - ELEVATION AT ADMIN WALL



FIELD VERIFY FINAL MOUNTING LOCATION WITH ARCHITECT BEFORE INSTALLATION ADJUSTMENTS MAY BE NECESSARY BASED ON PATCHES OR VISIBLE DISCOLORATIONS ON EXISTING WALL

INTENT IS FOR LETTERING TO STAY CLOSER TO TOP, RIGHT EDGE, BUT CONCERNED WALL DISCOLORATIONS MAY INTERFERE WITH LEGIBILITY

SIGN A-006: BUILDING ID - VIEW AT ADMIN WALL

# CDHY ADMINISTRATION

ESTABLISHED 1886

SIGN A-006: BUILDING ID - ELEVATION AT ADMIN WALL

MITHUN

Seattle, WA 98101 / 206.623.3344 SAN FRANCISCO / 660 Market Street, #300 San Francisco, CA 94104 / 415.956.0688 LOS ANGELES / 5837 Adams Blvd Culver City, CA 90232 / 323.937.2150

#### **SKANSKA**

Portland, OR 97209 / 503.382.0900 usa.skanska.com

Mayer/Reed

Mayer/Reed, Inc. 319 SW Washington St. Portland, Oregon 97204

503.223.5953

CDHY - ACADEMIC & PHYSICAL EDUCATION **BUILDING** 

611 GRAND BLVD VANCOUVER, WA 98661

PREPARED FOR CENTER FOR DEAF AND HARD OF HEARING YOUTH (CDHY)



**SIGNM DETAILS 11** 



	Number		Building Level	Comments
A	001	A: 3107, Washington School for the Deaf, Home of the Terriers,1886	SITE LEVEL 01	
		B: 3107, Washington School for the Deaf,		
В	001	Home of the Terriers, 1886  [ARROW RIGHT] Main Entry, Drop-off	SITE LEVEL 01	
С	001	[ARROW LEFT] Additional Parking  A:	SITE LEVEL 01	
		Washington School for the Deaf Main Entry [ARROW RIGHT]		
		B: Washington School for the Deaf [ARROW LEFT] Main Entry		
С	002	(ORIENTATION MAP) [ARROW UP] Cottages	SITE LEVEL 01	
		[ARROW OF ] Collages [ARROW RIGHT] Main Entry, Lloyd Auditorium		
С	003	[ARROW UP] Divine Academic [ARROW RIGHT] Lloyd Auditorium,	SITE LEVEL 01	
С	004	Clarke Hall (ORIENTATION MAP)	SITE LEVEL 01	
C	005	A: [ARROW UP] Cottages	SITE LEVEL 01	
		B: [ARROW UP] Main Entry, Hunter Gym		
С	006	[ARROW LEFT] Divine Academic [ARROW RIGHT] Kastel (TBD)	SITE LEVEL 01	
	101	WASHINGTON SCHOOL FOR THE DEAF Divine Academic	ACADEMIC - LEVEL 1	
	150 101	HUNTER GYMNASIUM DIVINE ACADEMIC	PE - LEVEL 1 ACADEMIC - LEVEL 1	
	101	(ENTRY RESTRICTIONS)  DIVINE ACADEMIC	ACADEMIC - LEVEL 1	ON GLASS
	102	(ENTRY RESTRICTIONS)  Please Check-In at Reception	ACADEMIC - LEVEL 1	ON GLASS
	104 105	Please Check-In at Reception (TBD)	ACADEMIC - LEVEL 1  ACADEMIC - LEVEL 1	ON GLASS ON GLASS. VERIFY IF NEEDED.
	106	DIVINE ACADEMIC (ENTRY RESTRICTIONS)	ACADEMIC - LEVEL 1	ON GLASS. VERILY II NEEDED.
<b>,</b>	107	DIVINE ACADEMIC (ENTRY RESTRICTIONS)	ACADEMIC - LEVEL 1	ON GLASS
}	150	HUNTER GYMNASIUM (ENTRY RESTRICTIONS)	PE - LEVEL 1	ON GLASS
}	151	HUNTER GYMNASIUM (ENTRY RESTRICTIONS)	PE - LEVEL 1	ON GLASS
}	152	HUNTER GYMNASIUM (ENTRY RESTRICTIONS)	PE - LEVEL 1	ON GLASS
	153	HUNTER GYMNASIUM (ENTRY RESTRICTIONS)	PE - LEVEL 1	ON GLASS
	101	102D VIDEO PHONE	ACADEMIC - LEVEL 1	
	102	102E ELECTRICAL	ACADEMIC - LEVEL 1	
	103	114 McGILL LIBRARY	ACADEMIC - LEVEL 1	ON GLASS. VERIFY ROOM NAN
	104	108B WORKROOM	ACADEMIC - LEVEL 1	ON GLASS
	105	108BA IDF	ACADEMIC - LEVEL 1	
· ·	106	114 LIBRARY	ACADEMIC - LEVEL 1	ON GLASS
į	107	120 PLUMBING ENTRY & FIRE RISER	ACADEMIC - LEVEL 1	USE EXTERIOR GRADE MATERIALS
<b>L</b>	108	120B ELECTRICAL	ACADEMIC - LEVEL 1	
	109	130F CUSTODIAL	ACADEMIC - LEVEL 1	
	150	151 GYMNASIUM	PE - LEVEL 1	VERIFY ROOM NAME
	151	153 CUSTODIAL	PE - LEVEL 1	ON GLASS
	152	151 GYMNASIUM	PE - LEVEL 1	ON GLASS. VERIFY ROOM NAM
	153	162 ELECTRICAL	PE - LEVEL 1	
	154	162A IDF	PE - LEVEL 1	
	155	167 STORAGE	PE - LEVEL 1	VERIFY ROOM NAME.
	201	202A STORAGE	ACADEMIC - LEVEL 2	
	202	202A STORAGE 201	ACADEMIC - LEVEL 2  ACADEMIC - LEVEL 2	ON GLASS
	203	CONFERENCE 212	ACADEMIC - LEVEL 2	UN GLASS
	205	CUSTODIAL 212C	ACADEMIC - LEVEL 2	
	206	ELEVATOR CONTROL 212A	ACADEMIC - LEVEL 2	
	207	MDF ROOF	ACADEMIC - LEVEL 2	
	208	212B ELECTRICAL	ACADEMIC - LEVEL 2	
	209	223 PRINT ROOM	ACADEMIC - LEVEL 2	ON GLASS
	210	232A ELECTRICAL	ACADEMIC - LEVEL 2	
	211	239 STAFF LOUNGE	ACADEMIC - LEVEL 2	ON GLASS
	101	102 (NAME INSERT)	ACADEMIC - LEVEL 1	ON GLASS
	102	102 (NAME INSERT)	ACADEMIC - LEVEL 1	ON GLASS
	103	102A (NAME INSERT)	ACADEMIC - LEVEL 1	ON GLASS
	104	102B (NAME INSERT)	ACADEMIC - LEVEL 1	ON GLASS
	105	102C (NAME INSERT)	ACADEMIC - LEVEL 1	ON GLASS
	106	104 (NAME INSERT)	ACADEMIC - LEVEL 1	ON GLASS
	107	106 (NAME INSERT) 108	ACADEMIC - LEVEL 1  ACADEMIC - LEVEL 1	ON GLASS ON GLASS
	108	(NAME INSERT)	ACADEMIC - LEVEL 1  ACADEMIC - LEVEL 1	ON GLASS ON GLASS
	1109	(NAME INSERT)	ACADEMIC - LEVEL 1	ON GLASS ON GLASS
	110	(NAME INSERT)	VOVDEINIIO - FEACE	ON ULAUU

туре	e Numbe	r Message	Building Level	Comments
D	112	131	ACADEMIC - LEVEL 1	ON GLASS
D	113	(NAME INSERT)	ACADEMIC - LEVEL 1	ON GLASS
		(NAME INSERT)		
D	114	126A (NAME INSERT)	ACADEMIC - LEVEL 1	ON GLASS
D	115	132 (NAME INSERT)	ACADEMIC - LEVEL 1	ON GLASS
D	116	131A (NAME INSERT)	ACADEMIC - LEVEL 1	ON GLASS
D	117	133	ACADEMIC - LEVEL 1	ON GLASS
D	118	(NAME INSERT) 135	ACADEMIC - LEVEL 1	ON GLASS
D	119	(NAME INSERT)	ACADEMIC - LEVEL 1	ON GLASS
D	120	(NAME INSERT)	ACADEMIC - LEVEL 1	ON GLASS
		(NAME INSERT)		
D	121	136 (NAME INSERT)	ACADEMIC - LEVEL 1	ON GLASS
D	150	161 (NAME INSERT)	PE - LEVEL 1	ON GLASS
D	201	202 (NAME INSERT)	ACADEMIC - LEVEL 2	ON GLASS
D	202	204	ACADEMIC - LEVEL 2	ON GLASS
D	203	(NAME INSERT) 206	ACADEMIC - LEVEL 2	ON GLASS
D	204	(NAME INSERT) 221	ACADEMIC - LEVEL 2	ON GLASS
		(NAME INSERT)		
D	205	222 (NAME INSERT)	ACADEMIC - LEVEL 2	ON GLASS
D	206	224 (NAME INSERT)	ACADEMIC - LEVEL 2	ON GLASS
D	207	226	ACADEMIC - LEVEL 2	ON GLASS
D	208	(NAME INSERT)  228B	ACADEMIC - LEVEL 2	ON GLASS
D	209	(NAME INSERT) 228A	ACADEMIC - LEVEL 2	ON GLASS
D	210	(NAME INSERT) 231	ACADEMIC - LEVEL 2	ON GLASS
		(NAME INSERT)		
D	211	232 (NAME INSERT)	ACADEMIC - LEVEL 2	ON GLASS
D	212	233 (NAME INSERT)	ACADEMIC - LEVEL 2	ON GLASS
D	213	235	ACADEMIC - LEVEL 2	ON GLASS
D	214	(NAME INSERT) 234	ACADEMIC - LEVEL 2	ON GLASS
D	215	(NAME INSERT) 237	ACADEMIC - LEVEL 2	ON GLASS
D	216	(NAME INSERT) 236	ACADEMIC - LEVEL 2	ON GLASS
		(NAME INSERT)		
E	101	[TOILET] [ADA] ACCESSIBLE STAFF	ACADEMIC - LEVEL 1	VERIFY IF STAFF RESTROOM
E	102	RESTROOM [TOILET] [ADA]	ACADEMIC - LEVEL 1	VERIFY IF STAFF RESTROOM
_		ACCESSIBLE RESTROOM		
E	103	[TOILET] [ADA]	ACADEMIC - LEVEL 1	
		ACCESSIBLE TOILET		
E	104	[TOILET] TOILET	ACADEMIC - LEVEL 1	
Е	105	[TOILET] TOILET	ACADEMIC - LEVEL 1	
E	106	[TOILET]	ACADEMIC - LEVEL 1	
E	107	TOILET [ADA]	ACADEMIC - LEVEL 1	
		ACCESSIBLE TOILET		
Е	150	[TOILET] [ADA] ACCESSIBLE	PE - LEVEL 1	
		RESTROOM		
E	151	[TOILET] [ADA] ACCESSIBLE	PE - LEVEL 1	
E	152	TOILET [TOILET]	PE - LEVEL 1	
		TOILET		
E	153	[TOILET] TOILET	PE - LEVEL 1	
E	154	[TOILET] TOILET	PE - LEVEL 1	
Е	155	[TOILET] TOILET	PE - LEVEL 1	
E	156	[TOILET]	PE - LEVEL 1	
E	157	TOILET [ADA]	PE - LEVEL 1	
E	158	TOILET [ADA]	PE - LEVEL 1	
-		ACCESSIBLE RESTROOM		
E	159	[WOMEN] [TOILET] [ADA] [SHOWER]	PE - LEVEL 1	INCLUDE ADDITIONAL INSER
		ACCESSIBLE WOMEN'S LOCKER ROOM		WINDOW. VERIFY ROOM DESIGNATION.
Е	160	[TOILET] [ADA] ACCESSIBLE	PE - LEVEL 1	
	101	RESTROOM	DE 1 F\/F1 4	
E	161	[SHOWER] [ADA] ACCESSIBLE SHOWER	PE - LEVEL 1	
E	162	[TOILET] [ADA] ACCESSIBLE	PE - LEVEL 1	
E	163	RESTROOM [TOILET] [ADA]	PE - LEVEL 1	
-		ACCESSIBLE RESTROOM		
E	164	[MEN] [TOILET] [ADA] [SHOWER]	PE - LEVEL 1	INCLUDE ADDITIONAL INSER
		ACCESSIBLE MEN'S LOCKER ROOM		WINDOW. VERIFY ROOM DESIGNATION.
Е	165	[TOILET] [ADA] ACCESSIBLE	PE - LEVEL 1	
Г	100	RESTROOM	DE LEVEL 4	
E	166	[SHOWER] [ADA] ACCESSIBLE SHOWER	PE - LEVEL 1	
E	201	[TOILET] [ADA] ACCESSIBLE	ACADEMIC - LEVEL 2	
E	202	RESTROOM	ACADEMIC - LEVEL 2	
Ľ	202	[TOILET] [ADA] ACCESSIBLE	AUADEIVIIO - LEVEL Z	
E	203	RESTROOM [TOILET] [ADA]	ACADEMIC - LEVEL 2	
		ACCESSIBLE RESTROOM		

	Number	ESSAGE SCHEDUL	Building Level	Comments
Type	Nullibel	INIESSAYE	Dulluling Level	Comments
E	205	[TOILET] [ADA] ACCESSIBLE STAFF RESTROOM	ACADEMIC - LEVEL 2	
F	101	A: [TOILET] B: [TOILET]	ACADEMIC - LEVEL 1	
F	102	A: [WATER FOUNTAIN] B: [WATER FOUNTAIN]	ACADEMIC - LEVEL 1	
F	103	A: [WATER FOUNTAIN] B: [WATER FOUNTAIN]	ACADEMIC - LEVEL 1	
F	150	A: [LOCKER] Locker Rooms B: [LOCKER] Locker Rooms	PE - LEVEL 1	
F	151	A: [WATER FOUNTAIN] B: [WATER FOUNTAIN]	PE - LEVEL 1	
F	201	A: [TOILET] B: [TOILET]	ACADEMIC - LEVEL 2	
F	202	A: [TOILET] B: [TOILET]	ACADEMIC - LEVEL 2	
G	101	(EVACUATION MAP)	ACADEMIC - LEVEL 1	
G	102	(EVACUATION MAP)	ACADEMIC - LEVEL 1	
G	103	(EVACUATION MAP)	ACADEMIC - LEVEL 1	
G	104	(EVACUATION MAP)	ACADEMIC - LEVEL 1	
G	105	(EVACUATION MAP)	ACADEMIC - LEVEL 1	
G	106	(EVACUATION MAP)	ACADEMIC - LEVEL 1	
G	107	(EVACUATION MAP)	ACADEMIC - LEVEL 1	
G	108	(EVACUATION MAP)	ACADEMIC - LEVEL 1	
G	109	(EVACUATION MAP)	ACADEMIC - LEVEL 1	
G	110	(EVACUATION MAP)	ACADEMIC - LEVEL 1	
G	201	(EVACUATION MAP)	ACADEMIC - LEVEL 2	
G	202	(EVACUATION MAP)	ACADEMIC - LEVEL 2	
G	203	(EVACUATION MAP)	ACADEMIC - LEVEL 2	
G	204	(EVACUATION MAP)	ACADEMIC - LEVEL 2	
G	205	(EVACUATION MAP)	ACADEMIC - LEVEL 2	
G	206	(EVACUATION MAP)	ACADEMIC - LEVEL 2	
G	207	(EVACUATION MAP)	ACADEMIC - LEVEL 2	
G	208	(EVACUATION MAP)	ACADEMIC - LEVEL 2	
G	209	(EVACUATION MAP)	ACADEMIC - LEVEL 2	
G	210	(EVACUATION MAP)	ACADEMIC - LEVEL 2	
G	211	(EVACUATION MAP)	ACADEMIC - LEVEL 2	
G	212	(EVACUATION MAP)	ACADEMIC - LEVEL 2	
	212			

ACADEMIC - LEVEL 2

ACADEMIC - LEVEL 1

PE - LEVEL 1

G 213 (EVACUATION MAP)

H 101 MAXIMUM OCCUPANCY 50

H 150 MAXIMUM OCCUPANCY 1007

[ ] = SYMBOL ( ) = NOTES

Type	Description
EXTER	IOR
AA	Campus ID, Freestanding
BB	Vehicular Directional
CC	Pedestrian Directional
INTERI	OR
Α	Building ID, Building Mounted
В	Vinyl Messages
С	Room ID, Fixed Message
D	Room ID, Changeable Message
Е	Room ID, Symbol
F	Amenity Flag
G	Evacuation Map
Н	Information Sign

**SEATTLE** / Pier 56, 1201 Alaskan Way, #200 Seattle, WA 98101 / 206.623.3344 **SAN FRANCISCO** / 660 Market Street, #300 San Francisco, CA 94104 / 415.956.0688 **LOS ANGELES** / 5837 Adams Blvd Culver City, CA 90232 / 323.937.2150

## **SKANSKA**

**PORTLAND** / 1010 NW Flanders St, #500 Portland, OR 97209 / 503.382.0900 usa.skanska.com

Mayer/Reed Mayer/Reed, Inc. 319 SW Washington St.

Suite 820 Portland, Oregon 97204 503.223.5953

PROJECT **CDHY - ACADEMIC &** PHYSICAL EDUCATION

**BUILDING** LOCATION 611 GRAND BLVD VANCOUVER, WA 98661

PREPARED FOR **CENTER FOR DEAF AND** HARD OF HEARING YOUTH (CDHY)



PROJECT ARCHITECT PROJECT DESIGNER PROJECT TEAM MEMBERS SK, SB, KK KB ARCHITECT SEAL

DESIGN PARTNER

PROJECT MANAGER

SIGN MESSAGE SCHEDULE

SHEET NUMBER SG10.01 © 2022 MITHUN, INC.