


CHILDREN'S HOSPITAL OF ORANGE COUNTY



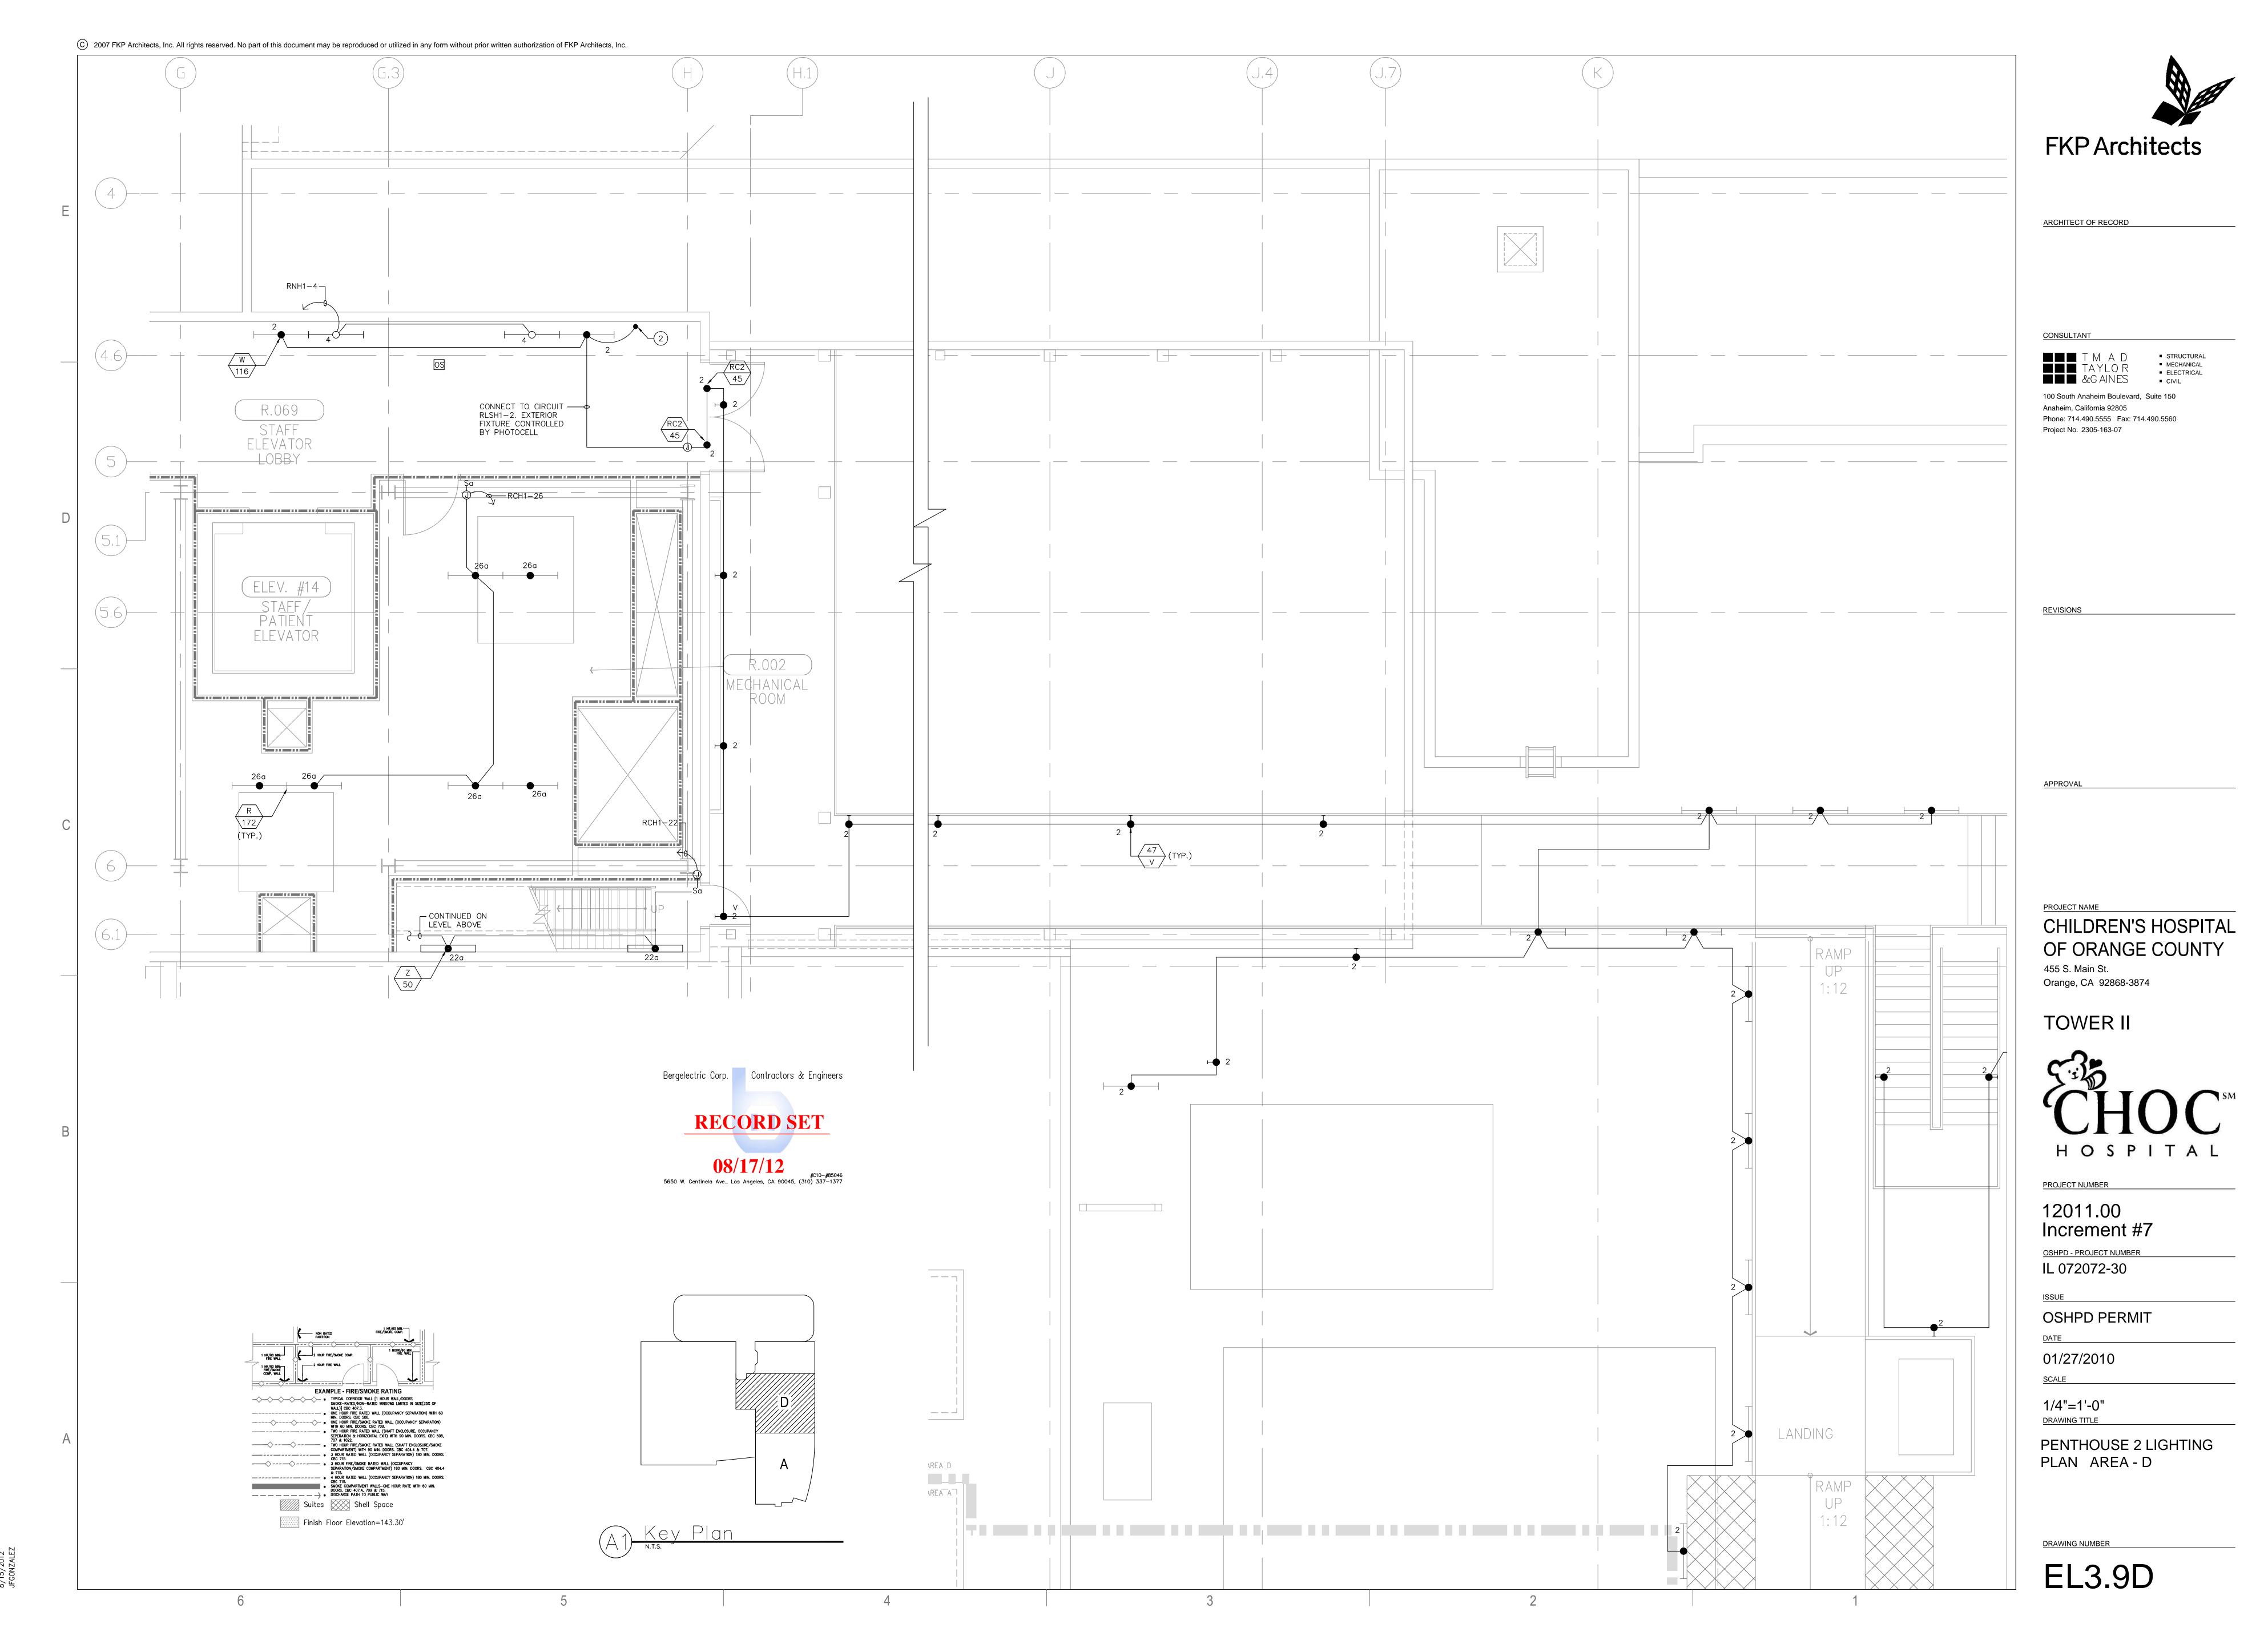

F. \FINU4EVIS\VIIOV 113/2\NEVONDS\EIGIIING\ELJ_3E