

FOR KEY NOTES REFER TO SHEET "EL3A"



ARCHITECT OF RECORD

CONSULTANT
T M A D
TAYLOR
& G AINES
• STRUCTURAL
• MECHANICAL
• ELECTRICAL
• CIVIL
100 South Anaheim Boulevard, Suite 150
Anaheim, California 92805
Phone: 714.490.5555 Fax: 714.490.5560
Project No. 2305-163-07

REVISIONS

APPROVAL

PROJECT NAME
CHILDREN'S HOSPITAL
OF ORANGE COUNTY
456 S. Main St.
Orange, CA 92868-3874






PROJECT NUMBER
12011.00
Increment #7
OSHPD - PROJECT NUMBER
IL 072072-30

ISSUE
OSHPD PERMIT
DATE
01/27/2010
SCALE
1/4" = 1' - 0"

DRAWING TITLE
PENTHOUSE 3 LIGHTING
PLAN AREA - H

DRAWING NUMBER

EL3.10H

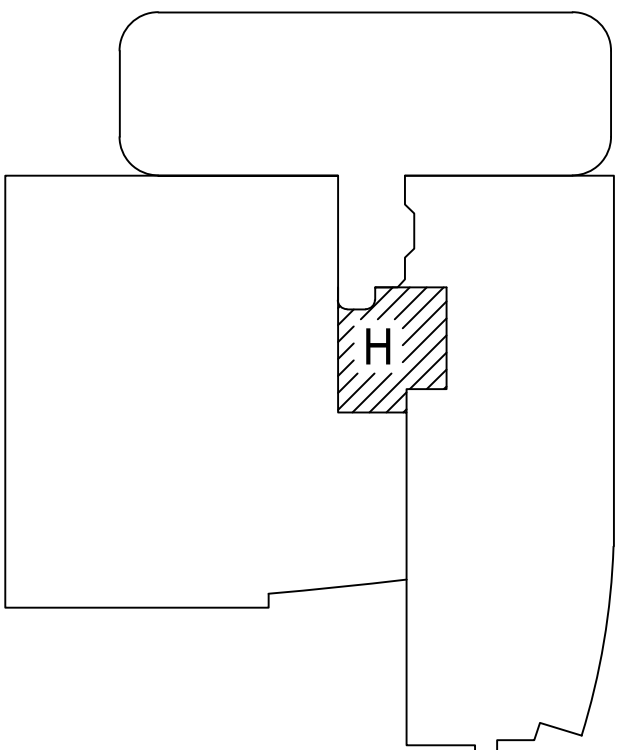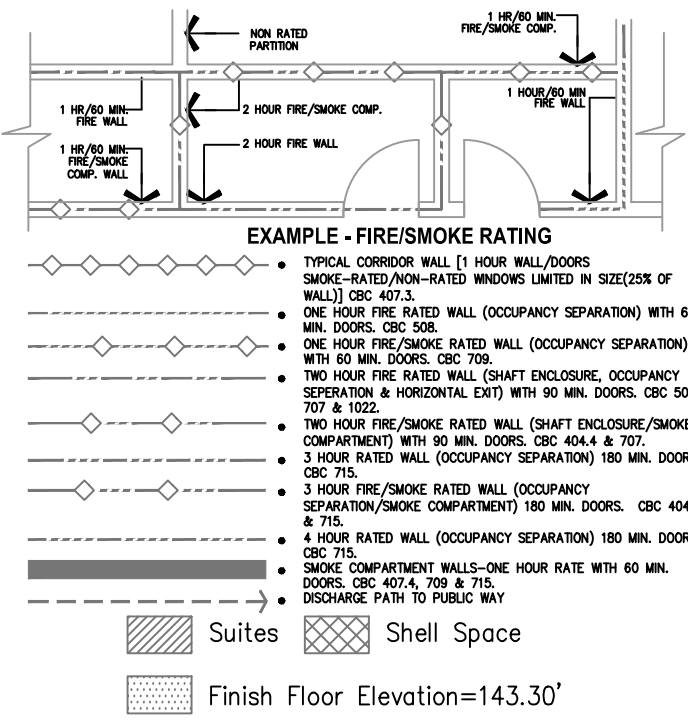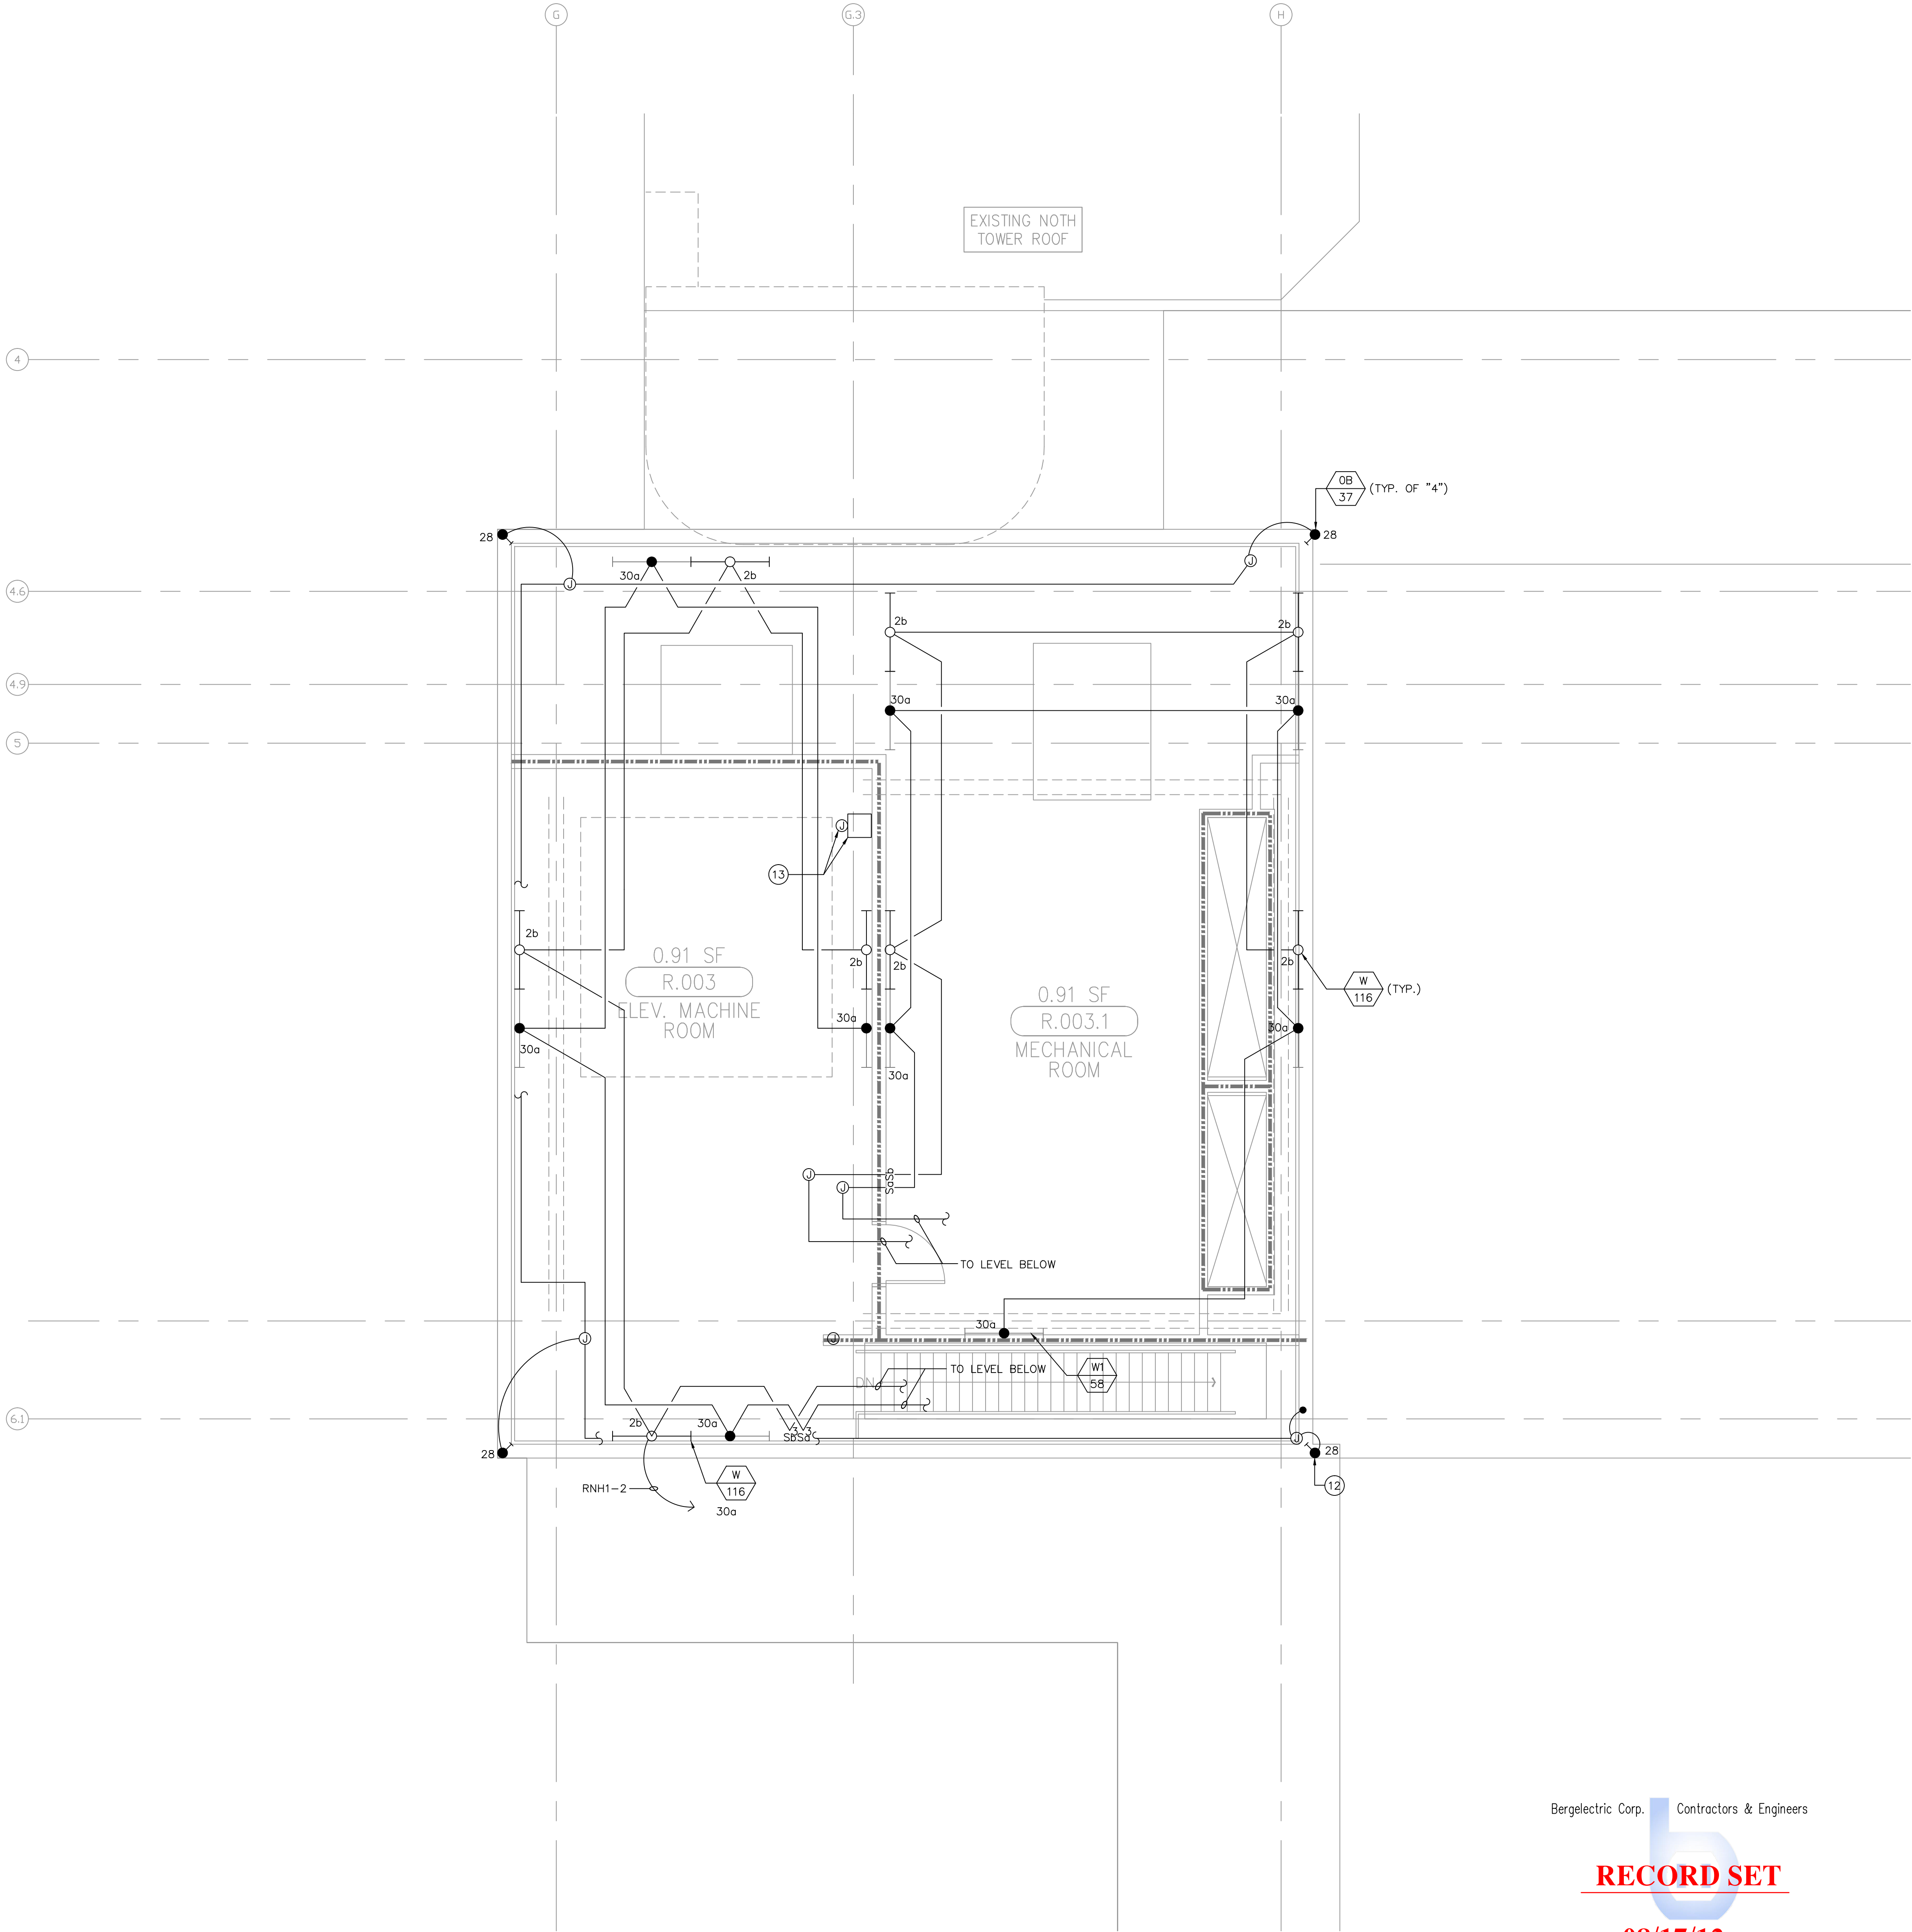

Bergelectric Corp. Contractors & Engineers

RECORD SET

08/17/12

5650 W. Centinela Ave., Los Angeles, CA 90045, (310) 337-1377

A1 Key Plan
N.T.S.