

FKP Architects

ARCHITECT OF RECORD

CONSULTANT

T M A D
TAYLOR
& G AINES
STRUCTURAL
MECHANICAL
ELECTRICAL
CIVIL
100 South Anaheim Boulevard, Suite 150
Anaheim, California 92805
Phone: 714.490.5555 Fax: 714.490.5560
Project No. 2305-163-07

REVISIONS

12/19/11 CHANGE ORDER #294

APPROVAL

PROJECT NAME

CHILDREN'S HOSPITAL
OF ORANGE COUNTY
455 S. Main St.
Orange, CA 92868-3874

TOWER II



PROJECT NUMBER

12011.00
Increment #7

OSHPD - PROJECT NUMBER

IL 072072-30

ISSUE

OSHPD PERMIT

DATE

01/27/2010

SCALE


1/4"=1'- 0"

DRAWING TITLE


LOWER LEVEL POWER
PLAN AREA - A

DRAWING NUMBER

EP3.0A

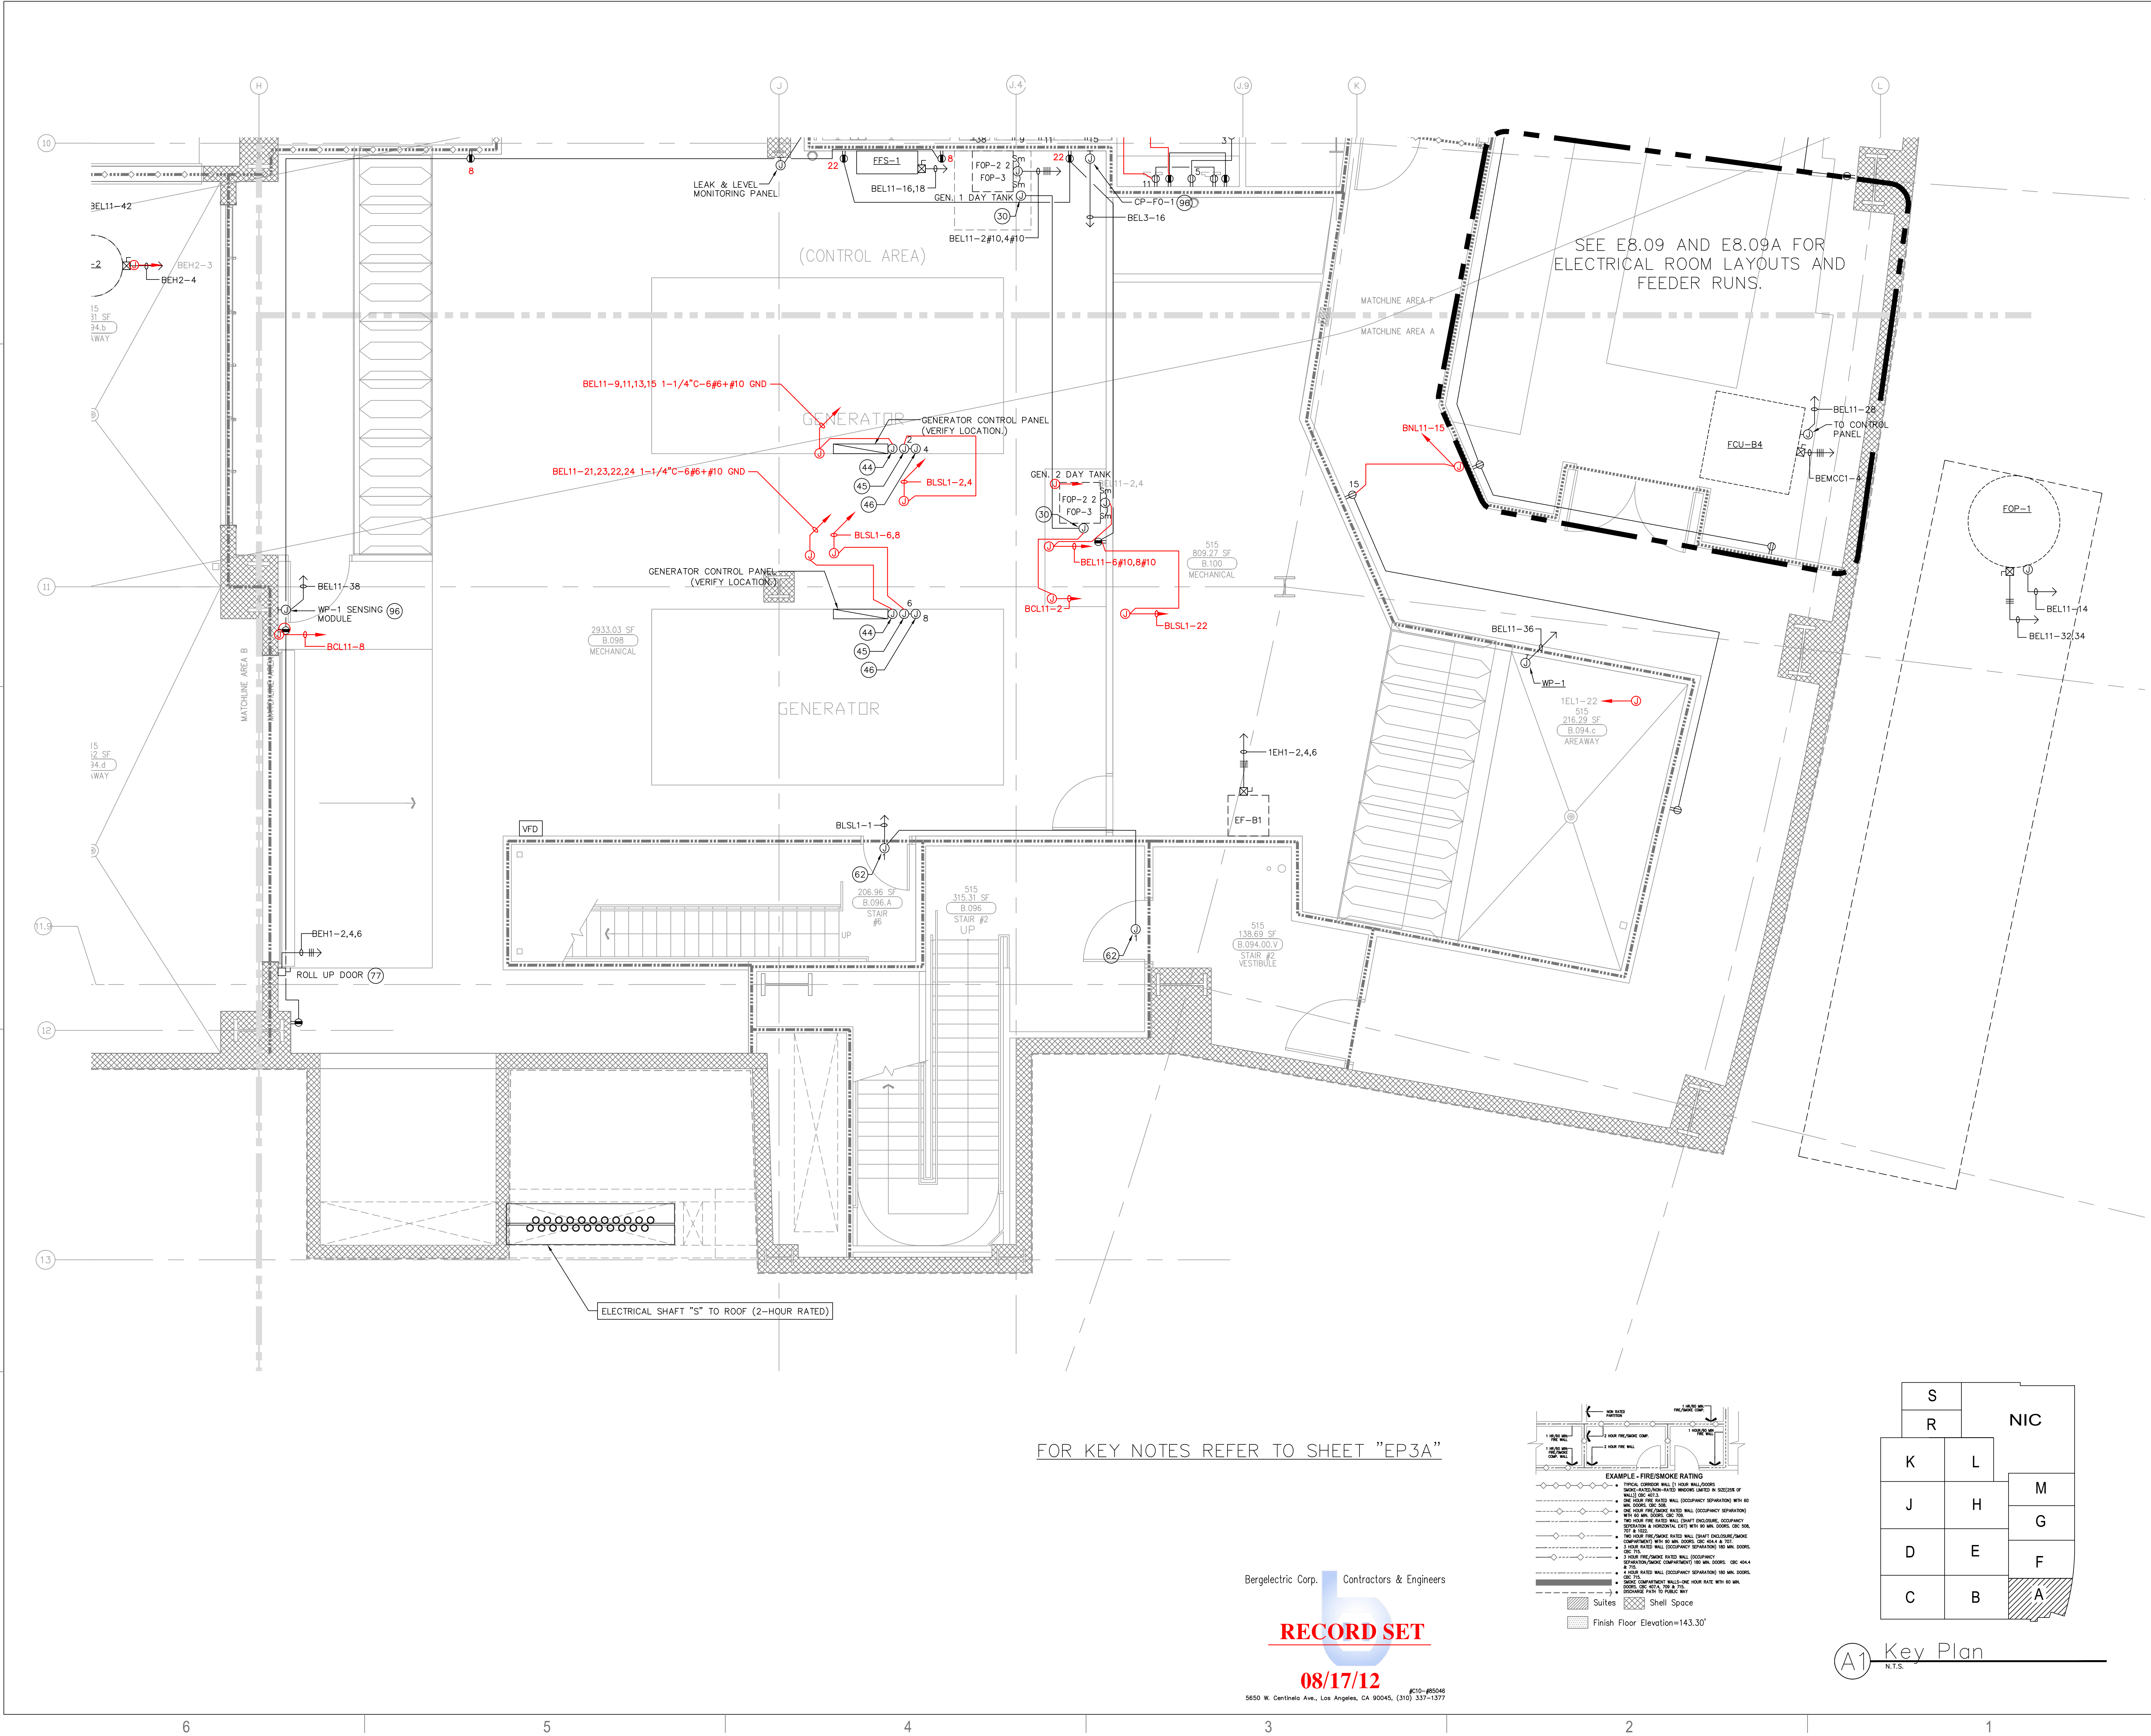

FOR KEY NOTES REFER TO SHEET "EP3A"

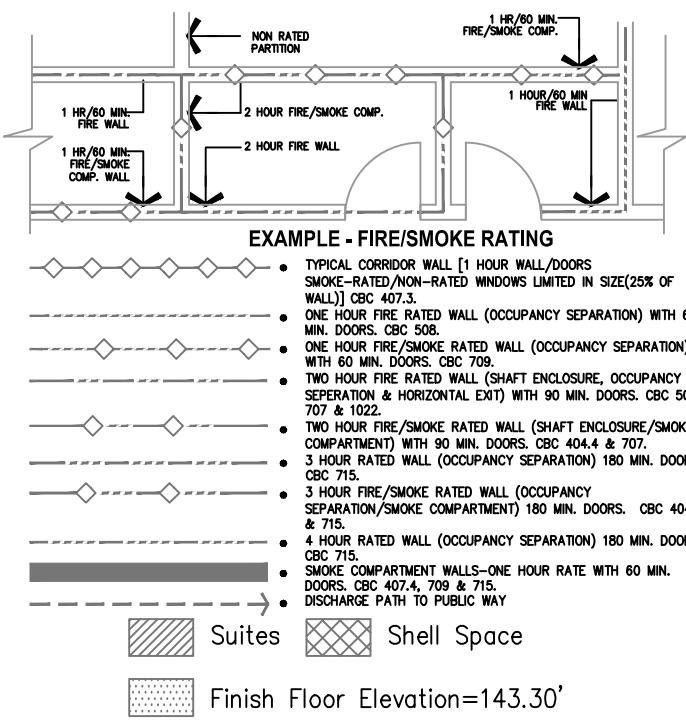

S		
R		NIC
K	L	
J	H	M
		G
D	E	F
C	B	A

A1 Key Plan
N.T.S.

Bergelectric Corp. Contractors & Engineers

RECORD SET

08/17/12

5650 W. Centinela Ave., Los Angeles, CA 90045, (310) 337-1377

ARCHITECT OF RECORD

CONSULTANT

T M A D
TAYLOR
& GAINES

- STRUCTURAL
- MECHANICAL
- ELECTRICAL
- CIVIL

100 South Anaheim Boulevard, Suite 150
Anaheim, California 92805
Phone: 714.490.5555 Fax: 714.490.5560
Project No. 2305-163-07

REVISIONS

397 12/19/11 CHANGE ORDER #29

APPROVAL

PROJECT NAME

**CHILDREN'S HOSPITAL
OF ORANGE COUNTY**
455 S. Main St.
Orange, CA 92868-3874

TOWER II



PROJECT NUMBER

12011.00
Increment #7

OSHPD - PROJECT NUMBER
IL 072072-30

ISSUE

OSHPD PERMIT

DATE _____

01/27/2010

SCALE



$$1/4'' = 1' - 0''$$

DRAWING TITLE

LOWER LEVEL POWER
PLAN AREA - C

DRAWING NUMBER

EP3.0C

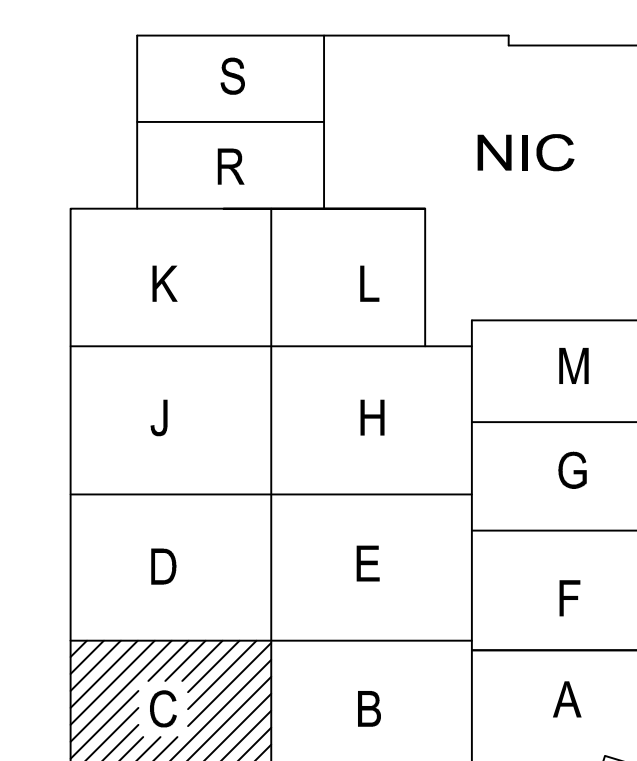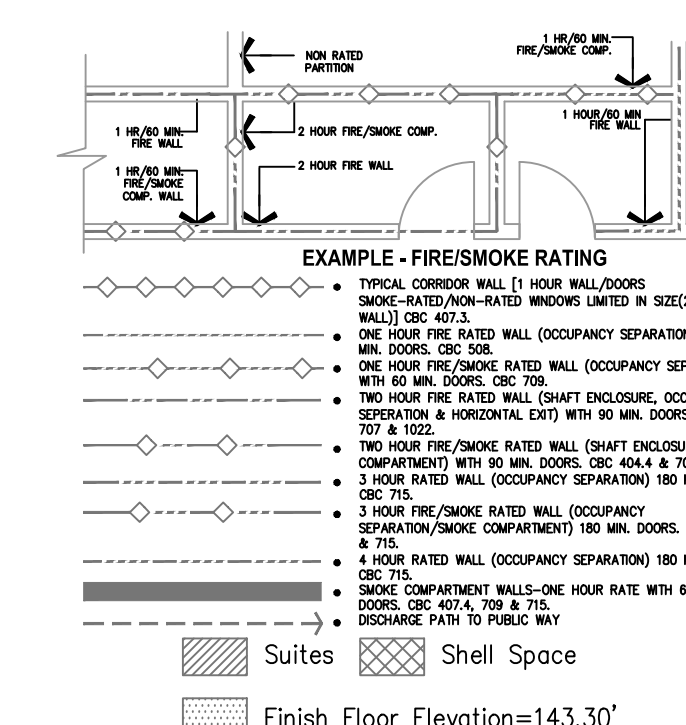

A1 Key Plan


FOR KEY NOTES REFER TO SHEET "EP3A"

Bergelectric Corp. Contractors & Engineers

RECORD SET

08/17/12

5650 W. Centinela Ave., Los Angeles, CA 90045, (310) 337-1377

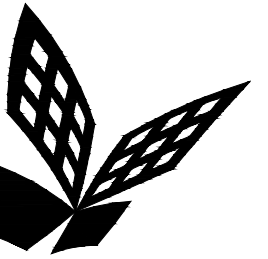

FKP Architects

ARCHITECT OF RECORD

CONSULTANT

T M A D
TAYLOR
& G AINES

STRUCTURAL
MECHANICAL
ELECTRICAL
CIVIL

100 South Anaheim Boulevard, Suite 150
Anaheim, California 92805
Phone: 714.490.5555 Fax: 714.490.5560
Project No. 2305-163-07

REVISIONS

REVISIONS	DATE	DESCRIPTION
73	02/05/10	INFORMATION BULLETIN #5
74	07/12/10	CHANGE ORDER #64
75	03/08/11	CHANGE ORDER #130
76	03/28/11	CHANGE ORDER #156
77	08/22/11	CHANGE ORDER #234
78	12/19/11	CHANGE ORDER #294
79	12/22/11	CHANGE ORDER #295

APPROVAL

PROJECT NAME

CHILDREN'S HOSPITAL
OF ORANGE COUNTY
455 S. Main St.
Orange, CA 92668-3874

TOWER II



PROJECT NUMBER

12011.00
Increment #7

OSHPD - PROJECT NUMBER
IL 072072-30

ISSUE

OSHPD PERMIT

DATE

01/27/2010

SCALE


1/4"=1'-0"

DRAWING TITLE



LOWER LEVEL POWER
PLAN AREA - D

DRAWING NUMBER

EP3.0D

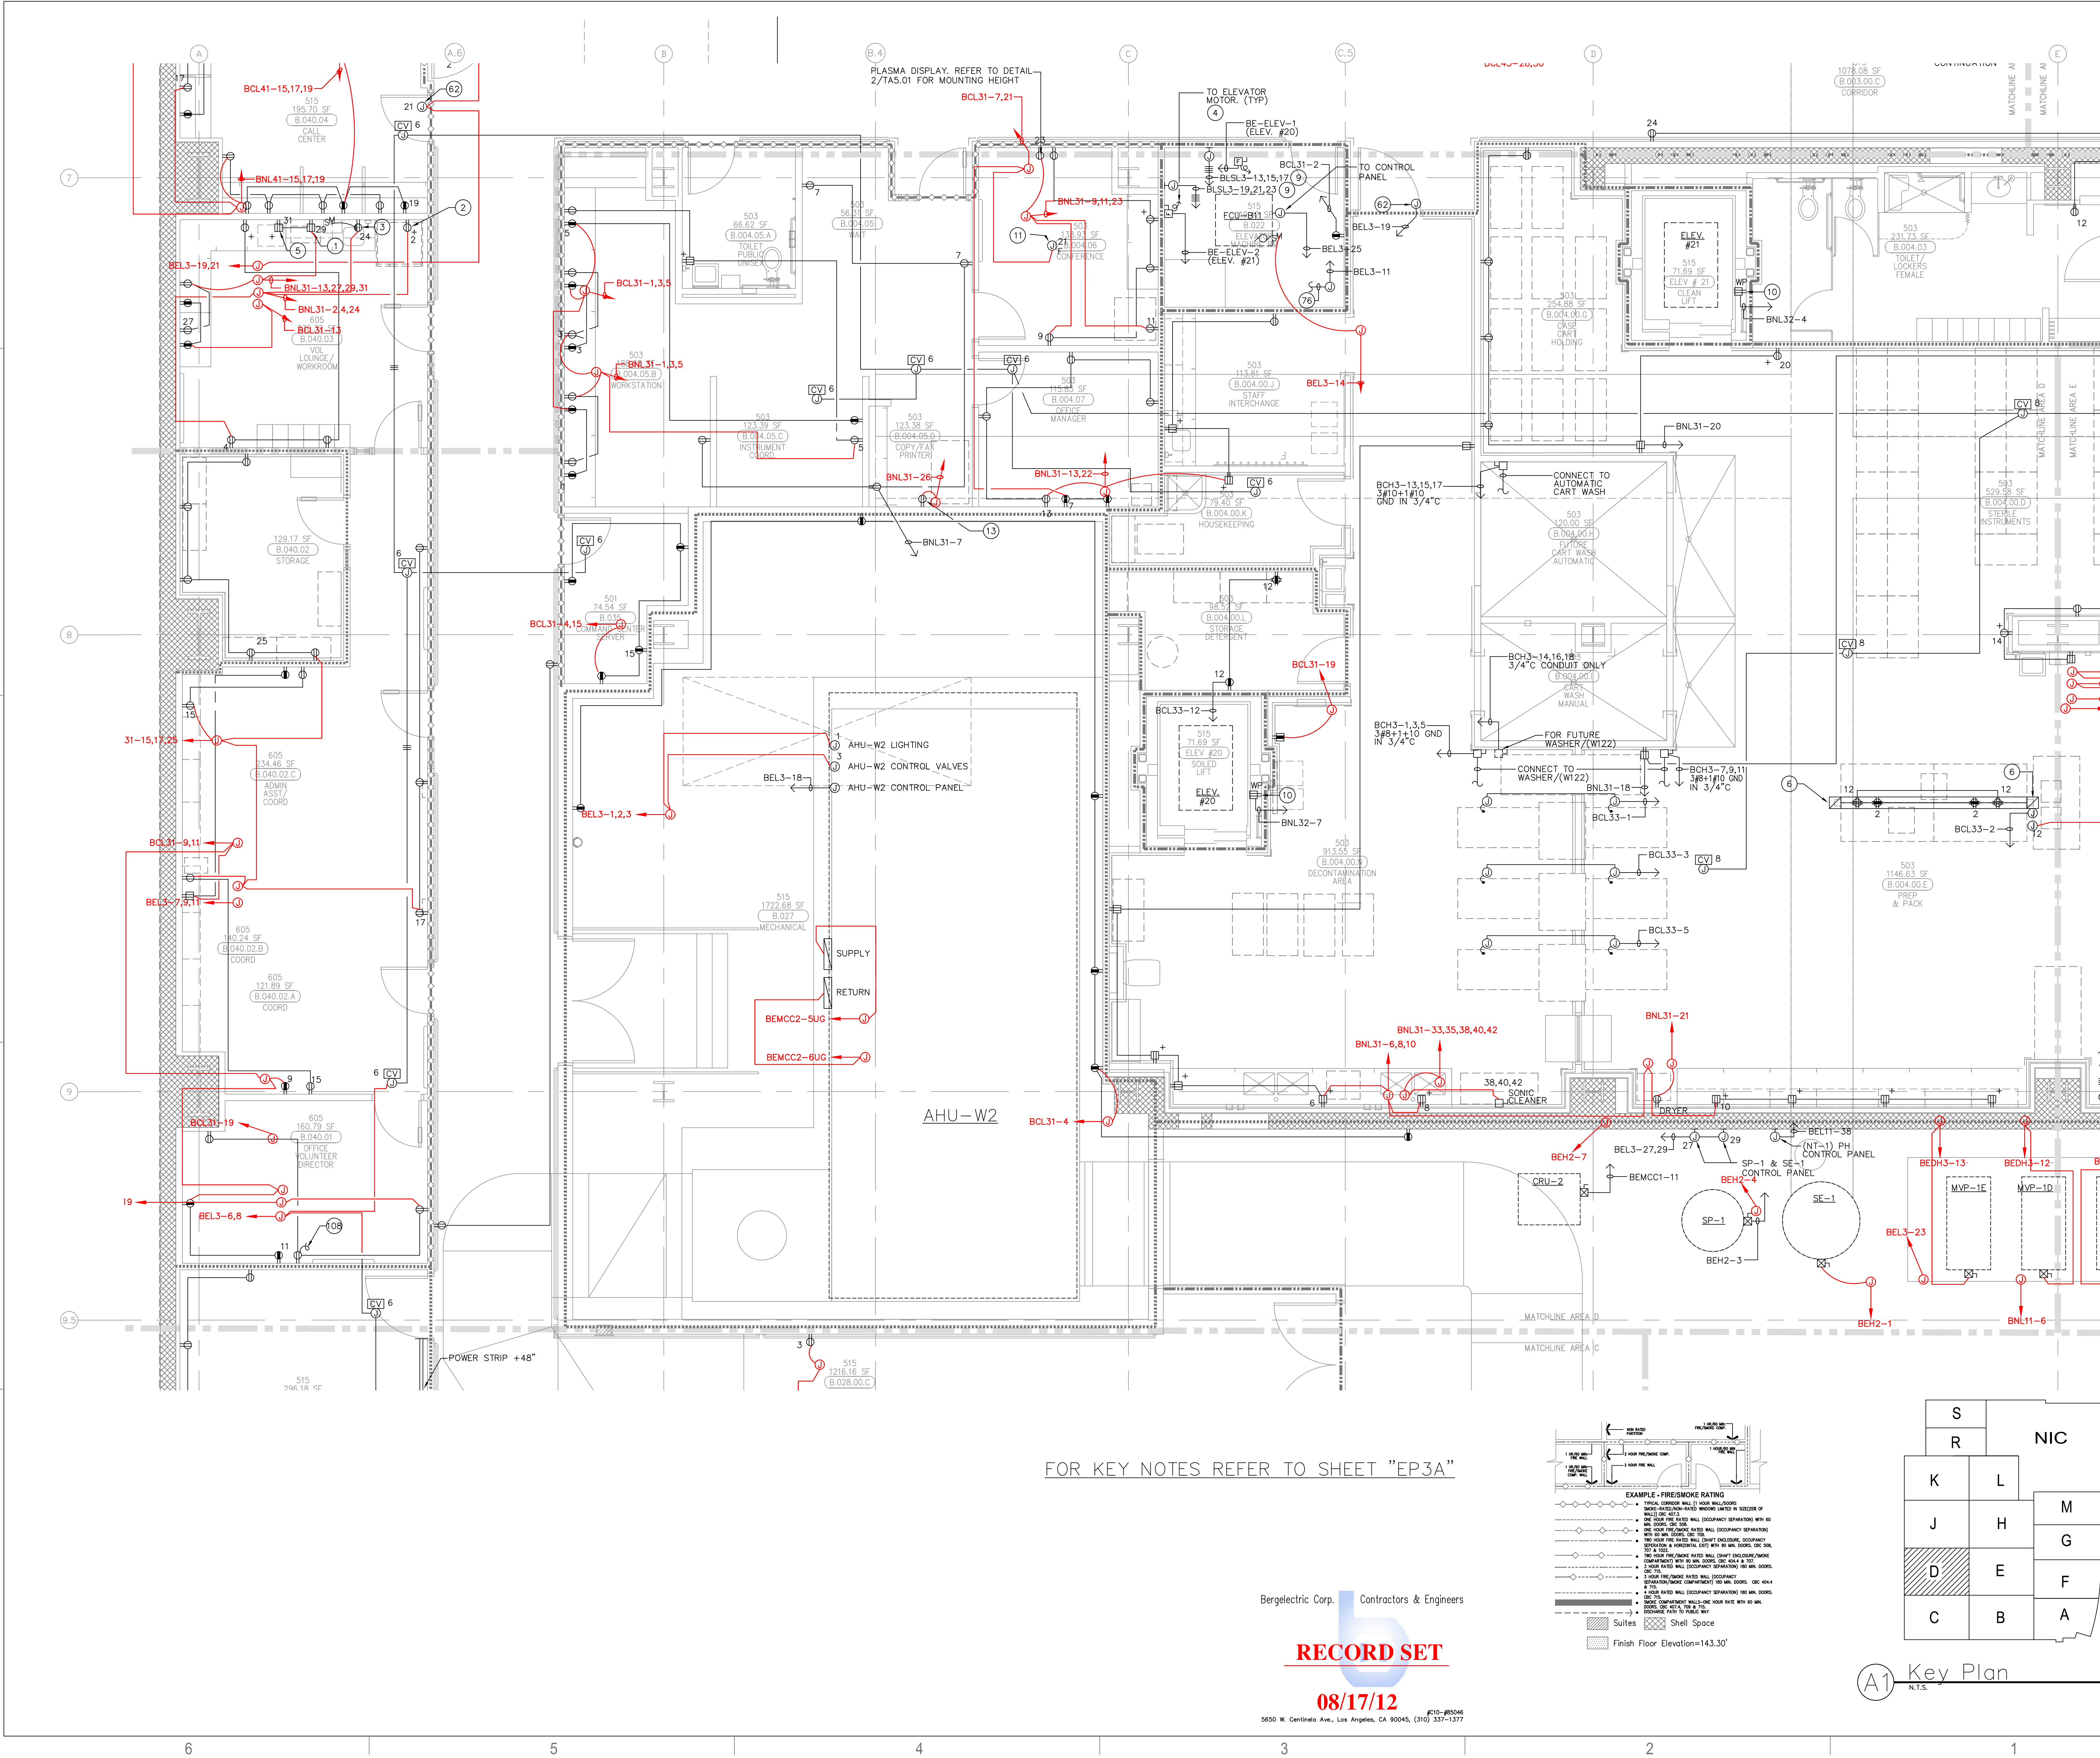

FOR KEY NOTES REFER TO SHEET "EP3A"

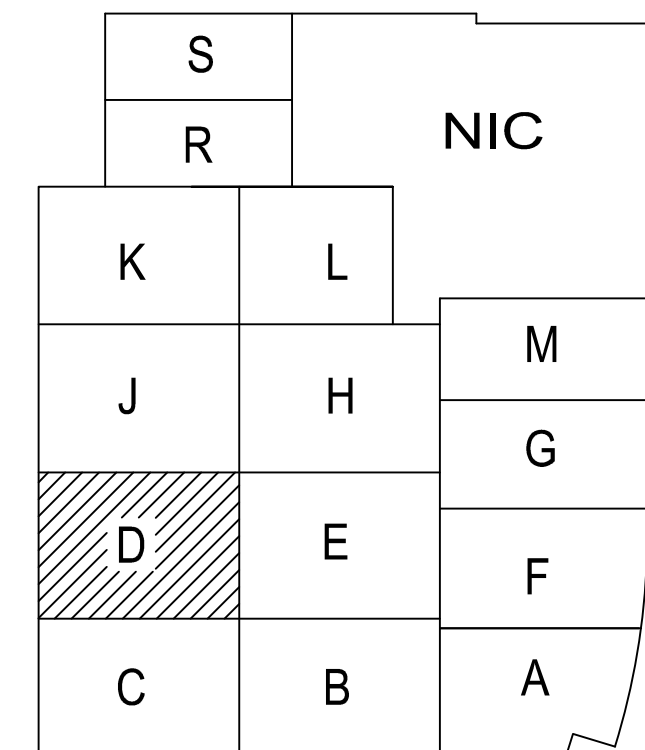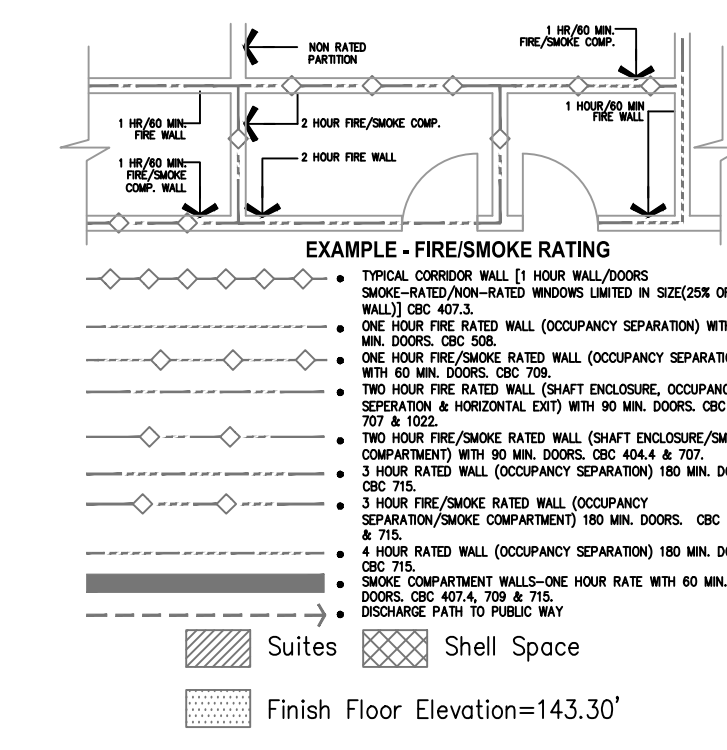


Bergelectric Corp. Contractors & Engineers

RECORD SET

08/17/12

5650 W. Centinela Ave., Los Angeles, CA 90045, (310) 337-1377

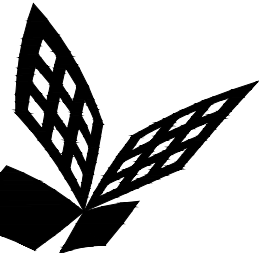

FKP Architects

ARCHITECT OF RECORD

CONSULTANT

T M A D
TAYLOR
& G AINES

STRUCTURAL
MECHANICAL
ELECTRICAL
CIVIL

100 South Anaheim Boulevard, Suite 150
Anaheim, California 92805
Phone: 714.490.5555 Fax: 714.490.5560
Project No. 2305-163-07

REVISIONS

428 06/07/11 CHANGE ORDER #104
897 12/19/11 CHANGE ORDER #294

APPROVAL

PROJECT NAME

CHILDREN'S HOSPITAL
OF ORANGE COUNTY

455 S. Main St.
Orange, CA 92868-3874

TOWER II



PROJECT NUMBER

12011.00
Increment #7

OSHPD - PROJECT NUMBER

IL 072072-30

ISSUE

OSHPD PERMIT

DATE

01/27/2010

SCALE


1/4"=1'-0"

DRAWING TITLE


LOWER LEVEL POWER
PLAN AREA - F

DRAWING NUMBER

EP3.0F

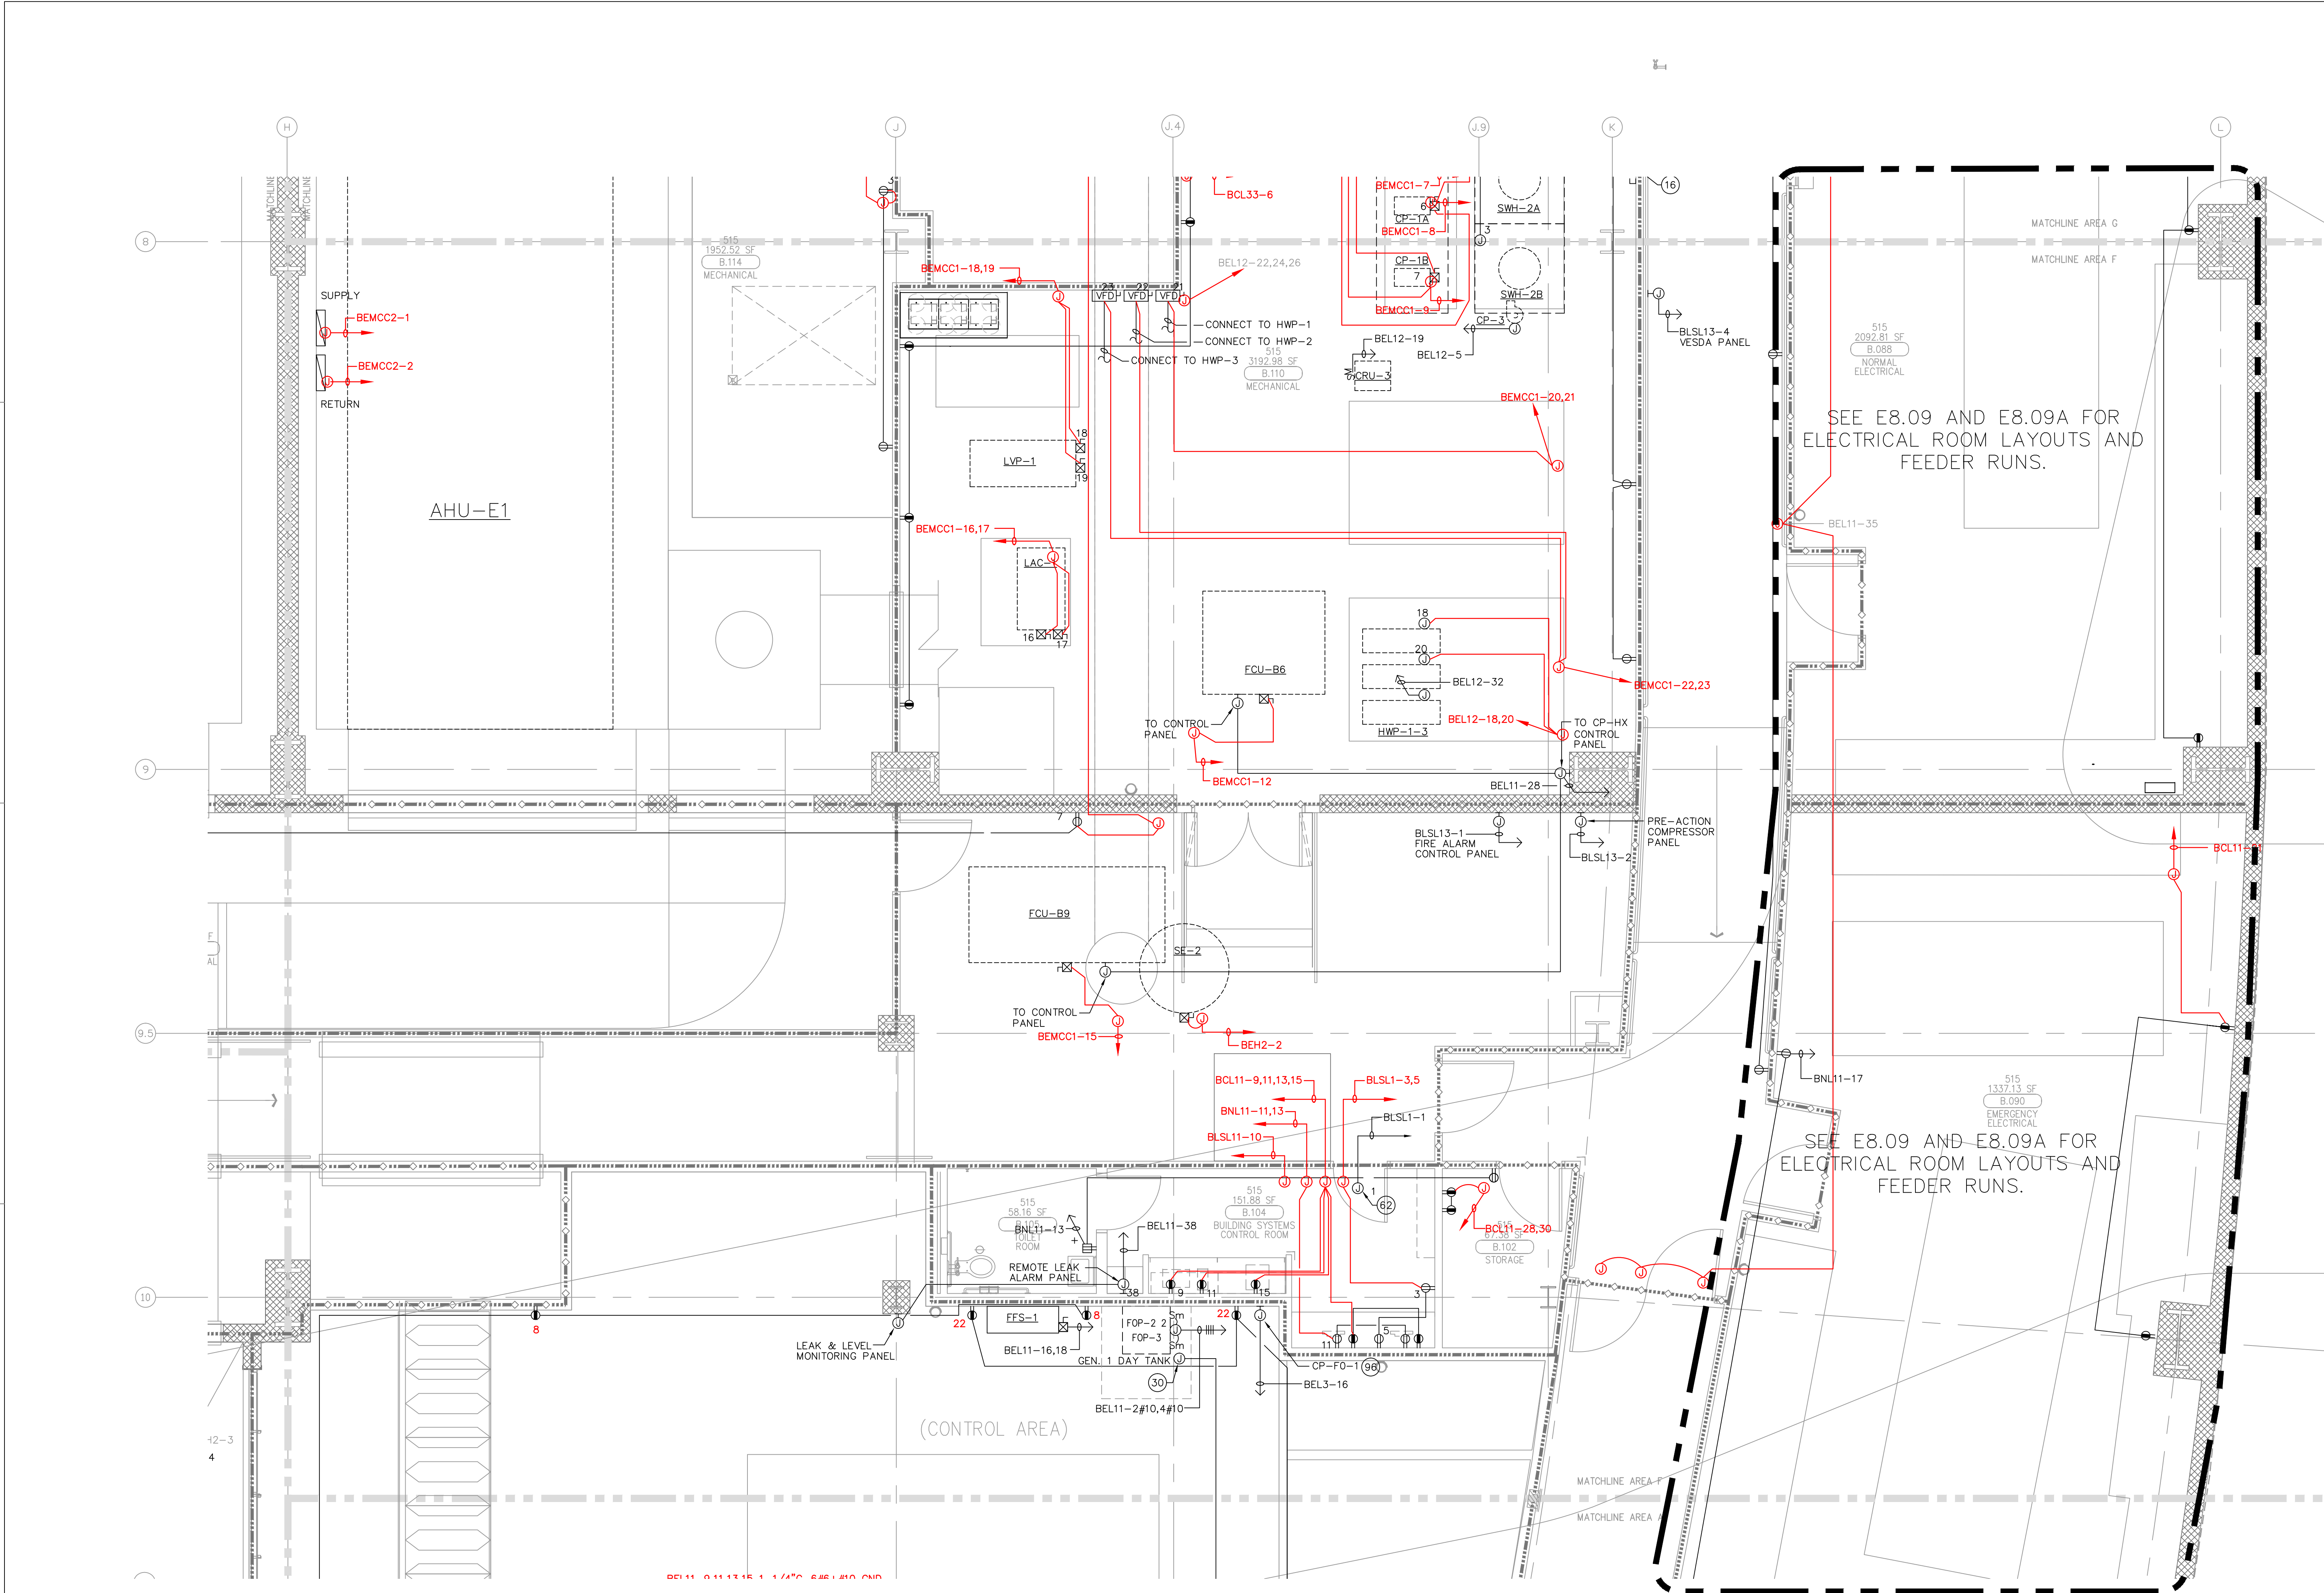

FOR KEY NOTES REFER TO SHEET "EP3A"

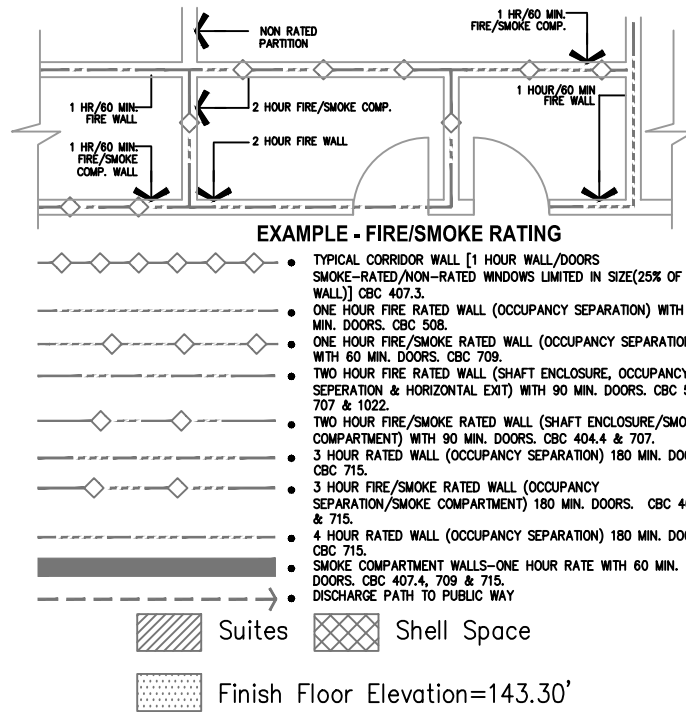

S		NIC
R		
K	L	M
J	H	G
D	E	F
C	B	A

A1 Key Plan
N.T.S.



Bergelectric Corp. Contractors & Engineers

RECORD SET

08/17/12


1650 W. Centinela Ave., Los Angeles, CA 90045, (310) 337-1377

#C10-#5046

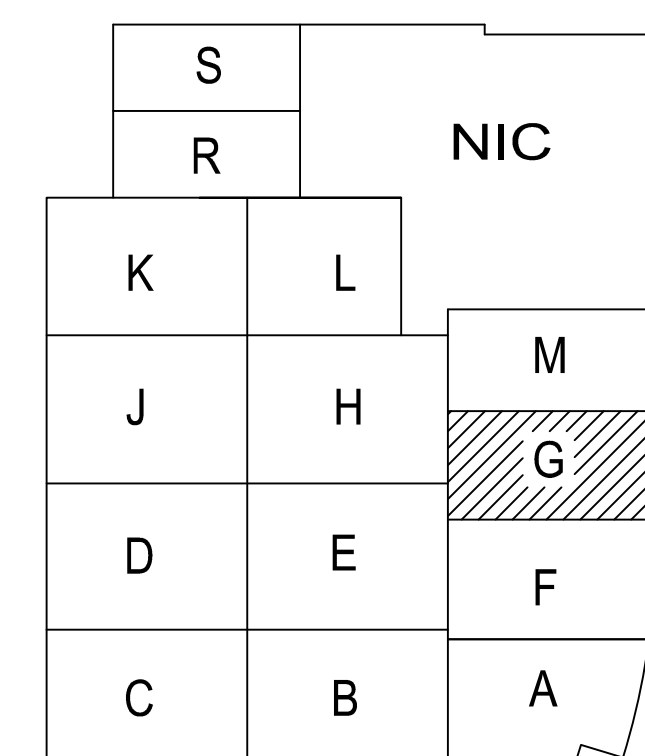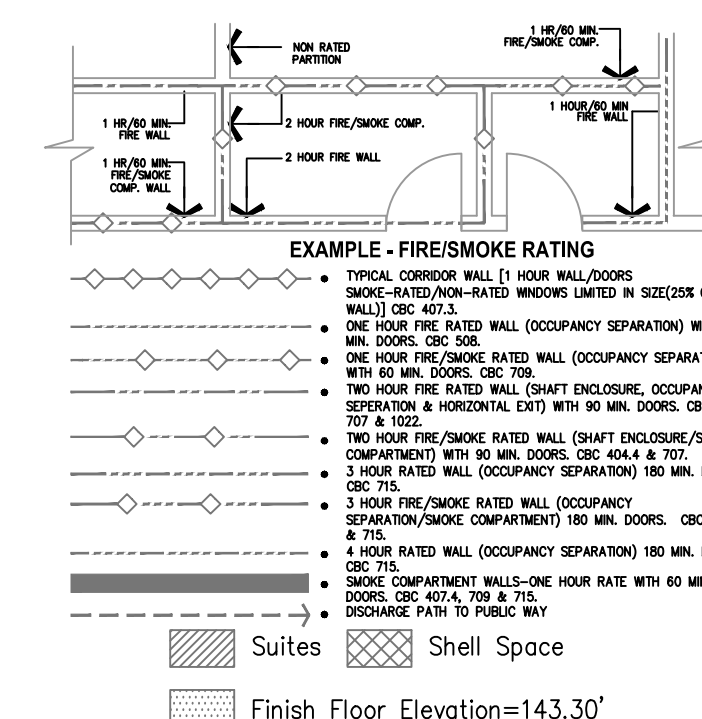

A1 Key Plan
N.T.S.

5650 W. Centinela Ave., Los Angeles, CA 90045, (310) 337-1377

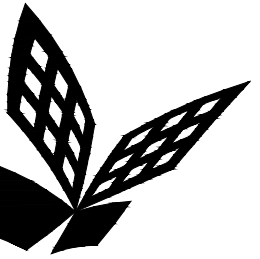

FKP Architects

ARCHITECT OF RECORD

CONSULTANT

T M A D
TAYLOR
& G AINES
100 South Anaheim Boulevard, Suite 150
Anaheim, California 92805
Phone: 714.490.5555 Fax: 714.490.5560
Project No. 2305-163-07

REVISIONS

02/05/10	INFORMATION BULLETIN #5
07/12/10	CHANGE ORDER #40
09/26/11	CHANGE ORDER #262

APPROVAL

Bergelectric Corp. Contractors & Engineers

RECORD SET

08/17/12

5650 W. Centinela Ave., Los Angeles, CA 90045, (310) 337-1377

PROJECT NAME

CHILDREN'S HOSPITAL
OF ORANGE COUNTY
455 S. Main St.
Orange, CA 92868-3874

TOWER II



PROJECT NUMBER

12011.00
Increment #7

OSHPD - PROJECT NUMBER

IL 072072-30

ISSUE

OSHPD PERMIT

DATE

01/27/2010

SCALE

1/4"=1'-0"



DRAWING TITLE

LOWER LEVEL POWER
PLAN AREA - H


DRAWING NUMBER

EP3.0H

FOR KEY NOTES REFER TO SHEET "EP3A"

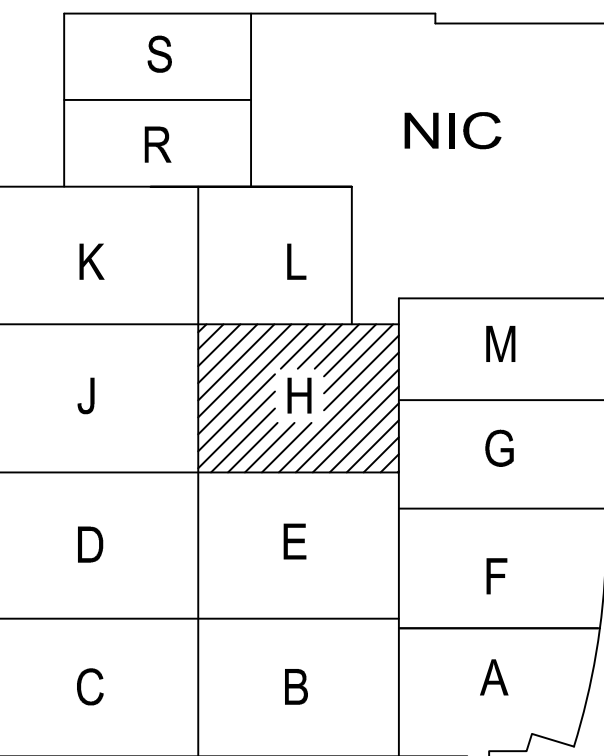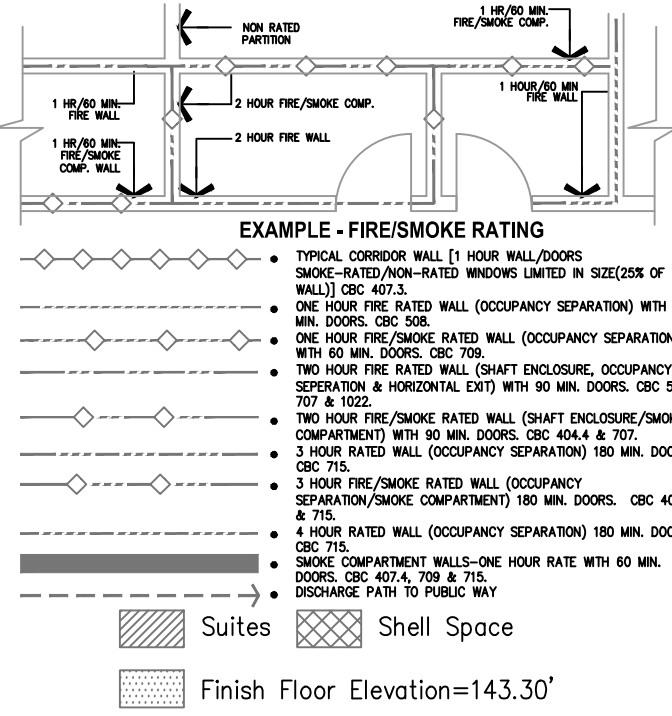

Key Plan
N.T.S.

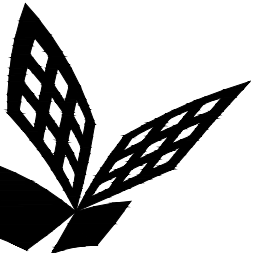

FKP Architects

ARCHITECT OF RECORD

CONSULTANT

T M A D
TAYLOR
& G AINES

100 South Anaheim Boulevard, Suite 150
Anaheim, California 92805
Phone: 714.490.5555 Fax: 714.490.5560
Project No. 2305-163-07

REVISIONS	DATE	DESCRIPTION
1	02/05/10	INFORMATION BULLETIN #5
2	07/12/10	CHANGE ORDER #40
3	03/08/11	CHANGE ORDER #130
4	09/26/11	CHANGE ORDER #262
5	12/05/11	CHANGE ORDER #288

APPROVAL

PROJECT NAME
**CHILDREN'S HOSPITAL
OF ORANGE COUNTY**
455 S. Main St.
Orange, CA 92868-3874

TOWER II



PROJECT NUMBER

**12011.00
Increment #7**

OSHPD - PROJECT NUMBER
IL 072072-30

ISSUE

OSHPD PERMIT

DATE

01/27/2010


SCALE

1/4"=1'-0"



DRAWING TITLE

DRAWING NUMBER

EP3.0J

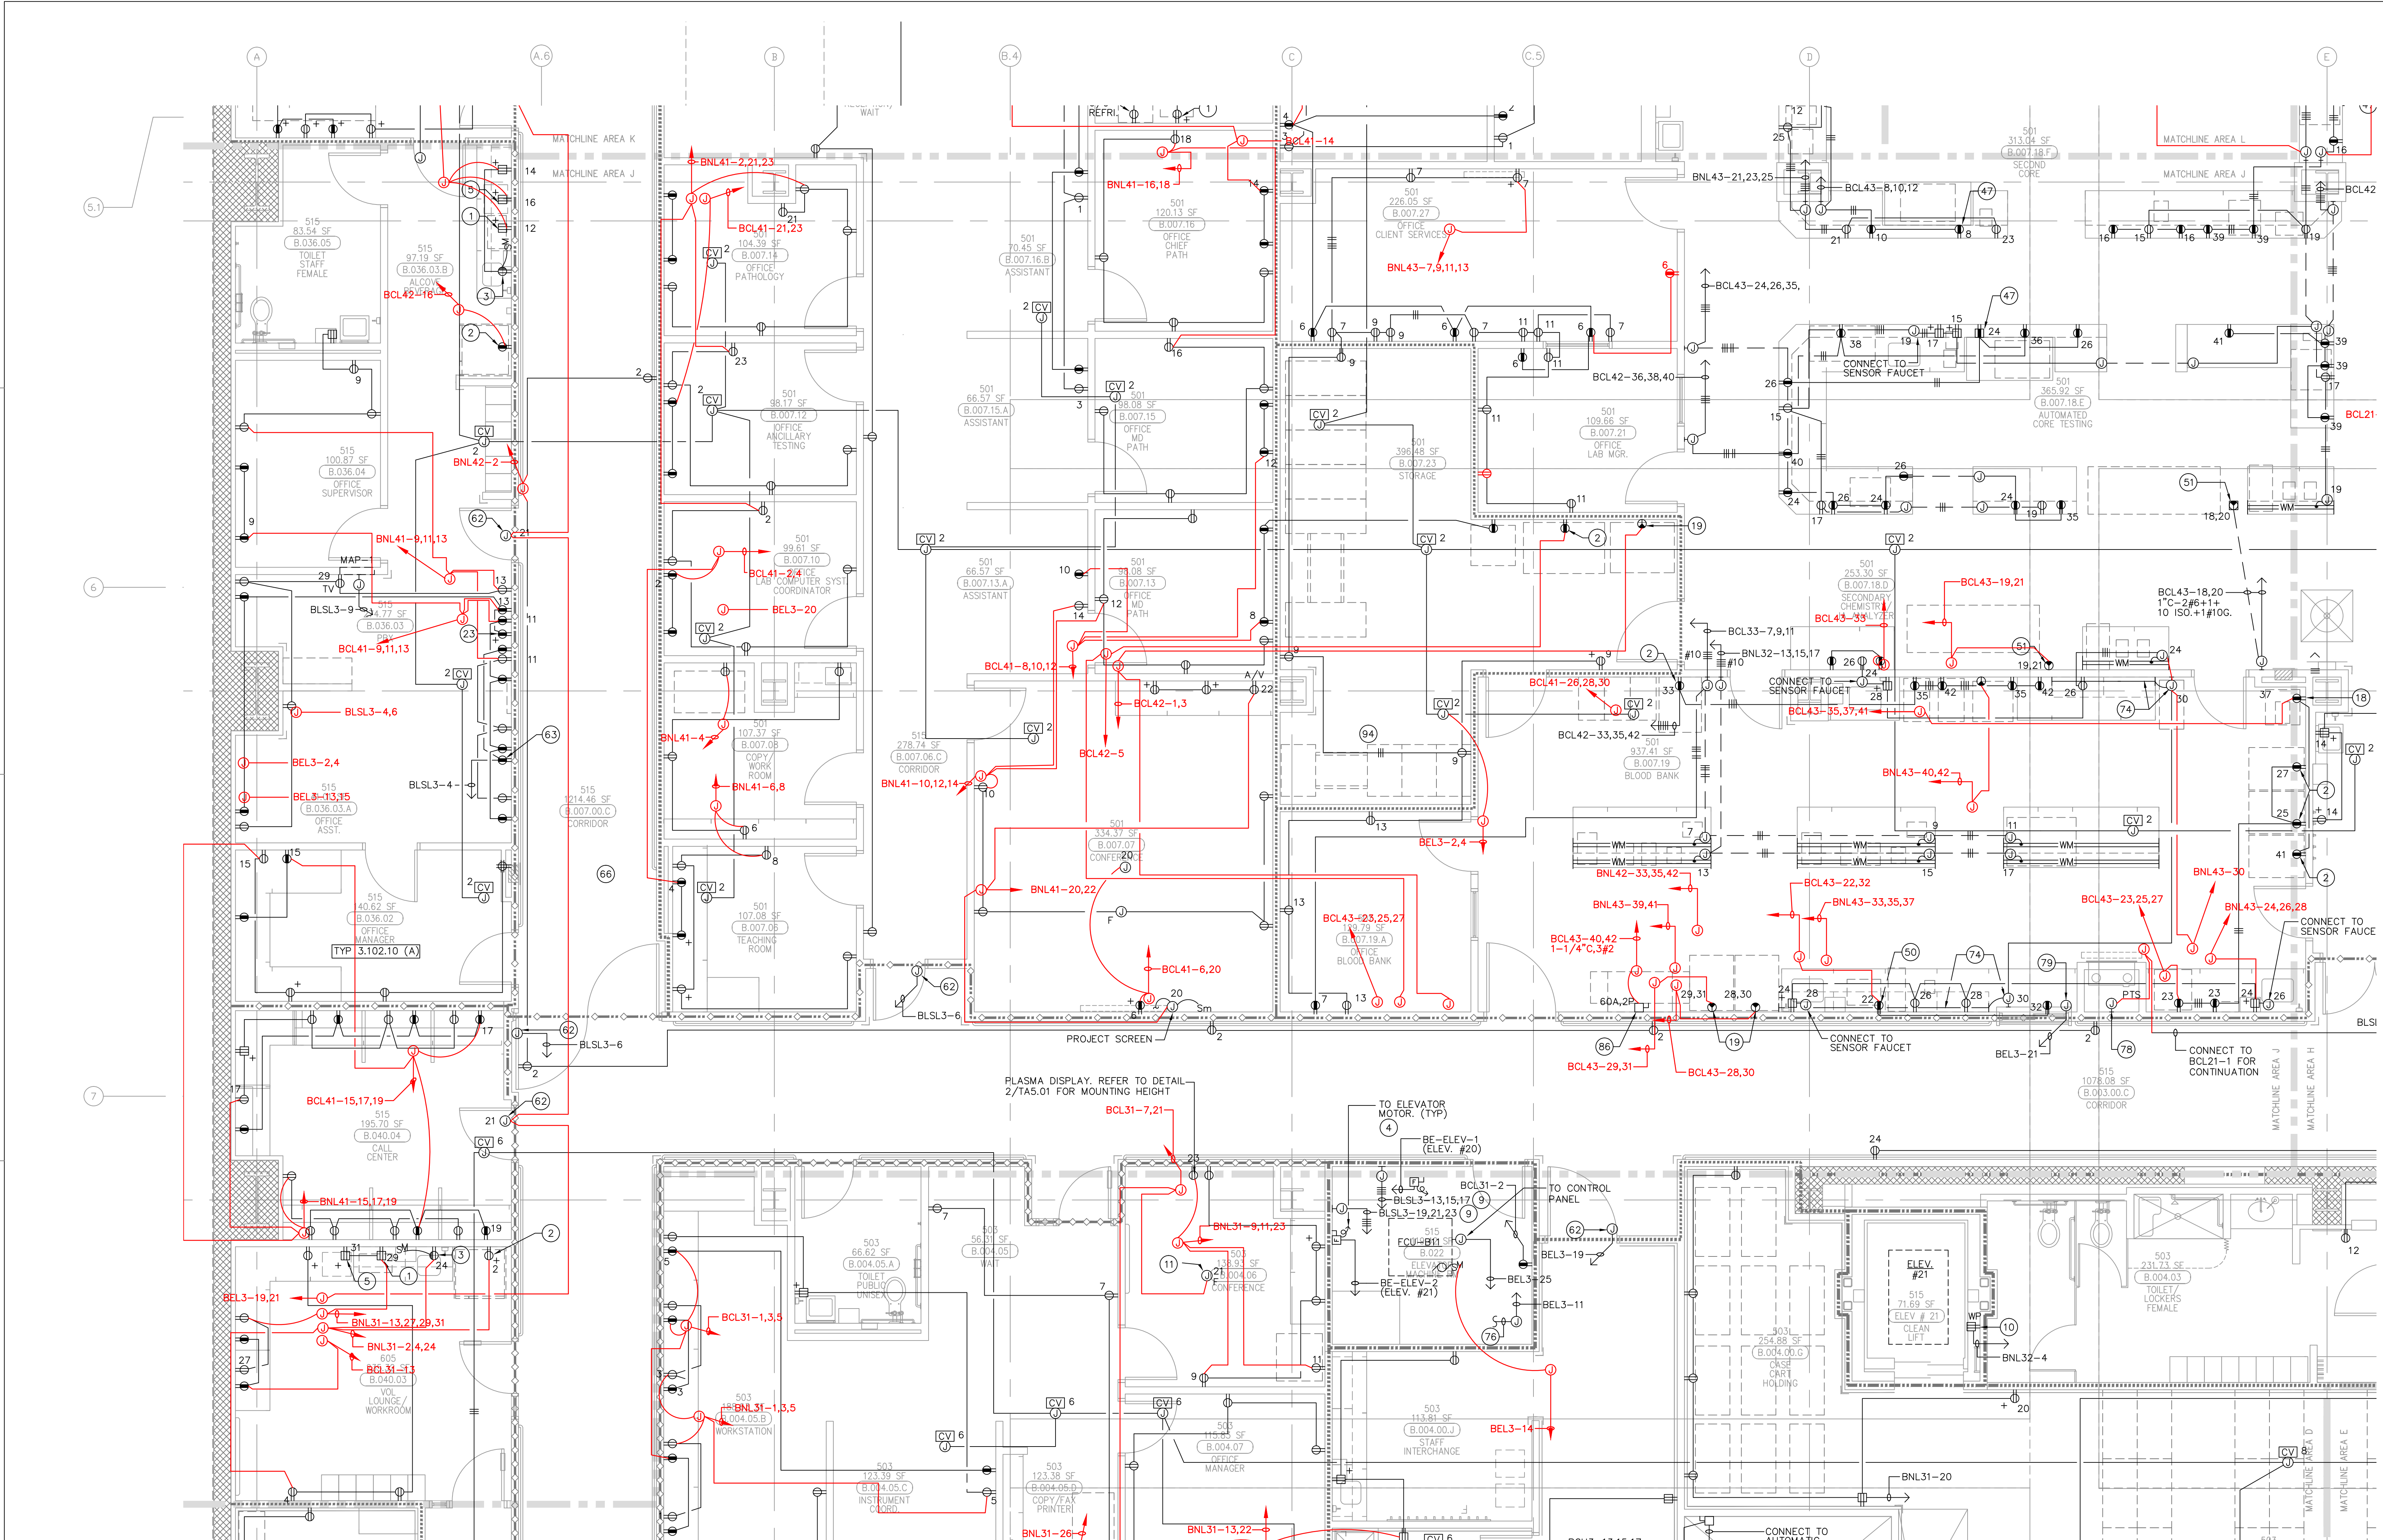

FOR KEY NOTES REFER TO SHEET "EP3A"

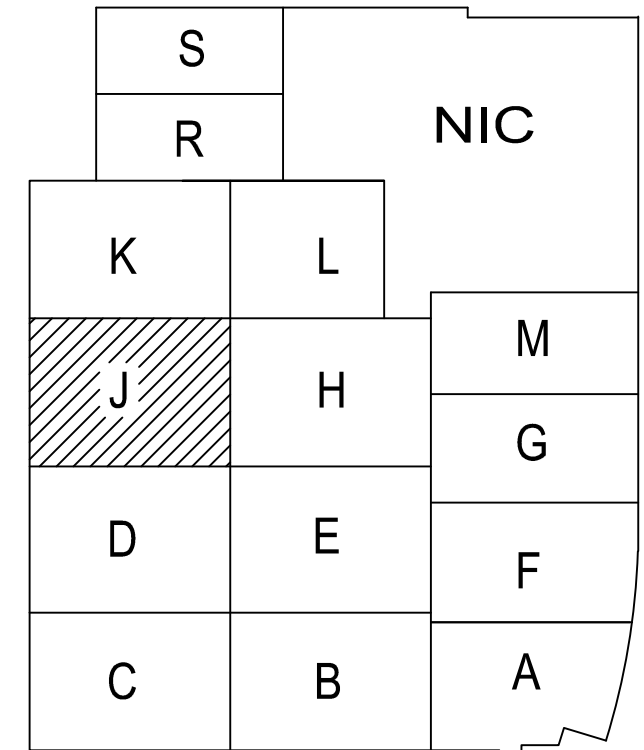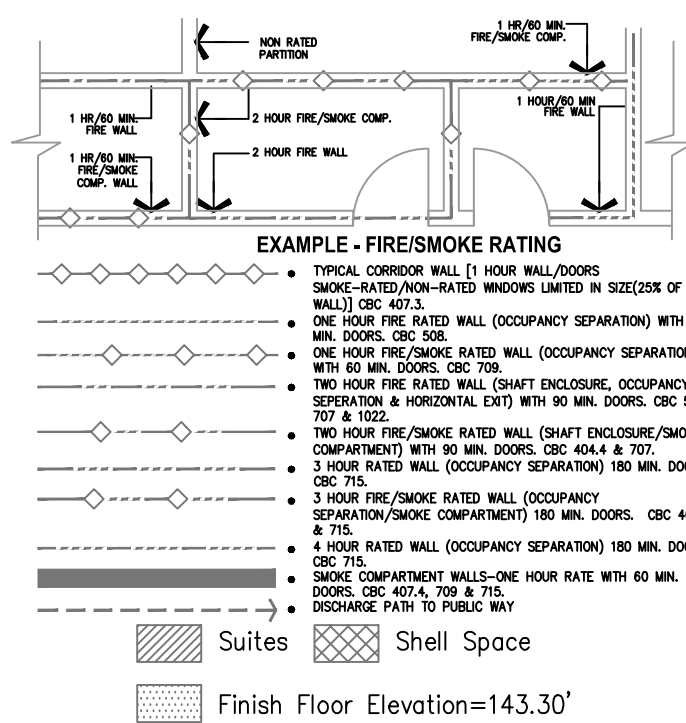


Bergelectric Corp. Contractors & Engineers

RECORD SET

08/17/12

5650 W. Centinela Ave., Los Angeles, CA 90045, (310) 337-1377



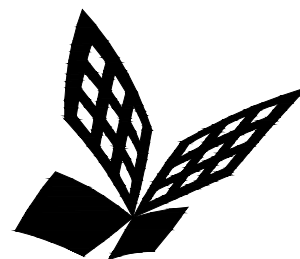

FKP Architects

ARCHITECT OF RECORD

CONSULTANT

T M A D
TAYLOR
& G AINES
100 South Anaheim Boulevard, Suite 150
Anaheim, California 92805
Phone: 714.490.5555 Fax: 714.490.5560
Project No. 2305-163-07

REVISIONS

02/05/10	INFORMATION BULLETIN #5
07/12/10	CHANGE ORDER #40
12/19/11	CHANGE ORDER #294

APPROVAL

Bergelectric Corp. Contractors & Engineers

RECORD SET

08/17/12

5650 W. Centinella Ave., Los Angeles, CA 90045, (310) 337-1377

PROJECT NAME

CHILDREN'S HOSPITAL
OF ORANGE COUNTY
455 S. Main St.
Orange, CA 92868-3874

TOWER II



PROJECT NUMBER

12011.00
Increment #7

OSHPD - PROJECT NUMBER
IL 072072-30

ISSUE

OSHPD PERMIT

DATE

01/27/2010

SCALE




1/4"=1'-0"

DRAWING TITLE



LOWER LEVEL POWER
PLAN AREA - L

DRAWING NUMBER

EP3.0L

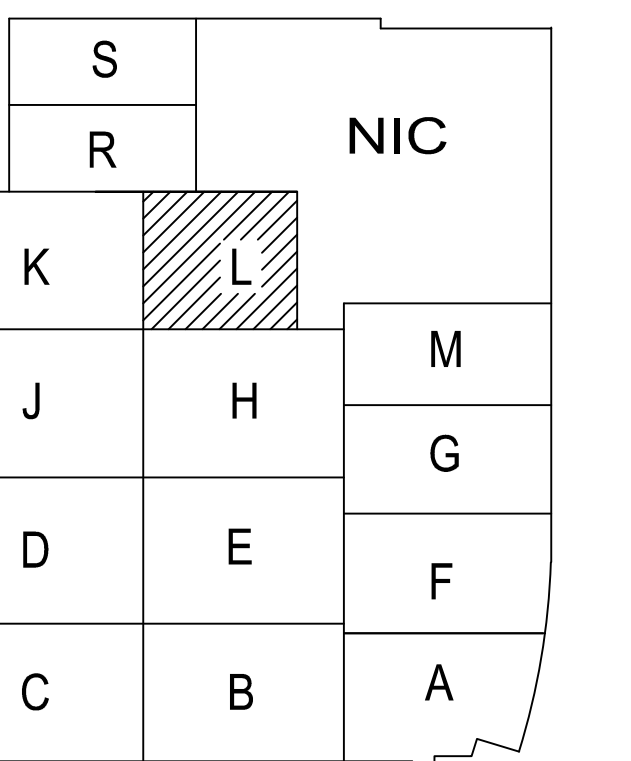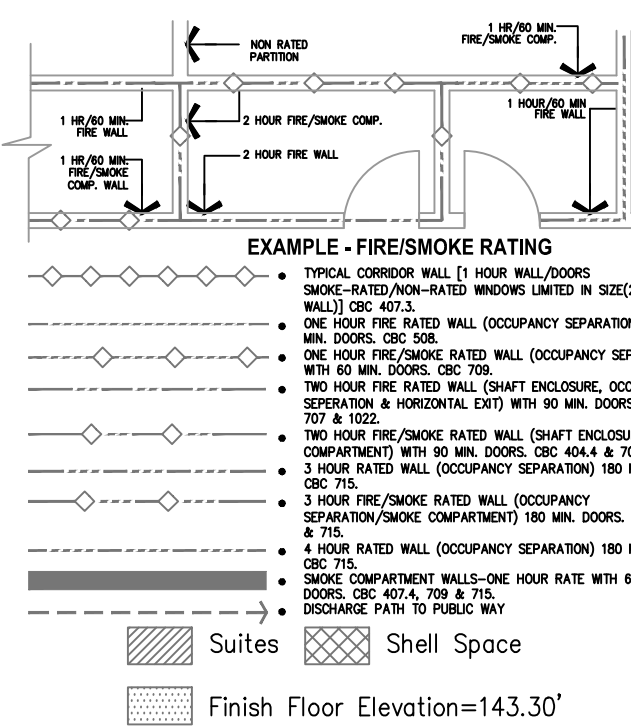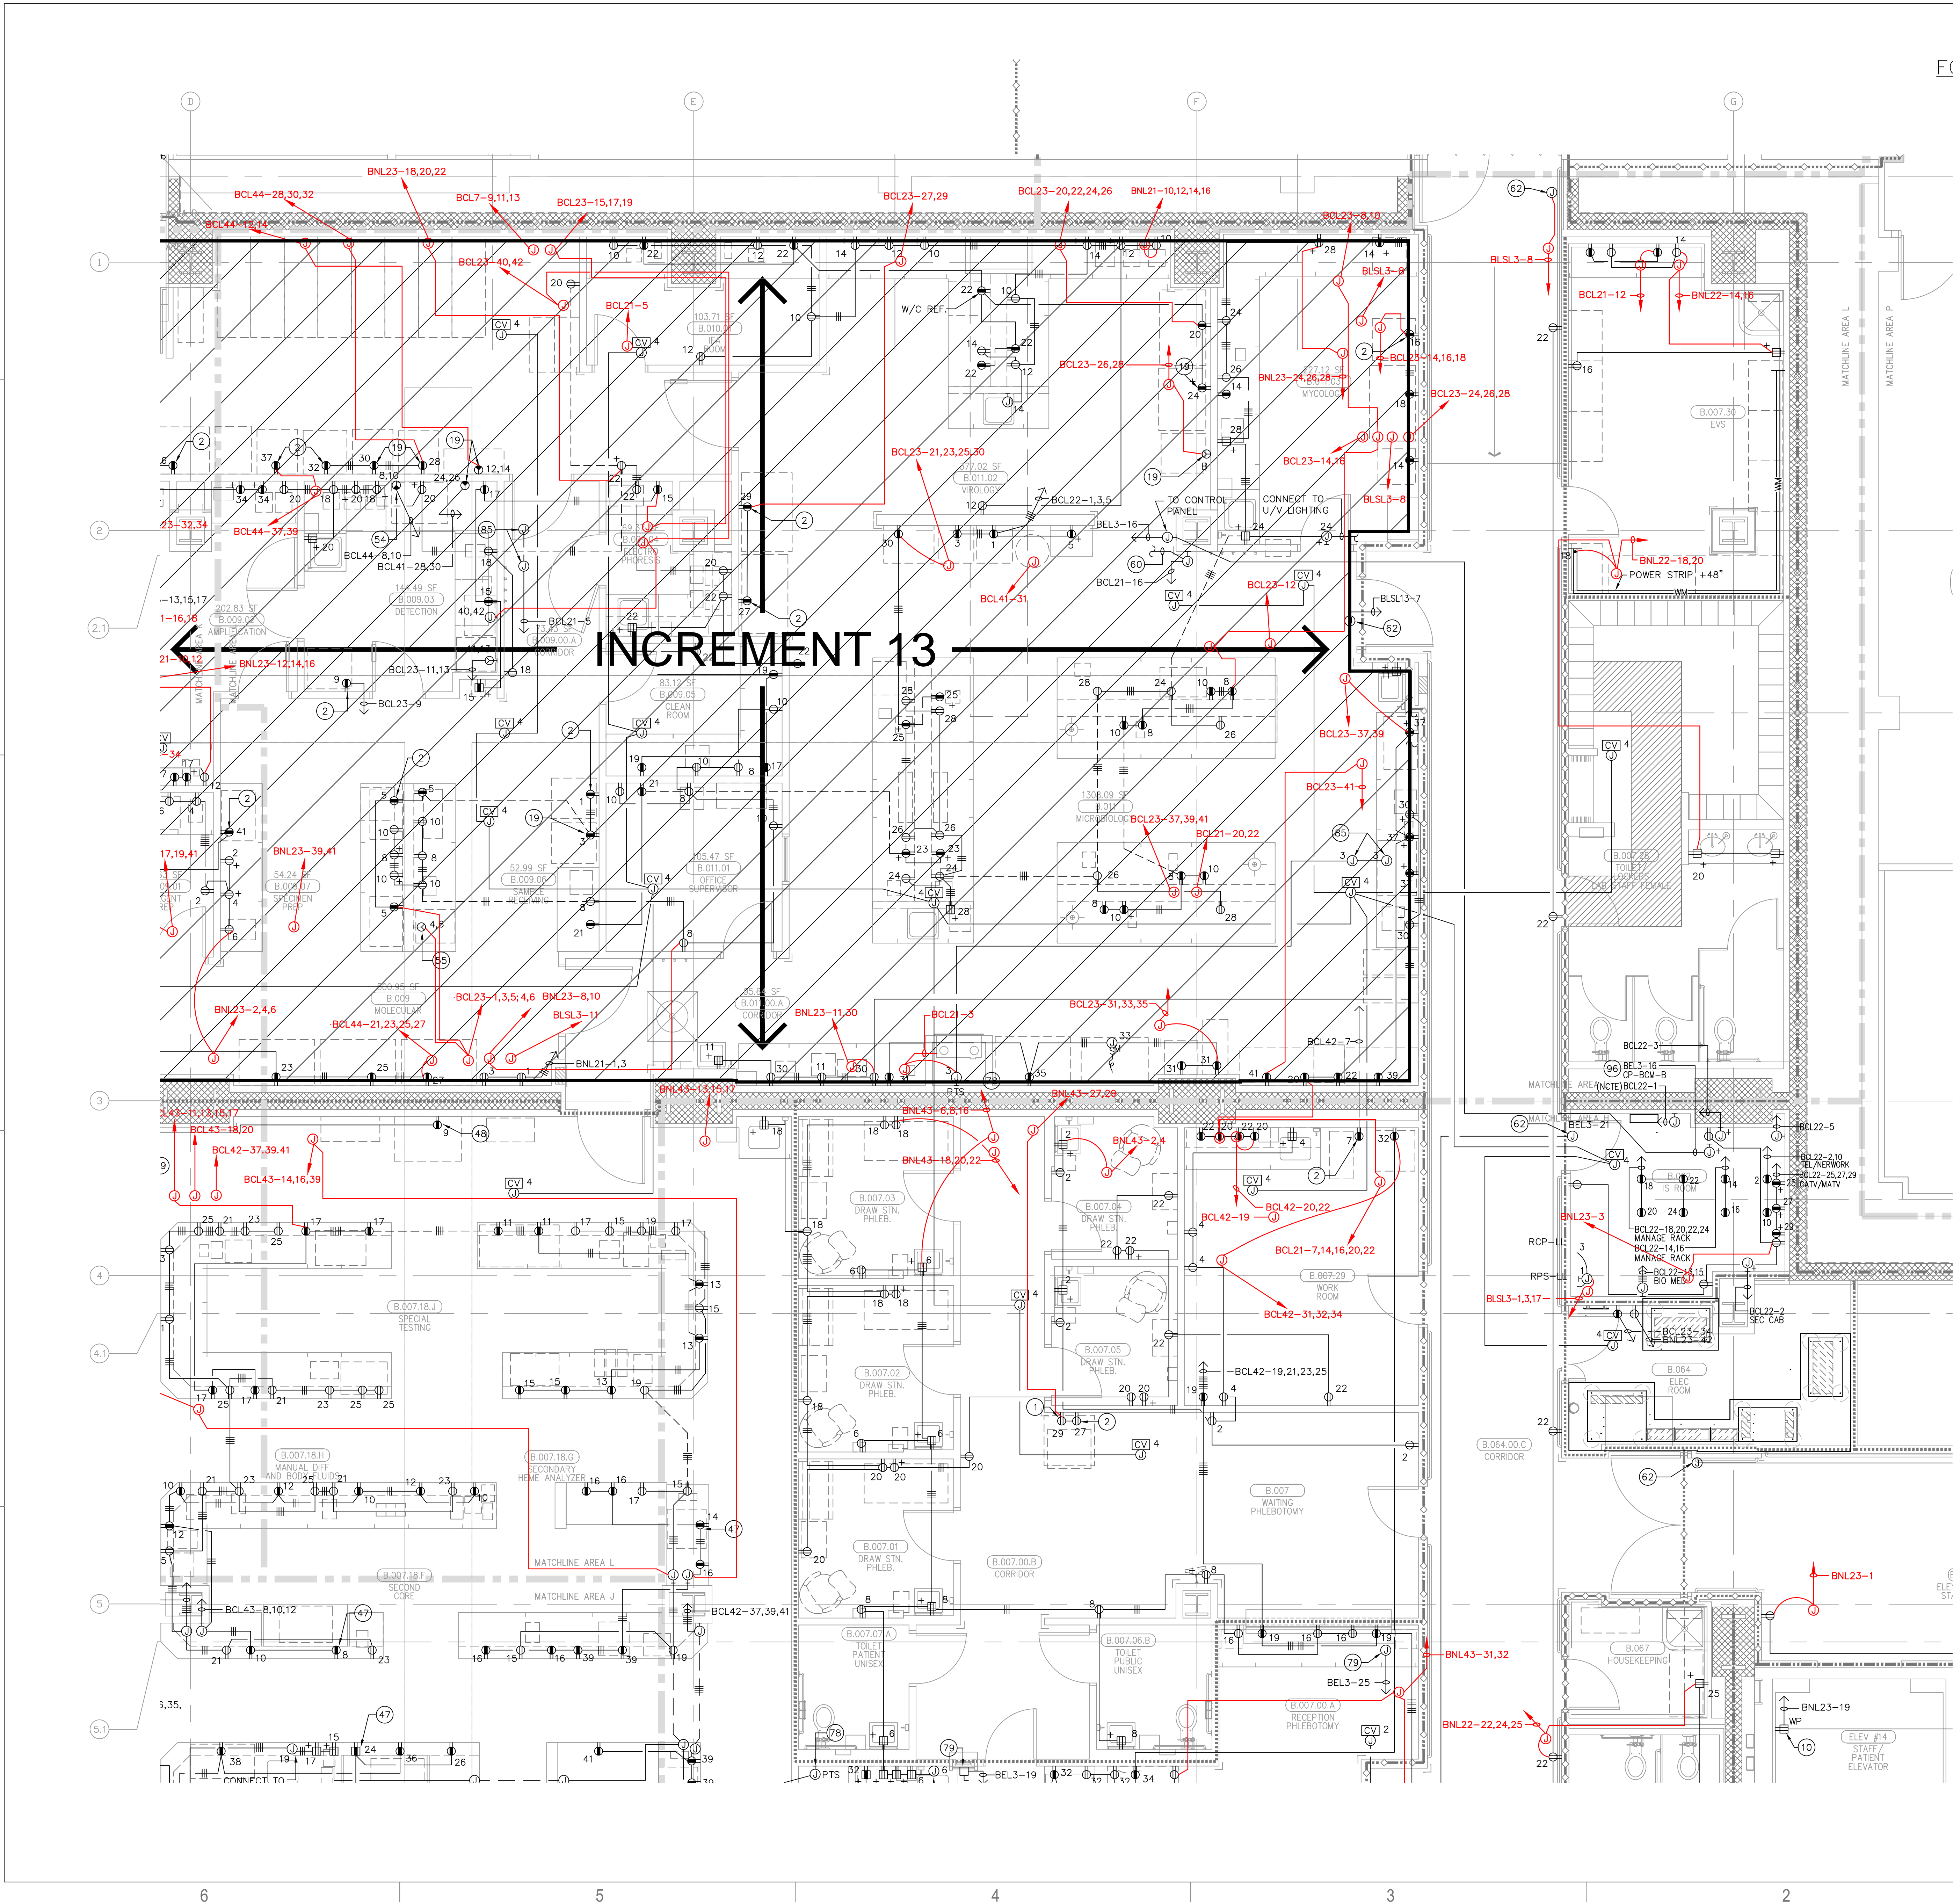

A1 Key Plan
N.T.S.

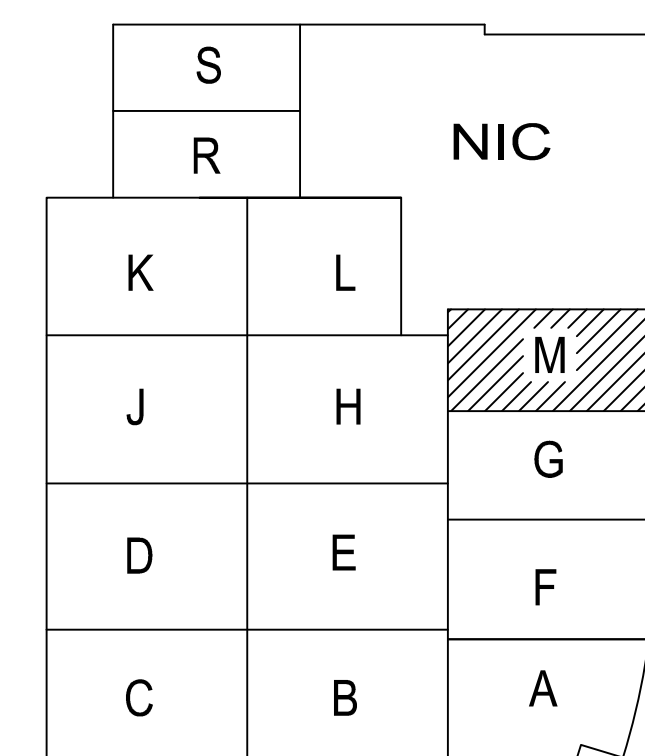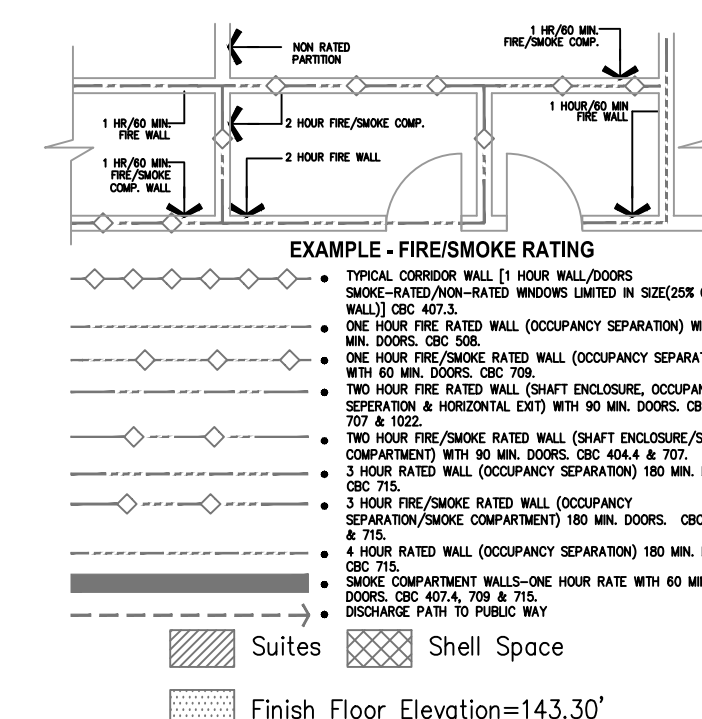


A1 Key Plan
N.T.S.

Bergelectric Corp. Contractors & Engineers

RECORD SET



08/17/12

5650 W. Centinela Ave., Los Angeles, CA 90045, (310) 337-1377

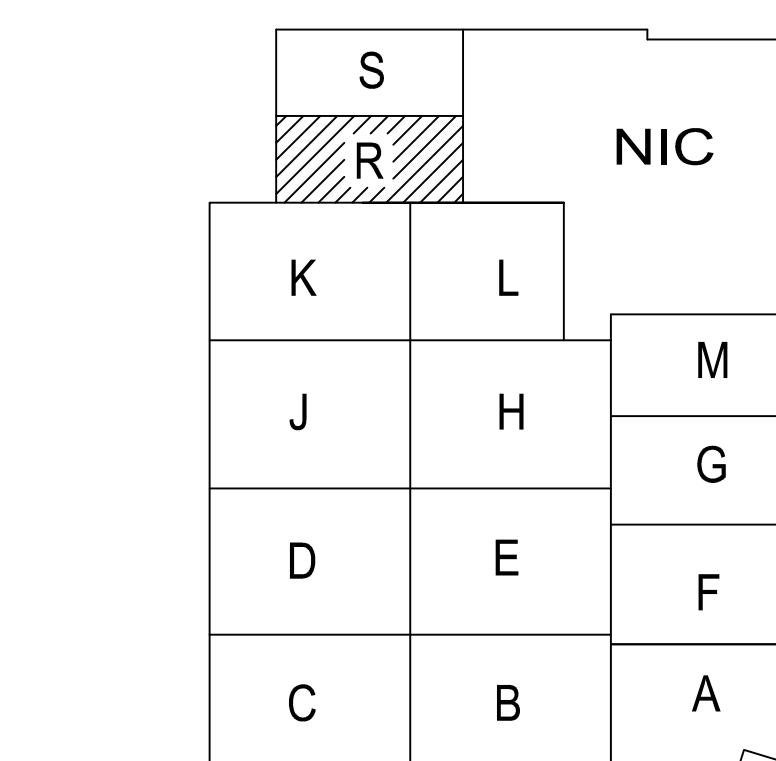

5650 W. Centinelo Ave., Los Angeles, CA 90045, (310) 337-1377

A1 Key Plan

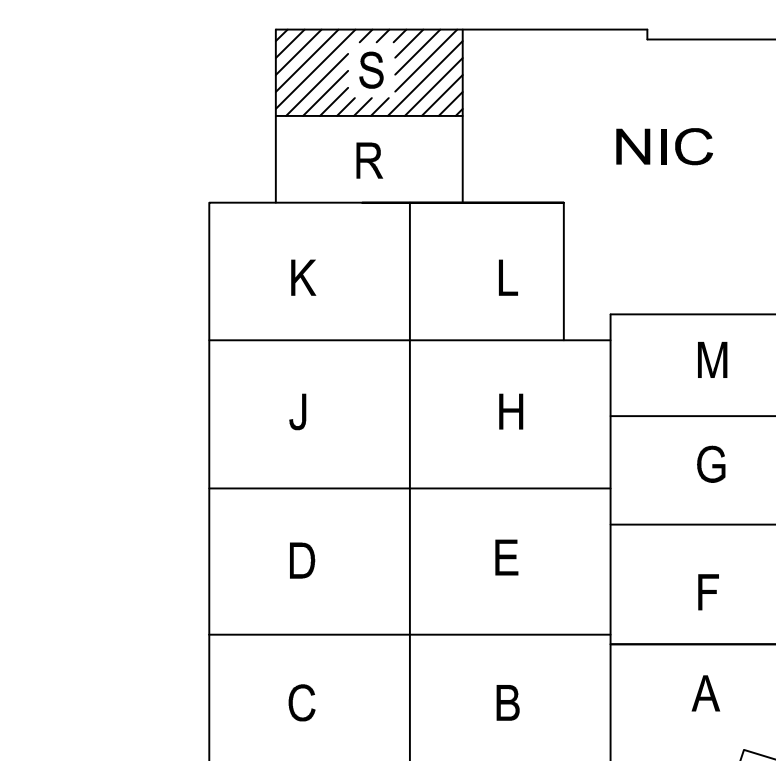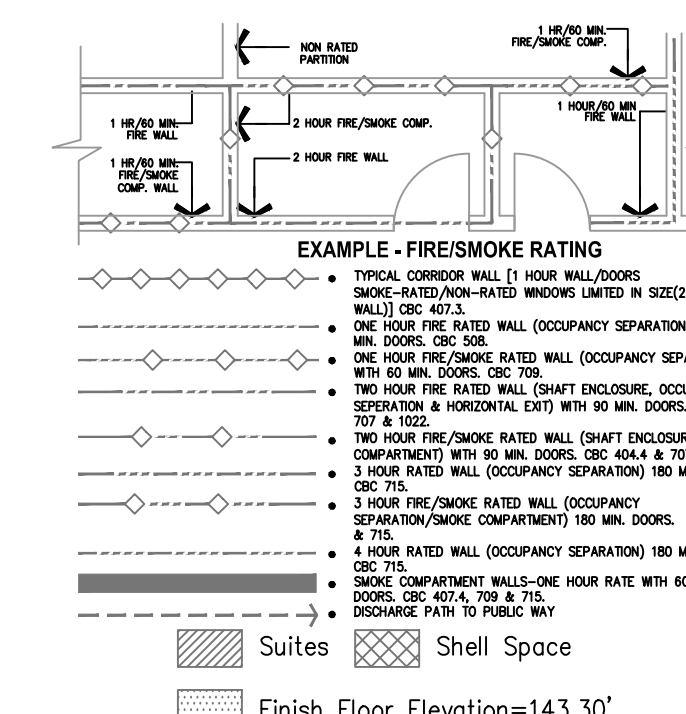

A1 Key Plan
N.T.S.