



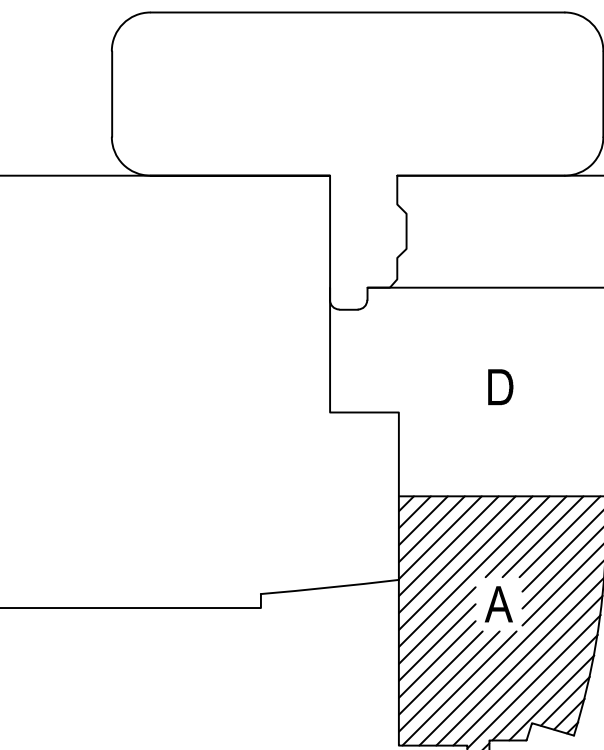


08/17/12

5650 W. Centinela Ave., Los Angeles, CA 90045, (310) 337-1377

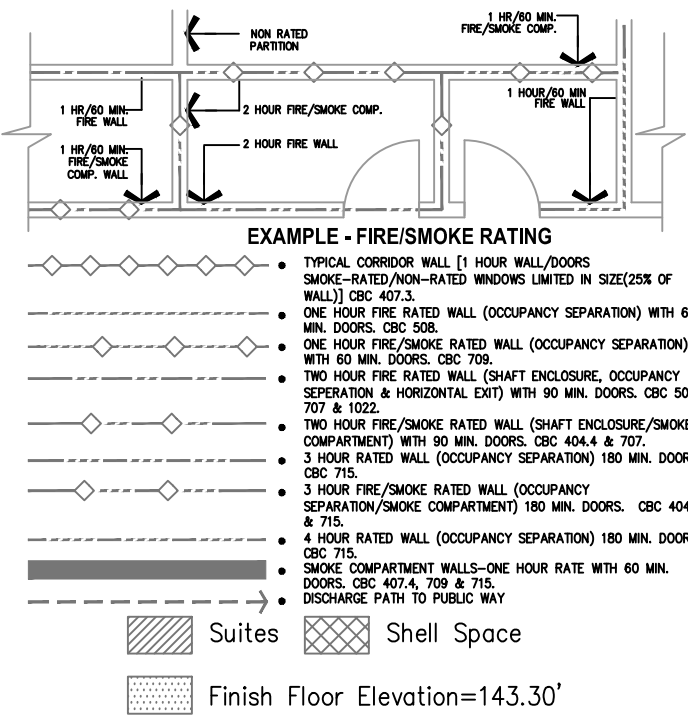

A1 Key Plan
N.T.S.

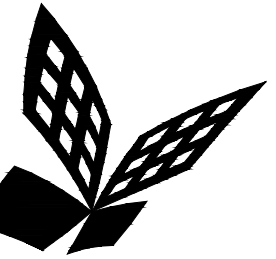

FKP Architects

ARCHITECT OF RECORD

CONSULTANT
T M A D
TAYLOR
& G AINES
100 South Anaheim Boulevard, Suite 150
Anaheim, California 92805
Phone: 714.490.5555 Fax: 714.490.5560
Project No. 2305-163-07

REVISIONS
8/9/11 12/19/11 CHANGE ORDER #294

APPROVAL

Bergelectric Corp. Contractors & Engineers

RECORD SET

08/17/12

5650 W. Centinela Ave., Los Angeles, CA 90045, (310) 337-1377

PROJECT NAME
CHILDREN'S HOSPITAL
OF ORANGE COUNTY
455 S. Main St.
Orange, CA 92868-3874

TOWER II



PROJECT NUMBER

12011.00
Increment #7

OSHPD - PROJECT NUMBER
IL 072072-30

ISSUE

OSHPD PERMIT

DATE

01/27/2010

SCALE


1/8"=1'-0"

DRAWING TITLE

PENTHOUSE 2 POWER
PLAN AREA - D

DRAWING NUMBER

EP3.9D

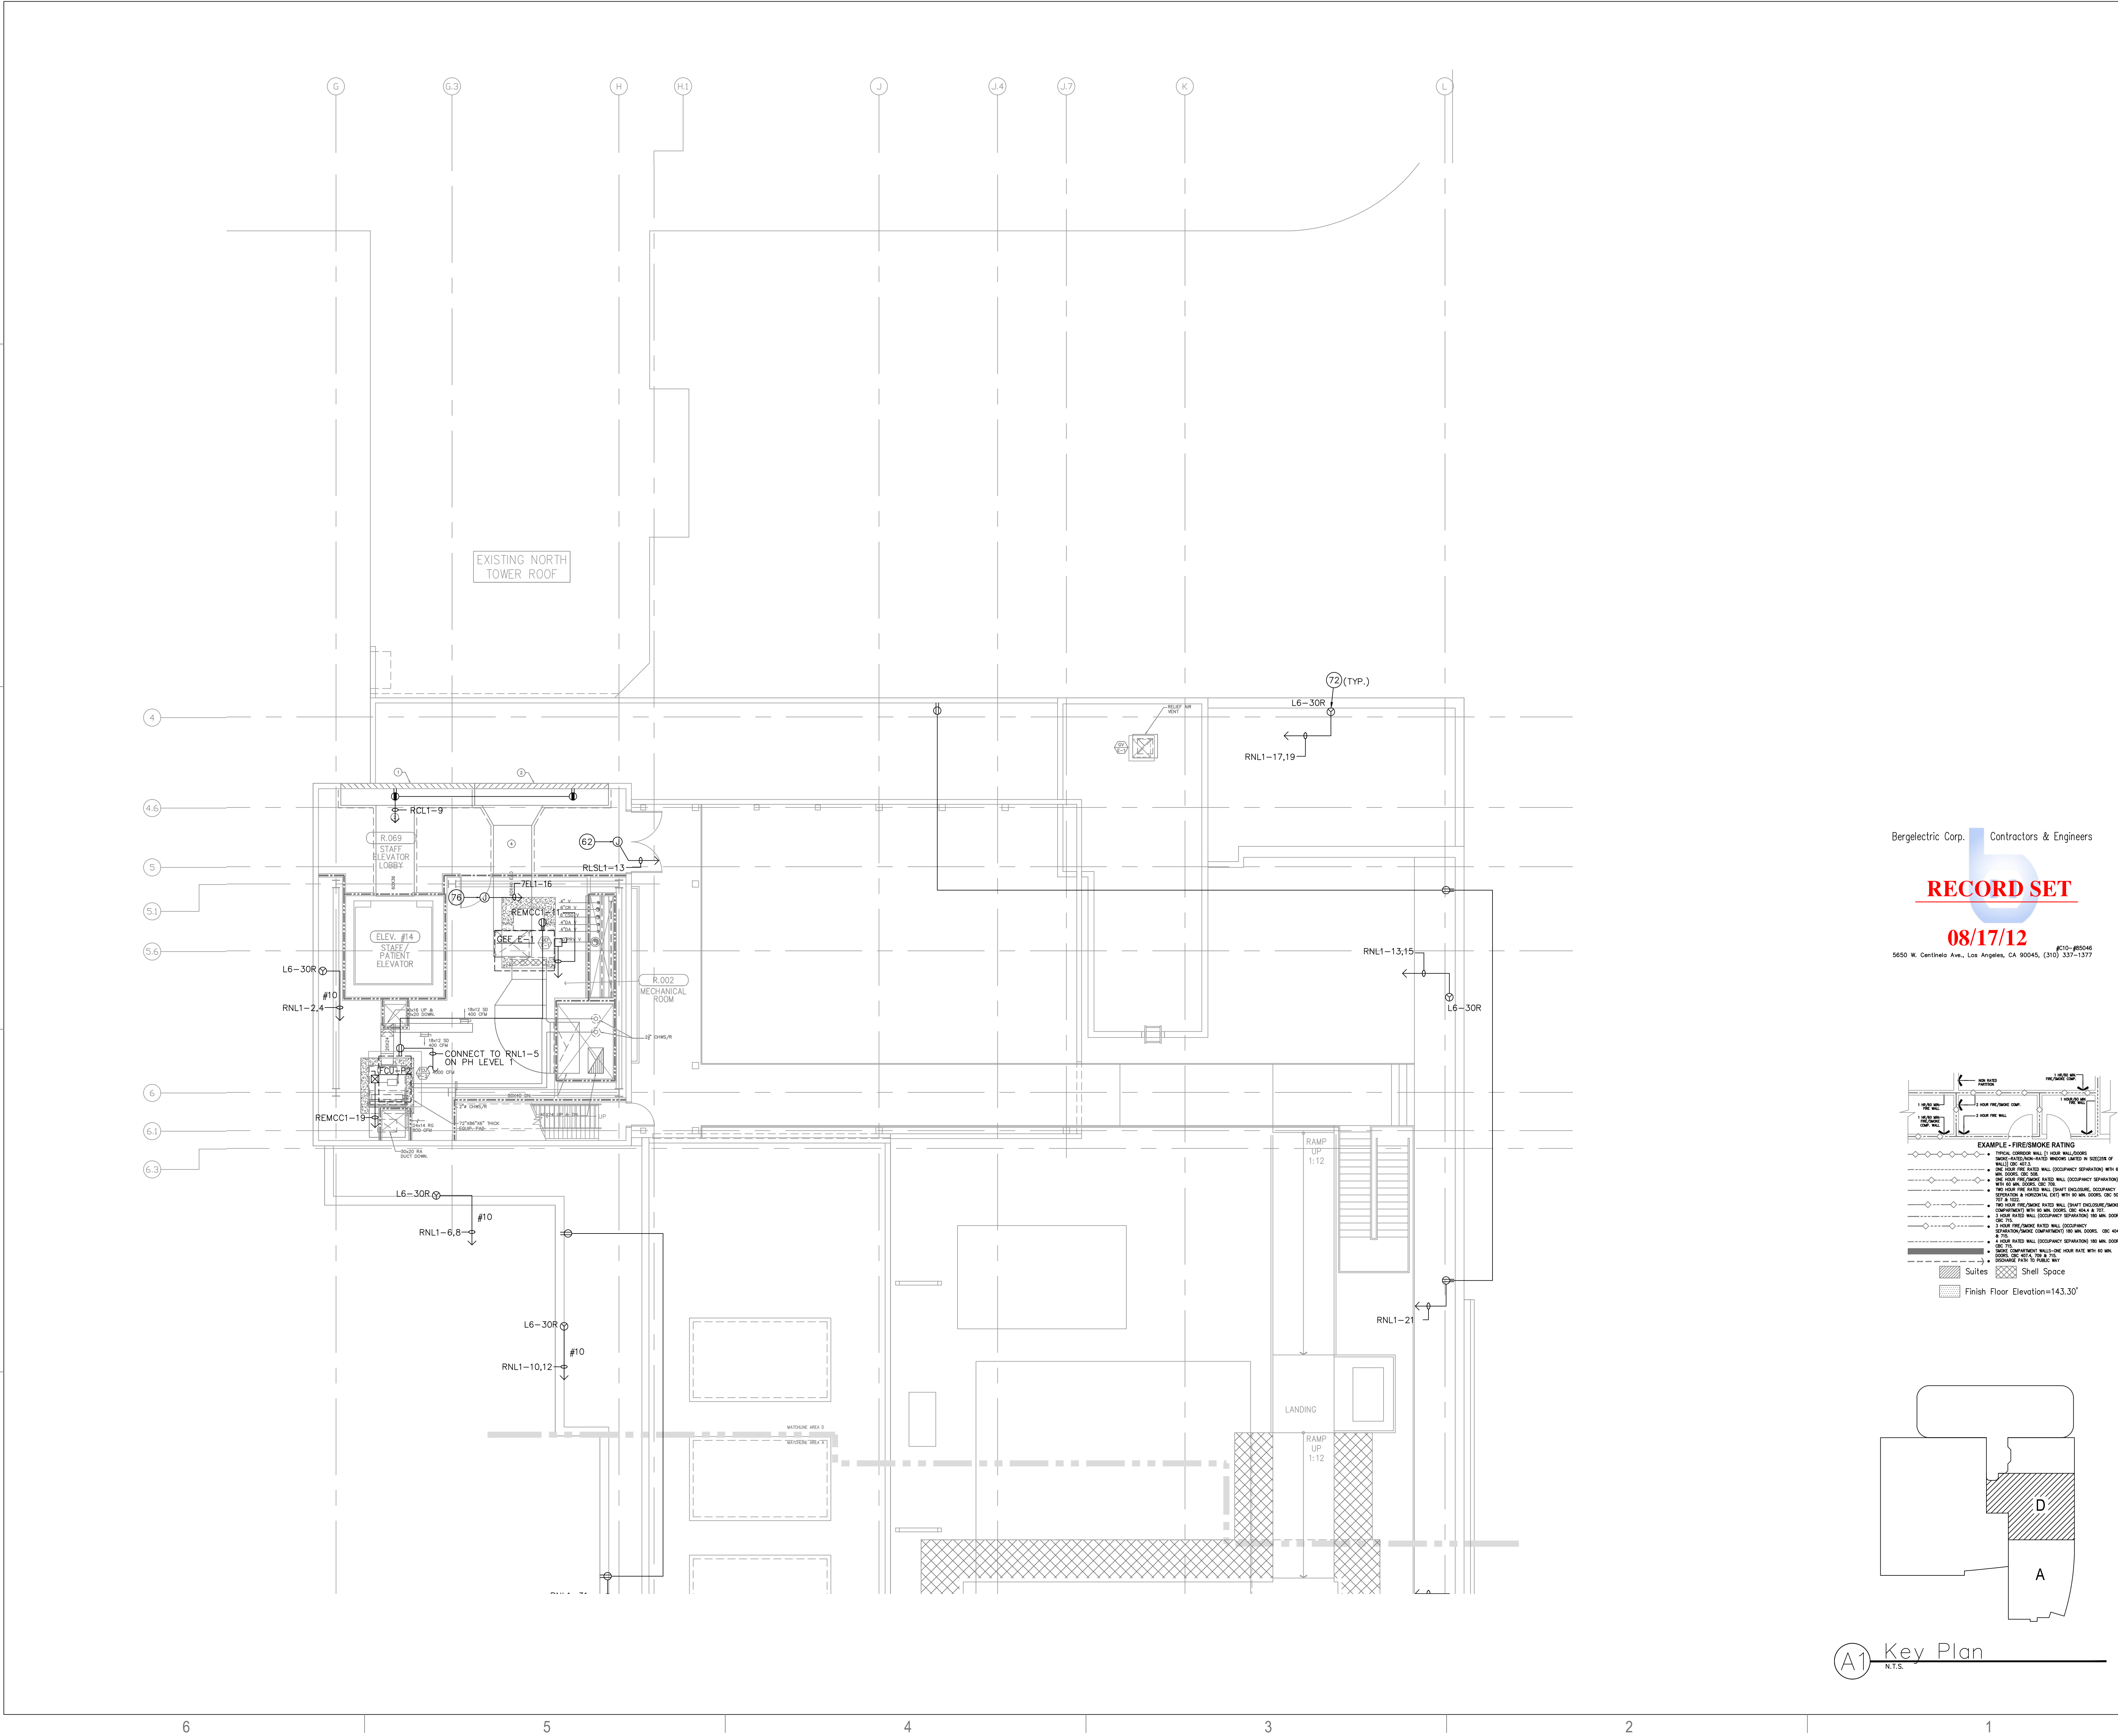

A1 Key Plan
N.T.S.