


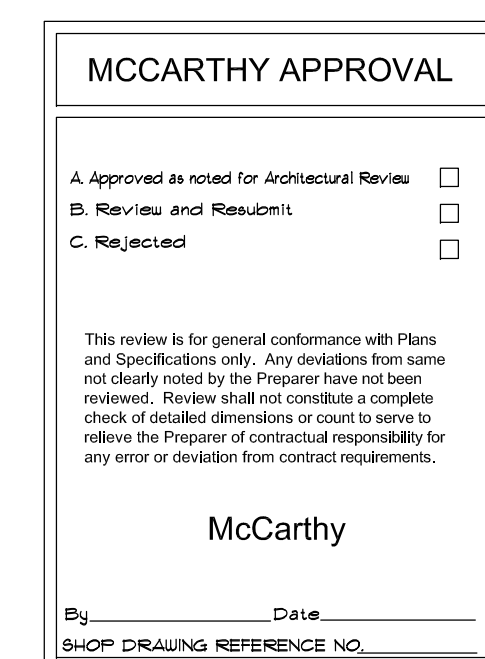

DATE: 12-1-09	
SCALE: 1/4"=1'-0"	
DRAWN BY: P.F.	
JOB NO. LC-7196	
SHEET NO. FP-7.G	

COSCO

Fire Protection

FIRE PROTECTION AND LIFE SAFETY SPECIALISTS

CALIFORNIA C-6 LIC. # 379021
LOS ANGELES COUNTY OFFICE
Orange, California 92685
call (714) 794-8351

ORANGE COUNTY OFFICE
Orange, California 92685
call (714) 794-8378 • Fax (714) 794-3451

SAN DIEGO OFFICE
San Diego, CA 92108 • call (619) 581-0764

SAN JOSE OFFICE
San Jose, CA 95128 • call (415) 281-0764

SAN FRANCISCO OFFICE
San Francisco, CA 94103 • call (415) 381-0764

SAN ANTONIO OFFICE
San Antonio, TX 78204 • call (214) 348-0764

DALLAS OFFICE
Dallas, TX 75201 • call (214) 348-0764

AUSTIN OFFICE
Austin, TX 78701 • call (512) 348-0764

HOUSTON OFFICE
Houston, TX 77002 • call (713) 348-0764

MILWAUKEE OFFICE
Milwaukee, WI 53201 • call (414) 348-0764

CHICAGO OFFICE
Chicago, IL 60601 • call (312) 348-0764

INDIANAPOLIS OFFICE
Indianapolis, IN 46201 • call (317) 348-0764

KANSAS CITY OFFICE
Kansas City, MO 64101 • call (816) 348-0764

ST. LOUIS OFFICE
St. Louis, MO 63101 • call (314) 348-0764

PHOENIX OFFICE
Phoenix, AZ 85001 • call (602) 348-0764

TAMPA OFFICE
Tampa, FL 33601 • call (813) 348-0764

JACKSONVILLE OFFICE
Jacksonville, FL 32201 • call (904) 348-0764

MEMPHIS OFFICE
Memphis, TN 38101 • call (901) 348-0764

BIRMINGHAM OFFICE
Birmingham, AL 35201 • call (205) 348-0764

ATLANTA OFFICE
Atlanta, GA 30301 • call (404) 348-0764

NEW YORK OFFICE
New York, NY 10001 • call (212) 348-0764

WASHINGTON D.C. OFFICE
Washington, DC 20001 • call (202) 348-0764

PORTLAND OFFICE
Portland, OR 97201 • call (503) 348-0764


SEATTLE OFFICE
Seattle, WA 98101 • call (206) 348-0764

PACIFIC NORTHWEST OFFICE
Tacoma, WA 98401 • call (206) 348-0764

HONOLULU OFFICE
Honolulu, HI 96801 • call (808) 348-0764

SAFETY EQUIPMENT
Call (800) 348-0764 for more information.


WE'VE GOT YOU COVERED!

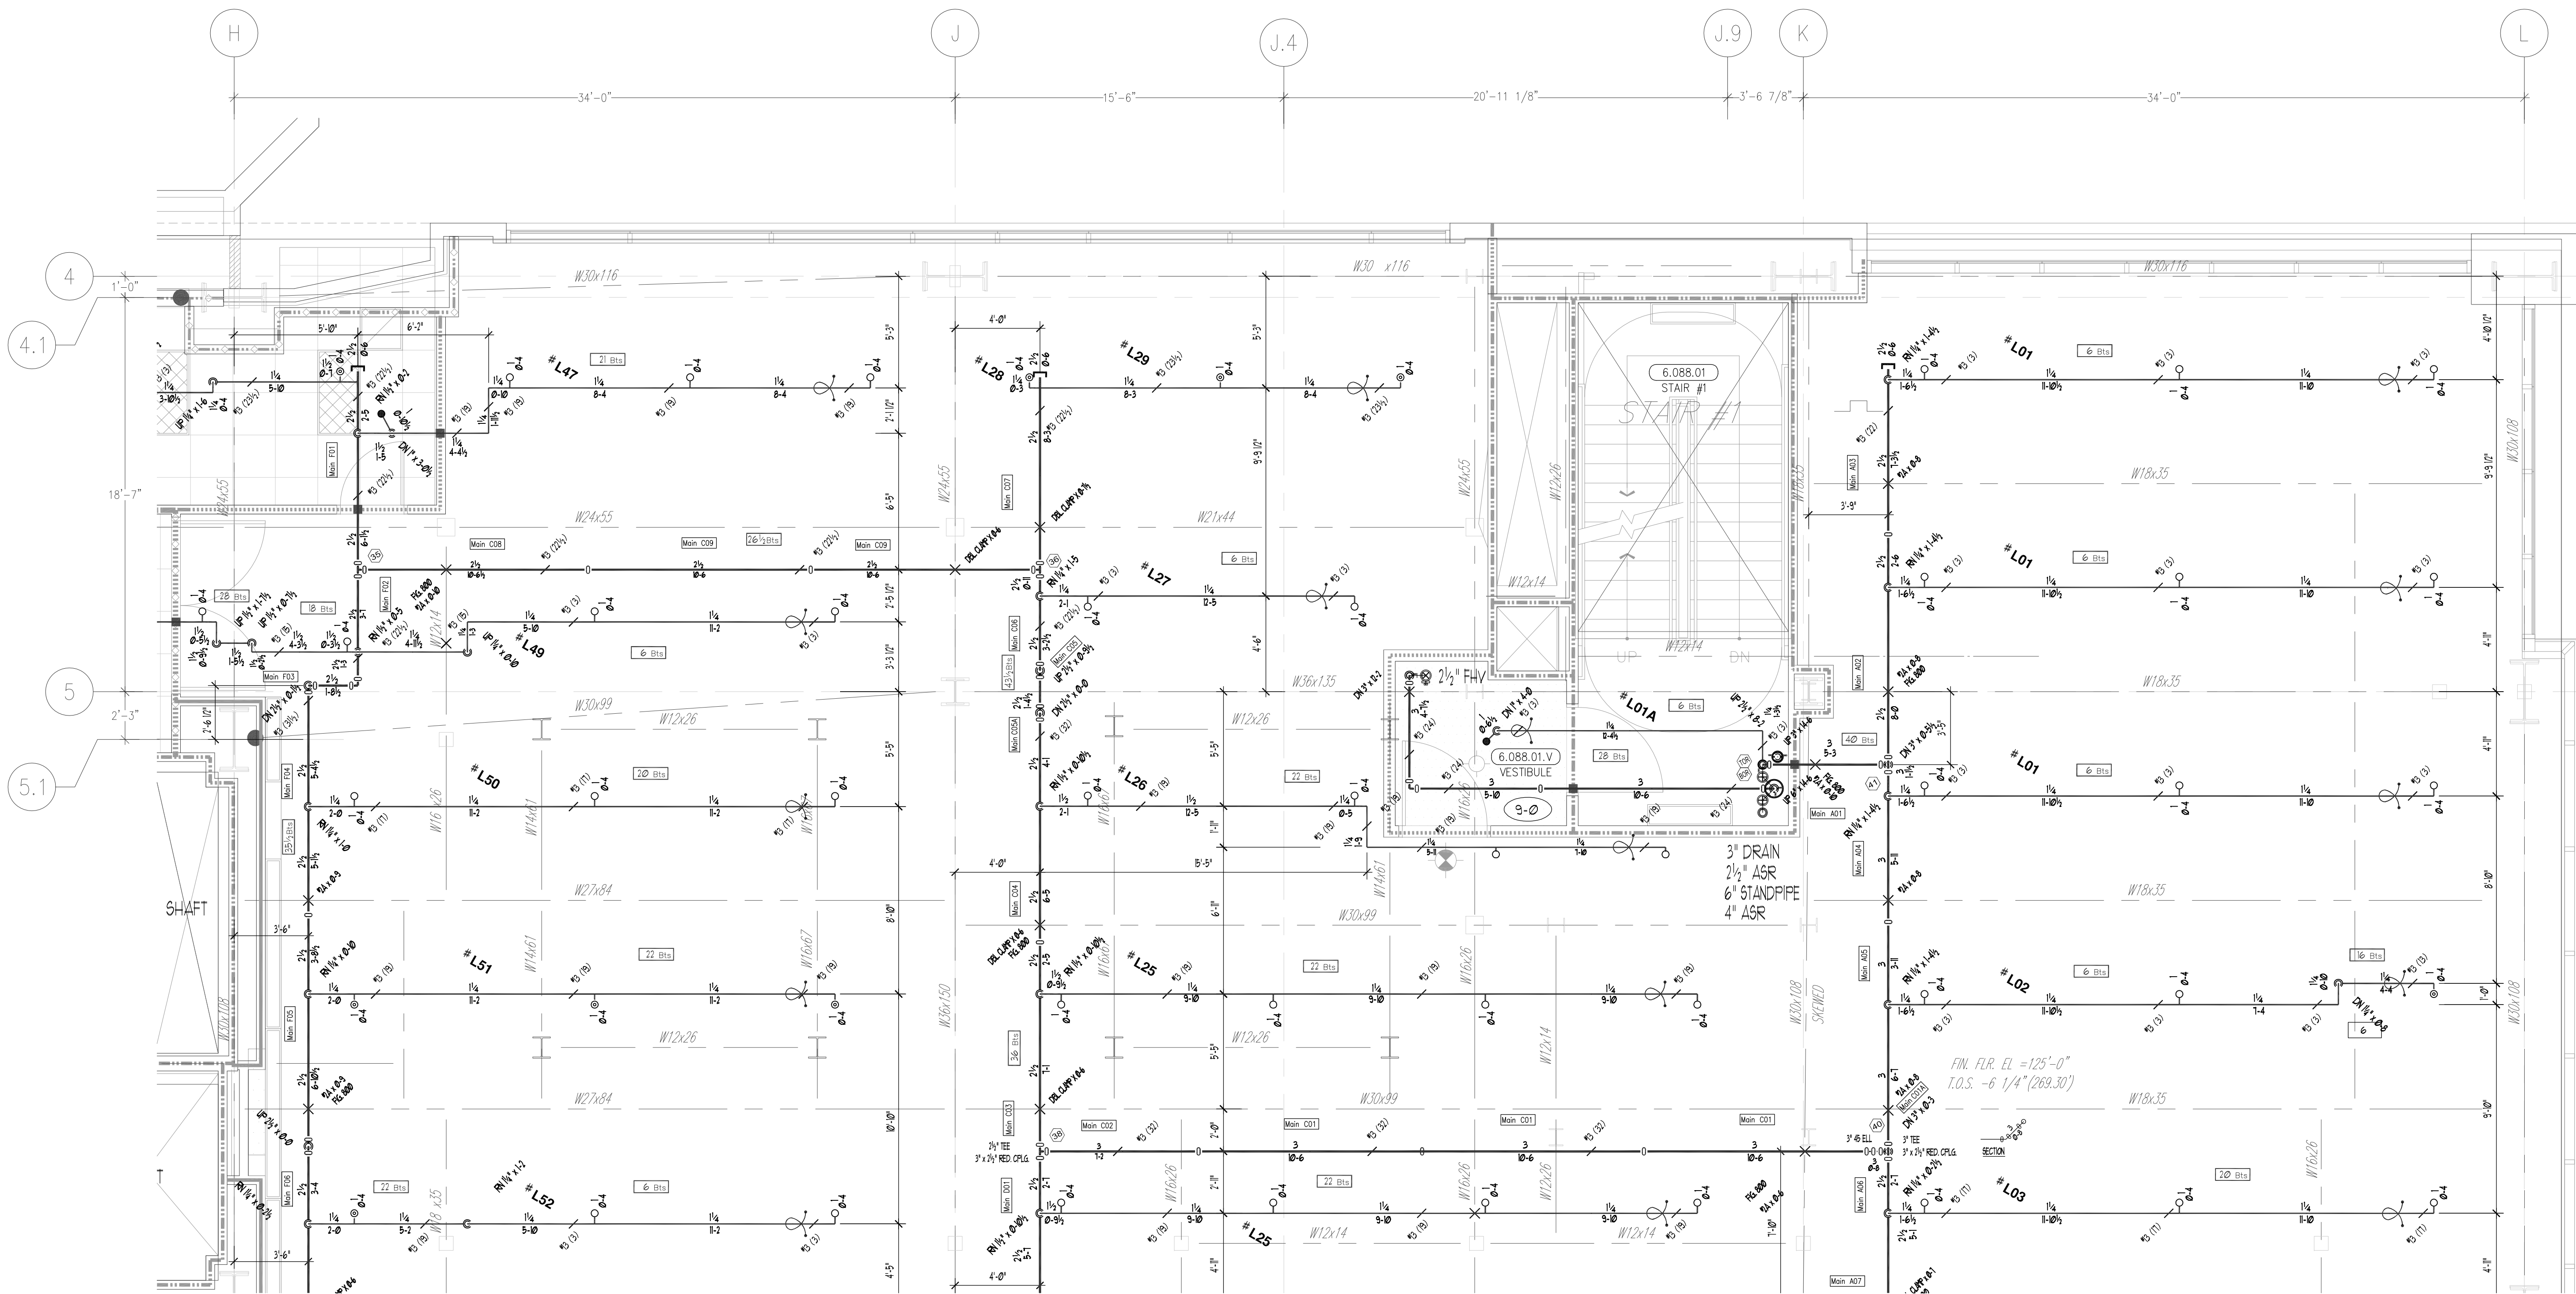

SYSTEM RISER RECAP

TOTAL SQUARE FOOTAGE
FOR THIS SYSTEM: 28,672

TOTAL HEAD COUNT
FOR THIS SYSTEM: 299

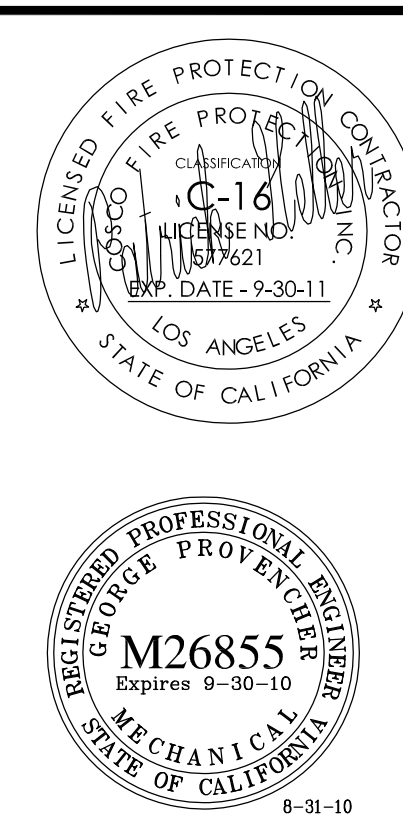

NO.	DESCRIPTION	DATE	BY
0	CONTO INCREMENT 7C SUBMITTAL	12-1-09	P.F.
1	OSHPD BACKCHECK #1	3-1-10	P.F.
2	OSHPD BACKCHECK #2	7-15-10	P.F.

SYMBOL	SN	OFFICE	WPT	K-FACT	HEAD	FINISH	WTP	QUAN.
Wing Microdot GR SSP Concealed Pendant	•	VI462	1/2"	1/2"	5.6	Brass	White	150"
Wing Microdot GR SSP Concealed Pendant	•	VI464	3/4"	3/4"	8.0	Brass	White	150"
Wing Microdot GR SSP Pendant	•	VI300	1/2"	1/2"	5.6	Brass	White	200"
Wing Microdot GR SSP Pendant	•	VI302	1/2"	1/2"	5.6	Brass	White	200"
Wing Microdot GR SSP Pendant	•	VI303	1/2"	1/2"	5.6	Brass	White	200"
Wing Microdot GR SSP Pendant	•	VI305	1/2"	1/2"	5.6	Brass	White	200"

COSCO Fire Protection
FIRE PROTECTION AND LIFE SAFETY SPECIALISTS
LOS ANGELES COUNTY OFFICE
321 East Coastway Boulevard
San Jose, CA 95128
call (408) 933-8211 or (408) 933-8212
SAN JOSE • LOS ANGELES • FRESNO • SAN FRANCISCO • SACRAMENTO • PORTLAND • SEATTLE • ANCHORAGE

MCCARTHY APPROVAL

A. Approved as noted for Architectural Review ☐
B. Review and Re-submit ☐
C. Rejected ☐

This review is for general conformance with Plans and Specifications only. Any deviations from plans or specifications shall be noted on the drawings and not be used for construction. Review shall not constitute a complete check of installed equipment or work to be done to relieve the Designer of contractual responsibility for any error or deviation from contract requirements.

McCarthy


By: _____ Date: _____
B-OP DRAWING REFERENCE NO. _____

SYMBOL IDENTIFICATION LEGEND


- LINE RESTRAINT
- FIRE STOPPING THROUGH RATED WALL
- CALCULATION DESIGN AREA
- HYDRAULIC CALCULATION NODE
- CENTERLINE OF PIPE BELOW TOP OF STEEL
- CENTERLINE OF PIPE ABOVE FINISH FLOOR
- CENTERLINE OF PIPE BELOW DECK (SAME AS TOP OF STEEL)
- CENTERLINE OF PIPE ABOVE FINISH FLOOR
- RIGID GROOVED PIPE COUPLING (UNLESS NOTED AS FLEXIBLE)
- PIPE HANGER TO CONCRETE
- PIPE HANGER TO STEEL
- CEILING HEIGHT

CEILING HEIGHT WILL TYPICALLY BE 9'-0", UNLESS OTHERWISE NOTED ON THE PLAN.

AS BUILT DRAWING
9-1-2011
Pat Fisher

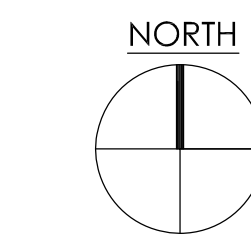

LEVEL 06 239.30' = 0'-0"
REFERENCE THIS SHEET

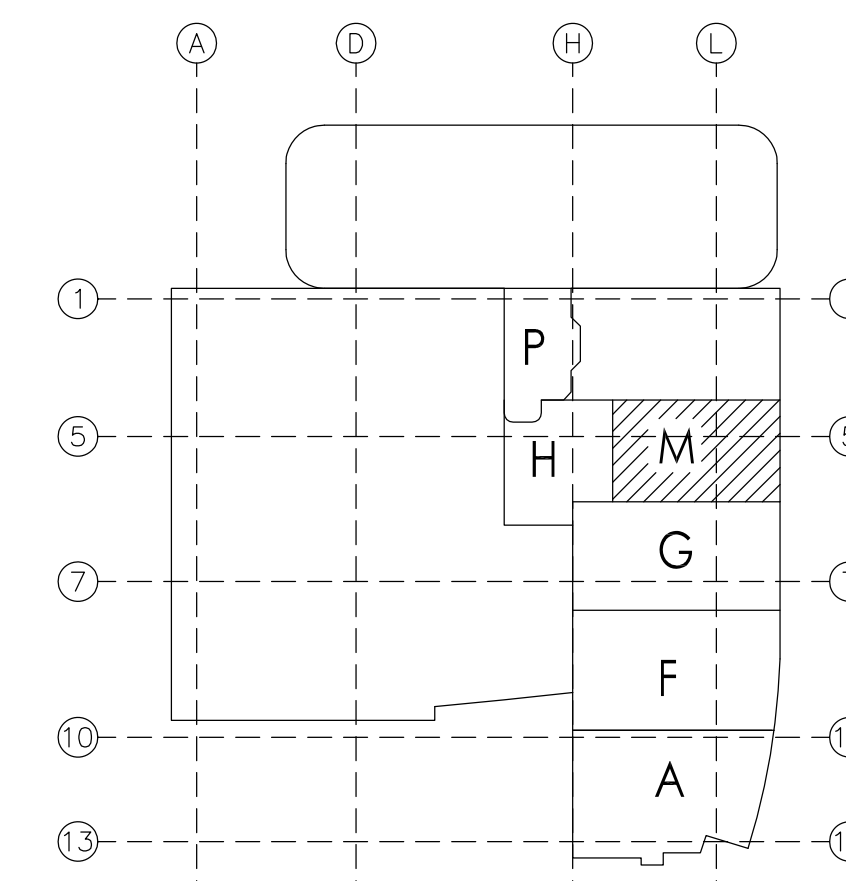

OSHPD No.: IL-072072-30 / INCREMENT #7C - DA#16

PROJECT: CHOC Hospital
255 S. Main St.
Orange, CA 92668
CONTRACT WITH: McCarthy
20401 Southwest Birch St, Suite 300
Newport Beach, CA 92660
DRAWING TITLE: Level 7 - Area M

DATE: 12-1-09
SCALE: 1/4"=1'-0"
DRAWN BY: P.F.
JOB NO.: LC-7196
SHEET NO.: FP-7.M
2