

CHILDREN'S HOSPITAL OF ORANGE COUNTY

Customer- McCarthy Building Co.

**INTERIOR SIGNAGE &
5 STORY GARAGE SIGNAGE**

Designer- Formation

Fabrication & Installation - Vomar Products, Inc.

48765

- 1 Per Site Meeting
Jan. 9, 2010
- 2 Per RFI 2133-0
Sep. 03, 2010
- 3 Per Exterior Signage
Resubmittal Comments
Dec. 9, 2010
- 4 Per ASI #34
Oct. 15, 2010
- 5 Per Submittal 010400-0001-1
Dec. 21, 2010
- 6 Per RFI 4494-0
Oct. 13, 2011
- 7 Per RFI 3003 R2
Jan. 16, 2012
- 8 Per ASI 129
Jan. 16, 2012
- 9 Per RFI 3003 R2
Feb. 23, 2012
- 10 Per ASI 183 \ 171
March 16, 2012
- 11 Per ASI 180
March 16, 2012
- 12 Per RFI #5698
April 30, 2012
- 13 Per Sample Review
May 4, 2012

Drawings approved by 

- ☐ submit for approval / / 12
- ☐ resubmit for approval / / 12
- ☒ release for fabrication 5/15 12

PROJECT TYPEFACES & ARTWORK

New Century Schoolbook Roman

ABCDEFGHIJKLMNOPQRSTUVWXYZ

abcdefghijklmnopqrstuvwxyz

1234567890

Avenir 85 Heavy

ABCDEFGHIJKLMNOPQRSTUVWXYZ

abcdefghijklmnopqrstuvwxyz

1234567890

Avenir 65 Medium

ABCDEFGHIJKLMNOPQRSTUVWXYZ

abcdefghijklmnopqrstuvwxyz

1234567890

Avenir 35 Light

ABCDEFGHIJKLMNOPQRSTUVWXYZ

abcdefghijklmnopqrstuvwxyz

1234567890

 **CHOC Children's**

 CHOC Children's



Men



Women




Restroom



Fire Extinguisher



Accessibility

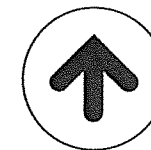


Project Arrow



Information



Elevator

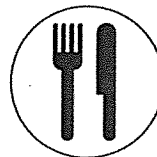

Dining



Restroom




Changing




Gift Shop




Resource Library

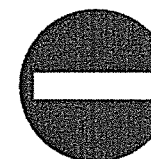

Do Not Enter

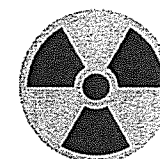


Radiation

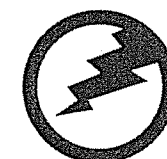

High Voltage



Biohazard

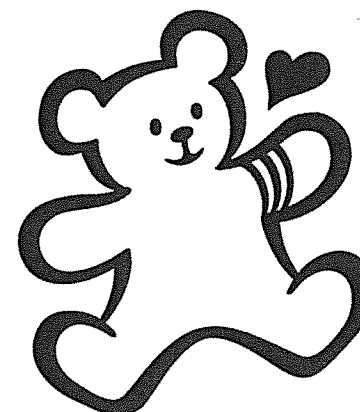

Invoice Number: 48765

Fabrication Drawing

Project
CHILDREN'S HOSPITAL OF
ORANGE COUNTY

Customer
McCARTHY BUILDING CO.
ATT: JAMES BURGGRAF
20401 S.W. BIRCH ST.
NEWPORT BEACH, CA 92660


Designers
FORMATION

Order Item:

Sign Type:

Revision No.:

Drawn By: MWilliams

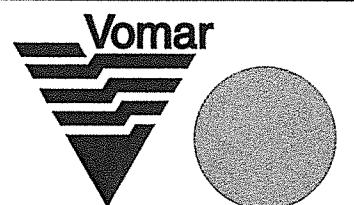

Vomar Products, Inc.
7800 Deering Avenue
Canoga Park, CA 91304-5005
Tel: 818-610-5115
Fax: 818-610-5123
E-Mail: info@vomarproducts.com

Sheet Date: 05/20/10

Sheet Number G-2

PROJECT COLORS & GENERAL NOTES

PAINT COLORS

- (P1) PMS Black Matte
- (P2) Matte White
- (P3) Yellow (TBD) Matte
- (P4) Red (TBD) Matte
- (P5) Dark Gray - PMS Cool Gray 11
- (P6) Gray - PMS Cool Gray 6
- (P7) Medium Gray - PMS Cool Gray 2
- (P8) Light Gray - PMS Cool Gray 1
- (P9) Blue - PMS 660C
- (P10) Cyan - Circle Bear Logo PMS 659

GARAGE LEVEL COLORS

- (P11) Level 1 - Blue - PMS 2945U
- (P12) Level 2 - Orange - PMS 021C
- (P13) Level 3 - Green - PMS 369C
- (P14) Level 4 - Yellow - PMS 122C
- (P15) Level 5 - Red - PMS 1805C

INTERIOR LEVEL COLORS

- (P16) Level 1 - To Match Frazee Copper Springs 8244D
- (P17) Level 2 - To Match Frazee Stars Forever 7066N
- (P18) Level 3 - To Match Frazee Mikada 7346A
- (P19) Level 4 - To Match Frazee Dried Basil 7674D
- (P20) Level 5 - To Match Benjamin Moore Yosemite Blue 2059-40
- (P21) Level 6 - To Match Sherwin Williams Juneberry Flat 6573
- (P22) Level 7 - To Match Frazee Regal CL2477N

DONOR WALL 3FORM COLORS

- (M1) Color to match 3Form Bliss
- (M2) Color to match 3Form Surf
- (M3) Color to match 3Form Flood
- (M4) Color to match 3Form Sea

Invoice Number: 48765

Fabrication Drawing

Project
CHILDREN'S HOSPITAL OF
ORANGE COUNTY

Customer
McCARTHY BUILDING CO.
ATT: JAMES BURGGRAF
20401 S.W. BIRCH ST.
NEWPORT BEACH, CA 92660


Designers
FORMATION

Order Item:

Sign Type:

Revision No.:

Drawn By: MWilliams

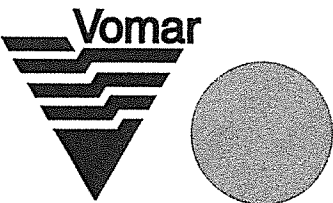

Vomar Products, Inc.
7800 Deering Avenue
Canoga Park, CA 91304-5005
Tel: 818-610-5115
Fax: 818-610-5123
E-Mail: info@vomarproducts.com

Sheet Date: 05/20/10

Sheet Number G-3

13




4



5

Sheet Number 1.0

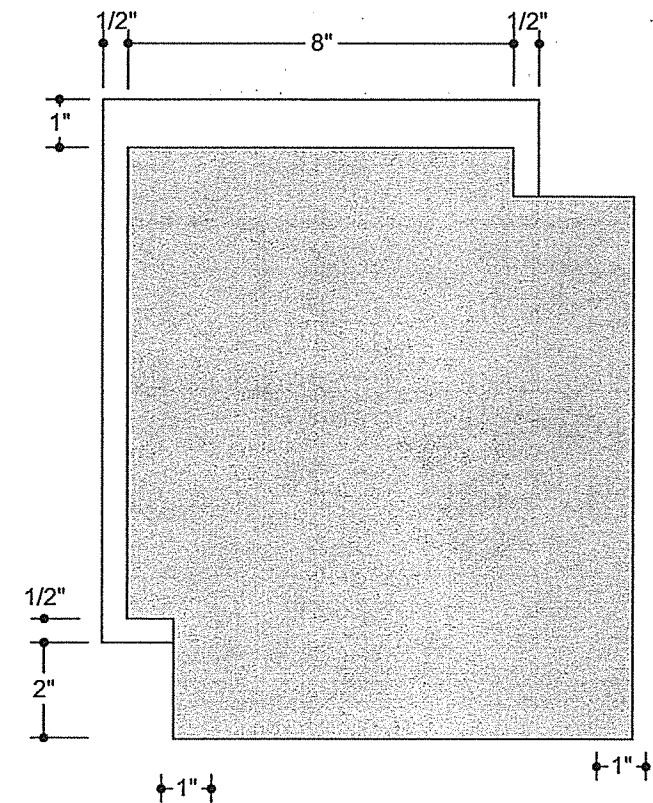

①

②

3

Fabrication Drawing

Project
CHILDREN'S HOSPITAL OF
ORANGE COUNTY

Customer
McCARTHY BUILDING CO.
ATT: JAMES BURGGRAF
20401 S.W. BIRCH ST.
NEWPORT BEACH, CA 92660

Designers
FORMATION

Order Item: 1


Sign Type: PRI

Revision No.:

10 Per ASI 183
March 16, 2012

13 Per Sample Review
May 4, 2012



Drawn By: MWilliams

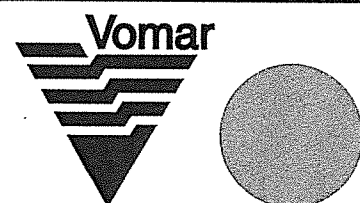


Vomar Products, Inc.
7800 Deering Avenue
Canoga Park, CA 91304-5005
Tel: 818-610-5115
Fax: 818-610-5123
E-Mail: info@vomarproducts.com


Sheet Date: 05/20/10

Sheet Number 1.1

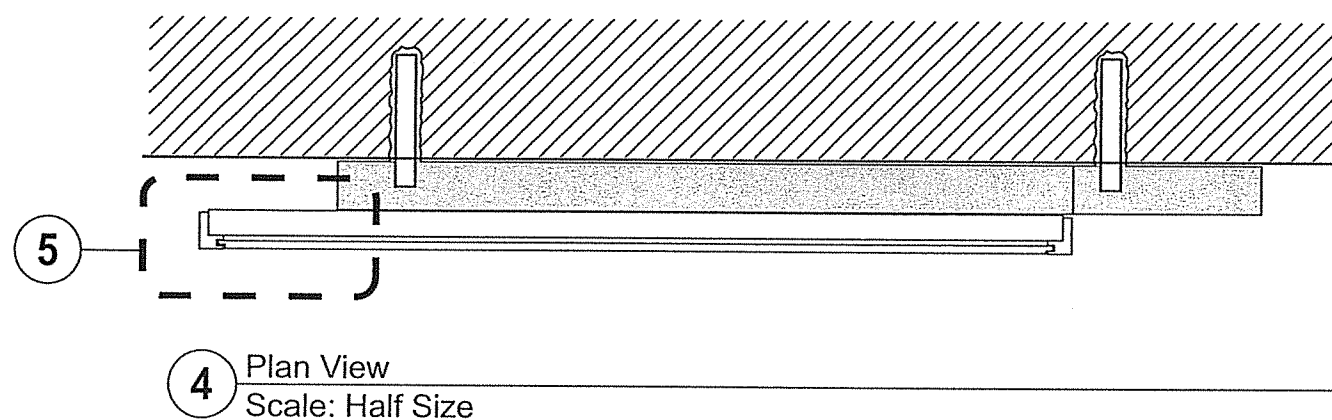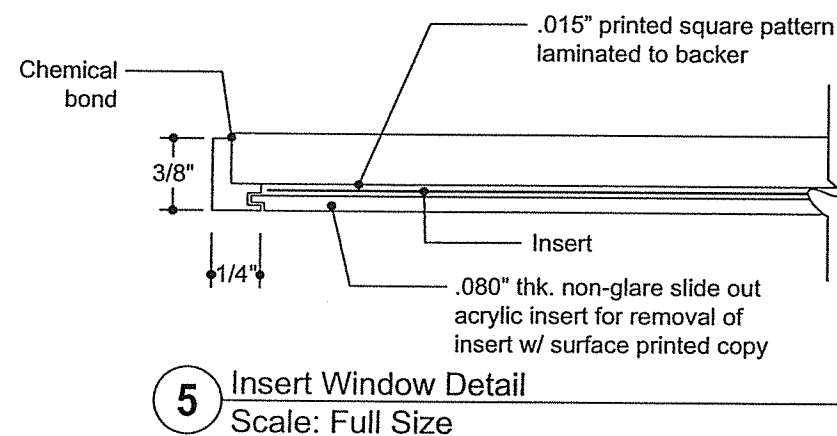


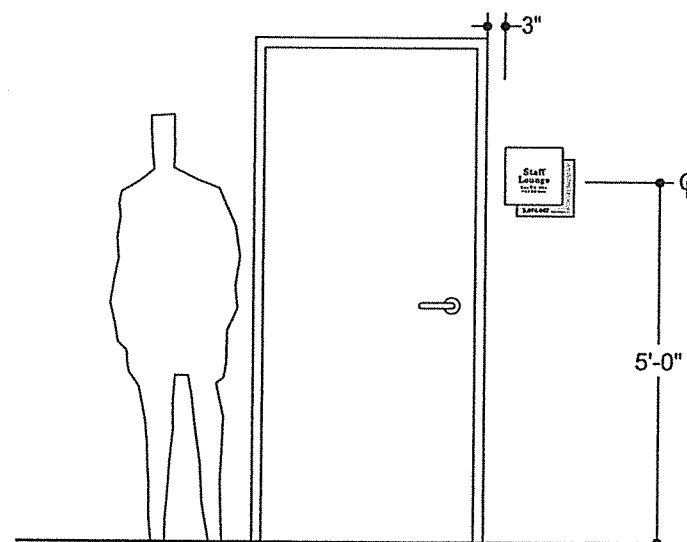

4 Front Elevation
Scale: 3/8" = 1'-0"

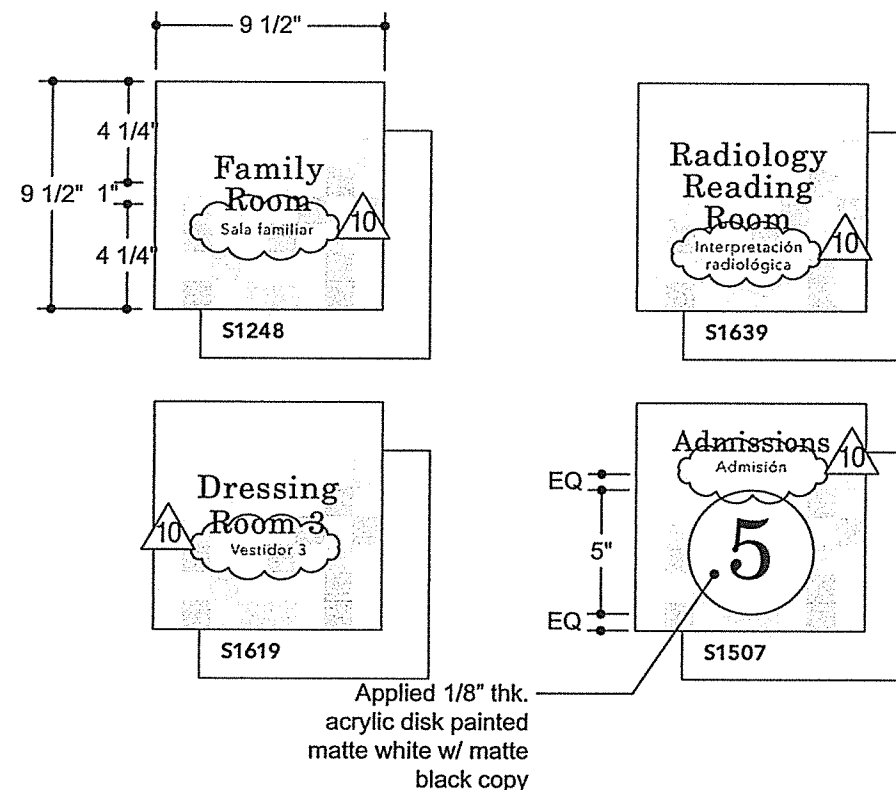


5 Copy Layout
Scale: 1 1/2" = 1'-0"

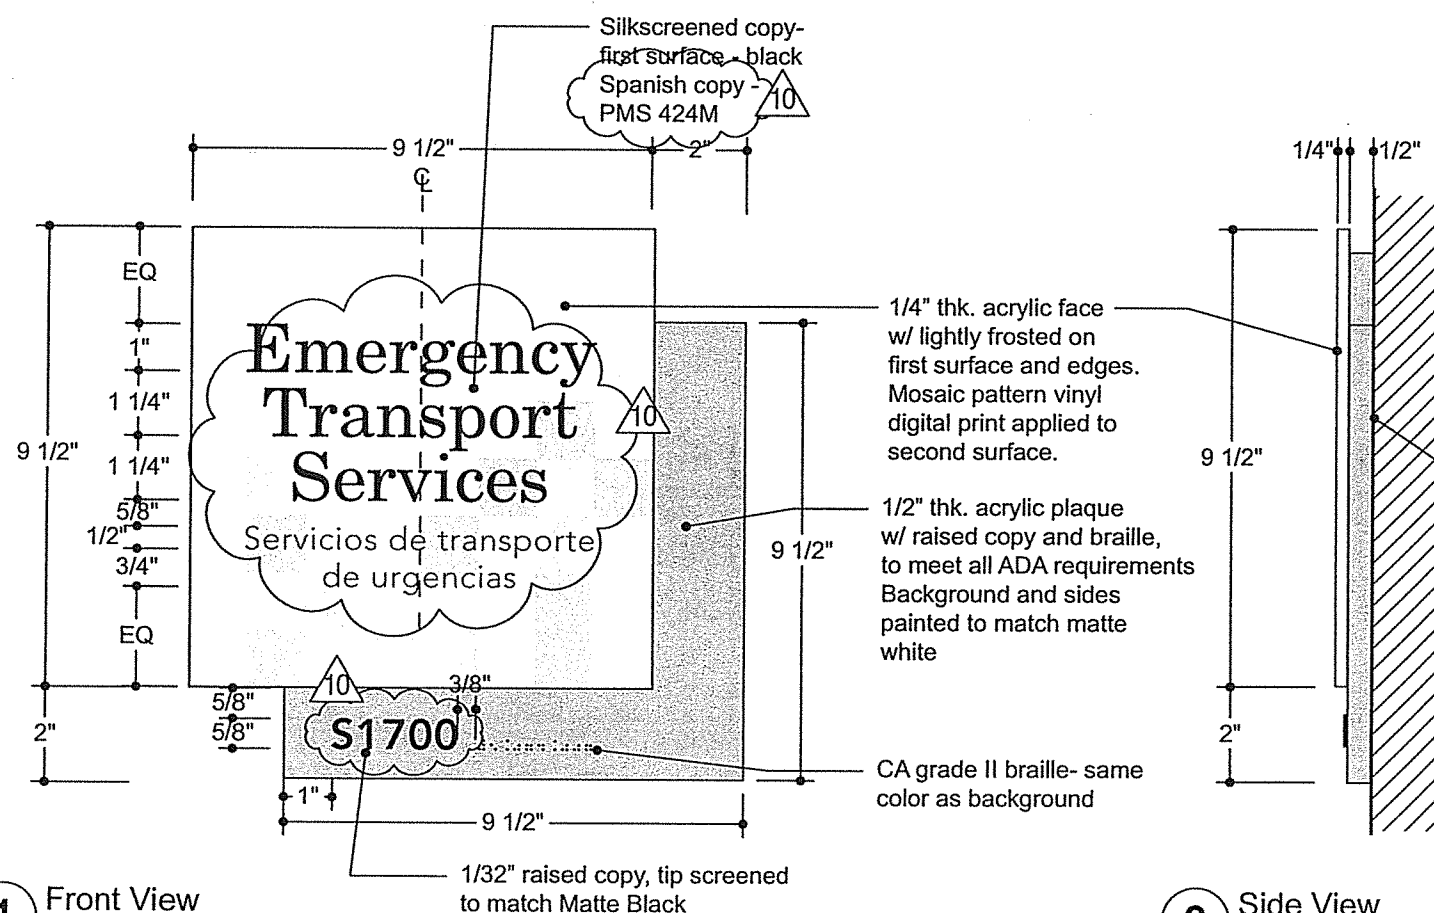

1 Front View
Scale: 3" = 1'-0"

2 Side View
Scale: 3" = 1'-0"

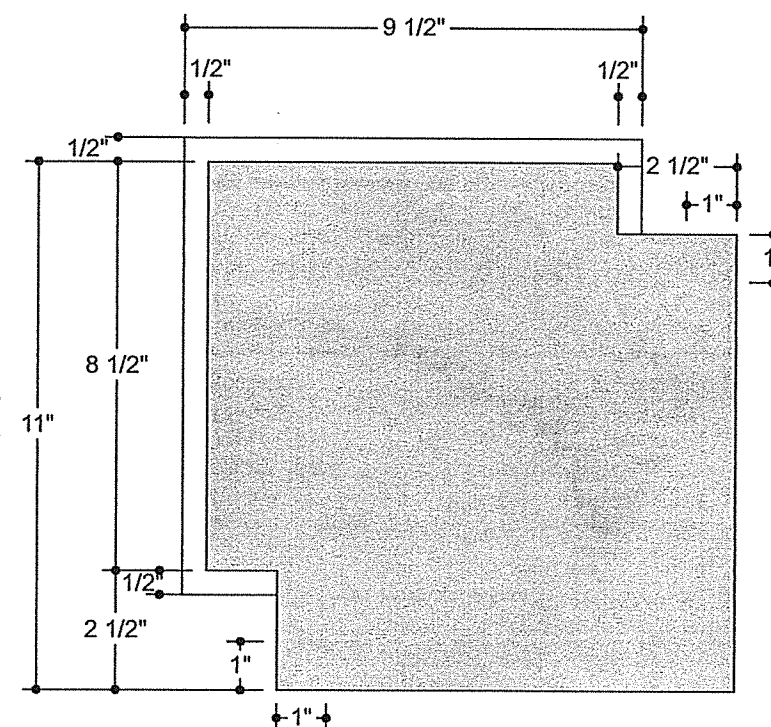

3 Back View
Scale: 3" = 1'-0"

ITEM NO. 2
SIGN TYPE RIP

QTY: 137 10

SIGN MATERIALS:
11 1/2" H X 11 1/2" W UNFRAMED
ACRYLIC PLAQUE W/ 1/4" THK.
ACRYLIC FACE PANEL AND FRONT
SURFACE SILKSCREENED COPY AND
1/2" THK. TACTILE BACKING W/
RAISED COPY & BRAILLE.

MOUNTING:
WALL SURFACE MOUNTED

COLOR/FINISH:
REFER ELEVATIONS

FONT:
AVENIR 85 HEAVY
AVENIR 35 LIGHT
NEW CENTURY SCHOOLBOOK
ROMAN

Invoice Number: 48765

Fabrication Drawing

Project
CHILDREN'S HOSPITAL OF
ORANGE COUNTY

Customer
McCARTHY BUILDING CO.
ATT: JAMES BURGGRAF
20401 S.W. BIRCH ST.
NEWPORT BEACH, CA 92660

Designers
FORMATION

Order Item: 2

Sign Type: RIP

Revision No.:

10 Per ASI 183

March 16, 2012

13 Per Sample Review

May 4, 2012

- GENERAL NOTES**
1. Eliminate visible adhesive @ rear acrylic and face acrylic perimeter.
 2. Mosaic pattern & BACK PAINT to be consistent & not chipped at edges.
 3. Paint at braille ball to be EVEN (Not indents in paint around balls)
 4. Upper acrylic to have smooth laser cut (sample had striations around perimeter).





Drawn By: MWilliams



Vomar Products, Inc.
7800 Deering Avenue
Canoga Park, CA 91304-5005
Tel: 818-610-5115
Fax: 818-610-5123
E-Mail: info@vomarproducts.com

Sheet Date: 05/20/10

Sheet Number 2.0

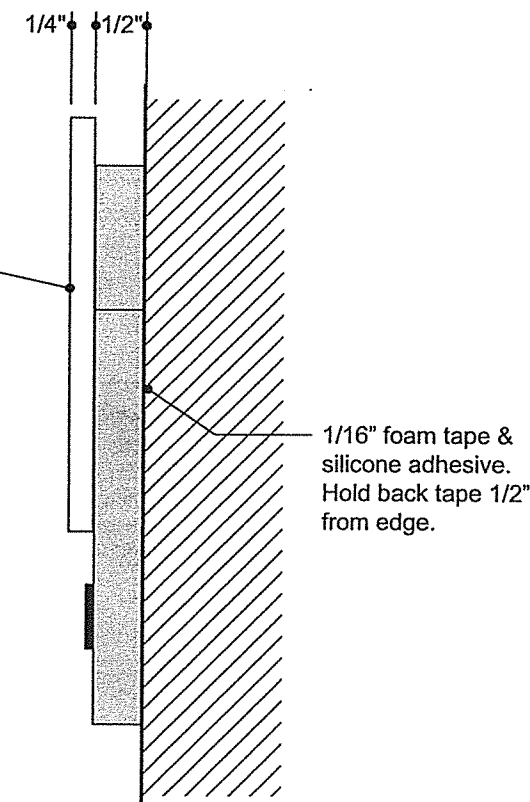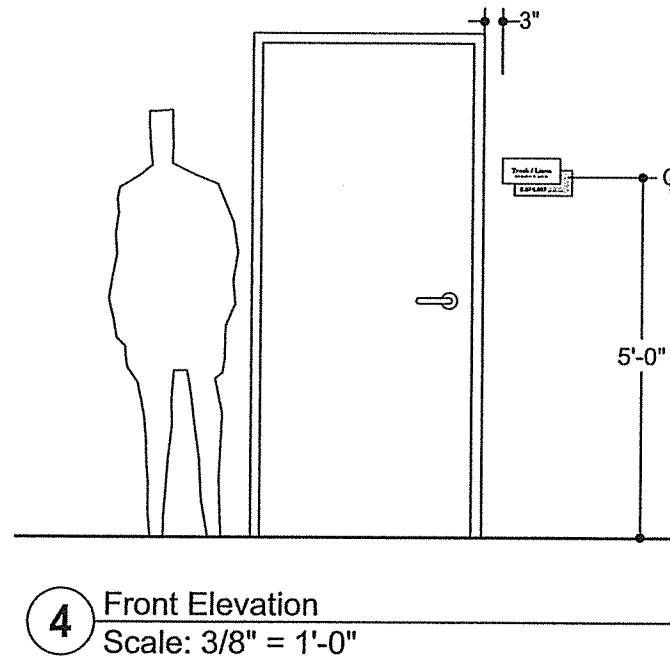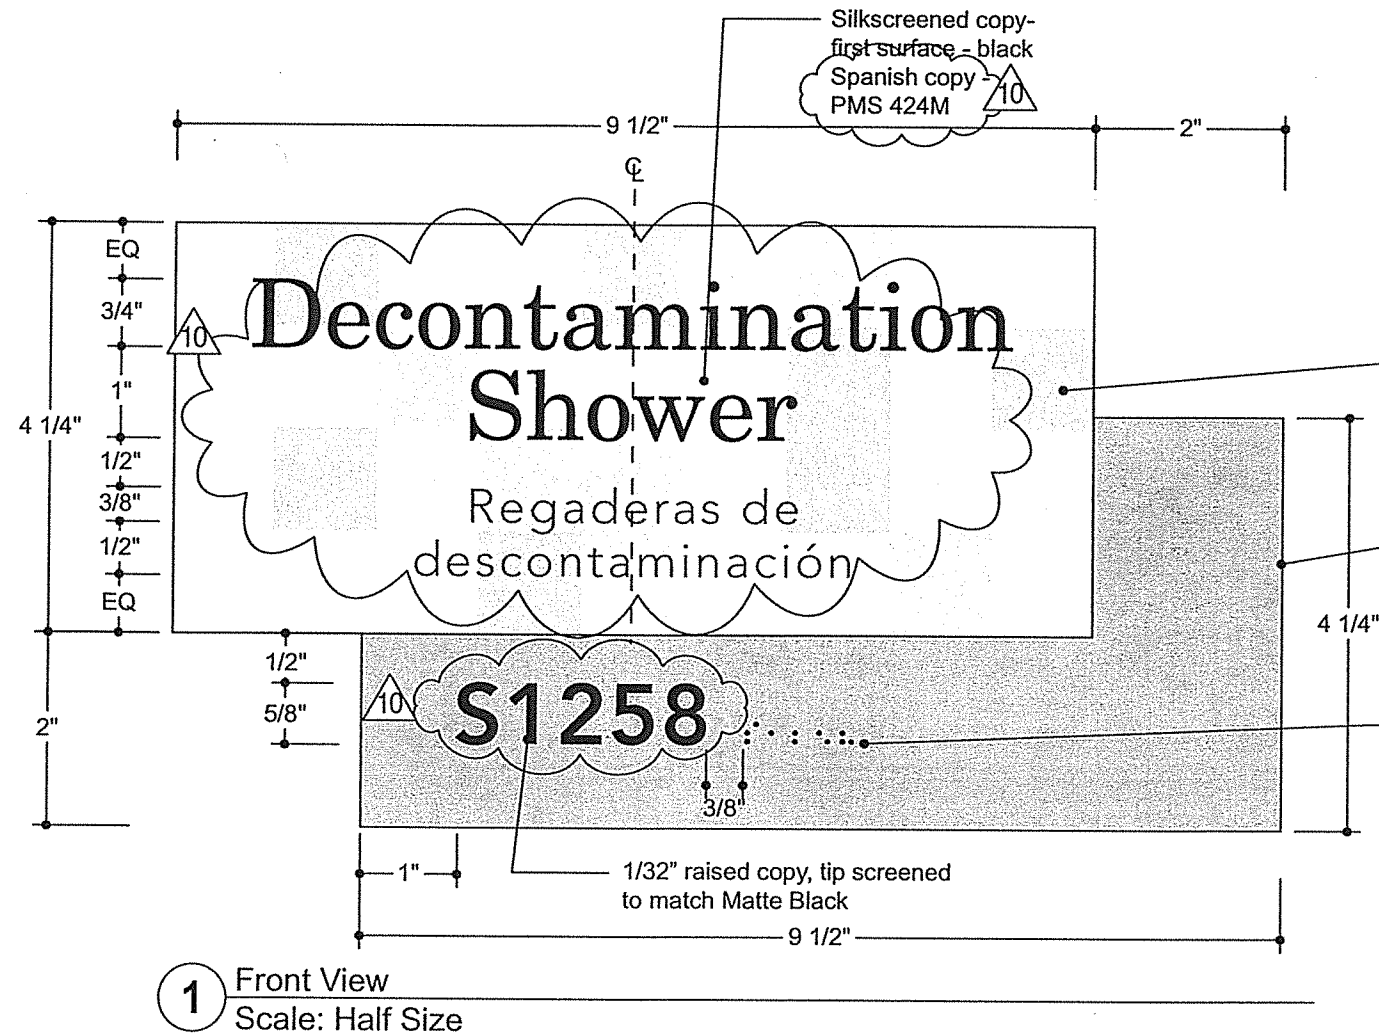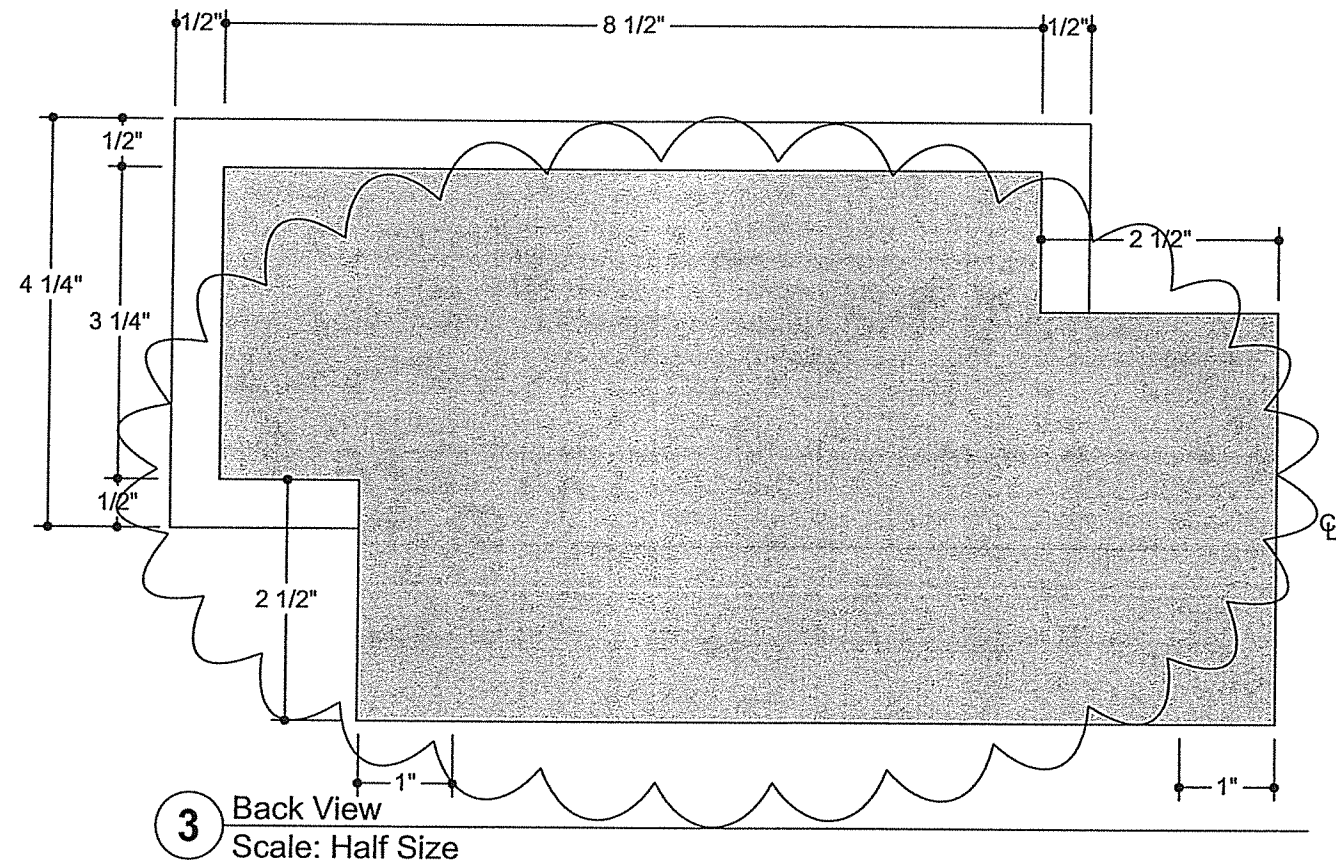

ITEM NO. 3
SIGN TYPE RIB-BOH

QTY: 316 / 10

SIGN MATERIALS:
6 1/4" H X 11 1/2" W UNFRAMED
ACRYLIC PLAQUE W/ 1/4" THK.
ACRYLIC FACE PANEL AND FRONT
SURFACE SILKSCREENED COPY AND
1/2" THK. TACTILE BACKING W/
RAISED COPY & BRAILLE.

MOUNTING:
WALL SURFACE MOUNTED

COLOR/FINISH:
REFER ELEVATIONS

FONT:
AVENIR 85 HEAVY
AVENIR 35 LIGHT
NEW CENTURY SCHOOLBOOK
ROMAN

Invoice Number: 48765

Fabrication Drawing

Project
CHILDREN'S HOSPITAL OF
ORANGE COUNTY

Customer
McCARTHY BUILDING CO.
ATT: JAMES BURGGRAF
20401 S.W. BIRCH ST.
NEWPORT BEACH, CA 92660

Designers
FORMATION

Order Item: 3

Sign Type: RIB-BOH

Revision No.:

10 Per ASI 183
March 16, 2012

13 Per Sample Review
May 4, 2012

GENERAL NOTES

1. Eliminate visible adhesive @ rear acrylic and face acrylic perimeter.
2. Mosaic pattern & BACK PAINT to be consistent & not chipped at edges.
3. Paint at braille ball to be EVEN (Not indents in paint around balls)
4. Upper acrylic to have smooth laser cut (sample had striations around perimeter).


Drawn By: MWilliams




Vomar Products, Inc.
7800 Deering Avenue
Canoga Park, CA 91304-5005
Tel: 818-610-5115
Fax: 818-610-5123
E-Mail: info@vomarproducts.com

Sheet Date: 05/20/10

Sheet Number 3.0

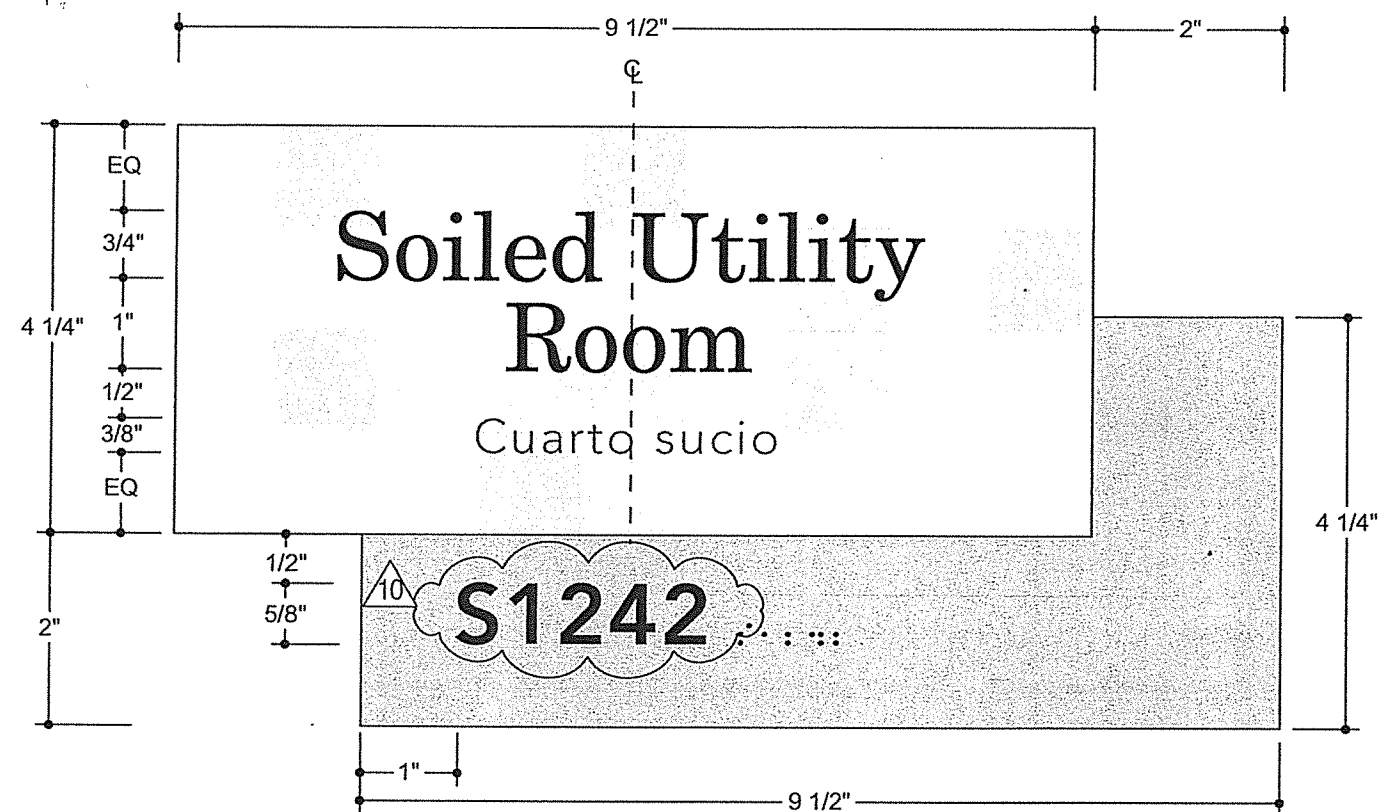

6 Front View
Scale: Half Size

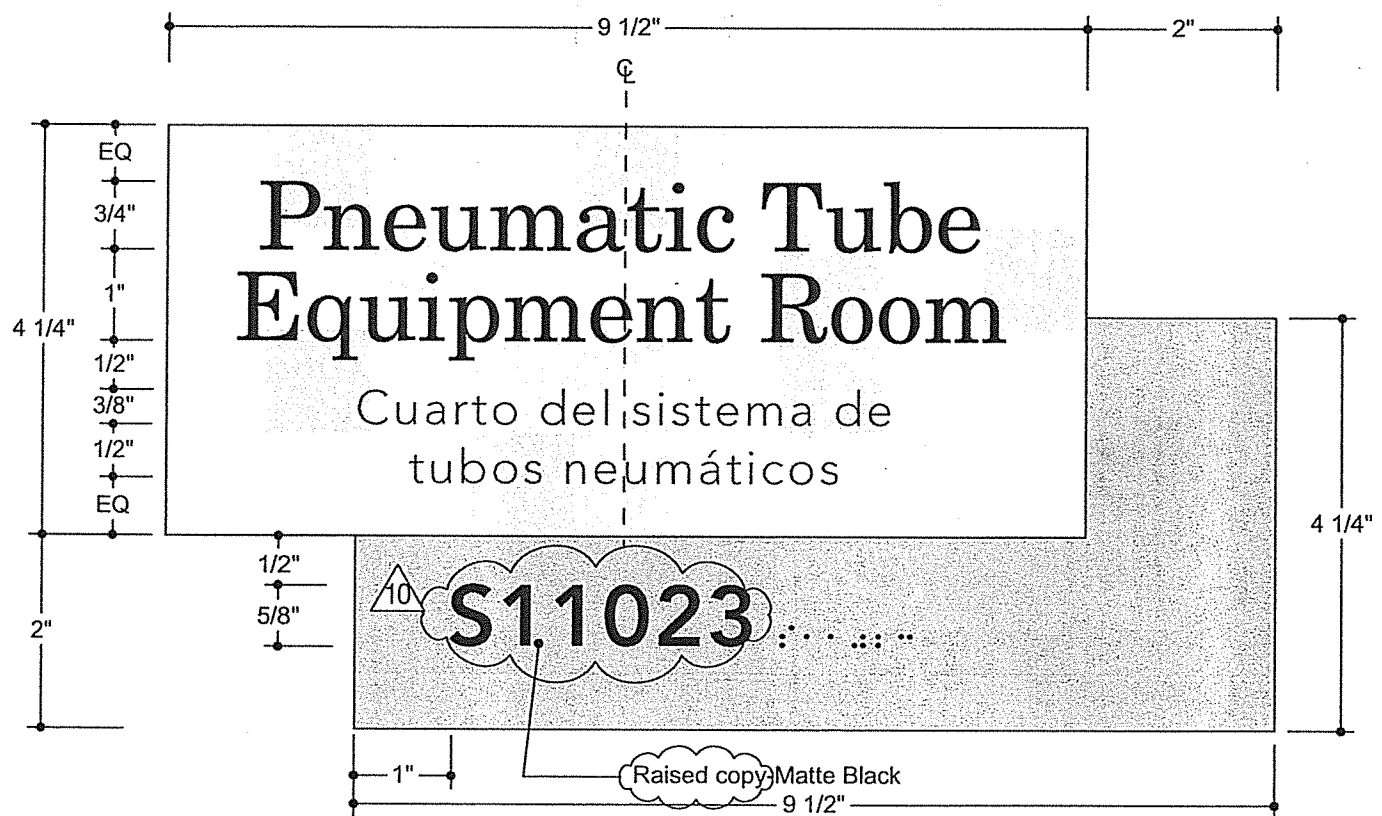

5 Front View
Scale: Half Size

Invoice Number: 48765

Fabrication Drawing

Project
CHILDREN'S HOSPITAL OF
ORANGE COUNTY

Customer
McCARTHY BUILDING CO.
ATT: JAMES BURGGRAB
20401 S.W. BIRCH ST.
NEWPORT BEACH, CA 92660

Designers
FORMATION


Order Item: 3

Sign Type: RIB-BOH

Revision No.:

10 Per ASI 183
March 16, 2012


Drawn By: MWilliams

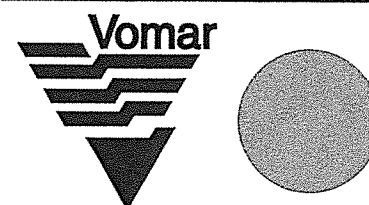


Vomar Products, Inc.
7800 Deering Avenue
Canoga Park, CA 91304-5005
Tel: 818-610-5115
Fax: 818-610-5123
E-Mail: info@vomarproducts.com

Sheet Date: 05/20/10

Sheet Number 3.1

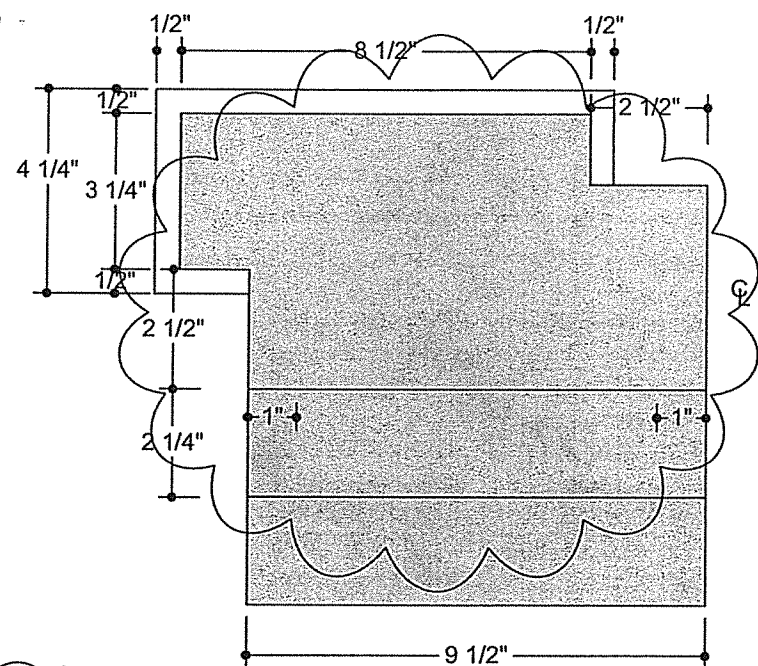


3 Back View
Scale: 3" = 1'-0"

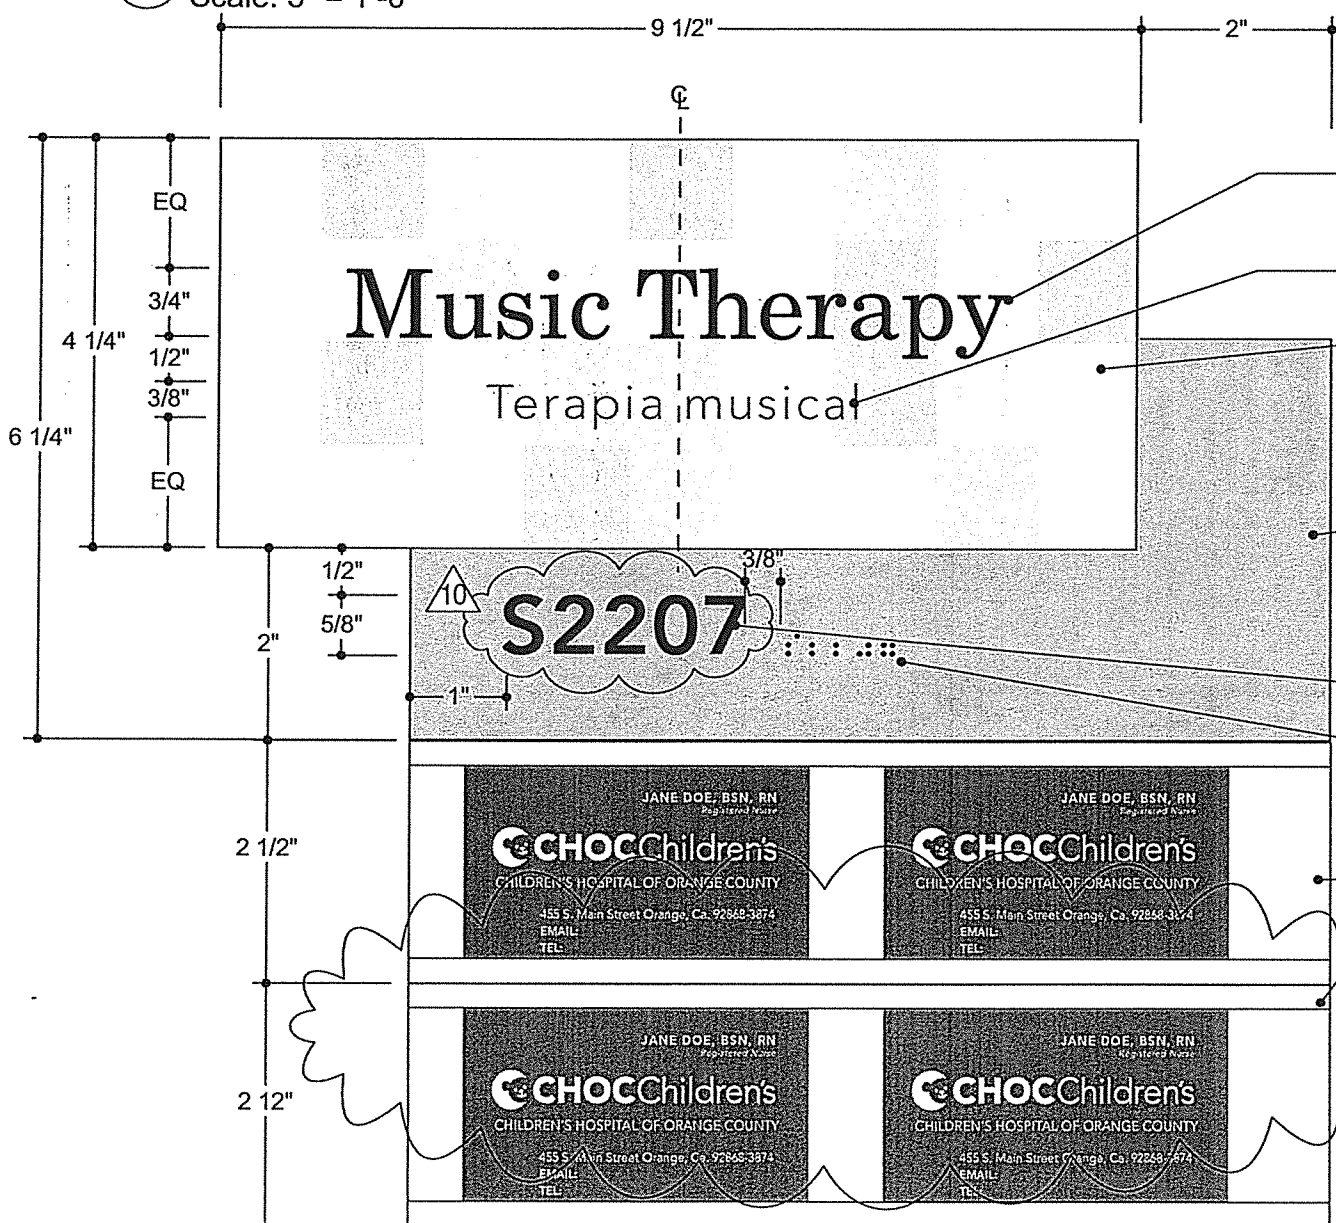

1 Front View
Scale: Half Size

PROVIDE IN HOUSE
SAMPLE OF 2 1/4" CARD
HOLDER FOR APPROVAL

4 Front Elevation
Scale: 3/8" = 1'-0"

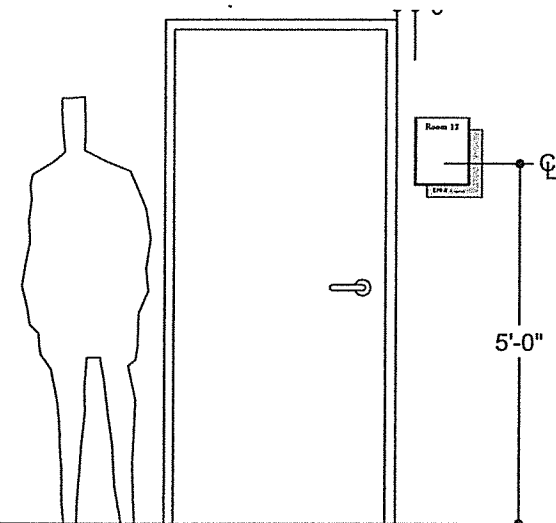

ITEM NO. 4
SIGN TYPE OID

QTY: 95

SIGN MATERIALS:
8 1/4" H X 11 1/2" W PLAQUE W/ 1/4"
THK. ACRYLIC FACE PANEL AND
FRONT SURFACE SILKSCREENED
COPY AND 1/2" THK. TACTILE
BACKING W/ RAISED COPY &
BRAILLE. SEPARATE CARD/NAME
INSERT HOLDER W/ BLANK INSERT.

MOUNTING:
WALL SURFACE MOUNTED

COLOR/FINISH:
REFER ELEVATIONS

FONT:
AVENIR 85 HEAVY
NEW CENTURY SCHOOLBOOK
ROMAN

Silkscreened copy-
first surface Black

Spanish to match PMS 424M

1/4" thk. acrylic face
w/ lightly frosted on
first surface and edges.
Mosaic pattern vinyl
digital print applied to
second surface.

1/2" thk. acrylic plaque
w/ raised copy and braille,
to meet all ADA requirements
Background and sides
painted to match matte
white

1/32" raised copy, tip screened
to match Matte Black

CA grade II braille- same
color as background

Acrylic slider mounted to
bottom of sign, flush with face.
Sliders to have 2" h inserts.

1/16" foam tape &
silicone adhesive.
Hold back tape 1/2"
from edge.

Mounted to wall
w/ silicone adhesive
and foam tape

Invoice Number: 48765

Fabrication Drawing

Project
CHILDREN'S HOSPITAL OF
ORANGE COUNTY

Customer
McCARTHY BUILDING CO.
ATT: JAMES BURGGRAB
20401 S.W. BIRCH ST.
NEWPORT BEACH, CA 92660

Designers
FORMATION

Order Item: 4

Sign Type: OID

Revision No.:

10 Per ASI 183
March 16, 2012

13 Per Sample Review
May 4, 2012

GENERAL NOTES

1. Eliminate visible adhesive @ rear acrylic and face acrylic perimeter.
2. Mosaic pattern & BACK PAINT to be consistent & not chipped at edges.
3. Paint at braille ball to be EVEN (Not indents in paint around balls)
4. Upper acrylic to have smooth laser cut (sample had striations around perimeter).

Drawn By: MWilliams



Vomar Products, Inc.
7800 Deering Avenue
Canoga Park, CA 91304-5005
Tel: 818-610-5115
Fax: 818-610-5123
E-Mail: info@vomarproducts.com

Sheet Date: 05/20/10

Sheet Number 4.0

Fabrication Drawing

Project
CHILDREN'S HOSPITAL OF
ORANGE COUNTY

Customer
McCARTHY BUILDING CO.
ATT: JAMES BURGGRAF
20401 S.W. BIRCH ST.
NEWPORT BEACH, CA 92660

Designers

Order Item: 4

Sign Type: **OID**

Revision No.:

10 Per ASI 183
March 16, 2012


Drawn By: MWilliams




Vomar Products, Inc. 6-8-12
1800 Deering Avenue
Canoga Park, CA 91304-5005
Tel: 818-610-5115
Fax: 818-610-5123
E-Mail: info@vomarproducts.com

Sheet Date: 05/20/10


Sheet Number 4.1

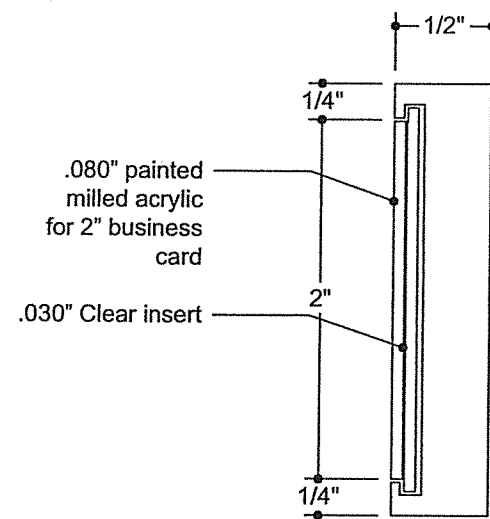

8 Side View @ Slider
Scale: Full Size



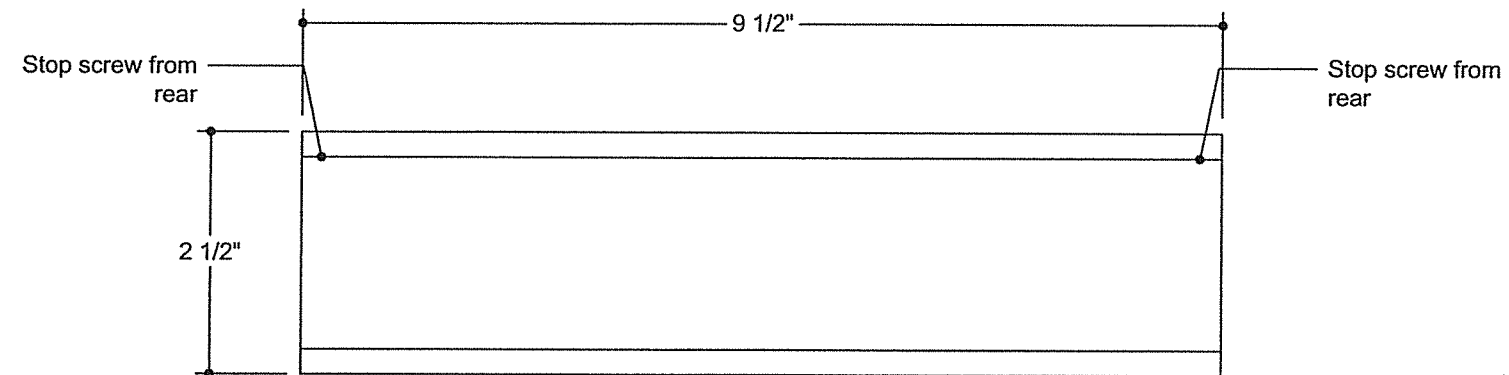


9 Front View @ Slder
Scale: Half Size

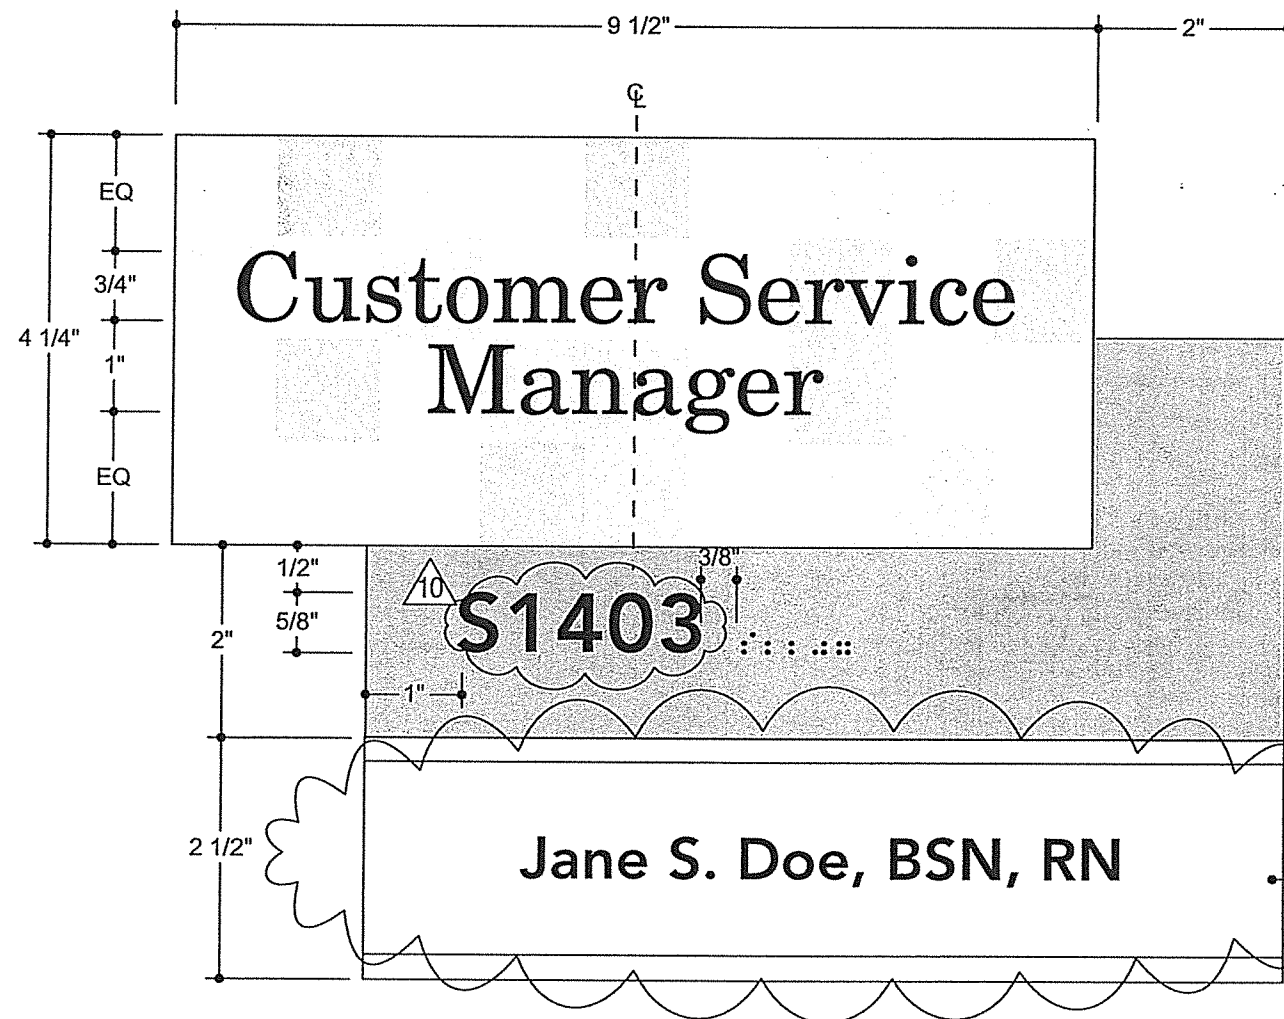

6 Front View
Scale: Half Size

Acrylic slider mounted to bottom of sign, flush with face. Sliders to have 2" h inserts.

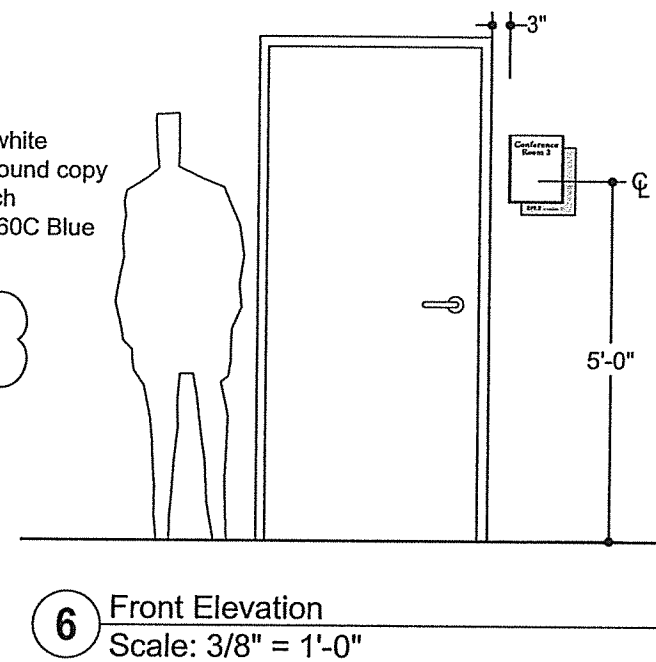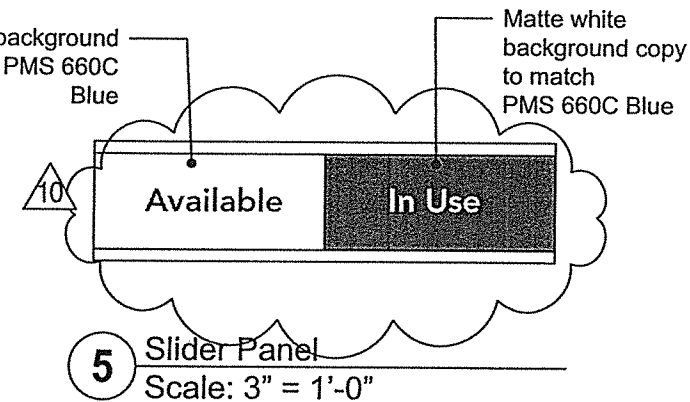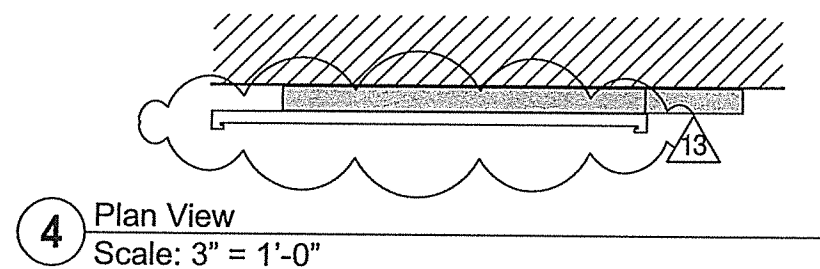

ITEM NO. 5
SIGN TYPE CRI

QTY: 18 ~~10~~

SIGN MATERIALS:

13 1/4" H X 11" W UNFRAMED PLAQUE
W/ FACE PLATE CONSISTING OF 3
LAYERS OF 1/8" THK. ACRYLIC TO
CREATE WINDOW PLAQUE W/ BLANK
INSERT AND 1/2" THK. TACTILE
BACKER PLATE W/ RAISED COPY AND
BRAILLE.
SEPARATE SLIDER INSERT HOLDER
W/ IN USE/ AVAILABLE COPY.

MOUNTING:
WALL SURFACE MOUNTED

COLOR/FINISH:
REFER ELEVATIONS

FONT:
AVENIR 85 HEAVY
NEW CENTURY SCHOOLBOOK
ROMAN

Invoice Number: 48765

Fabrication Drawing

Project
CHILDREN'S HOSPITAL OF
ORANGE COUNTY

Customer
McCARTHY BUILDING CO.
ATT: JAMES BURGGRAF
20401 S.W. BIRCH ST.
NEWPORT BEACH, CA 92660

Designers FORMATION

Order Item: 5

Sign Type: CRI

Revision No.:

 Per ASI 183
March 16, 2012

13 Per Sample Review
May 4, 2012

GENERAL NOTES

1. Eliminate visible adhesive @ rear acrylic and face acrylic perimeter.
2. Mosaic pattern & BACK PAINT to be consistent & not chipped at edges.
3. Paint at braille ball to be EVEN (Not indents in paint around balls)
4. Upper acrylic to have smooth laser cut (sample had striations around perimeter.)




Drawn By: MWilliams



Vomar Products, Inc.
7800 Deering Avenue
Canoga Park, CA 91304-5005
Tel: 818-610-5115
Fax: 818-610-5123
E-Mail: info@vomarproducts.com

Sheet Date: 05/20/10

Sheet Number 5.0

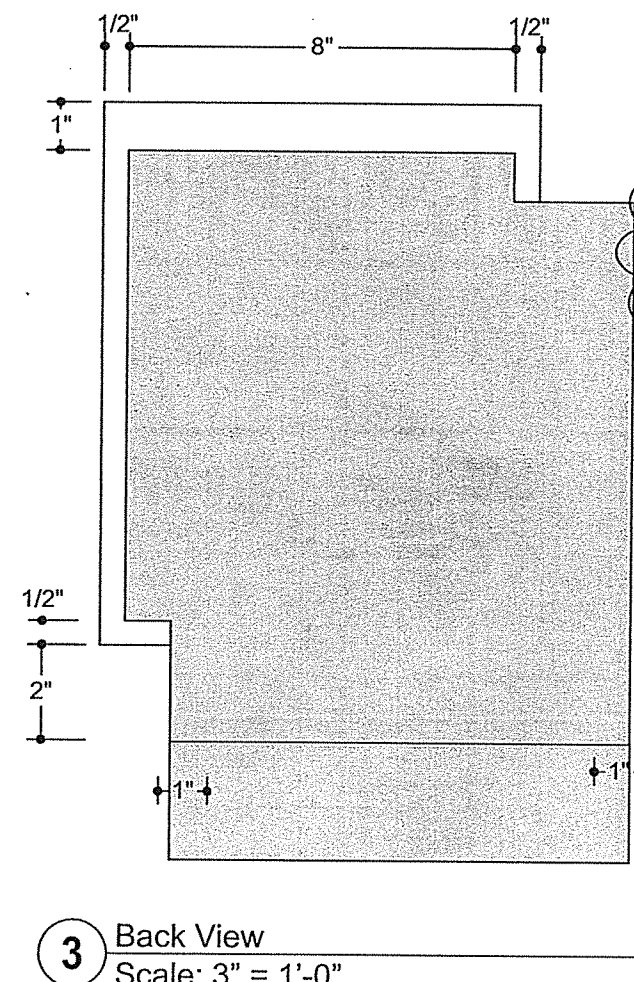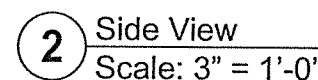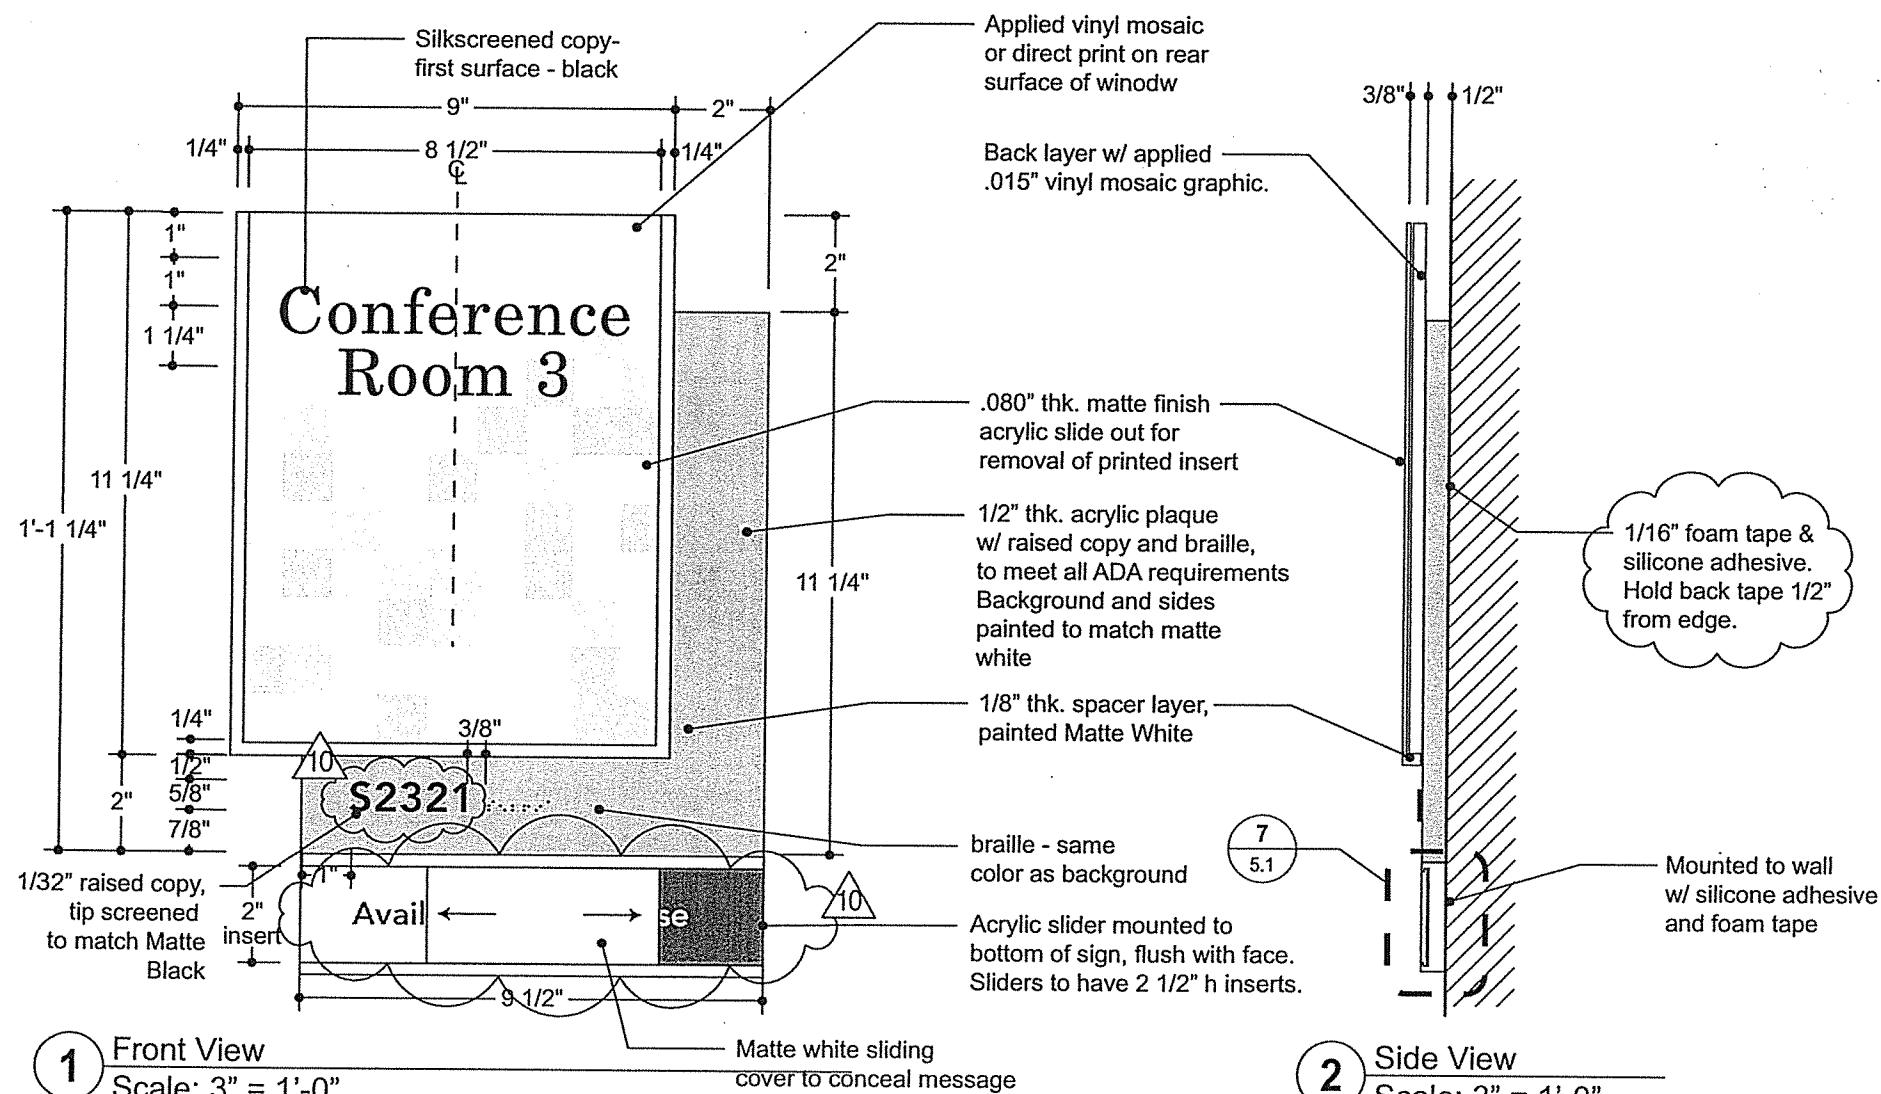

Fabrication Drawing

Project
CHILDREN'S HOSPITAL OF
ORANGE COUNTY

Customer
McCARTHY BUILDING CO.
ATT: JAMES BURGGRAF
20401 S.W. BIRCH ST.
NEWPORT BEACH, CA 92660

Designers
FORMATION

Order Item: 5


Sign Type: CRI

Revision No.:

10 Per ASI 183
March 16, 2012

13 Per Sample Review
May 4, 2012


Drawn By: MWilliams

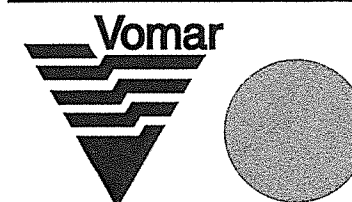


Vomar Products, Inc.
7800 Deering Avenue
Canoga Park, CA 91304-5005
Tel: 818-610-5115
Fax: 818-610-5123
E-Mail: info@vomarproducts.com

Sheet Date: 05/20/10

Sheet Number 5.1

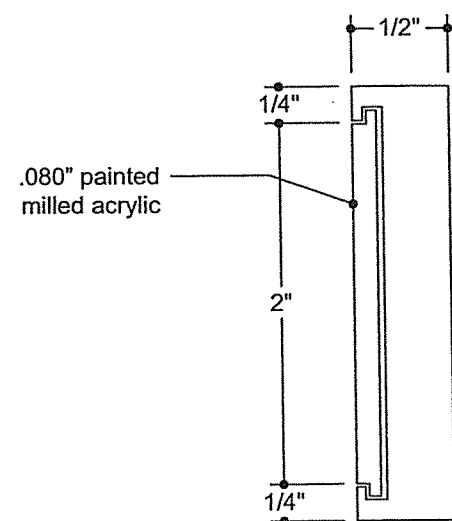

8 Side View @ Slider
Scale: Full Size

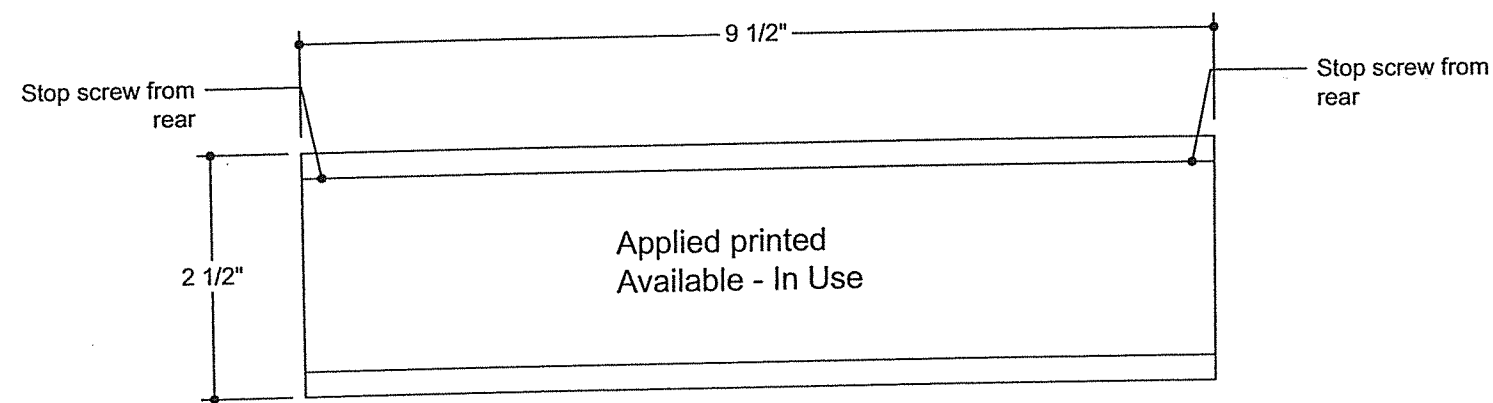

9 Front View @ Slider
Scale: Half Size

Fabrication Drawing

Project
CHILDREN'S HOSPITAL OF
ORANGE COUNTY

Customer
McCARTHY BUILDING CO.
ATT: JAMES BURGGRAF
20401 S.W. BIRCH ST.
NEWPORT BEACH, CA 92660

Designers
FORMATION

Order Item: 6


Sign Type: WIP

Revision No.:

10 Per ASI 183
March 16, 2012

13 Per Sample Review
May 4, 2012

Drawn By: MWilliams

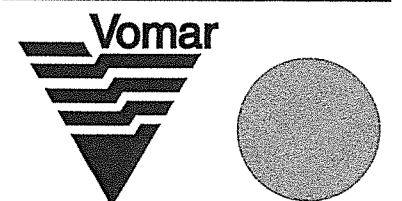

Vomar Products, Inc.
7800 Deering Avenue
Canoga Park, CA 91304-5005
Tel: 818-610-5115
Fax: 818-610-5123
E-Mail: info@vomarproducts.com

Sheet Date: 05/20/10

Sheet Number 6.0

ITEM NO. 6
SIGN TYPE WIP

QTY: 276 10


SIGN MATERIALS:
9 1/2" X 9 1/2" X 1/2" THK. ACRYLIC
PLAQUE W/ SILKSCREENED COPY

MOUNTING:
WALL SURFACE MOUNTED

COLOR/FINISH:
REFER ELEVATIONS

FONT:
AVENIR 85 HEAVY

3 Copy Layout
Scale: 3" = 1'-0"

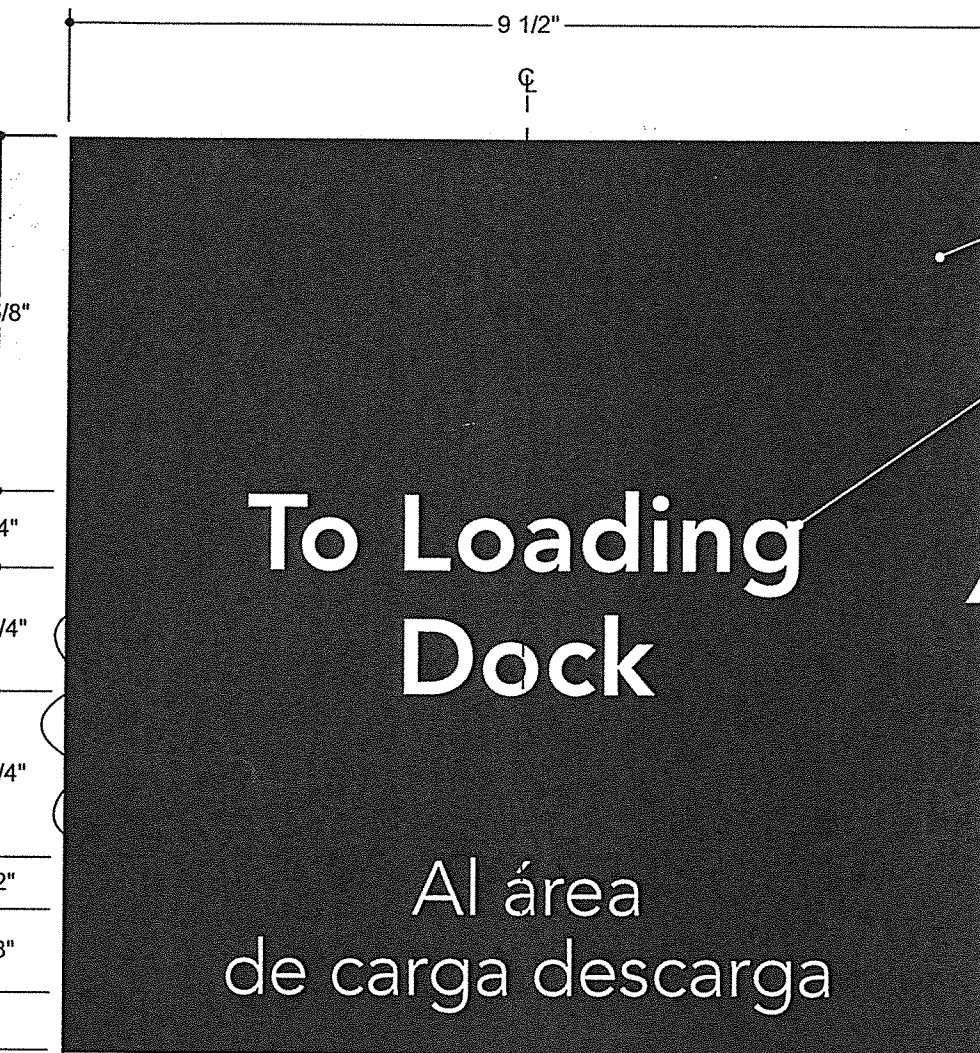

1 Front View - Qty. (1)
Scale: Half Size



1/2" thk. acrylic panel w/
silkscreened copy.
Background painted Matte
Black



Subsurface copy-
Matte White

DO NOT PRINT
SILKSCREEN GRAPHICS
FOLLOW DETAILS AS
SHOWN


Mounted to wall w/
silicone adhesive
and VHB tape

2 Side View
Scale: Half Size

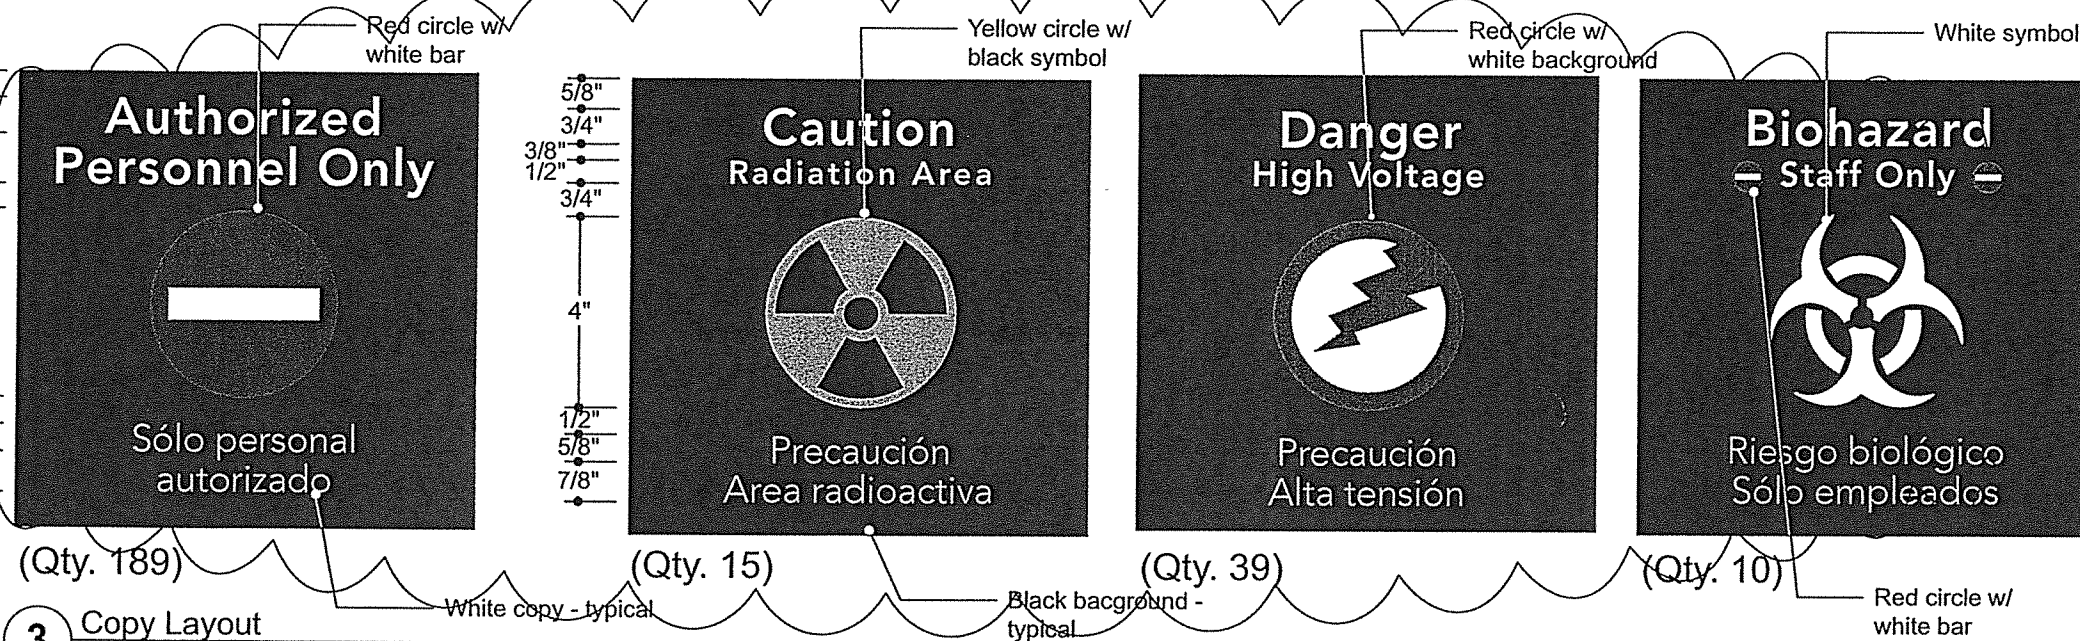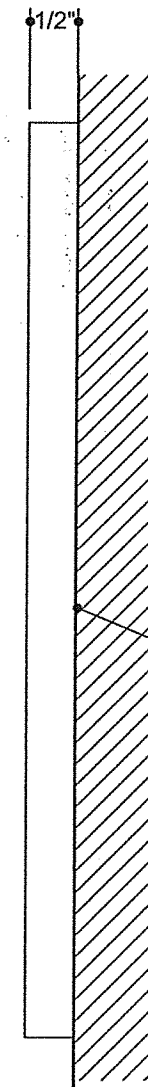


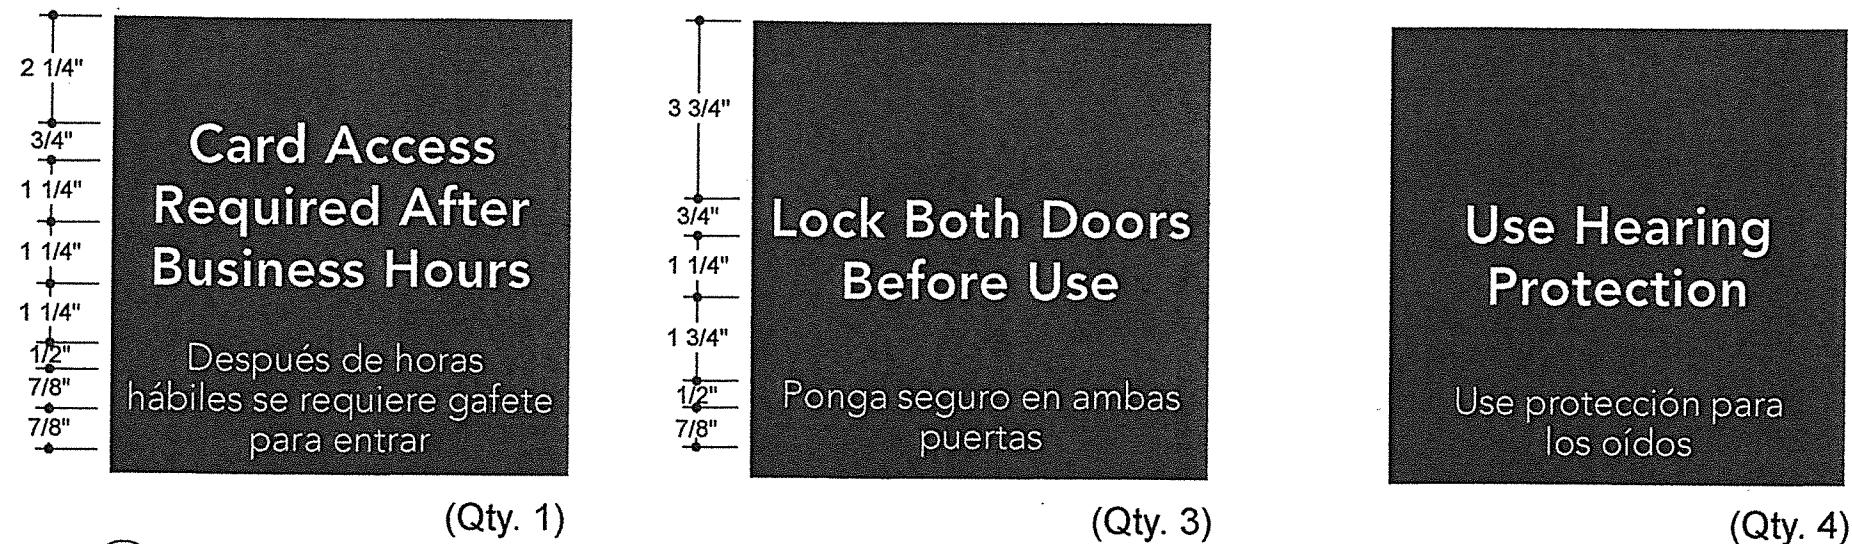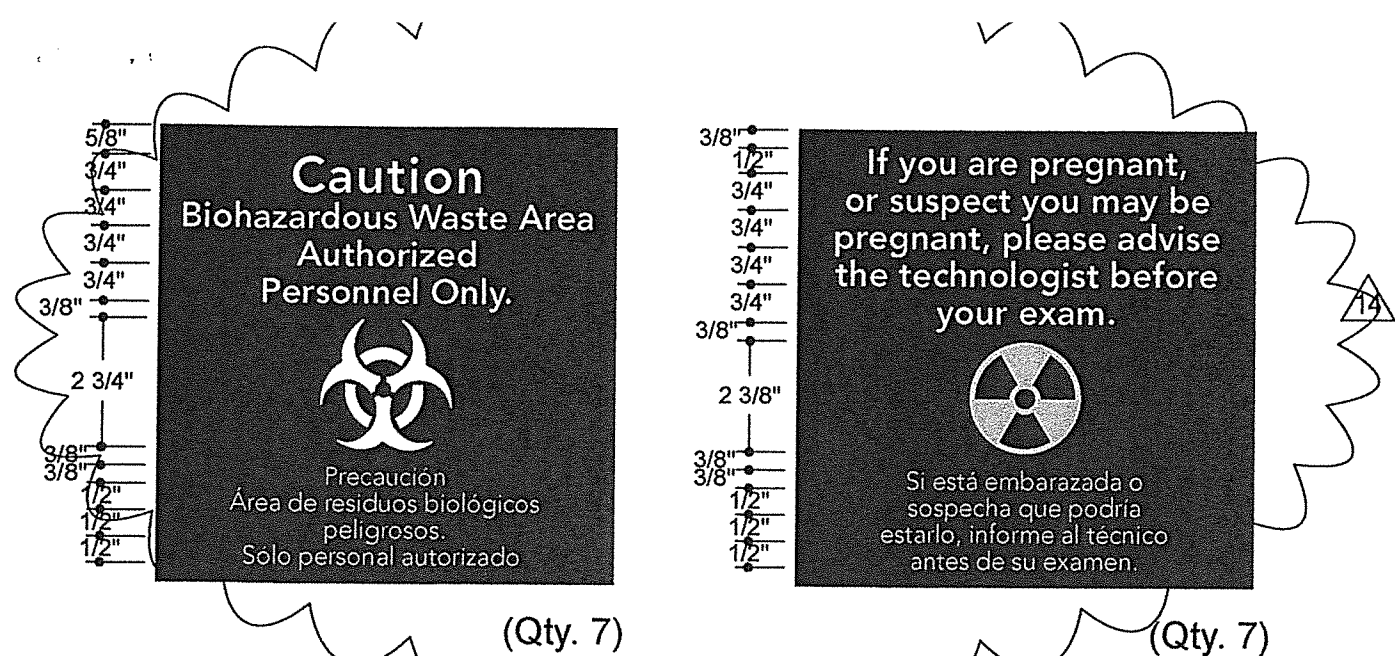

6 Copy Layout
Scale: 3" = 1'-0"

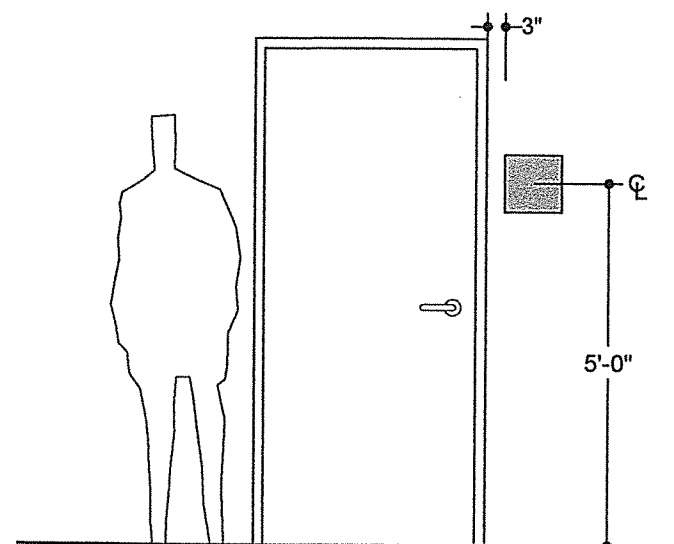

4 Front Elevation
Scale: 3/8" = 1'-0"

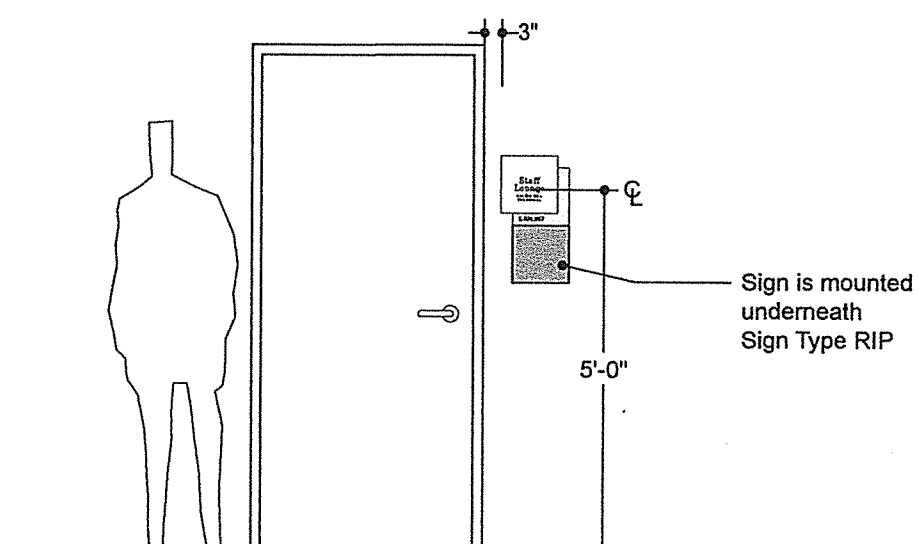

5 Front Elevation
Scale: 3/8" = 1'-0"

Invoice Number: 48765

Fabrication Drawing

Project
CHILDREN'S HOSPITAL OF ORANGE COUNTY

Customer
McCARTHY BUILDING CO.
ATT: JAMES BURGGRAF
20401 S.W. BIRCH ST.
NEWPORT BEACH, CA 92660

Designers
FORMATION

Order Item: 6

Sign Type: WIP

Revision No.:

14 Per Returned Submittal
May 18, 2012


Drawn By: MWilliams



Vomar Products, Inc.
7800 Deering Avenue
Canoga Park, CA 91304-5005
Tel: 818-610-5115
Fax: 818-610-5123
E-Mail: info@vomarproducts.com


Sheet Date: 05/20/10

Sheet Number 6.1

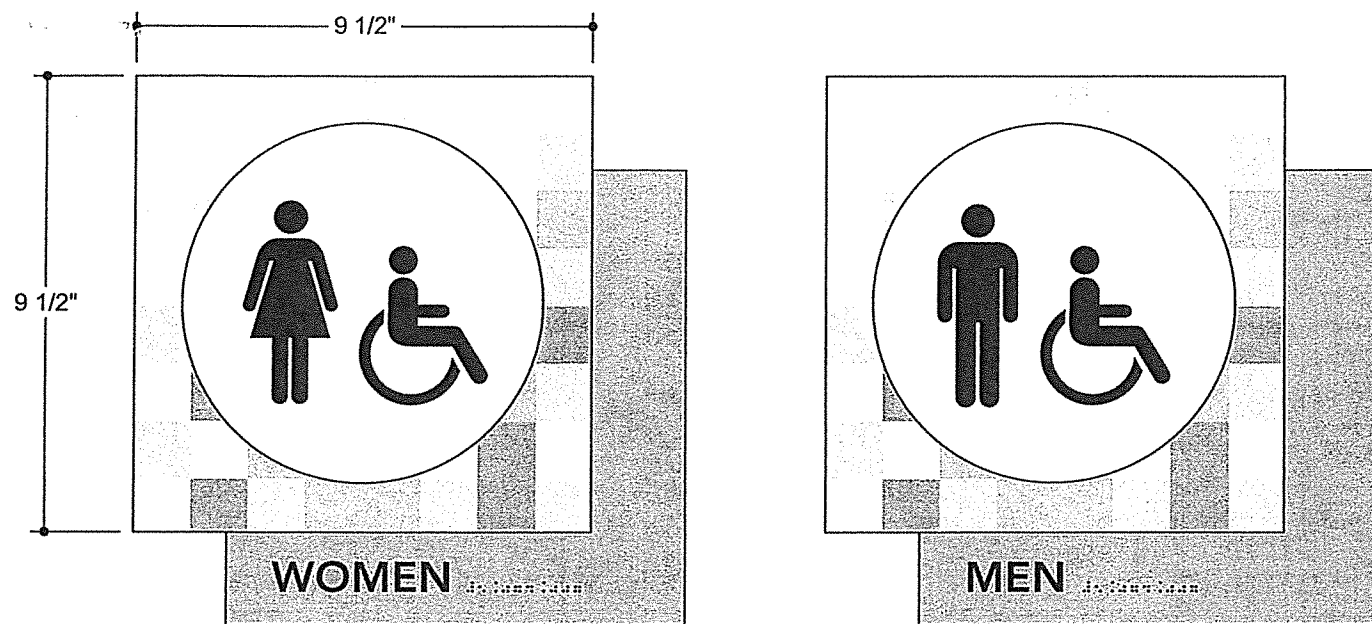

4 Copy Layout
Scale: 3" = 1'-0"

5 Front Elevation
Scale: 3/8" = 1'-0"

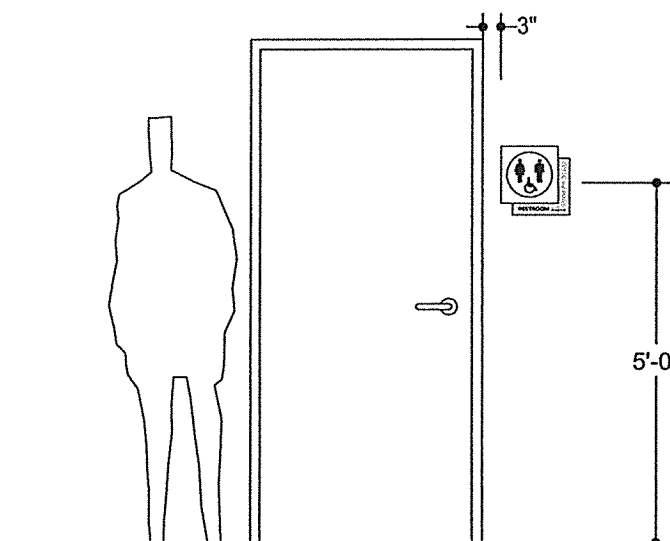

ITEM NO. 7
SIGN TYPE RRI

QTY: 83

SIGN MATERIALS:
11 1/2" X 11 1/2" UNFRAMED ACRYLIC
PLAQUE CONSISTING OF:
A) 1/4" THK. ACRYLIC W/ 1/8" THK.
ACRYLIC DISK APPLIED ON FACE W/
SILKSCREENED SYMBOLS.
B) 1/2" THK. TACTILE BACKING W/
RAISED COPY AND BRAILLE

MOUNTING:
WALL SURFACE MOUNTED

COLOR/FINISH:
REFER ELEVATIONS

FONT:
AVENIR 85 HEAVY

Invoice Number: 48765

Fabrication Drawing

Project
CHILDREN'S HOSPITAL OF
ORANGE COUNTY

Customer
McARTHUR BUILDING CO.
ATT: JAMES BURGGRAB
20401 S.W. BIRCH ST.
NEWPORT BEACH, CA 92660

Designers
FORMATION

Order Item: 7

Sign Type: RRI

Revision No.:

10 Per ASI 183
March 16, 2012

13 Per Sample Review
May 4, 2012

- GENERAL NOTES**
1. Eliminate visible adhesive @ rear acrylic and face acrylic perimeter.
 2. Mosaic pattern & BACK PAINT to be consistent & not chipped at edges.
 3. Paint at braille ball to be EVEN (Not indents in paint around balls)
 4. Upper acrylic to have smooth laser cut (sample had striations around perimeter).


Drawn By: MWilliams




Vomar Products, Inc.
7800 Deering Avenue
Canoga Park, CA 91304-5005
Tel: 818-610-5115
Fax: 818-610-5123
E-Mail: info@vomarproducts.com

Sheet Date: 05/20/10


Sheet Number 7.0

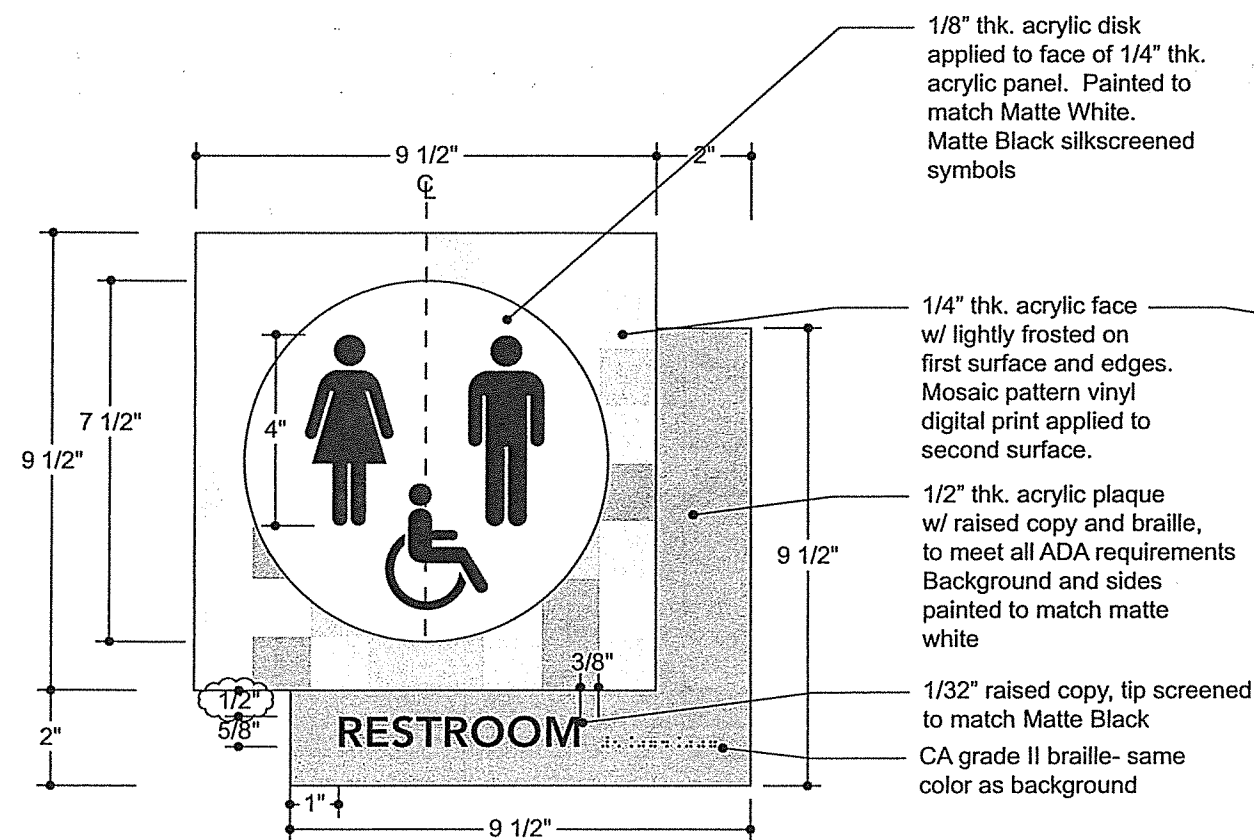

1 Front View
Scale: 3" = 1'-0"

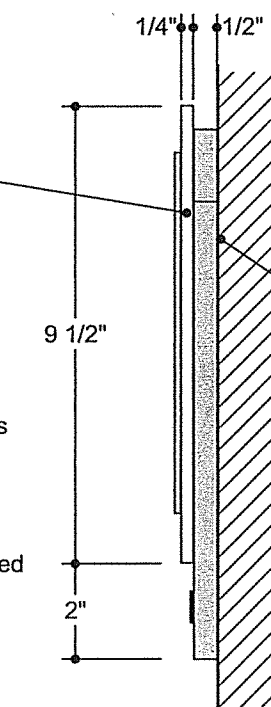

2 Side View
Scale: 3" = 1'-0"

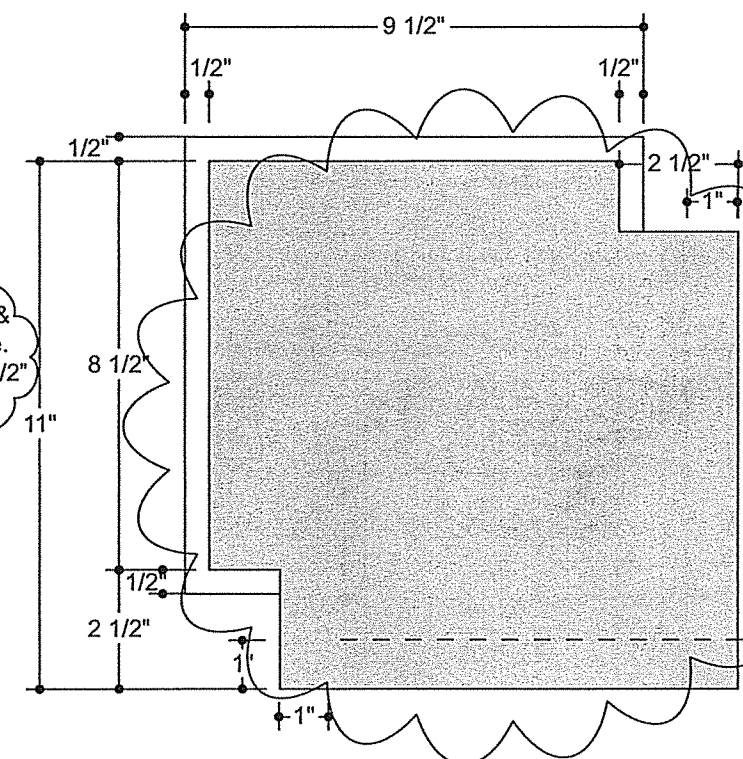

3 Back View
Scale: 3" = 1'-0"

48765

Fabrication Drawing

Project
CHILDREN'S HOSPITAL OF
ORANGE COUNTY

Customer
McCARTHY BUILDING CO.
ATT: JAMES BURGGRAF
20401 S.W. BIRCH ST.
NEWPORT BEACH, CA 92660

Designers FORMATION

Order Item: 7

Sign Type: RRI

Revision No.:

Per ASI 183
March 16, 2012


Drawn By: MWilliams



Vomar Products, Inc. 6-8-12
7800 Deering Avenue
Canoga Park, CA 91304-5005
Tel: 818-610-5115
Fax: 818-610-5123
E-Mail: info@vomarproducts.com


Sheet Date: 05/20/10

Sheet Number 7.1

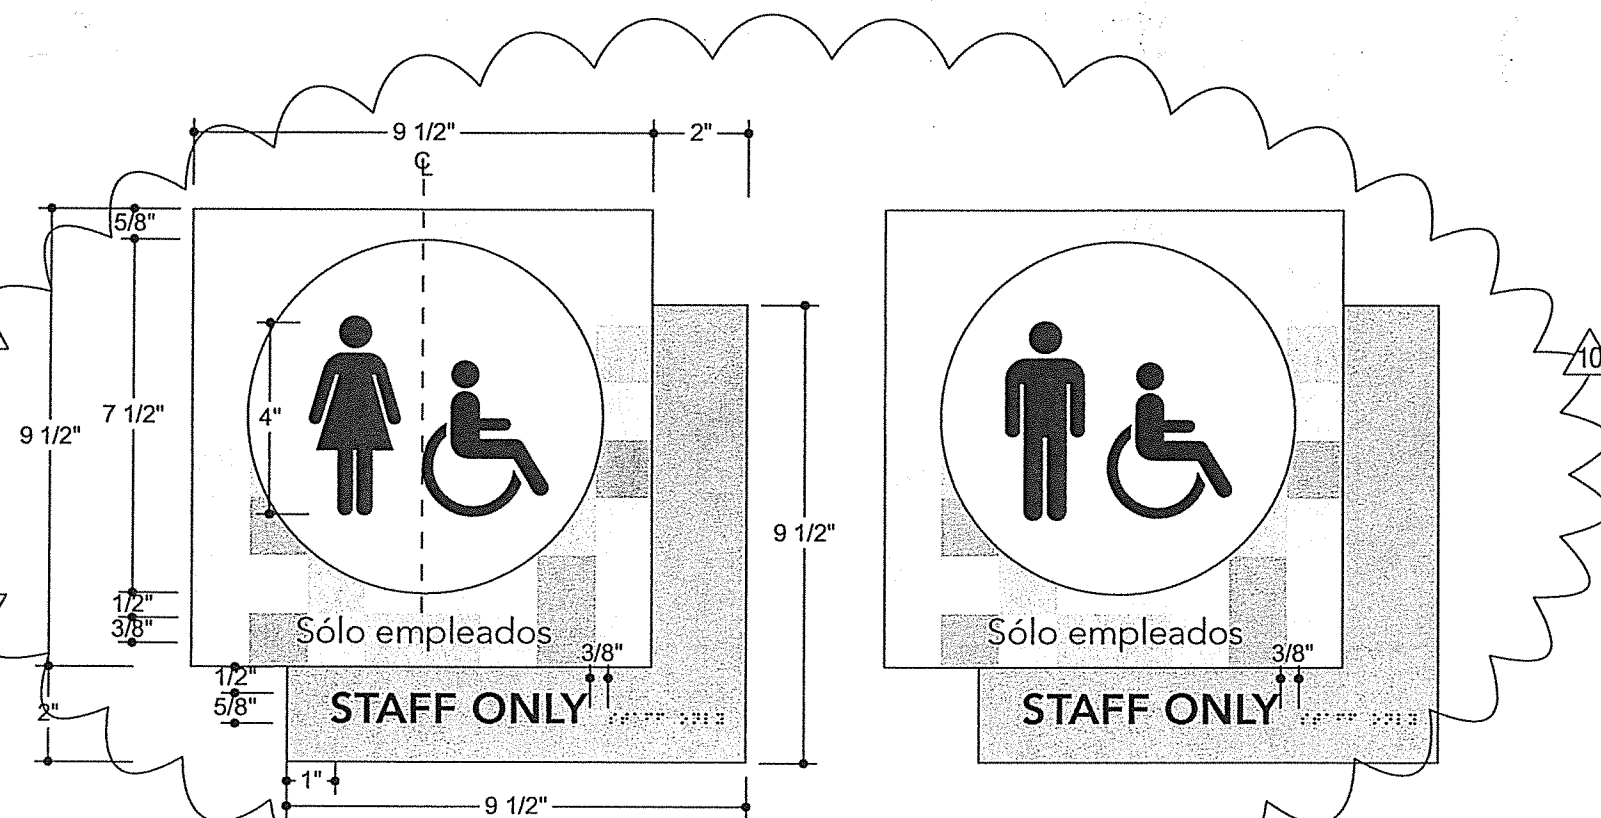


6


Copy Layout
Scale: 3" = 1'-0"

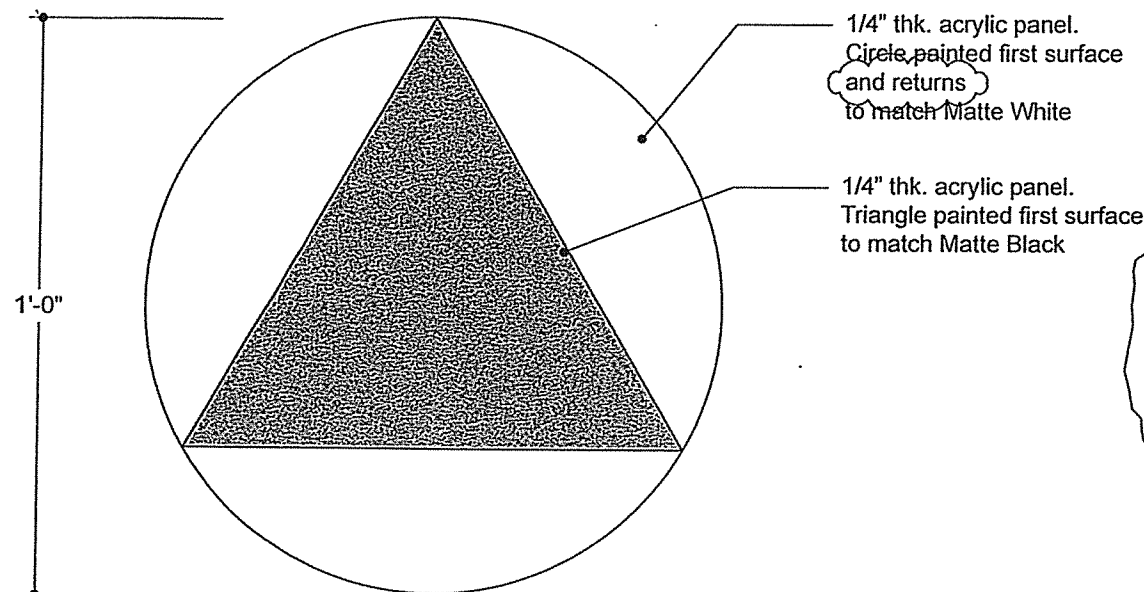


4 Front View - Unisex (Qty. (47))
Scale: 3" = 1'-0"

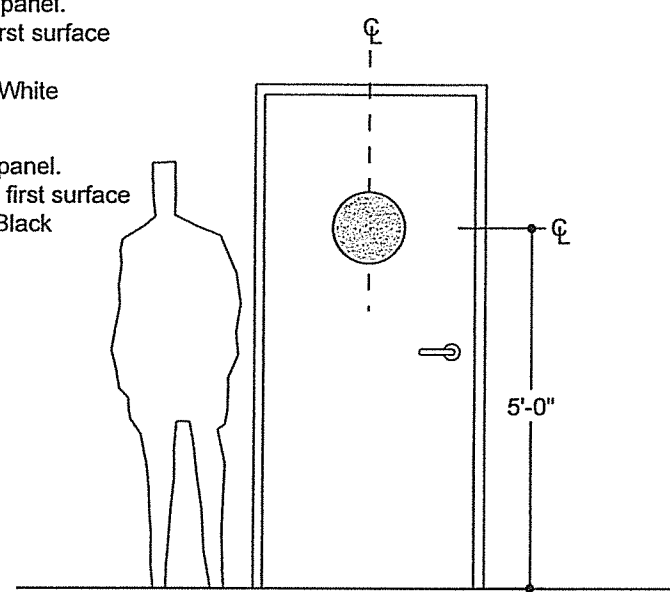


5 Front Elevation
Scale: 3/8" = 1'-0"

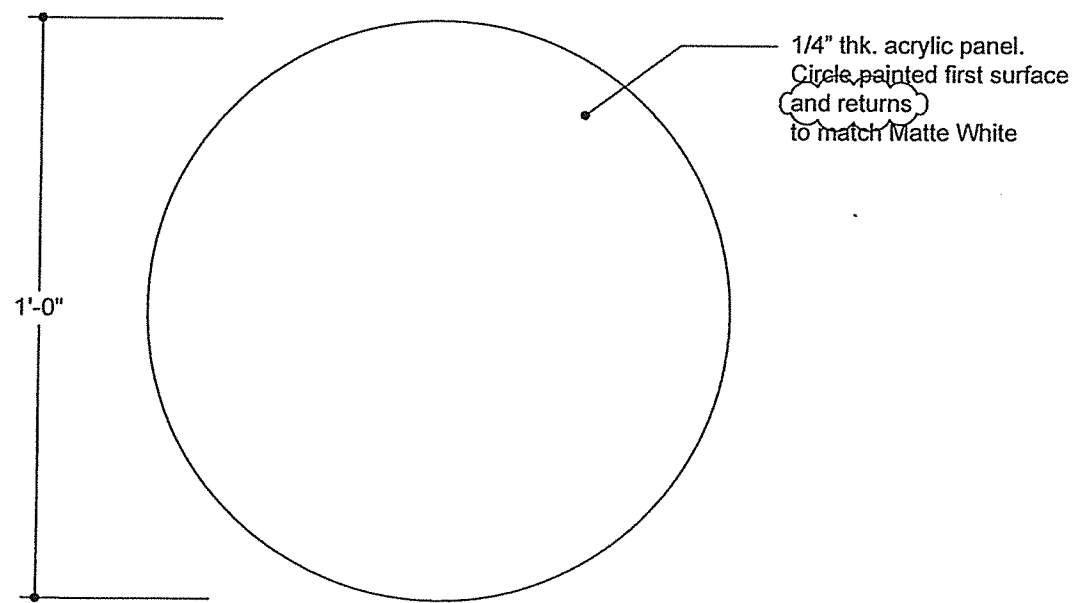

1 Front View - Women (Qty. (18))
Scale: 3" = 1'-0"

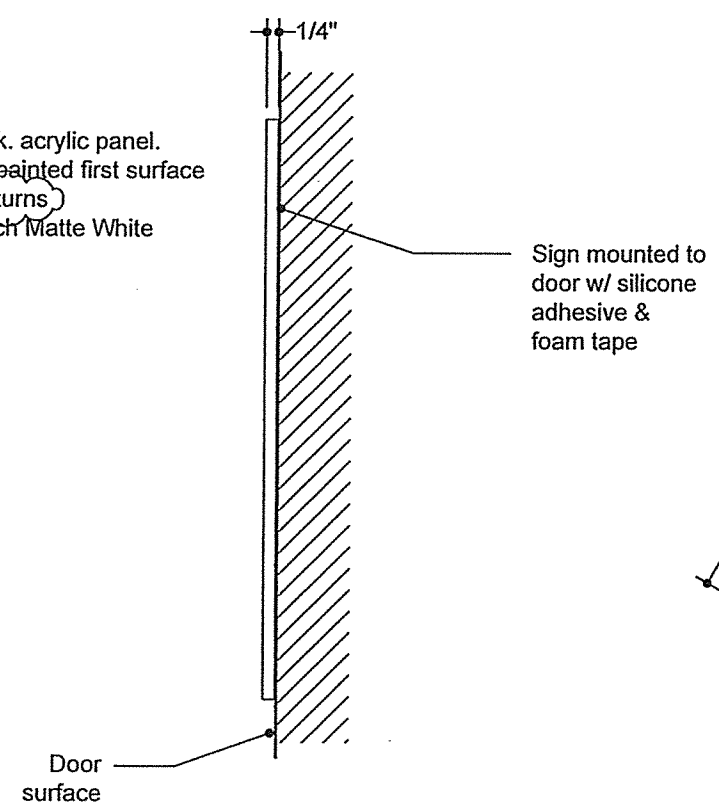

2 Side View
Scale: 3" = 1'-0"

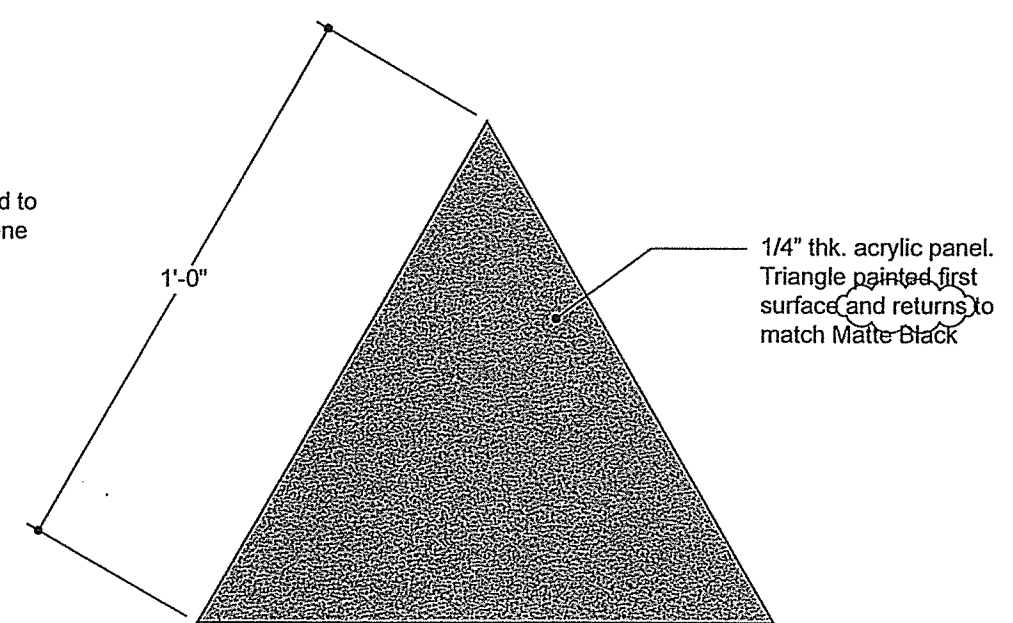

3 Front View - Men (Qty. (15))
Scale: 3" = 1'-0"

ITEM NO. 8
SIGN TYPE RRD

10 QTY: 83

SIGN MATERIALS:
12" X 1/4" TRIANGULAR/CIRCULAR/
COMBINATION OF BOTH PAINTED
ACRYLIC PLAQUE

MOUNTING:
DOOR SURFACE MOUNTED

COLOR/FINISH:
REFER ELEVATIONS

FONT:
N/A

Invoice Number: 48765

Fabrication Drawing

Project
CHILDREN'S HOSPITAL OF
ORANGE COUNTY

Customer
McCARTHY BUILDING CO.
ATT: JAMES BURGGRAF
20401 S.W. BIRCH ST.
NEWPORT BEACH, CA 92660

Designers
FORMATION


Order Item: 8

Sign Type: RRD

Revision No.:

10 Per ASI 183
March 16, 2012

Drawn By: MWilliams

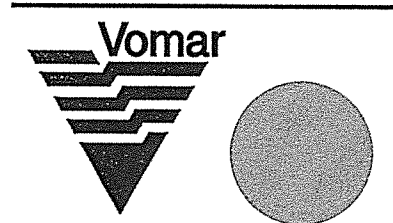

Vomar Products, Inc.
7800 Deering Avenue
Canoga Park, CA 91304-5005
Tel: 818-610-5115
Fax: 818-610-5123
E-Mail: info@vomarproducts.com

Sheet Date: 05/20/10

Sheet Number 8.0



**NOTE-
GC/ARCH TO CONFIRM
STAIR COPY RANGE &
ACCESS - PER DESIGNER/
CONTRACT DOCUMENTS**

STAIR 1
ROOF ACCESS
10 RUTA DE ACCESO
AL TECHO
2
THRU R

10 QTY: 33

10

FONT:
AVENIR 85 HEAVY

Sheet Number 9.0

4 Front View
Scale: 3" = 1'-0"

- Mounted to wall w/
silicone adhesive
and foam tape

2 Side View
Scale: 3" = 1'-0"

3 Front Elevation
Scale: $3/8" = 1'-0"$

Technical drawing of a fire escape sign. The sign is rectangular with a width of 1'-2" and a height of 1'-5". The sign features the following text and graphics:


- STAIR 5** (Large, bold, sans-serif font)
- NO ROOF ACCESS** (Large, bold, sans-serif font)
- NO HAY ACCESO** (Large, bold, sans-serif font, with a cloud-like background)
- AL TECHO** (Large, bold, sans-serif font, with a cloud-like background)
- 2** (Large, bold, sans-serif font)
- 1 THRU 2** (Large, bold, sans-serif font)

Dimensions and callouts:


- Width: 1'-2"
- Height: 1'-5"
- Top margin: 3/4", 1", 3/8", 1/4", 1/2", 1", 3/8", 1/4", 1/2", 1", 1 1/2"
- Left margin: 3/8", 1/4", 1/2", 5"
- Right margin: 3/8", 1/4", 1/2", 1"
- Bottom margin: 3/8", 1/4"
- Callouts:
 - 1/8" thk. Photopolymer panel w/ raised copy & braille. Background & side to be painted Matte White
 - Raised copy-Matte Black
 - braille - same color as background

1 Front View
Scale: 3" = 1'-0"


Diagram illustrating a door with a person standing next to it. The door has a handle and a lock. A vertical dimension line on the right indicates a height of 5'-0" from the floor to the top of the door frame. A horizontal dimension line at the top right indicates a width of 3" from the door frame to the wall.

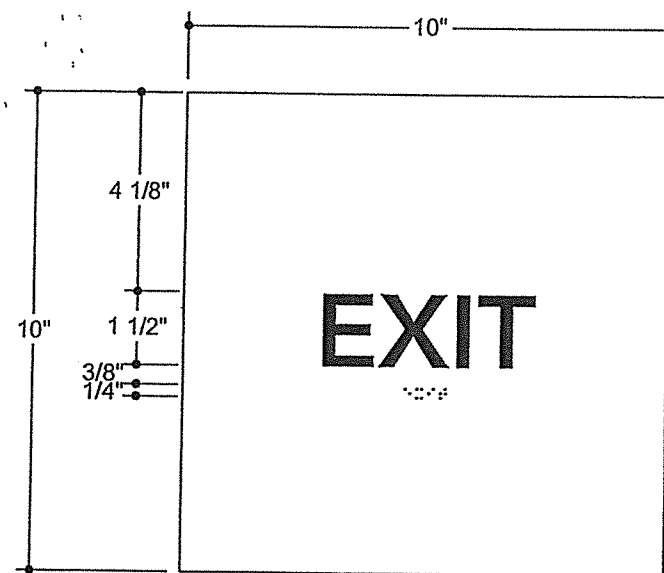


(Qty. 7 - interior)

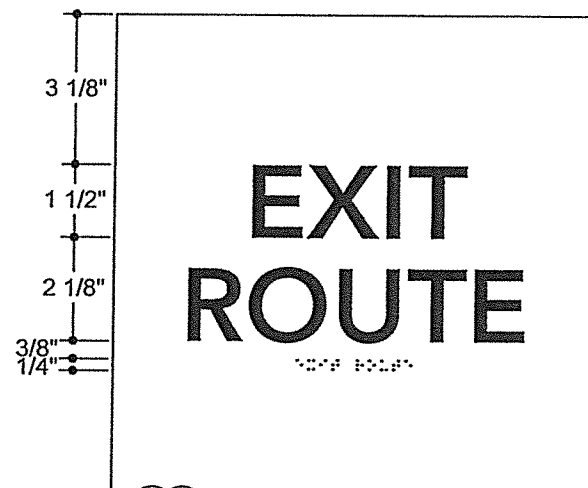


(Qty. 6)

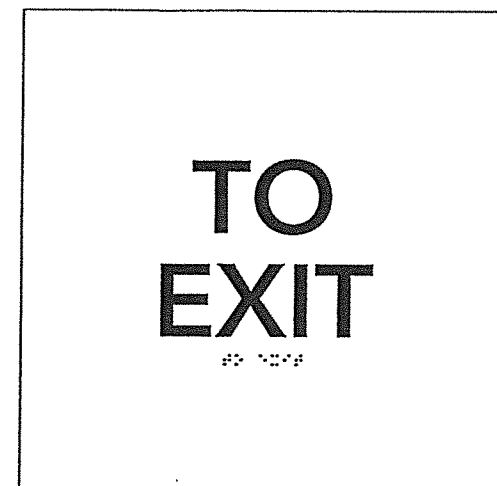

(Qty. 0)

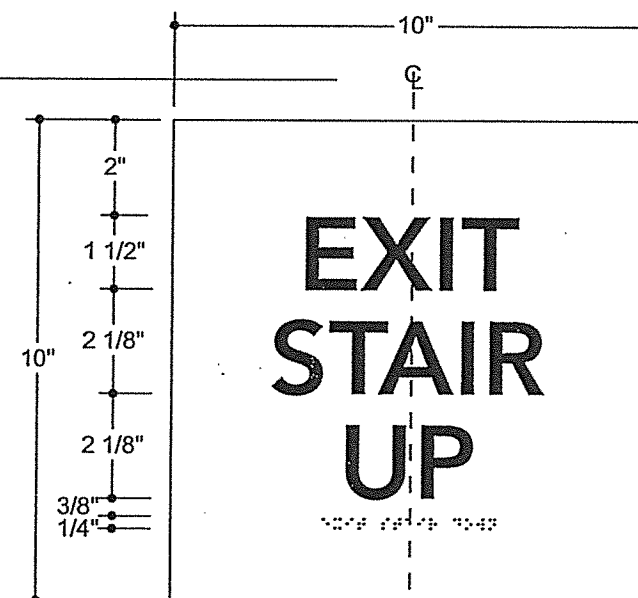


(Qty. 8 - interior)

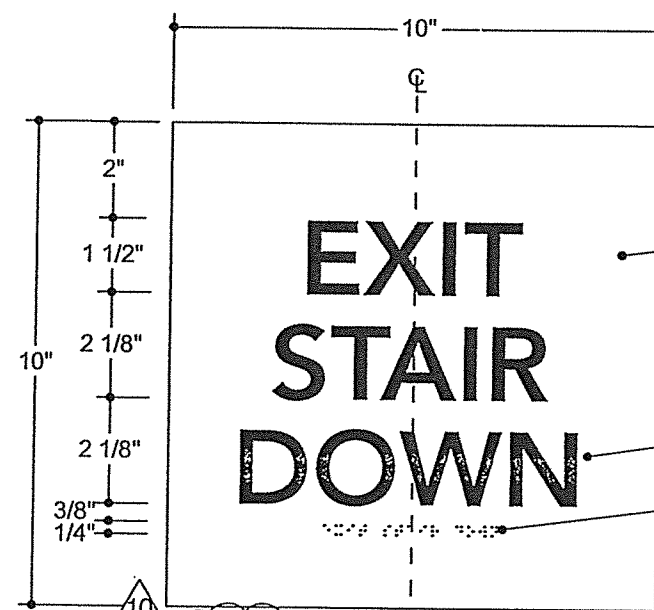


(Qty. 32 - interior)
(Qty. 10 - garage)

1/4" thk. acrylic plaque w/ raised copy and braille, to meet all ADA requirements Background and sides painted to match matte white

1/32" raised copy, tip screened to match Matte Black
CA grade II braille- same color as background

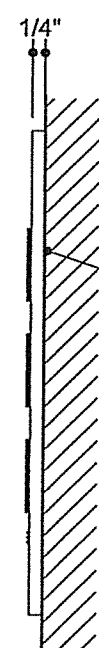

Mounted to wall w/ silicone adhesive and foam tape

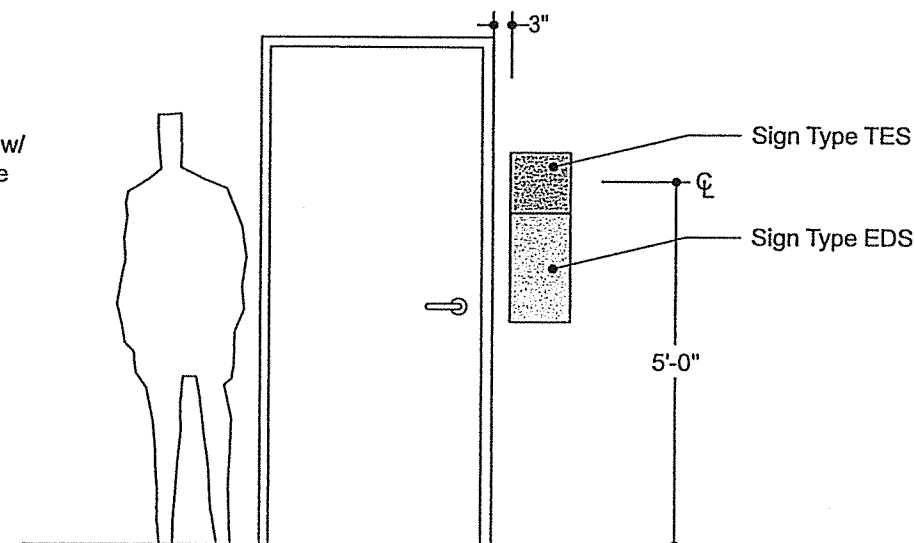

ITEM NO. 10
SIGN TYPE TES

QTY: 64
(46 EA.) BUILDING
(10 EA.) PARKING

SIGN MATERIALS:
10" X 10" X 1/4" THK. UNFRAMED
TACTILE PLAQUE W/ RASED COPY &
BRAILLE

MOUNTING:
WALL SURFACE MOUNTED

COLOR/FINISH:
REFER ELEVATIONS

FONT:
AVENIR 85 HEAVY

Invoice Number: 48765

Fabrication Drawing

Project
CHILDREN'S HOSPITAL OF
ORANGE COUNTY

Customer
McCARTHY BUILDING CO.
ATT: JAMES BURGGRAF
20401 S.W. BIRCH ST.
NEWPORT BEACH, CA 92660

Designers
FORMATION


Order Item: 10

Sign Type: TES

Revision No.:

Per ASI 183
March 16, 2012

Drawn By: MWilliams

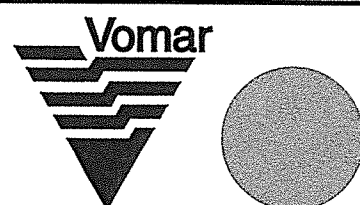

Vomar Products, Inc.
7800 Deering Avenue
Canoga Park, CA 91304-5005
Tel: 818-610-5115
Fax: 818-610-5123
E-Mail: info@vomarproducts.com


1 Front View
Scale: 3" = 1'-0"

2 Side View
Scale: 3" = 1'-0"


3 Front Elevation
Scale: 3/8" = 1'-0"

Sheet Date: 05/20/10


Sheet Number 10.0

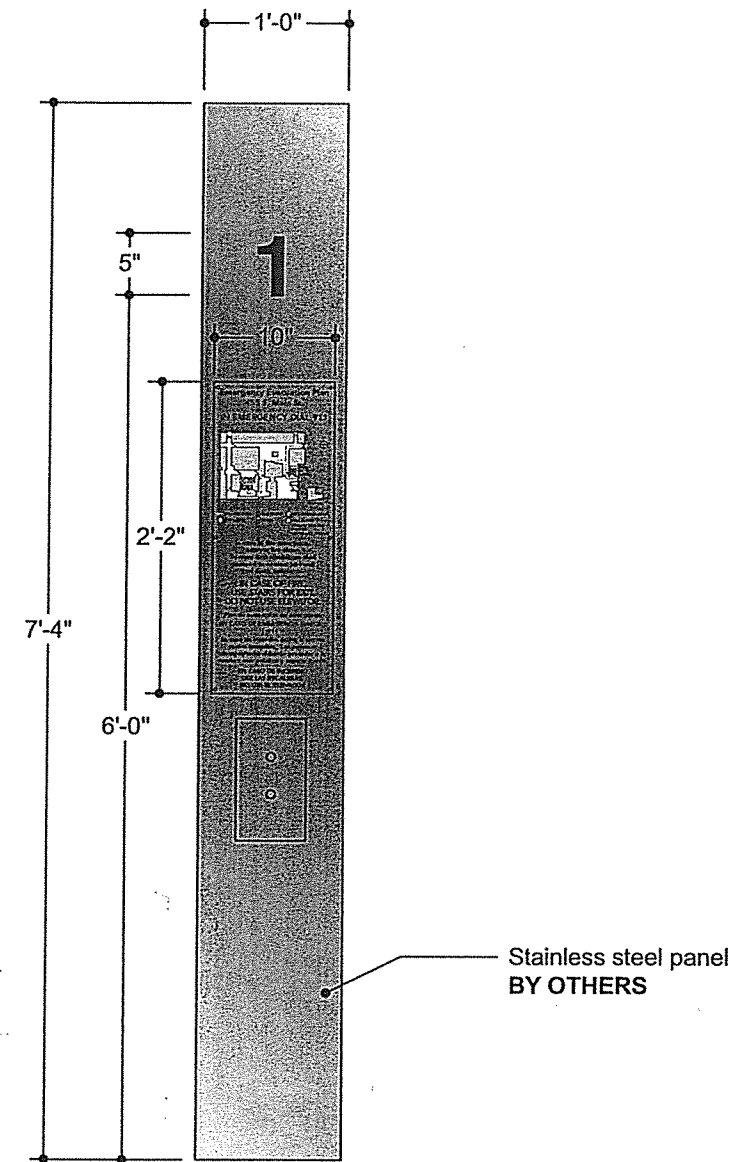


4 Front View
Scale: 3/4" = 1'-0"

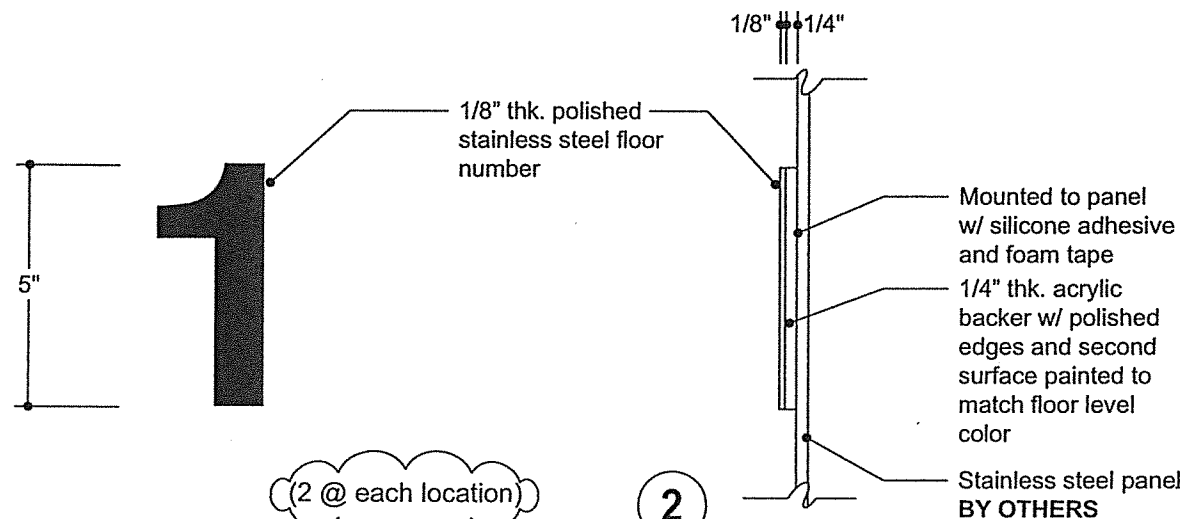

2 Side View @ Number
Scale: 3" = 1'-0"

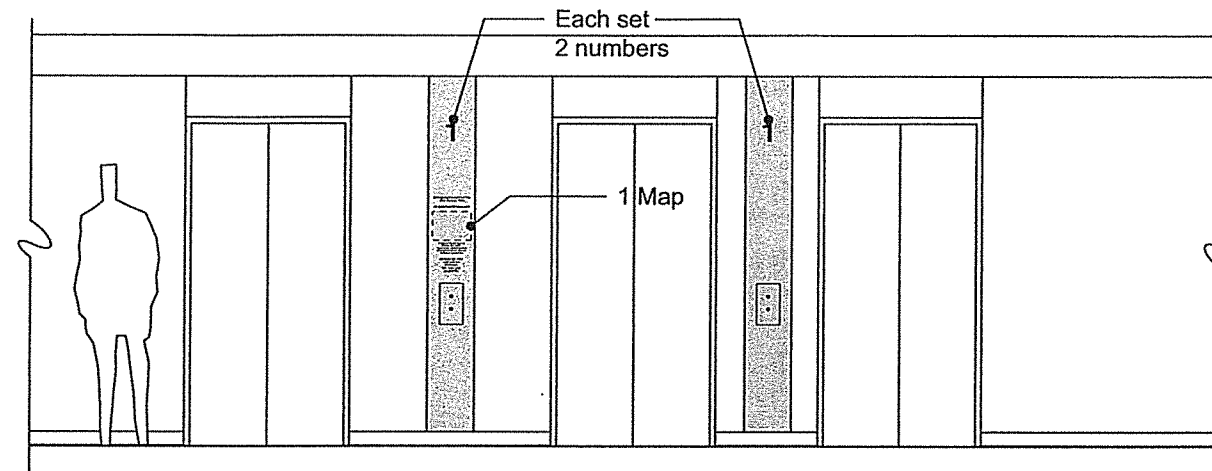

5 Front Elevation
Scale: 1/4" = 1'-0"

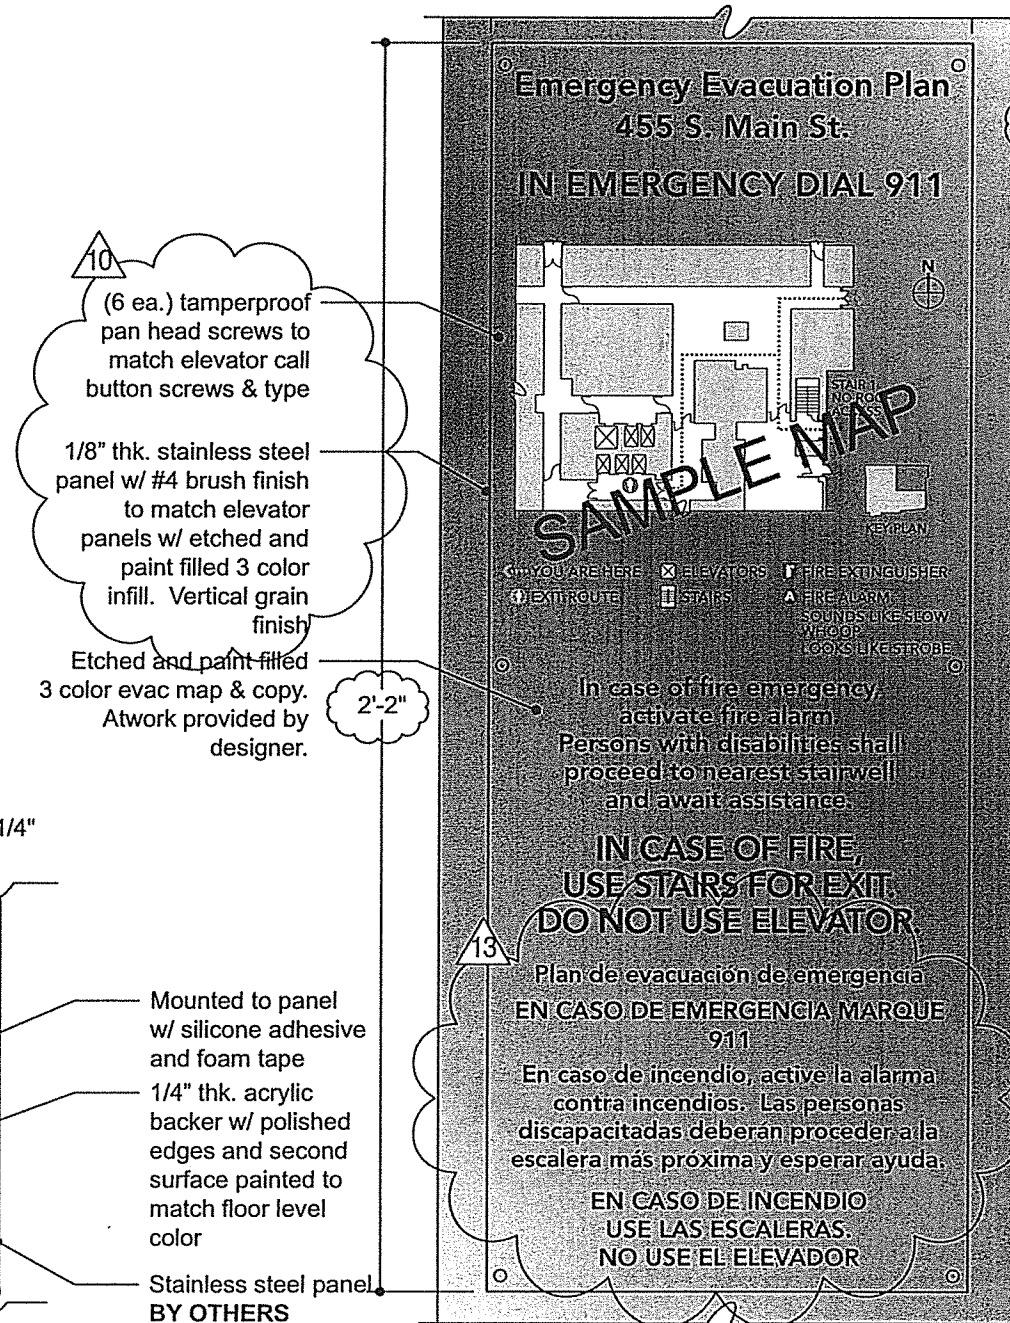

3 Front View - Map
Scale: 3" = 1'-0"

ITEM NO. 11
SIGN TYPE EDP

QTY: 16

SIGN MATERIALS:
VOMAR PRODUCTS TO RECEIVE 2'-2" H X 10" W STAINLESS STEEL CALL BUTTON COVER W/ HOLES FOR MECHANICAL MOUNTING. VOMAR TO MANUFACTURE AND INSTALL 1/8" THK. POLISHED STAINLESS STEEL LEVEL INDICATOR W/ 1/4" THK. ACRYLIC BACKER AS WELL AS ETCHED AND INFILLED (3 COLORS) EVACUATION MAP AND GRAPHIC. DIGITAL ARTWORK PROVIDED BY DESIGNER.


MOUNTING:
FLUSH MOUNT TO WALL SURFACE
WALL MOUNT

COLOR/FINISH:
REFER ELEVATIONS

FONT:
AVENIR 85 HEAVY
HELVETICA BOLD

FINAL ADDRESS
TO BE CONFIRMED

Tamperproof
pan head fasteners
1/8" thk. stainless
steel applied map

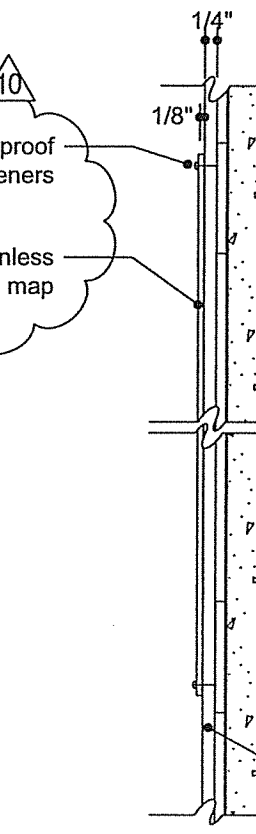

2 Side View @ Map
Scale: 3" = 1'-0"

Invoice Number: 48765

Fabrication Drawing

Project
CHILDREN'S HOSPITAL OF
ORANGE COUNTY

Customer
McCARTHY BUILDING CO.
ATT: JAMES BURGGRAB
20401 S.W. BIRCH ST.
NEWPORT BEACH, CA 92660

Designers
FORMATION

Order Item: 11

Sign Type: EDP

Revision No.:

10 Per ASI 183
March 16, 2012

13 Per Sample Review
May 4, 2012

Drawn By: MWilliams



Vomar Products, Inc.
7800 Deering Avenue
Canoga Park, CA 91304-5005
Tel: 818-610-5115
Fax: 818-610-5123
E-Mail: info@vomarproducts.com

Sheet Date: 05/20/10

Sheet Number 11.0

Project
CHILDREN'S HOSPITAL OF
ORANGE COUNTY

Designers FORMATION

Sign Type: EDP

Revision No.:

**EN CASO DE INCENDIO
USE LAS ESCALERAS.
NO USE EL ELEVADOR**

6 Typical Map Layout
Scale: Half Size

Drawn By: MWilliams



Sheet Date: 05/20/10

Sheet Number 11.1

ITEM NO. 12
SIGN TYPE EDS

QTY: 64

SIGN MATERIALS:
2'-2" H X 10" W X 1/4" THK. ACRYLIC
PLAQUE W/ 2 COLOR EVACUATION
MAP AND GRAPHIC LAYOUT. DIGITAL
MAP ARTWORK PROVIDED BY
DESIGNER.

MOUNTING:
WALL SURFACE MOUNTED

COLOR/FINISH:
REFER ELEVATIONS

FONT:
AVENIR 85 HEAVY

Invoice Number: 48765

Fabrication
Drawing

Project
CHILDREN'S HOSPITAL OF
ORANGE COUNTY

Customer
McCARTHY BUILDING CO.
ATT: JAMES BURGGRAF
20401 S.W. BIRCH ST.
NEWPORT BEACH, CA 92660

Designers
FORMATION

Order Item: 12


Sign Type: EDS

Revision No.:

10 Per ASI 183
March 16, 2012

13 Per Sample Review
May 4, 2012


Drawn By: MWilliams

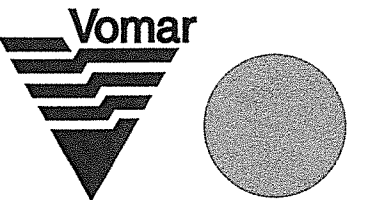

Vomar Products, Inc.
7800 Deering Avenue
Canoga Park, CA 91304-5005
Tel: 818-610-5115
Fax: 818-610-5123
E-Mail: info@vomarproducts.com

Sheet Date: 05/20/10


Sheet Number 12.0

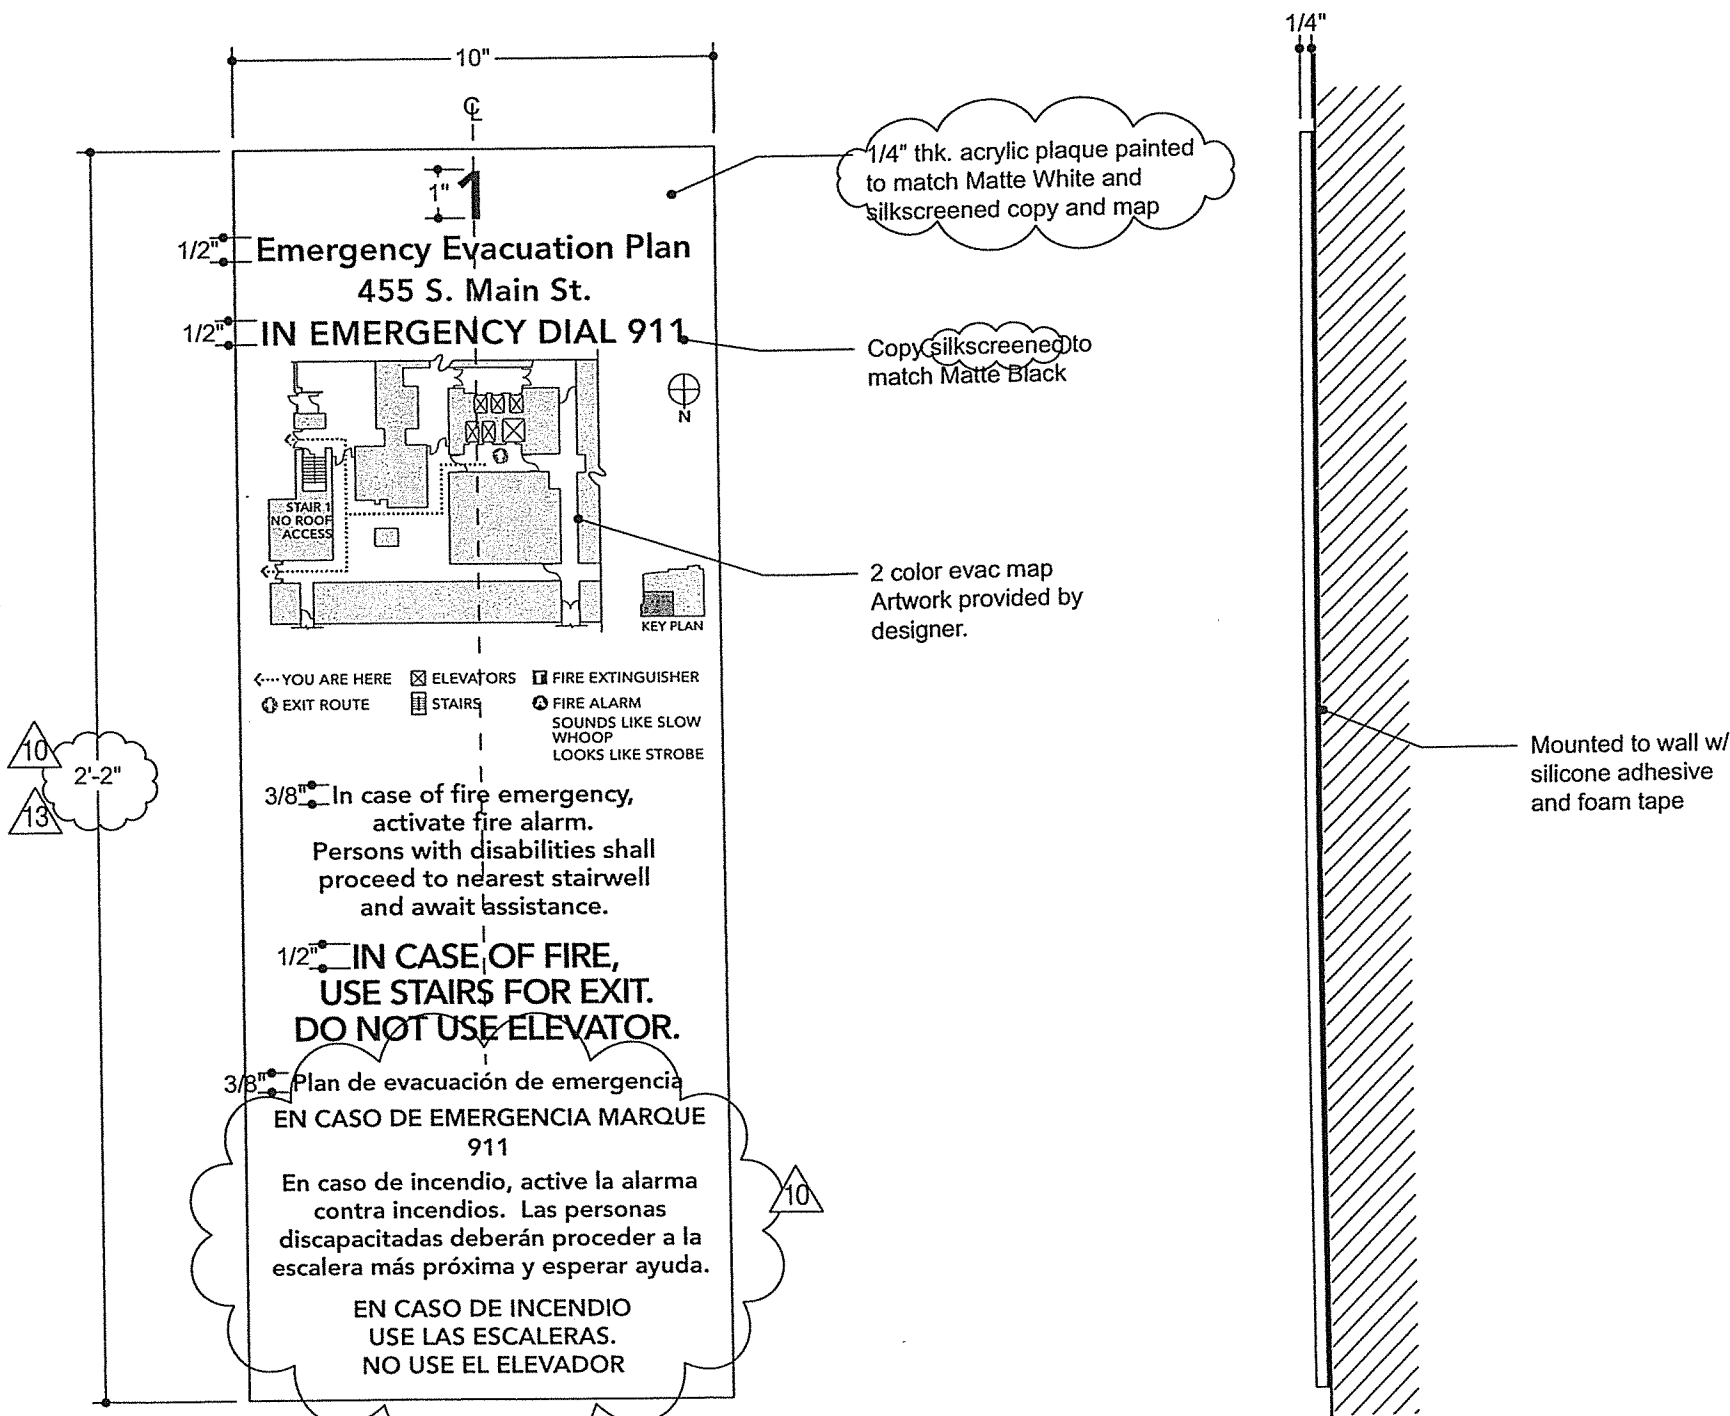

1 Front View
Scale: 3" = 1'-0"

2 Side View
Scale: 3" = 1'-0"

3 Typical Map Layout
Scale: Half Size

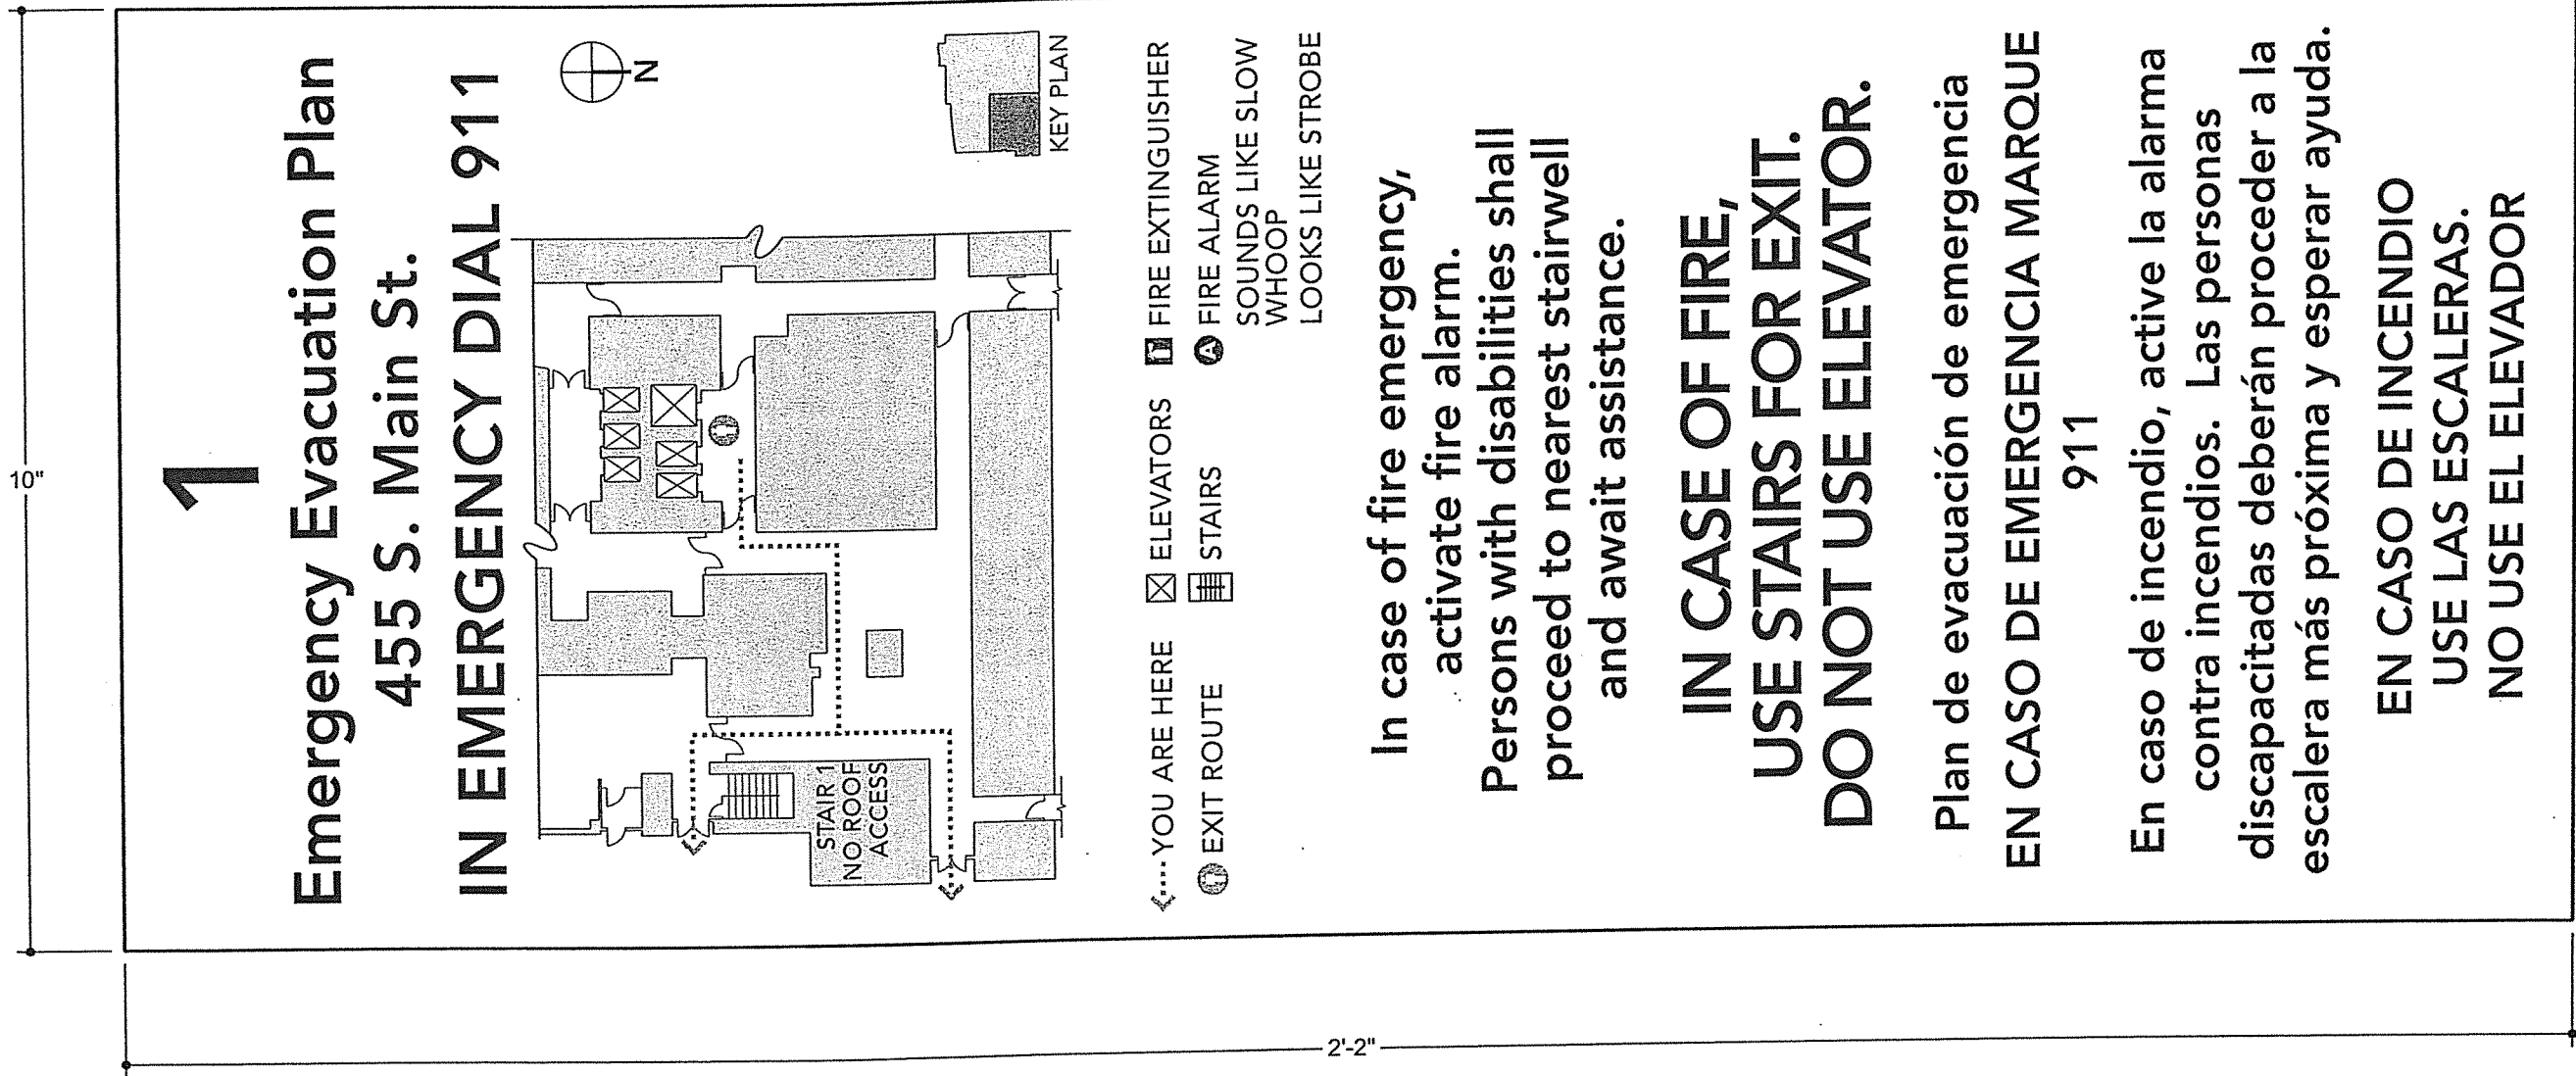

Fabrication
Drawing

Project
CHILDREN'S HOSPITAL OF
ORANGE COUNTY

Customer
McCARTHY BUILDING CO.
ATT: JAMES BURGGRAF
20401 S.W. BIRCH ST.
NEWPORT BEACH, CA 92660


Designers
FORMATION

Order Item: 12

Sign Type: EDS

Revision No.:

Drawn By: MWilliams

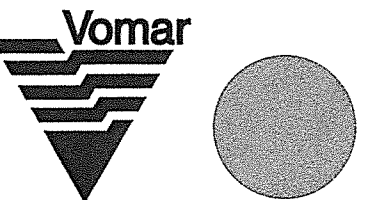

Vomar Products, Inc.
7800 Deering Avenue
Canoga Park, CA 91304-5005
Tel: 818-610-5115
Fax: 818-610-5123
E-Mail: info@vomarproducts.com

Sheet Date: 05/20/10

Sheet Number 12.1

Fabrication Drawing

Project
CHILDREN'S HOSPITAL OF
ORANGE COUNTY


Customer
McCARTHY BUILDING CO.
ATT: JAMES BURGGRAF
20401 S.W. BIRCH ST.
NEWPORT BEACH, CA 92660

Designers
FORMATION


Order Item: 12

Sign Type: EDS

Revision No.:

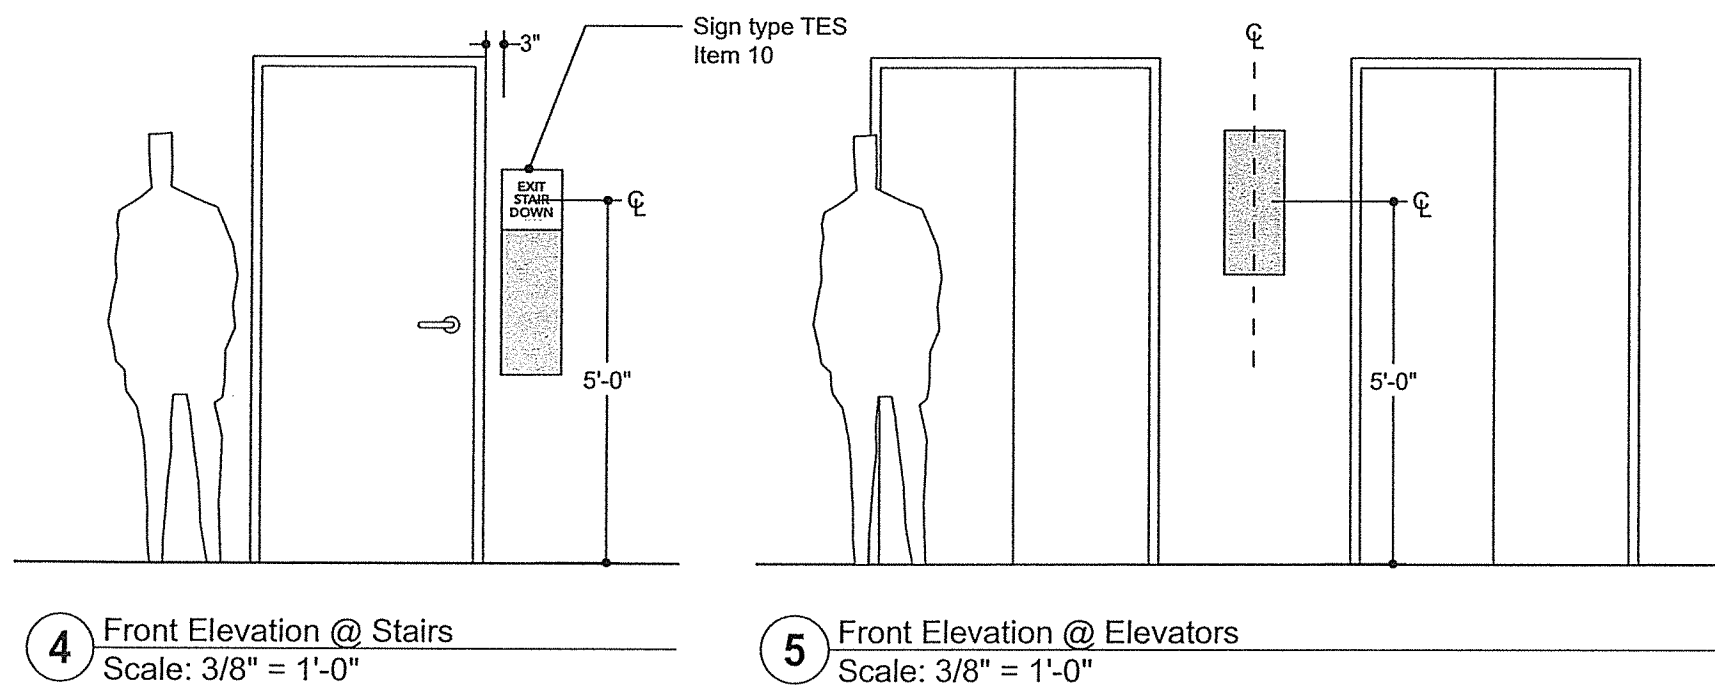


Drawn By: MWilliams

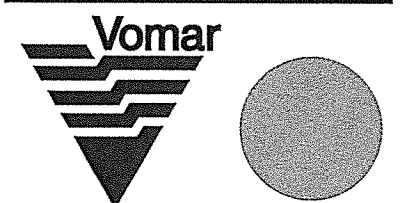


Vomar Products, Inc.
7800 Deering Avenue
Canoga Park, CA 91304-5005
Tel: 818-610-5115
Fax: 818-610-5123
E-Mail: info@vomarproducts.com

Sheet Date: 05/20/10

Sheet Number 12.2

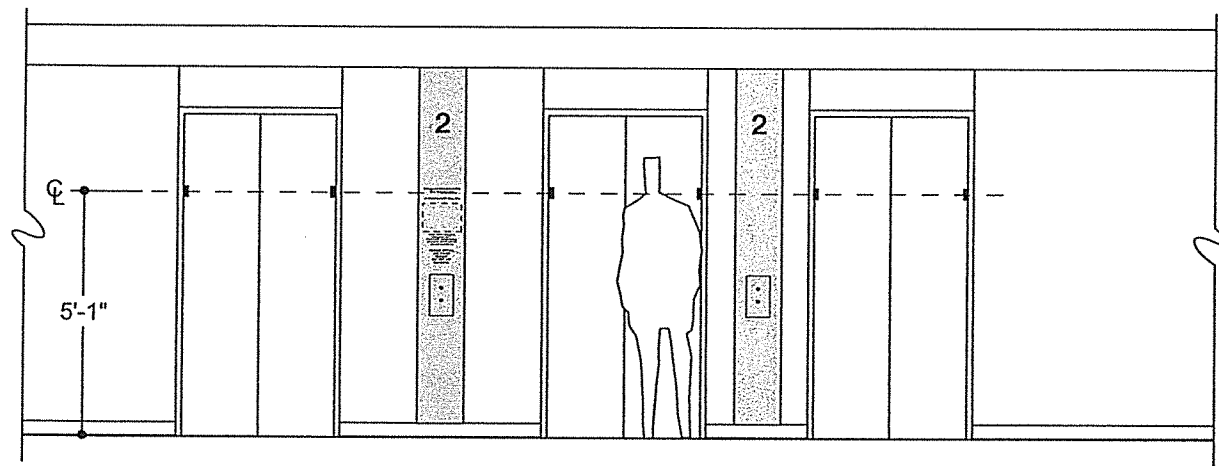

3 Front Elevation
Scale: 1/4" = 1'-0"

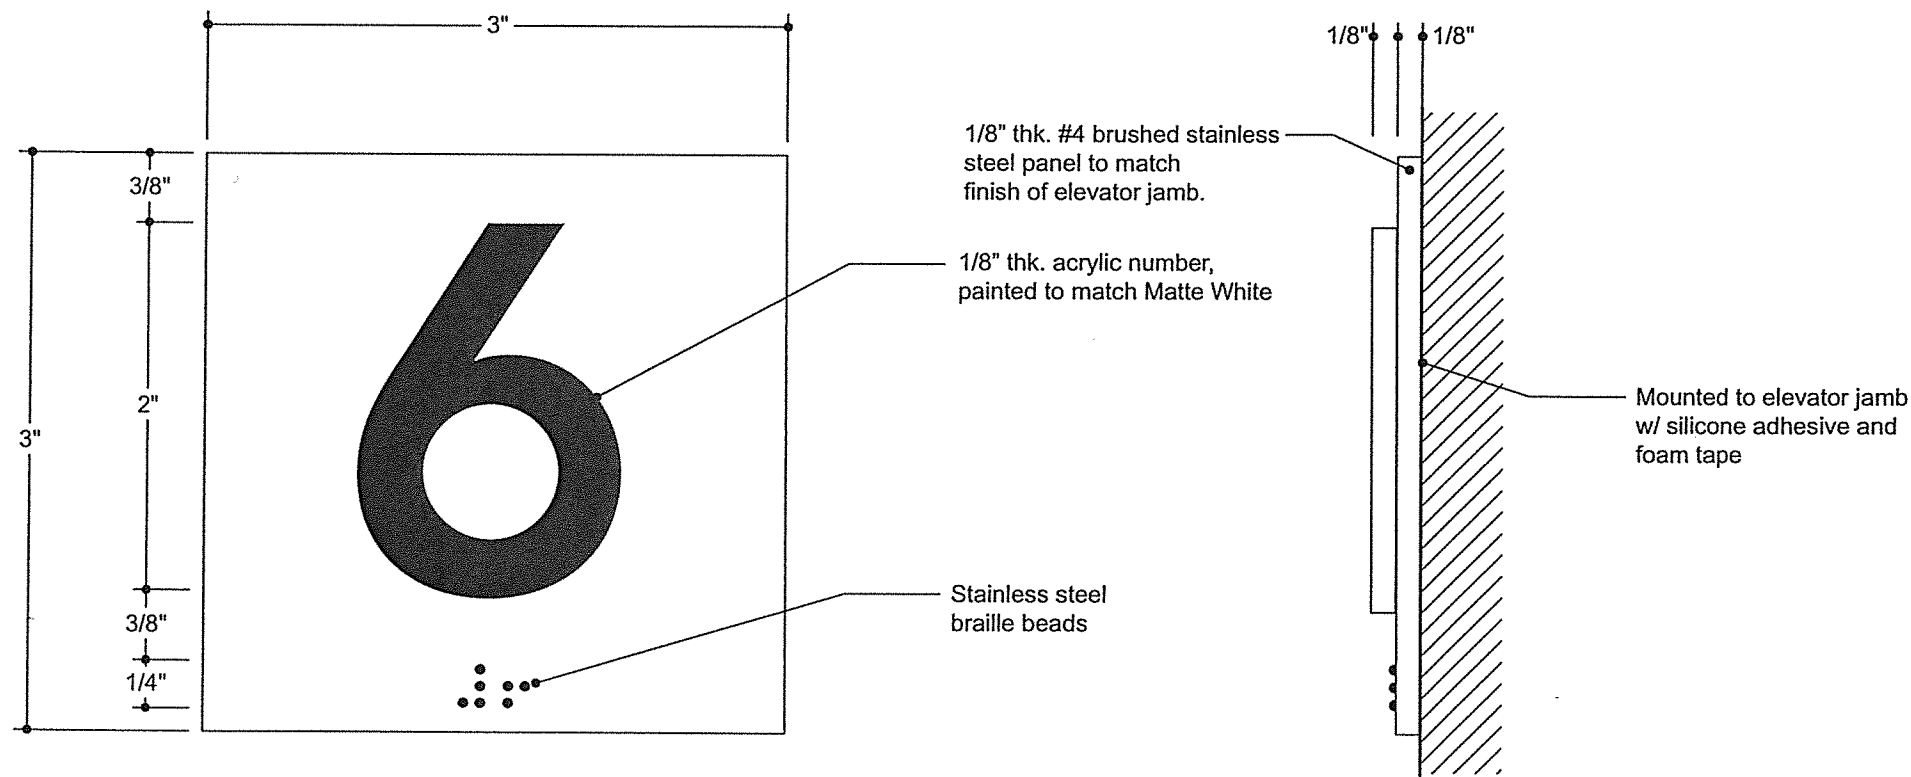

1 Front View
Scale: Full Size

2 Side View
Scale: Full Size

ITEM NO. 13
SIGN TYPE EJI

QTY: 120

SIGN MATERIALS:
3" X 3" X 1/8" THK. #4 BRUSHED
STAINLESS STEEL PLAQUE W/
TACTILE COPY AND BRAILLE.

MOUNTING:
ELEVATOR JAMB MOUNTED

COLOR/FINISH:
REFER ELEVATIONS

FONT:
AVENIR 85 HEAVY

Invoice Number: 48765

Fabrication Drawing

Project
CHILDREN'S HOSPITAL OF
ORANGE COUNTY

Customer
McCARTHY BUILDING CO.
ATT: JAMES BURGGRAB
20401 S.W. BIRCH ST.
NEWPORT BEACH, CA 92660

Designers
FORMATION


Order Item: 13

Sign Type: EJI

Revision No.:

10 Per ASI 183
March 16, 2012


Drawn By: MWilliams

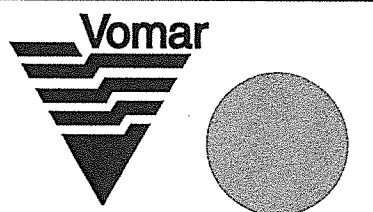


Vomar Products, Inc.
7800 Deering Avenue
Canoga Park, CA 91304-5005
Tel: 818-610-5115
Fax: 818-610-5123
E-Mail: info@vomarproducts.com

Sheet Date: 05/20/10


Sheet Number 13.0

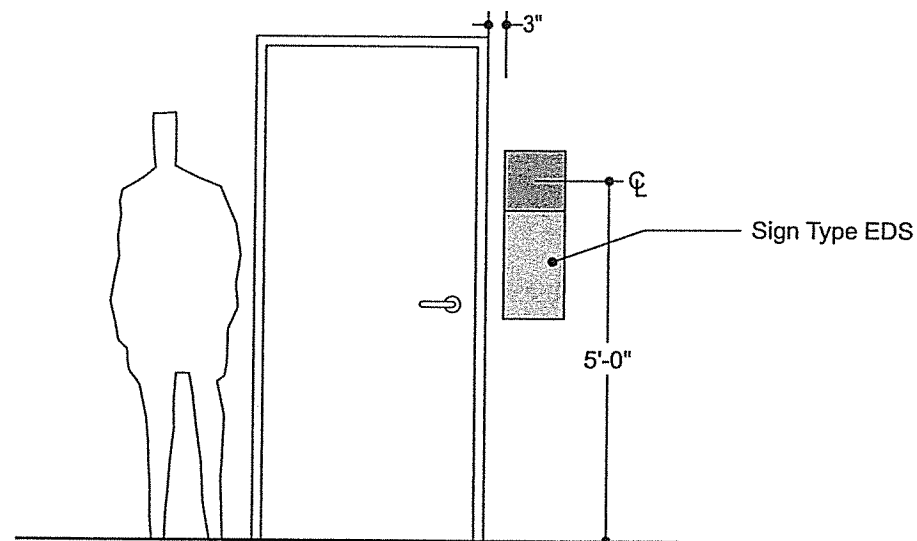

4 Front Elevation @ Stairs
Scale: 3/8" = 1'-0"

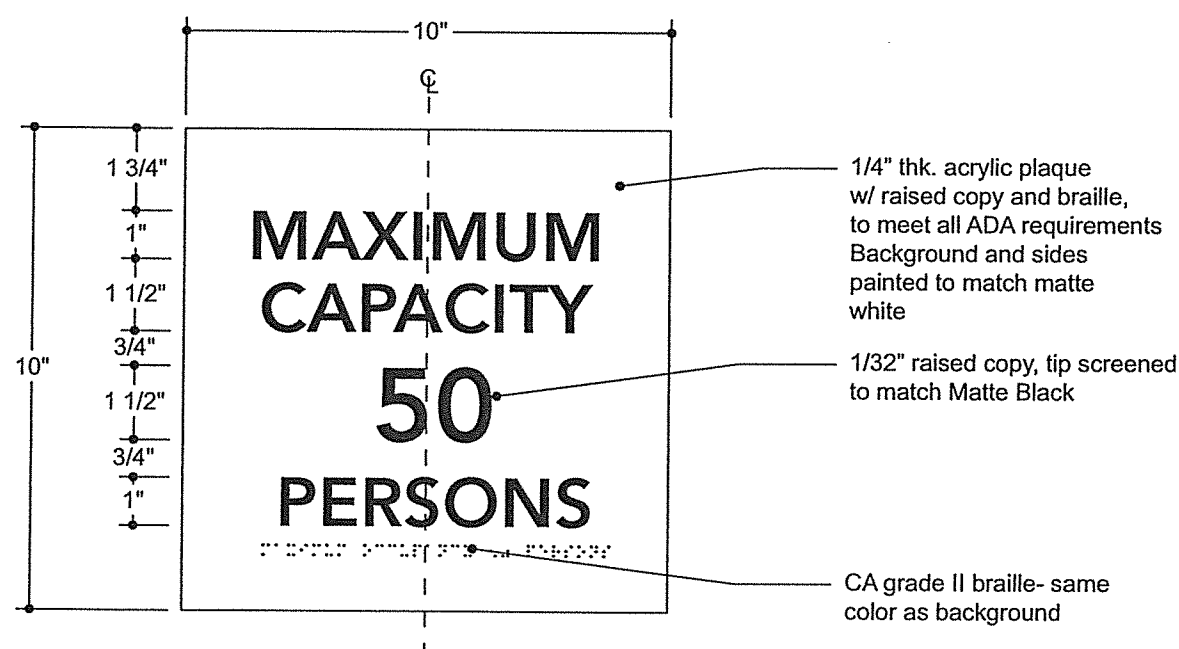

1 Front View
Scale: 3" = 1'-0"

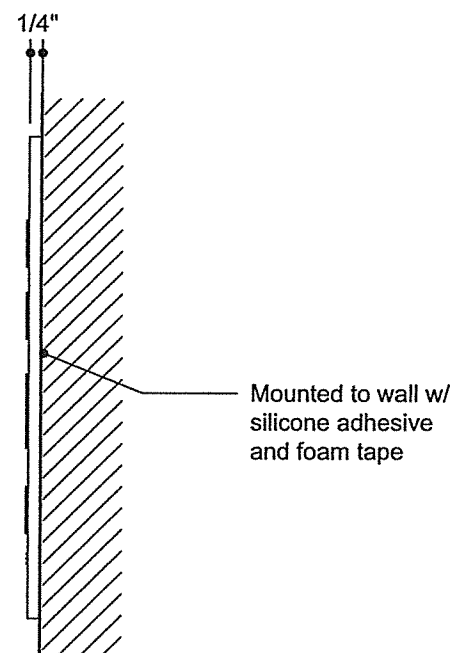

2 Side View
Scale: 3" = 1'-0"

ITEM NO. 14
SIGN TYPE MOP

QTY: 24

SIGN MATERIALS:
6" X 6" X 1/8" THK. UNFRAMED
TACTILE PLAQUE W/ RAISED COPY &
BRAILLE

MOUNTING:
WALL SURFACE MOUNTED

COLOR/FINISH:
REFER ELEVATIONS

FONT:
AVENIR 85 HEAVY

Invoice Number: 48765

Fabrication Drawing

Project
CHILDREN'S HOSPITAL OF
ORANGE COUNTY

Customer
McCARTHY BUILDING CO.
ATT: JAMES BURGGRAF
20401 S.W. BIRCH ST.
NEWPORT BEACH, CA 92660

Designers
FORMATION

Order Item: 14

Sign Type: MOP

Revision No.:

10 Per ASI 183
March 16, 2012

SHEET 13
DELETED


Drawn By: MWilliams




Vomar Products, Inc.
7800 Deering Avenue
Canoga Park, CA 91304-5005
Tel: 818-610-5115
Fax: 818-610-5123
E-Mail: info@vomarproducts.com

Sheet Date: 05/20/10


Sheet Number 14.0

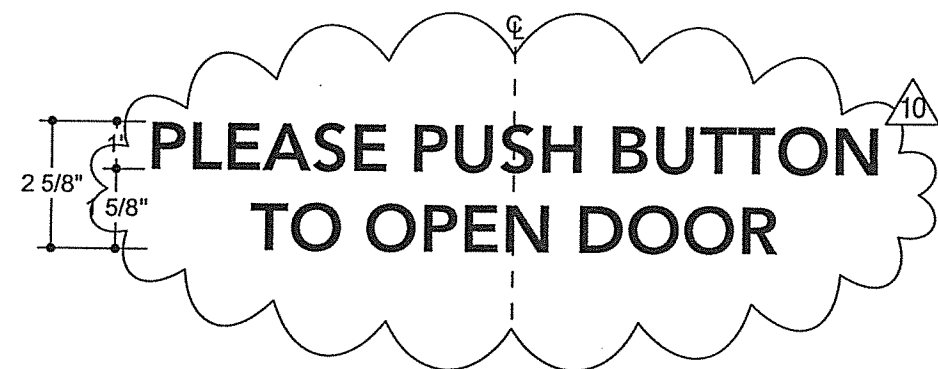

4 Front View - Sign Type DEV (Qty. (18))
Scale: 3" = 1'-0"

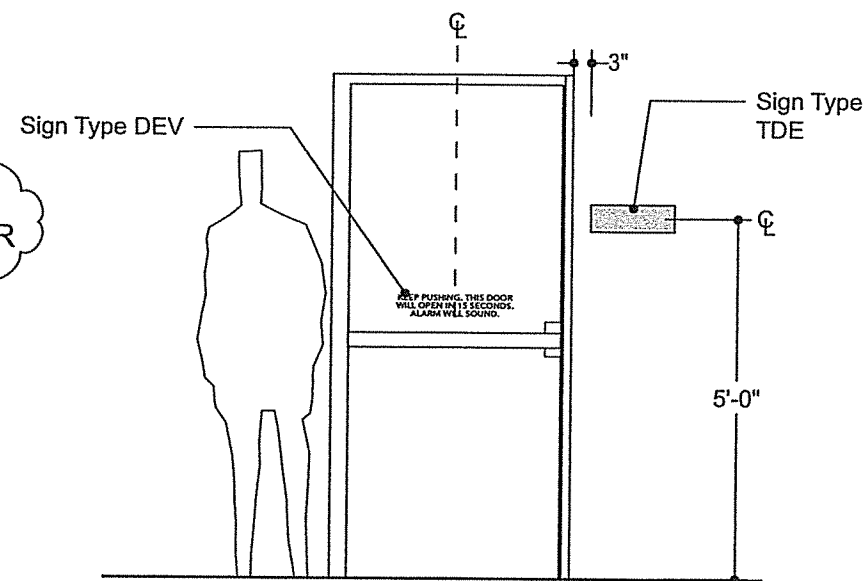


5 Front Elevation @ Stairs
Scale: 3/8" = 1'-0"

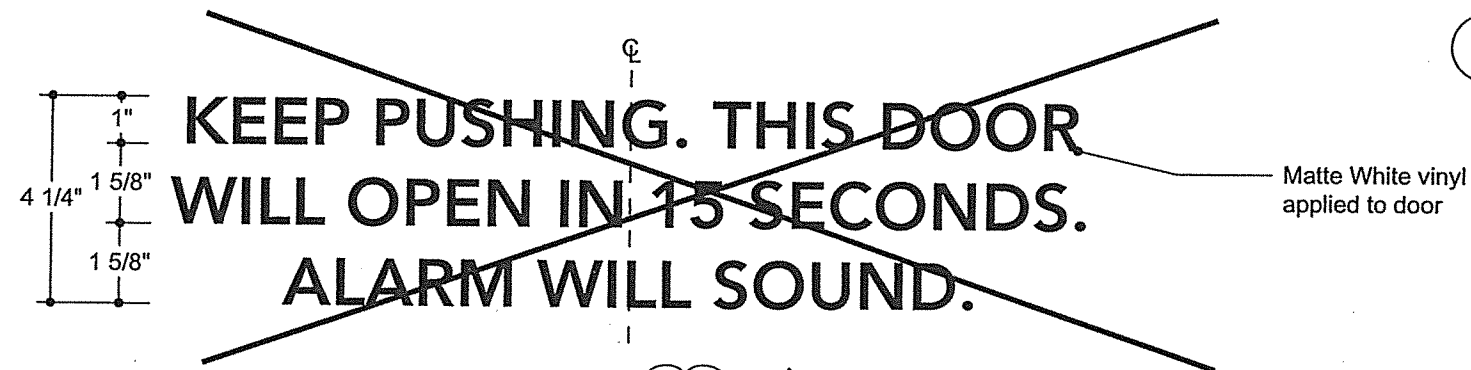


3 Front View - Sign Type DEV (Qty. (1))
Scale: 3" = 1'-0"

Schedule for Sign Type DEV "Please push button to open door."

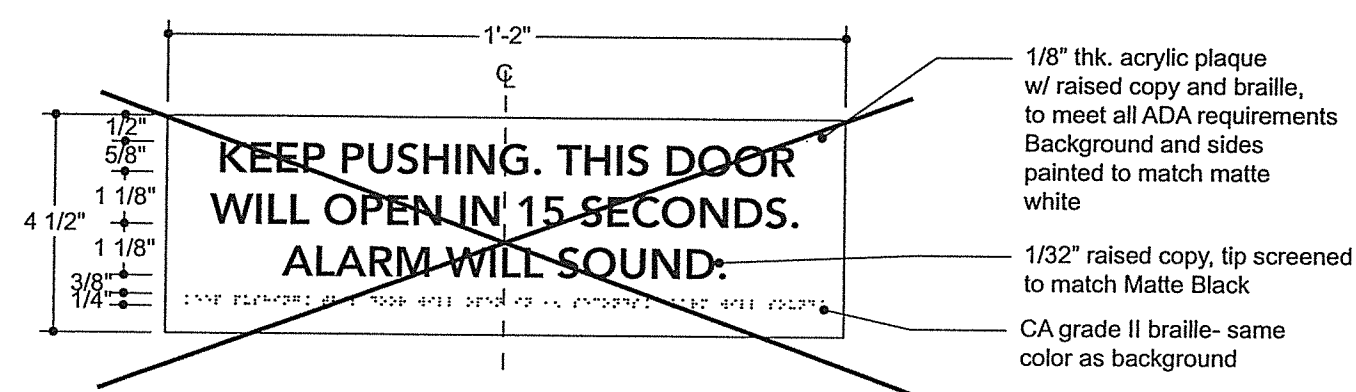

1 Front View - Sign Type TDE (Qty. (1))
Scale: 3" = 1'-0"

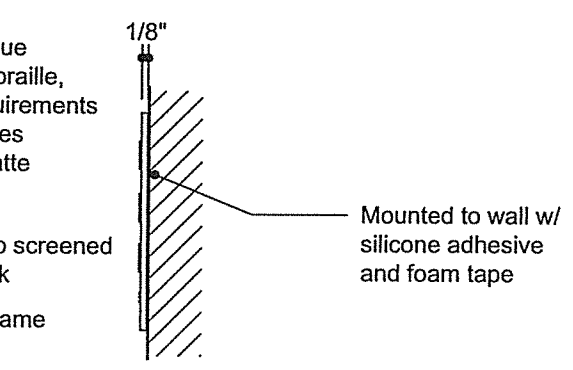

2 Side View
Scale: 3" = 1'-0"

ITEM NO. 15
SIGN TYPE DEV, TDE
QTY: 20
SIGN MATERIALS:
DELAYED EGRESS SIGNS
MOUNTING:
WALL/DOOR SURFACE MOUNTED
COLOR/FINISH:
REFER ELEVATIONS
FONT:
AVENIR 85 HEAVY

1	1.070.00.C
2	1.000.07
3	2.068.00.L
4	3.046.03.C
5	3.046.04.C
6	3.068.00.La
7	3.068.00.Lb
8	3.109.01.C
9	4.081.00.La
10	4.081.00.Lb
11	5.068.00.L
12	6.081.00.L
13	7.081.00.L
14	3.109.04.Ca
15	3.106.00.C
16	3.102.03.C
17	3.001.03.C
18	3.046.01.Ca
19	3.109.03.C
20	1.068.00.Ca
21	1.050.00.C
22	3.001.04.Ca
23	3.001.00.Cb
24	3.001.04.Cb
25	3.001.46.C
26	3.000.00.C
27	R.069
28	1.070.54.V

Invoice Number: 48765
Fabrication Drawing
Project: CHILDREN'S HOSPITAL OF ORANGE COUNTY
Customer: McCARTHY BUILDING CO. ATT: JAMES BURGGRAF 20401 S.W. BIRCH ST. NEWPORT BEACH, CA 92660
Designers: FORMATION

Order Item: 15
Sign Type: DEV-TDV
Revision No.:
10 Per ASI 183 March 16, 2012
11 Per ASI 180 March 16, 2012
13 Per Sample Review May 4, 2012

Drawn By: MWilliams
Vomar
Vomar Products, Inc. 6-8-12
7800 Deering Avenue
Canoga Park, CA 91304-5005
Tel: 818-610-5115
Fax: 818-610-5123
E-Mail: info@vomarproducts.com

Sheet Date: 05/20/10
Sheet Number 15.0

Schedule for Sign
Type DEV "Please
push button to open
door.

11

- | | |
|----|-------------|
| 1 | 1.070.00.C |
| 2 | 1.000.07 |
| 3 | 2.068.00.L |
| 4 | 3.046.03.C |
| 5 | 3.046.04.C |
| 6 | 3.068.00.La |
| 7 | 3.068.00.Lb |
| 8 | 3.109.01.C |
| 9 | 4.081.00.La |
| 10 | 4.081.00.Lb |
| 11 | 5.068.00.L |
| 12 | 6.081.00.L |
| 13 | 7.081.00.L |
| 14 | 3.109.04.Ca |
| 15 | 3.106.00.C |
| 16 | 3.102.03.C |
| 17 | 3.001.03.C |
| 18 | 3.046.01.Ca |
| 19 | 3.109.03.C |
| 20 | 1.068.00.Ca |
| 21 | 1.050.00.C |
| 22 | 3.001.04.Ca |
| 23 | 3.001.00.Cb |
| 24 | 3.001.04.Cb |
| 25 | 3.001.46.C |
| 26 | 3.000.00.C |
| 27 | R.069 |
| 28 | 1.070.54.V |

Invoice Number: 48765

Fabrication
Drawing

Project
CHILDREN'S HOSPITAL OF
ORANGE COUNTY

Customer
McCARTHY BUILDING CO.
ATT: JAMES BURGGRAB
20401 S.W. BIRCH ST.
NEWPORT BEACH, CA 92660

Designers
FORMATION


Order Item: 15

Sign Type: DEV-TDV

Revision No.:

11 Per ASI 180
March 16, 2012

Drawn By: MWilliams

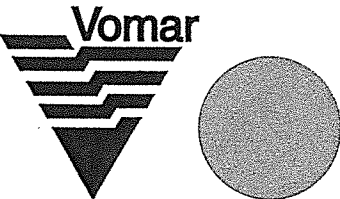

Vomar Products, Inc.
7800 Deering Avenue
Canoga Park, CA 91304-5005
Tel: 818-610-5115
Fax: 818-610-5123
E-Mail: info@vomarproducts.com

Sheet Date: 05/20/10

Sheet Number 15.1

Project
CHILDREN'S HOSPITAL OF
ORANGE COUNTY

Designers

FORMATION




8 Per ASI #129
December 9, 2011

Sheet Number 16.0

FONT:
FONT AS SHOWN ON DESIGN
DOCUMENTS.

TRANSLUCENT COLOR SAMPLES
FORTHCOMING FOR COLOR
MATCH

1. Undulating panels provided by others.
2. Vomar to cut thru number forms.
3. Vomar to cut push thru numerals to align with tallest/highest panel undulation.
4. Push thru numerals to be digitally sub surface printed to match level color.
5. Install "white coat aluminum" enclosure to rear of panel with LED light modules mounted to the sides only.
6. Transformer to be located in lower portion of millwork.

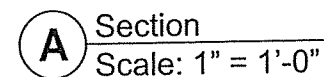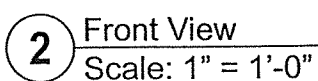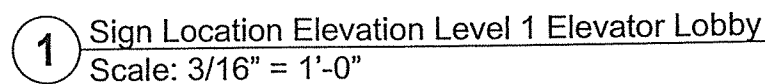

All provided panels to be 4'-0" in height

Fabrication Drawing

Project
CHILDREN'S HOSPITAL OF
ORANGE COUNTY


Customer
McCARTHY BUILDING CO.
ATT: JAMES BURGGRAF
20401 S.W. BIRCH ST.
NEWPORT BEACH, CA 92660

Designers
FORMATION

Order Item: 16


Sign Type: LID

Revision No.:

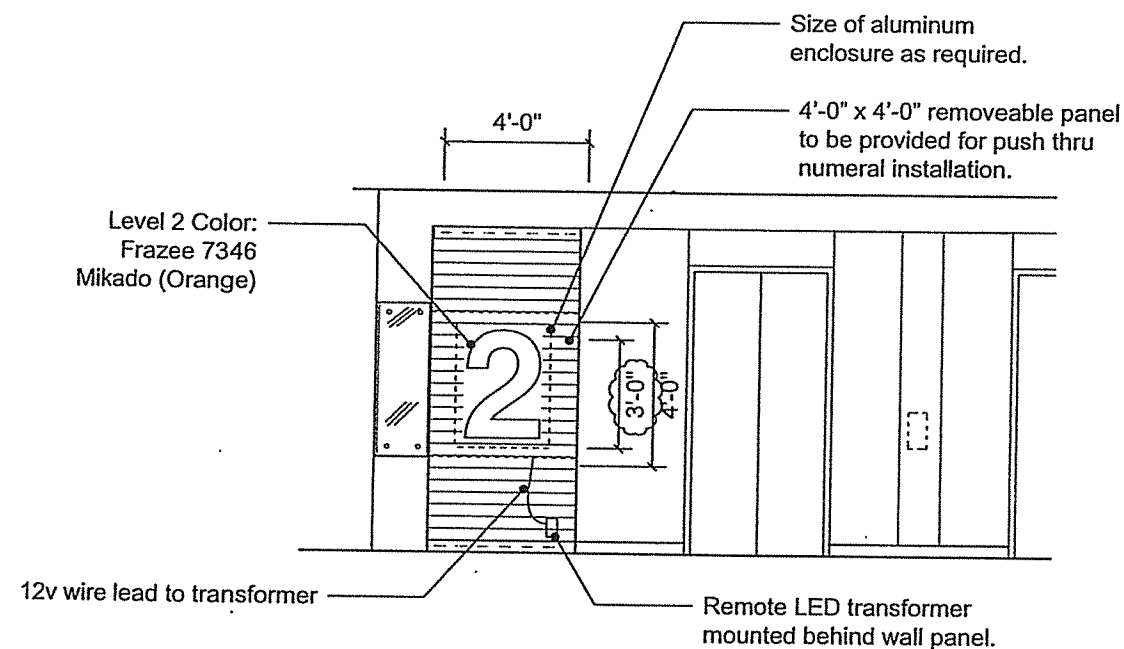


1 Sign Location Elevation Level 2
Scale: 3/16" = 1'-0"

Color: (RFI Pending)

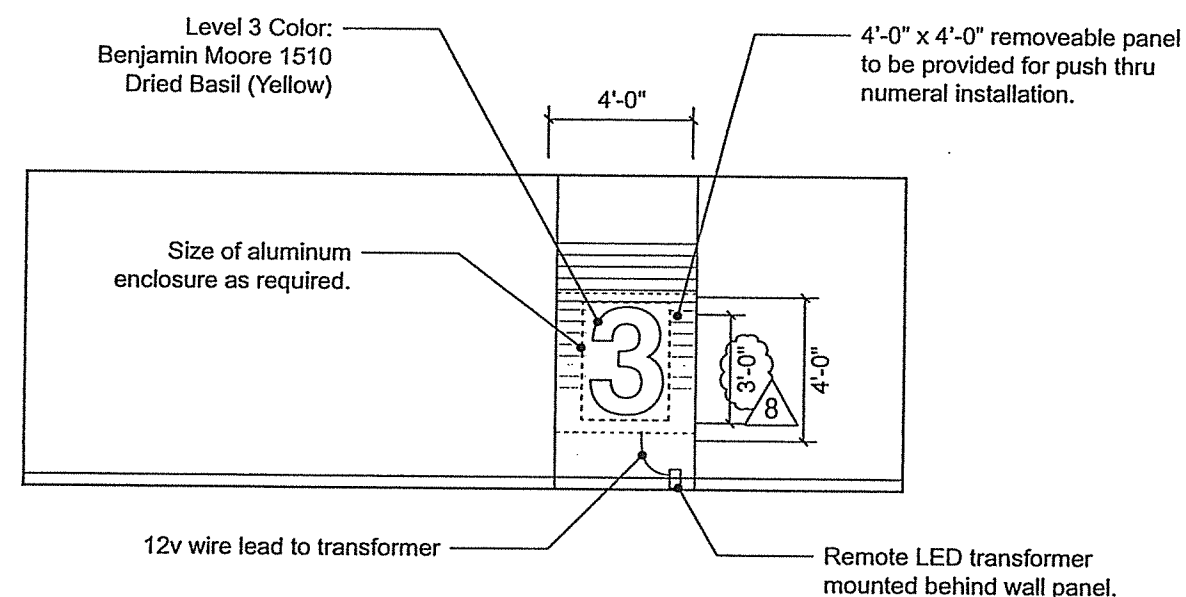


2 Sign Location Elevation Level 3 Elevator 2
Scale: 3/16" = 1'-0"

Color: (RFI Pending)

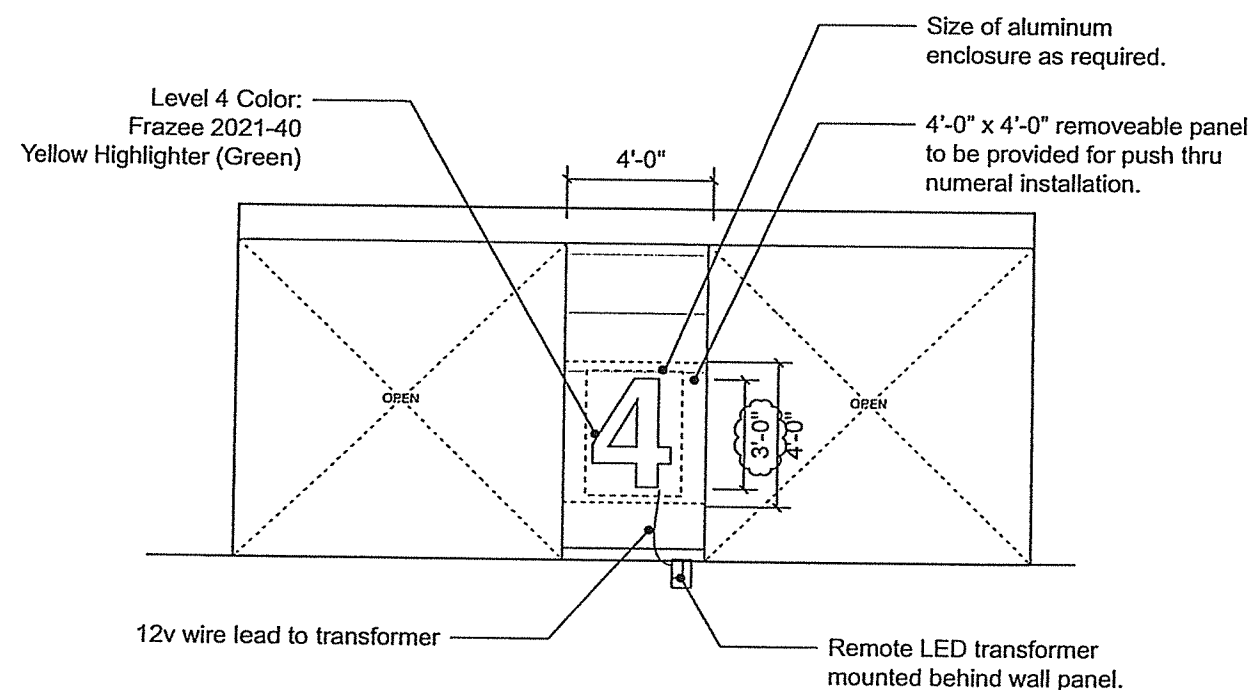

3 Sign Location Elevation Level 4 Elevator Lobby 2
Scale: 3/16" = 1'-0"


Color: (RFI Pending)

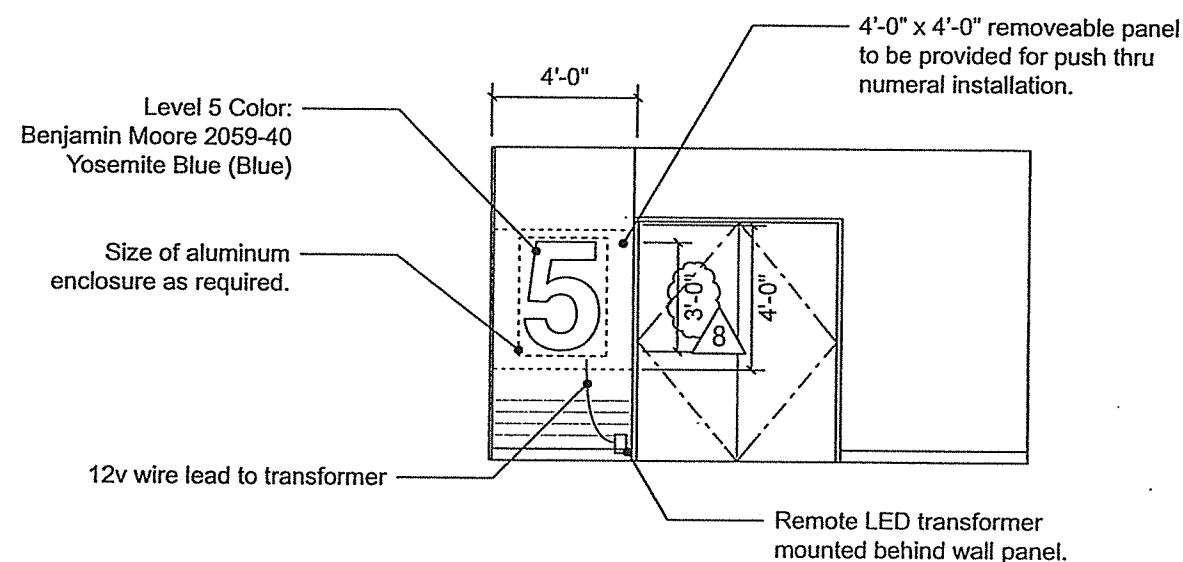

4 Sign Location Elevation Level 5
Scale: 3/16" = 1'-0"

Color: (RFI Pending)

Drawn By: RA

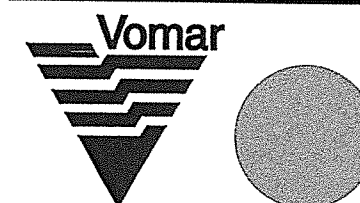

Vomar Products, Inc.
7800 Deering Avenue
Canoga Park, CA 91304-5005
Tel: 818-610-5115
Fax: 818-610-5123
E-Mail: info@vomarproducts.com

Sheet Date: 3/07/12

Sheet Number 16.1

Fabrication
Drawing

Project
CHILDREN'S HOSPITAL OF
ORANGE COUNTY


Customer
McCARTHY BUILDING CO.
ATT: JAMES BURGGRAB
20401 S.W. BIRCH ST.
NEWPORT BEACH, CA 92660

Designers
FORMATION


Order Item: 16

Sign Type: LID

Revision No.:

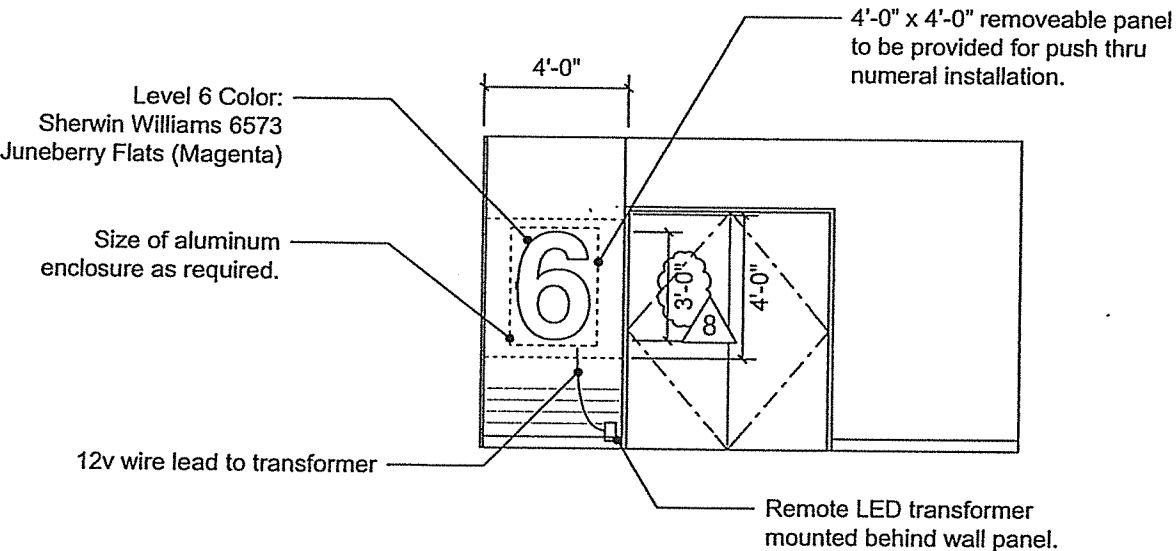


① Sign Location Elevation Level 6
Scale: 3/16" = 1'-0"
Color: (RFI Pending)

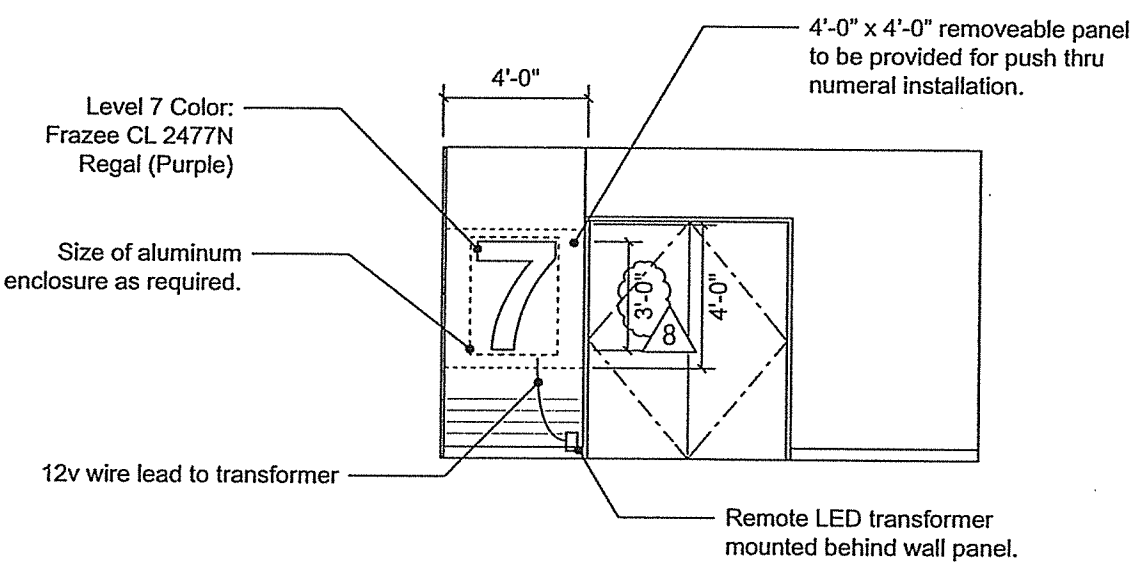

② Sign Location Elevation Level 7
Scale: 3/16" = 1'-0"
Color: (RFI Pending)

Drawn By: RA

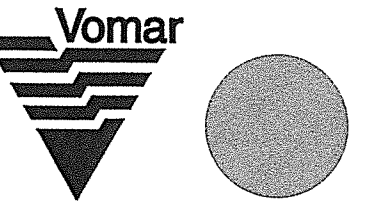

Vomar Products, Inc.
7800 Deering Avenue
Canoga Park, CA 91304-5005
Tel: 818-610-5115
Fax: 818-610-5123
E-Mail: info@vomarproducts.com

Sheet Date: 3/07/12

Sheet Number 16.2

Fabrication Drawing

Project
CHILDREN'S HOSPITAL OF
ORANGE COUNTY



Customer
McCARTHY BUILDING CO.
ATT: JAMES BURGGRAF
20401 S.W. BIRCH ST.
NEWPORT BEACH, CA 92660

Designers
FORMATION


Order Item: 16

Sign Type: LID

Revision No.:

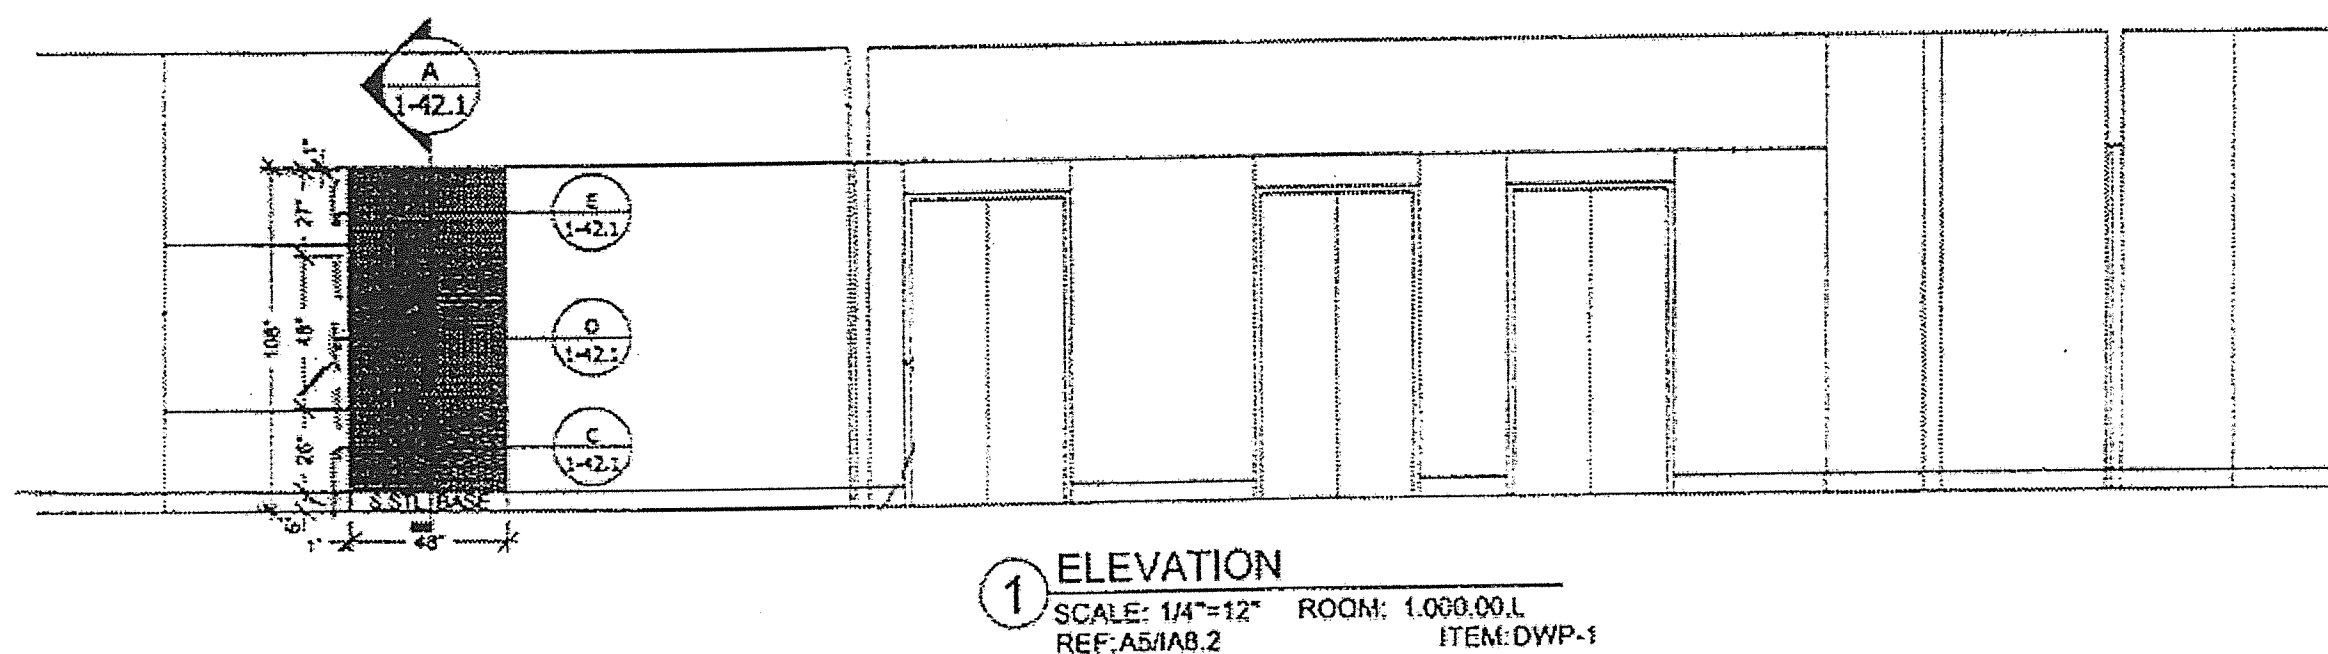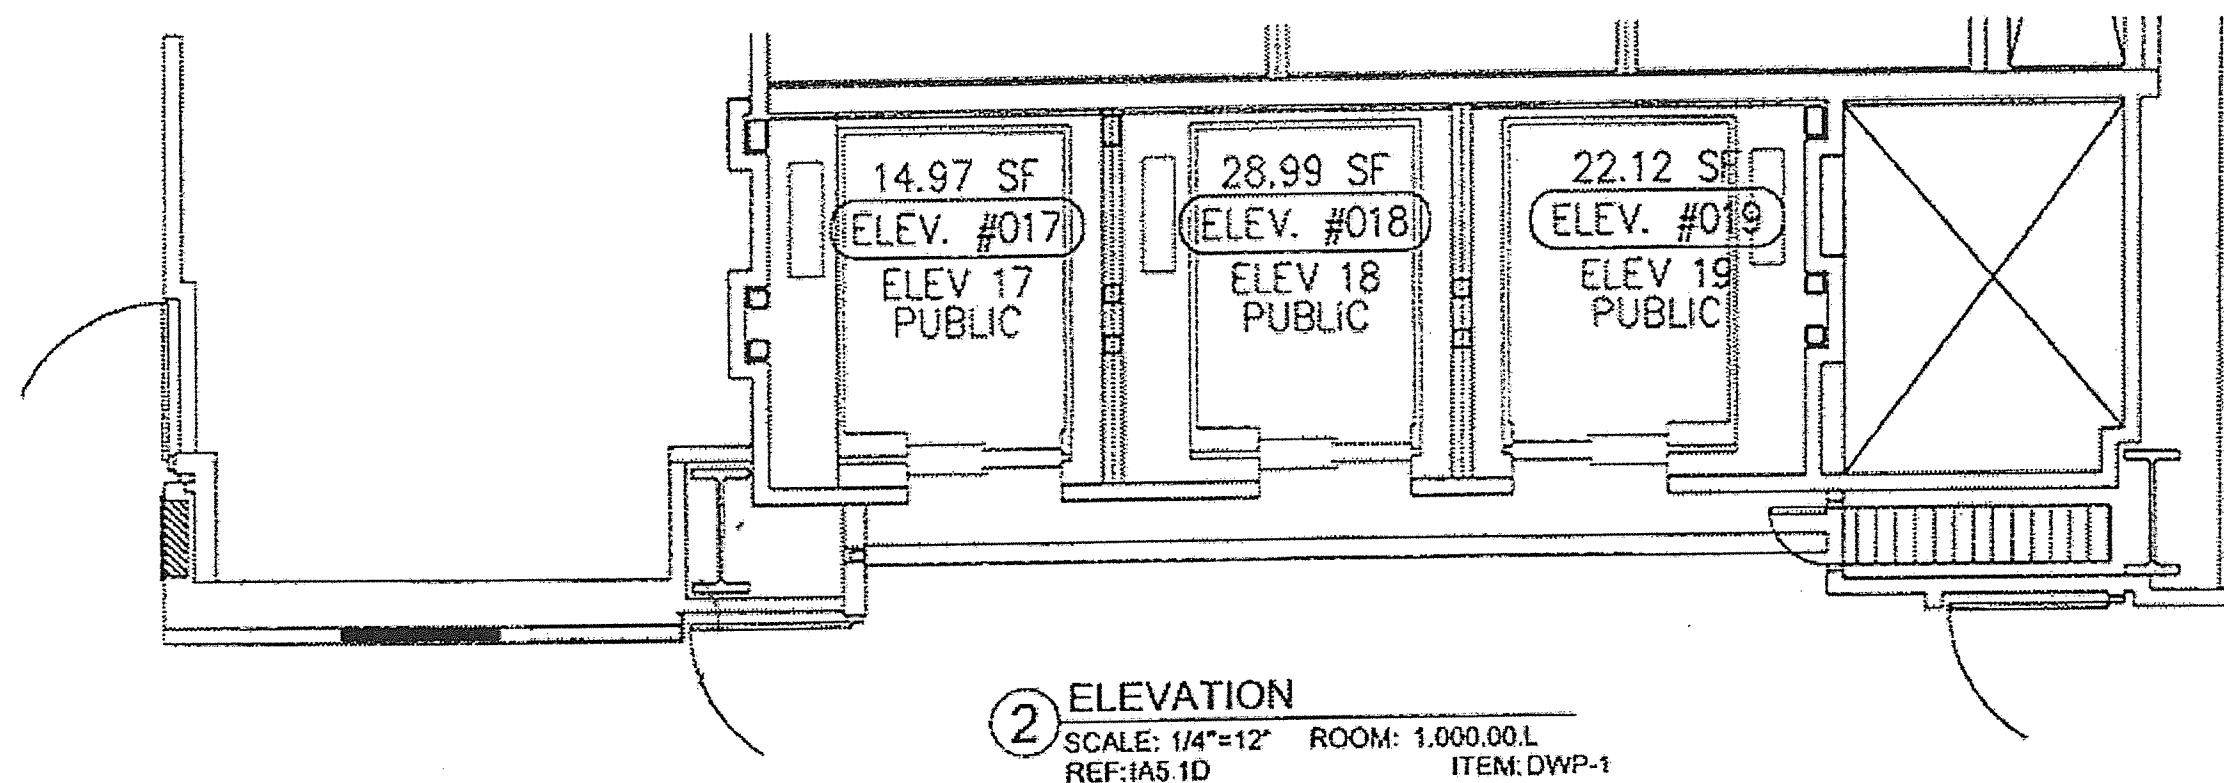


Drawn By: RA

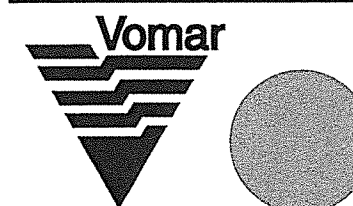


Vomar Products, Inc.
7800 Deering Avenue
Canoga Park, CA 91304-5005
Tel: 818-610-5115
Fax: 818-610-5123
E-Mail: info@vomarproducts.com

Sheet Date: 3/07/12

Sheet Number 16.3

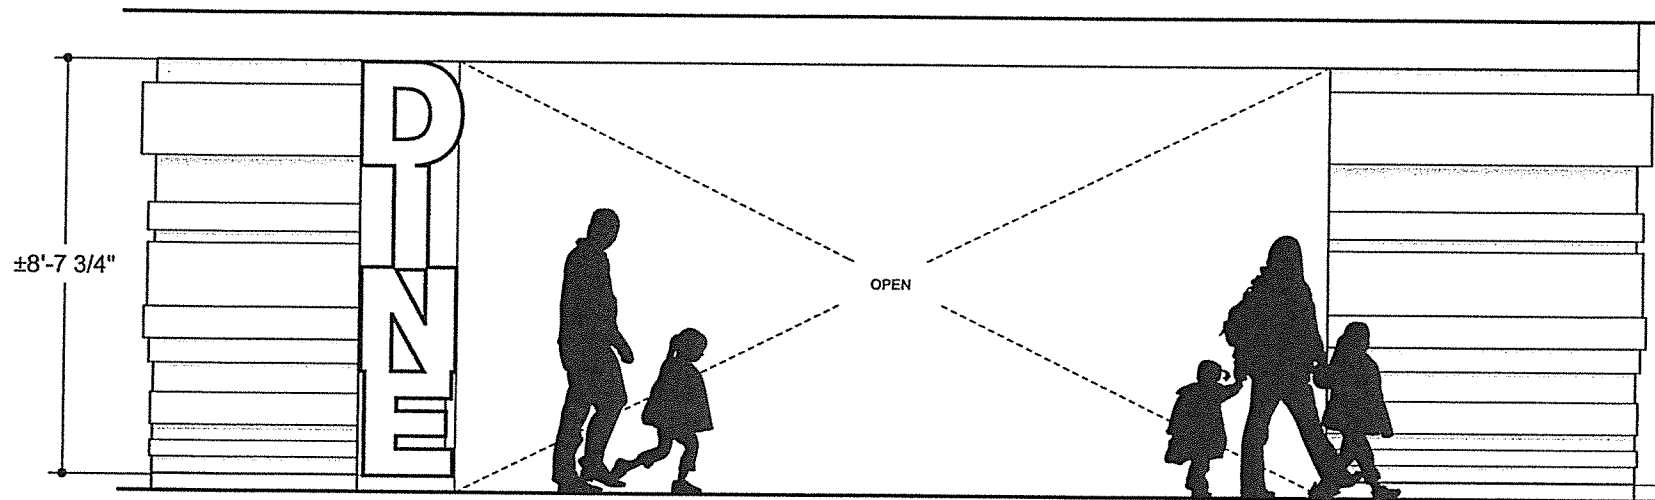


4 Front Elevation
Scale: 1/4" = 1'-0"

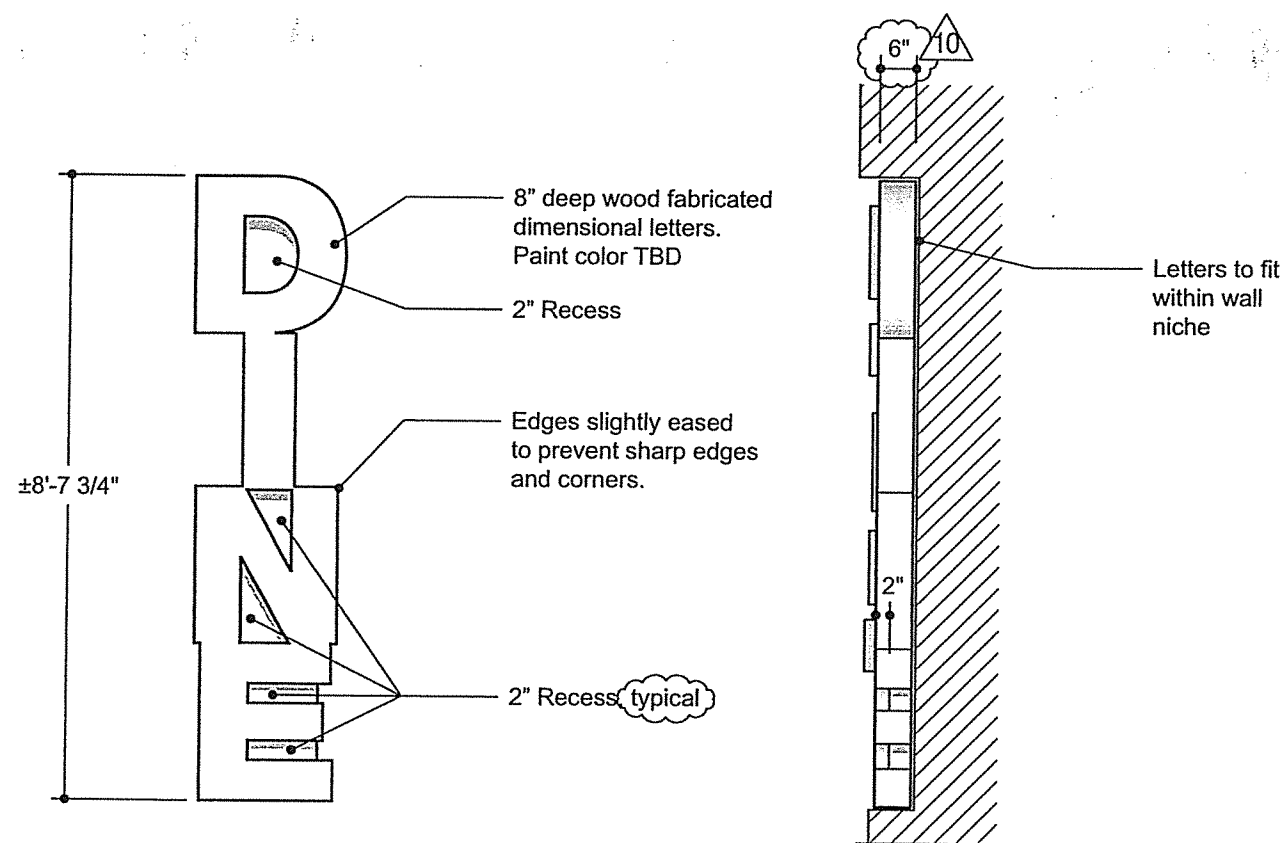

1 Front View
Scale: 3/8" = 1'-0"

2 Side View
Scale: 3/8" = 1'-0"

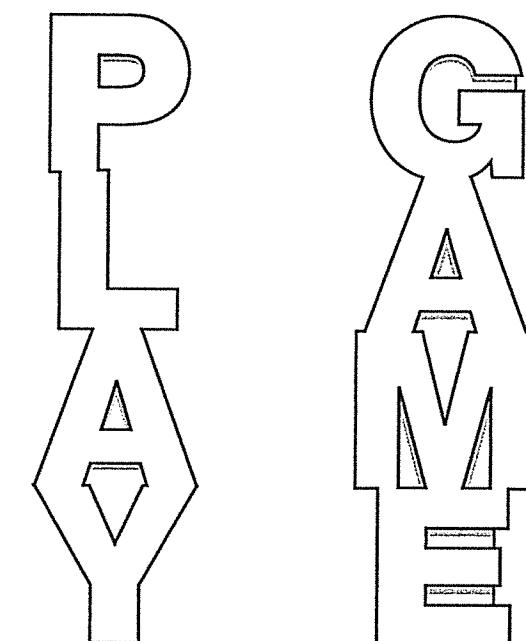

3 Copy Layout
Scale: 3/8" = 1'-0"

ITEM NO. 17
SIGN TYPE ML

10 QTY: 5

SIGN MATERIALS:
8'-7 3/4" H X 8" DEEP
NON-ILLUMINATED FABRICATED
DIMENSIONAL LETTERFORMS
PAINTED TO MATCH SURROUNDING
WALL SURFACE

MOUNTING:
WALL SURFACE MOUNTED

COLOR/FINISH:
REFER ELEVATIONS

FONT:
AVENIR 85 HEAVY

Invoice Number: 48765

Fabrication Drawing

Project
CHILDREN'S HOSPITAL OF
ORANGE COUNTY

Customer
McCARTHY BUILDING CO.
ATT: JAMES BURGGRAF
20401 S.W. BIRCH ST.
NEWPORT BEACH, CA 92660

Designers
FORMATION

Order Item: 17

Sign Type: ML

Revision No.:

10 Per ASI 183
March 16, 2012

14 Per RFI 5669
June 8, 2012

NEW COLOR -
PROVIDE SAMPLE FOR
IN HOUSE REVIEW.
FRAZEE WEAVERBIRD
7760W


Drawn By: MWilliams




Vomar Products, Inc.
7800 Deering Avenue
Canoga Park, CA 91304-5005
Tel: 818-610-5115
Fax: 818-610-5123
E-Mail: info@vomarproducts.com

Sheet Date: 05/20/10


Sheet Number 17.0

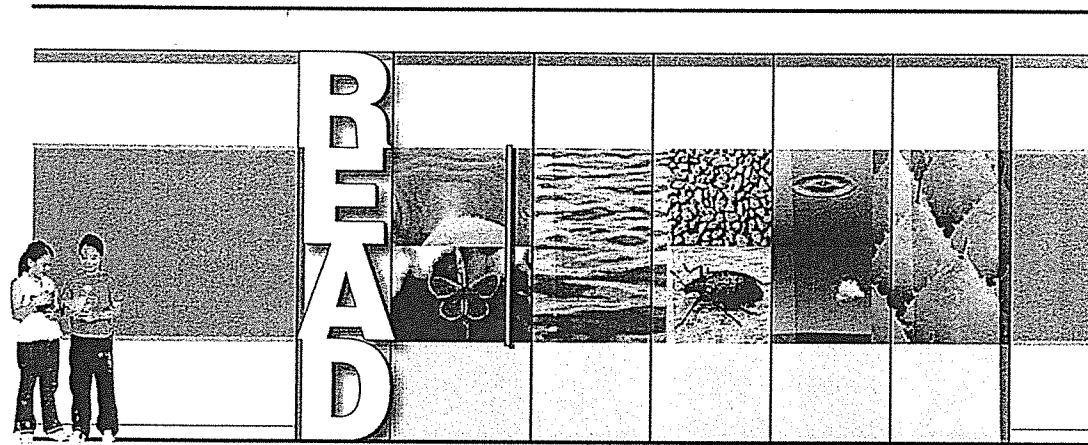

7 Front Elevation @ Bookstore
Scale: NTS

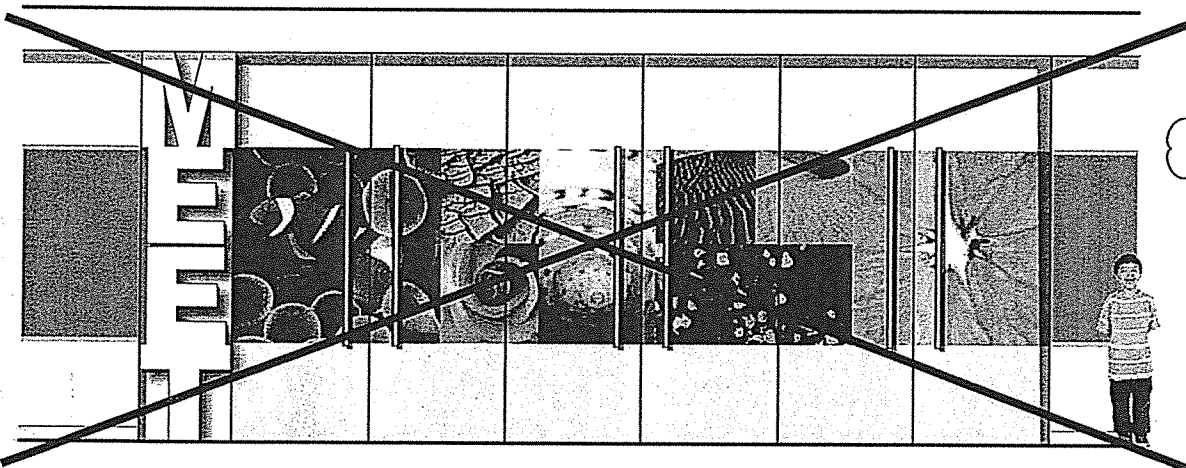


6 Front Elevation @ Meeting Room
Scale: NTS

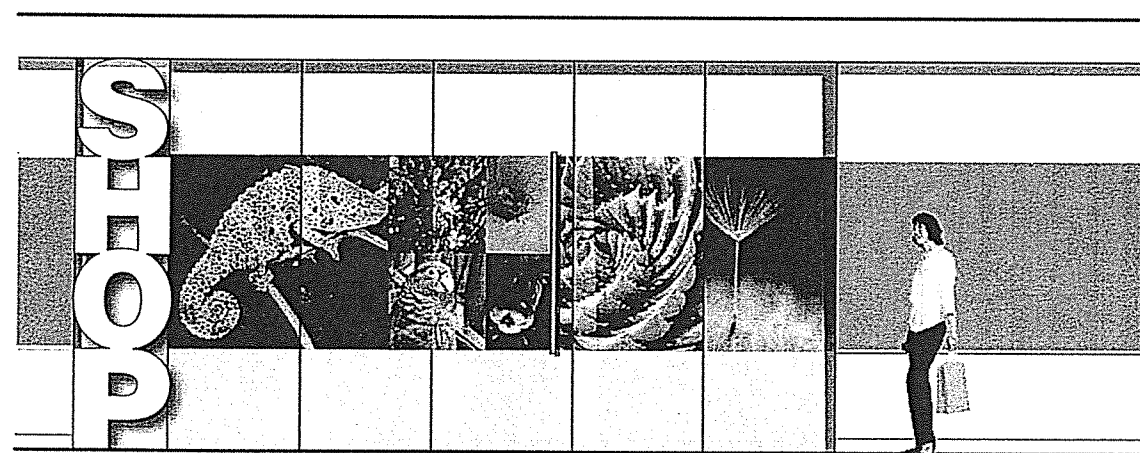

5 Front Elevation @ Gift Shop
Scale: NTS

DELETED ¹⁴

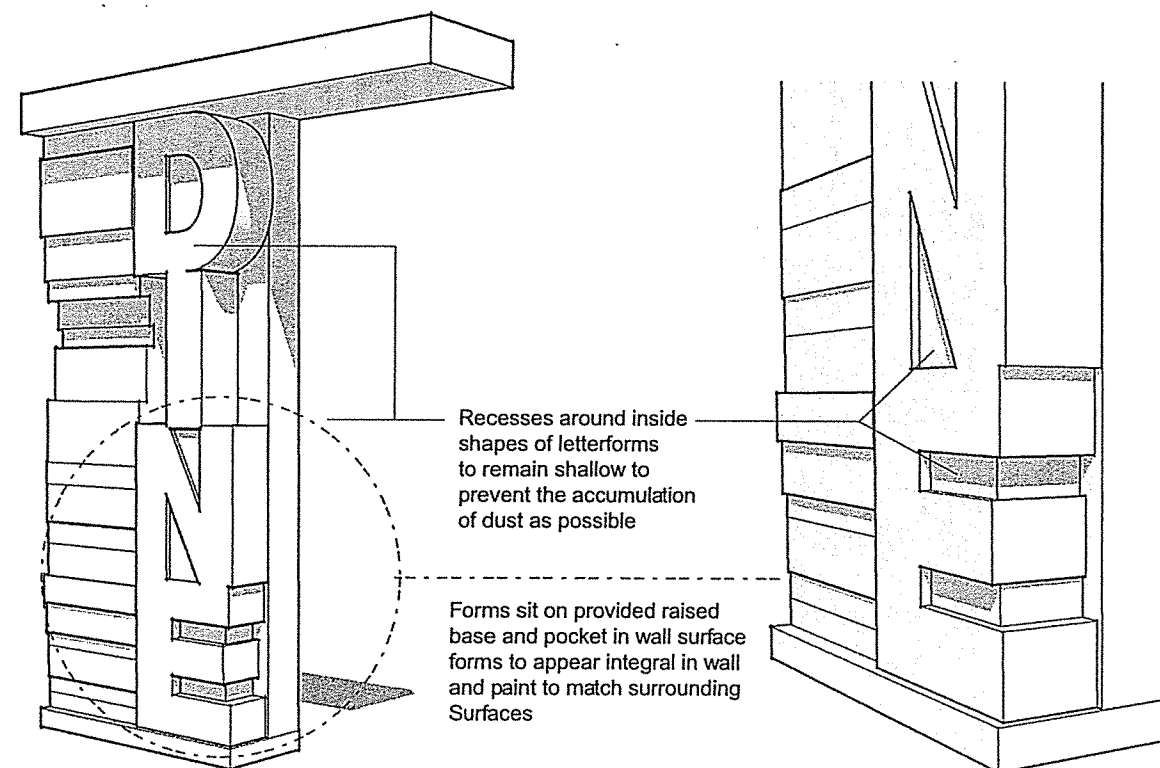

8 Isometric View
Scale: NTS

Invoice Number: 48765

Fabrication Drawing

Project
CHILDREN'S HOSPITAL OF
ORANGE COUNTY

Customer
McCARTHY BUILDING CO.
ATT: JAMES BURGGRAF
20401 S.W. BIRCH ST.
NEWPORT BEACH, CA 92660

Designers
FORMATION

Order Item: 17

Sign Type: ML

Revision No.:

¹⁴ Per Returned Submittal
May 18, 2012


Drawn By: MWilliams




Vomar Products, Inc.
7800 Deering Avenue
Canoga Park, CA 91304-5005
Tel: 818-610-5115
Fax: 818-610-5123
E-Mail: info@vomarproducts.com

Sheet Date: 05/20/10

Sheet Number 17.1

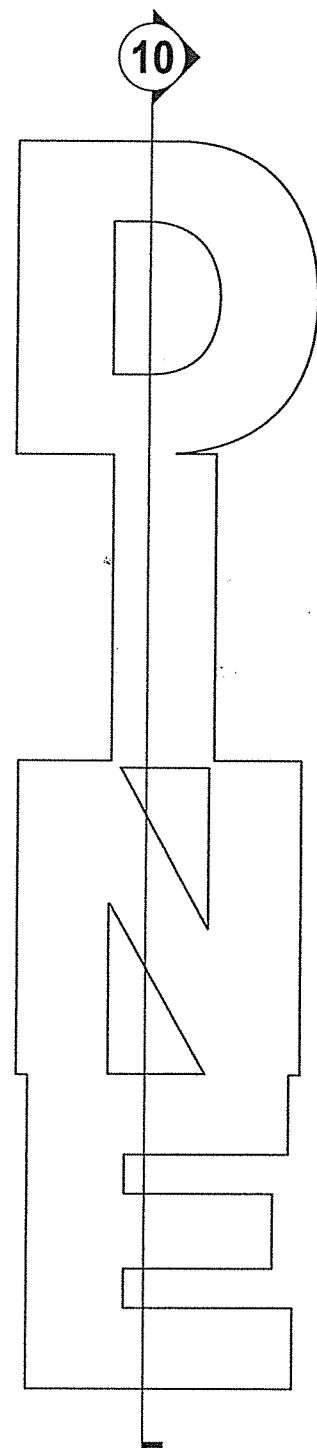

9 Front View
Scale: 3/4" = 1'-0"

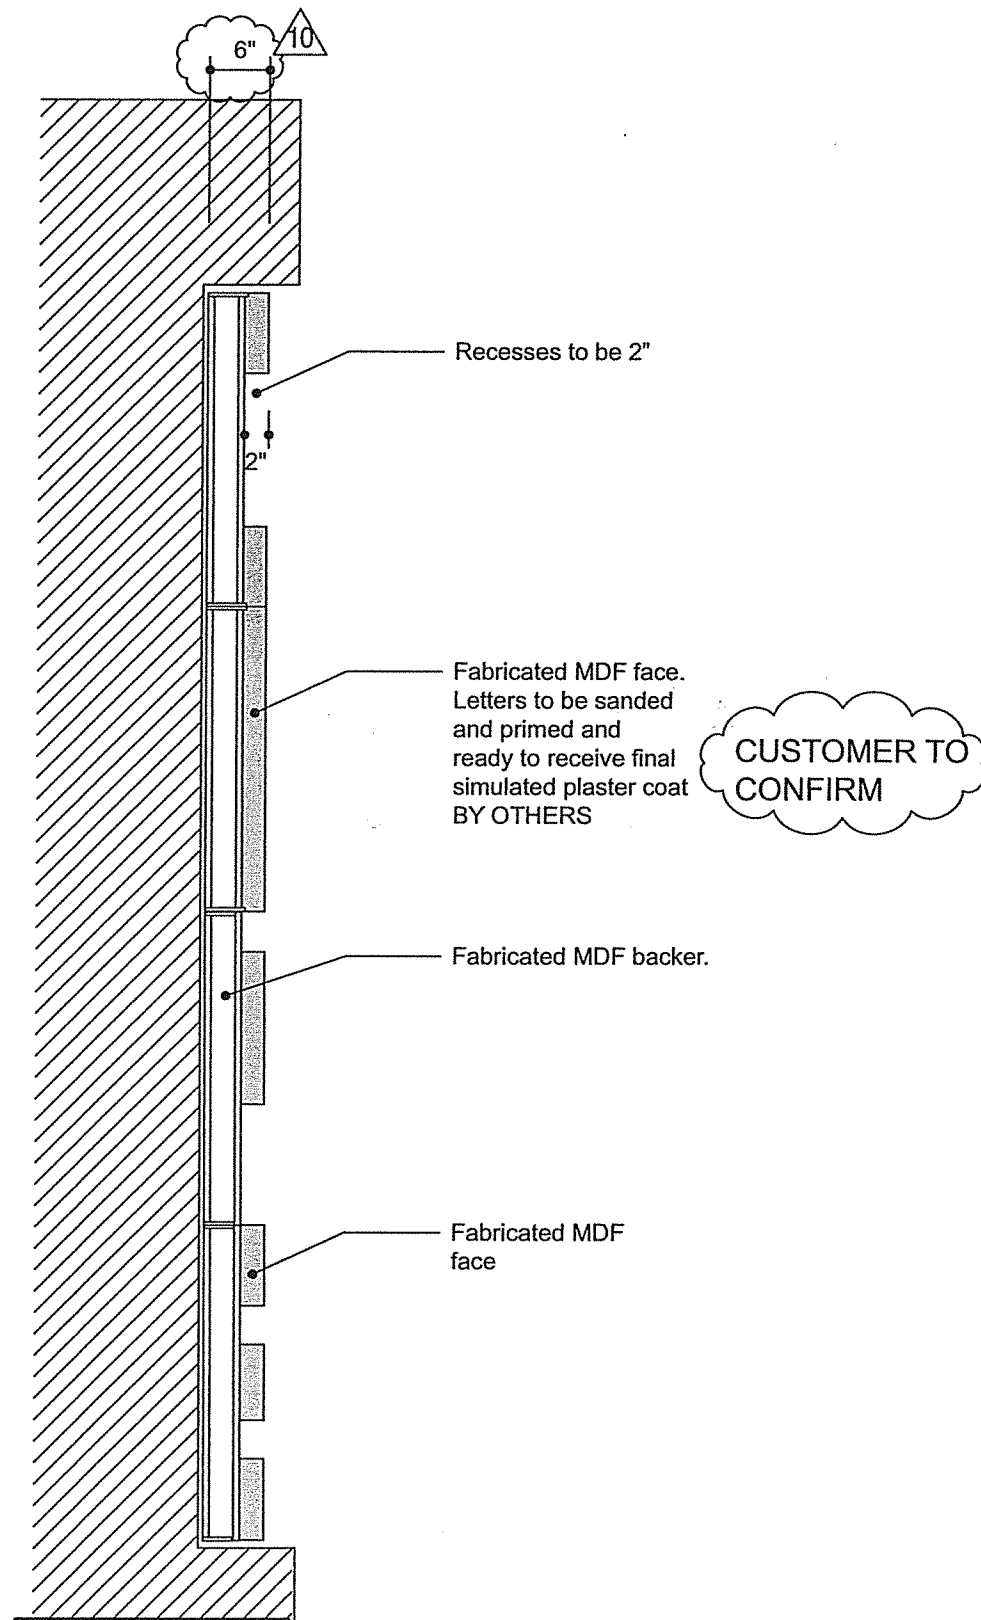

10 Section
Scale: 3/4" = 1'-0"

Invoice Number: 48765

Fabrication Drawing

Project
CHILDREN'S HOSPITAL OF
ORANGE COUNTY

Customer
McCARTHY BUILDING CO.
ATT: JAMES BURGGRAF
20401 S.W. BIRCH ST.
NEWPORT BEACH, CA 92660

Designers
FORMATION

Order Item: 17

Sign Type: ML

Revision No.:

10 Per ASI 183
March 16, 2012


Drawn By: MWilliams



Vomar Products, Inc. 6-8-12
7800 Deering Avenue
Canoga Park, CA 91304-5005
Tel: 818-610-5115
Fax: 818-610-5123
E-Mail: info@vomarproducts.com

Sheet Date: 05/20/10

Sheet Number 17.2

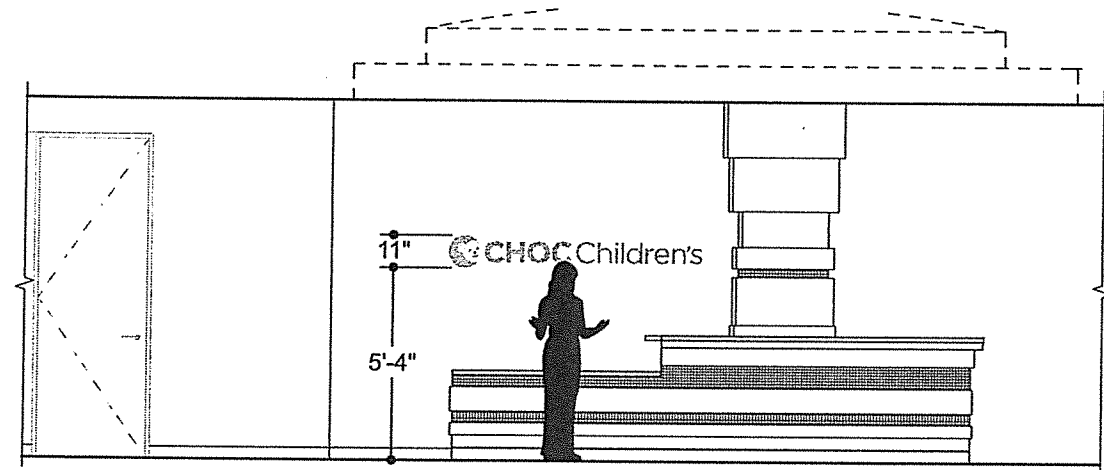

1 Front View
Scale: 1" = 1'-0"

ITEM NO. 18
SIGN TYPE LI

QTY: 2

SIGN MATERIALS:
11" H AND $\pm 8"$ H X $\frac{3}{4}"$ THK. BRUSHED
FINISH STAINLESS STEEL
FABRICATED DISK AND LETTERS.

MOUNTING:
WALL SURFACE MOUNTED

COLOR/FINISH:
REFER ELEVATIONS

FONT:
N/A

Invoice Number: 48765

Fabrication Drawing

Project
CHILDREN'S HOSPITAL OF
ORANGE COUNTY

Customer
McCARTHY BUILDING CO.
ATT: JAMES BURGGRAF
20401 S.W. BIRCH ST.
NEWPORT BEACH, CA 92660


Designers
FORMATION

Order Item: 18

Sign Type: LI


Revision No.:

10 Per ASI 183
March 16, 2012

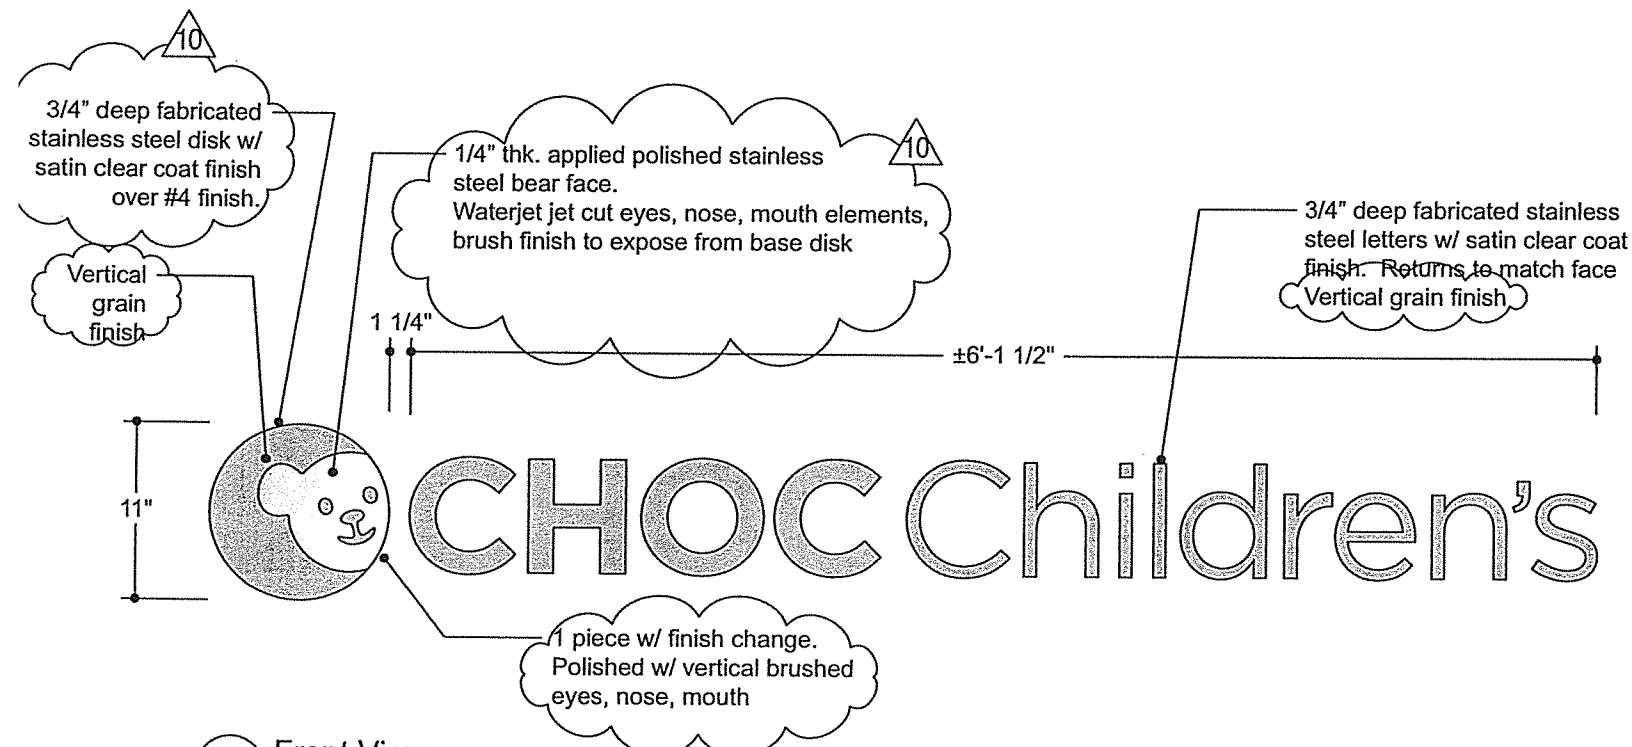

1 Front View
Scale: 1" = 1'-0"

PROVIDE FINISH
SAMPLES FOR REVIEW

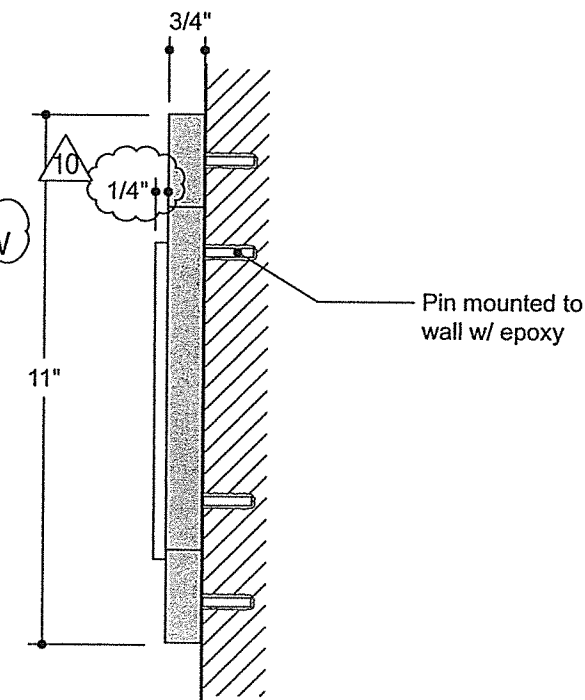

2 Side View
Scale: 3" = 1'-0"



Drawn By: MWilliams



Vomar Products, Inc. 6-8-12
7800 Deering Avenue
Canoga Park, CA 91304-5005
Tel: 818-610-5115
Fax: 818-610-5123
E-Mail: info@vomarproducts.com

Sheet Date: 05/20/10

Sheet Number 18.0

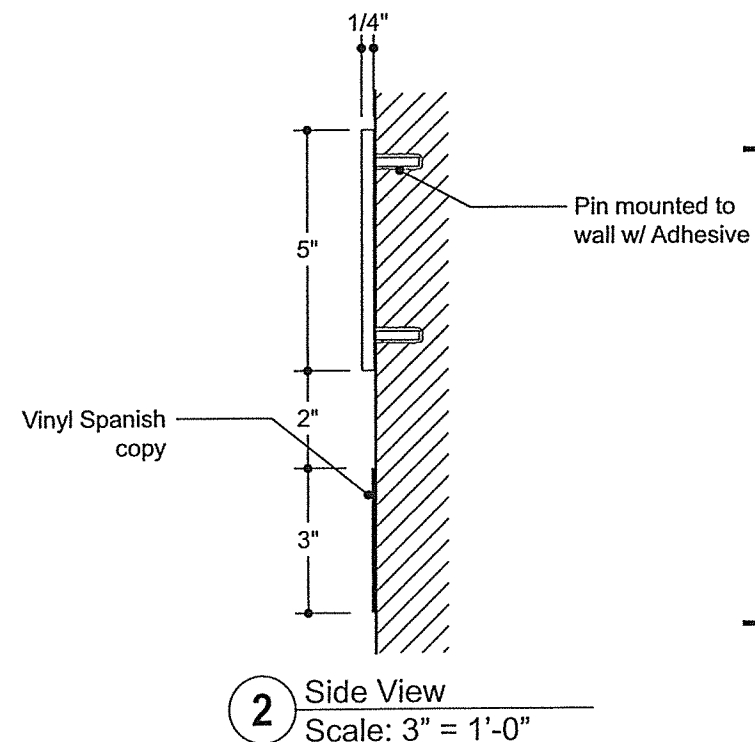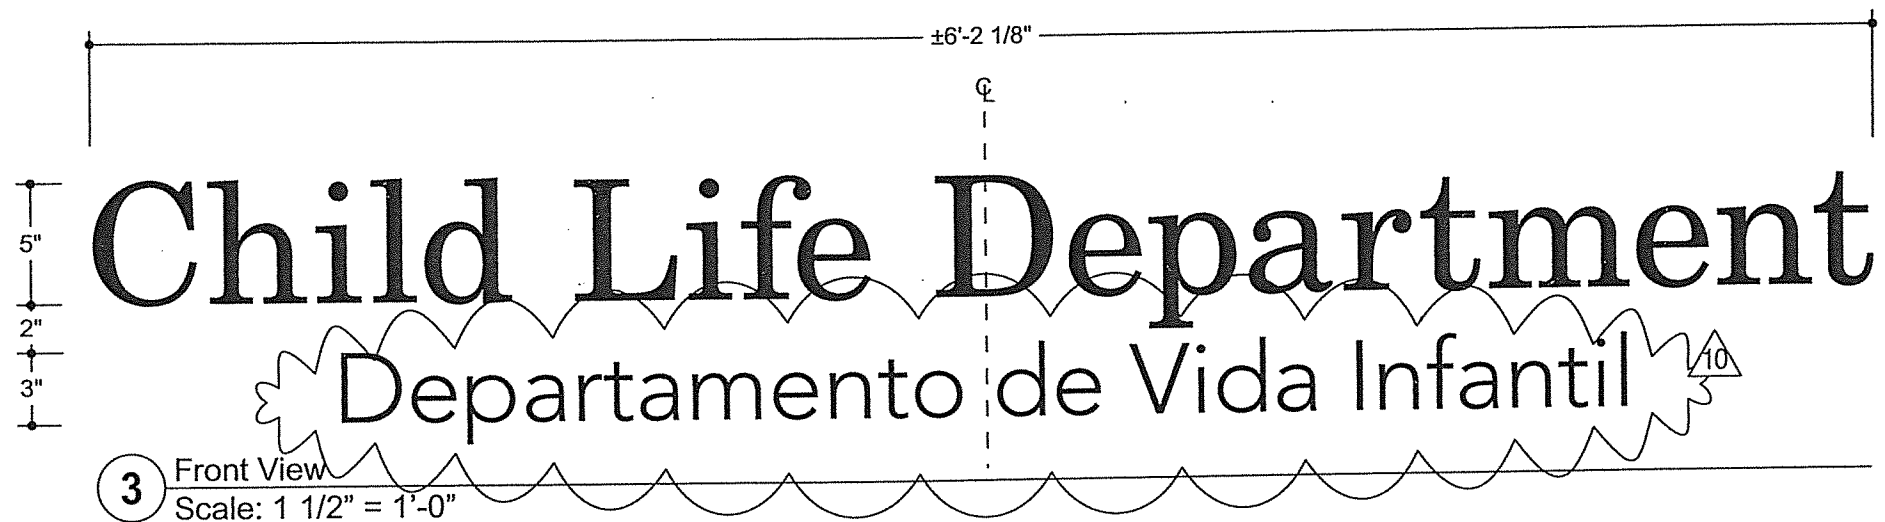

ITEM NO. 19
SIGN TYPE ILL

QTY: 13 LOCATIONS

SIGN MATERIALS:
EACH LOCATION CONSISTS OF 5" H X
1/4" THK. FLAT, CUT-OUT BRUSHED
STAINLESS STEEL LETTERS AND 3" H
VINYL SPANISH LETTERS.

MOUNTING:
WALL SURFACE MOUNTED

COLOR/FINISH:
REFER ELEVATIONS

FONT:
NEW CENTURY SCHOOLBOOK
ROMAN (ENGLISH)
AVENIR 35 LIGHT (SPANISH)

Invoice Number: 48765

Fabrication Drawing

Project
CHILDREN'S HOSPITAL OF
ORANGE COUNTY

Customer
McCARTHY BUILDING CO.
ATT: JAMES BURGGRAF
20401 S.W. BIRCH ST.
NEWPORT BEACH, CA 92660

Designers
FORMATION


Order Item: 19

Sign Type: ILL

Revision No.:

10 Per ASI 183
March 16, 2012

Drawn By: MWilliams

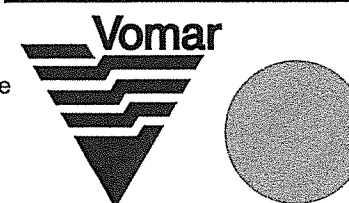

Vomar Products, Inc.
7800 Deering Avenue
Canoga Park, CA 91304-5005
Tel: 818-610-5115
Fax: 818-610-5123
E-Mail: info@vomarproducts.com

Sheet Date: 05/20/10

Sheet Number 19.0

Fabrication Drawing

Project
CHILDREN'S HOSPITAL OF
ORANGE COUNTY

Customer
McCARTHY BUILDING CO.
ATT: JAMES BURGGRAF
20401 S.W. BIRCH ST.
NEWPORT BEACH, CA 92660

Designers
FORMATION


Order Item: 19

Sign Type: ILL

Revision No.:

10 Per ASI 183
March 16, 2012

Drawn By: MWilliams

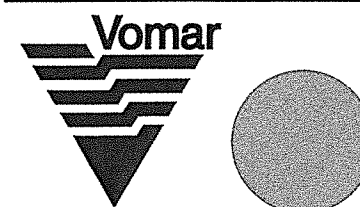

Vomar Products, Inc.
7800 Deering Avenue
Canoga Park, CA 91304-5005
Tel: 818-610-5115
Fax: 818-610-5123
E-Mail: info@vomarproducts.com

Sheet Date: 05/20/10

Sheet Number 19.1

5" 2" 3" 5
Outpatient Laboratory
Laboratorio para pacientes externos 10
5 Front View
Scale: 1 1/2" = 1'-0"

Applied vinyl Spanish copy
Gerber Matte White on colored walls,
Gerber Medium Gray on white walls
Typical for all Spanish copy 10

5" 6 3/4" 2" 3" 4
Central
Sterile Processing
Central de procesos de esterilización 10
4 Front View
Scale: 1 1/2" = 1'-0"

3"
1 1/4"
1 3/4"

Welcome to The South Tower

Bienvenidos a la Torre Sur

3"
1 1/4"
1 3/4"

Access to The North Tower

Acceso a la Torre Norte

3 Front View
Scale: 1 1/2" = 1'-0"

±1'-7 5/8"

3"

Emergency

Painted to match
PMS 186 Red

2 Front View
Scale: 3" = 1'-0"

1/4" thk. flat, cut-out #4 brushed
stainless steel circle w/ satin
clear coat and arrow cut out of
disk.

±1'-8 1/4"

3"


Admissions

1 1/2"

1/4" thk. flat, cut-out #4 brushed
stainless steel letters w/ satin
clear coat. Returns to match
face.

Vertical grain finish

1 Front View
Scale: 3" = 1'-0"

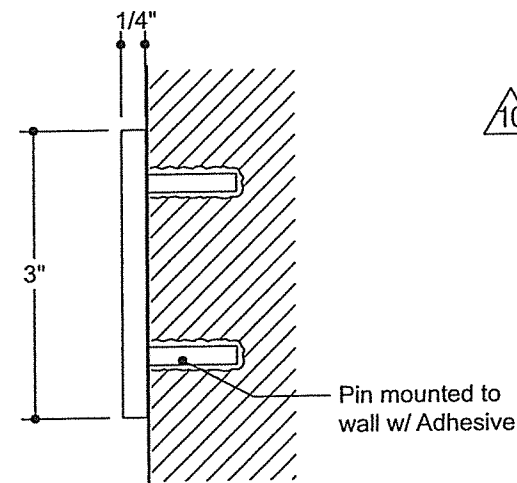

4 Side View
Scale: Half Size

ITEM NO. 20
SIGN TYPE ILS

QTY: 16

SIGN MATERIALS:
EACH LOCATION CONSISTS OF 3" H
AND 1 3/4" X 1/4" THK. BRUSHED #4
FINISHED FLAT CUT-OUT STAINLESS
STEEL LETTERFORMS AND DISKS

MOUNTING:
WALL SURFACE MOUNTED

COLOR/FINISH:
REFER ELEVATIONS

FONT:
NEW CENTURY SCHOOLBOOK
ROMAN (ENGLISH)
AVENIR 35 LIGHT (SPANISH)

Invoice Number: 48765

Fabrication Drawing

Project
CHILDREN'S HOSPITAL OF
ORANGE COUNTY

Customer
McCARTHY BUILDING CO.
ATT: JAMES BURGGRAB
20401 S.W. BIRCH ST.
NEWPORT BEACH, CA 92660

Designers
FORMATION


Order Item: 20

Sign Type: ILS

Revision No.:

10 Per ASI 183
March 16, 2012


Drawn By: MWilliams

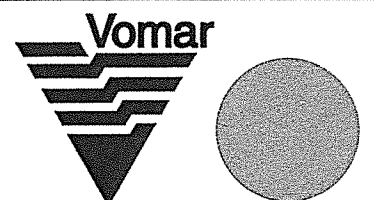


Vomar Products, Inc.
7800 Deering Avenue
Canoga Park, CA 91304-5005
Tel: 818-610-5115
Fax: 818-610-5123
E-Mail: info@vomarproducts.com

Sheet Date: 05/20/10


Sheet Number 20.0

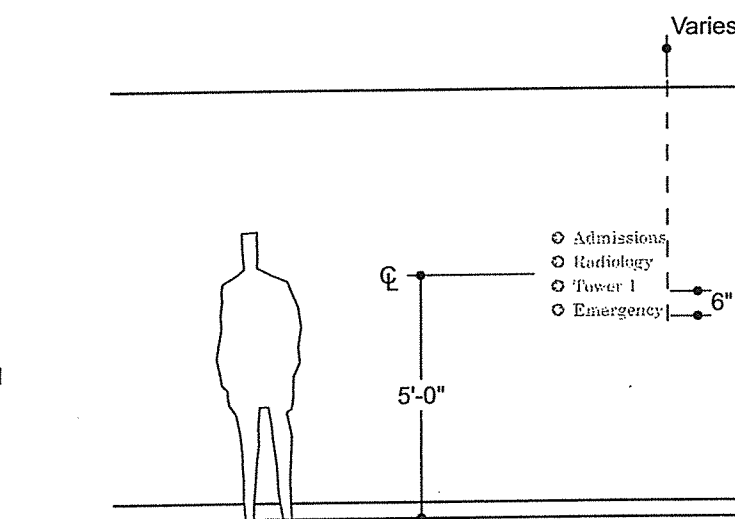

5 Front Elevation
Scale: 1/4" = 1'-0"

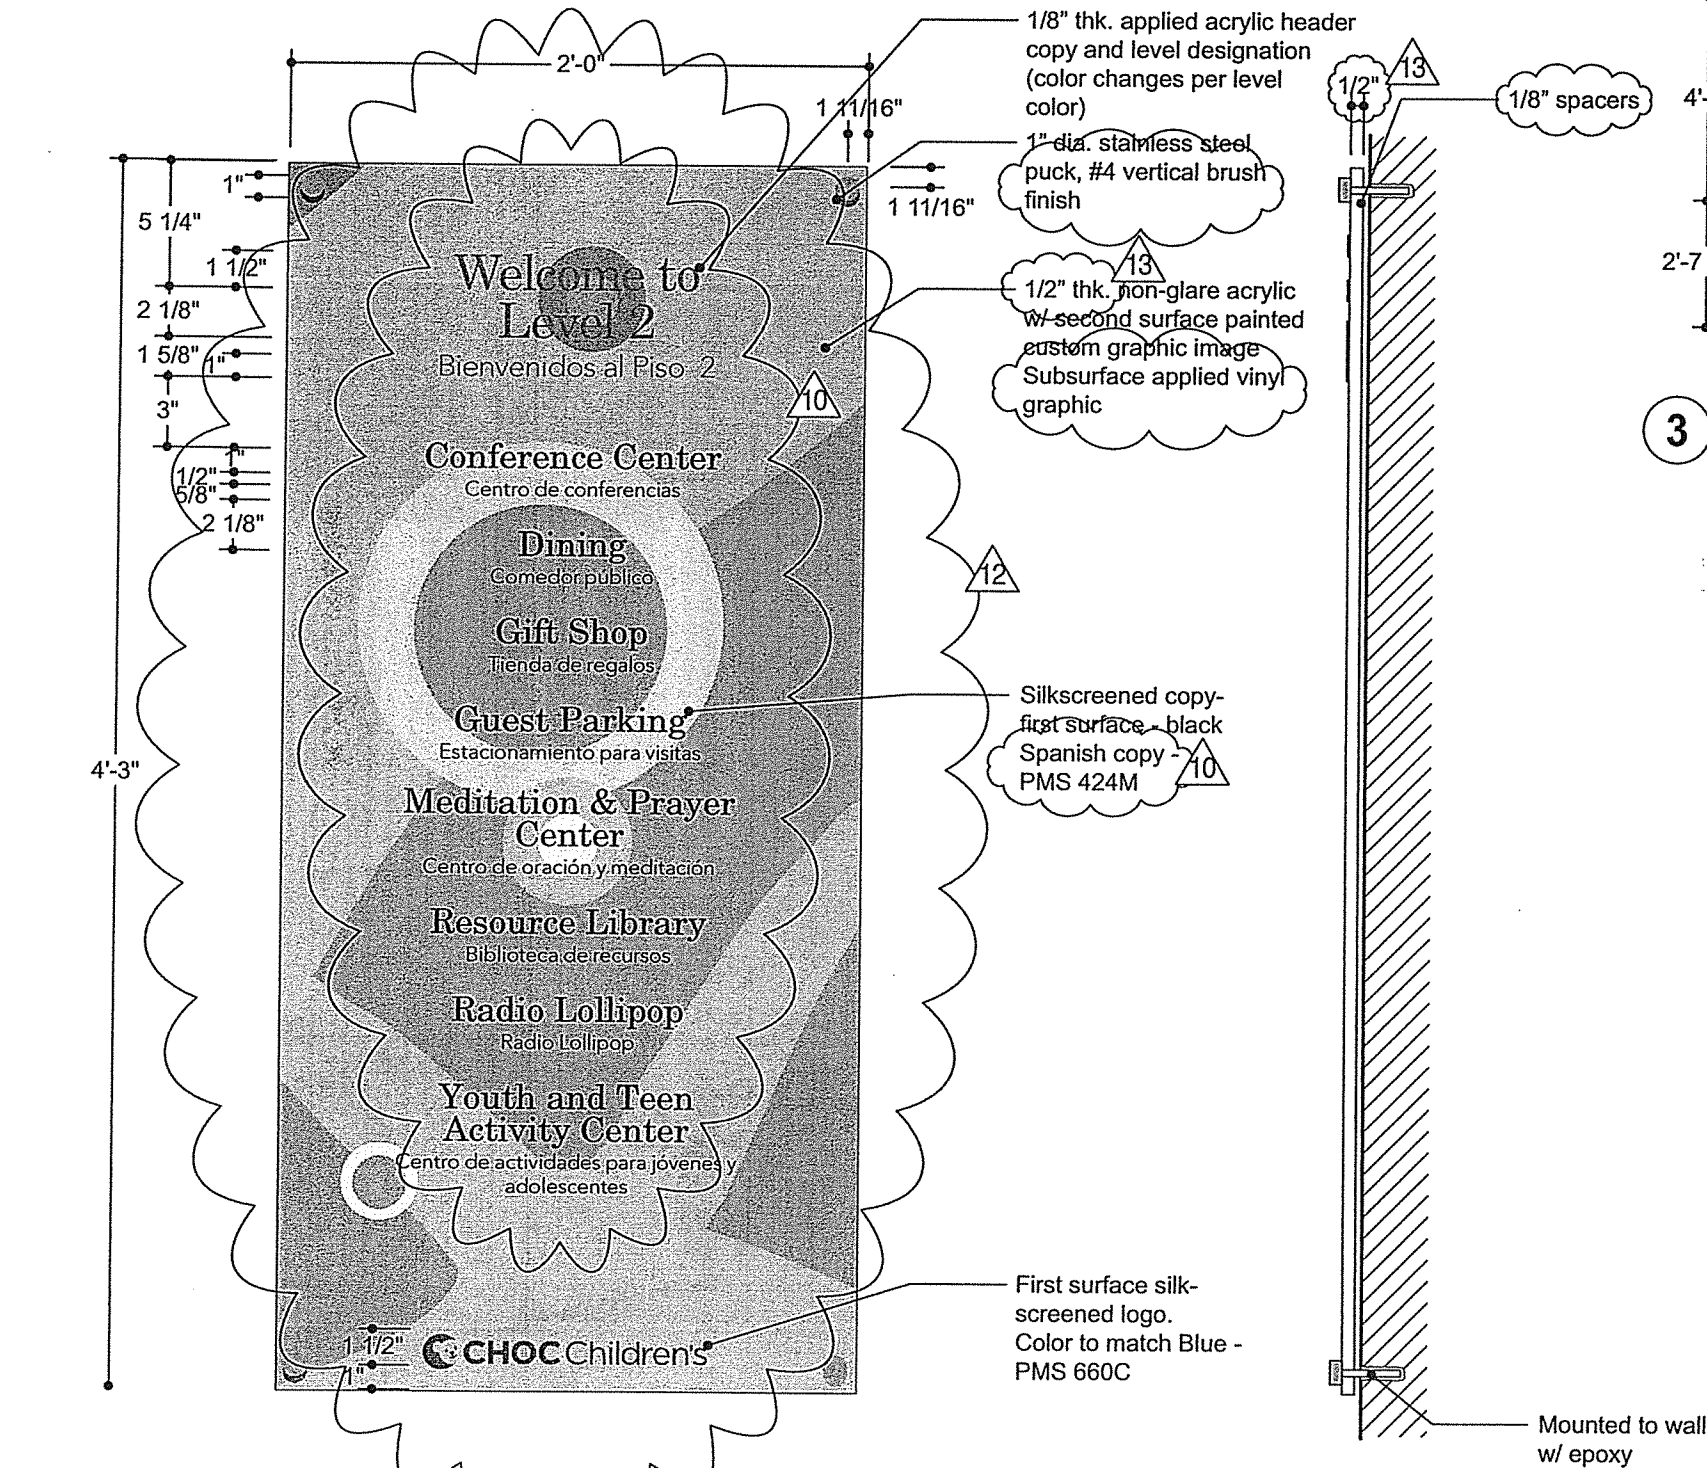

2 Side View
Scale: 1 1/2" = 1'-0"

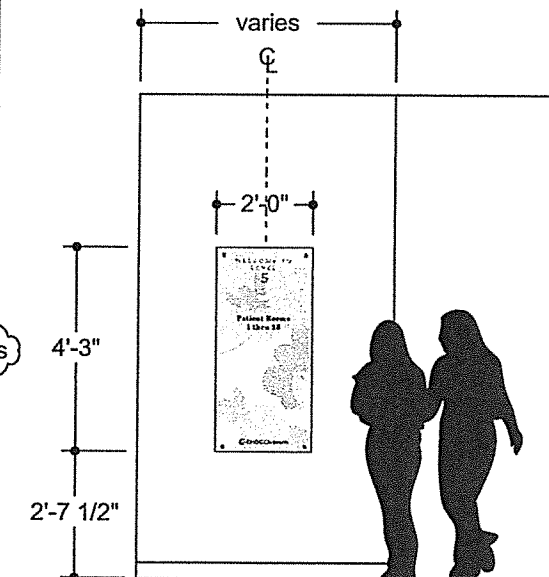







3 Front Elevation
Scale: 1/4" = 1'-0"

FONT:
AVENIR 85 HEAVY
NEW CENTURY SCHOOLBOOK
ROMAN



Vomar

Sheet Number 21.0

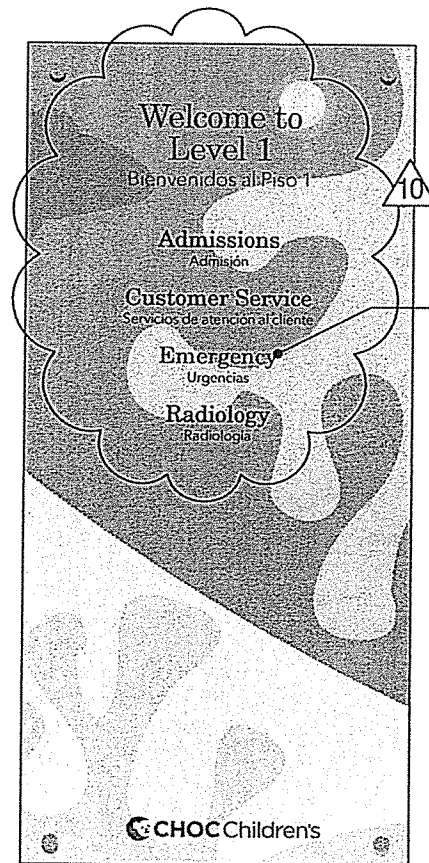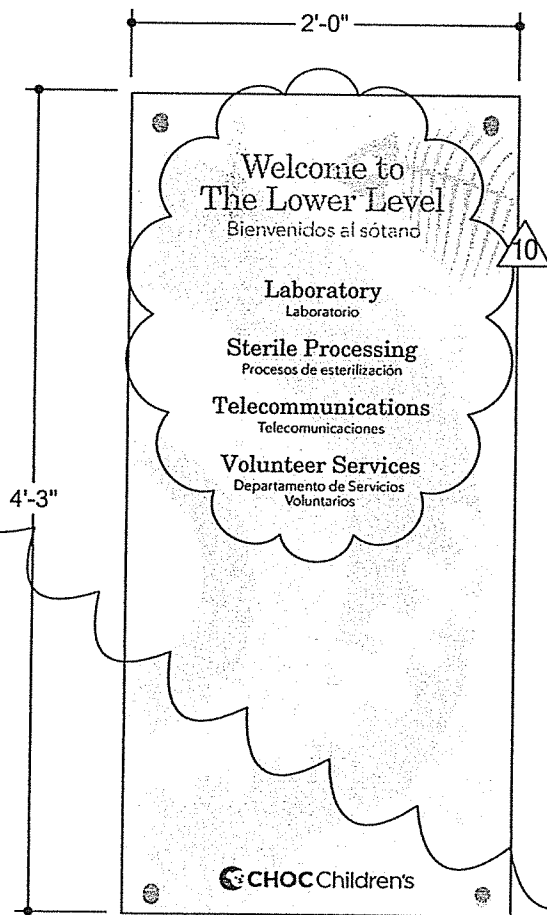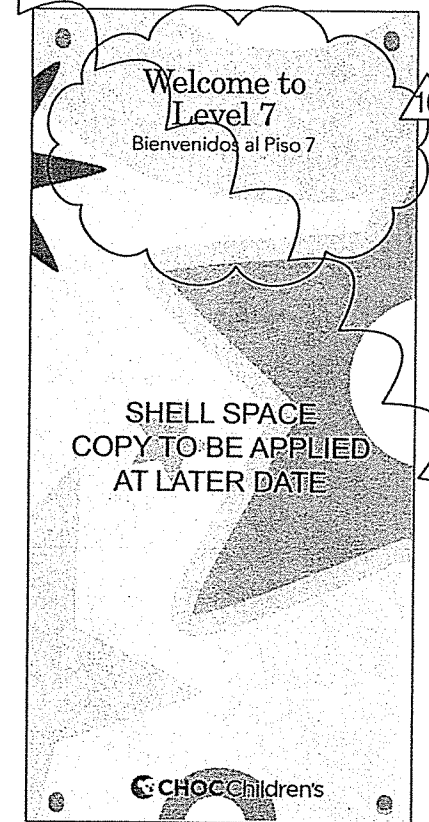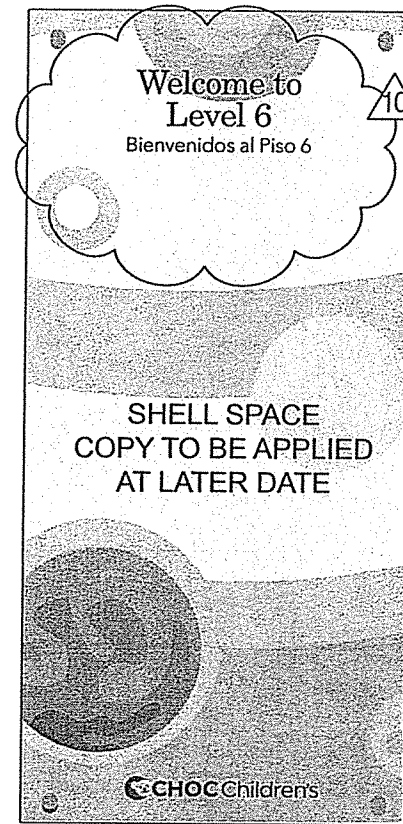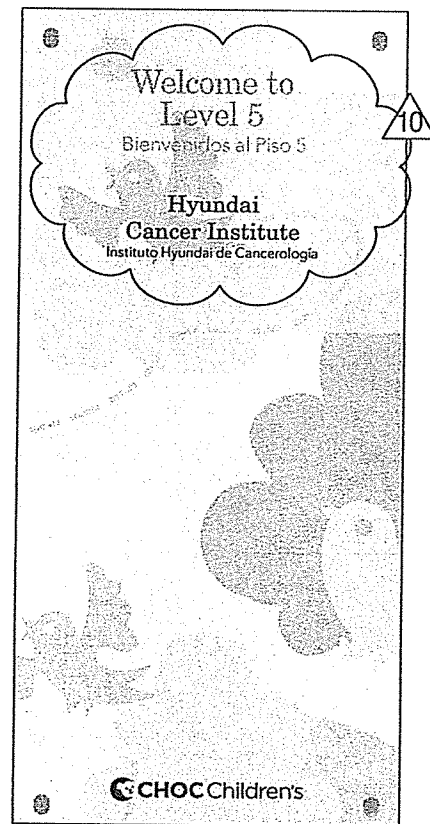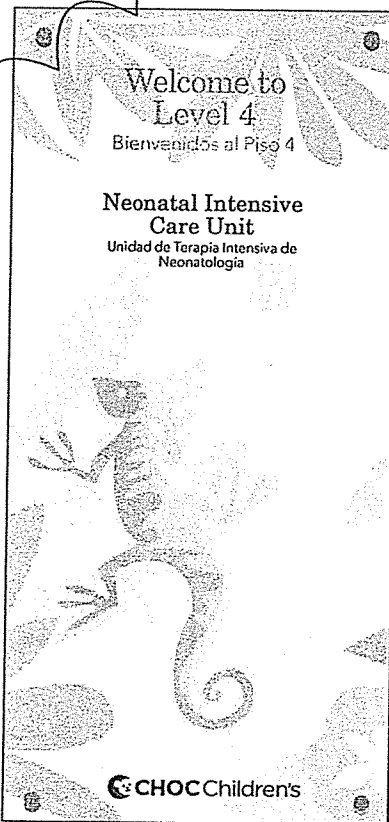

Emergency
Red copy to
match PMS 186



Invoice Number: 48765

Fabrication Drawing

Project
CHILDREN'S HOSPITAL OF
ORANGE COUNTY

Customer
McCARTHY BUILDING CO.
ATT: JAMES BURGGRAF
20401 S.W. BIRCH ST.
NEWPORT BEACH, CA 92660

Designers
FORMATION

Order Item: 21


Sign Type: LD

Revision No.:

10 Per ASI 183
March 16, 2012

12 Per RFI #5698
April 30, 2012

Drawn By: MWilliams

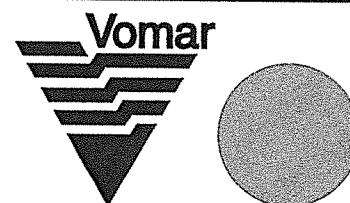

Vomar Products, Inc.
7800 Deering Avenue
Canoga Park, CA 91304-5005
Tel: 818-610-5115
Fax: 818-610-5123
E-Mail: info@vomarproducts.com

Sheet Date: 05/20/10

Sheet Number 21.1

Fabrication Drawing

Project
CHILDREN'S HOSPITAL OF
ORANGE COUNTY

Customer
McCARTHY BUILDING CO.
ATT: JAMES BURGGRAF
20401 S.W. BIRCH ST.
NEWPORT BEACH, CA 92660

Designers
FORMATION


Order Item: 22

Sign Type: WD

Revision No.:

10 Per ASI 183
March 16, 2012

Drawn By: MWilliams

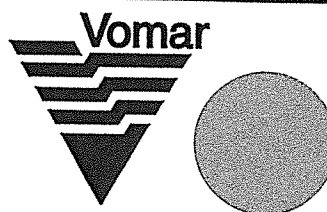

Vomar Products, Inc.
7800 Deering Avenue
Canoga Park, CA 91304-5005
Tel: 818-610-5115
Fax: 818-610-5123
E-Mail: info@vomarproducts.com

Sheet Date: 05/20/10

Sheet Number 22.0

ITEM NO. 22
SIGN TYPE WD


10 QTY: 16

SIGN MATERIALS:
3'-2" H X 1'-8" W UNFRAMED PLAQUE
CONSISTING OF 1/2" THK. ACRYLIC
FACE W/ FROSTED FACE,
SILKSCREENED COPY AND LOGO,
AND APPLIED 1/8" THK. ACRYLIC DISK
ON FACE. VINYL DIGITAL PRINT ON
2ND SURFACE. 3/4" THK. BACK
PLATE.


MOUNTING:
WALL SURFACE MOUNTED

COLOR/FINISH:
REFER ELEVATIONS

FONT:
AVENIR 85 HEAVY
NEW CENTURY SCHOOLBOOK
ROMAN

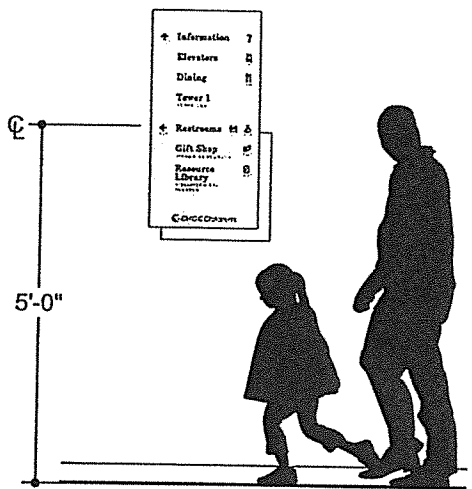


4 Front Elevation
Scale: 3/8" = 1'-0"

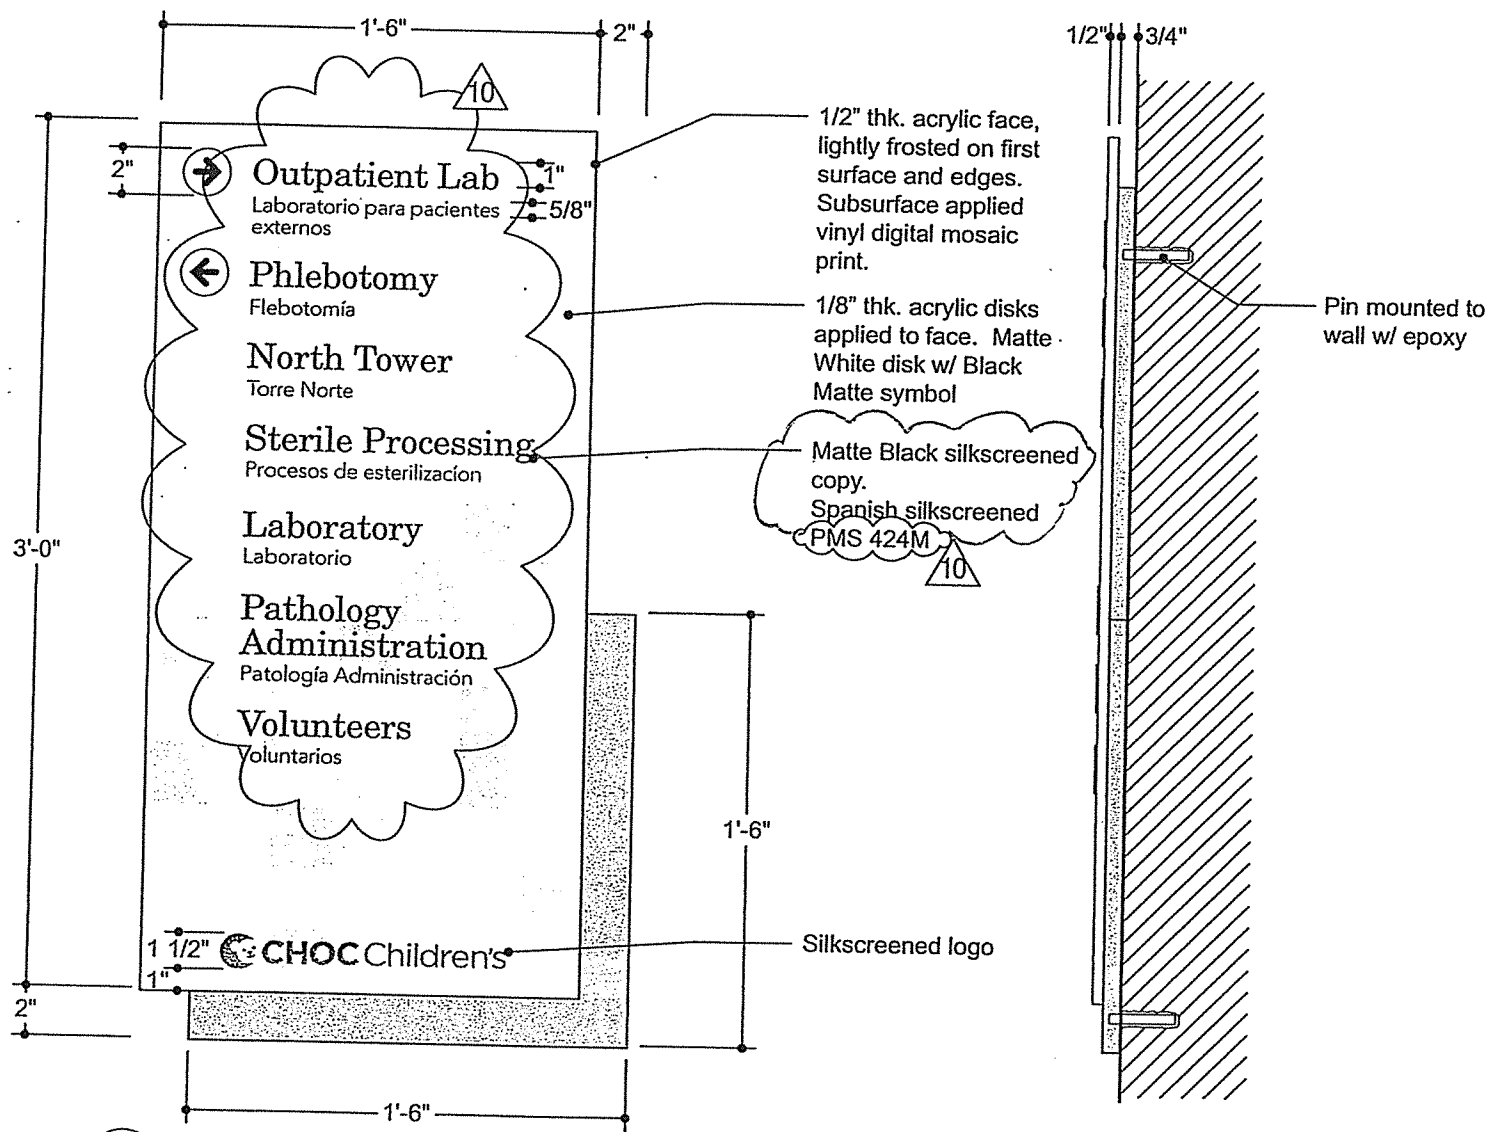

1 Front View
Scale: 1 1/2" = 1'-0"

2 Side View
Scale: 1 1/2" = 1'-0"

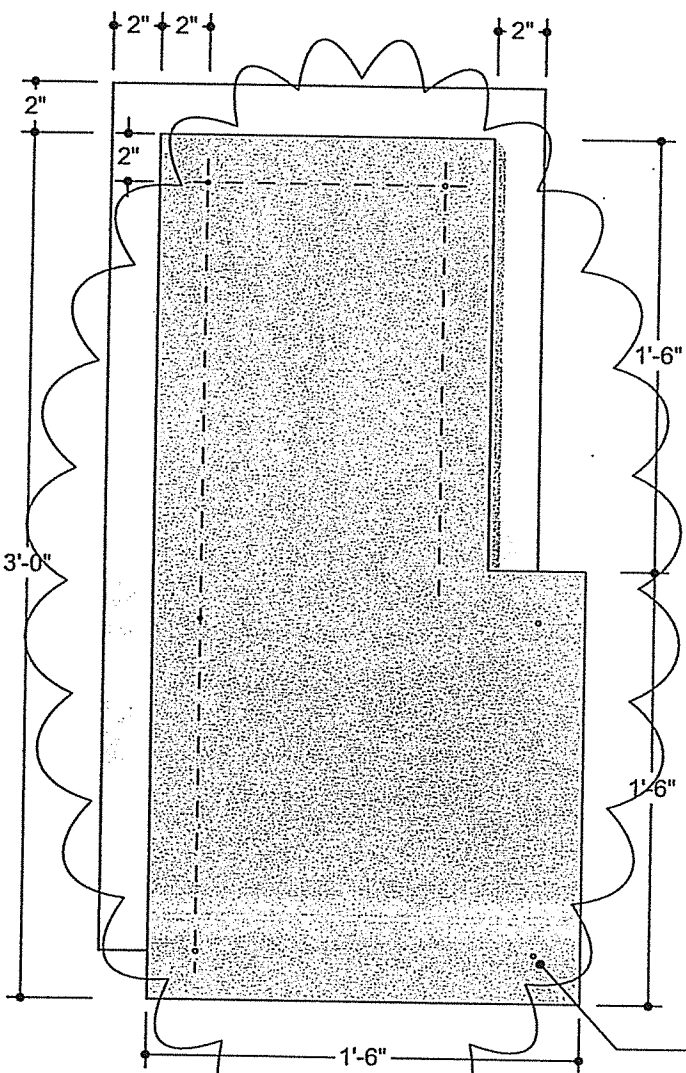

3 Back View
Scale: 3" = 1'-0"

3/16" holes, 1/4"
deep into 1/2" acrylic
threaded studs on back,
1 1/2" long.

Fabrication Drawing

Project
CHILDREN'S HOSPITAL OF
ORANGE COUNTY

Customer
McCARTHY BUILDING CO.
ATT: JAMES BURGGRAF
20401 S.W. BIRCH ST.
NEWPORT BEACH, CA 92660

Designers
FORMATION


Order Item: 22

Sign Type: WD

Revision No.:

10 Per ASI 183
March 16, 2012


Drawn By: MWilliams

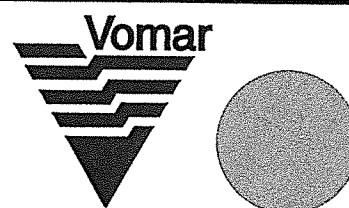


Vomar Products, Inc.
7800 Deering Avenue
Canoga Park, CA 91304-5005
Tel: 818-610-5115
Fax: 818-610-5123
E-Mail: info@vomarproducts.com

Sheet Date: 05/20/10


Sheet Number 22.1

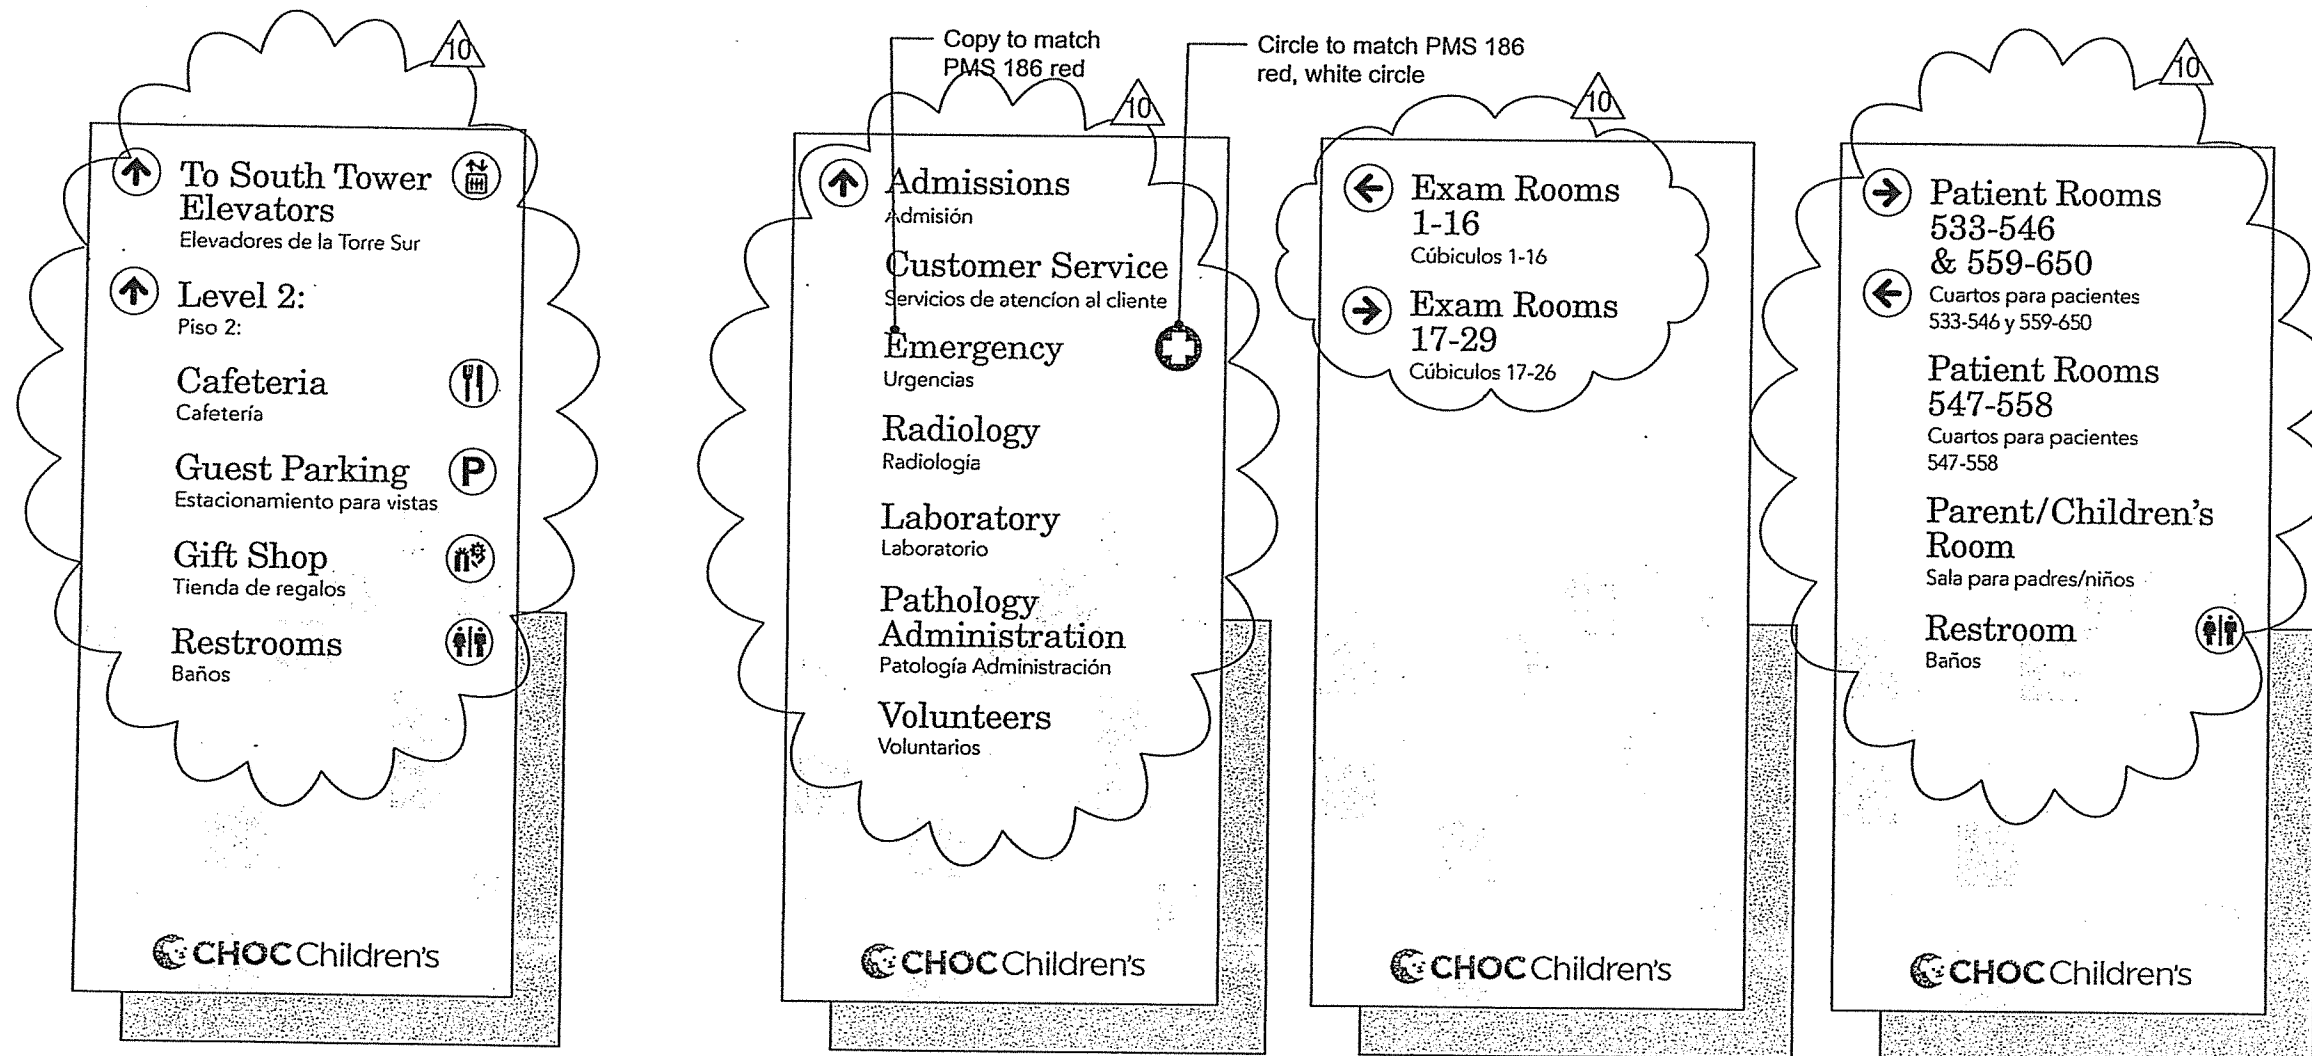


5 Copy Layout
Scale: 1 1/2" = 1'-0"

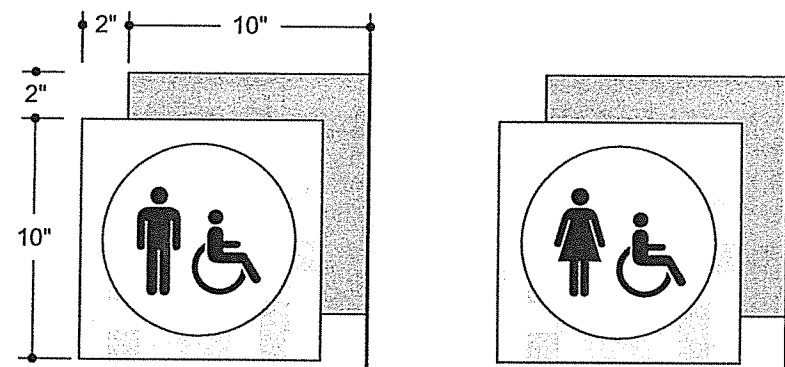


5 Additional Layouts
Scale: 1 1/2" = 1'-0"

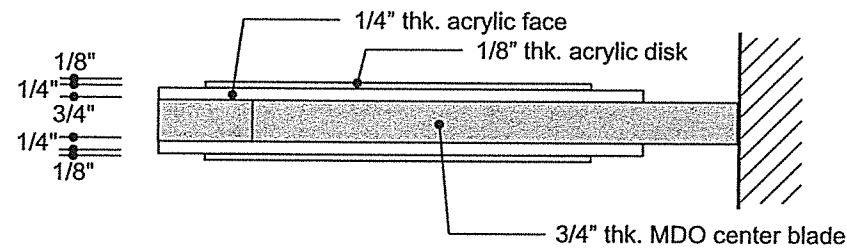


4 Plan View
Scale: 3" = 1'-0"

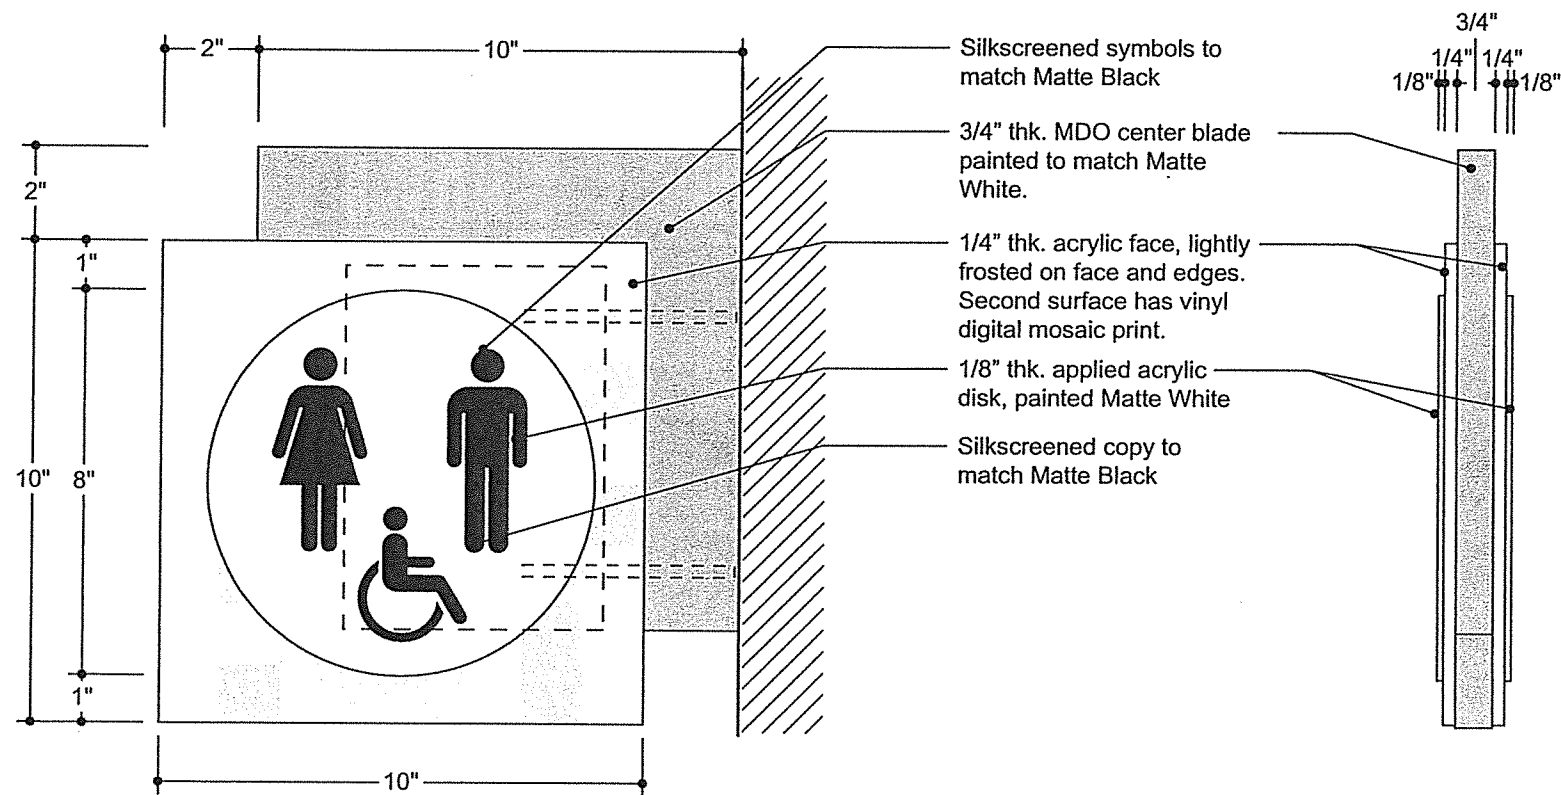

1 Front View
Scale: 3" = 1'-0"

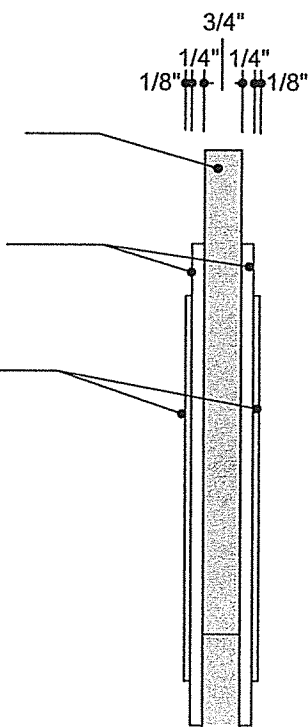

2 Side View
Scale: 3" = 1'-0"

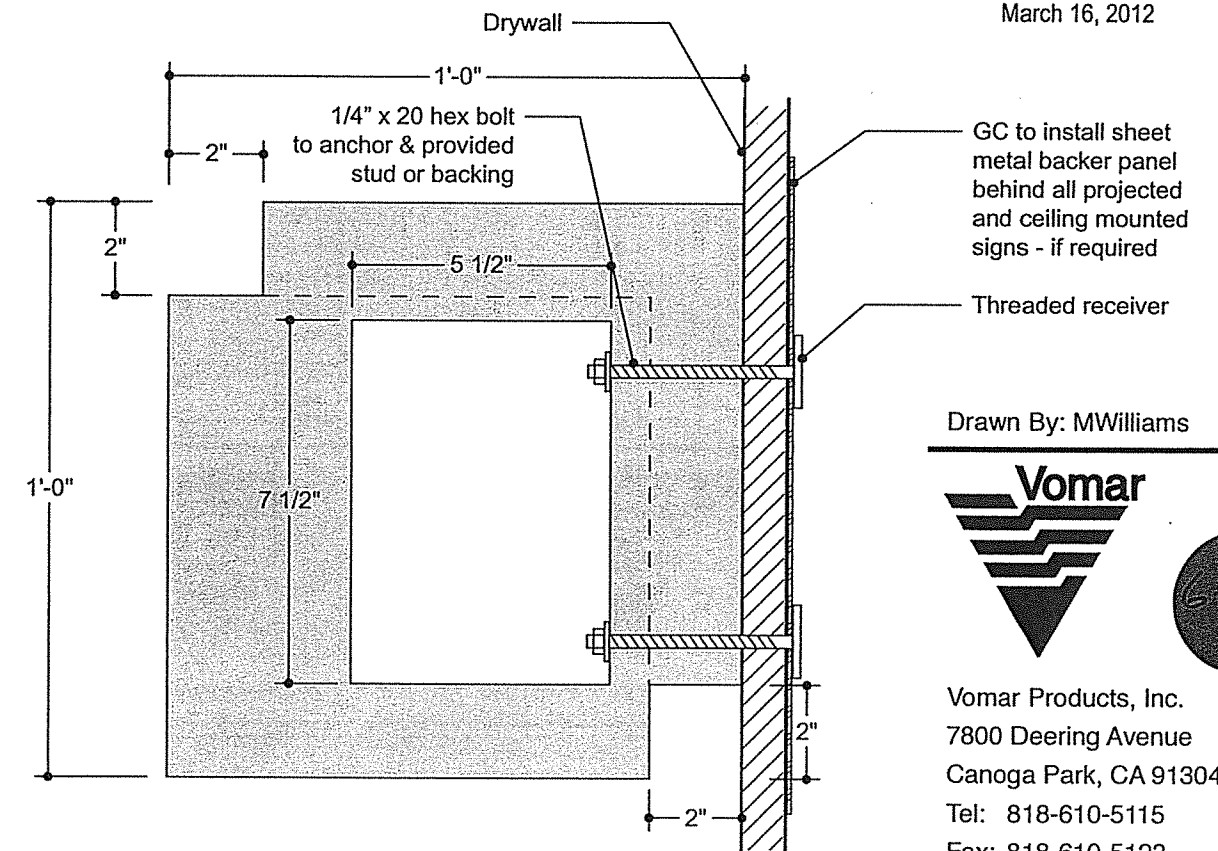

3 Center Blade
Scale: 3" = 1'-0"

ITEM NO. 23
SIGN TYPE RRBW

QTY: 27

SIGN MATERIALS:
12" X 12" ACRYLIC FABRICATED
BLADE SIGN W/ DOUBLE SIDED 1/4"
THK. ACRYLIC PANEL W/ 1/8" THK.
DISK W/ SILKSCREENED COPY
APPLIED TO BOTH SIDES OF PANELS.

MOUNTING:
WALL SURFACE MOUNTED

COLOR/FINISH:
REFER ELEVATIONS

FONT:
N/A

Invoice Number: 48765

Fabrication Drawing

Project
CHILDREN'S HOSPITAL OF
ORANGE COUNTY

Customer
McCARTHY BUILDING CO.
ATT: JAMES BURGGRAF
20401 S.W. BIRCH ST.
NEWPORT BEACH, CA 92660

Designers
FORMATION

Order Item: 23

Sign Type: RRBW

Revision No.:

Per ASI 183
March 16, 2012


Drawn By: MWilliams




Vomar Products, Inc.
7800 Deering Avenue
Canoga Park, CA 91304-5005
Tel: 818-610-5115
Fax: 818-610-5123
E-Mail: info@vomarproducts.com

Sheet Date: 05/20/10


Sheet Number 23.0

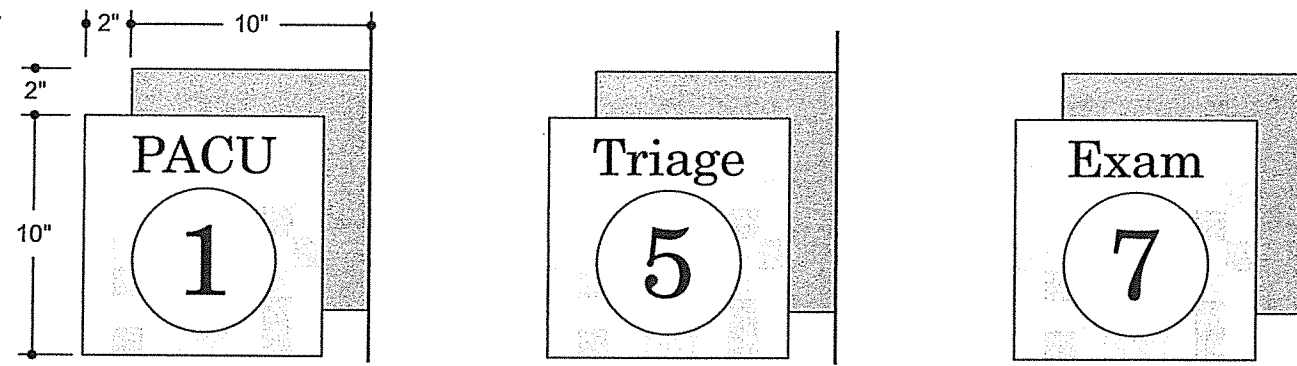

5 Copy Layout
Scale: 1 1/2" = 1'-0"

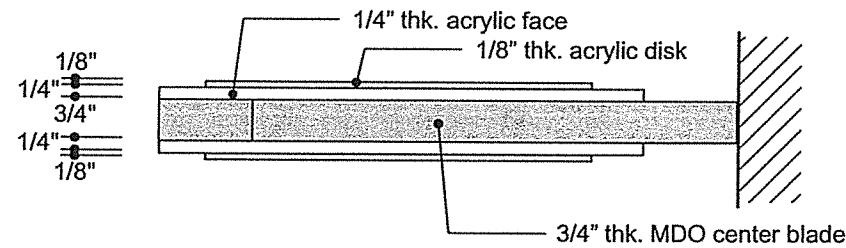


4 Plan View
Scale: 3" = 1'-0"

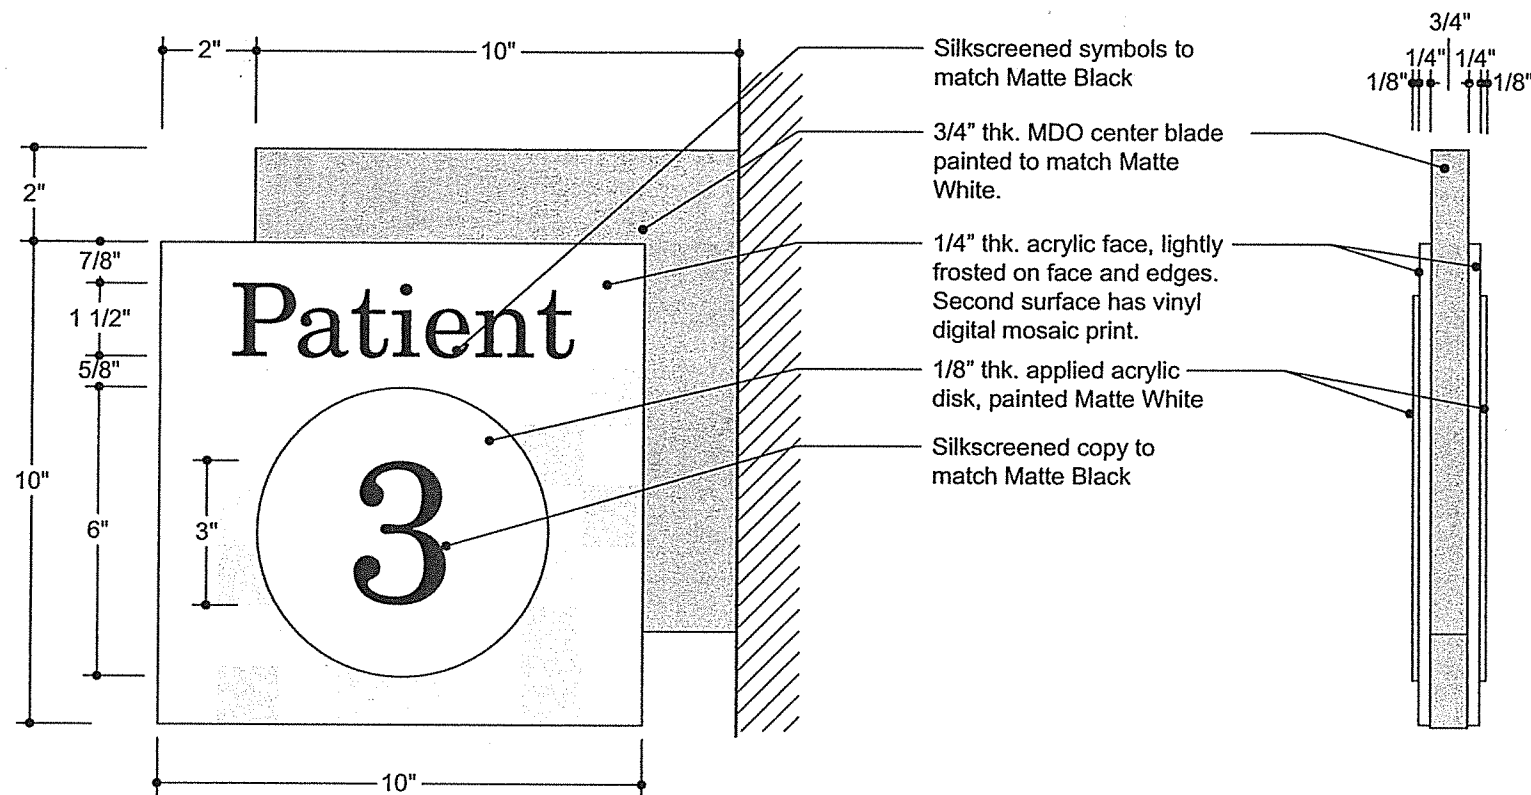

1 Front View
Scale: 3" = 1'-0"

2 Side View
Scale: 3" = 1'-0"

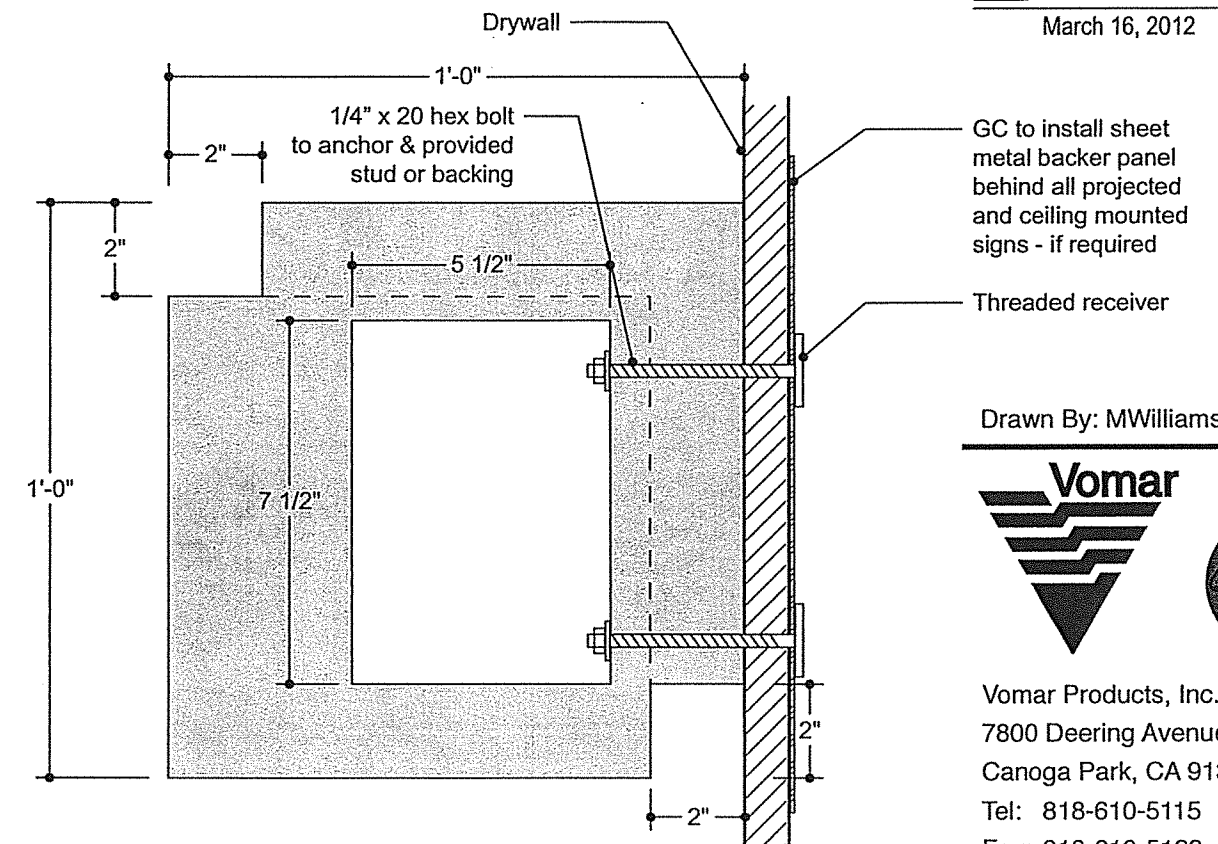

3 Center Blade
Scale: 3" = 1'-0"

ITEM NO. 24
SIGN TYPE PBW

QTY: 80

SIGN MATERIALS:
12" X 12" ACRYLIC FABRICATED
BLADE SIGN W/ DOUBLE SIDED 1/4"
THK. ACRYLIC PANEL W/ 1/8" THK.
DISK W/ SILKSCREENED COPY
APPLIED TO BOTH SIDES OF PANELS.

MOUNTING:
FLAG MOUNTED

COLOR/FINISH:
REFER ELEVATIONS

FONT:
NEW CENTURY SCHOOLBOOK
ROMAN

Invoice Number: 48765

Fabrication Drawing

Project
CHILDREN'S HOSPITAL OF
ORANGE COUNTY

Customer
McCARTHY BUILDING CO.
ATT: JAMES BURGGRAF
20401 S.W. BIRCH ST.
NEWPORT BEACH, CA 92660

Designers
FORMATION

Order Item: 24

Sign Type: PBW

Revision No.:

Per ASI 183
March 16, 2012


Drawn By: MWilliams




Vomar Products, Inc.
7800 Deering Avenue
Canoga Park, CA 91304-5005
Tel: 818-610-5115
Fax: 818-610-5123
E-Mail: info@vomarproducts.com

Sheet Date: 05/20/10


Sheet Number 24.0

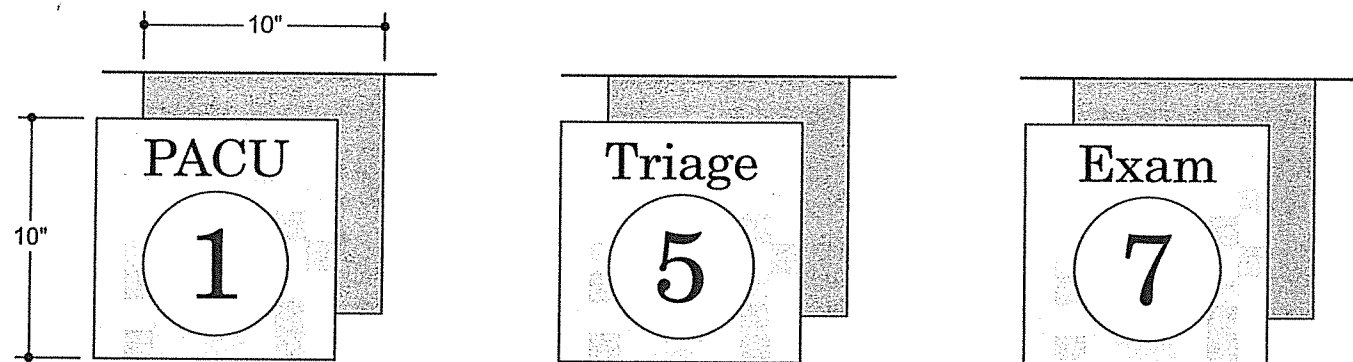

5 Copy Layout
Scale: 1 1/2" = 1'-0"

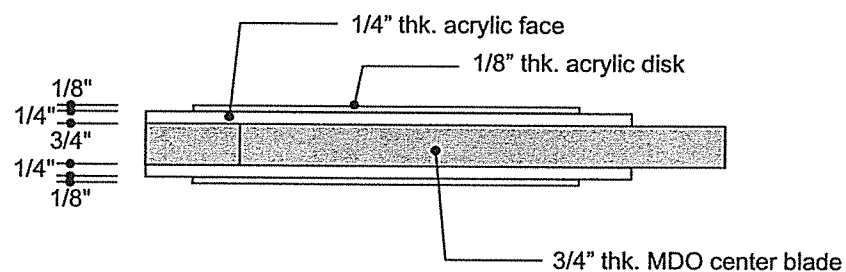


4 Plan View
Scale: 3" = 1'-0"

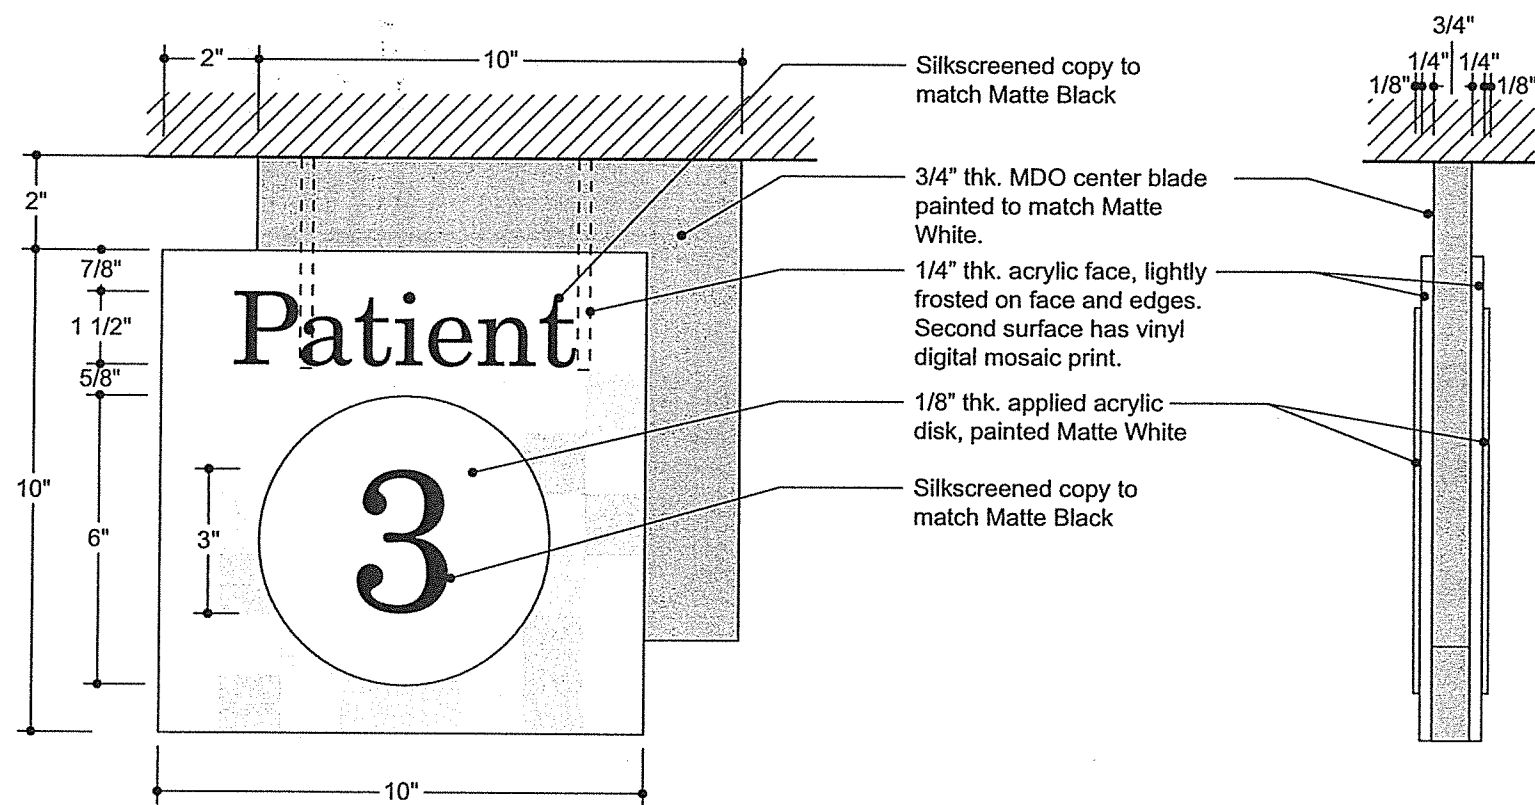

1 Front View
Scale: 3" = 1'-0"

2 Side View
Scale: 3" = 1'-0"

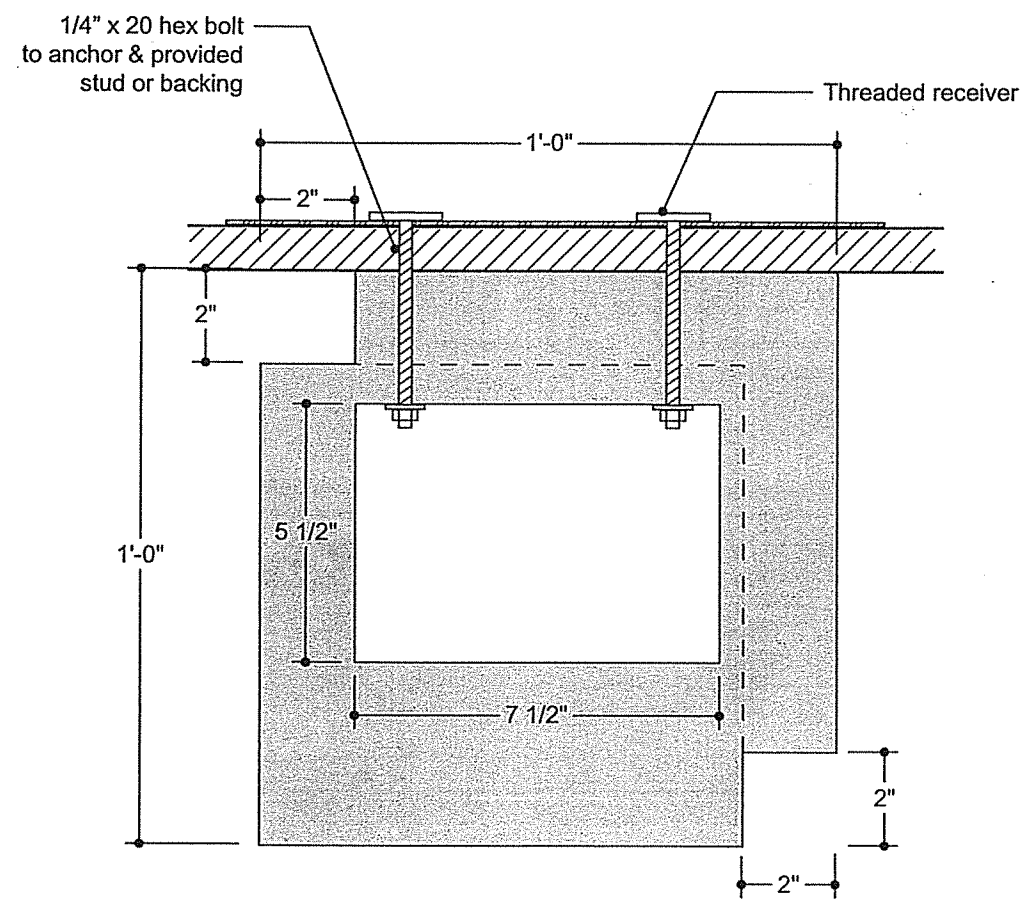

3 Center Blade
Scale: 3" = 1'-0"

ITEM NO. 25
SIGN TYPE PBC

QTY: 26

SIGN MATERIALS:
12" X 12" ACRYLIC FABRICATED
BLADE SIGN W/ DOUBLE SIDED 1/4"
THK. ACRYLIC PANEL W/ 1/8" THK.
DISK W/ SILKSCREENED COPY
APPLIED TO BOTH SIDES OF PANELS.

MOUNTING:
CEILING MOUNTED

COLOR/FINISH:
REFER ELEVATIONS

FONT:
NEW CENTURY SCHOOLBOOK
ROMAN

Invoice Number: 48765

Fabrication Drawing

Project
CHILDREN'S HOSPITAL OF
ORANGE COUNTY

Customer
McCARTHY BUILDING CO.
ATT: JAMES BURGGRAF
20401 S.W. BIRCH ST.
NEWPORT BEACH, CA 92660

Designers
FORMATION

Order Item: 25

Sign Type: PBC

Revision No.:

Per ASI 183
March 16, 2012

Drawn By: MWilliams



Vomar Products, Inc.
7800 Deering Avenue
Canoga Park, CA 91304-5005
Tel: 818-610-5115
Fax: 818-610-5123
E-Mail: info@vomarproducts.com

Sheet Date: 05/20/10

Sheet Number 25.0

Fabrication
Drawing

Project
CHILDREN'S HOSPITAL OF
ORANGE COUNTY

Customer
McCARTHY BUILDING CO.
ATT: JAMES BURGGRAF
20401 S.W. BIRCH ST.
NEWPORT BEACH, CA 92660


Designers
FORMATION

Order Item: 36

Sign Type: RVG

Revision No.:

Drawn By: MWilliams

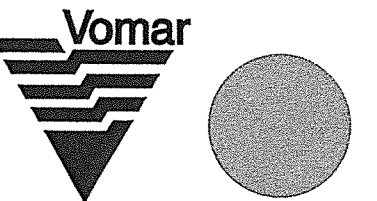

Vomar Products, Inc.
7800 Deering Avenue
Canoga Park, CA 91304-5005
Tel: 818-610-5115
Fax: 818-610-5123
E-Mail: info@vomarproducts.com

Sheet Date: 05/20/10

Sheet Number 36.0

ITEM NO. 36
SIGN TYPE RVG

QTY: 2

SIGN MATERIALS:
SIGN CONSISTS OF 3M WHITE VINYL
APPLIED TO GLASS SIDE OF
EXTERIOR HOSPITAL ENTRANCE

MOUNTING:
APPLIED TO SECOND SURFACE OF
GLASS

COLOR/FINISH:
REFER ELEVATIONS

FONT:
AVENIR 65 MEDIUM

1'-10 3/8"

NO SMOKING:
SMOKING IS PROHIBITED EXCEPT IN
DESIGNATED SMOKING AREAS.
PROHIBIDO FUMAR, EXCEPTO EN AREAS
DESIGNADAS PARA ESTE USO.


NO CELLULAR PHONES:
THE USE OF CELLULAR PHONES IS PROHIBITED
INSIDE THE HOSPITAL. PLEASE TURN OFF YOUR
PHONES.
SE PROHIBE EL USO DE TELEFONOS CELULARES
DENTRO DEL HOSPITAL. POR FAVOR APAGUE SU
TELEFONO.

White vinyl copy and symbols
applied to second surface of
glass.
Copy may be divided per
section to allow space per
condition.
Final layout TBD.

NO FIRE ARMS:
NOTICE: PURSUANT TO SECTION 30.06, PENAL
CODE (TRESPASS BY HOLDER OF LICENSE TO
CARRY A CONCEALED HANDGUN), A PERSON
LICENSED UNDER SUBCHAPTER H, CHAPTER 411,
GOVERNMENT CODE (CONCEALED HANDGUN
LAW), MAY NOT ENTER THIS PROPERTY WITH A
CONCEALED HANDGUN.

Aviso: CONFORME A LA SECCIÓN 30.06, DEL
CÓDIGO PENAL (TRASPASE POR PORTADOR DE
LICENCIA PARA CARGAR ARMAS DE FUEGO),
PERSONAS CON LICENCIA BAJO AUTORIDAD DEL
SUBCAPÍTULO H, CAPÍTULO 411, DEL CÓDIGO
GUBERNAMENTAL (LEY DE ARMAS DE FUEGO),
NO DEBERÁ ENTRAR A ÉSTA PROPIEDAD
PORTANDO UN ARMA DE FUEGO.

3'-6 3/8"

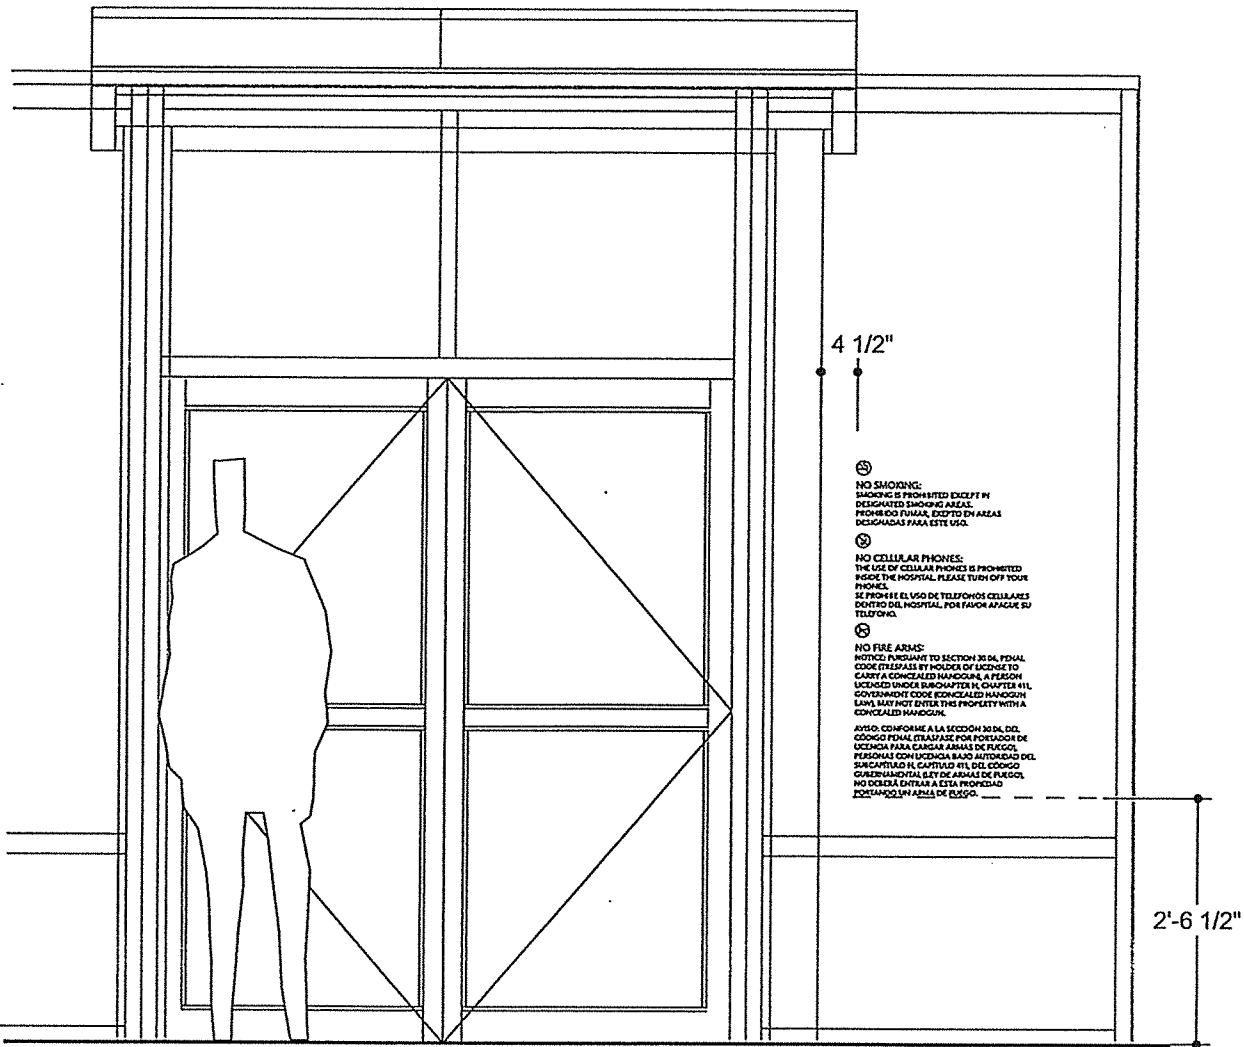

1 Front View
Scale: 1 1/2" = 1'-0"

2 Front Elevation
Scale: 1/2" = 1'-0"

Fabrication Drawing

Project
CHILDREN'S HOSPITAL OF
ORANGE COUNTY

Customer
McCARTHY BUILDING CO.
ATT: JAMES BURGGRAF
20401 S.W. BIRCH ST.
NEWPORT BEACH, CA 92660

Designers
FORMATION

Order Item: 37

Sign Type: DIGE

Revision No.:

5 Per Submittal 010400-0001-1
Dec. 21, 2010

14 Per Returned Submittal
May 18, 2012



Drawn By: MWilliams / Cameron



Vomar Products, Inc. 6-8-12
7800 Deering Avenue
Canoga Park, CA 91304-5005
Tel: 818-610-5115
Fax: 818-610-5123
E-Mail: info@vomarproducts.com

Sheet Date: 01/26/2011

Sheet Number 37.1

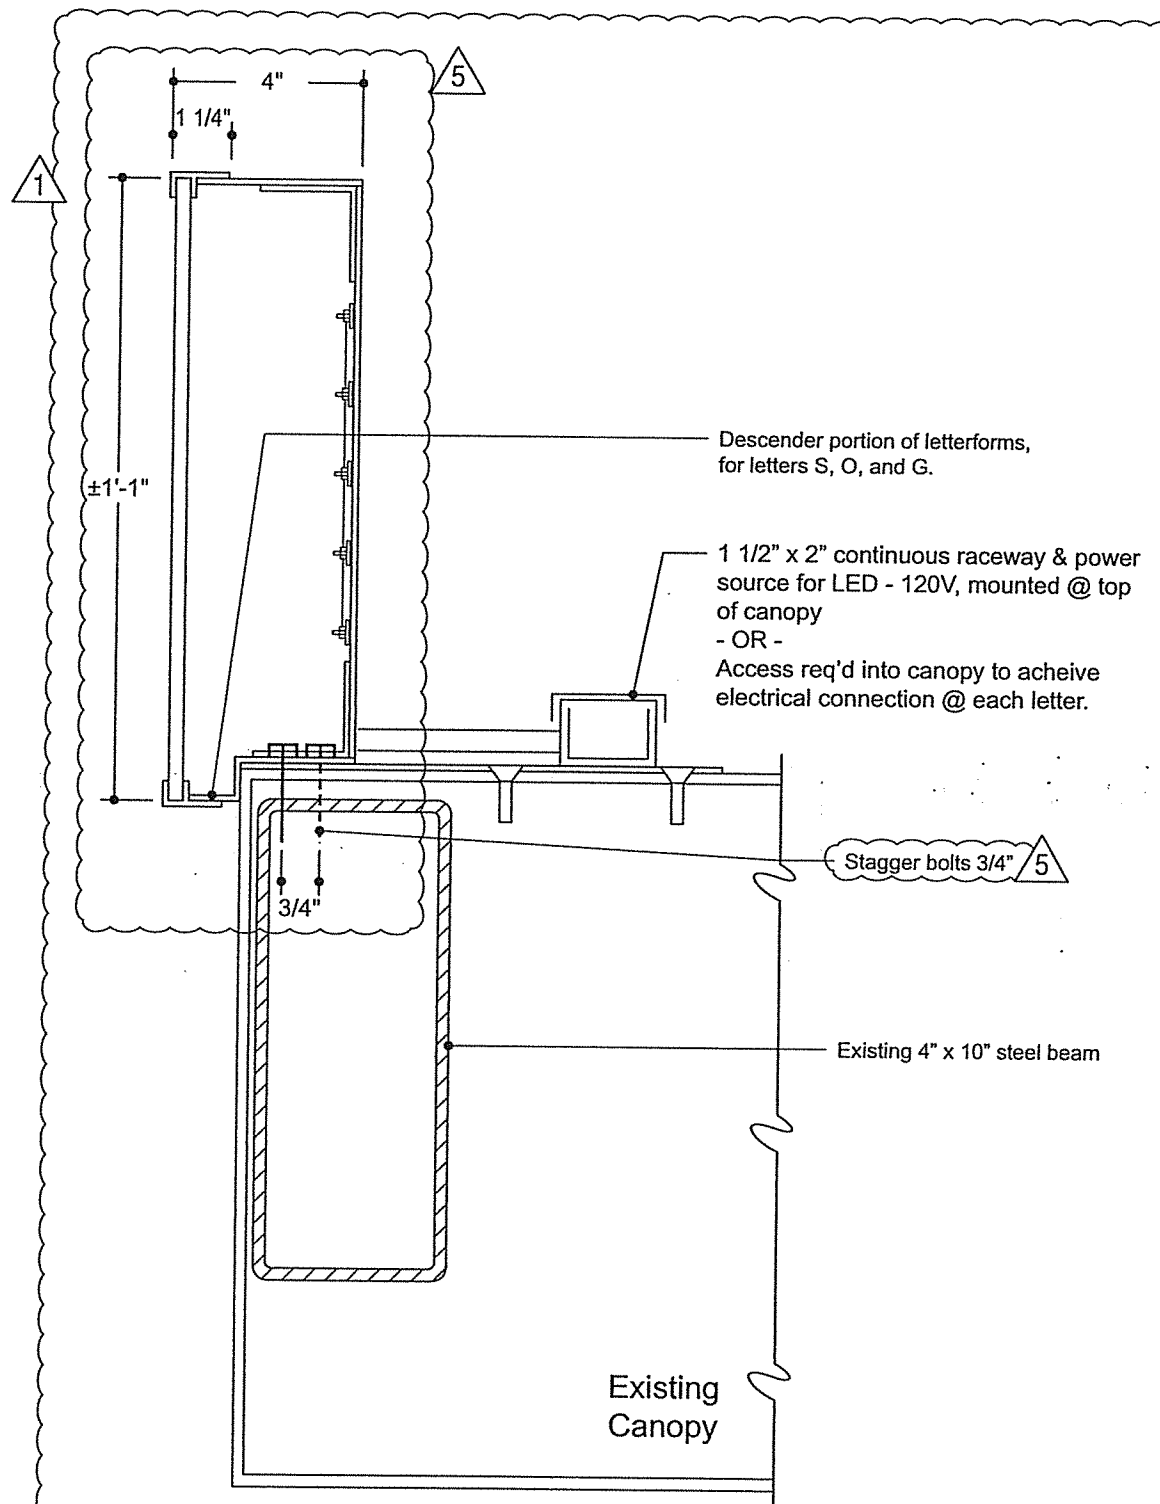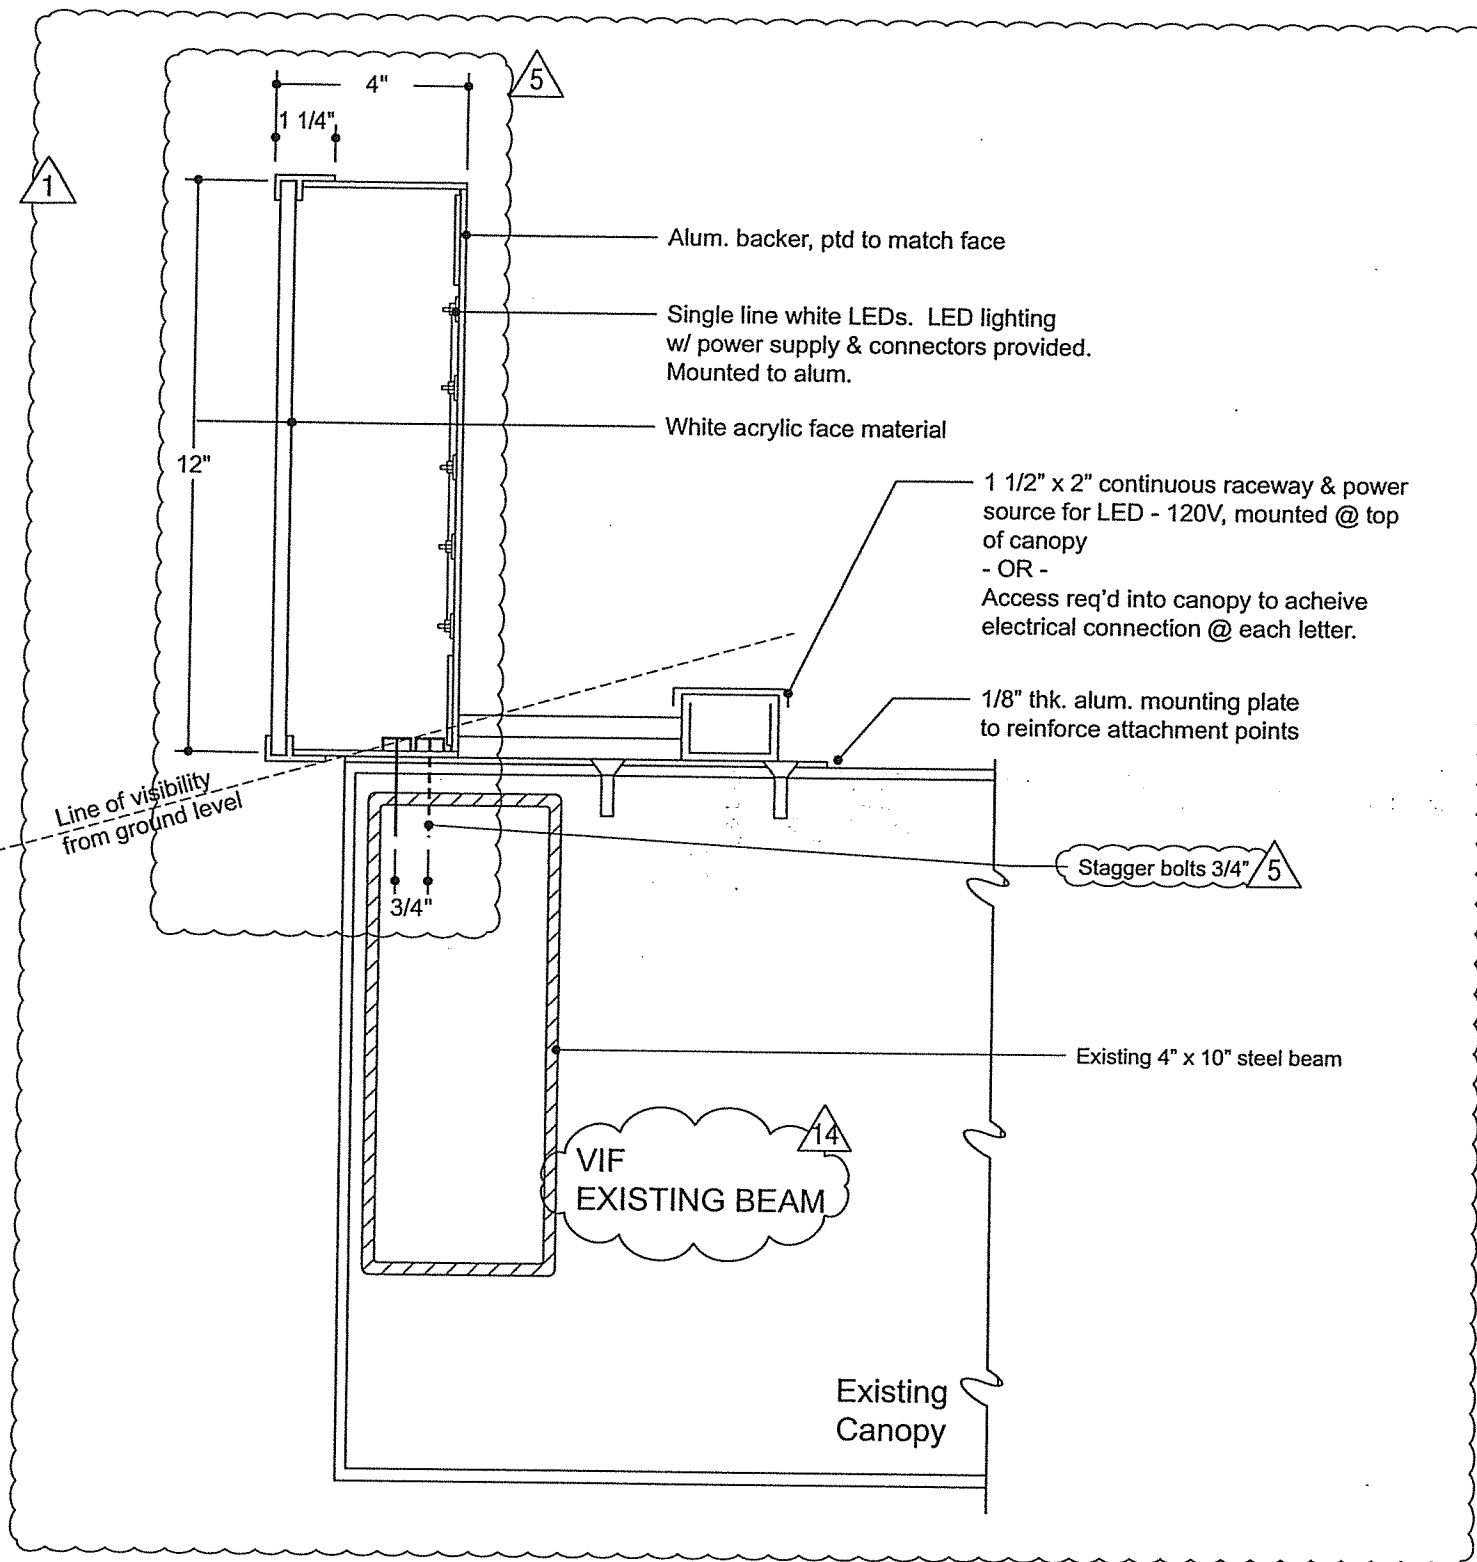

5 Section
Scale: 3" = 1'-0"

6 Section - Descenders Only ("S", "O", "G")
Scale: 3" = 1'-0"
(Similar/based on 5/37.1)

Fabrication Drawing

Project
CHILDREN'S HOSPITAL OF
ORANGE COUNTY

Customer
McCARTHY BUILDING CO.
ATT: JAMES BURGGRAF
20401 S.W. BIRCH ST.
NEWPORT BEACH, CA 92660

Designers
FORMATION

Order Item: 42

Sign Type: WG

Revision No.:

14 Per Returned Submittal
May 18, 2012


Drawn By: MWilliams




Vomar Products, Inc.
7800 Deering Avenue
Canoga Park, CA 91304-5005
Tel: 818-610-5115
Fax: 818-610-5123
E-Mail: info@vomarproducts.com

Sheet Date: 05/20/10


Sheet Number 42.1

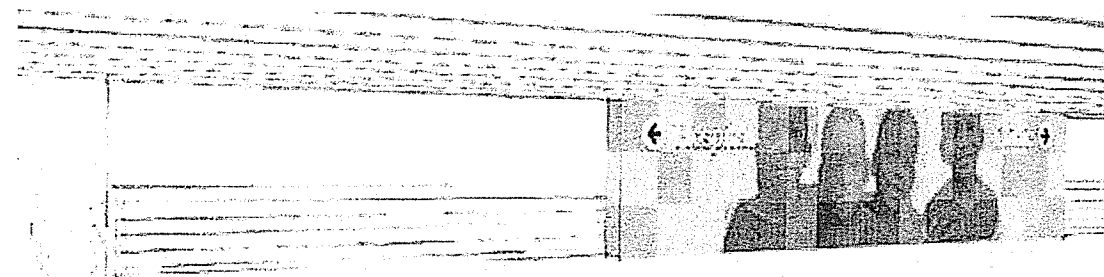


5 Level 4 South Wall Isometric View
Scale: NTS

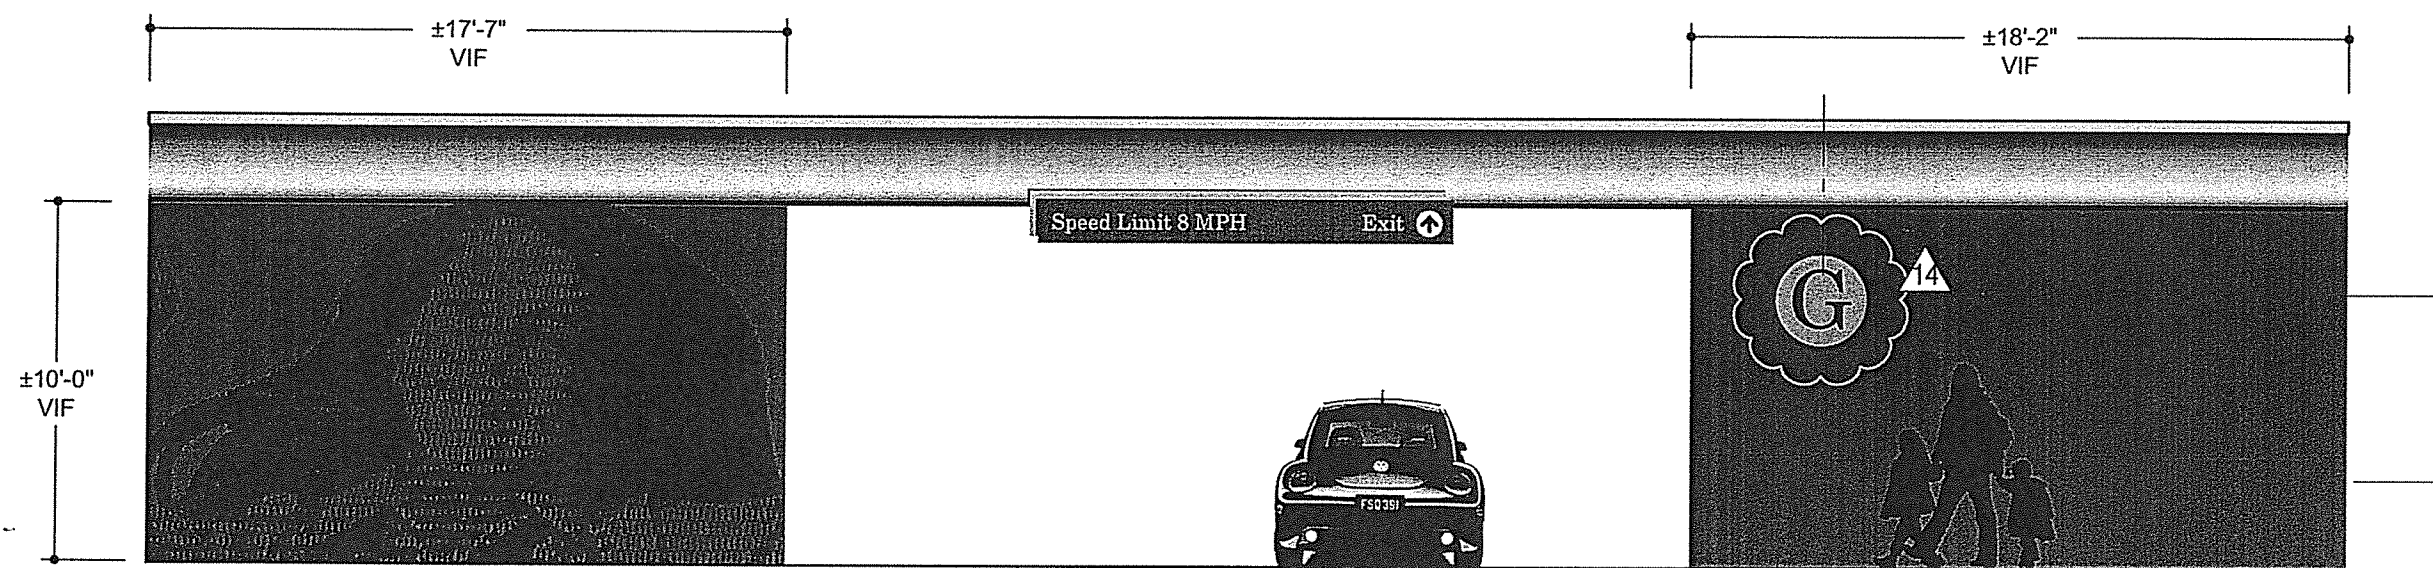


4 Typical Interior Wall - Level 1
Scale: 3/16" = 1'-0"

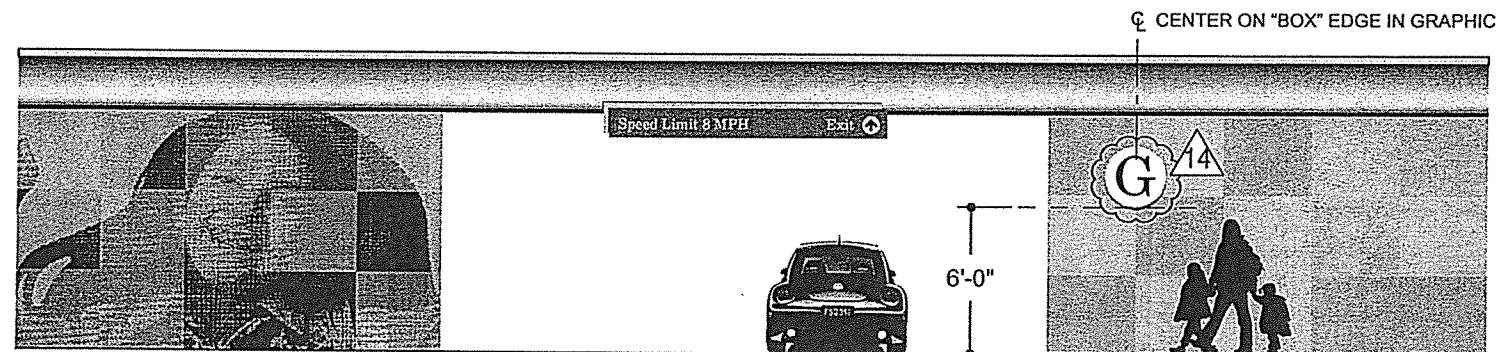


5 Front Elevation
Scale: 1/8" = 1'-0"

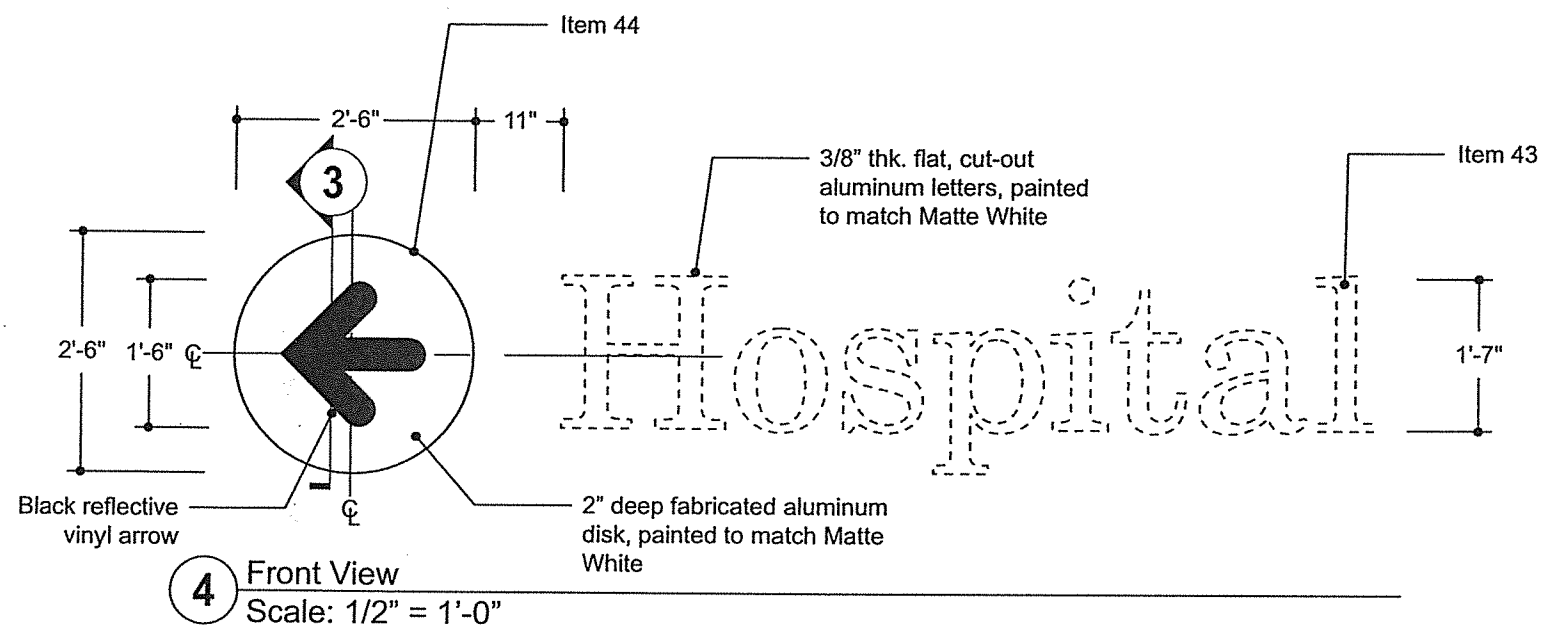


4 Front View
Scale: 1/2" = 1'-0"

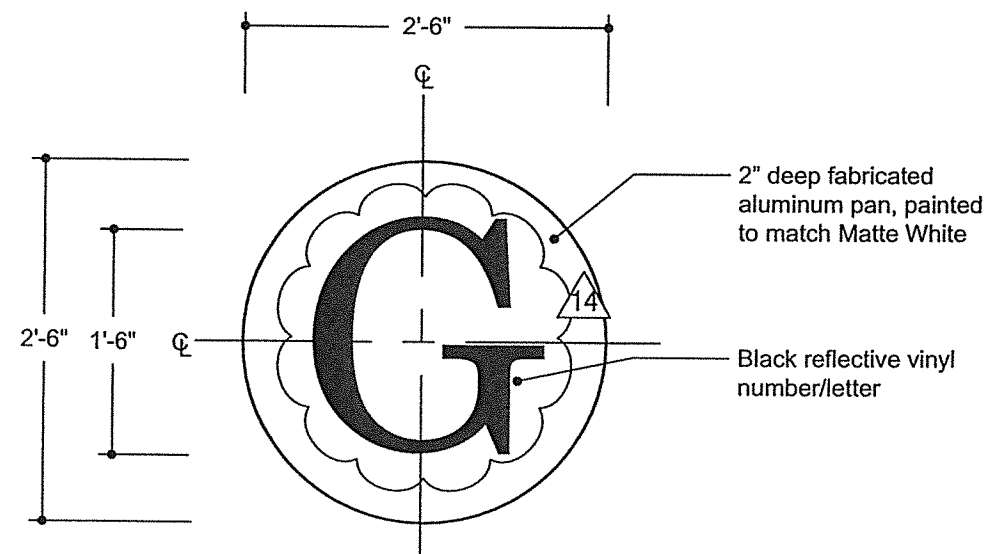

1 Front View
Scale: 3/4" = 1'-0"

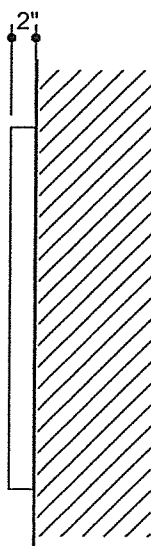

2 Side View
Scale: 3/4" = 1'-0"

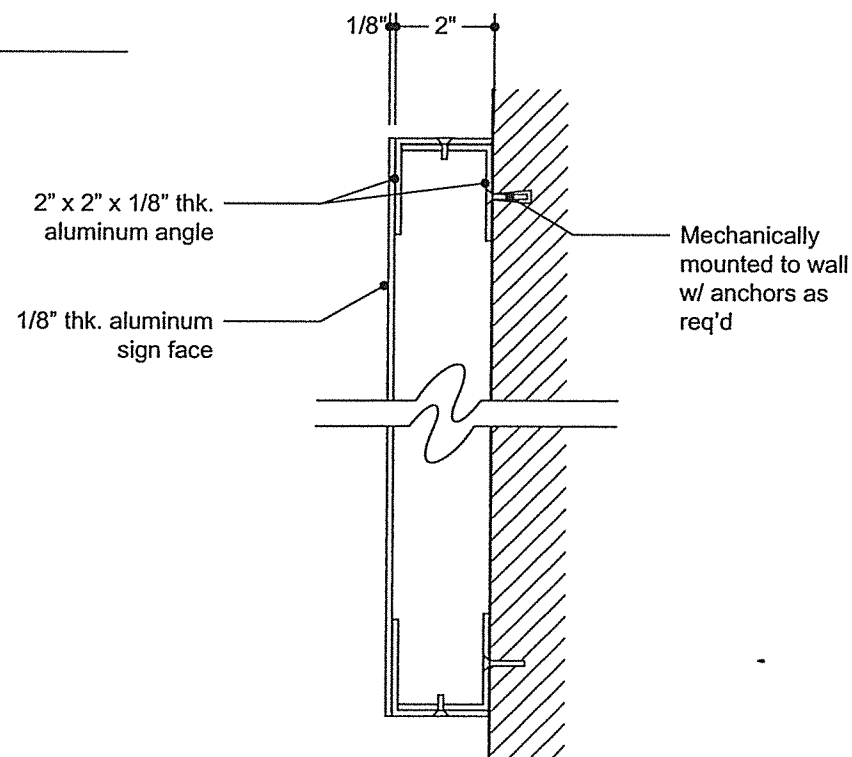

3 Section - Disk
Scale: 3" = 1'-0"

ITEM NO. 44
SIGN TYPE GLD

QTY: 45

SIGN MATERIALS:
2'-6" OD X 2" THK. FABRICATED
ALUMINUM PAN PAINTED W/ APPLIED
REFLECTIVE BLACK VINYL NUMBERS.

MOUNTING:
SURFACE MOUNT W/ MOUNTING
CLEAT AND SET SCREWS, PAINTED
TO MATCH.

COLOR/FINISH:
REFER ELEVATIONS

FONT:
NEW CENTURY SCHOOLBOOK
ROMAN

Invoice Number: 48765

Fabrication Drawing

Project
CHILDREN'S HOSPITAL OF
ORANGE COUNTY

Customer
McCARTHY BUILDING CO.
ATT: JAMES BURGGRAF
20401 S.W. BIRCH ST.
NEWPORT BEACH, CA 92660

Designers
FORMATION

Order Item: 44

Sign Type: GLD

Revision No.:

14 Per Returned Submittal
May 18, 2012


Drawn By: MWilliams




Vomar Products, Inc.
7800 Deering Avenue
Canoga Park, CA 91304-5005
Tel: 818-610-5115
Fax: 818-610-5123
E-Mail: info@vomarproducts.com

Sheet Date: 05/20/10


Sheet Number 44.0

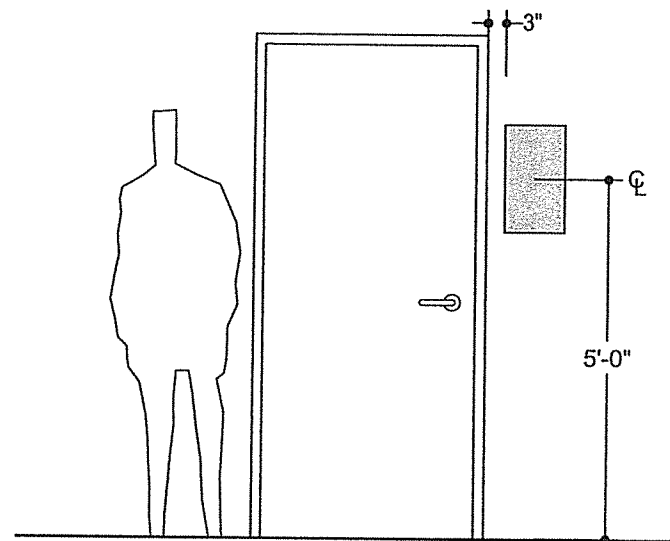

3 Front Elevation @ Stairs
Scale: 3/8" = 1'-0"

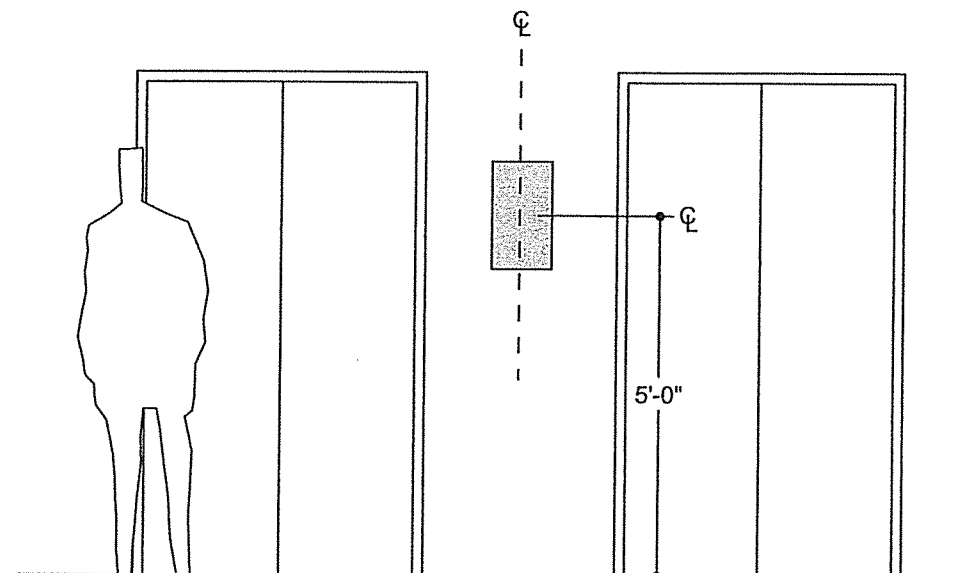

4 Front Elevation @ Elevators
Scale: 3/8" = 1'-0"

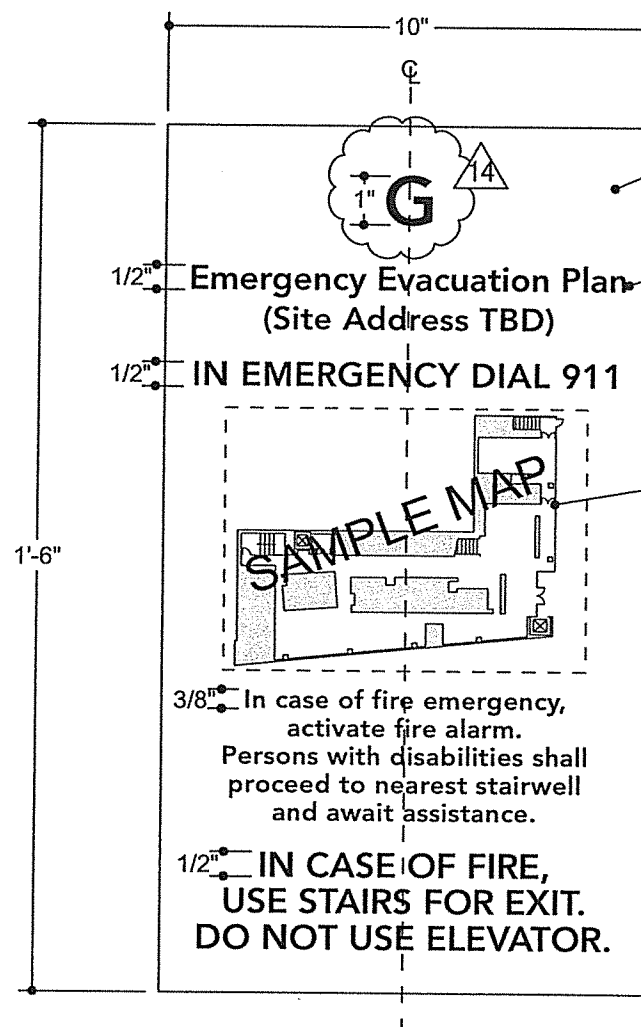


1 Front View
Scale: 3" = 1'-0"

1/4" thk. clear matte finish acrylic plaque painted second surface to match Matte White

Copy - Matte Black

2 color evac map
Artwork provided by designer. Digitally printed map on second surface

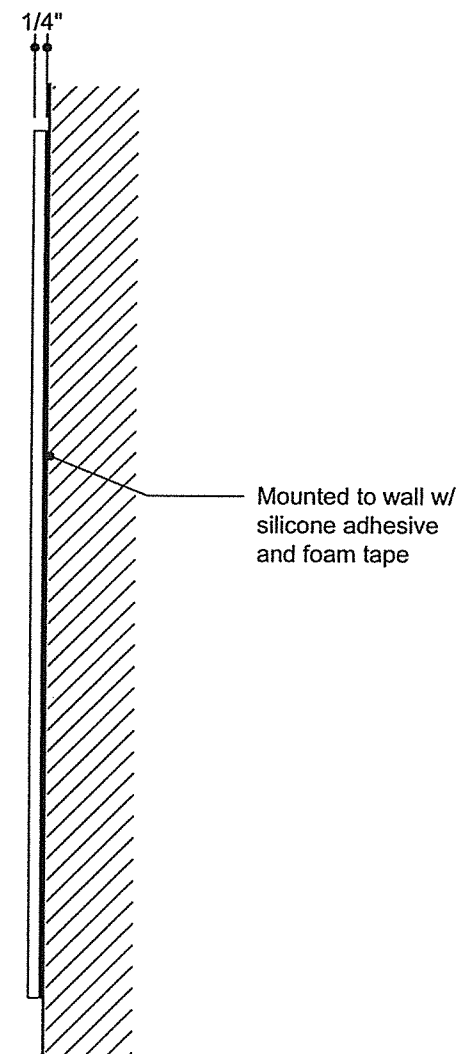

2 Side View
Scale: 3" = 1'-0"

ITEM NO. 47
SIGN TYPE EDS

QTY: 15

SIGN MATERIALS:
18" H X 10" W X 1/4" THK. ACRYLIC
PLAQUE W/ 2 COLOR EVACUATION
MAP AND GRAPHIC LAYOUT. DIGITAL
MAP ARTWORK PROVIDED BY
DESIGNER.

MOUNTING:
WALL SURFACE MOUNTED

COLOR/FINISH:
REFER ELEVATIONS

FONT:
AVENIR 85 HEAVY

Invoice Number: 48765

Fabrication Drawing

Project
CHILDREN'S HOSPITAL OF
ORANGE COUNTY

Customer
McCARTHY BUILDING CO.
ATT: JAMES BURGGRAF
20401 S.W. BIRCH ST.
NEWPORT BEACH, CA 92660

Designers
FORMATION

Order Item: 47

Sign Type: EDS

Revision No.:

14 Per Returned Submittal
May 18, 2012

Drawn By: MWilliams



Vomar Products, Inc.
7800 Deering Avenue
Canoga Park, CA 91304-5005
Tel: 818-610-5115
Fax: 818-610-5123
E-Mail: info@vomarproducts.com

Sheet Date: 05/20/10

Sheet Number 47.0

ITEM NO. 48
SIGN TYPE ISI

QTY: 10

SIGN MATERIALS:
14" X 14" X 1/8" THK. UNFRAMED
EXTERIOR GRADE PHOTOPOLYMER
PLAQUE W/ TACTILE COPY & BRAILLE

MOUNTING:
WALL SURFACE MOUNTED

COLOR/FINISH:
REFER ELEVATIONS

FONT:
AVENIR 85 HEAVY

Invoice Number: 48765

Fabrication Drawing

Project
CHILDREN'S HOSPITAL OF
ORANGE COUNTY

Customer
McCARTHY BUILDING CO.
ATT: JAMES BURGGRAF
20401 S.W. BIRCH ST.
NEWPORT BEACH, CA 92660

Designers
FORMATION

Order Item: 48

Sign Type: ISI

Revision No.:

14 Per Returned Submittal
May 18, 2012


Drawn By: MWilliams




Vomar Products, Inc.
7800 Deering Avenue
Canoga Park, CA 91304-5005
Tel: 818-610-5115
Fax: 818-610-5123
E-Mail: info@vomarproducts.com

Sheet Date: 05/20/10


Sheet Number 48.0

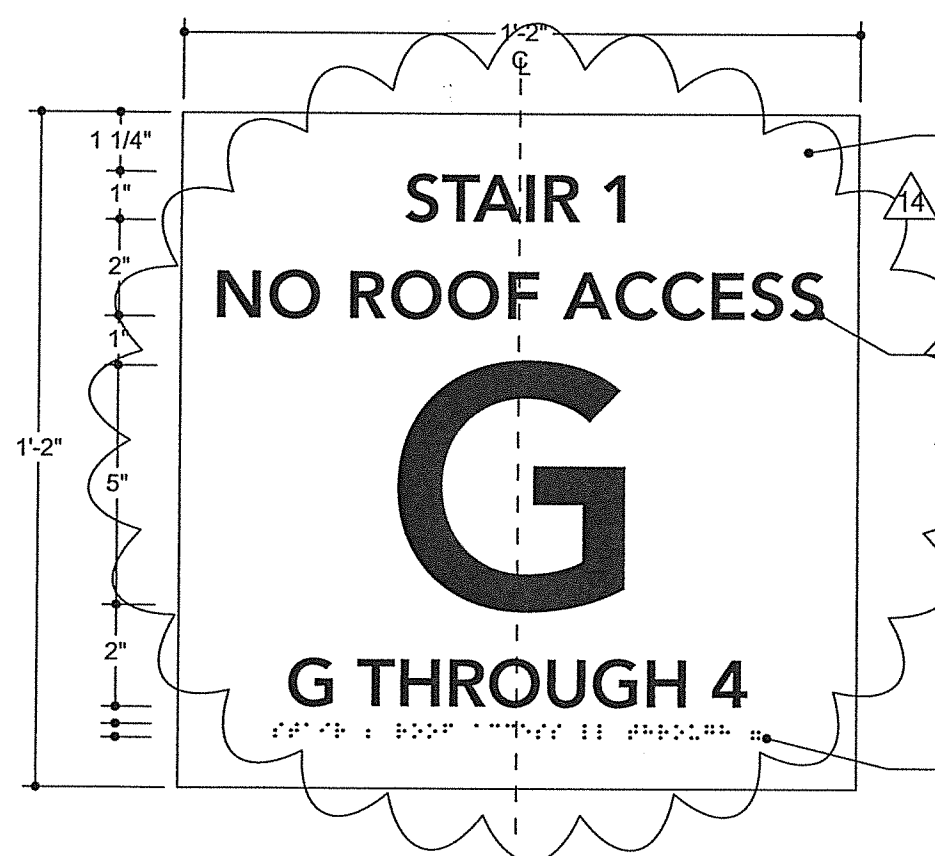


1 Front View
Scale: 3" = 1'-0"

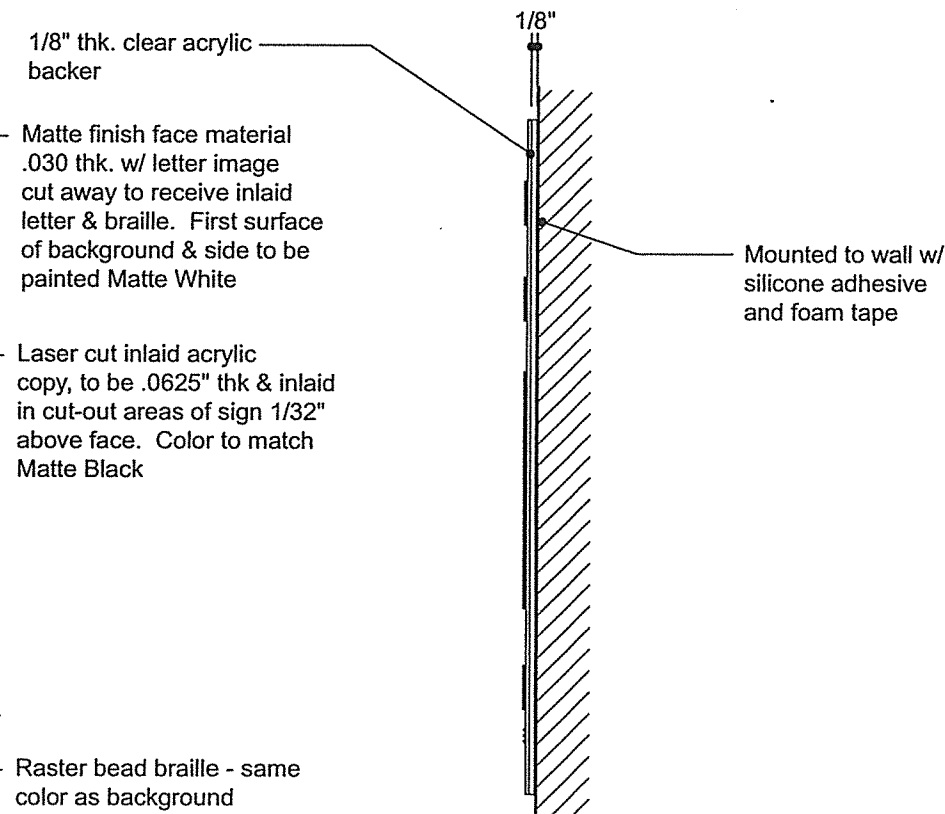

2 Side View
Scale: 3" = 1'-0"

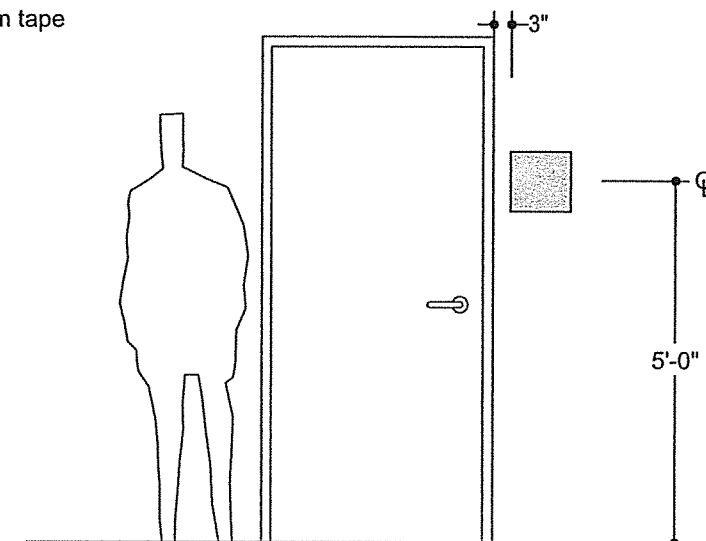


3 Front Elevation
Scale: 3/8" = 1'-0"

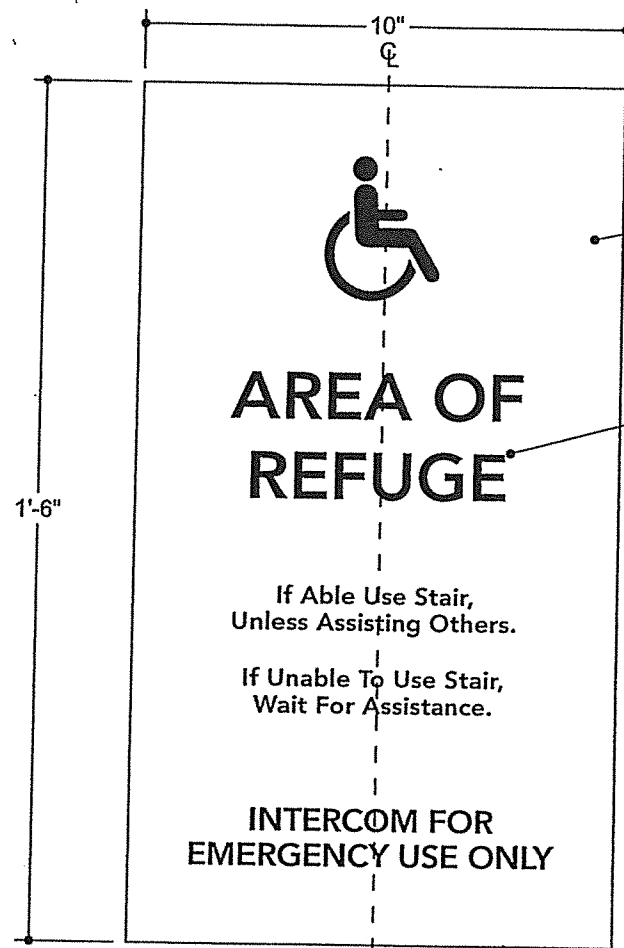

1/4" thk. acrylic plaque w/ silkscreened copy. Background & sides painted to match Matte White


Silkscreened copy and symbol to match Matte Black

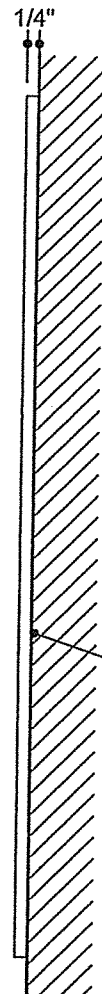

Mounted to wall w/ silicone adhesive and foam tape

4 Front View - Sign Type ARI
Scale: 3" = 1'-0"


5 Side View
Scale: 3" = 1'-0"

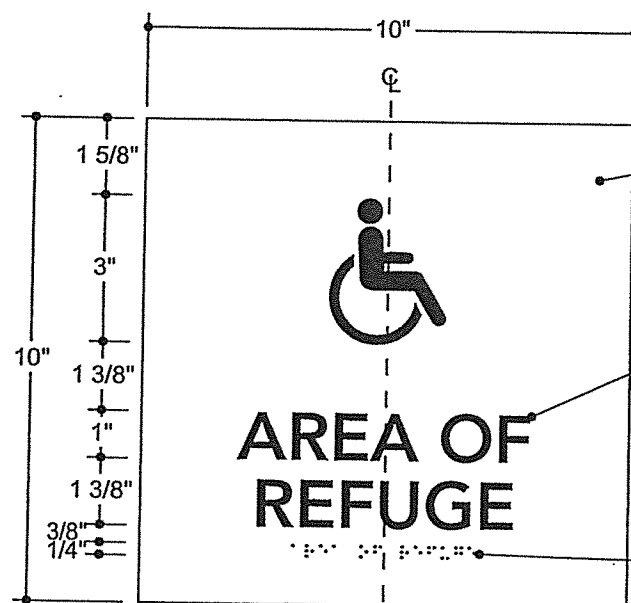

1/4" thk. acrylic plaque w/ raised copy and braille, to meet all ADA requirements Background and sides painted to match matte white

1/32" Raised copy, tip screened to match Matte Black


CA grade II braille - same color as background

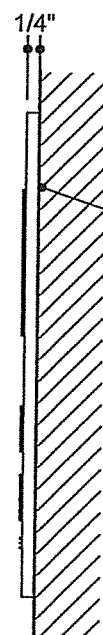

Mounted to wall w/ silicone adhesive and foam tape

1 Front View - Sign Type AEP
Scale: 3" = 1'-0"

2 Side View
Scale: 3" = 1'-0"

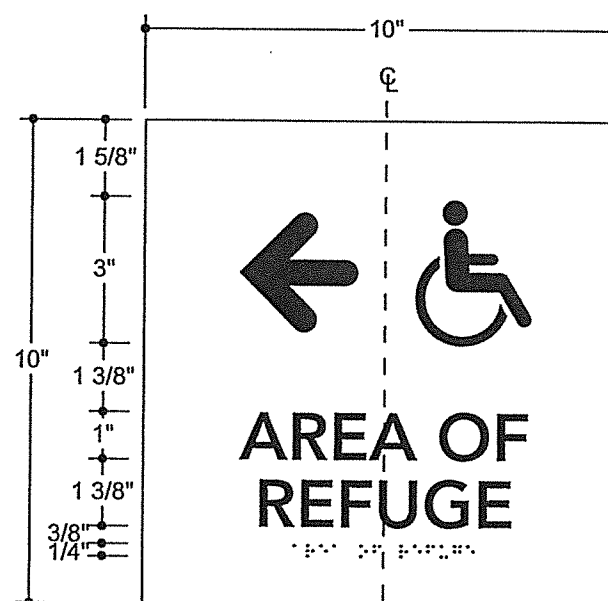

3 Front View - Sign Type AEP
Scale: 3" = 1'-0"

SEE INCH.
AC DRESS #7
For
BASED on
Fire Marshall
Approval

ITEM NO. 52
SIGN TYPE ARI, AEP

QTY: ADVISE

SIGN MATERIALS:
10" X 10" X 1/4" THK AND
10" W X 1'-6" H X 1/4" THK. ACRYLIC
PANEL W/ RAISED COPY AND BRAILLE
AND ACRYLIC W/ SILKSCREENED
COPY.

MOUNTING:
WALL SURFACE MOUNTED

COLOR/FINISH:
REFER ELEVATIONS

FONT:
AVENIR 85 HEAVY

Invoice Number: 48765

Fabrication Drawing

Project
CHILDREN'S HOSPITAL OF
ORANGE COUNTY

Customer
McCARTHY BUILDING CO.
ATT: JAMES BURGGRAF
20401 S.W. BIRCH ST.
NEWPORT BEACH, CA 92660


Designers
FORMATION

Order Item: 52

Sign Type: ARI, AEP

Revision No.:

Drawn By: MWilliams

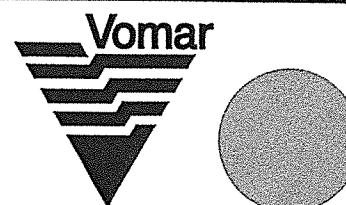

Vomar Products, Inc.
7800 Deering Avenue
Canoga Park, CA 91304-5005
Tel: 818-610-5115
Fax: 818-610-5123
E-Mail: info@vomarproducts.com

Sheet Date: 05/20/10

Sheet Number 52.0

Fabrication Drawing

Project
CHILDREN'S HOSPITAL OF
ORANGE COUNTY


Customer
McCARTHY BUILDING CO.
ATT: JAMES BURGGRAF
20401 S.W. BIRCH ST.
NEWPORT BEACH, CA 92660

Designers
FORMATION


Order Item: 52

Sign Type: ARI, AEP

Revision No.:

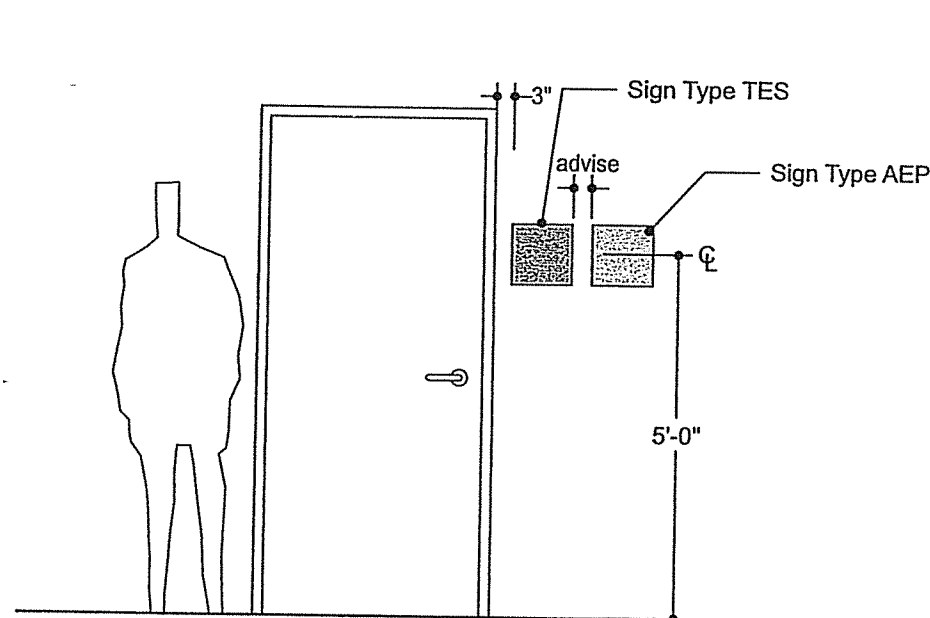


6 Front Elevation
Scale: 3/8" = 1'-0"

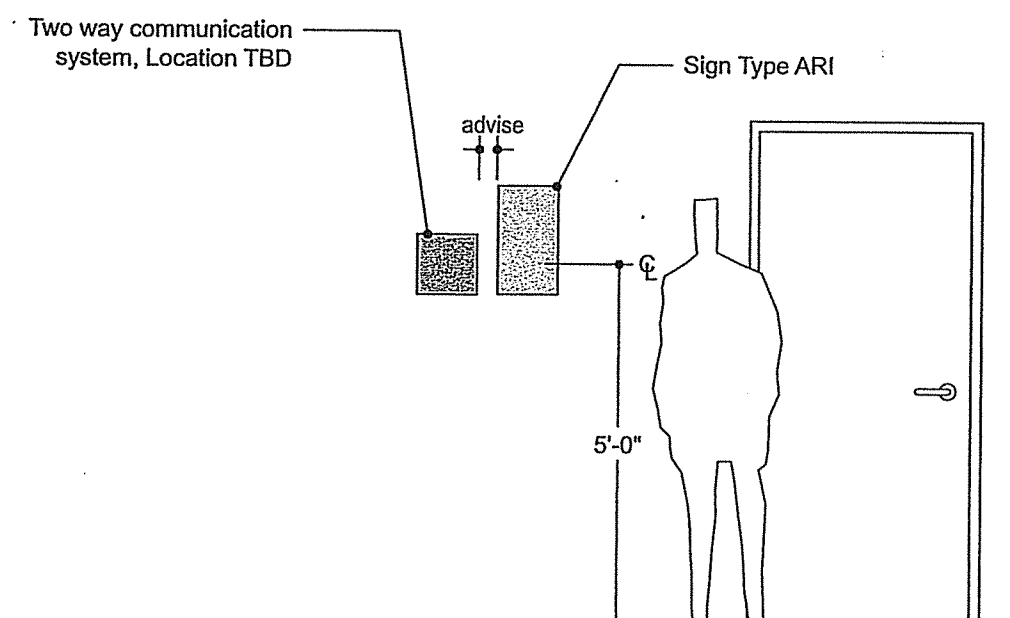

7 Front Elevation
Scale: 3/8" = 1'-0"


Drawn By: MWilliams

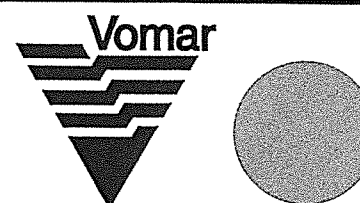


Vomar Products, Inc.
7800 Deering Avenue
Canoga Park, CA 91304-5005
Tel: 818-610-5115
Fax: 818-610-5123
E-Mail: info@vomarproducts.com

Sheet Date: 05/20/10

Sheet Number 52.1

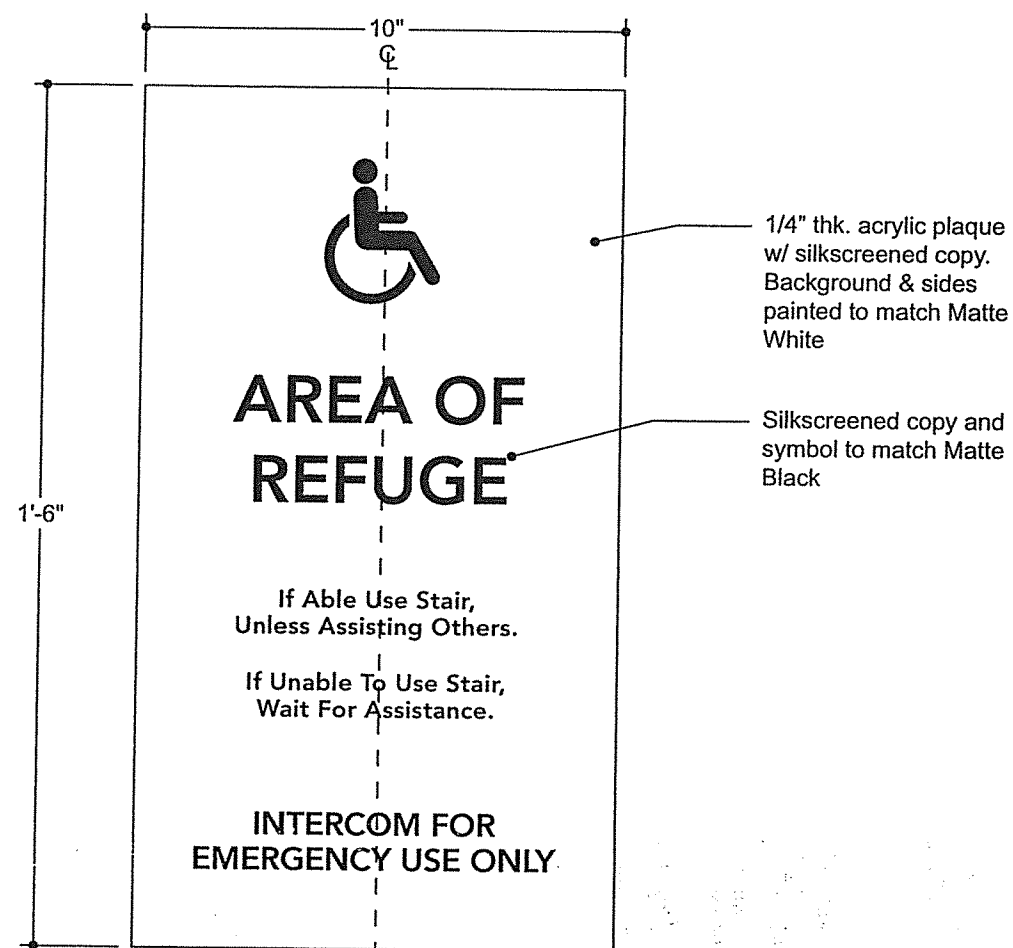

4 Front View - Sign Type ARI
Scale: 3" = 1'-0"

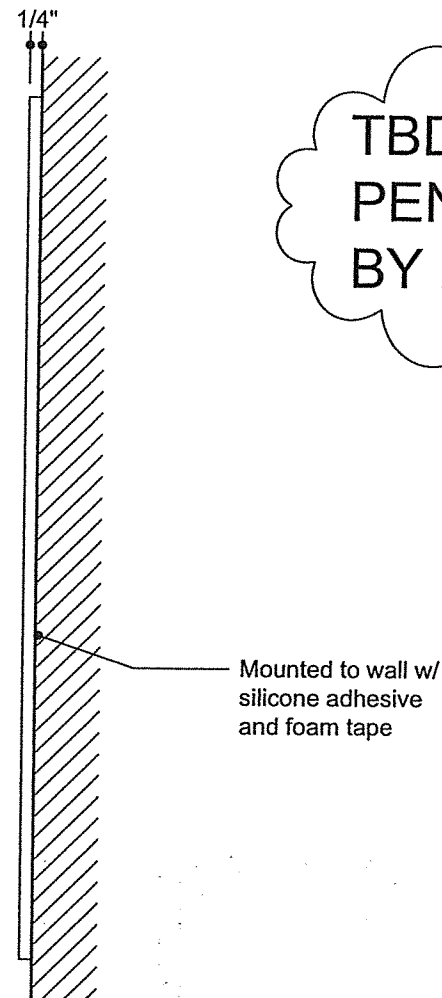

5 Side View
Scale: 3" = 1'-0"



ITEM NO. 55
SIGN TYPE ARI, AEP

QTY: ADVISE

SIGN MATERIALS:
10" X 10" X 1/4" THK AND
10" W X 1'-6" H X 1/4" THK. ACRYLIC
PANEL W/ RAISED COPY AND BRAILLE
AND ACRYLIC W/ SILKSCREENED
COPY.

MOUNTING:
WALL SURFACE MOUNTED

COLOR/FINISH:
REFER ELEVATIONS

FONT:
AVENIR 85 HEAVY

Invoice Number: 48765

Fabrication Drawing

Project
CHILDREN'S HOSPITAL OF
ORANGE COUNTY

Customer
McCARTHY BUILDING CO.
ATT: JAMES BURGGRAB
20401 S.W. BIRCH ST.
NEWPORT BEACH, CA 92660


Designers
FORMATION

Order Item: 55


Sign Type: ARI, AEP

Revision No.:


14 Per Returned Submittal
May 18, 2012

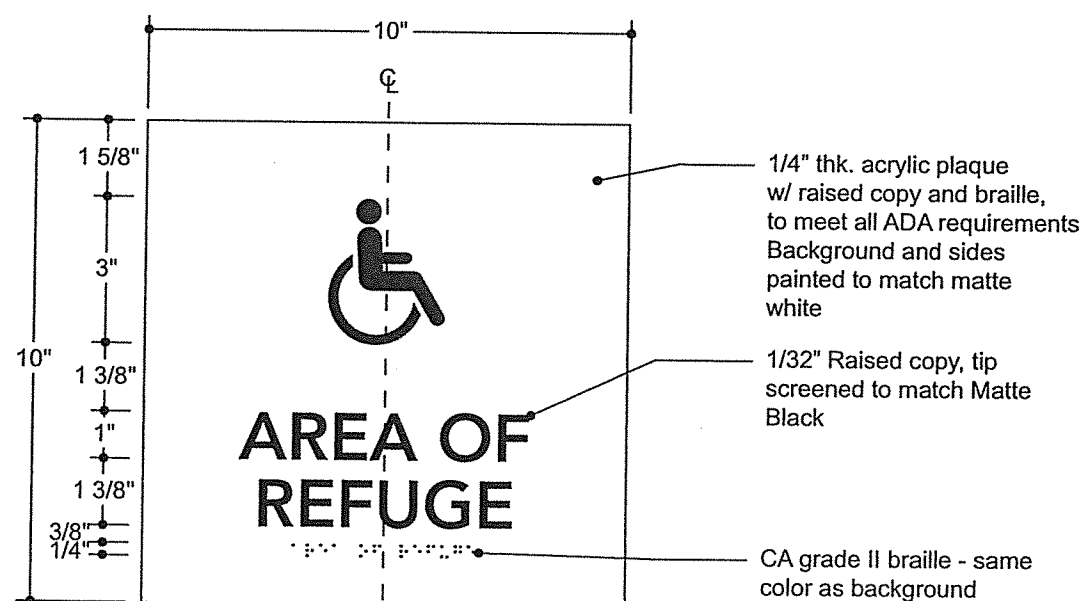

1 Front View - Sign Type AEP
Scale: 3" = 1'-0"

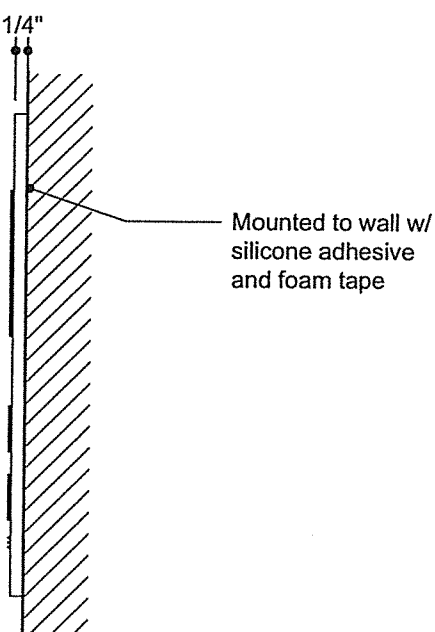

2 Side View
Scale: 3" = 1'-0"

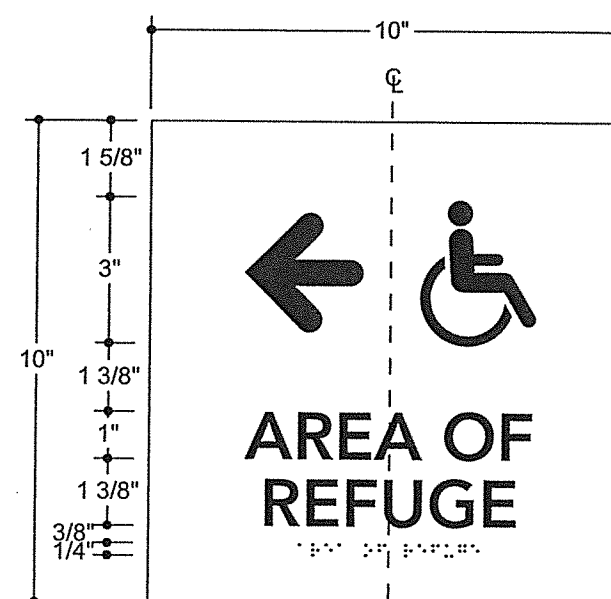

3 Front View - Sign Type AEP
Scale: 3" = 1'-0"

Drawn By: MWilliams



Vomar Products, Inc.
7800 Deering Avenue
Canoga Park, CA 91304-5005
Tel: 818-610-5115
Fax: 818-610-5123
E-Mail: info@vomarproducts.com

Sheet Date: 05/20/10

Sheet Number 55.0

CHILDREN'S HOSPITAL OF ORANGE COUNTY

48765

Customer- McCarthy Building Co.

Designer - Formation

Fabrication & Installation - Vomar Products, Inc.

ASI # 253

- 1 Per Site Meeting
Jan. 9, 2010
- 2 Per RFI 2133-0
Sep. 03, 2010
- 3 Per Exterior Signage
Resubmittal Comments
Dec. 9, 2010
- 4 Per ASI #34
Oct. 15, 2010
- 5 Per Submittal 010400-0001-1
Dec. 21, 2010
- 6 Per RFI 4494-0
Oct. 13, 2011
- 7 Per RFI 3003 R2
Jan. 16, 2012
- 8 Per ASI 129
Jan. 16, 2012
- 9 Per RFI 3003 R2
Feb. 23, 2012
- 10 Per ASI 183 \ 171
March 16, 2012
- 11 Per ASI 180
March 16, 2012
- 12 Per RFI #5698
April 30, 2012
- 13 Per Sample Review
May 4, 2012
- 14 Per RFI 5669
June 8, 2012
- 15 Per Schedule Sbmth.
May 22, 2012

- 30 ASI # 211
- 32 Per ASI # 250
- 33 Per ASI # 253

- 25 Per ASI # 194
- 26 Per ASI # 343
- 27 Per ASI # 164


- 22 Per ASI # 70 and ASI # 176
- 23 Per RFI # 3003
- 24 Per ASI # 158

- 19 Per RFI 5692
June 27, 2012
- 20 Per ASI # 34
- 21 South Brick Donor Wall

- 16 Per RFI 694
June 1, 2012
- 17 Per ASI 221
May 31, 2012
- 18 Per RFI 5700
May 20, 2012



3 Garage East Entrance
Scale: 3/32" = 1'-0"

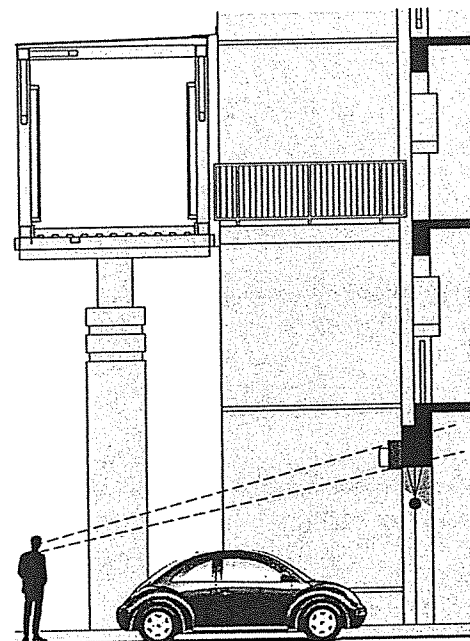

4 Section
Scale: 3/32" = 1'-0"

ITEM NO. 37
SIGN TYPE DIGE

QTY: 1

SIGN MATERIALS:
SIGN CONSISTS OF
(14 EA.) 12" H X 4" DEEP FABRICATED
ALUMINUM LED ILLUMINATED WHITE
MONOLITHIC LETTERS WITH WHITE
ACRYLIC FACE AND TRIM CAP.

MOUNTING:
MOUNTED TO EXISTING STRUCTURAL
STEEL SIGN CABINET (PROVIDED AND
INSTALLED BY OTHERS)

COLOR/FINISH:
REFER ELEVATIONS

FONT:
AVENIR 65 MEDIUM

Invoice Number: 48765

Fabrication Drawing

Project
CHILDREN'S HOSPITAL OF
ORANGE COUNTY

Customer
McCARTHY BUILDING CO.
ATT: JAMES BURGGRAF
20401 S.W. BIRCH ST.
NEWPORT BEACH, CA 92660

Designers
FORMATION

Order Item: 37


Sign Type: DIGE

Revision No.:

5 Per Submittal 010400-0001-1
Dec. 21, 2010

31 Per RFI6052


- A** MAINTAIN 9'-2" TO BOTTOM OF RACEWAY TO BE PAINTED TO MATCH "RED" CANOPY AT DRIVE AISLE
- B** GARAGE CLEARANCE BAR (SEE GCB - SHEET AGC27.0) BOTTOM OF CLEARANCE BAR 8'-0" AFF
- C** CABLE (SEE GCB - SHEET AGC27.0) ADJUST AS NEED TO MAINTAIN CLEARANCE

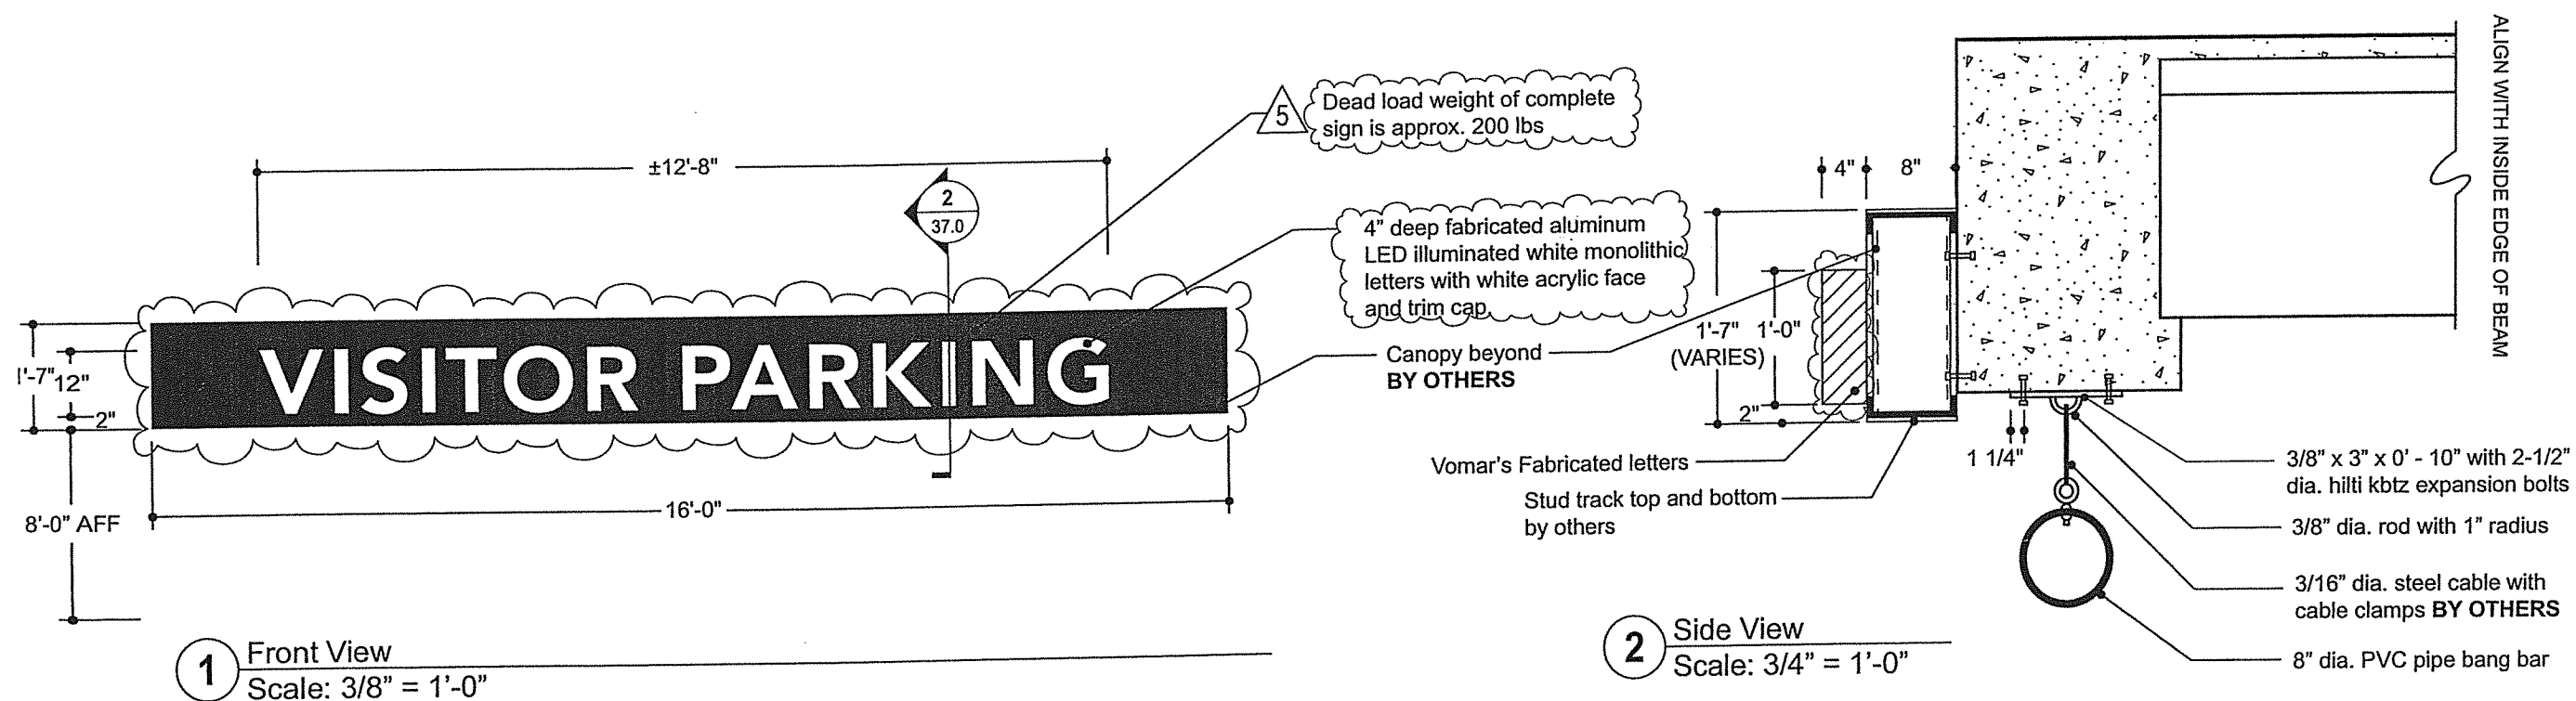

1 Front View
Scale: 3/8" = 1'-0"

2 Side View
Scale: 3/4" = 1'-0"

Drawn By: MWilliams / APalmer

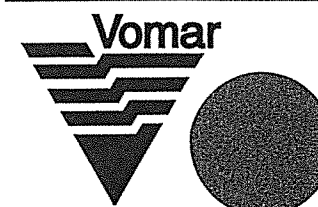

Vomar Products, Inc.
7800 Deering Avenue
Canoga Park, CA 91304-5005
Tel: 818-610-5115
Fax: 818-610-5123
E-Mail: info@vomarproducts.com

Sheet Date: 09/04/2012

Sheet Number 37.0

Children's Hospital of Orange County
Tower 2 Garage Graphics
Project: 12407001

Message Schedule
ASI #253: 4 September 2012

Sign Type/ Loc.	Description	Message	Comments	Level	Sheet
DIGE 01	Destination Identification Garage East	VISITOR PARKING (See Layout)	Mounts To Underside Of Concrete Beam	1	AGC22.0

Invoice Number: 48765

Fabrication Drawing

Project
CHILDREN'S HOSPITAL OF ORANGE COUNTY

Customer
McCARTHY BUILDING CO.
ATT: JAMES BURGGRAF
20401 S.W. BIRCH ST.
NEWPORT BEACH, CA 92660


Designers
FORMATION

Order Item: 37

Sign Type: DIGE

Revision No.:



Drawn By: MWilliams / APalmer

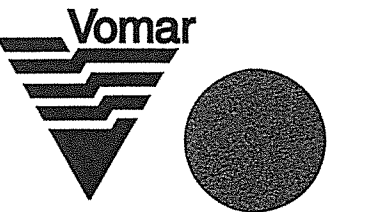

Vomar Products, Inc.
7800 Deering Avenue
Canoga Park, CA 91304-5005
Tel: 818-610-5115
Fax: 818-610-5123
E-Mail: info@vomarproducts.com

Sheet Date: 09/12/12

Sheet Number 37.1

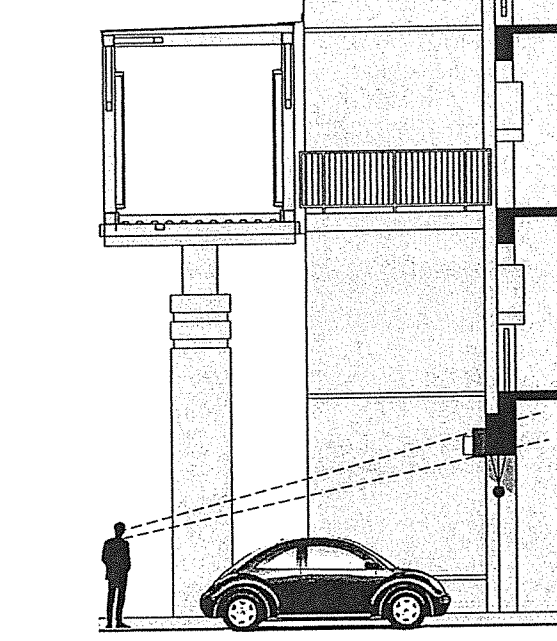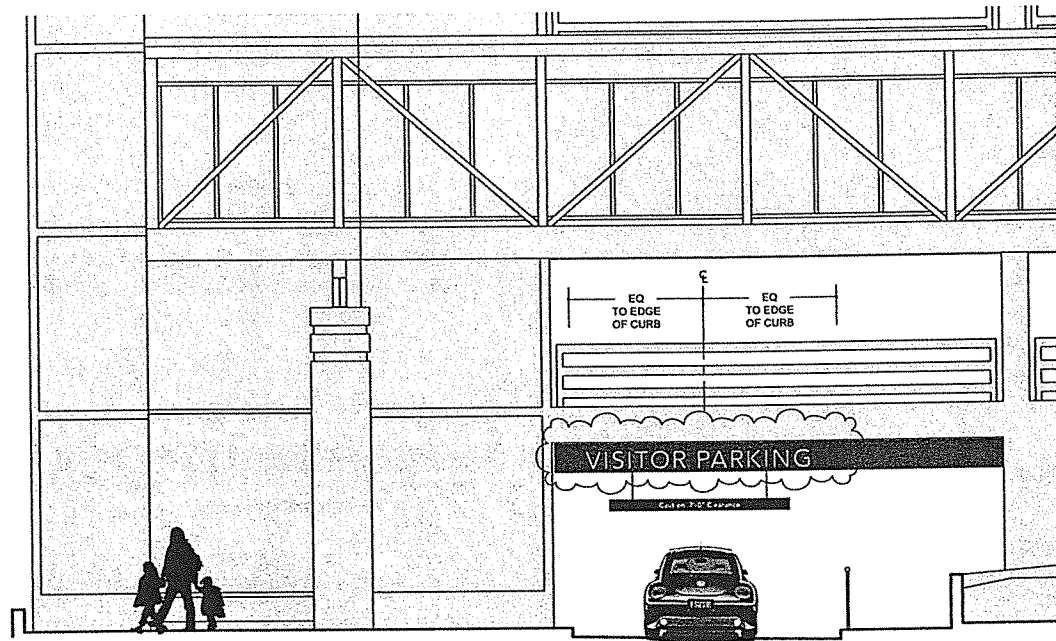

4 Garage East Entrance
Scale: 3/32" = 1'-0"

5 Section
Scale: 3/32" = 1'-0"

ITEM NO. 38
SIGN TYPE GCB

QTY: 1

SIGN MATERIALS:
10'-0" X 8" OD PVC BANG BAR W/ END CAPS. PAINTED W/ REFLECTIVE VINYL COPY.

MOUNTING:
CABLE HUNG

COLOR/FINISH:
REFER ELEVATIONS

FONT:
AVENIR 65 MEDIUM

Invoice Number: 48765

Fabrication Drawing

Project
CHILDREN'S HOSPITAL OF ORANGE COUNTY


Customer
McCARTHY BUILDING CO.
ATT: JAMES BURGGRAF
20401 S.W. BIRCH ST.
NEWPORT BEACH, CA 92660

Designers
FORMATION


Order Item: 38

Sign Type: GCB

Revision No.:

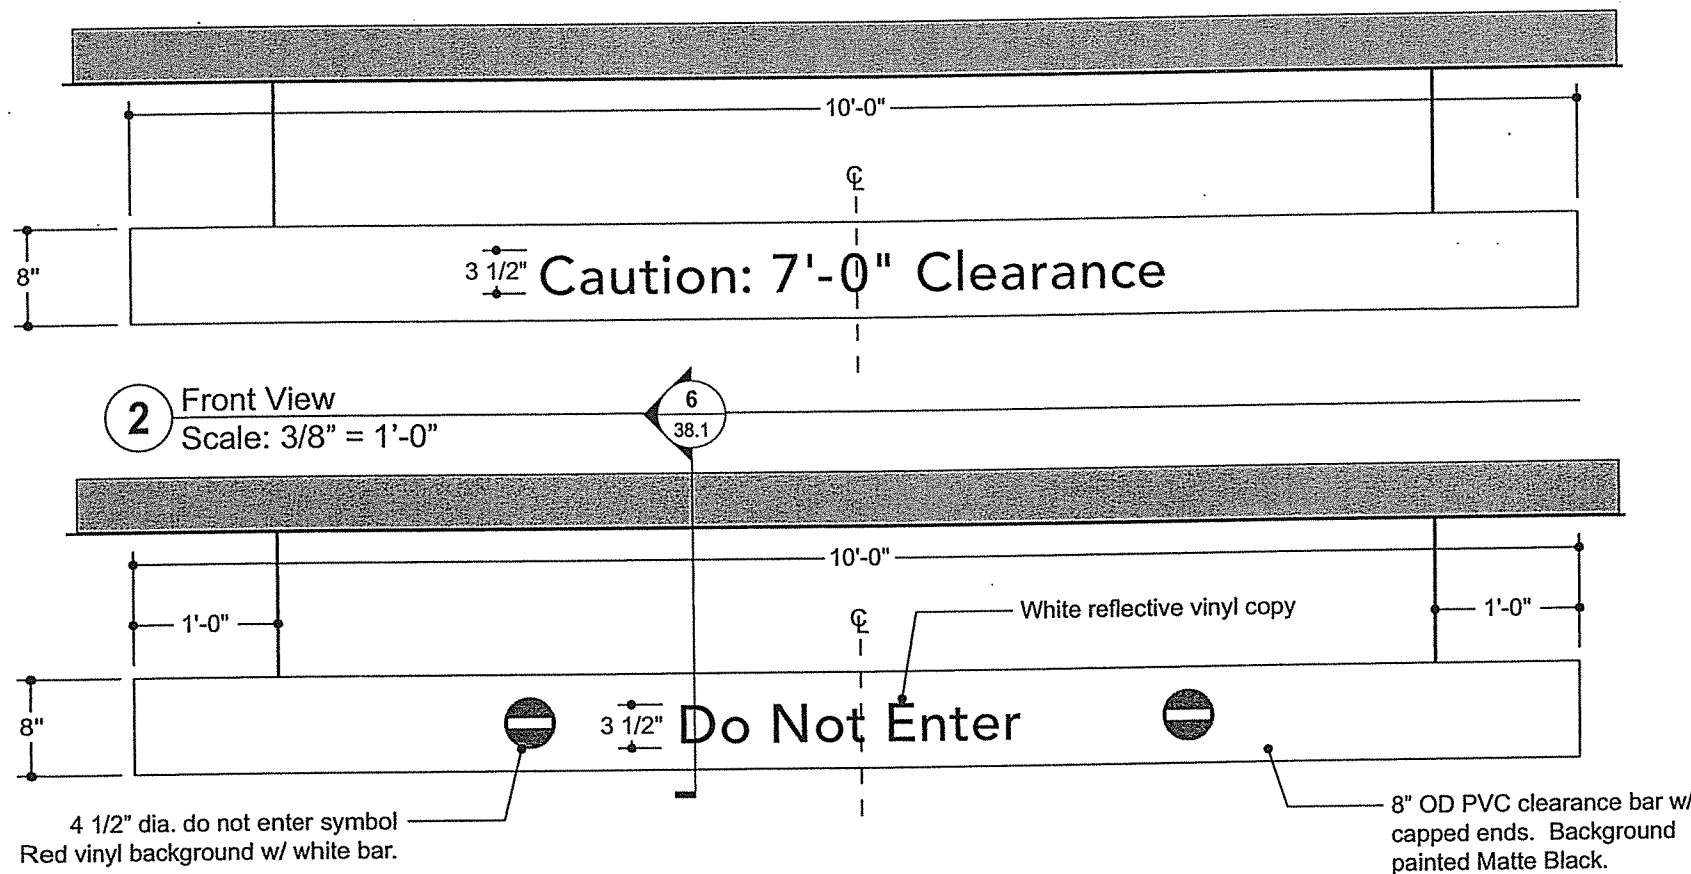


2 Front View
Scale: 3/8" = 1'-0"

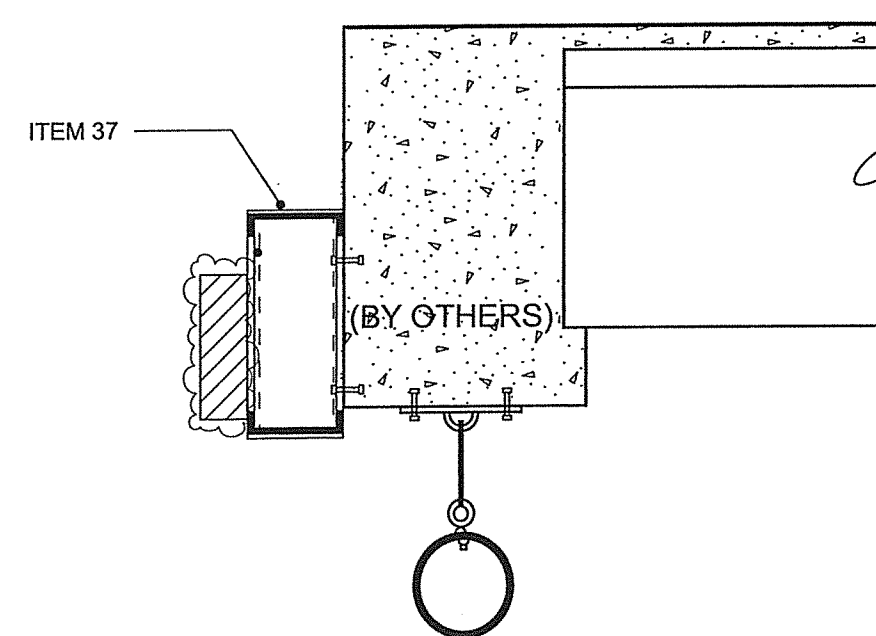

3 Side View
Scale: 3/4" = 1'-0"

Drawn By: Apalmer

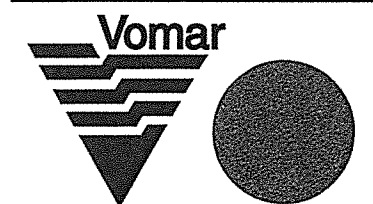

Vomar Products, Inc.
7800 Deering Avenue
Canoga Park, CA 91304-5005
Tel: 818-610-5115
Fax: 818-610-5123
E-Mail: info@vomarproducts.com

Sheet Date: 09/13/12

Sheet Number 38.0

Children's Hospital of Orange County
Tower 2 Garage Graphics
Project: 12407001

Message Schedule
ASI #253: 4 September 2012

Sign Type/ Loc.	Description	Message	Comments	Level	Sheet
GCB 01	Garage Clearance Bar	Side A: Caution: 7'-0" Clearance Side B: Do Not Enter (with symbols per layout)	Mounts To Underside Of Canopy Sign As Specified In Drawings Owner To Verify Clearance Height	1	AGC22.0

Invoice Number: 48765

Fabrication
Drawing

Project
CHILDREN'S HOSPITAL OF
ORANGE COUNTY

Customer
McCARTHY BUILDING CO.
ATT: JAMES BURGGRAF
20401 S.W. BIRCH ST.
NEWPORT BEACH, CA 92660


Designers
FORMATION

Order Item: 38

Sign Type: GCB

Revision No.:

Drawn By: Apalmer

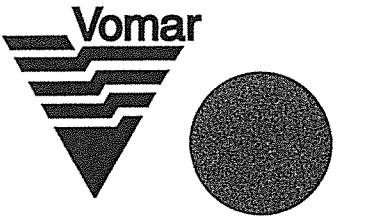

Vomar Products, Inc.
7800 Deering Avenue
Canoga Park, CA 91304-5005
Tel: 818-610-5115
Fax: 818-610-5123
E-Mail: info@vomarproducts.com

Sheet Date: 09/13/12

Sheet Number 38.1

Fabrication Drawing

Project
CHILDREN'S HOSPITAL OF
ORANGE COUNTY


Customer
McCARTHY BUILDING CO.
ATT: JAMES BURGGRAF
20401 S.W. BIRCH ST.
NEWPORT BEACH, CA 92660

Designers
FORMATION


Order Item: 39

Sign Type: DIGN

Revision No.:

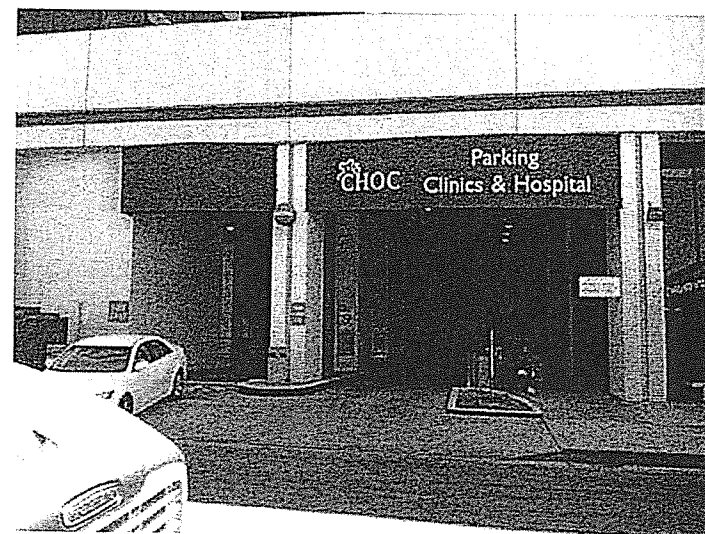


Existing Conditions

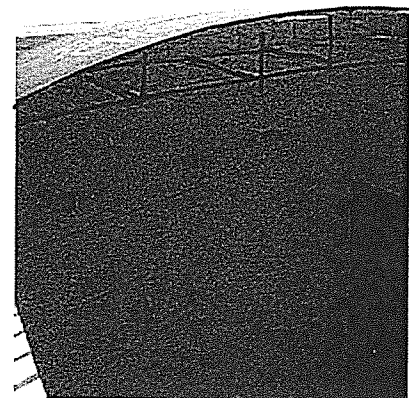

EXISTING
FRAMEWORK
TO REMAIN

ITEM 39 QTY 1
REVISED SIGN TYPE DIGN


REMOVE AND REPLACE EXISTING BLUE FABRIC ON EXISTING CANOPIES
REPLACE WITH Project "RED" canopy material (see sample color provided)
Material to be "sunbrella" or equivalent
all copy to be white size as shown
Paint existing frame to match red material color

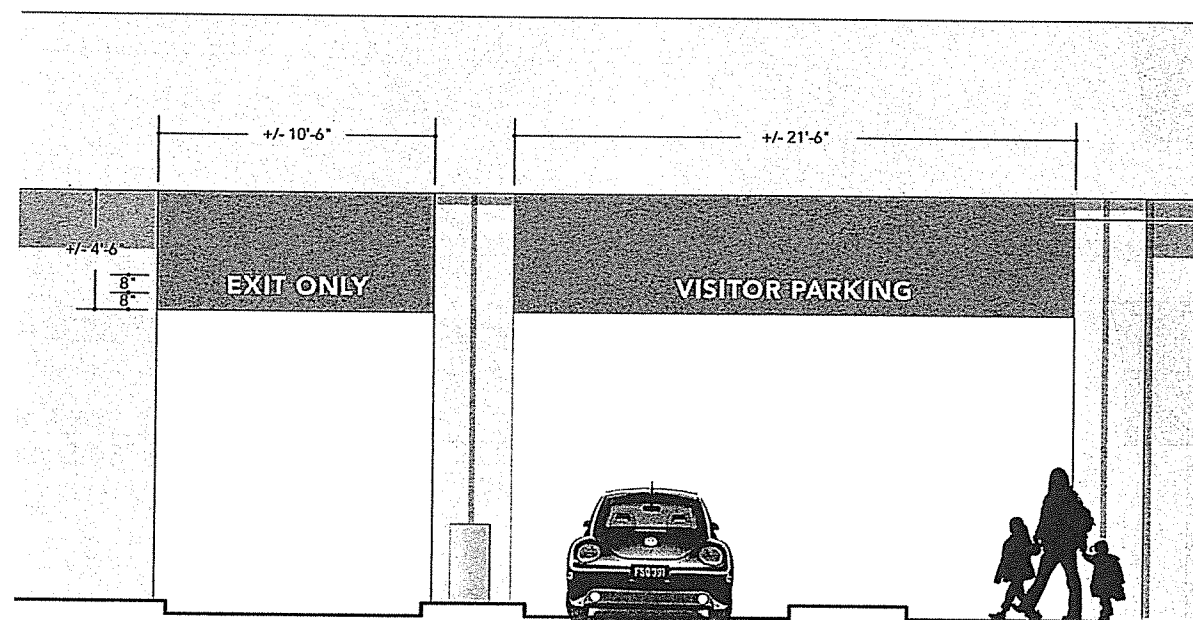

11 Location Elevation: Garage North Entrance
Scale: 3/16" = 1'-0"
DIGN


DIGN: Destination Identification Garage North

FABRICATOR TO REMOVE AND REPLACE EXISTING BLUE CANOPIES WITH
NEW CANOPIES MATCHING PROJECT "RED". MESSAGES TO BE WHITE.
ALL DIMENSIONS SHOWN ARE APPROXIMATE - FABRICATOR TO FIELD
VERIFY PRIOR TO OUTPUT OF SHOP DRAWINGS.

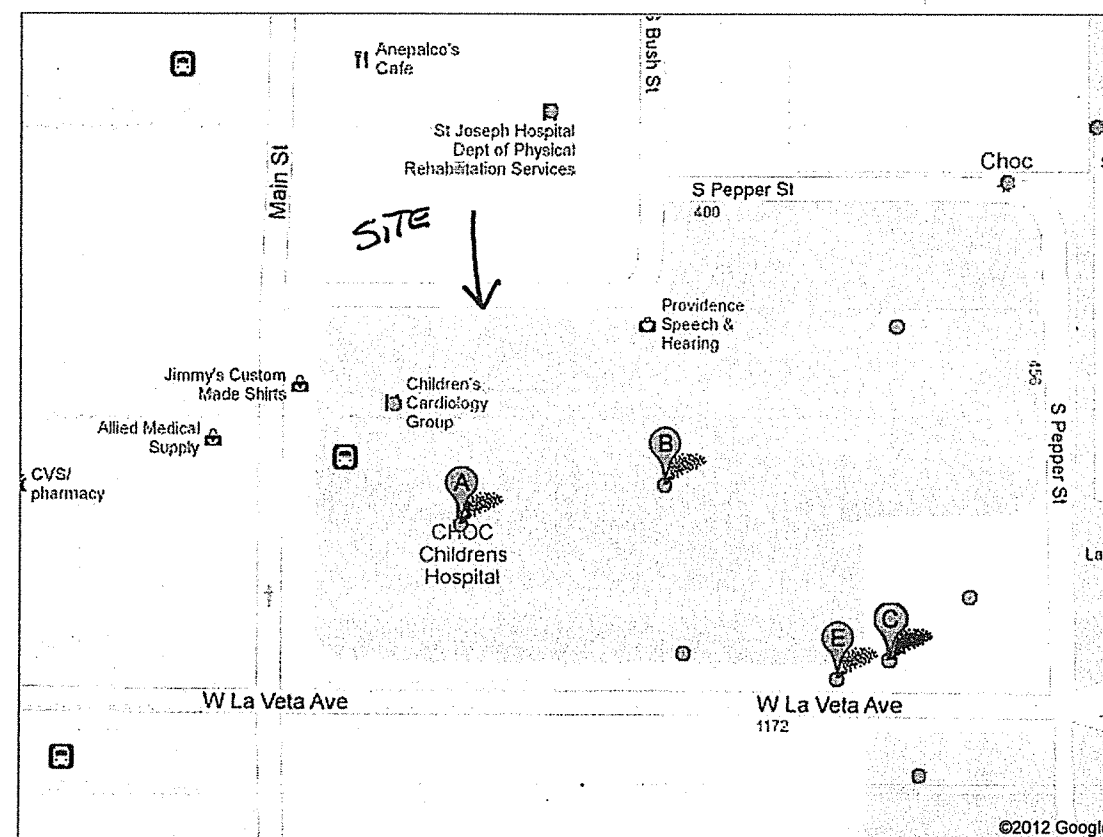

1349 WEST PROVIDENCE, ORANGE

AGC 27.0
Drawn By: MWilliams

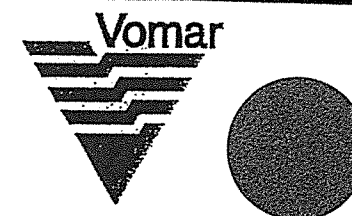

Vomar Products, Inc.
7800 Deering Avenue
Canoga Park, CA 91304-5005
Tel: 818-610-5115
Fax: 818-610-5123
E-Mail: info@vomarproducts.com

Sheet Date: 05/20/10

Sheet Number 39.0

1 Front View
Scale: 3/4" = 1'-0"

Fabrication Drawing

Project
CHILDREN'S HOSPITAL OF
ORANGE COUNTY

Customer
McCARTHY BUILDING CO.
ATT: JAMES BURGGRAF
20401 S.W. BIRCH ST.
NEWPORT BEACH, CA 92660


Designers
FORMATION

Order Item: 40

Sign Type: GIP

Revision No.:

Drawn By: MWilliams / APalmer

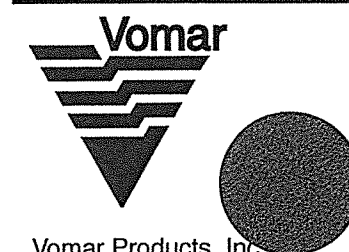

Vomar Products, Inc.
7800 Deering Avenue
Canoga Park, CA 91304-5005
Tel: 818-610-5115
Fax: 818-610-5123
E-Mail: info@vomarproducts.com

Sheet Date: 09/13/12

Sheet Number 40.0

ITEM NO. 40
SIGN TYPE GIP





QTY: 2

SIGN MATERIALS:
1'-8" H X 7 1/2" W X 1/8" PAINTED ALUMINUM
SIGN PANEL. REFLECTIVE SYMBOL &
COPY. SIGN TO HAVE 1/8" THK. PAINTED
ALUMINUM COPY

MOUNTING:
WALL SURFACE MOUNTED

COLOR/FINISH:
REFER ELEVATIONS

FONT:
AVENIR 65 MEDIUM
NEW CENTURY SCHOOLBOOK ROMAN

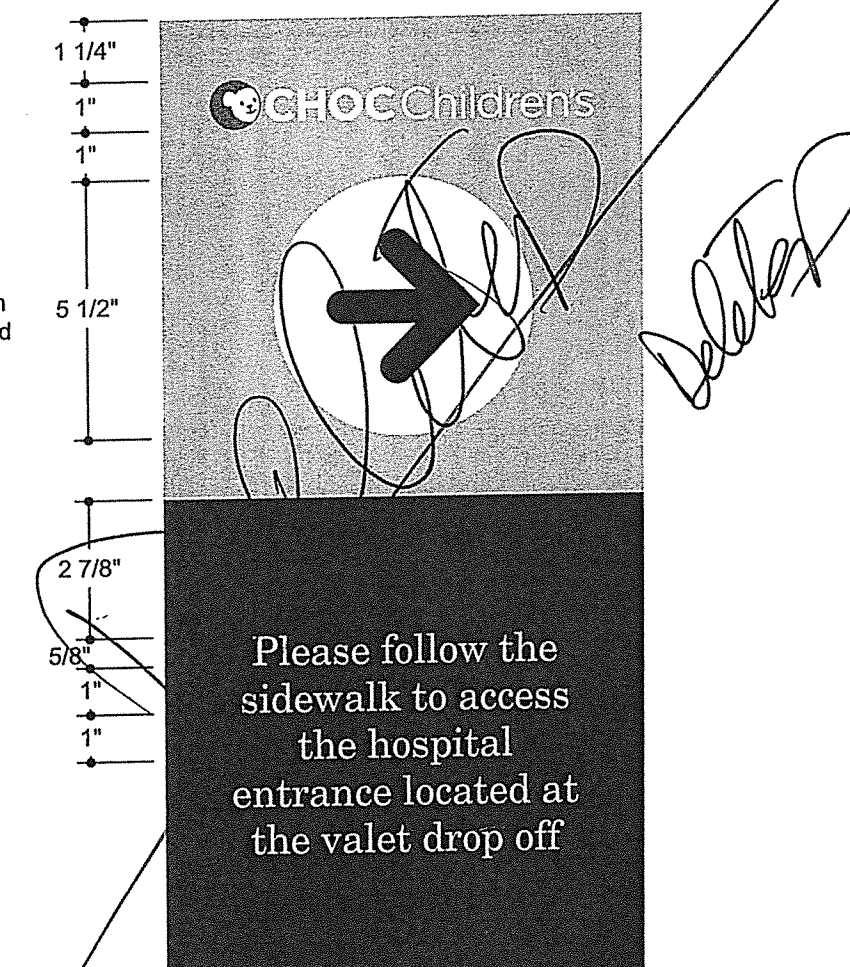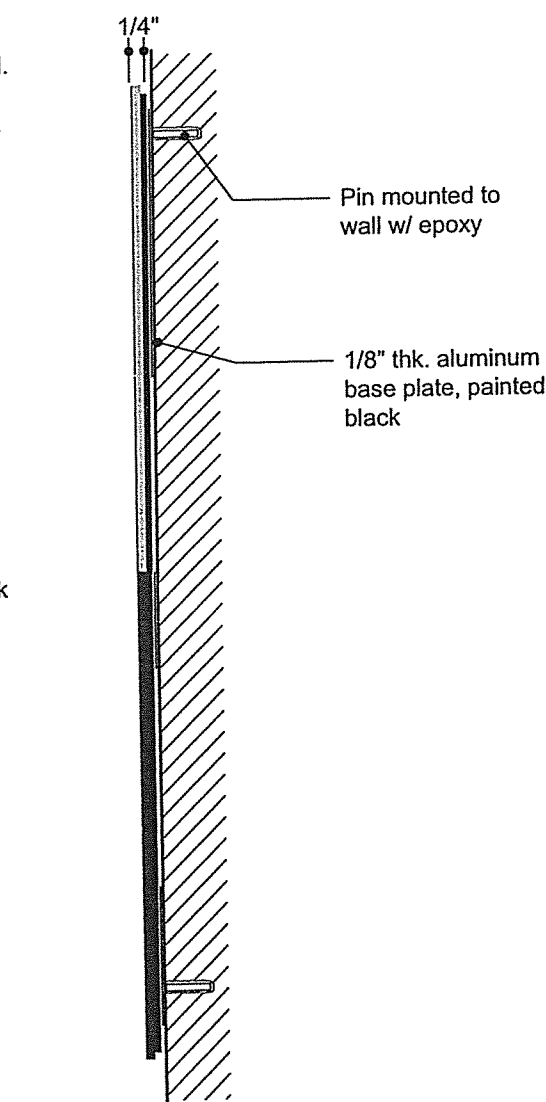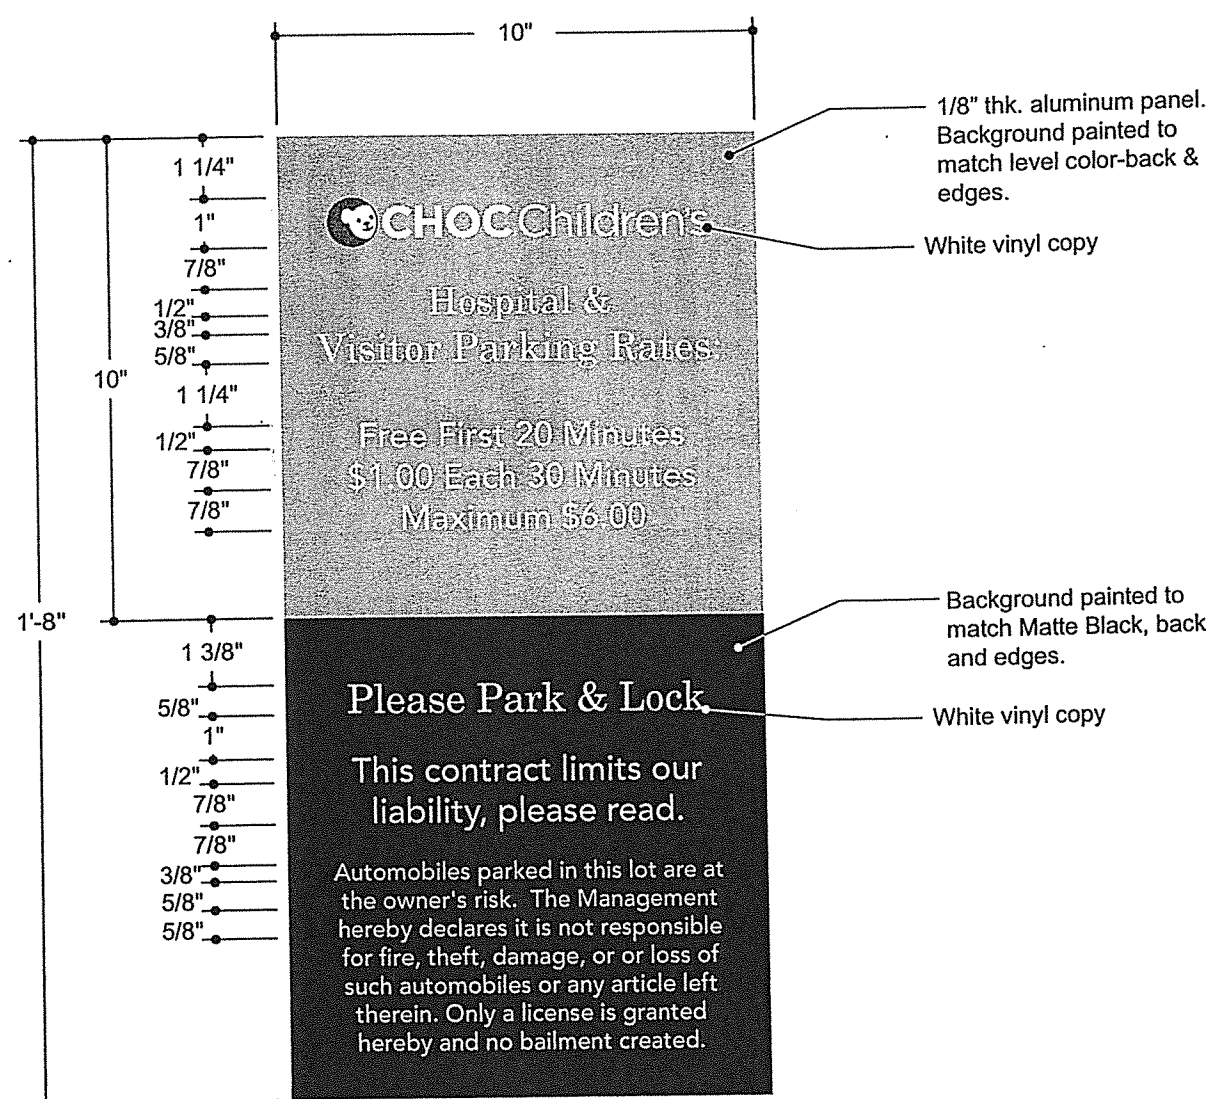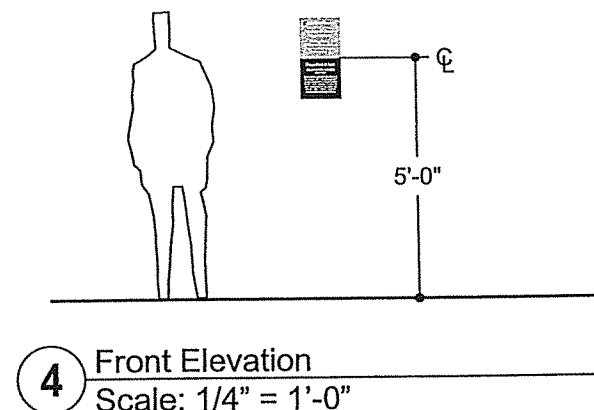

Children's Hospital of Orange County
Tower 2 Garage Graphics
Project: 12407001

Message Schedule

ASI #253: 4 September 2012

Sign Type/ Loc.	Description	Message	Comments	Level	Sheet
GIP 01	Garage Information Plaque	(CHOC CHILDREN'S LOGO) Hospital & Clinics Visitor Parking Parking Rates: Free First 20 Minute \$1.00 Each 30 Minutes Maximum \$6.00 Please Park & Lock This contract limits our liability, please read. Automobiles parked in this lot are at the owner's risk. The Management hereby declares it is not responsible for fire, theft, damage, or or loss of such automobiles or any article left therein. Only a license is granted hereby and no bailment created.	Mounting Location To Be Determined Owner To Verify Parking Rates & Message	G	AGC22.0
GIP 02	Garage Information Plaque	(CHOC CHILDREN'S LOGO) Hospital & Clinics Visitor Parking Parking Rates: Free First 20 Minute \$1.00 Each 30 Minutes Maximum \$6.00 Please Park & Lock This contract limits our liability, please read. Automobiles parked in this lot are at the owner's risk. The Management hereby declares it is not responsible for fire, theft, damage, or or loss of such automobiles or any article left therein. Only a license is granted hereby and no bailment created.	Mounts Guard Shack Owner To Verify Parking Rates & Message	1	AGC22.0

Invoice Number: 48765

Fabrication Drawing

Project
CHILDREN'S HOSPITAL OF
ORANGE COUNTY

Customer
McCARTHY BUILDING CO.
ATT: JAMES BURGGRAF
20401 S.W. BIRCH ST.
NEWPORT BEACH, CA 92660


Designers
FORMATION

Order Item: 40

Sign Type: GIP

Revision No.:


Drawn By: MWilliams / APalmer

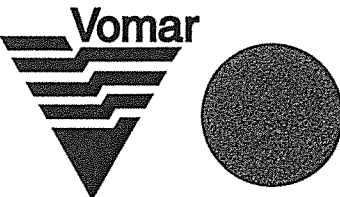


Vomar Products, Inc.
7800 Deering Avenue
Canoga Park, CA 91304-5005
Tel: 818-610-5115
Fax: 818-610-5123
E-Mail: info@vomarproducts.com

Sheet Date: 09/06/12


Sheet Number 40.0

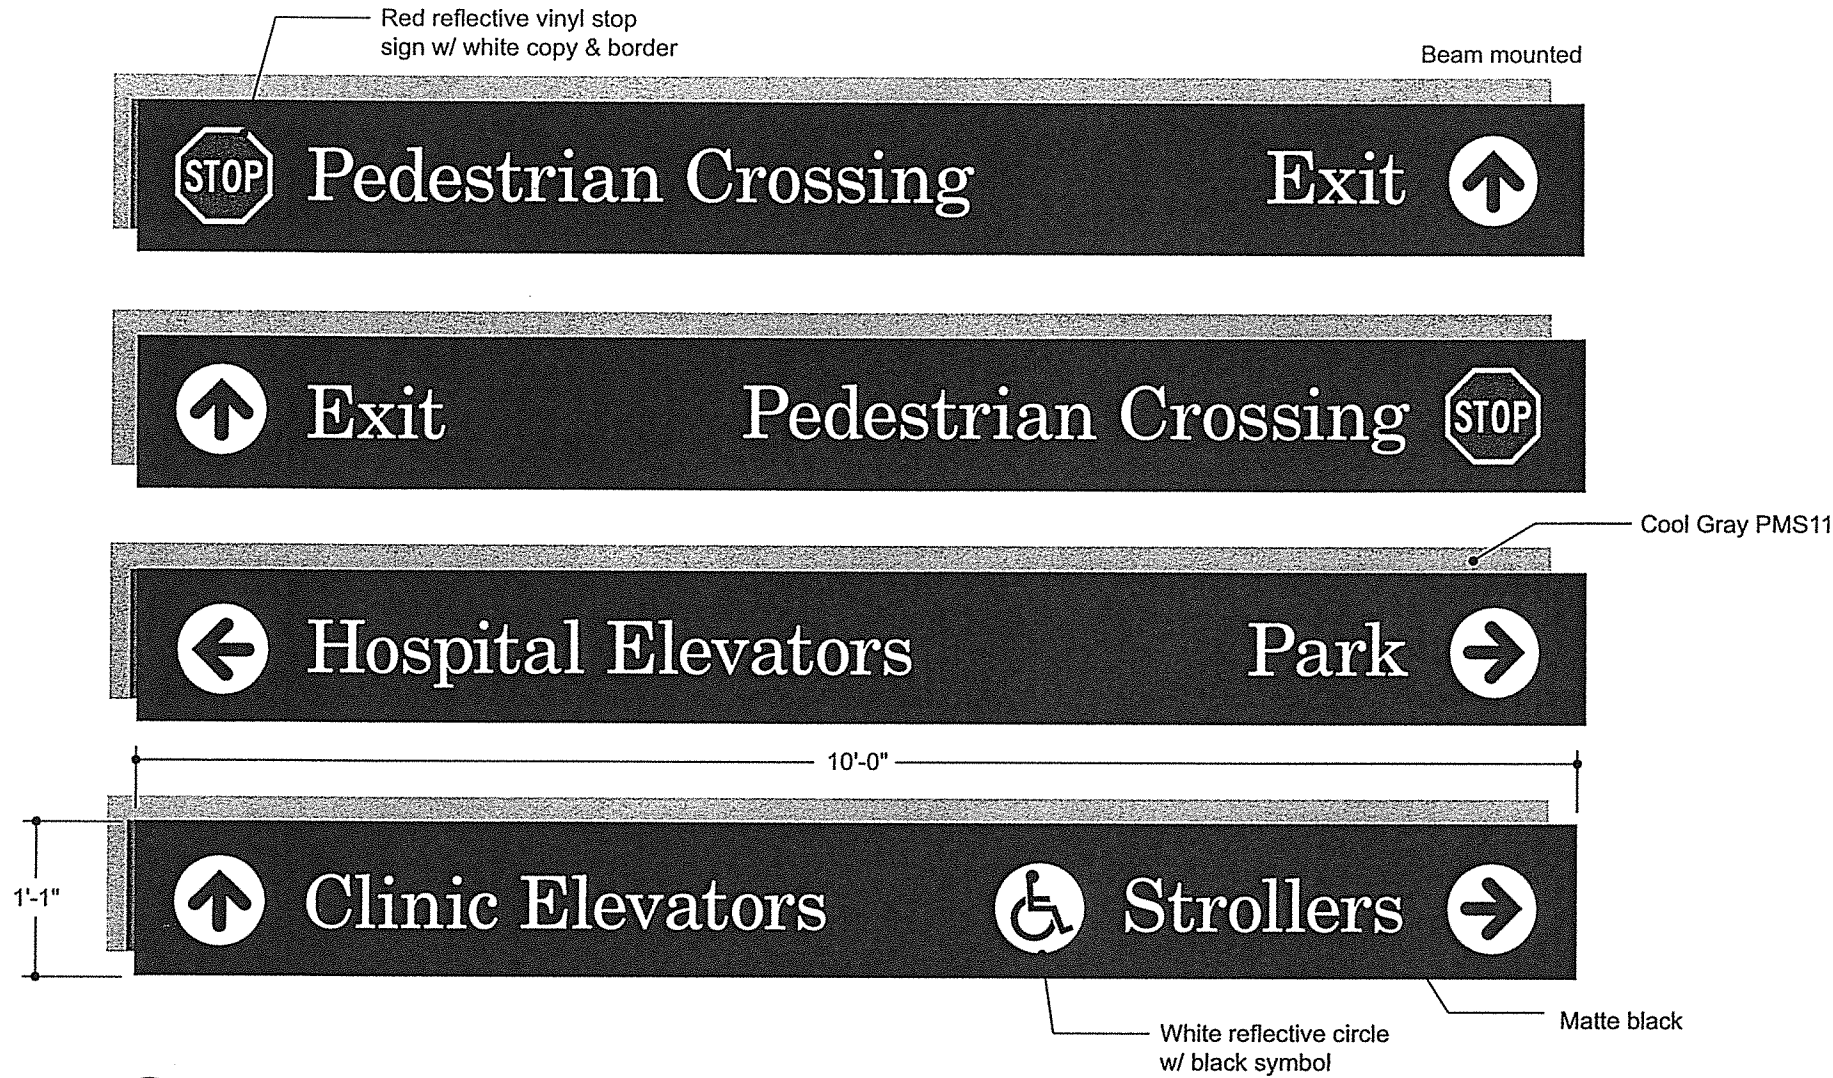

1 Copy Layout
Scale: 3/4" = 1'-0"

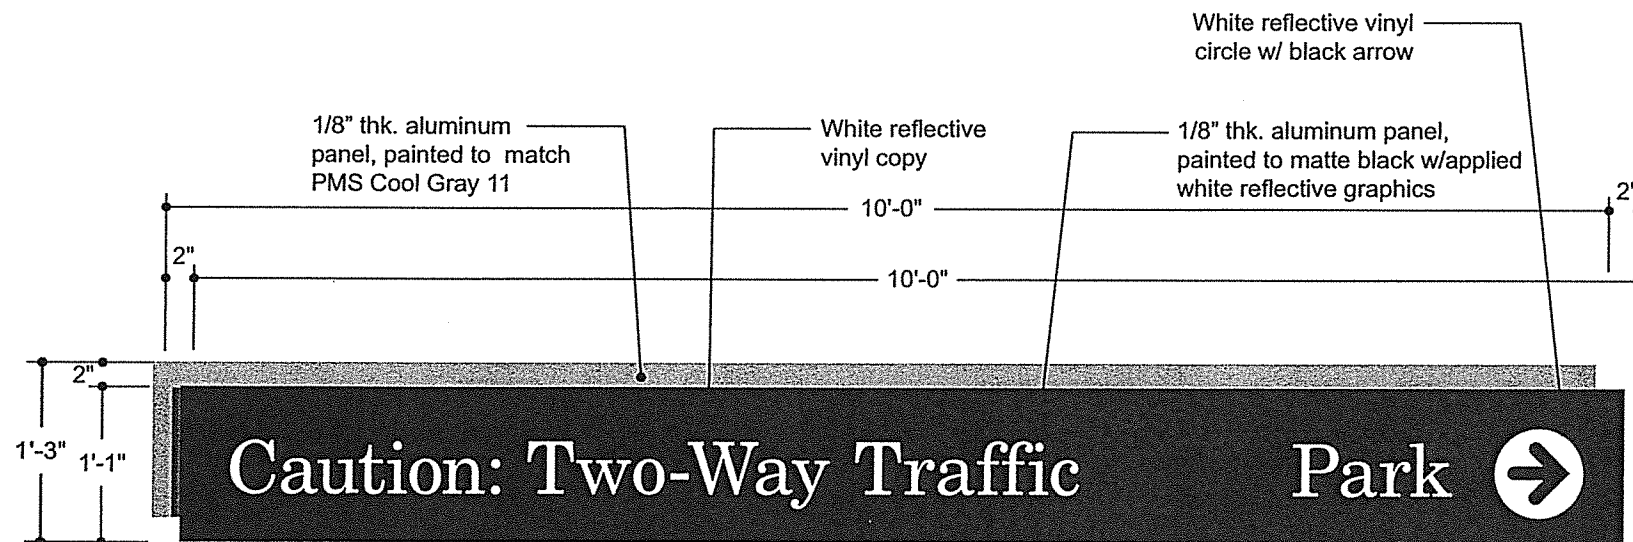

1 Front View
Scale: 3/4" = 1'-0"

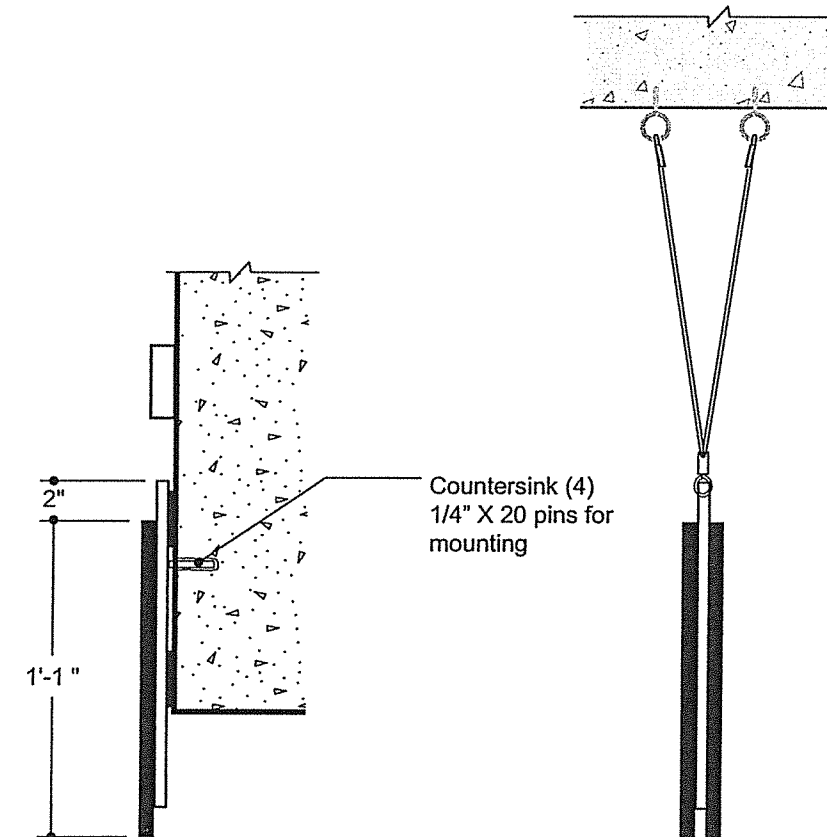

2 Side View-wall mtd typ @ped xing
Scale: 1 1/2" = 1'-0"

3 Side View-typ overhd dtl
Scale: 1 1/2" = 1'-0"

ITEM NO. 41
SIGN TYPE OD

QTY: 40
(16 EA.) SURFACE BEAM MOUNTED
(24 EA.) CEILING MOUNT

SIGN MATERIALS:
1'-1" H X 10'-0" W X 1/8" THK. PAINTED ALUMINUM W/ 1/8" THK. ALUMINUM BACKING.

MOUNTING:
SURFACE BEAM MOUNTED OF DOUBLE SIDED CEILING CABLE HUNG

COLOR/FINISH:
REFER ELEVATIONS

FONT:
NEW CENTURY SCHOOLBOOK ROMAN

Invoice Number: 48765

Fabrication Drawing

Project
CHILDREN'S HOSPITAL OF ORANGE COUNTY

Customer
McCARTHY BUILDING CO.
ATT: JAMES BURGGRAF
20401 S.W. BIRCH ST.
NEWPORT BEACH, CA 92660


Designers
FORMATION

Order Item: 41

Sign Type: OD

Revision No.:

Drawn By: MWilliams / APalmer

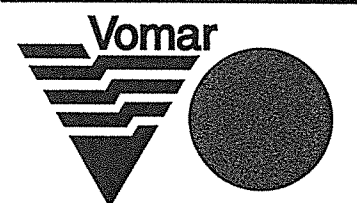

Vomar Products, Inc.
7800 Deering Avenue
Canoga Park, CA 91304-5005
Tel: 818-610-5115
Fax: 818-610-5123
E-Mail: info@vomarproducts.com

Sheet Date: 09/06/12

Sheet Number 41.0

Fabrication
Drawing

Project
CHILDREN'S HOSPITAL OF
ORANGE COUNTY

Customer
McCARTHY BUILDING CO.
ATT: JAMES BURGGRAB
20401 S.W. BIRCH ST.
NEWPORT BEACH, CA 92660


Designers
FORMATION

Order Item: 41

Sign Type: OD

Revision No.:


Drawn By: MWilliams / APalmer

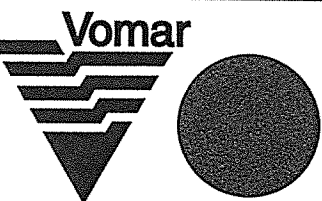

Vomar Products, Inc.
7800 Deering Avenue
Canoga Park, CA 91304-5005
Tel: 818-610-5115
Fax: 818-610-5123
E-Mail: info@vomarproducts.com

Sheet Date: 09/06/12

Sheet Number 41.1

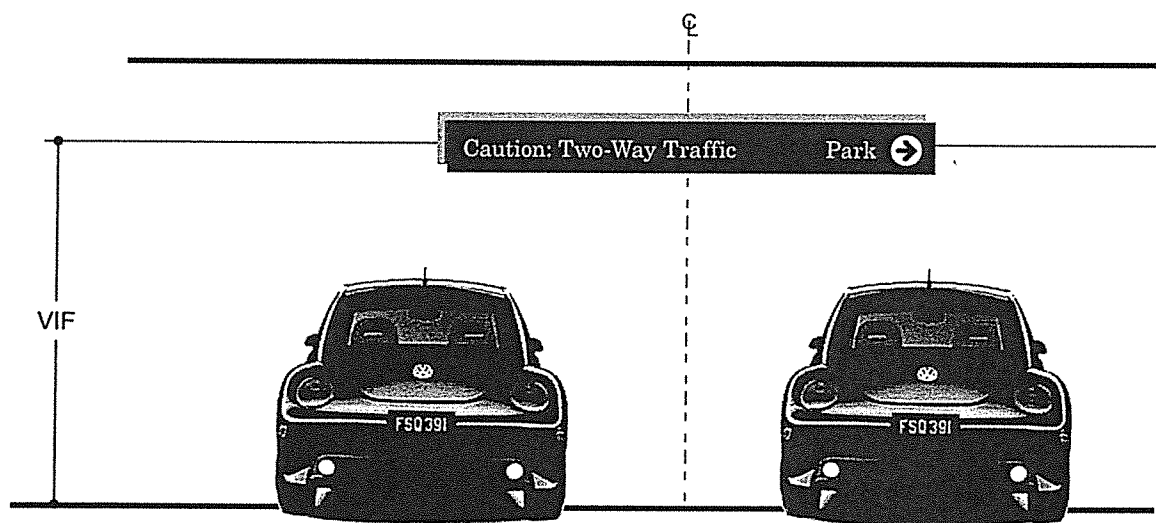

1 Front Elevation
Scale: NTS

Sign Type	Location	Description	Level	Area	Sign Copy	Comments	Level	Sheet No.	Vomar Item #
OD	01	OVRHD DIR	1	GARAGE	SIDE A; Self & [HC] Parking ↑ Side B: Exit ↑ Exit →	message rev new schedule 08 28 12	1	AGC.22.0	41
OD	02	OVRHD DIR	1	GARAGE	SIDE A; Pedestrian Crossing [Stop symbol] Park ↑	9/11/20129/1	1	AGC.22.0	41
OD	03	OVRHD DIR	1	GARAGE	SIDE A; ← Clinic Elevators Pedestrian Crossing [Stop symbol]	Beam Mtd	1	AGC.22.0	41
OD	04	OVRHD DIR	1	GARAGE	SIDE A; ← Clinic Elevators Pedestrian Crossing [Stop symbol]	Beam Mtd	1	AGC.22.0	41
OD	05	OVRHD DIR	1	GARAGE	SIDE A; Pedestrian Crossing [Stop symbol] Exit ↑	Beam Mtd	1	AGC.22.0	41
OD	06	OVRHD DIR	1	GARAGE	Side A: Hospital Elevators → Side B: ↑ Clinic Elevators [HC] Strollers →		1	AGC.22.0	41
OD	07	OVRHD DIR	1	GARAGE	Side A: ← Strollers [HC] Hospital Elevators ↑ Side B: ↑ Clinic Elevators [HC] Strollers →		1	AGC.22.0	41
OD	08	OVRHD DIR	1	GARAGE	Side A: Hospital Elevators → Side B: ← Hospital Elevators Clinic Elevators ↑	rev per new sch 082912	1	AGC.22.0	41

Invoice Number: 48765

Fabrication Drawing

Project
CHILDREN'S HOSPITAL OF ORANGE COUNTY

Customer
McCARTHY BUILDING CO.
ATT: JAMES BURGGRAF
20401 S.W. BIRCH ST.
NEWPORT BEACH, CA 92660


Designers
FORMATION

Order Item: 41

Sign Type:

Revision No.:


Drawn By: APalmer

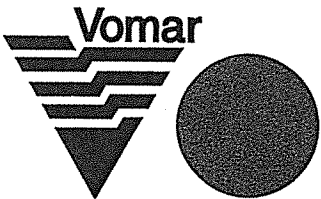

Vomar Products, Inc.
7800 Deering Avenue
Canoga Park, CA 91304-5005
Tel: 818-610-5115
Fax: 818-610-5123
E-Mail: info@vomarproducts.com

Sheet Date: 09/11/12

Sheet Number 41.2

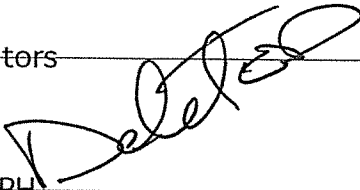Sign Type	Location	Description	Level	Area	Sign Copy	Comments	Level	Sheet No.	Vomar Item #
OD	09	OVRHD DIR	1	GARAGE	SIDE A; ← Hospital Elevators  → Park ↑ Side B: Speed Limit 8 MPH → Exit ↑	deleted in new 08 28 12 schedule	1	AGC.22.0	41
OD	10	OVRHD DIR	1	GARAGE	SIDE A; One Way: Do Not Enter Side B: ← Exit Exit ↑ Park →	ADDED per new sch 082912	1	AGC.22.0	41
OD	11	OVRHD DIR	1	GARAGE	SIDE A; Exit Only: Do Not Enter Side B: ↑Exit: Credit Card & Card Access Only	ADDED per new sch 082912	1	AGC.22.0	41
OD	01	OVRHD DIR	2	GARAGE	SIDE A; Caution: Two-Way Traffic Park → Side B: Speed Limit 8 MPH Exit ↑		2	AGC.23.0	41
OD	02	OVRHD DIR	2	GARAGE	SIDE A; Pedestrian Crossing Park ↑ [Stop symbol]		2	AGC.23.0	41
OD	03	OVRHD DIR	2	GARAGE	SIDE A; Pedestrian Crossing Clinic Elevators → [Stop symbol]		2	AGC.23.0	41
OD	04	OVRHD DIR	2	GARAGE	SIDE A; ← Clinic Elevators Pedestrian Crossing [Stop symbol]	Beam Mtd	2	AGC.23.0	41
OD	05	OVRHD DIR	2	GARAGE	SIDE A; Pedestrian Crossing Exit ↑ [Stop symbol]	Beam Mtd	2	AGC.23.0	41

Invoice Number: 48765

Fabrication Drawing

Project
CHILDREN'S HOSPITAL OF ORANGE COUNTY

Customer
McCARTHY BUILDING CO.
ATT: JAMES BURGGRAF
20401 S.W. BIRCH ST.
NEWPORT BEACH, CA 92660


Designers
FORMATION

Order Item: 41

Sign Type:

Revision No.:

Drawn By: APalmer

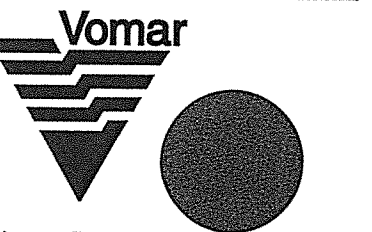

Vomar Products, Inc.
7800 Deering Avenue
Canoga Park, CA 91304-5005
Tel: 818-610-5115
Fax: 818-610-5123
E-Mail: info@vomarproducts.com

Sheet Date: 09/11/12

Sheet Number 41.3

Sign Type	Location	Description	Level	Area	Sign Copy	Comments	Level	Sheet No.	Vomar Item #
OD	06	OVRHD DIR	2	GARAGE	Side A: Hospital Elevators → Side B: ↑ Clinic Elevators		2	AGC.23.0	41
OD	07	OVRHD DIR	2	GARAGE	Side A: Hospital Elevators ↑ Side B: ↑ Clinic Elevators		2	AGC.23.0	41
OD	08	OVRHD DIR	2	GARAGE	Side A: Hospital Elevators → Side B: ← Hospital Elevators Clinic Elevators ↑	CHANGED as per ASI #253: 4 September 2012	2	AGC.23.0	41
OD	09	OVRHD DIR	2	GARAGE	SIDE A; ↖ Hospital Elevators Park ↑ Side B: Speed Limit 8 MPH Exit ↑		2	AGC.23.0	41
OD	10	OVRHD DIR	2	GARAGE	SIDE A; Speed Limit 8 MPH Park ↑ Side B: ↖ Clinic Elevators Exit ↑		2	AGC.23.0	41
OD	01	OVRHD DIR	3	GARAGE	SIDE A; Caution: Two-Way Traffic Park → Side B: Speed Limit 8 MPH Exit ↑		3	AGC.24.0	41
OD	02	OVRHD DIR	3	GARAGE	SIDE A; Pedestrian Crossing [Stop symbol] Park ↑		3	AGC.24.0	41
OD	03	OVRHD DIR	3	GARAGE	SIDE A; Pedestrian Crossing [Stop symbol] Clinic Elevators →	Beam Mtd	3	AGC.24.0	41

Invoice Number: 48765

Fabrication Drawing

Project
CHILDREN'S HOSPITAL OF
ORANGE COUNTY

Customer
McCARTHY BUILDING CO.
ATT: JAMES BURGGRAF
20401 S.W. BIRCH ST.
NEWPORT BEACH, CA 92660


Designers
FORMATION

Order Item: 41

Sign Type:

Revision No.:

Drawn By: APalmer

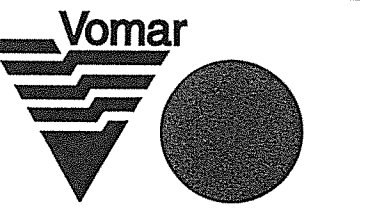

Vomar Products, Inc.
7800 Deering Avenue
Canoga Park, CA 91304-5005
Tel: 818-610-5115
Fax: 818-610-5123
E-Mail: info@vomarproducts.com

Sheet Date: 09/11/12

Sheet Number 41.4

Sign Type	Location	Description	Level	Area	Sign Copy	Comments	Level	Sheet No.	Vomar Item #
OD	04	OVRHD DIR	3	GARAGE	SIDE A; ← Clinic Elevators Pedestrian Crossing [Stop symbol]	Beam Mtd	3	AGC.24.0	41
OD	05	OVRHD DIR	3	GARAGE	SIDE A; Pedestrian Crossing [Stop symbol] Exit ↑	Beam Mtd	3	AGC.24.0	41
OD	06	OVRHD DIR	3	GARAGE	Side A: Hospital Elevators → Side B: ↑ Clinic Elevators		3	AGC.24.0	41
OD	07	OVRHD DIR	3	GARAGE	Side A: Hospital Elevators ↑ Side B: ↑ Clinic Elevators		3	AGC.24.0	41
OD	08	OVRHD DIR	3	GARAGE	Side A: Hospital Elevators → Side B: ← Hospital Elevators Clinic Elevators ↑	CHANGED as per ASI #253: 4 September 2012	3	AGC.24.0	41
OD	09	OVRHD DIR	3	GARAGE	SIDE A; ↖ Hospital Elevators Park ↑ Side B: Speed Limit 8 MPH Exit ↑		3	AGC.24.0	41
OD	10	OVRHD DIR	3	GARAGE	SIDE A; Speed Limit 8 MPH Park ↑ Side B: ↖ Clinic Elevators Exit ↑		3	AGC.24.0	41
OD	01	OVRHD DIR	4	GARAGE	SIDE A; Caution: Two-Way Traffic Park → Side B: Speed Limit 8 MPH Exit ↑		4	AGC.25.0	41

Invoice Number: 48765

Fabrication
Drawing

Project
CHILDREN'S HOSPITAL OF
ORANGE COUNTY

Customer
McCARTHY BUILDING CO.
ATT: JAMES BURGGRAF
20401 S.W. BIRCH ST.
NEWPORT BEACH, CA 92660


Designers
FORMATION

Order Item: 41

Sign Type:

Revision No.:

Drawn By: APalmer

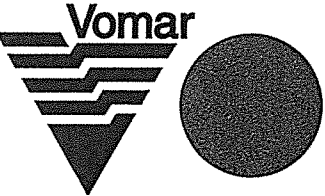

Vomar Products, Inc.
7800 Deering Avenue
Canoga Park, CA 91304-5005
Tel: 818-610-5115
Fax: 818-610-5123
E-Mail: info@vomarproducts.com

Sheet Date: 09/11/12

Sheet Number 41.5

Sign Type	Location	Description	Level	Area	Sign Copy	Comments	Level	Sheet No.	Vomar Item #
OD	02	OVRHD DIR	4	GARAGE	SIDE A; Pedestrian Crossing [Stop symbol] Park ↑	Beam Mtd	4	AGC.25.0	41
OD	03	OVRHD DIR	4	GARAGE	SIDE A; Pedestrian Crossing [Stop symbol] Clinic Elevators →		4	AGC.25.0	41
OD	04	OVRHD DIR	4	GARAGE	SIDE A; ← Clinic Elevators Pedestrian Crossing [Stop symbol]		4	AGC.25.0	41
OD	05	OVRHD DIR	4	GARAGE	SIDE A; Pedestrian Crossing [Stop symbol] Exit ↑		4	AGC.25.0	41
OD	06	OVRHD DIR	4	GARAGE	Side A: Hospital Elevators → Side B: ↑ Clinic Elevators		4	AGC.25.0	41
OD	07	OVRHD DIR	4	GARAGE	Side A: Hospital Elevators ↑ Side B: ↑ Clinic Elevators		4	AGC.25.0	41
OD	08	OVRHD DIR	4	GARAGE	Side A: Hospital Elevators → Side B: ← Hospital Elevators Clinic Elevators ↑	CHANGED as per ASI #253: 4 September 2012	4	AGC.25.0	41
OD	09	OVRHD DIR	4	GARAGE	SIDE A; ↖ Hospital Elevators Side B: Speed Limit 8 MPH Exit ↑		4	AGC.25.0	41
OD	10	OVRHD DIR	4	GARAGE	SIDE A; Speed Limit 8 MPH Park ↑ Side B: ↖ Clinic Elevators Exit ↑		4	AGC.25.0	41

Invoice Number: 48765

Fabrication
Drawing

Project
CHILDREN'S HOSPITAL OF
ORANGE COUNTY

Customer
McCARTHY BUILDING CO.
ATT: JAMES BURGGRAF
20401 S.W. BIRCH ST.
NEWPORT BEACH, CA 92660

Designers
FORMATION

Order Item: 41

Sign Type:

Revision No.:


Drawn By: APalmer




Vomar Products, Inc.
7800 Deering Avenue
Canoga Park, CA 91304-5005
Tel: 818-610-5115
Fax: 818-610-5123
E-Mail: info@vomarproducts.com

Sheet Date: 09/11/12

Sheet Number 41.6

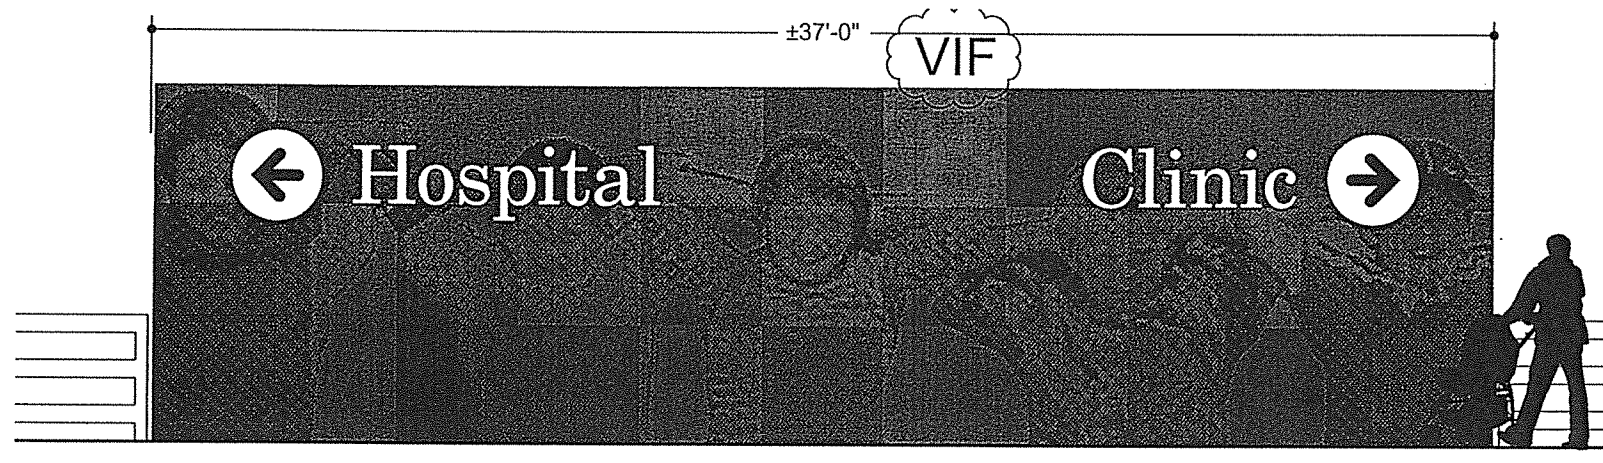

3 Interior South Wall - Level 5
Scale: 3/16" = 1'-0"

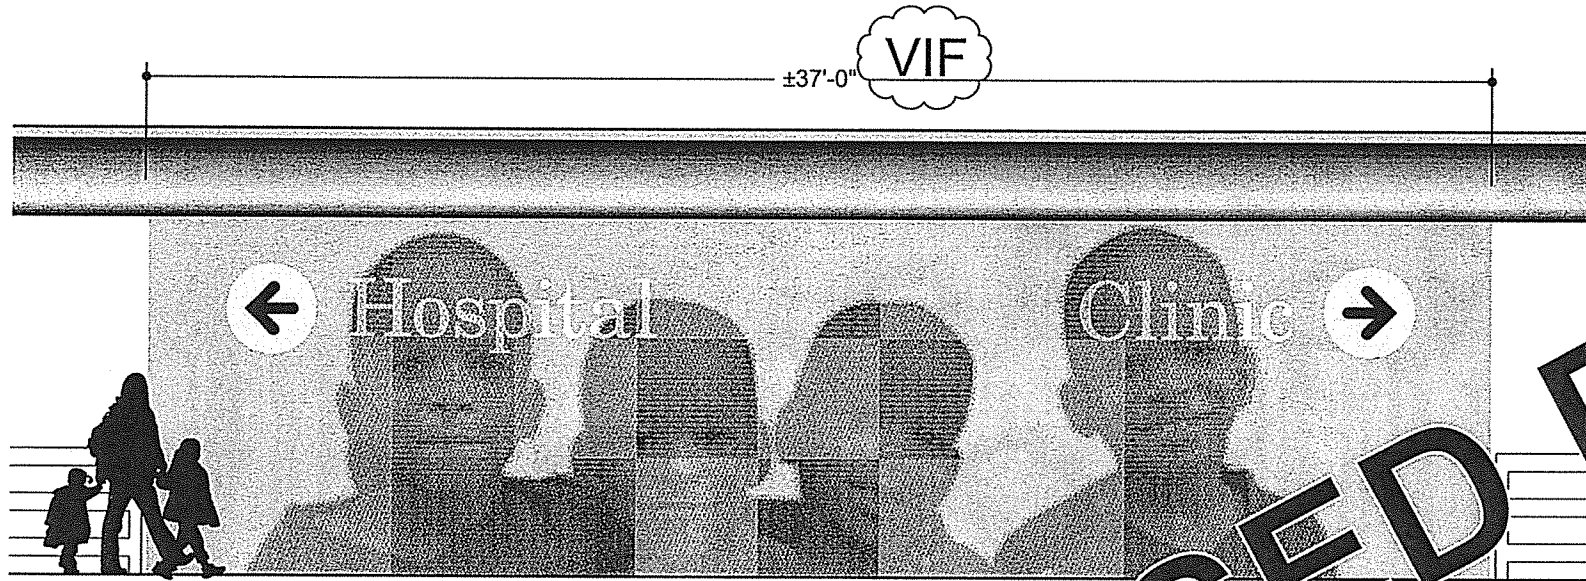

2 Interior South Wall - Level 4
Scale: 3/16" = 1'-0"



1 Interior South Wall - Level 1
Scale: 3/16" = 1'-0"

ITEM NO. 42
SIGN TYPE WG

QTY: 66

SIGN MATERIALS:
±10'-0" H X VARIOUS WIDTHS, FOUR
COLOR VINYL DIGITAL PRINTING
APPLIED TO WALL SURFACE. FINAL
ARTWORK TO BE PROVIDED BY
GRAPHIC DESIGNER

MOUNTING:
APPLIED VINYL GRAPHICS

FINISH:
REFLECTIONS

FONT:
N/A

Invoice Number: 48765

Fabrication Drawing

Project
CHILDREN'S HOSPITAL OF
ORANGE COUNTY

Customer
McCARTHY BUILDING CO.
ATT: JAMES BURGGRAF
20401 S.W. BIRCH ST.
NEWPORT BEACH, CA 92660

Designers
FORMATION


Order Item: 42

Sign Type: WG

Revision No.:

— ALL GRAPHIC FILES
HAVE BEEN PROVIDED

Drawn By: MWilliams

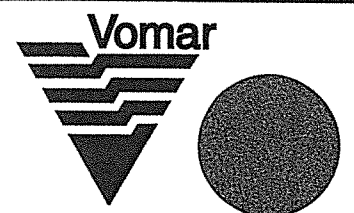

Vomar Products, Inc.
7800 Deering Avenue
Canoga Park, CA 91304-5005
Tel: 818-610-5115
Fax: 818-610-5123
E-Mail: info@vomarproducts.com

Sheet Date: 05/20/10

Sheet Number 42.0

Fabrication Drawing

Project
CHILDREN'S HOSPITAL OF
ORANGE COUNTY

Customer
McCARTHY BUILDING CO.
ATT: JAMES BURGGRAF
20401 S.W. BIRCH ST.
NEWPORT BEACH, CA 92660

Designers
FORMATION


Order Item: 42

Sign Type: WG

Revision No.:

14 Per Returned Submittal
May 18, 2012


Drawn By: MWilliams

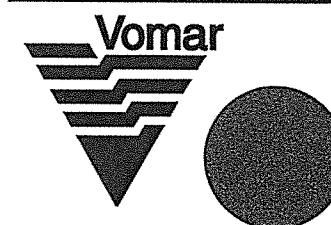


Vomar Products, Inc.
7800 Deering Avenue
Canoga Park, CA 91304-5005
Tel: 818-610-5115
Fax: 818-610-5123
E-Mail: info@vomarproducts.com

Sheet Date: 05/20/10


Sheet Number 42.1

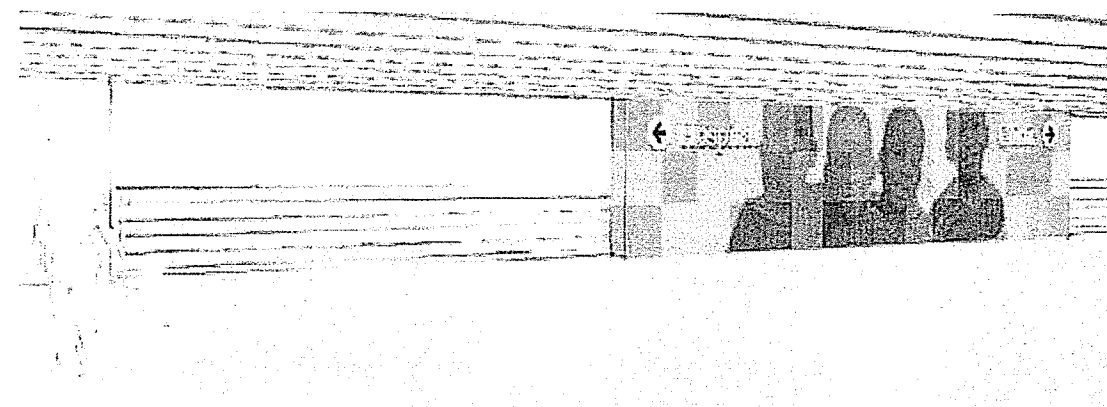



5 Level 4 South Wall Isometric View
Scale: NTS

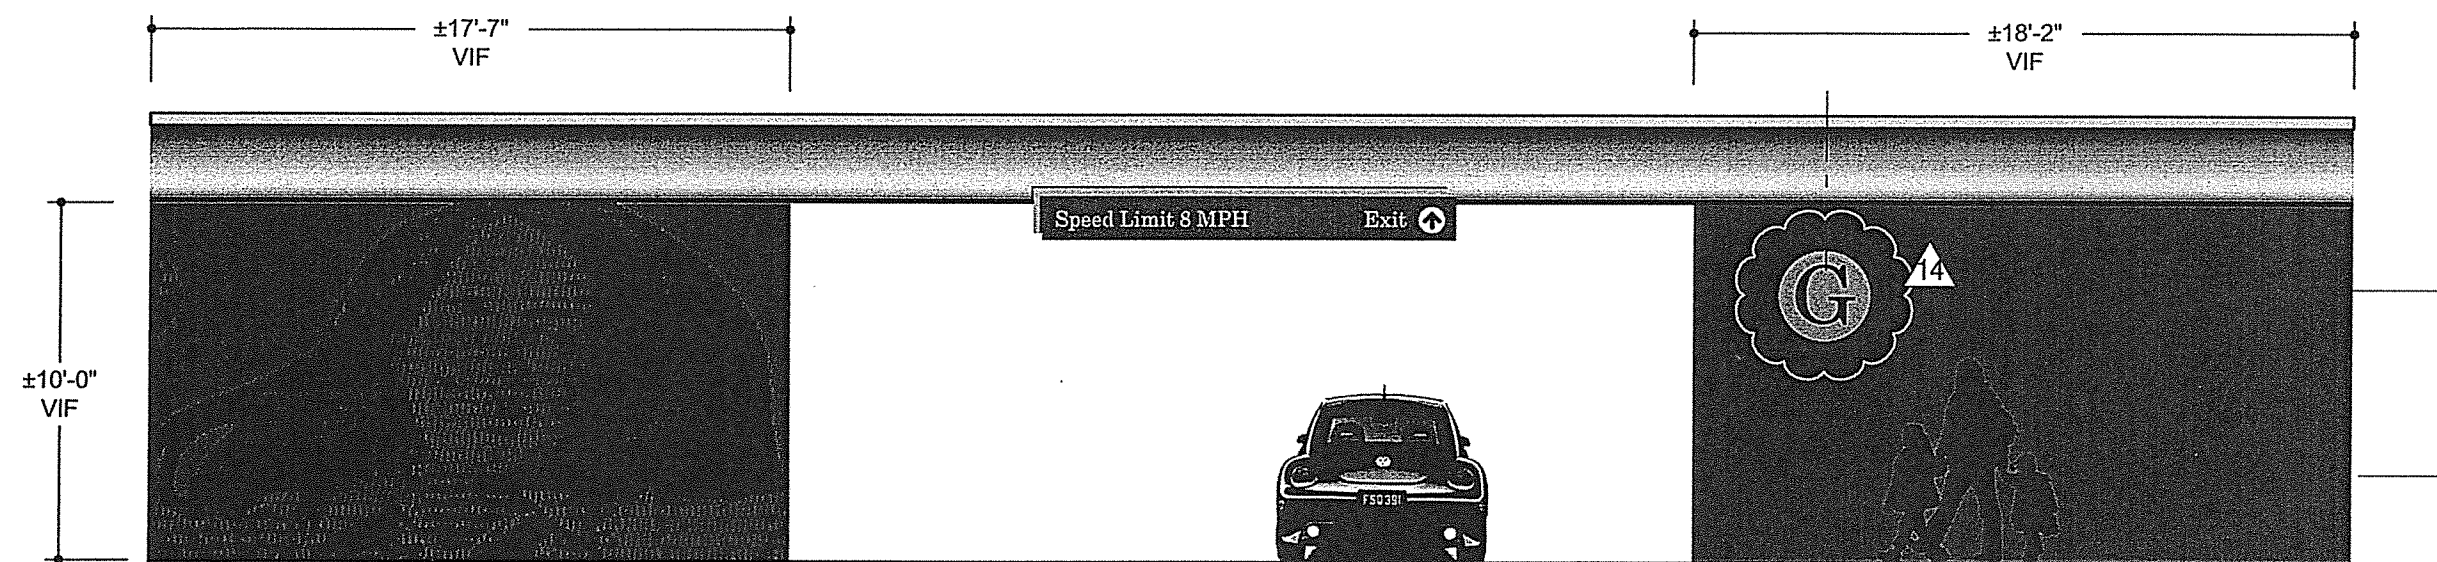

4 Typical Interior Wall - Level 1
Scale: 3/16" = 1'-0"

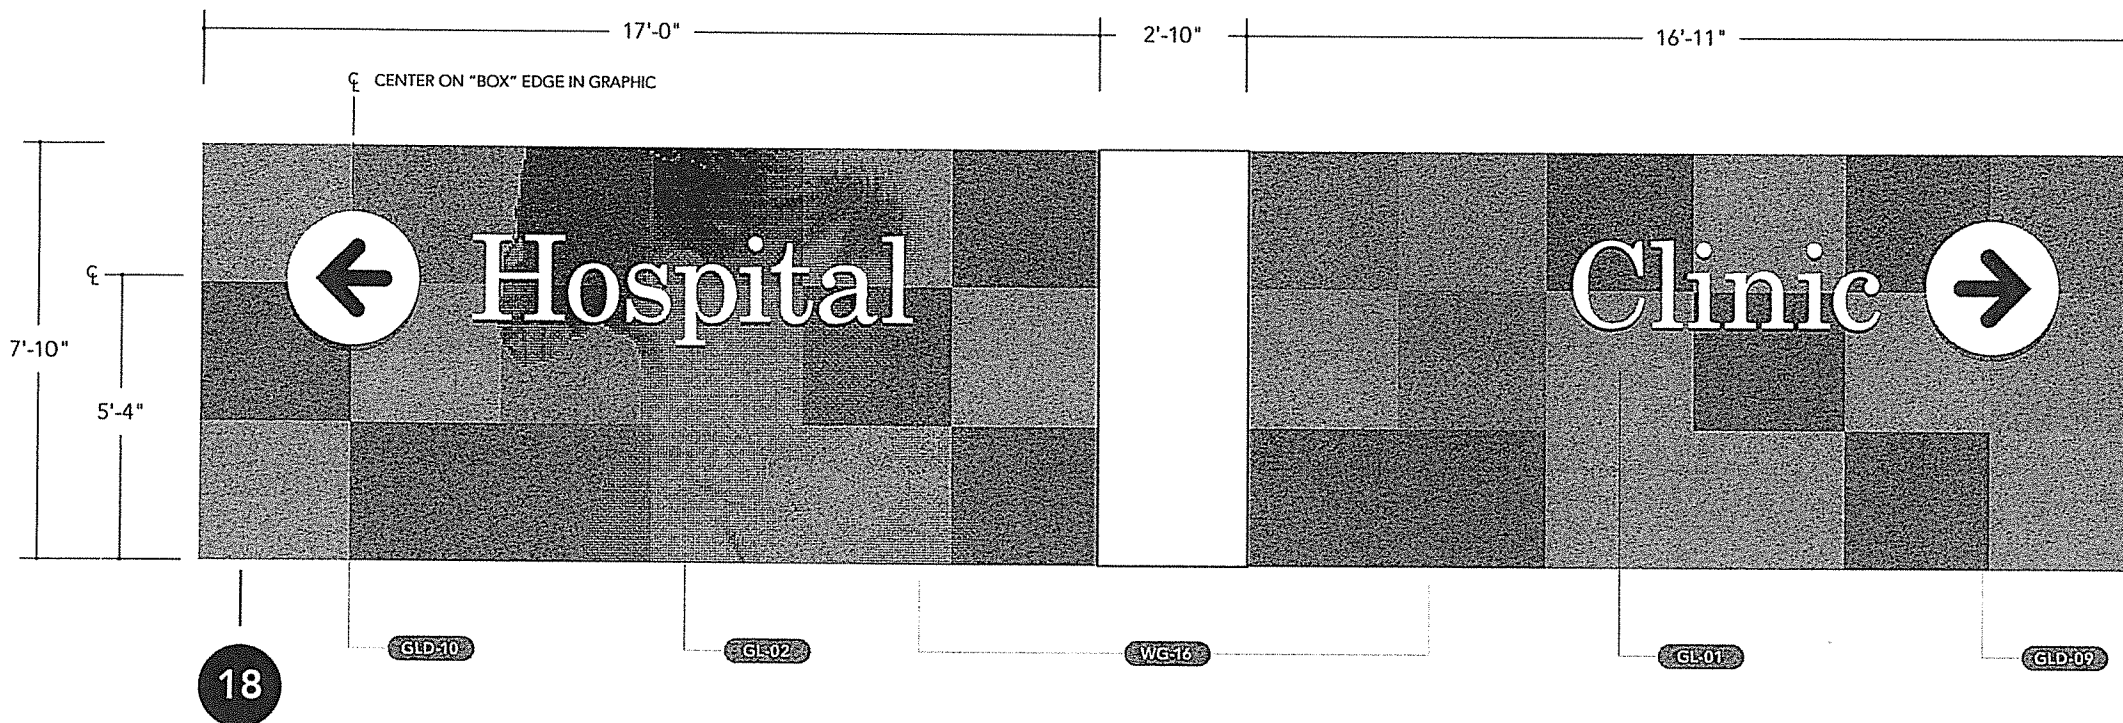

8 Location Elevation: Level 1 Interior South Wall
Scale: 3/8" = 1'-0"

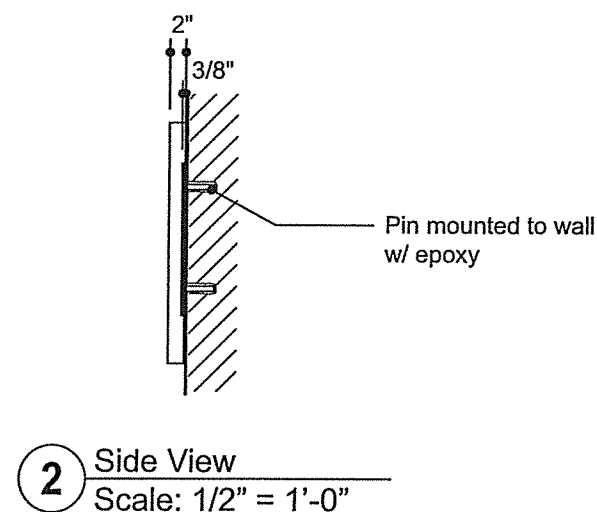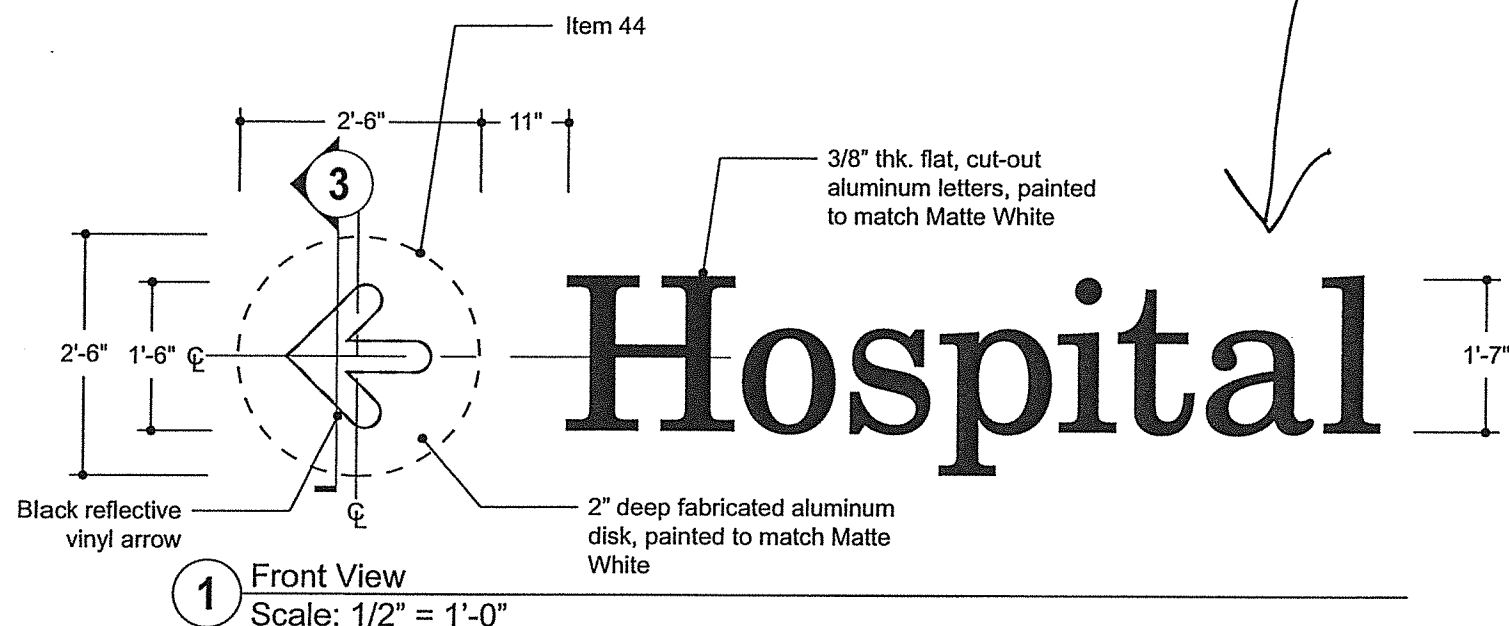

ITEM NO. 43
SIGN TYPE GL

QTY: 10

SIGN MATERIALS:
EACH LOCATION CONSISTS OF
19" H X 3/8" THK. PAINTED ALUMINUM
LETTERFORMS.

MOUNTING:
WALL SURFACE MOUNTED

COLOR/FINISH:
REFER ELEVATIONS

FONT:
NEW CENTURY SCHOOLBOOK
ROMAN

Invoice Number: 48765

Fabrication Drawing

Project
CHILDREN'S HOSPITAL OF
ORANGE COUNTY

Customer
McCARTHY BUILDING CO.
ATT: JAMES BURGGRAB
20401 S.W. BIRCH ST.
NEWPORT BEACH, CA 92660


Designers
FORMATION

Order Item: 43

Sign Type: GL

Revision No.:

Drawn By: APalmer

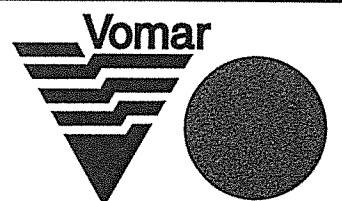

Vomar Products, Inc.
7800 Deering Avenue
Canoga Park, CA 91304-5005
Tel: 818-610-5115
Fax: 818-610-5123
E-Mail: info@vomarproducts.com

Sheet Date: 09/12/12

Sheet Number 43.0


Fabrication
Drawing

Project
CHILDREN'S HOSPITAL OF
ORANGE COUNTY


Customer
McCARTHY BUILDING CO.
ATT: JAMES BURGGRAB
20401 S.W. BIRCH ST.
NEWPORT BEACH, CA 92660

Designers
FORMATION

Order Item: 43
Sign Type: GL
Revision No.:

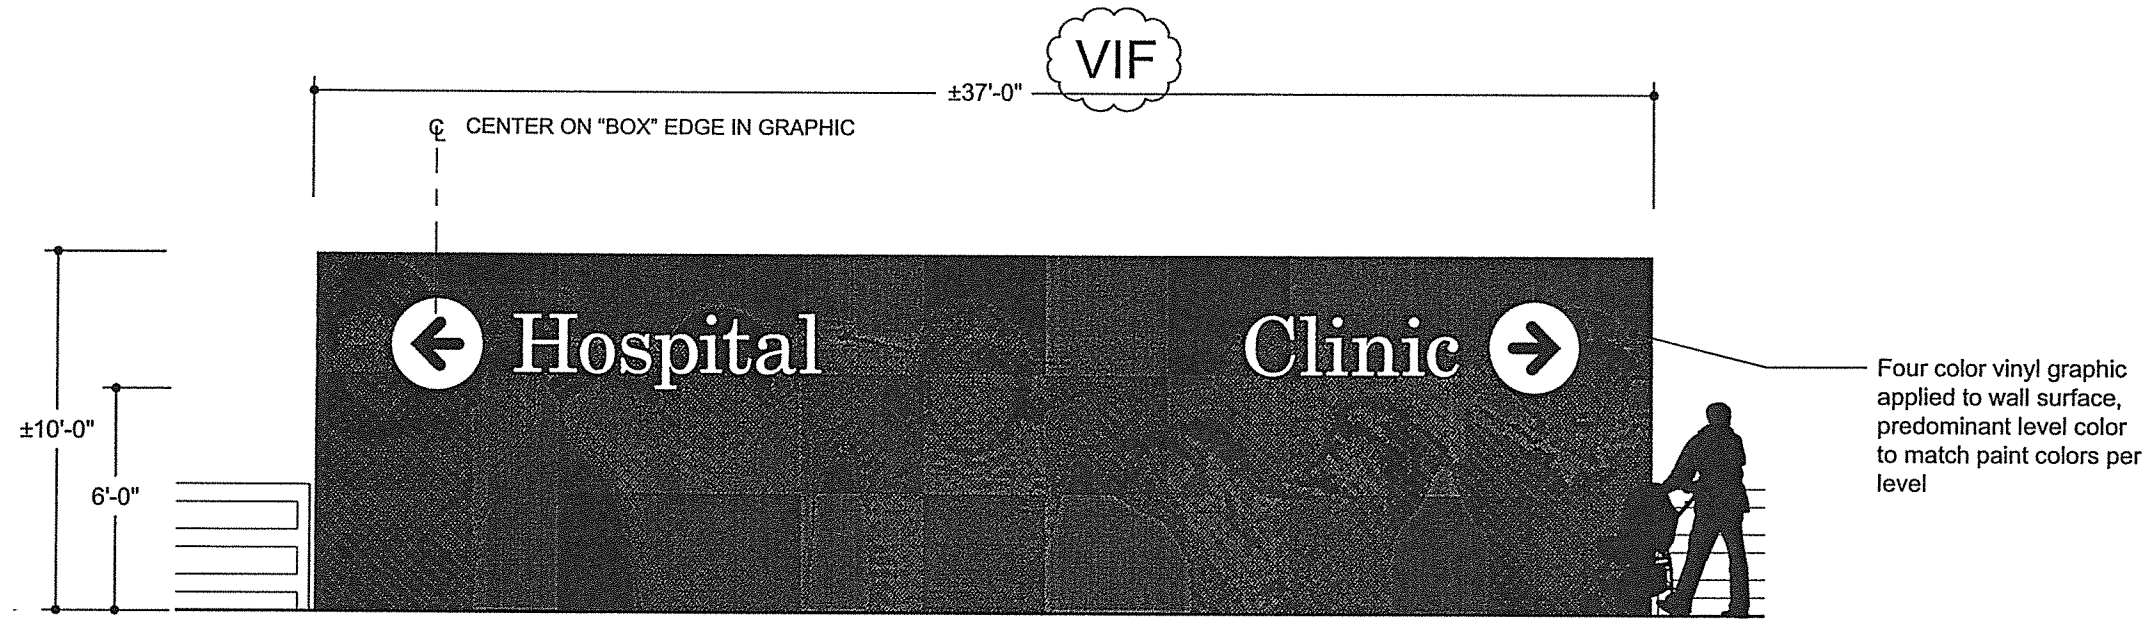


5 Location Elevation - Level 5 Interior South Wall
Scale: 3/16" = 1'-0"

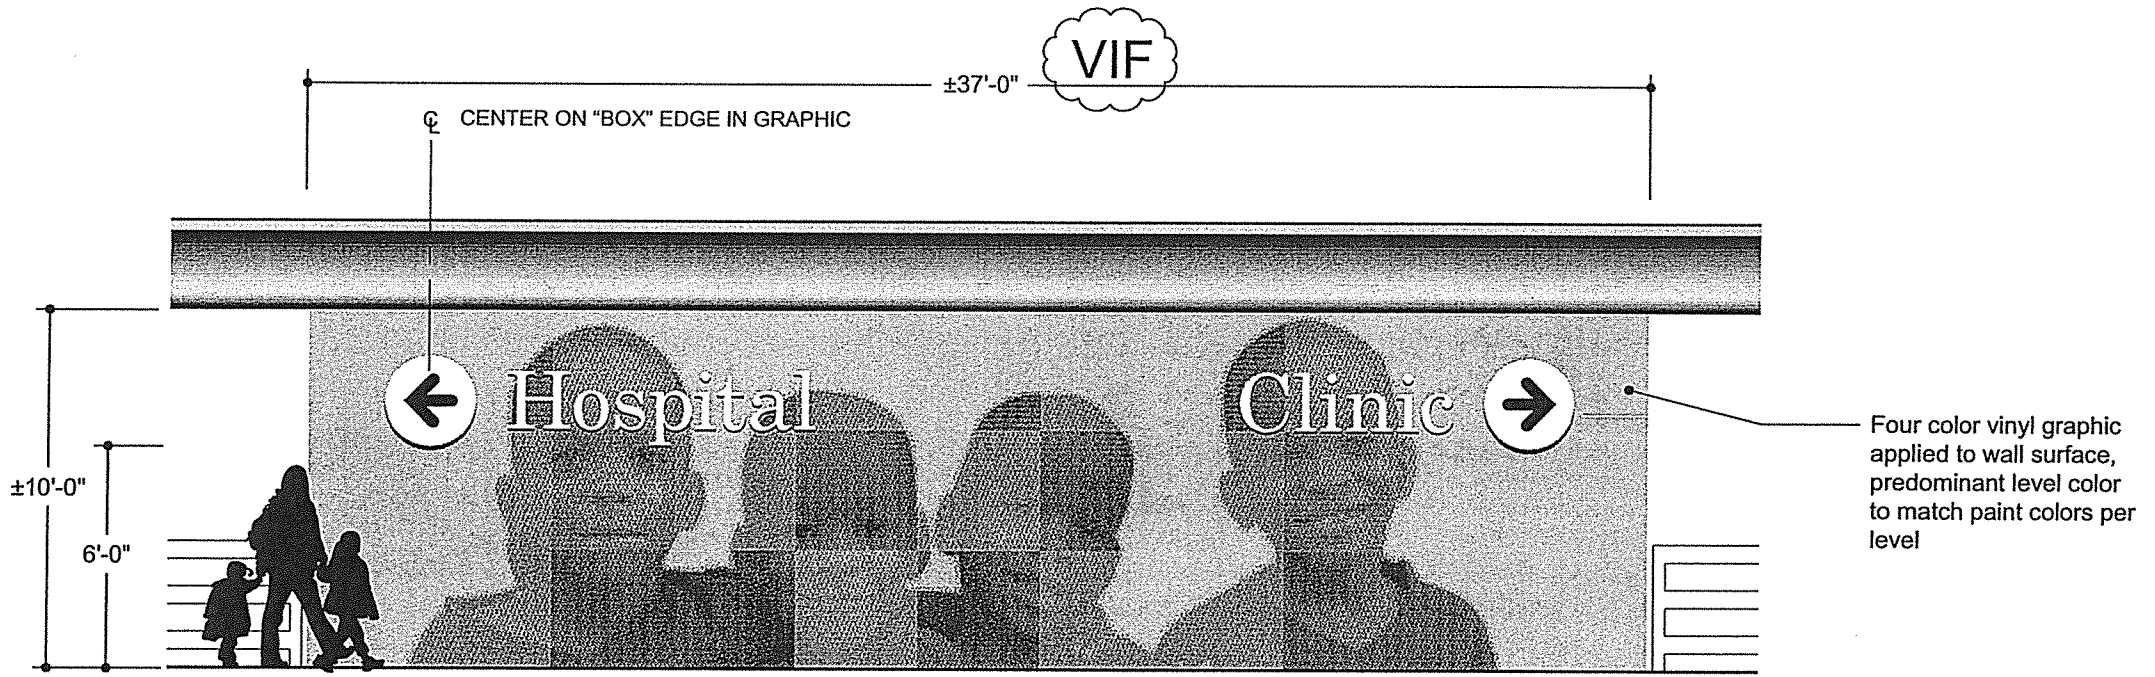

4 Location Elevation - Level 4 Interior South Wall
Scale: 3/16" = 1'-0"

Drawn By: APalmer

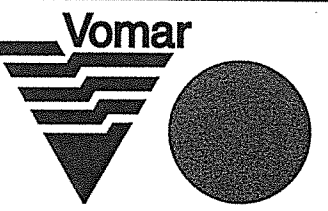

Vomar Products, Inc.
7800 Deering Avenue
Canoga Park, CA 91304-5005
Tel: 818-610-5115
Fax: 818-610-5123
E-Mail: info@vomarproducts.com

Sign Type	Location	Description	Level	Area	Sign Copy		Comments	Level	Sheet No.	Vomar Item #
GL	01	GARAGE LETTERS	1	GARAGE	Clinic		revised copy per 8 28 12 rev schedule	1	AGC.22.0	43
GL	01	GARAGE LETTERS	1	GARAGE	Hospital			1	AGC.22.0	43
GL	01	GARAGE LETTERS	2	GARAGE	Clinic			2	AGC.23.0	43
GL	01	GARAGE LETTERS	2	GARAGE	Hospital			2	AGC.23.0	43
GL	01	GARAGE LETTERS	3	GARAGE	Clinic			3	AGC.24.0	43
GL	01	GARAGE LETTERS	3	GARAGE	Hospital			3	AGC.24.0	43
GL	01	GARAGE LETTERS	4	GARAGE	Clinic			4	AGC.25.0	43
GL	01	GARAGE LETTERS	4	GARAGE	Hospital			4	AGC.25.0	43
GL	01	GARAGE LETTERS	5	GARAGE	Clinic			5	AGC.26.0	43
GL	01	GARAGE LETTERS	5	GARAGE	Hospital			5	AGC.26.0	43

Invoice Number: 48765

Fabrication Drawing

Project
CHILDREN'S HOSPITAL OF
ORANGE COUNTY

Customer
McCARTHY BUILDING CO.
ATT: JAMES BURGGRAF
20401 S.W. BIRCH ST.
NEWPORT BEACH, CA 92660


Designers
FORMATION

Order Item: 43

Sign Type: GL

Revision No.:


Drawn By: APalmer

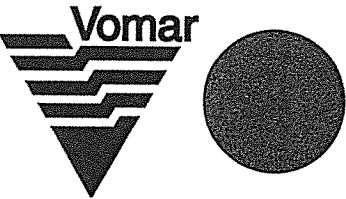


Vomar Products, Inc.
7800 Deering Avenue
Canoga Park, CA 91304-5005
Tel: 818-610-5115
Fax: 818-610-5123
E-Mail: info@vomarproducts.com

Sheet Date: 09/12/12


Sheet Number 43.2

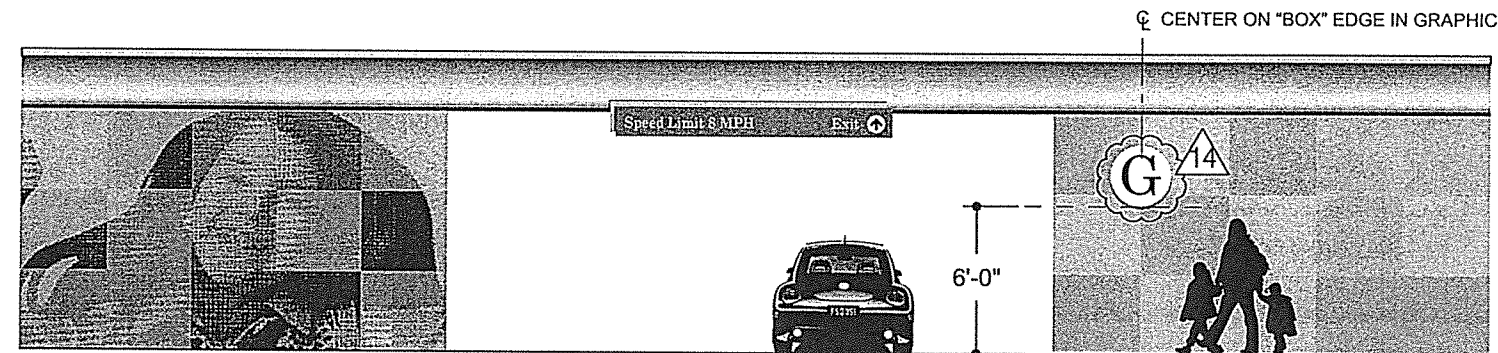


5 Front Elevation
Scale: 1/8" = 1'-0"

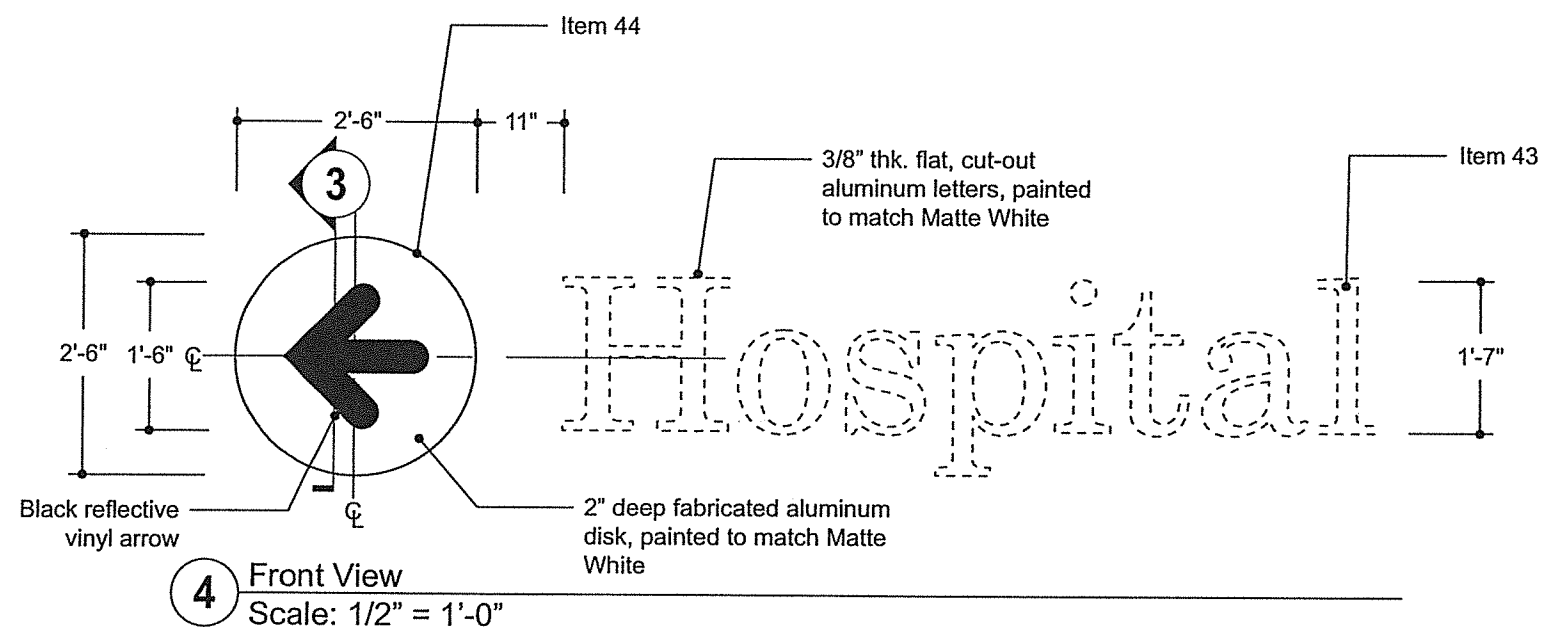


4 Front View
Scale: 1/2" = 1'-0"

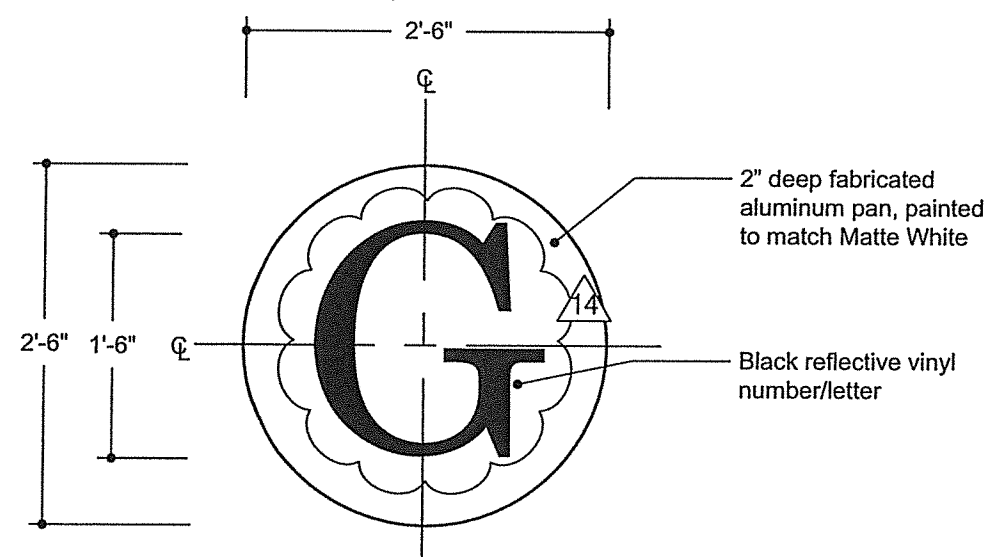

1 Front View
Scale: 3/4" = 1'-0"

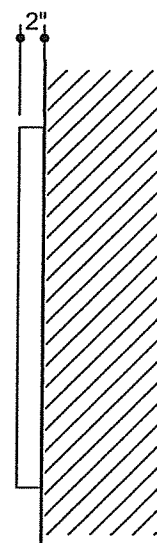

2 Side View
Scale: 3/4" = 1'-0"

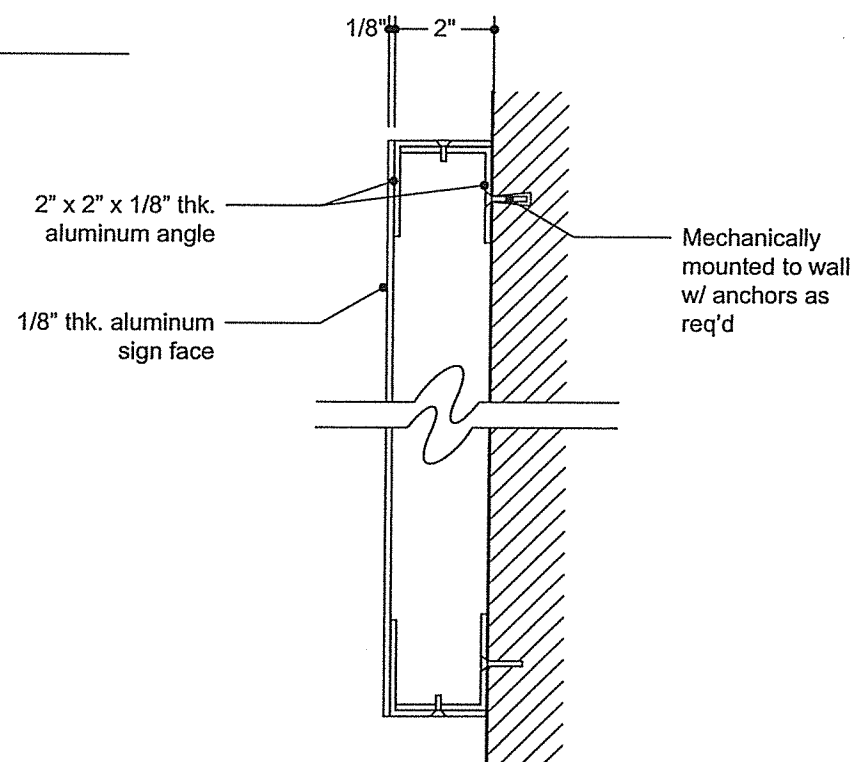

3 Section - Disk
Scale: 3" = 1'-0"

ITEM NO. 44
SIGN TYPE GLD

QTY: 44 42

SIGN MATERIALS:
2'-6" OD X 2" THK. FABRICATED
ALUMINUM PAN PAINTED W/ APPLIED
REFLECTIVE BLACK VINYL NUMBERS.

MOUNTING:
SURFACE MOUNT W/ MOUNTING
CLEAT AND SET SCREWS, PAINTED
TO MATCH.

COLOR/FINISH:
REFER ELEVATIONS

FONT:
NEW CENTURY SCHOOLBOOK
ROMAN

Invoice Number: 48765

Fabrication Drawing

Project
CHILDREN'S HOSPITAL OF
ORANGE COUNTY

Customer
McCARTHY BUILDING CO.
ATT: JAMES BURGGRAF
20401 S.W. BIRCH ST.
NEWPORT BEACH, CA 92660

Designers
FORMATION


Order Item: 44

Sign Type: GLD

Revision No.:

14 Per Returned Submittal
May 18, 2012

Drawn By: APalmer

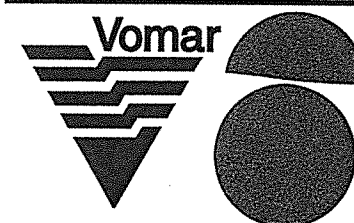

Vomar Products, Inc.
7800 Deering Avenue
Canoga Park, CA 91304-5005
Tel: 818-610-5115
Fax: 818-610-5123
E-Mail: info@vomarproducts.com

Sheet Date: 09/12/12

Sheet Number 44.0


Fabrication
Drawing

Project
CHILDREN'S HOSPITAL OF
ORANGE COUNTY

Customer
McCARTHY BUILDING CO.
ATT: JAMES BURGGRAF
20401 S.W. BIRCH ST.
NEWPORT BEACH, CA 92660


Designers
FORMATION

Order Item: 44
Sign Type: GLD
Revision No.:

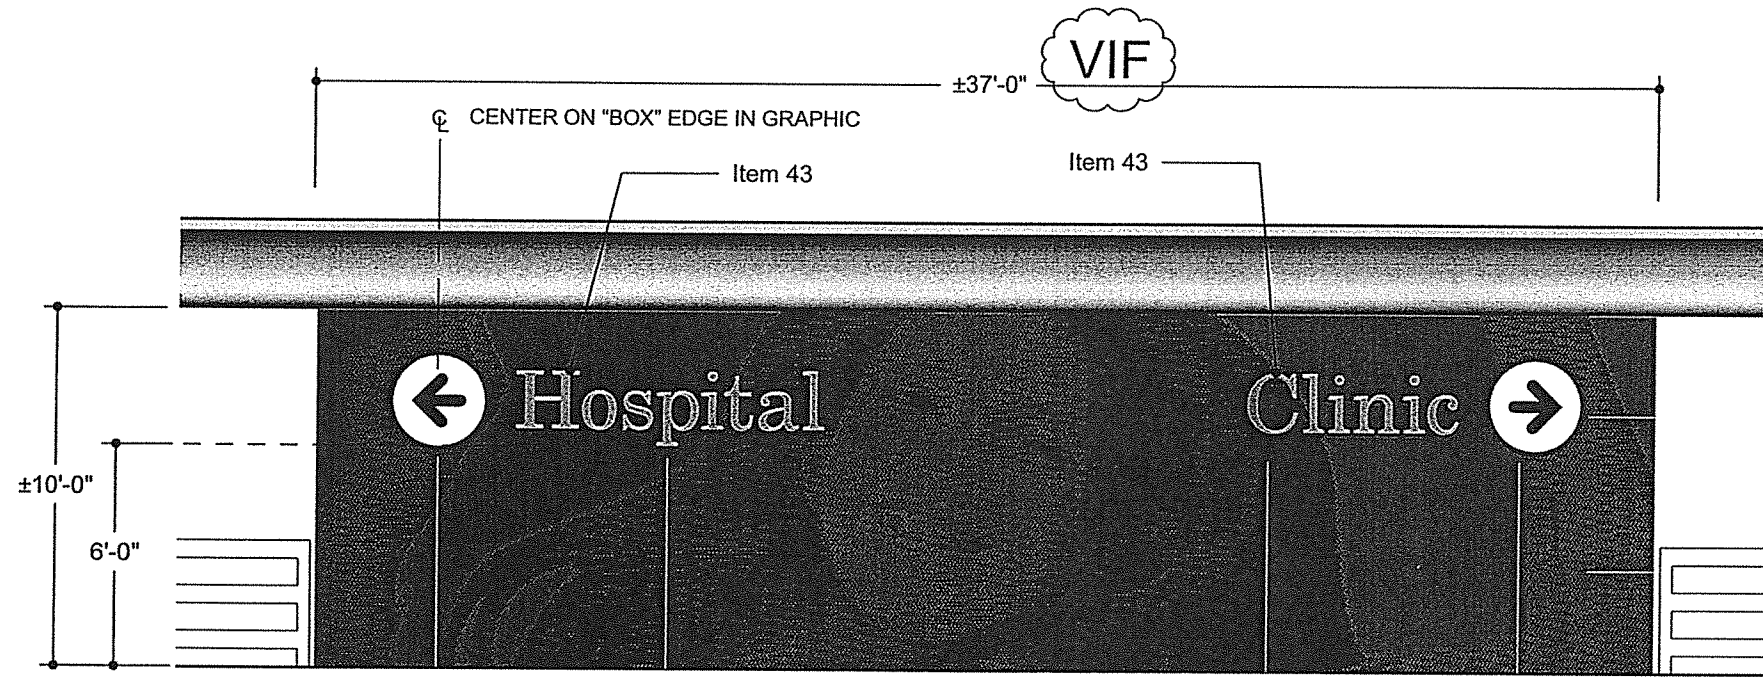

6 Location Elevation - Level 1 Interior South Wall
Scale: 3/16" = 1'-0"

Drawn By: MWilliams

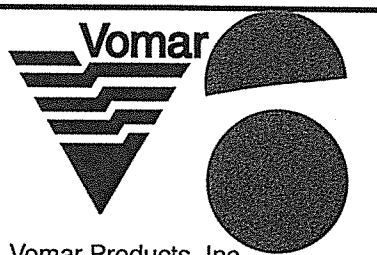

Vomar Products, Inc.
7800 Deering Avenue
Canoga Park, CA 91304-5005
Tel: 818-610-5115
Fax: 818-610-5123
E-Mail: info@vomarproducts.com

Sheet Date: 05/20/10
Sheet Number 44.1

Sign Type	Location	Description	Level	Area	Sign Copy	Comments	Level	Sheet No.	Vomar Item #
GLD	01	GARAGE LEVEL DISK	1	GARAGE	1	Rev 5/22/12 PER MESS SCH SUBT'L rev back to level 1 in new sch 8/29/12	1	AGC.22.0	44
GLD	02	GARAGE LEVEL DISK	1	GARAGE	1	Rev 5/22/12 PER MESS SCH SUBT'L rev back to level 1 in new sch 8/29/12	1	AGC.22.0	44
GLD	03	GARAGE LEVEL DISK	1	GARAGE	1	Rev 5/22/12 PER MESS SCH SUBT'L rev back to level 1 in new sch 8/29/12	1	AGC.22.0	44
GLD	04	GARAGE LEVEL DISK	1	GARAGE	1	Rev 5/22/12 PER MESS SCH SUBT'L rev back to level 1 in new sch 8/29/12	1	AGC.22.0	44
GLD	05	GARAGE LEVEL DISK	1	GARAGE	1	Rev 5/22/12 PER MESS SCH SUBT'L rev back to level 1 in new sch 8/29/12	1	AGC.22.0	44
GLD	06	GARAGE LEVEL DISK	1	GARAGE	G	Rev 5/22/12 PER MESS SCH SUBT'L rev back to level 1 in new sch 8/29/12	G	AGC.22.0	44
GLD	07	GARAGE LEVEL DISK	1	GARAGE	1		1	AGC.22.0	44
GLD	08	GARAGE LEVEL DISK	1	GARAGE	1-deleted	deleted in new 08 28 12 schedule	1	AGC.22.0	44
GLD	9	GARAGE LEVEL DISK	1	GARAGE	→	REV NEW SCHEDULE 082812	1	AGC.22.0	44
GLD	10	GARAGE LEVEL DISK	1	GARAGE	←	REV NEW SCHEDULE 082812	1	AGC.22.0	44
GLD	01	GARAGE LEVEL DISK	2	GARAGE	2	Rev 5/22/12 PER MESS SCH SUBT'L rev back to level 2 in new sch 8/29/12	2	AGC.23.0	44
GLD	02	GARAGE LEVEL DISK	2	GARAGE	2	Rev 5/22/12 PER MESS SCH SUBT'L rev back to level 2 in new sch 8/29/12	2	AGC.23.0	44
GLD	03	GARAGE LEVEL DISK	2	GARAGE	2	Rev 5/22/12 PER MESS SCH SUBT'L rev back to level 2 in new sch 8/29/12	2	AGC.23.0	44
GLD	04	GARAGE LEVEL DISK	2	GARAGE	2	Rev 5/22/12 PER MESS SCH SUBT'L rev back to level 2 in new sch 8/29/12	2	AGC.23.0	44
GLD	05	GARAGE LEVEL DISK	2	GARAGE	2	Rev 5/22/12 PER MESS SCH SUBT'L rev back to level 2 in new sch 8/29/12	1	AGC.23.0	44
GLD	06	GARAGE LEVEL DISK	2	GARAGE	1	Rev 5/22/12 PER MESS SCH SUBT'L	1	AGC.23.0	44

Invoice Number: 48765

Fabrication Drawing

Project
CHILDREN'S HOSPITAL OF
ORANGE COUNTY

Customer
McCARTHY BUILDING CO.
ATT: JAMES BURGGRAF
20401 S.W. BIRCH ST.
NEWPORT BEACH, CA 92660


Designers
FORMATION

Order Item: 44

Sign Type: GLD

Revision No.:

Drawn By: APalmer

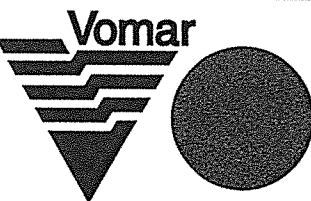

Vomar Products, Inc.
7800 Deering Avenue
Canoga Park, CA 91304-5005
Tel: 818-610-5115
Fax: 818-610-5123
E-Mail: info@vomarproducts.com

Sheet Date: 09/12/12

Sheet Number 44.2

15

Sign Type	Location	Description	Level	Area	Sign Copy	Comments	Level	Sheet No.	Vomar Item #
					2				
GLD	07	GARAGE LEVEL DISK	2	GARAGE			2	AGC.23.0	44
GLD	08	GARAGE LEVEL DISK	2	GARAGE	1	Rev 5/22/12 PER MESS SCH SUBT'L rev back to level 2 in new sch 8/29/12	1	AGC.23.0	44
					→	rev per 08 28 12 new schedule			
GLD	09	GARAGE LEVEL DISK	2	GARAGE			2	AGC.23.0	44
					←	rev per 08 28 12 new schedule			
GLD	10	GARAGE LEVEL DISK	2	GARAGE			2	AGC.23.0	44
					deleted	deleted new sch 082812			
GLD	11	GARAGE LEVEL DISK	2	GARAGE			2	AGC.23.0	44
GLD	01	GARAGE LEVEL DISK	3	GARAGE	3	Rev 5/22/12 PER MESS SCH SUBT'L rev back to level 3 in new sch 8/29/12	3	AGC.24.0	44
GLD	02	GARAGE LEVEL DISK	3	GARAGE	3	Rev 5/22/12 PER MESS SCH SUBT'L rev back to level 3 in new sch 8/29/12	3	AGC.24.0	44
GLD	03	GARAGE LEVEL DISK	3	GARAGE	3	Rev 5/22/12 PER MESS SCH SUBT'L rev back to level 3 in new sch 8/29/12	3	AGC.24.0	44
GLD	04	GARAGE LEVEL DISK	3	GARAGE	3	Rev 5/22/12 PER MESS SCH SUBT'L rev back to level 3 in new sch 8/29/12	3	AGC.24.0	44
GLD	05	GARAGE LEVEL DISK	3	GARAGE	3	Rev 5/22/12 PER MESS SCH SUBT'L rev back to level 3 in new sch 8/29/12	3	AGC.24.0	44
GLD	06	GARAGE LEVEL DISK	2	GARAGE	2	Rev 5/22/12 PER MESS SCH SUBT'L rev back to level 2 in new sch 8/29/12	2	AGC.24.0	44
GLD	07	GARAGE LEVEL DISK	3	GARAGE	3		3	AGC.24.0	44
GLD	08	GARAGE LEVEL DISK	2	GARAGE	2	Rev 5/22/12 PER MESS SCH SUBT'L rev back to level 2 in new sch 8/29/12	2	AGC.24.0	44

Invoice Number: 48765

Fabrication Drawing

Project
CHILDREN'S HOSPITAL OF ORANGE COUNTY

Customer
McCARTHY BUILDING CO.
ATT: JAMES BURGGRAF
20401 S.W. BIRCH ST.
NEWPORT BEACH, CA 92660


Designers
FORMATION

Order Item: 44

Sign Type: GLD

Revision No.:

Drawn By: APalmer

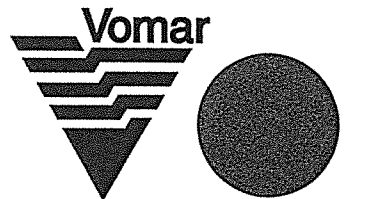

Vomar Products, Inc.
7800 Deering Avenue
Canoga Park, CA 91304-5005
Tel: 818-610-5115
Fax: 818-610-5123
E-Mail: info@vomarproducts.com

Sheet Date: 09/12/12

Sheet Number 44.3

Sign Type	Location	Description	Level	Area	Sign Copy	Comments	Level	Sheet No.	Vomar Item #
					→				
GLD	09	GARAGE LEVEL DISK	2	GARAGE		rev per new sch 08 29 12	2	AGC.24.0	44
					←				
GLD	10	GARAGE LEVEL DISK	2	GARAGE		rev per new sch 08 29 12	2	AGC.24.0	44
					4				
GLD	01	GARAGE LEVEL DISK	4	GARAGE		Rev 5/22/12 PER MESS SCH SUBT'L rev back to level 4 in new sch 8/29/12	4	AGC.25.0	44
					4				
GLD	02	GARAGE LEVEL DISK	4	GARAGE		Rev 5/22/12 PER MESS SCH SUBT'L rev back to level 4 in new sch 8/29/12	4	AGC.25.0	44
					4				
GLD	03	GARAGE LEVEL DISK	4	GARAGE		Rev 5/22/12 PER MESS SCH SUBT'L rev back to level 4 in new sch 8/29/12	4	AGC.25.0	44
					4				
GLD	04	GARAGE LEVEL DISK	4	GARAGE		Rev 5/22/12 PER MESS SCH SUBT'L rev back to level 4 in new sch 8/29/12	4	AGC.25.0	44
					4				
GLD	05	GARAGE LEVEL DISK	4	GARAGE		Rev 5/22/12 PER MESS SCH SUBT'L rev back to level 4 in new sch 8/29/12	4	AGC.25.0	44
					3				
GLD	06	GARAGE LEVEL DISK	4	GARAGE		Rev 5/22/12 PER MESS SCH SUBT'L per rev sch 08 29 12	3	AGC.25.0	44
GLD	07	GARAGE LEVEL DISK	4	GARAGE			4	AGC.25.0	44
					3				
GLD	08	GARAGE LEVEL DISK	4	GARAGE		Rev 5/22/12 PER MESS SCH SUBT'L per rev sch 08 29 12	4	AGC.25.0	44
					→				
GLD	09	GARAGE LEVEL DISK	4	GARAGE		rev per new sch 08 29 12	4	AGC.25.0	44
GLD	10	GARAGE LEVEL DISK	4	GARAGE		rev per new sch 08 29 12	4	AGC.25.0	44
					4				
GLD	08	GARAGE LEVEL DISK	5	GARAGE		rev per new sch 08 29 12	5	AGC.26.0	44
					→				
GLD	09	GARAGE LEVEL DISK	5	GARAGE		rev per new sch 08 29 12	5	AGC.26.0	44
					←				
GLD	10	GARAGE LEVEL DISK	5	GARAGE		rev per new sch 08 29 12	5	AGC.26.0	44

42

Invoice Number: 48765

Fabrication
Drawing

Project
CHILDREN'S HOSPITAL OF
ORANGE COUNTY

Customer
McCARTHY BUILDING CO.
ATT: JAMES BURGGRAF
20401 S.W. BIRCH ST.
NEWPORT BEACH, CA 92660


Designers
FORMATION

Order Item: 44

Sign Type: GLD

Revision No.:


Drawn By: APalmer

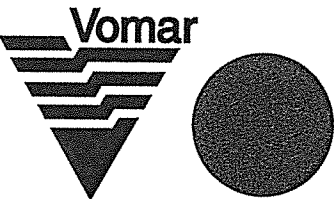


Vomar Products, Inc.
7800 Deering Avenue
Canoga Park, CA 91304-5005
Tel: 818-610-5115
Fax: 818-610-5123
E-Mail: info@vomarproducts.com

Sheet Date: 09/12/12


Sheet Number 44.4

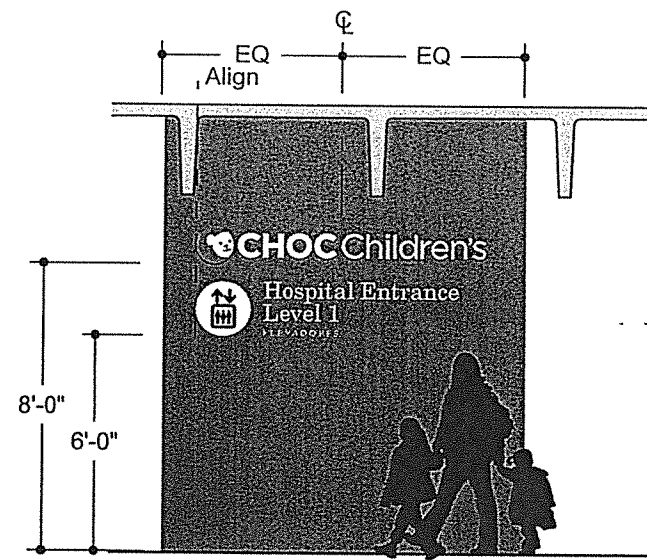


5 Level 2 Hospital Vestibule South Elevation
Scale: 3/16" = 1'-0"

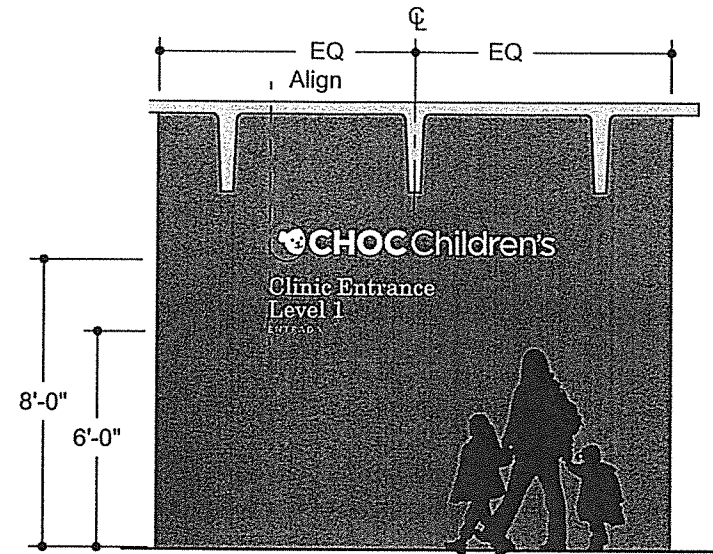


6 Level 2 Clinic Vestibule East Elevation
Scale: 3/16" = 1'-0"

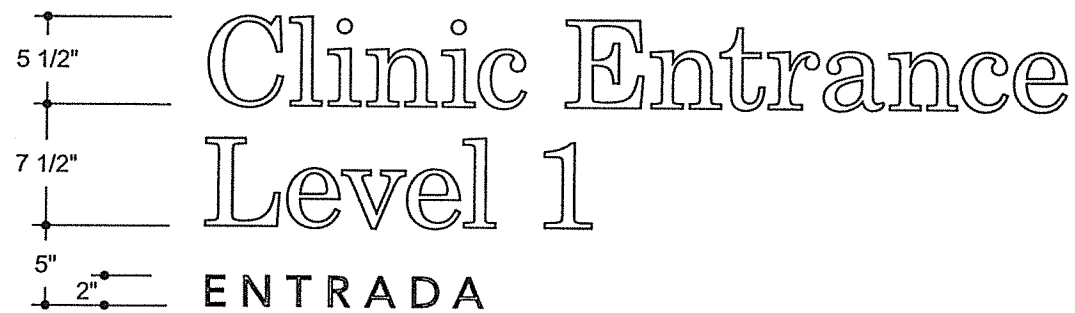


4 Front View
Scale: 1" = 1'-0"

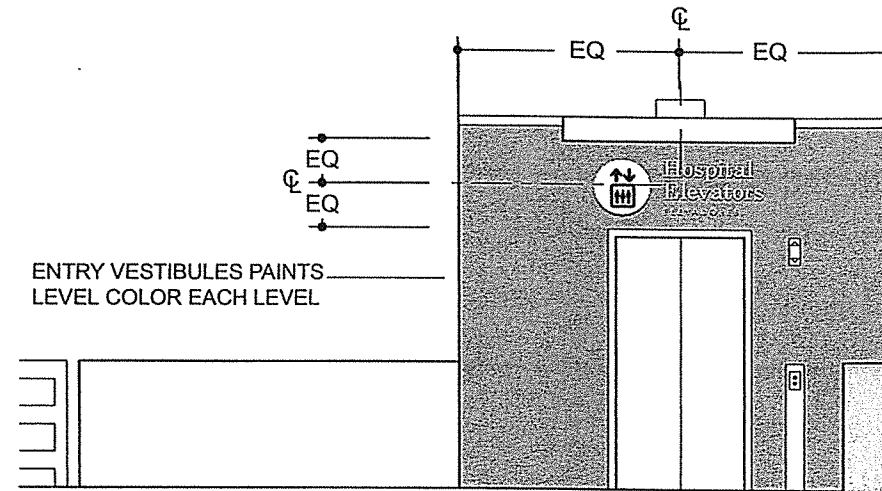


7 Level 2 Hospital Vestibule South Elevation
Scale: 3/16" = 1'-0"

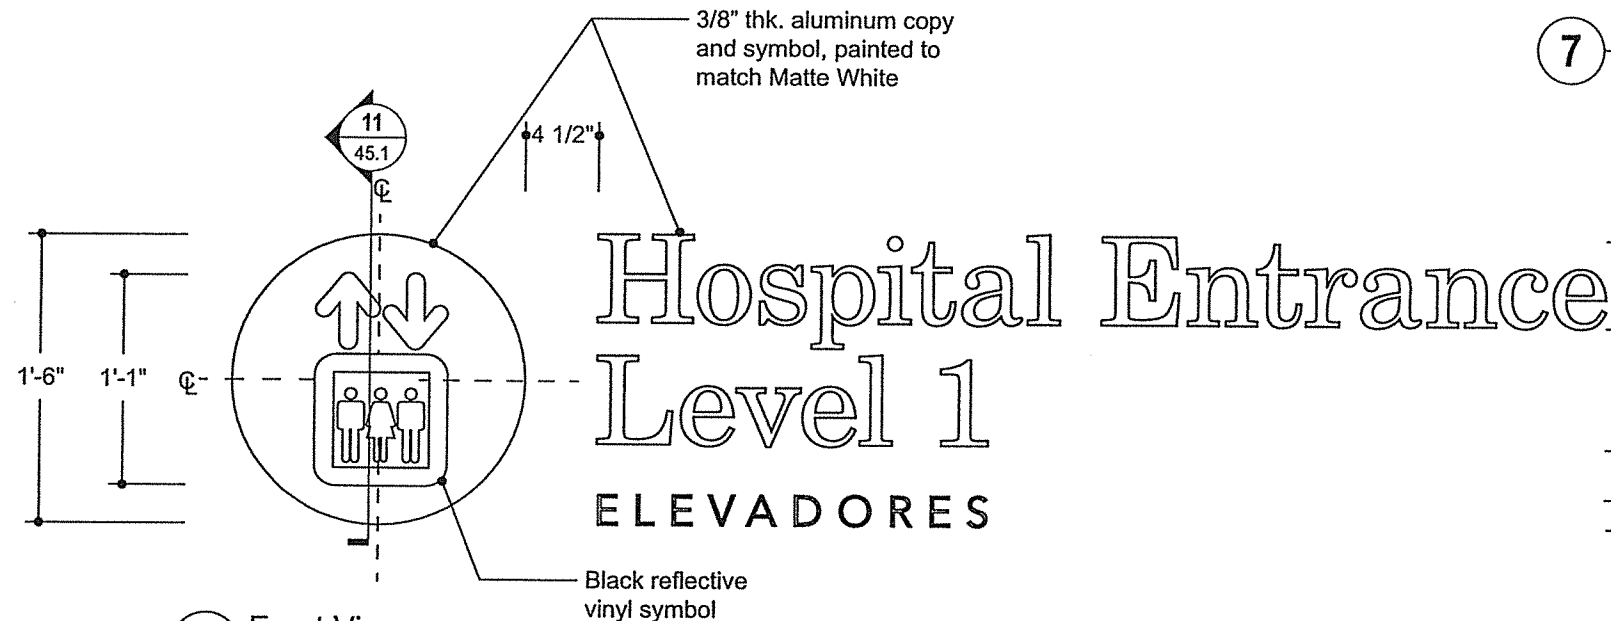

1 Front View
Scale: 1" = 1'-0"

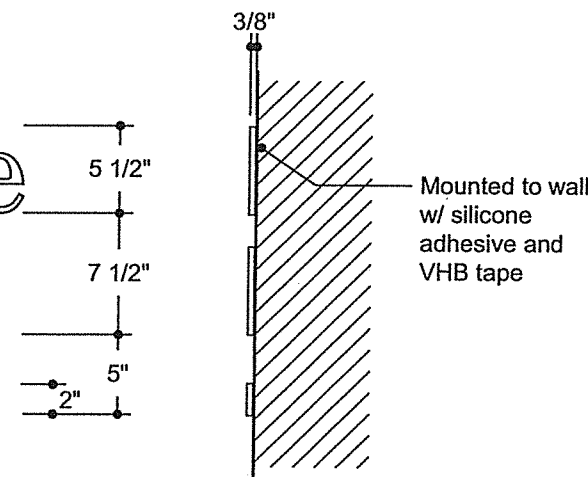

2 Side View - Copy
Scale: 1" = 1'-0"

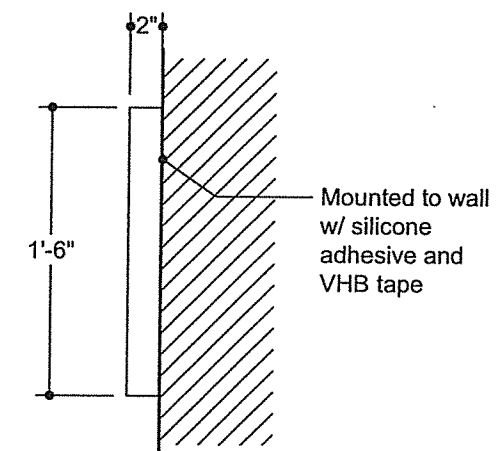

3 Side View - Disk
Scale: 1" = 1'-0"

ITEM NO. 45
SIGN TYPE EL

QTY: 9
SIGN MATERIALS:
EACH LOCATION CONSISTS OF
5 1/2" H, 7 1/2" H X 2" H X 3/8" THK.
ALUMINUM LETTERFORMS, PAINTED
WITH OR WITHOUT 18" OD X 2" THK.
FABRICATED ALUMINUM PAN W/
APPLIED REFLECTIVE GRAPHICS.

MOUNTING:
WALL SURFACE MOUNTED

COLOR/FINISH:
REFER ELEVATIONS

FONT:
NEW CENTURY SCHOOLBOOK
ROMAN
AVENIR 65 MEDIUM

Invoice Number: 48765

Fabrication Drawing

Project
CHILDREN'S HOSPITAL OF
ORANGE COUNTY

Customer
McCARTHY BUILDING CO.
ATT: JAMES BURGGRAF
20401 S.W. BIRCH ST.
NEWPORT BEACH, CA 92660


Designers
FORMATION

Order Item: 45

Sign Type: EL

Revision No.:

Drawn By: APalmer

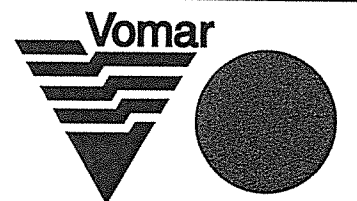

Vomar Products, Inc.
7800 Deering Avenue
Canoga Park, CA 91304-5005
Tel: 818-610-5115
Fax: 818-610-5123
E-Mail: info@vomarproducts.com

Sheet Date: 09/13/12

Sheet Number 45.0

Children's Hospital of Orange County
Tower 2 Garage Graphics
Project: 12407001

Message Schedule
ASI #253: 4 September 2012

Sign Type/ Loc.	Description	Message	Comments	Level	Sheet
EL 01	Elevator Letters	(ELEVATOR SYMBOL) Hospital Elevators Ground Level ELEVADORES		G	AGC22.0
EL 02	Elevator Letters	Clinic Entrance Level 1 ENTRADA		1	AGC22.0
EL 01	Elevator Letters	(ELEVATOR SYMBOL) Hospital Elevators Level 1 ELEVADORES		1	AGC23.0
EL 02	Elevator Letters	Clinic Entrance Level 2 ENTRADA		2	AGC23.0
EL 01	Elevator Letters	(ELEVATOR SYMBOL) Hospital Elevators Level 2 ELEVADORES		2	AGC24.0
EL 02	Elevator Letters	Clinic Entrance Level 3 ENTRADA		3	AGC24.0

Invoice Number: 48765

Fabrication
Drawing

Project
CHILDREN'S HOSPITAL OF
ORANGE COUNTY

Customer
McCARTHY BUILDING CO.
ATT: JAMES BURGGRAF
20401 S.W. BIRCH ST.
NEWPORT BEACH, CA 92660


Designers
FORMATION

Order Item: 45

Sign Type: EL

Revision No.:

Drawn By: APalmer

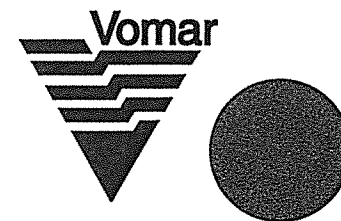

Vomar Products, Inc.
7800 Deering Avenue
Canoga Park, CA 91304-5005
Tel: 818-610-5115
Fax: 818-610-5123
E-Mail: info@vomarproducts.com

Sheet Date: 09/13/10

Sheet Number 45.2

45.1 NOT USED

Children's Hospital of Orange County
Tower 2 Garage Graphics
Project: 12407001

Message Schedule
ASI #253: 4 September 2012

Sign Type/ Loc.	Description	Message	Comments	Level	Sheet
EL 01	Elevator Letters	(ELEVATOR SYMBOL)		3	AGC25.0
		Hospital Elevators Level 3			
		ELEVADORES			
EL 02	Elevator Letters	Clinic Entrance Level 4		4	AGC25.0
		ENTRADA			

Invoice Number: 48765

Fabrication
Drawing

Project
CHILDREN'S HOSPITAL OF
ORANGE COUNTY

Customer
McCARTHY BUILDING CO.
ATT: JAMES BURGGRAF
20401 S.W. BIRCH ST.
NEWPORT BEACH, CA 92660


Designers
FORMATION

Order Item: 45

Sign Type: EL

Revision No.:


Drawn By: APalmer

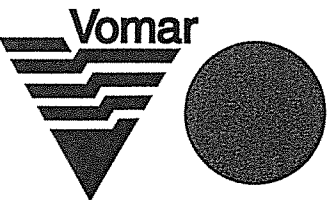


Vomar Products, Inc.
7800 Deering Avenue
Canoga Park, CA 91304-5005
Tel: 818-610-5115
Fax: 818-610-5123
E-Mail: info@vomarproducts.com

Sheet Date: 09/13/10


Sheet Number 45.3

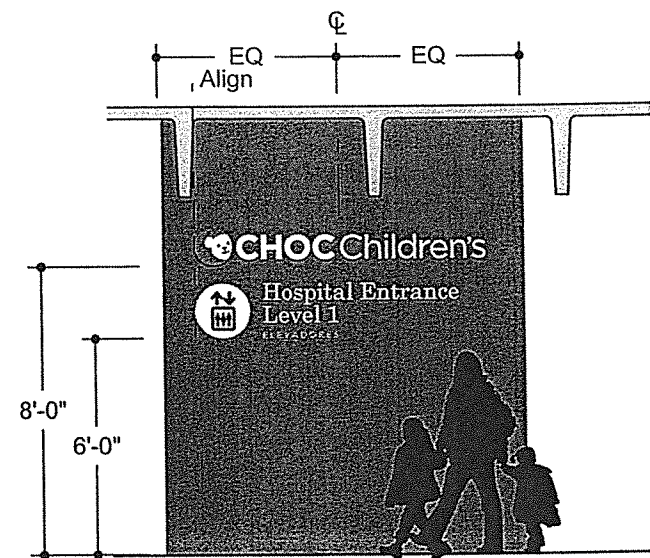


5 Level 2 Hospital Vestibule South Elevation
Scale: 3/16" = 1'-0"

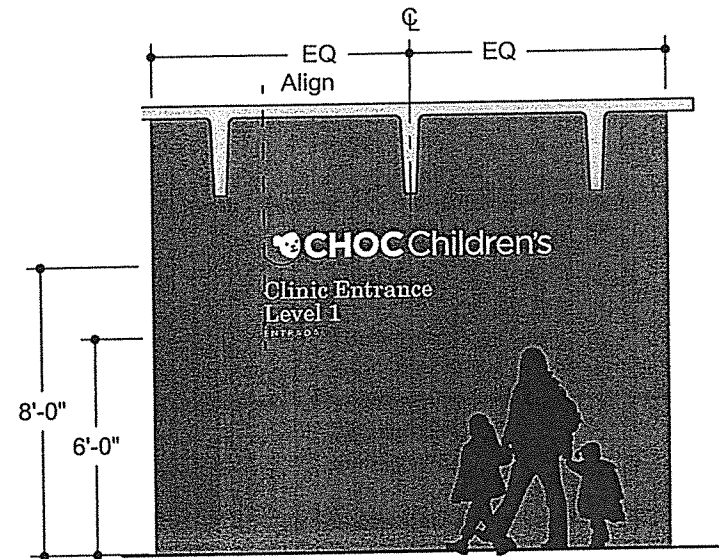

6 Level 2 Clinic Vestibule East Elevation
Scale: 3/16" = 1'-0"

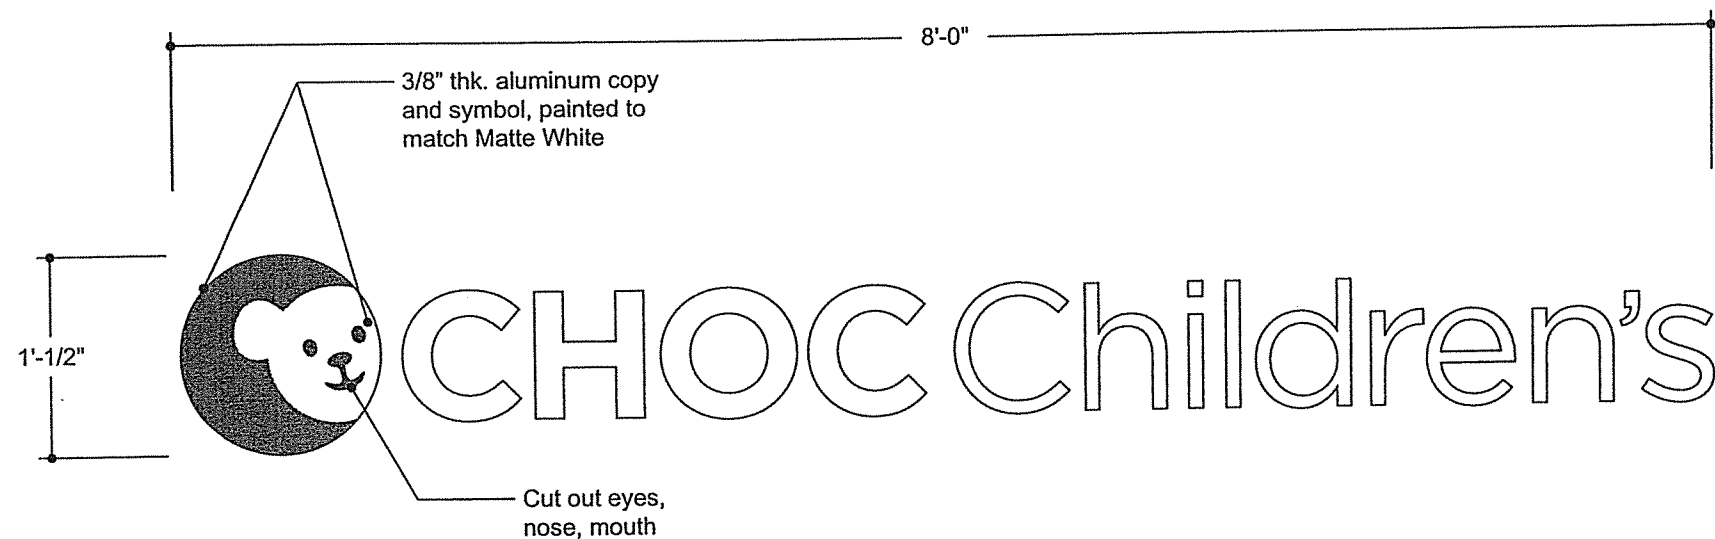

1 Front View
Scale: 1" = 1'-0"

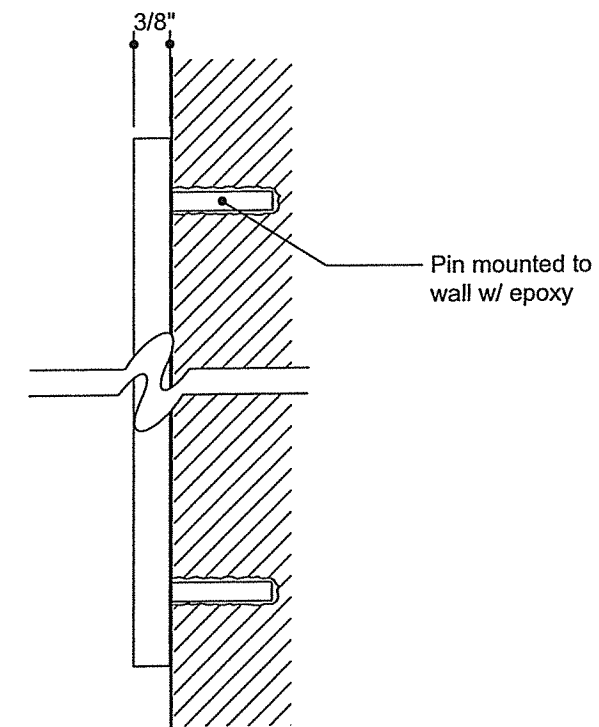

2 Side View
Scale: Half Size

ITEM NO. 46
SIGN TYPE CL

QTY: 4

SIGN MATERIALS:
SIGN CONSISTS OF
16 1/2" H X 3/8" THK. LOGOTYPE AND
LETTERS, PAINTED FLAT, CUT-OUT
ALUMINUM

MOUNTING:
WALL SURFACE MOUNTED

COLOR/FINISH:
REFER ELEVATIONS

FONT:
N/A

Invoice Number: 48765

Fabrication Drawing

Project
CHILDREN'S HOSPITAL OF
ORANGE COUNTY

Customer
McCARTHY BUILDING CO.
ATT: JAMES BURGGRAB
20401 S.W. BIRCH ST.
NEWPORT BEACH, CA 92660


Designers
FORMATION

Order Item: 46

Sign Type: CL

Revision No.:


Drawn By: APalmer

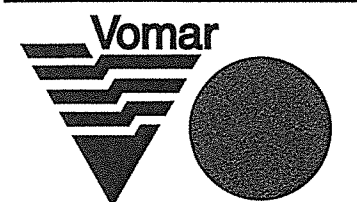



Vomar Products, Inc.
7800 Deering Avenue
Canoga Park, CA 91304-5005
Tel: 818-610-5115
Fax: 818-610-5123
E-Mail: info@vomarproducts.com

Sheet Date: 09/12/12

Sheet Number 46.0

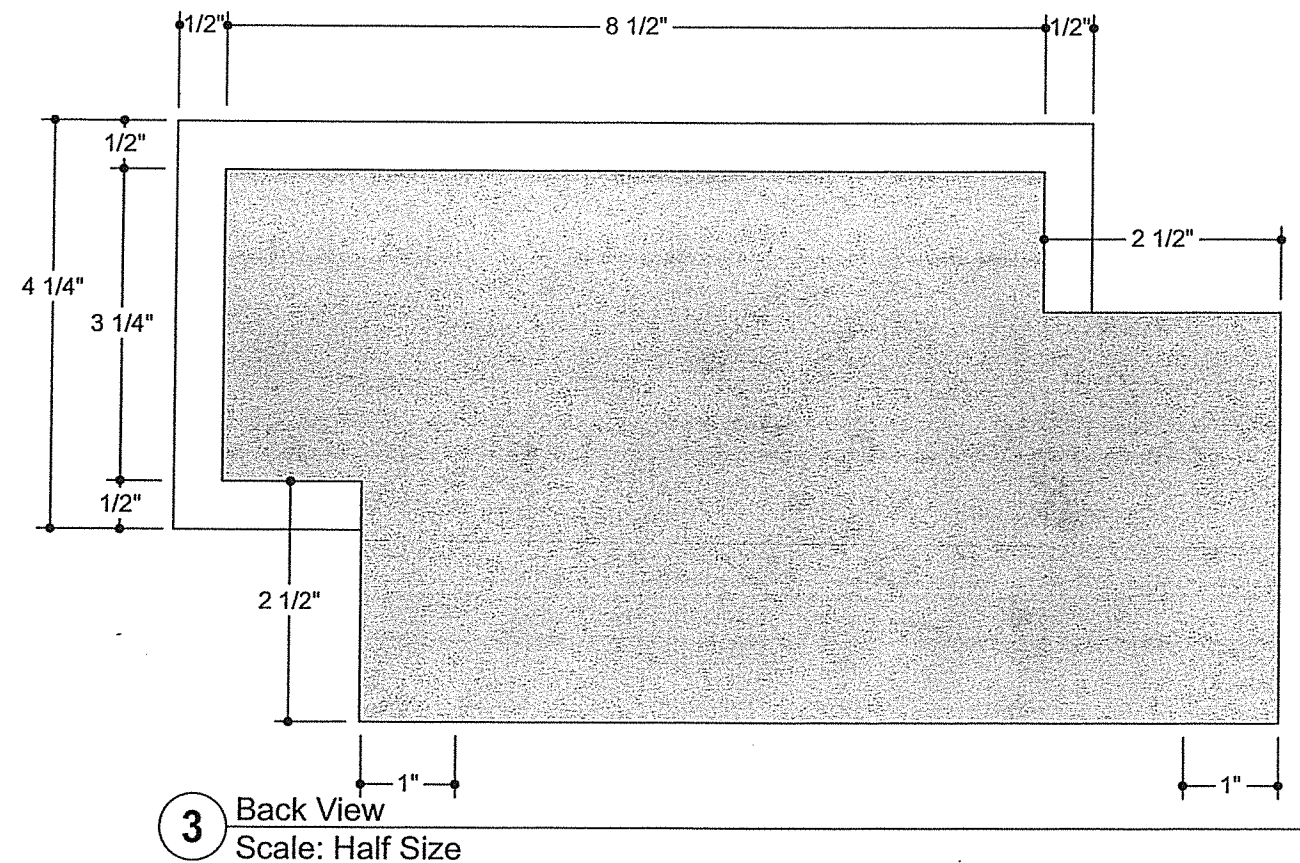

TEMPORARY SIGNS COMPLETE

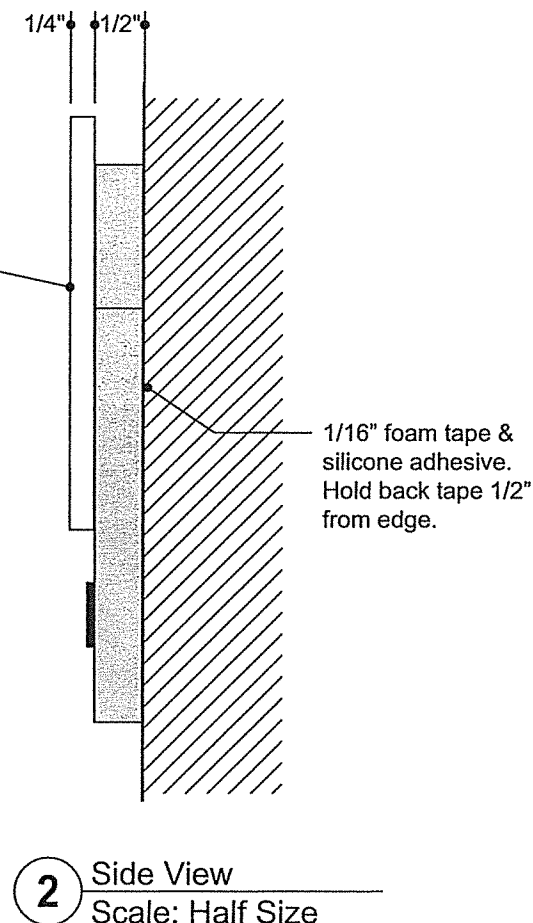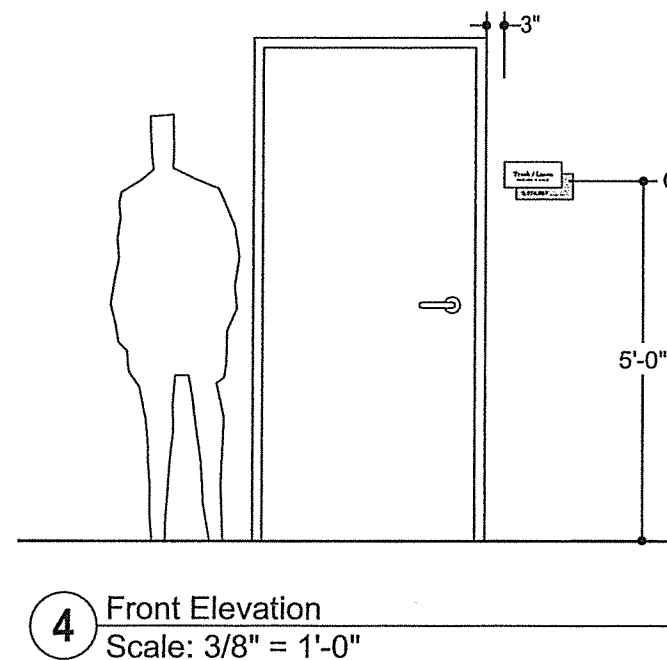

ITEM NO. 91
SIGN TYPE RIB-BOH
PERMANENT SIGNS AND
TEMPORARY SIGNS

QTY: 9

SIGN MATERIALS:
6 1/4" H X 11 1/2" W UNFRAMED
ACRYLIC PLAQUE W/ 1/4" THK.
ACRYLIC FACE PANEL AND FRONT
SURFACE SILKSCREENED COPY AND
1/2" THK. TACTILE BACKING W/
RAISED COPY & BRAILLE.

MOUNTING:
WALL SURFACE MOUNTED

COLOR/FINISH:
REFER ELEVATIONS

FONT:
AVENIR 85 HEAVY
AVENIR 35 LIGHT
NEW CENTURY SCHOOLBOOK
ROMAN

Invoice Number: 48765

Fabrication Drawing

Project
CHILDREN'S HOSPITAL OF
ORANGE COUNTY

Customer
McCARTHY BUILDING CO.
ATT: JAMES BURGGRAF
20401 S.W. BIRCH ST.
NEWPORT BEACH, CA 92660

Designers
FORMATION


Order Item: 91

Sign Type: RIB-BOH

Revision No.:

32 Per RFI# 5975
July 19, 2012

Drawn By: RA

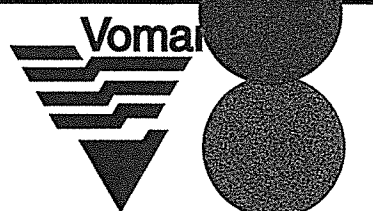

Vomar Products, Inc.
7800 Deering Avenue
Canoga Park, CA 91304-5005
Tel: 818-610-5115
Fax: 818-610-5123
E-Mail: info@vomarproducts.com

Sheet Date: 08/01/12

Sheet Number 91.0

Sign Type	Loc.	Description	Existing Arch. #	Wayfinding Room #	Arch. Room Name	Wayfinding Message	Spanish	Comments	Level	Sheet
RIB	001	Room Identification (boh)	B.084	S0104	FIRE PUMPS	UPS Equipment (spanish translation)	Refer To Spanish Translation Document For Message - Asi #171: Delta #449	Rfi 5975 * Message Has Changed.	Lower Level	AGC1.0
RIB	800	Room Identification (boh)	B.098	S0110	MECHANICAL	Generator Mechanical (spanish translation)	Refer To Spanish Translation Document For Message - Asi #171: Delta #449	Rfi 5975	Lower Level	AGC1.0
RIB	801	Room Identification (boh)	B.098	S0110	MECHANICAL	Generator Mechanical (spanish translation)	Refer To Spanish Translation Document For Message - Asi #171: Delta #449	Rfi 5975	Lower Level	AGC1.0
RIB	802	Room Identification (boh)	B.098	S0110	MECHANICAL	Generator Mechanical (spanish translation)	Refer To Spanish Translation Document For Message - Asi #171: Delta #449	Rfi 5975	Lower Level	AGC1.0
RIB	803	Room Identification (boh)	EB.1001	EB.1001	MED GAS RM	Med Gas Room (spanish translation)		Rfi 5975	Lower Level	AGC1.0
RIB	800	Room Identification (boh)	*B.084*	S1107	FIRE PUMPS	Fire Pumps (spanish translation)	Refer To Spanish Translation Document For Message - Asi #171: Delta #449	Rfi 5975 * Exterior Grade	1	AGC2.0

Invoice Number: 48765

Fabrication Drawing

Project
CHILDREN'S HOSPITAL OF
ORANGE COUNTY

Customer
McCARTHY BUILDING CO.
ATT: JAMES BURGGRAF
20401 S.W. BIRCH ST.
NEWPORT BEACH, CA 92660

Designers
FORMATION


Order Item: 91

Sign Type: RIB-BOH

Revision No.:

 32 Per RFI# 5975
July 19, 2012

Drawn By: RA

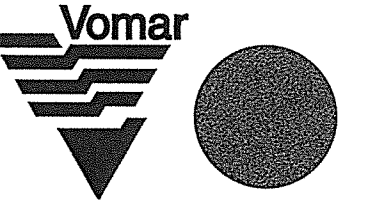

Vomar Products, Inc.
7800 Deering Avenue
Canoga Park, CA 91304-5005
Tel: 818-610-5115
Fax: 818-610-5123
E-Mail: info@vomarproducts.com

Sheet Date: 08/01/12

Sheet Number 91.1

Fabrication
Drawing

Project
CHILDREN'S HOSPITAL OF
ORANGE COUNTY

Customer
McCARTHY BUILDING CO.
ATT: JAMES BURGGRAF
20401 S.W. BIRCH ST.
NEWPORT BEACH, CA 92660

Designers
FORMATION


Order Item: 91

Sign Type: RIB-BOH

Revision No.:

 32 Per RFI# 5975
July 19, 2012

Drawn By: RA

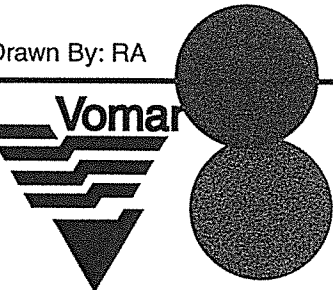

Vomar Products, Inc.
7800 Deering Avenue
Canoga Park, CA 91304-5005
Tel: 818-610-5115
Fax: 818-610-5123
E-Mail: info@vomarproducts.com

Sheet Date: 08/01/12

Sheet Number 91.2

Sign Type	Loc	Description	Existing Arch. #	Wayfinding Room #	Arch. Room Name	Wayfinding Message	Spanish	Comments	Level	Sheet
RIB	009	Room Identification (boh)	R.141	SR002	STORAGE GENERAL	Future Mechanical (spanish translation)	Refer To Spanish Translation Document For Message - Asi #171: Delta #449	Rfi 5975 * Message Has Changed.	Roof Level	AGC9.0
RIB	100	Room Identification (boh)	R.003	SR106	ELEVATOR MACHINE ROOM	Elevator Machine Room (spanish translation)	Refer To Spanish Translation Document For Message - Asi #171: Delta #449	Rfi 5954	Roof Level	AGC9.0
RIB	700	Room Identification (boh)	1000	S1000X	ELEVATOR MACHINE ROOM	Elevator Machine Room (spanish translation)	Refer To Spanish Translation Document For Message - Asi #171: Delta #449	Rfi 5954	1	AGC2.0