



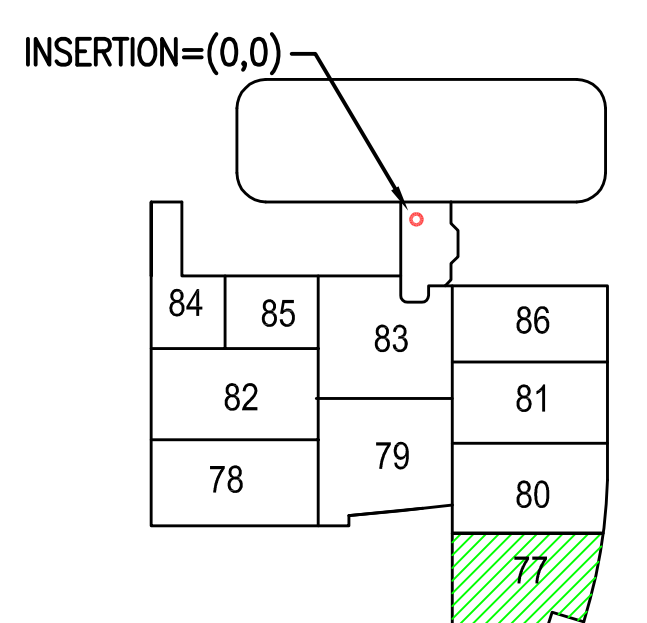



"PROJECT RECORD DRAWING"

[illegible]

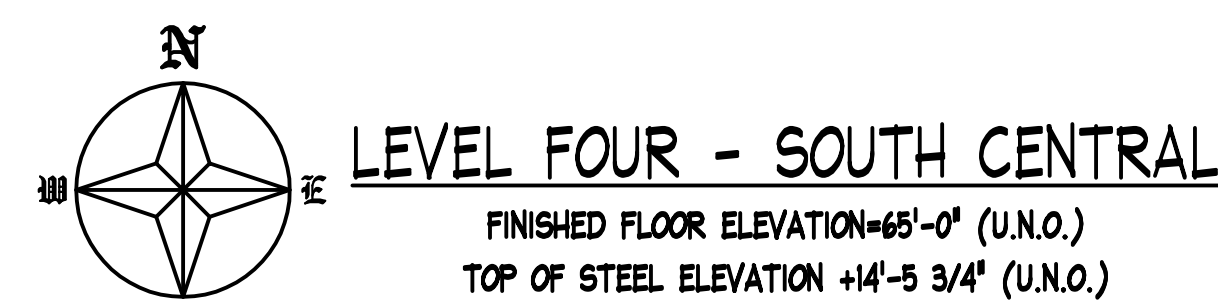

  KEY PLAN

JOB NO: 9507		PAY ITEM 79
PROJECT: CHILDRENS HOSPITAL ORANGE, CA		
TITLE: LEVEL FOUR AREA E HVAC SYSTEM LAOYOT		
REFERENCE DRAWINGS ARCH: A3.40 STRUCT: S3.5A&B MECH: M3.4E		
BY: BP	DRAWING NO.	
DATE: 1-27-10	79 OF 115	

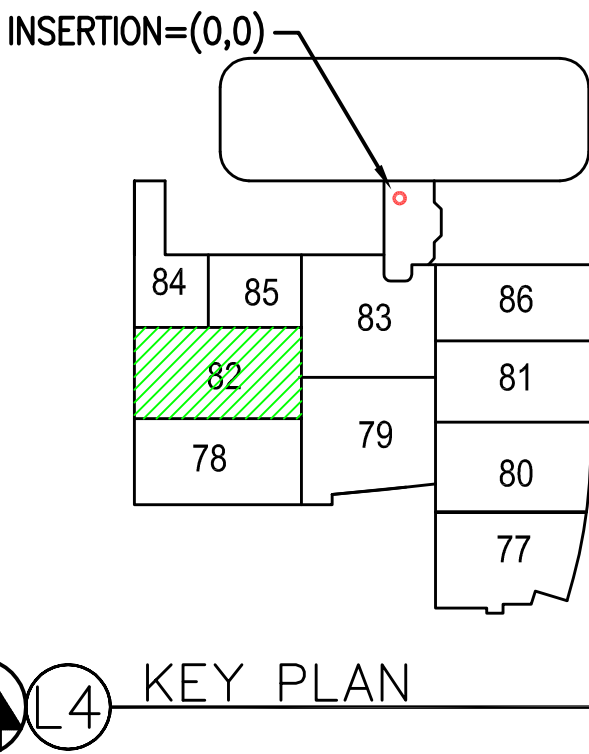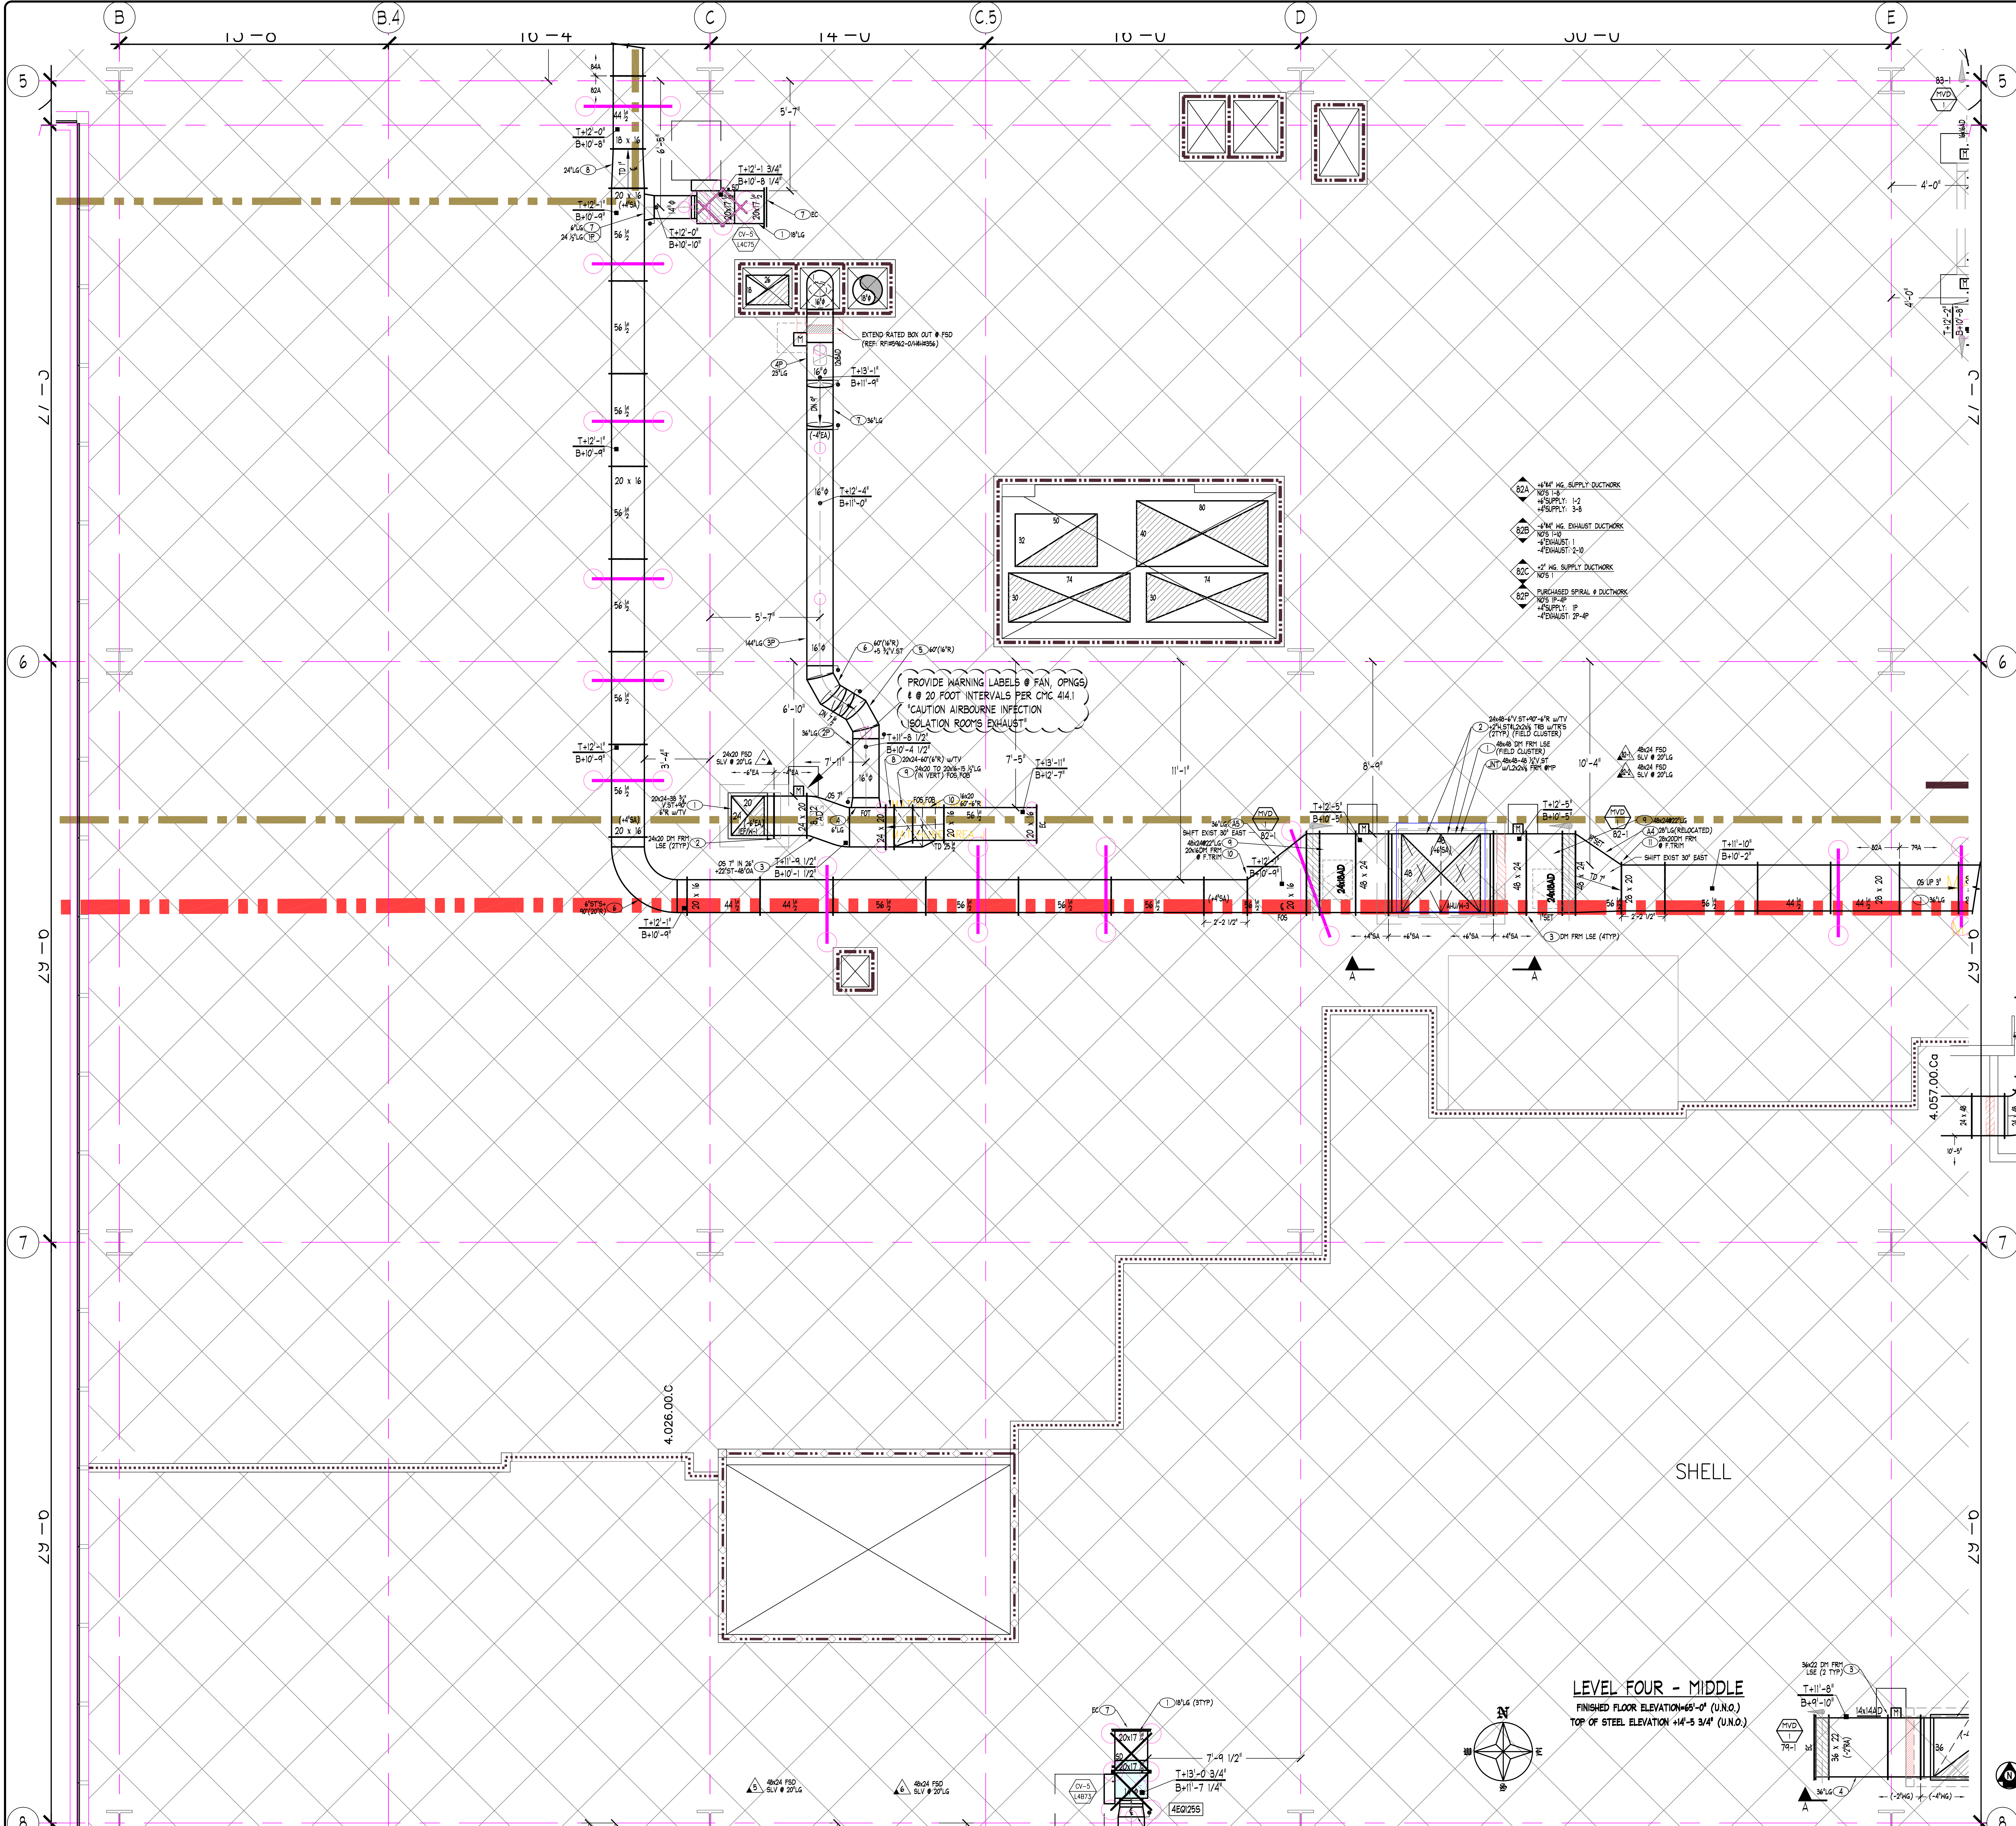

LEVEL FOUR - MIDDLE
FINISHED FLOOR ELEVATION +65'-0" (U.N.O.)
TOP OF STEEL ELEVATION +14'-5 3/4" (U.N.O.)

INSERTION=(0,0)

NOTES

1. ELEVATIONS SHOWN ON THIS DRAWING ARE TO THE EXISTING FINISHED FLOOR. ALL ELEVATIONS MUST BE CORRECTED TO THE FINISHED FLOOR ELEVATION.

ABBREVIATIONS

SYMBOL	DESCRIPTION
1/2" DIA. SUPPLY DUCTWORK	1/2" DIA. SUPPLY DUCTWORK
1/2" DIA. RETURN DUCTWORK	1/2" DIA. RETURN DUCTWORK
1/2" DIA. EXHAUST DUCTWORK	1/2" DIA. EXHAUST DUCTWORK
1/2" DIA. CONDENSATE PIPING	1/2" DIA. CONDENSATE PIPING
1/2" DIA. GAS PIPING	1/2" DIA. GAS PIPING
1/2" DIA. WATER PIPING	1/2" DIA. WATER PIPING
1/2" DIA. VENT PIPING	1/2" DIA. VENT PIPING
1/2" DIA. DRAIN PIPING	1/2" DIA. DRAIN PIPING
1/2" DIA. RAIN PIPING	1/2" DIA. RAIN PIPING
1/2" DIA. FUEL PIPING	1/2" DIA. FUEL PIPING
1/2" DIA. AIR PIPING	1/2" DIA. AIR PIPING
1/2" DIA. VACUUM PIPING	1/2" DIA. VACUUM PIPING
1/2" DIA. OTHER PIPING	1/2" DIA. OTHER PIPING

SYMBOL LEGEND

SYMBOL	DESCRIPTION
1/2" DIA. SUPPLY DUCTWORK	1/2" DIA. SUPPLY DUCTWORK
1/2" DIA. RETURN DUCTWORK	1/2" DIA. RETURN DUCTWORK
1/2" DIA. EXHAUST DUCTWORK	1/2" DIA. EXHAUST DUCTWORK
1/2" DIA. CONDENSATE PIPING	1/2" DIA. CONDENSATE PIPING
1/2" DIA. GAS PIPING	1/2" DIA. GAS PIPING
1/2" DIA. WATER PIPING	1/2" DIA. WATER PIPING
1/2" DIA. VENT PIPING	1/2" DIA. VENT PIPING
1/2" DIA. DRAIN PIPING	1/2" DIA. DRAIN PIPING
1/2" DIA. RAIN PIPING	1/2" DIA. RAIN PIPING
1/2" DIA. FUEL PIPING	1/2" DIA. FUEL PIPING
1/2" DIA. AIR PIPING	1/2" DIA. AIR PIPING
1/2" DIA. VACUUM PIPING	1/2" DIA. VACUUM PIPING
1/2" DIA. OTHER PIPING	1/2" DIA. OTHER PIPING

MATERIAL LISTS

DATE	NO.	DESCRIPTION	QTY.	UNIT
10-25-22	5	1/2" DIA. SUPPLY AIR DUCTWORK (STEEL) OF 200' L.S.	200	LF
		1/2" DIA. RETURN AIR DUCTWORK (STEEL) OF 200' L.S.	200	LF
		1/2" DIA. EXHAUST AIR DUCTWORK (STEEL) OF 200' L.S.	200	LF
		1/2" DIA. CONDENSATE PIPING (PVC) OF 200' L.S.	200	LF
		1/2" DIA. GAS PIPING (STEEL) OF 200' L.S.	200	LF
		1/2" DIA. WATER PIPING (STEEL) OF 200' L.S.	200	LF
		1/2" DIA. VENT PIPING (STEEL) OF 200' L.S.	200	LF
		1/2" DIA. DRAIN PIPING (STEEL) OF 200' L.S.	200	LF
		1/2" DIA. RAIN PIPING (STEEL) OF 200' L.S.	200	LF
		1/2" DIA. FUEL PIPING (STEEL) OF 200' L.S.	200	LF
		1/2" DIA. AIR PIPING (STEEL) OF 200' L.S.	200	LF
		1/2" DIA. VACUUM PIPING (STEEL) OF 200' L.S.	200	LF
		1/2" DIA. OTHER PIPING (STEEL) OF 200' L.S.	200	LF

REVISIONS


DATE	NO.	DESCRIPTION
10-25-22	5	1/2" DIA. SUPPLY AIR DUCTWORK (STEEL) OF 200' L.S.

PROJECT RECORD DRAWING





SHEET METAL
HARRIS & HART
TRACTORS & FABRICATORS

HARRIS & HART INC.
1759 WEST 1200 SOUTH
OGDEN, UTAH 84404
PHONE: (801) 731-0577
FAX NO: (801) 731-0580
WEBSITE: WWW.HARRIS-HART.COM
E-MAIL TO: DETAILING DEPARTMENT:
taylor@harris-hart.com

JOB NO: 9507
PROJECT: CHILDRENS HOSPITAL
ORANGE, CA
TITLE: LEVEL FOUR AREA J
HVAC SYSTEM LAYOUT
REFERENCE DRAWINGS: ARCH4340 STRUCT: 52.5A&B MECH: M3.41
BY: BP
DATE: 1-27-10
SCALE: 3/8"=1'-0"

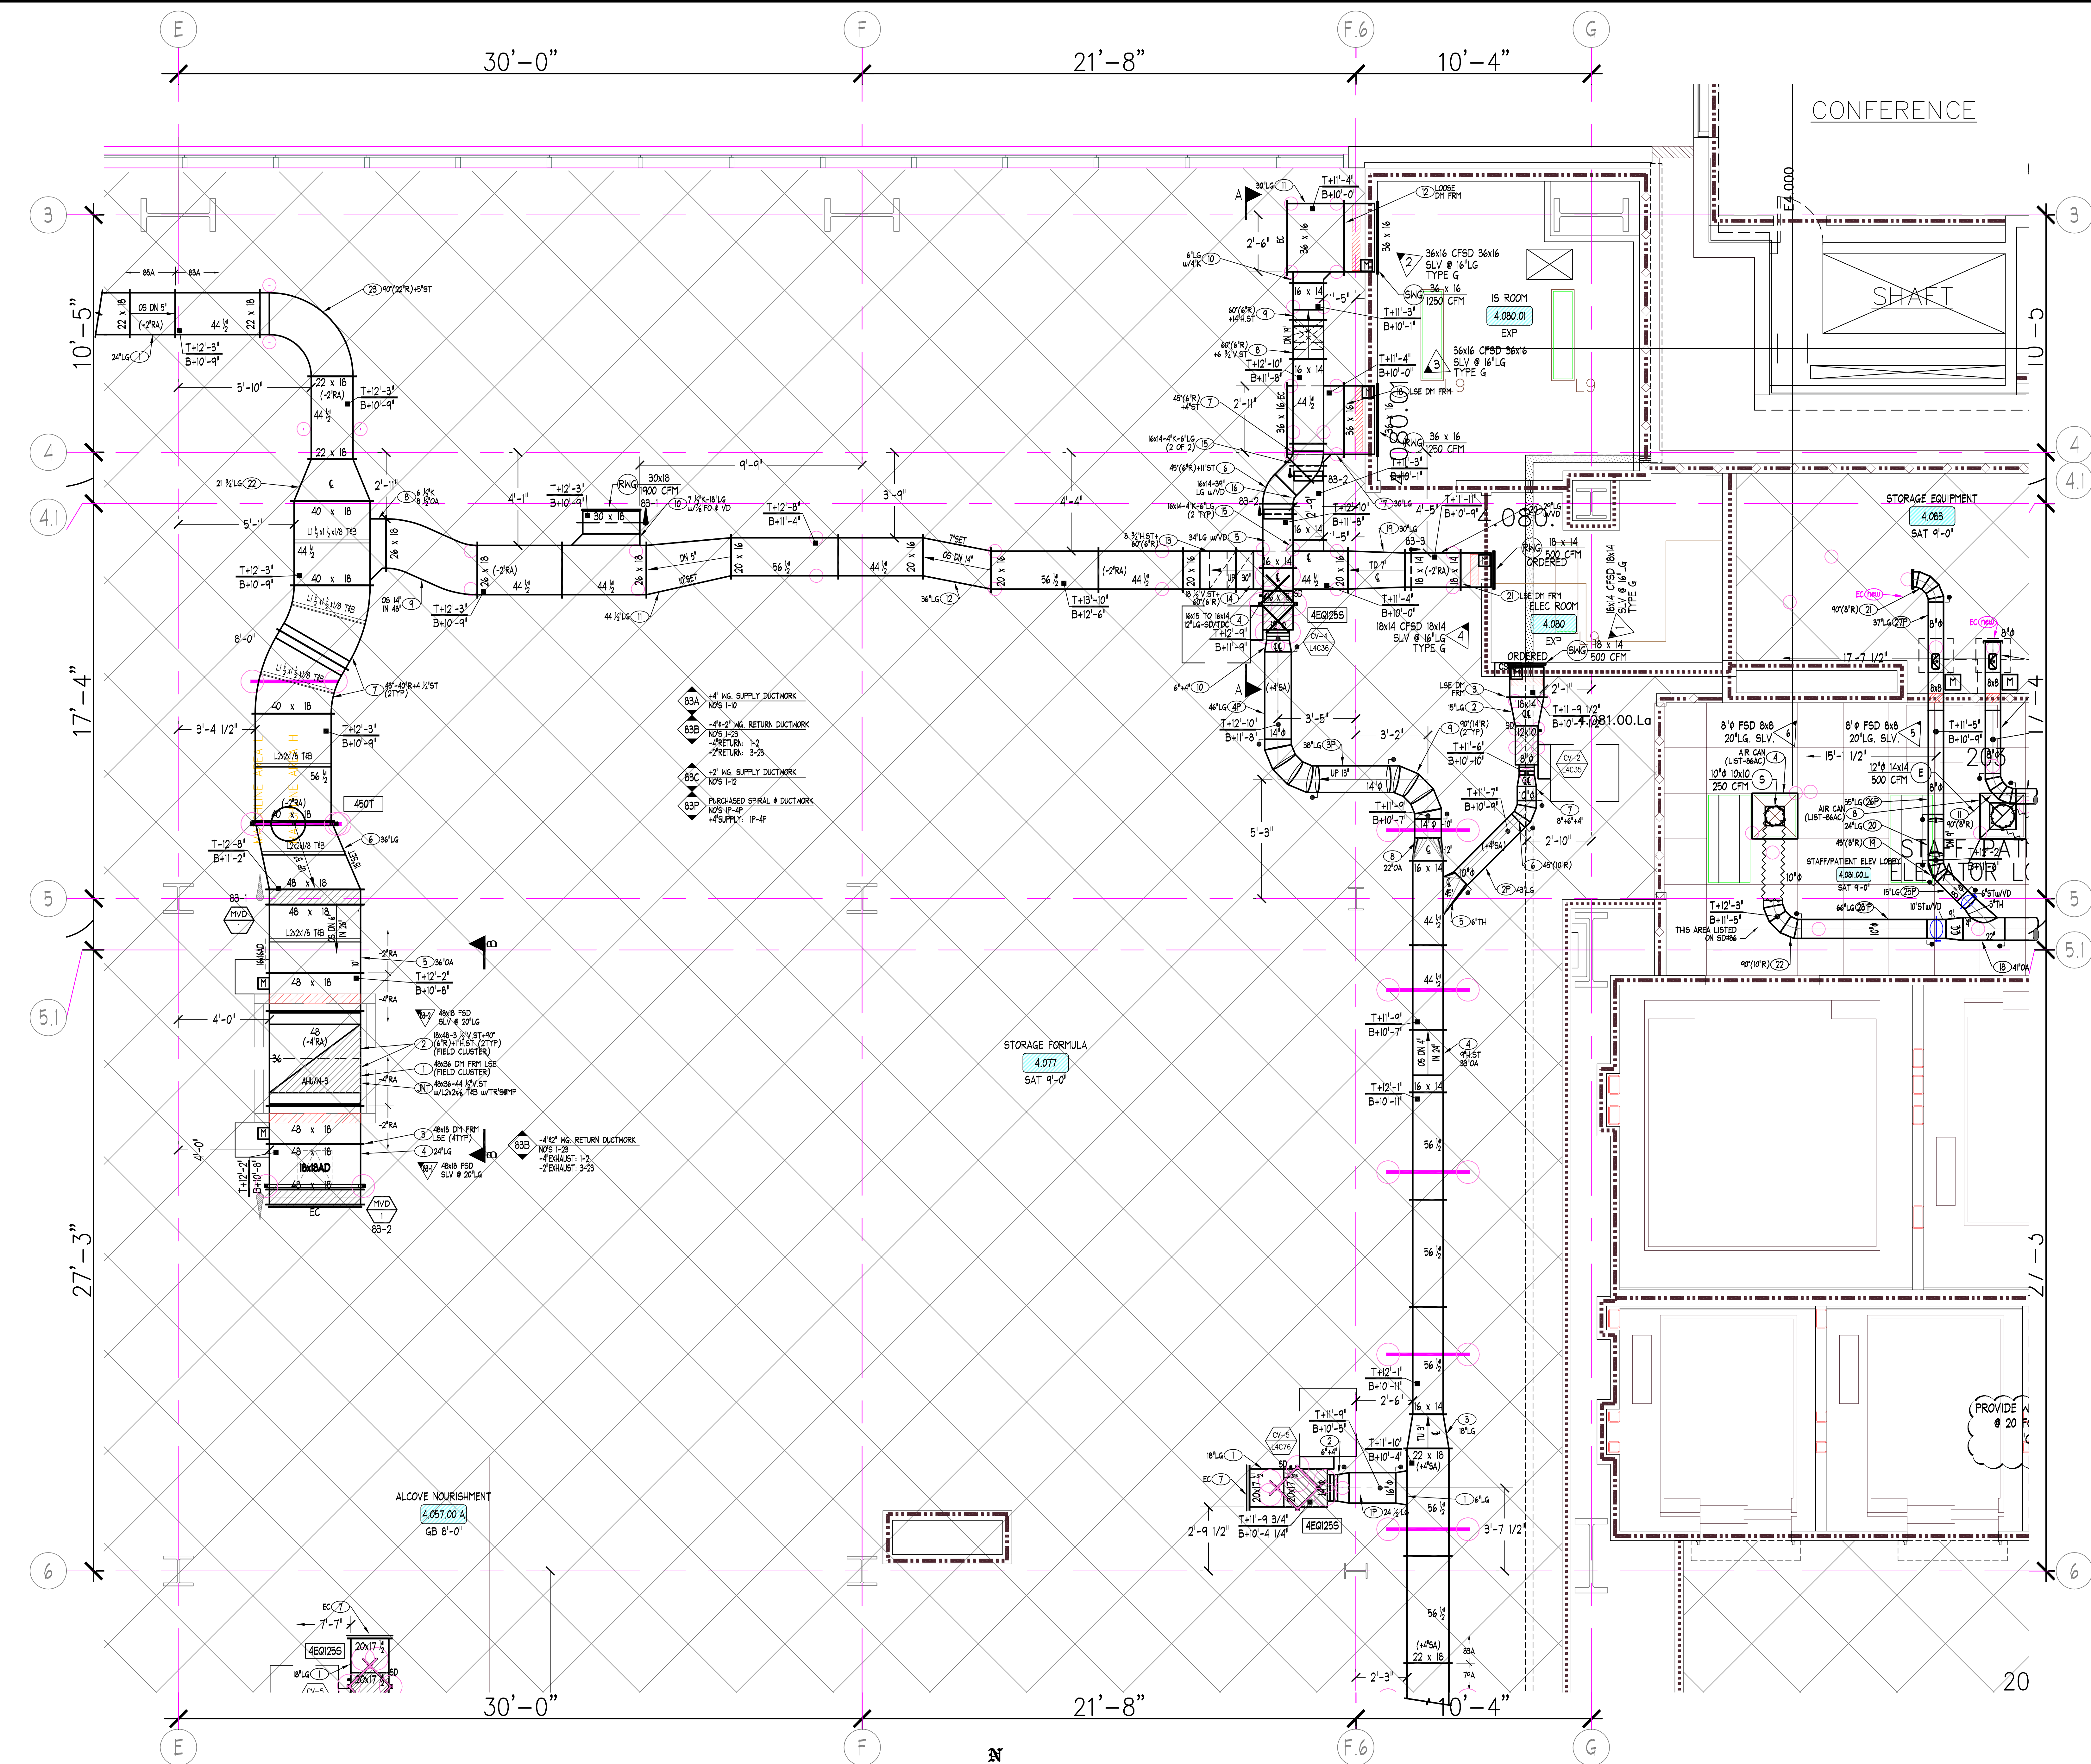

LEVEL FOUR - NORTH WEST
FINISHED FLOOR ELEVATION +48'-0" (U.N.O.)
TOP OF STEEL ELEVATION +44'-5 3/4" (U.N.O.)

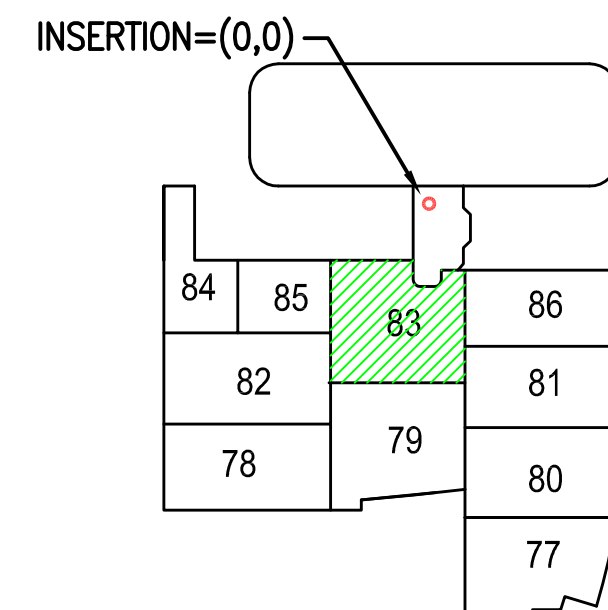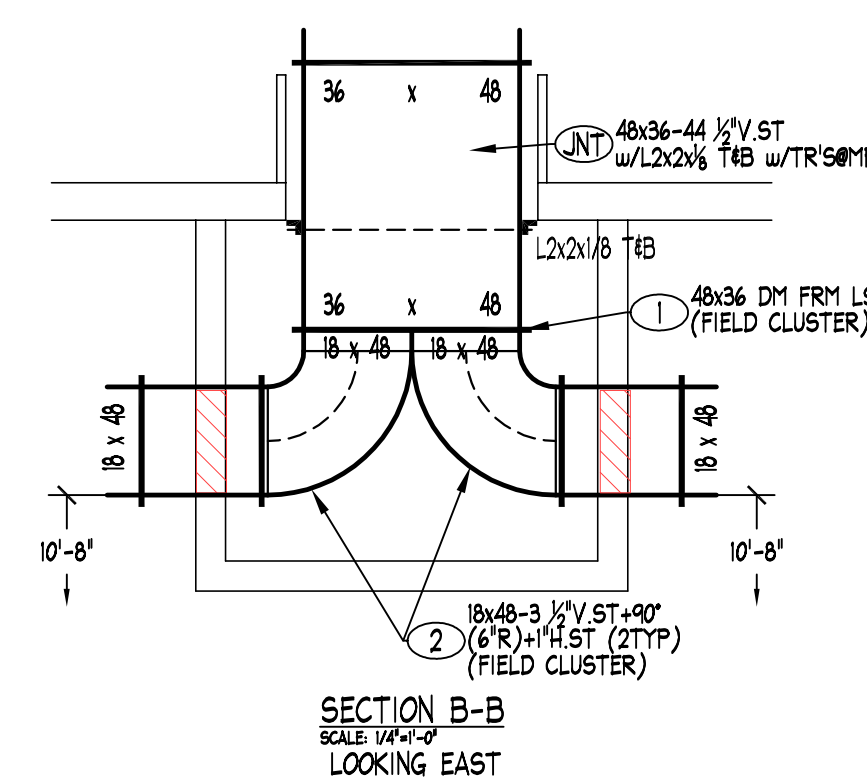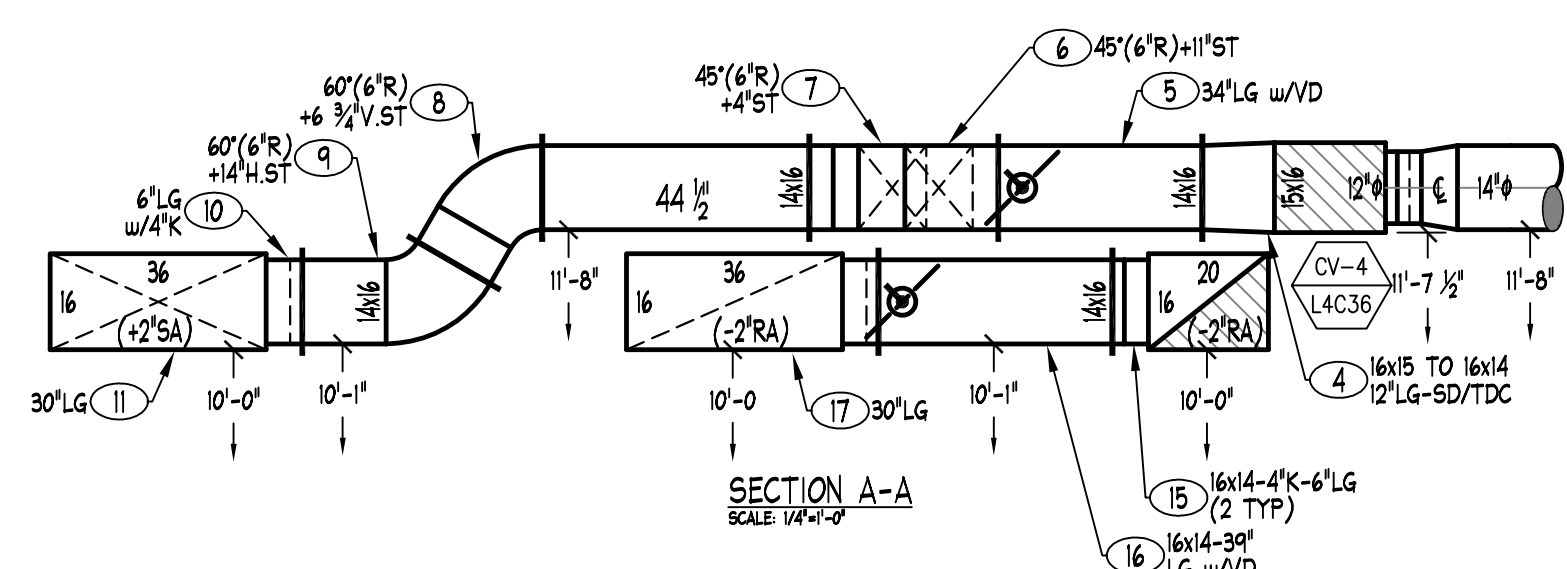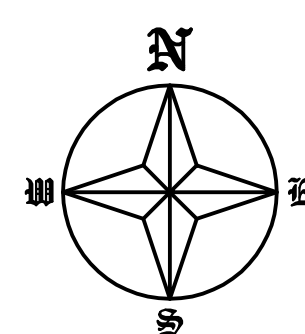


NOTES	
1. EXISTING AIRWAYS ON THE DRAWING ARE TO BE DUCT BODY. ALUMINUM MUST BE INSULATED AND DUCT INSULATION WHEN COORDINATING ELEVATIONS.	
ABBREVIATIONS	
3 & 4 DUCT CONNECTION	5 & 6 D
SPRINKLER FITTING	5 & 7
DUCT INSULATION	5 & 8
DUCT PRESSURE	5 & 9
DUCT	5 & 10
TRANSVERSE DUCT CONNECTION	5 & 11
TRANSVERSE DUCT CONNECTION	5 & 12
TRANSVERSE DUCT CONNECTION	5 & 13
TRANSVERSE DUCT CONNECTION	5 & 100

SYMBOL LEGEND	
SYMBOL	DESCRIPTION
1	1" DUCT
2	2" DUCT
3	3" DUCT
4	4" DUCT
5	5" DUCT
6	6" DUCT
7	7" DUCT
8	8" DUCT
9	9" DUCT
10	10" DUCT
11	12" DUCT
12	14" DUCT
13	16" DUCT
14	18" DUCT
15	20" DUCT
16	24" DUCT
17	30" DUCT
18	36" DUCT
100	528" DUCT

HARRIS & HART INC.
1759 WEST 1200 SOUTH
ODGEN, UTAH. 84404
PHONE: (801) 731-0577
FAX NO: (801) 731-0580
WEBSITE: WWW.HARRIS-HART.COM
E-MAIL TO: DETAILING DEPARTMENT:
ttaylor@harris-hart.com

JOB NO: 9507	PAY ITEM: 83
PROJECT:	CHILDRENS HOSPITAL ORANGE, CA
TITLE:	LEVEL FOUR AREA H HVAC SYSTEM LAYOUT
REFERENCE DRAWINGS	ARCH: A3.40 STRUCT: S2.5A80 MECH: M3.4H
BY: BP	DRAWING NO:
DATE: 1-27-10	83 OF 115
SCALE: 3/8"=1'-0"	

"PROJECT RECORD DRAWING"

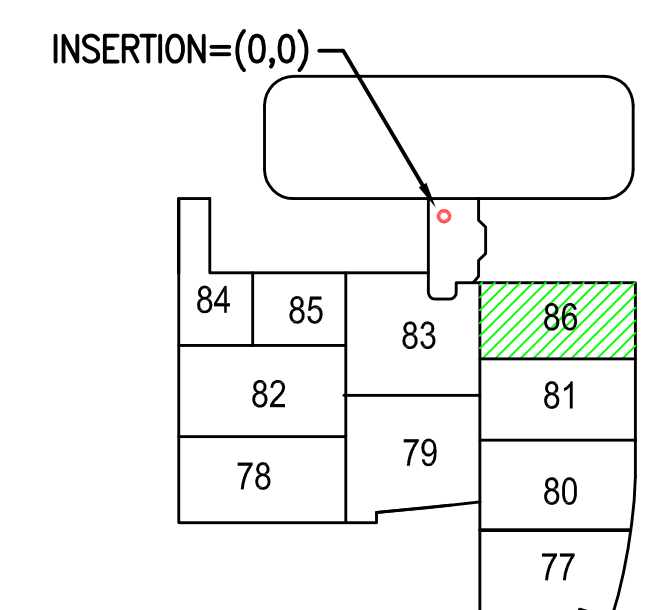 KEY PLAN

JOB NO: 9507		PAY ITEM: 86	
PROJECT:			
CHILDRENS HOSPITAL ORANGE, CA			
TITLE:			
LEVEL FOUR AREA M HVAC SYSTEM LAYOUT			
REFERENCE DRAWINGS		DRAWING NO.	
ARCH: A3.40		STRUCT: S2.546B MECH: M3.4M	
BY: BP		86 OF 115	
DATE:			