

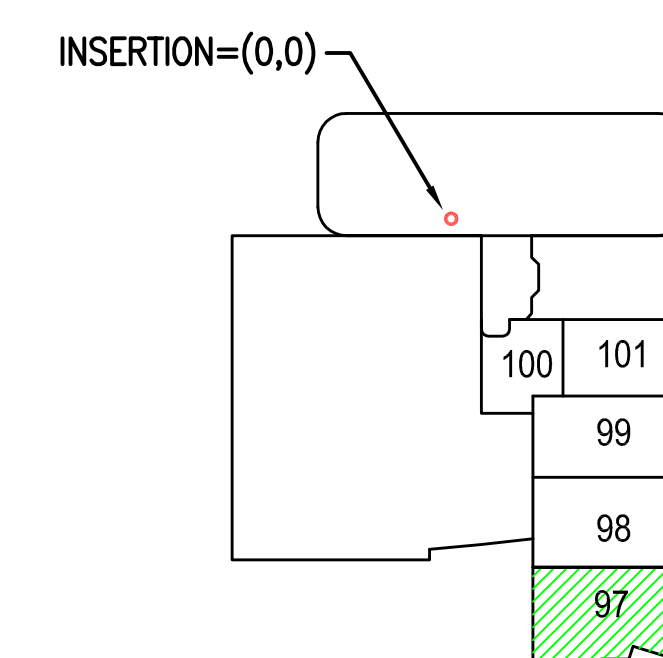


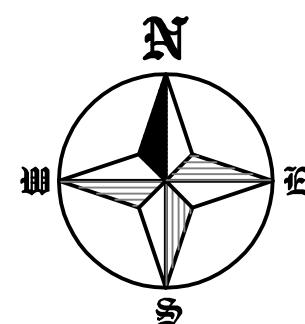


LEVEL SIX - SOUTH EAST
FINISHED FLOOR ELEVATION=95'-0" (U.N.O.)
TOP OF STEEL ELEVATION +14'-5 3/4" (U.N.O.)

JOB NO: 9507		PAY ITEM 97	
PROJECT: CHILDRENS HOSPITAL ORANGE, CA			
TITLE: LEVEL SIX AREA A HVAC SYSTEM LAYOUT			
REFERENCE: DRAWINGS ARCH-A3.6A		STRUCT- S2.7A MECH-M3.6A	
BY: BIP DATE: 1-27-10		DRAWING NO. 97 OF 115	
SCALE: 3/8"=1'-0"			

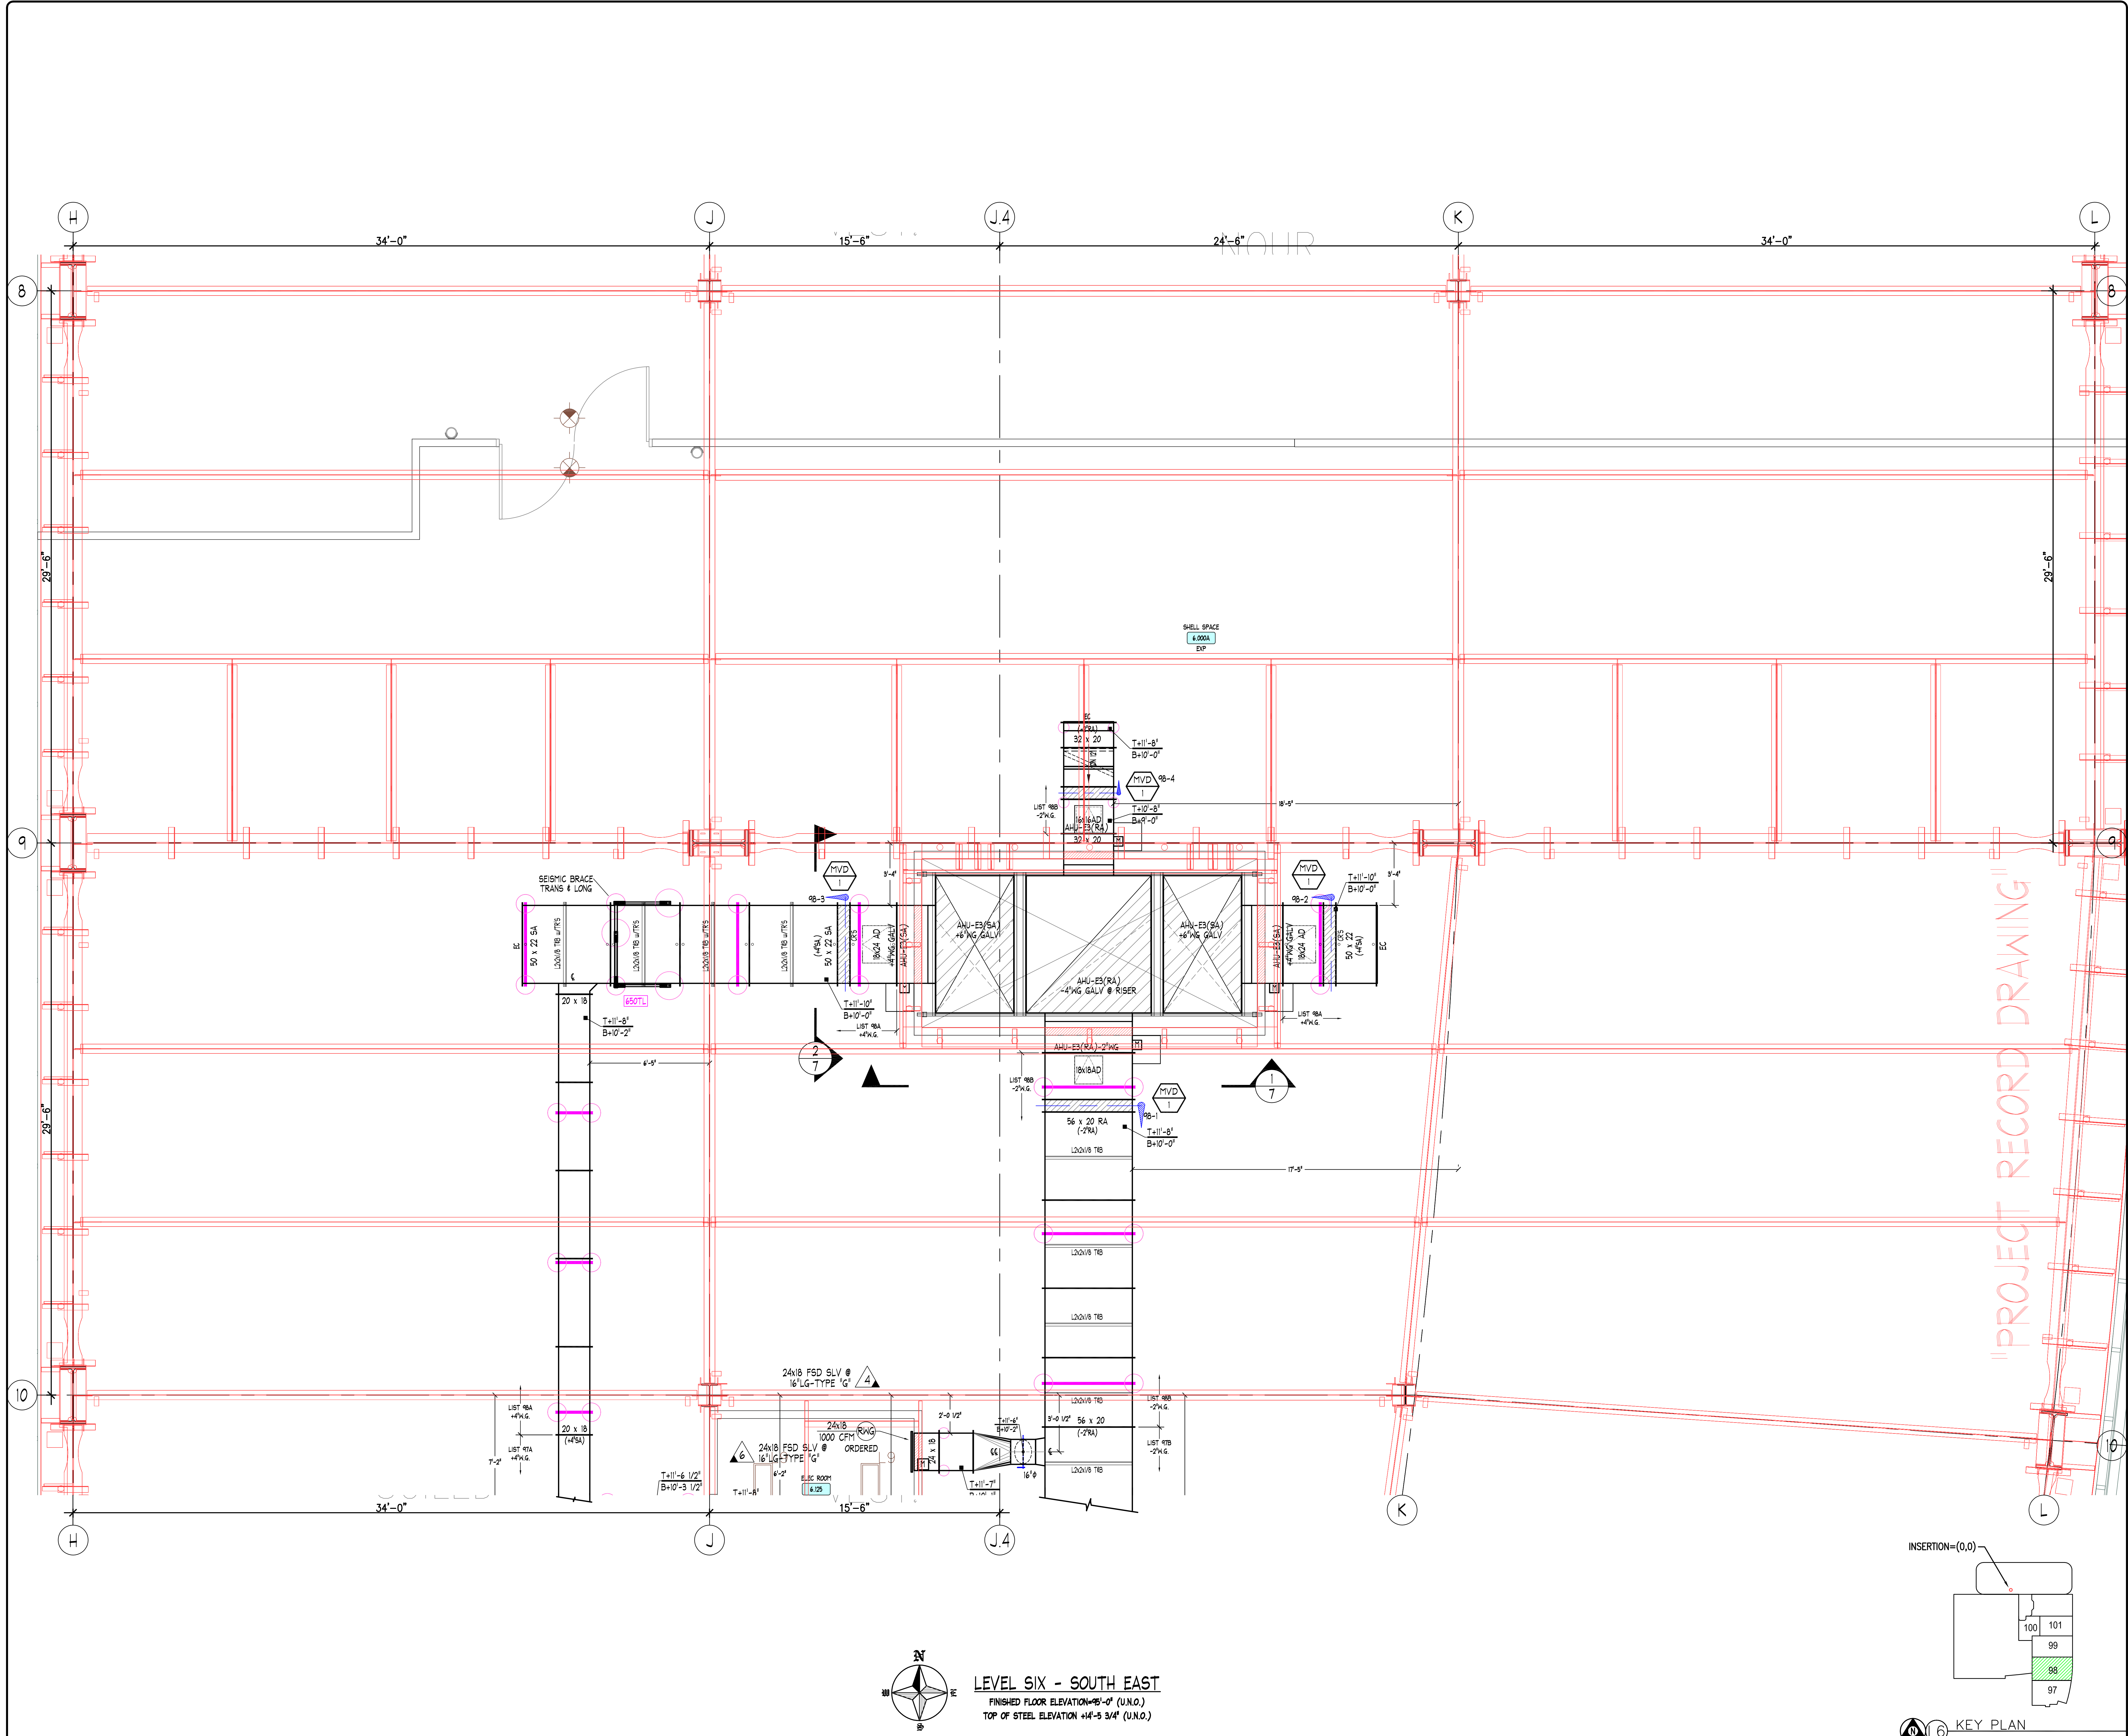

LEVEL SIX - SOUTH EAST
FINISHED FLOOR ELEVATION +0'-0" (U.N.O.)
TOP OF STEEL ELEVATION +4'-5 3/4" (U.N.O.)

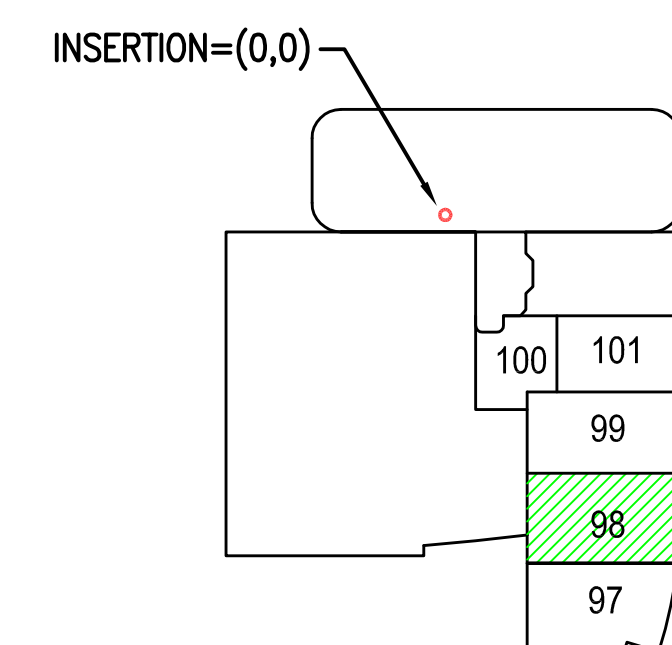

KEY PLAN

NOTES

1. ELEVATIONS INDICATED ON THIS DRAWING ARE TO THE FACE UNLESS OTHERWISE NOTED. ALL DIMENSIONS SHALL BE TO THE FACE UNLESS OTHERWISE NOTED. ALL DIMENSIONS SHALL BE TO THE FACE UNLESS OTHERWISE NOTED.

ABBREVIATIONS

SYMBOL	DESCRIPTION
1/2\"/>	

REVISIONS

DATE	NO.	DESCRIPTION
10-11-10	1	ISSUED FOR PERMIT
10-11-10	2	ISSUED FOR PERMIT
10-11-10	3	ISSUED FOR PERMIT

HARRIS & HART INC.

1759 WEST 1200 SOUTH
OGDEN, UTAH 84404
PHONE: (801) 731-0577
FAX: (801) 731-0580
WEBSITE: WWW.HARRIS-HART.COM
E-MAIL TO: DETAILING DEPARTMENT:
ttaylor@harris-hart.com

JOB NO: 9507

PKY ITEM: 98

PROJECT:
CHILDRENS HOSPITAL
ORANGE, CA

TITLE:
LEVEL SIX AREA F
HVAC SYSTEM LAYOUT

REFERENCE: DRAWINGS
ARCH: A3.6F STRUCT: S2.7A MECH: M3.6F
BY: BP DATE: 1-27-10 DRAWING NO:
98 OF 115
SCALE: 3/8\"/>

