
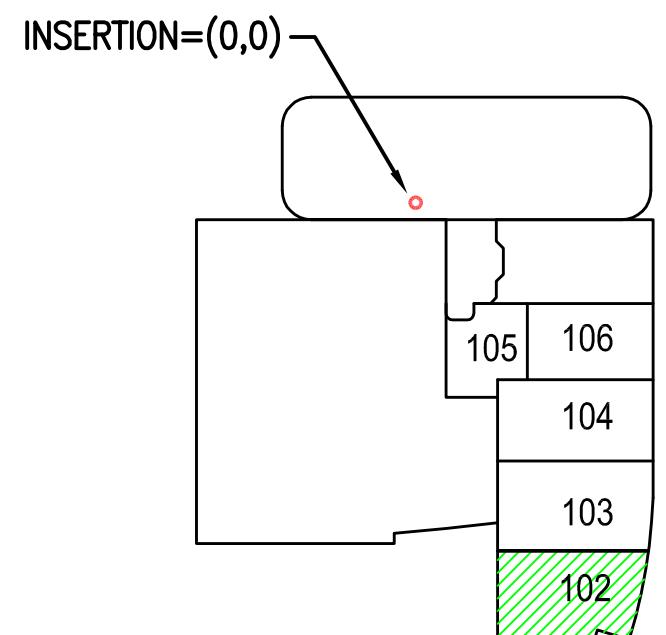
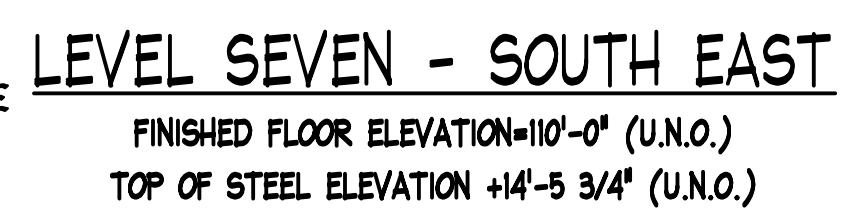
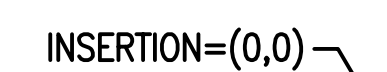


 KEY PLAN

HARRIS & HART INC.
1759 WEST 1200 SOUTH
OGDEN, UTAH. 84404
PHONE: (801) 731-0577
FAX NO: (801) 731-0580
WEBSITE: WWW.HARRIS-HART.COM
E-MAIL TO DETAILING DEPARTMENT:
tylador@harris-hart.com

JOB NO: 9507		PAY ITEM: 102	
PROJECT:			
CHILDRENS HOSPITAL ORANGE, CA			
TITLE:			
LEVEL SEVEN AREA A HVAC SYSTEM LAYOUT			
REFERENCE DRAWINGS			
ARCH:A3.7A		STRUCT: S2.8A	
MECH: M3.7A			
BY: J.L.		DRAWING NO.	
DATE: 1-27-10		102 OF 115	
SCALE: 3/8"=1'-0"			

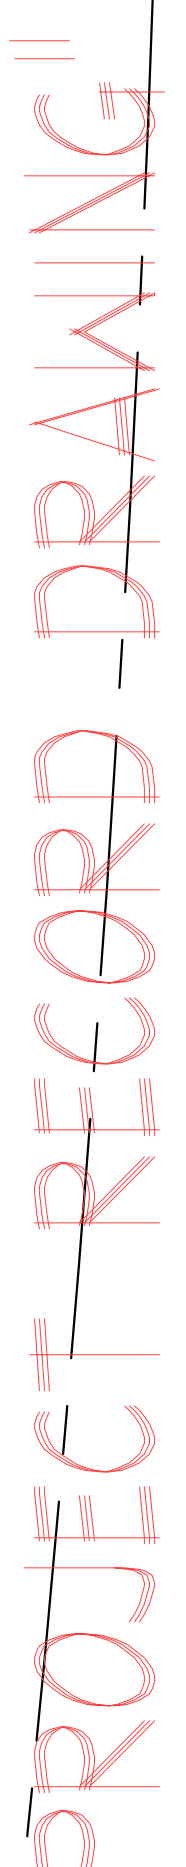




HARRIS & HART INC.
1759 WEST 1200 SOUTH
OGDEN, UTAH. 84404

PHONE: (801) 731-0577
FAX NO: (801) 731-0580

WEBSITE: WWW.HARRIS-HART.COM

E-MAIL TO DETAILING DEPARTMENT:
taylor@harris-hart.com

JOB NO: 9507		PAY ITEM: 103	
PROJECT: CHILDRENS HOSPITAL ORANGE, CA			
TITLE: LEVEL SEVEN AREA F HVAC SYSTEM LAYOUT			
REFERENCE: DRAWINGS			
ARCH: A3.7F		STRUCT: S2.8A MECH: M3.7F	
BY: T.L.		DRAWING NO.	
DATE: 1-27-10		103 OF 115	
SCALE: 3/8"=1'-0"			

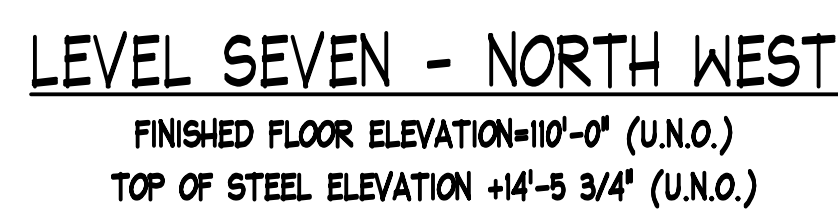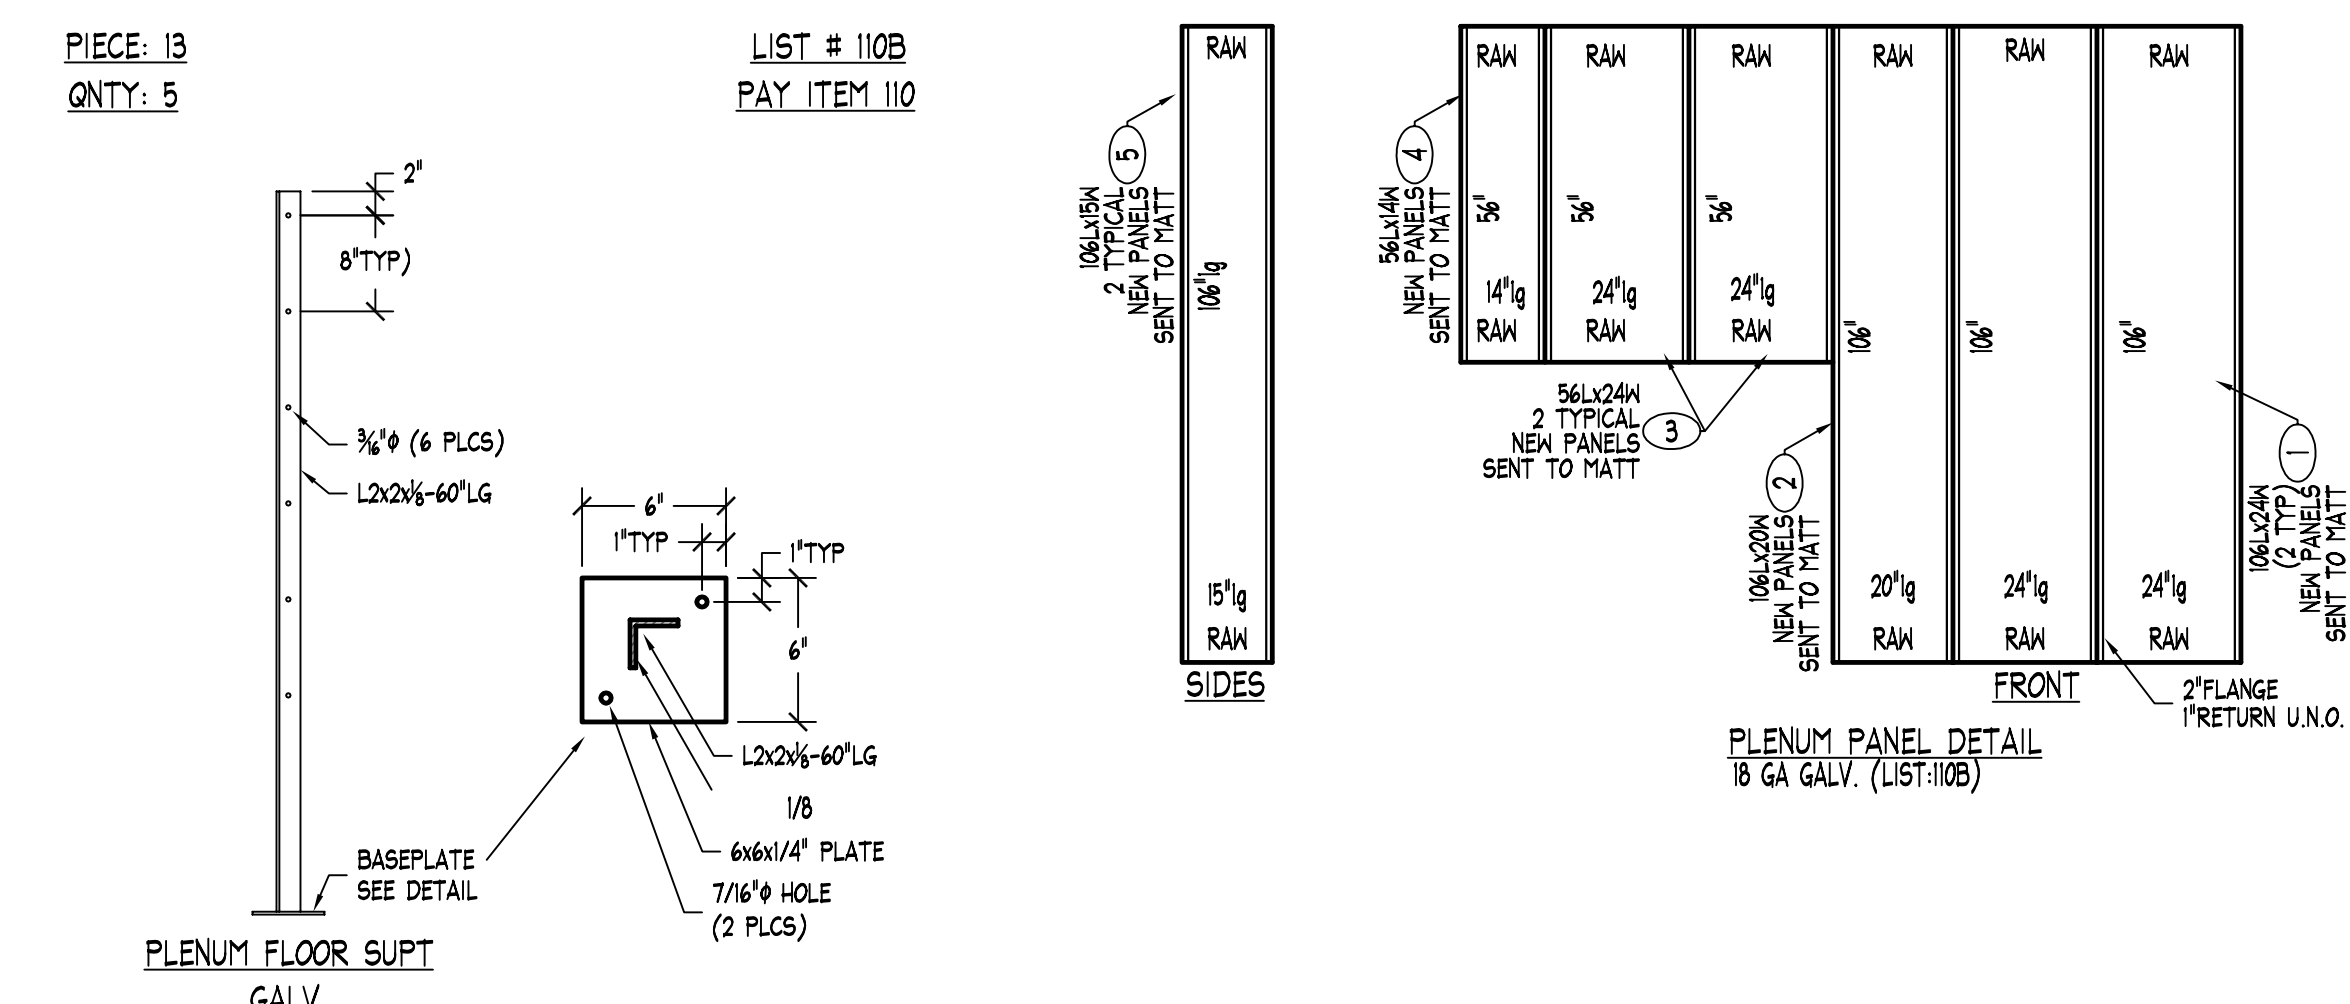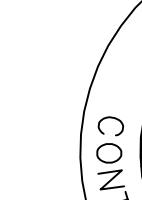 KEY PLAN


HARRIS & HART INC.
1759 WEST 1200 SOUTH
OGDEN, UTAH. 84404

PHONE: (801) 731-0577
FAX NO: (801) 731-0580

WEBSITE: WWW.HARRIS-HART.COM

E-MAIL TO DETAILING DEPARTMENT:
ttaylor@harris-hart.com

JOB NO: 9507		PAY ITEM: 105	
PROJECT: CHILDRENS HOSPITAL ORANGE, CA			
TITLE: LEVEL SEVEN AREA H HVAC SYSTEM LAYOUT			
REFERENCE: DRAWINGS ARCH-A3.7H		STRUCT: S2.8D MECH: M3.7H	
BY: T.L. DATE: 1-27-10 SCALE: 3/8"=1'-0"		DRAWING NO. 105 OF 115	

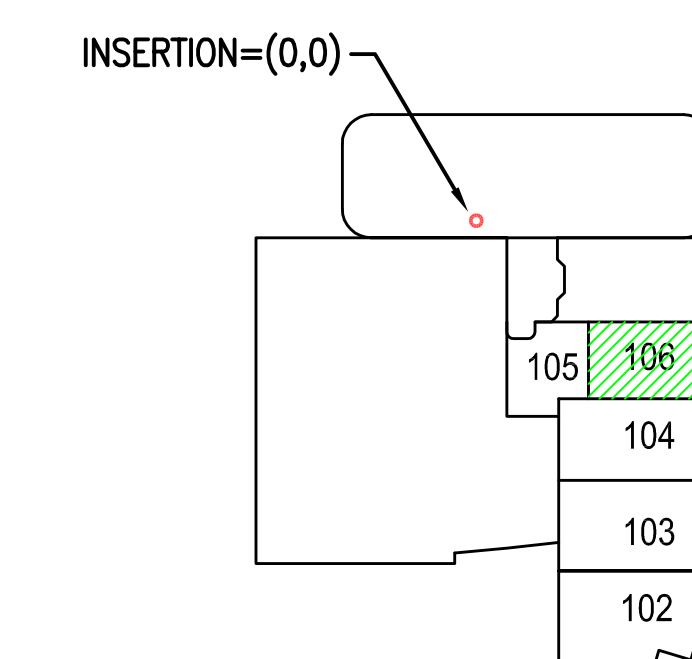

 17 KEY PLAN

JOB NO: 9507		PAY ITEM: 106
PROJECT: CHILDRENS HOSPITAL ORANGE, CA		
TITLE: LEVEL SEVEN AREA M HVAC SYSTEM LAYOUT		
REFERENCE: DRAWINGS ARCH: A3.7M STRUCT: S2.8D MECH: M3.7M		
BY: T.L.	DRAWING NO.	
DATE: 1-27-10	106 OF 115	
SCALE: 1/8"=1'-0"		