





JOB NO: 9507		PAY ITEM: 112	
PROJECT: CHILDRENS HOSPITAL ORANGE, CA			
TITLE: PENTHOUSE LEVEL 2 AREA A HVAC SYSTEM LAYOUT			
REFERENCE DRAWINGS ARCH:A3.90 STRUCT: 52.10&BMECH: M3.9A			
BY: DATE: 1-27-10		DRAWING NO. 112 OF 115	
SCALE: 3/8"=1'-0"			

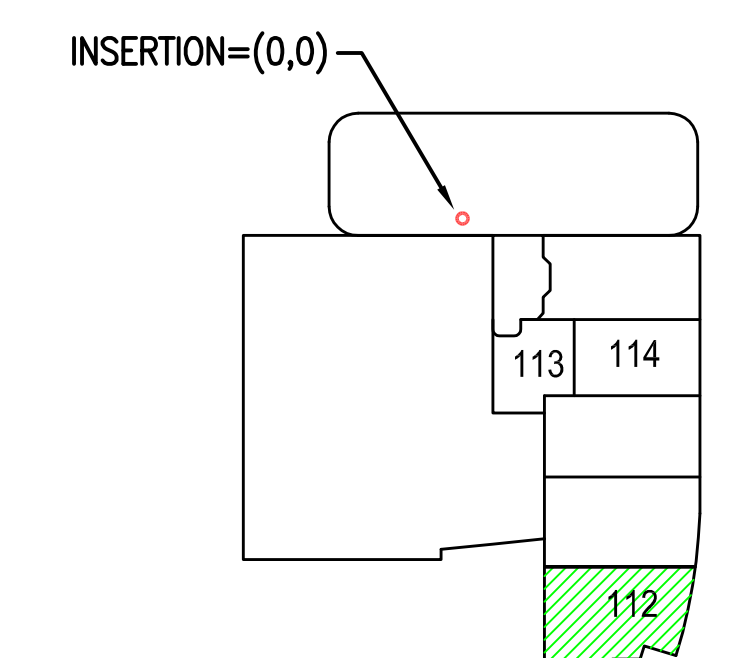

PROJECT RECORD DRAWING

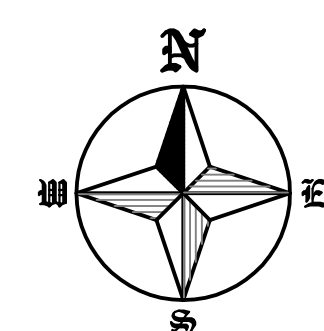

JOB NO: 9507		PAY ITEM: 114	
PROJECT: CHILDRENS HOSPITAL ORANGE, CA			
TITLE: PENTHOUSE LEVEL 2 AREA M HVAC SYSTEM LAYOUT			
REFERENCE: DRAWINGS ARCH-A3.90 STRUCT: S2.10M&MECH-M3.9M			
BY: DATE:		DRAWING NO. 114 OF 115	
SCALE: 3/8"=1'-0"			