

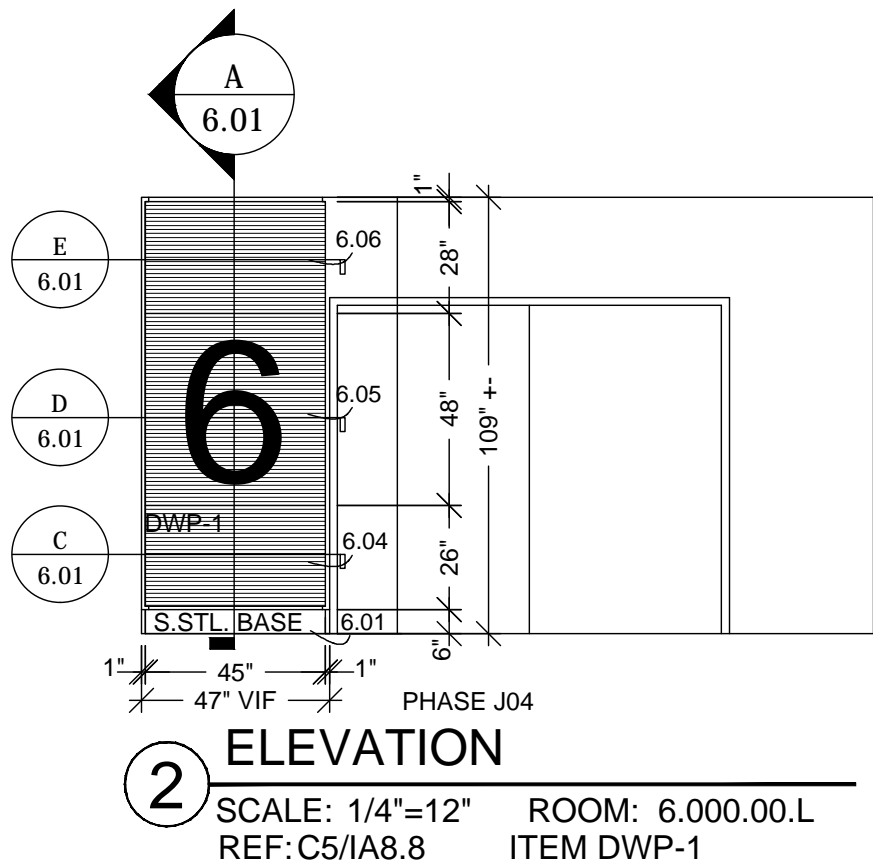
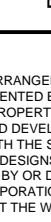


1 FLOOR PLAN
SCALE: 1/4"=12" ROOM: 6,000.00.L
REF: IA5.6D ITEM DWP-1

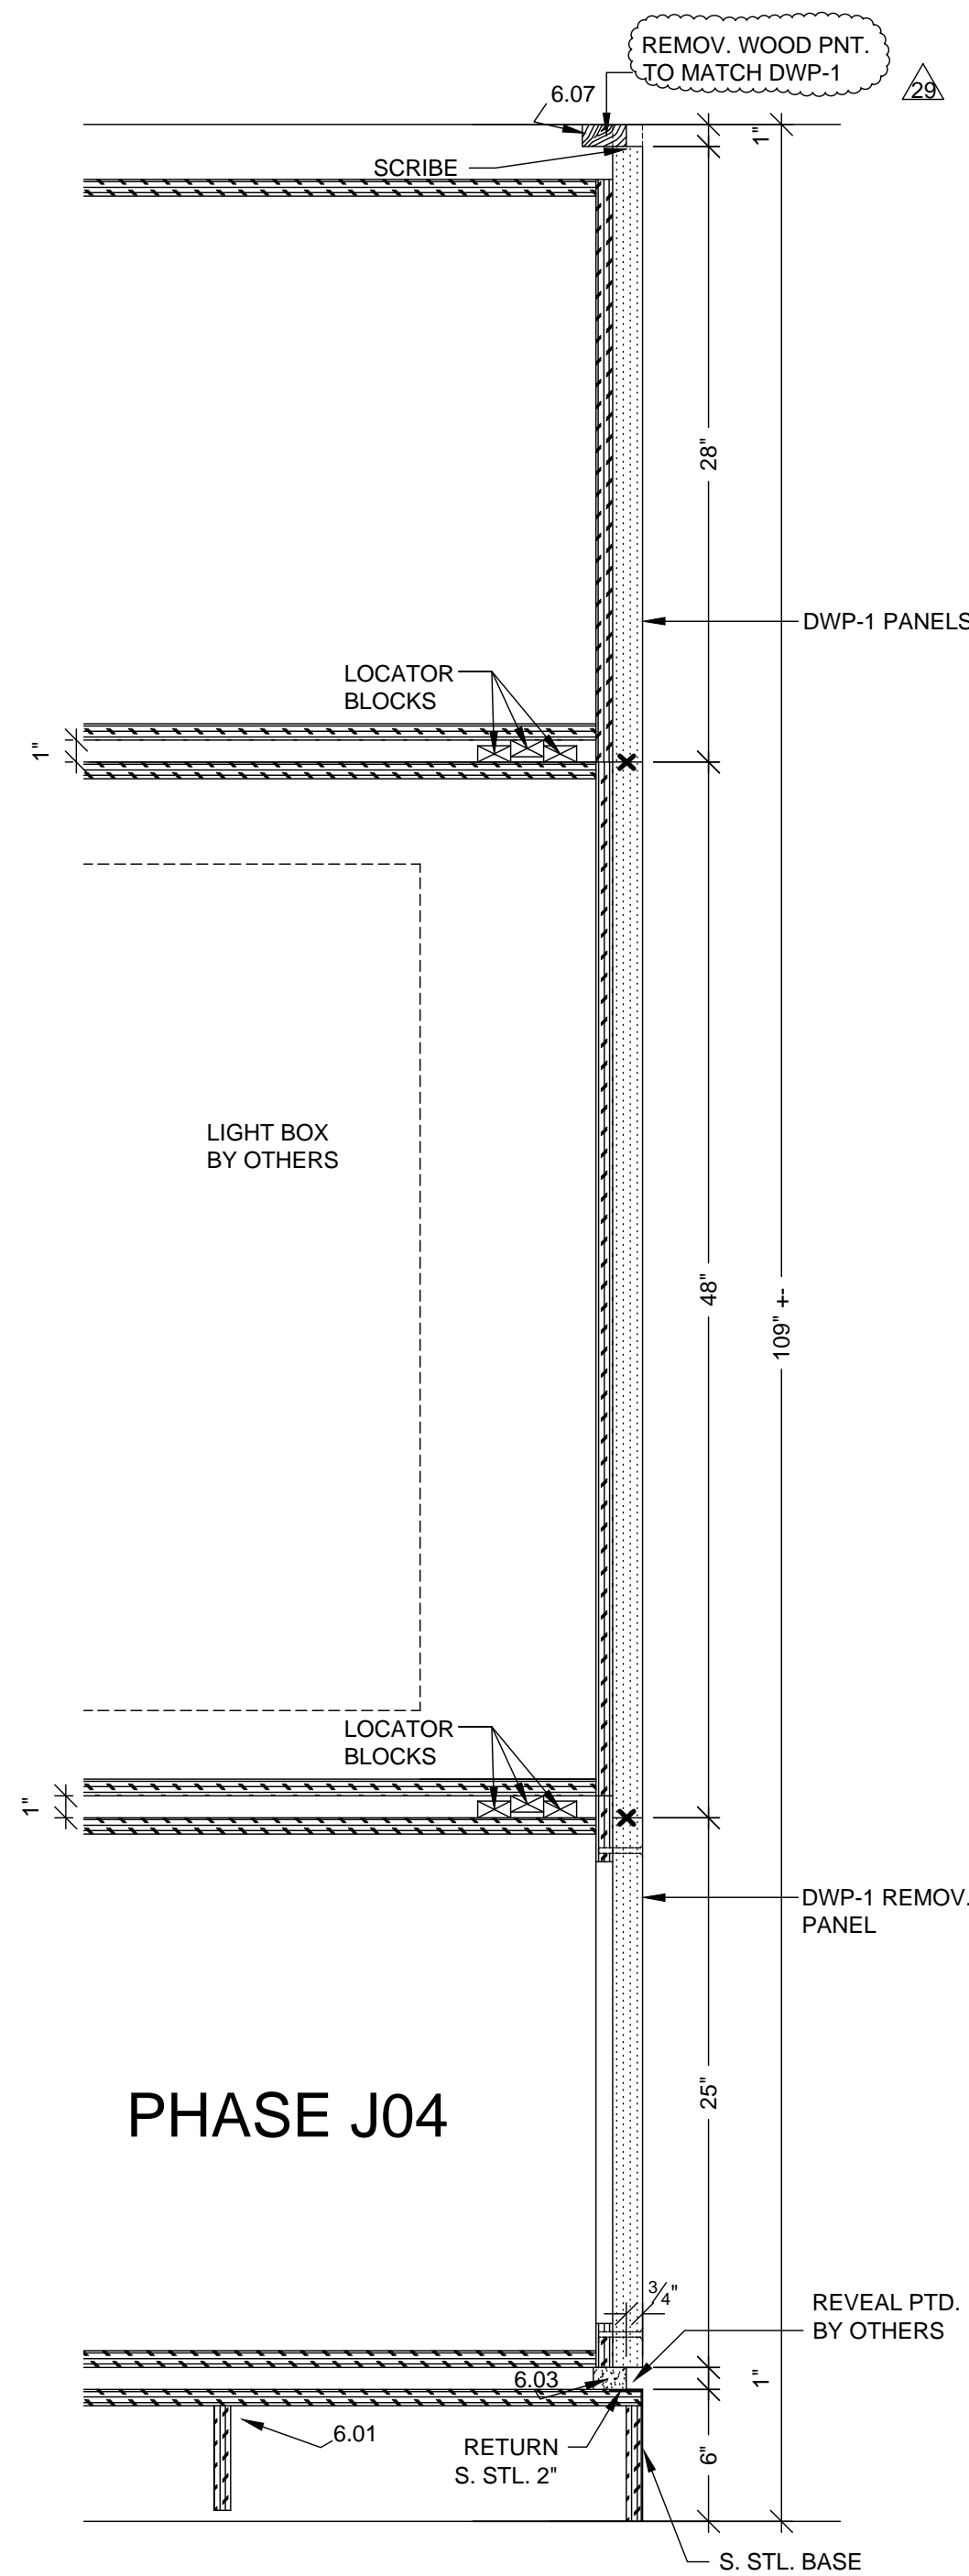


MCCARTHY APPROVAL	
A. Approved as noted for Subcontract Review	<input type="checkbox"/>
B. Review and Resubmit	<input type="checkbox"/>
C. Rejected	<input type="checkbox"/>
This review is for general conformance with Plans and Specifications only. Any deviations from same, not clearly noted by the Preparer have not been reviewed. Review shall not constitute a complete check of detailed dimensions or count to serve to relieve the Preparer of contractual responsibility for any error or deviation from contract requirements.	
McCarthy	
By _____ Date _____	
SHOP DRAWING REFERENCE NO. _____	

PROJECT : CHOC HOSPITAL TOWER II		NO.		DATE		BY	
455 S. MAIN STREET ORANGE, CALIFORNIA 92668		20		12-6-11		JB	
FLOOR: SIXTH		21				35	
ROOM: 6,000.00.L		22					
ITEM: ELEVATOR WALL PANELS		23					
REF : IA5.6D, IA7, 1/IA8.8		24					
ARCHITECT : FKP		25					
CONTRACTOR : MCCARTHY		26					
COPYRIGHT		27					
FIELD VERIFICATION		28					
P.A.M. SHOP DRAWINGS ARE MADE FOR THE EXCLUSIVE USE OF P.A.M. AND ANY OTHER TRADES USING THESE DRAWINGS. USE THEM AT THEIR OWN RISK. CHANGES ON THESE DRAWINGS MAY NOT BE ALWAYS NOTED. FIELD CONDITIONS MAY REQUIRE CHANGES IN DRAWINGS. SO OTHER TRADES USING THESE DRAWINGS MUST TAKE THEIR OWN FIELD DIMENSIONS.		29					
		30					
DATE: 12-6-11		31					
DRAWN BY: JB		32					
JOB: 3635		33					
DWG: 6.00		34					
J04		35					
		36					
		37					
		38					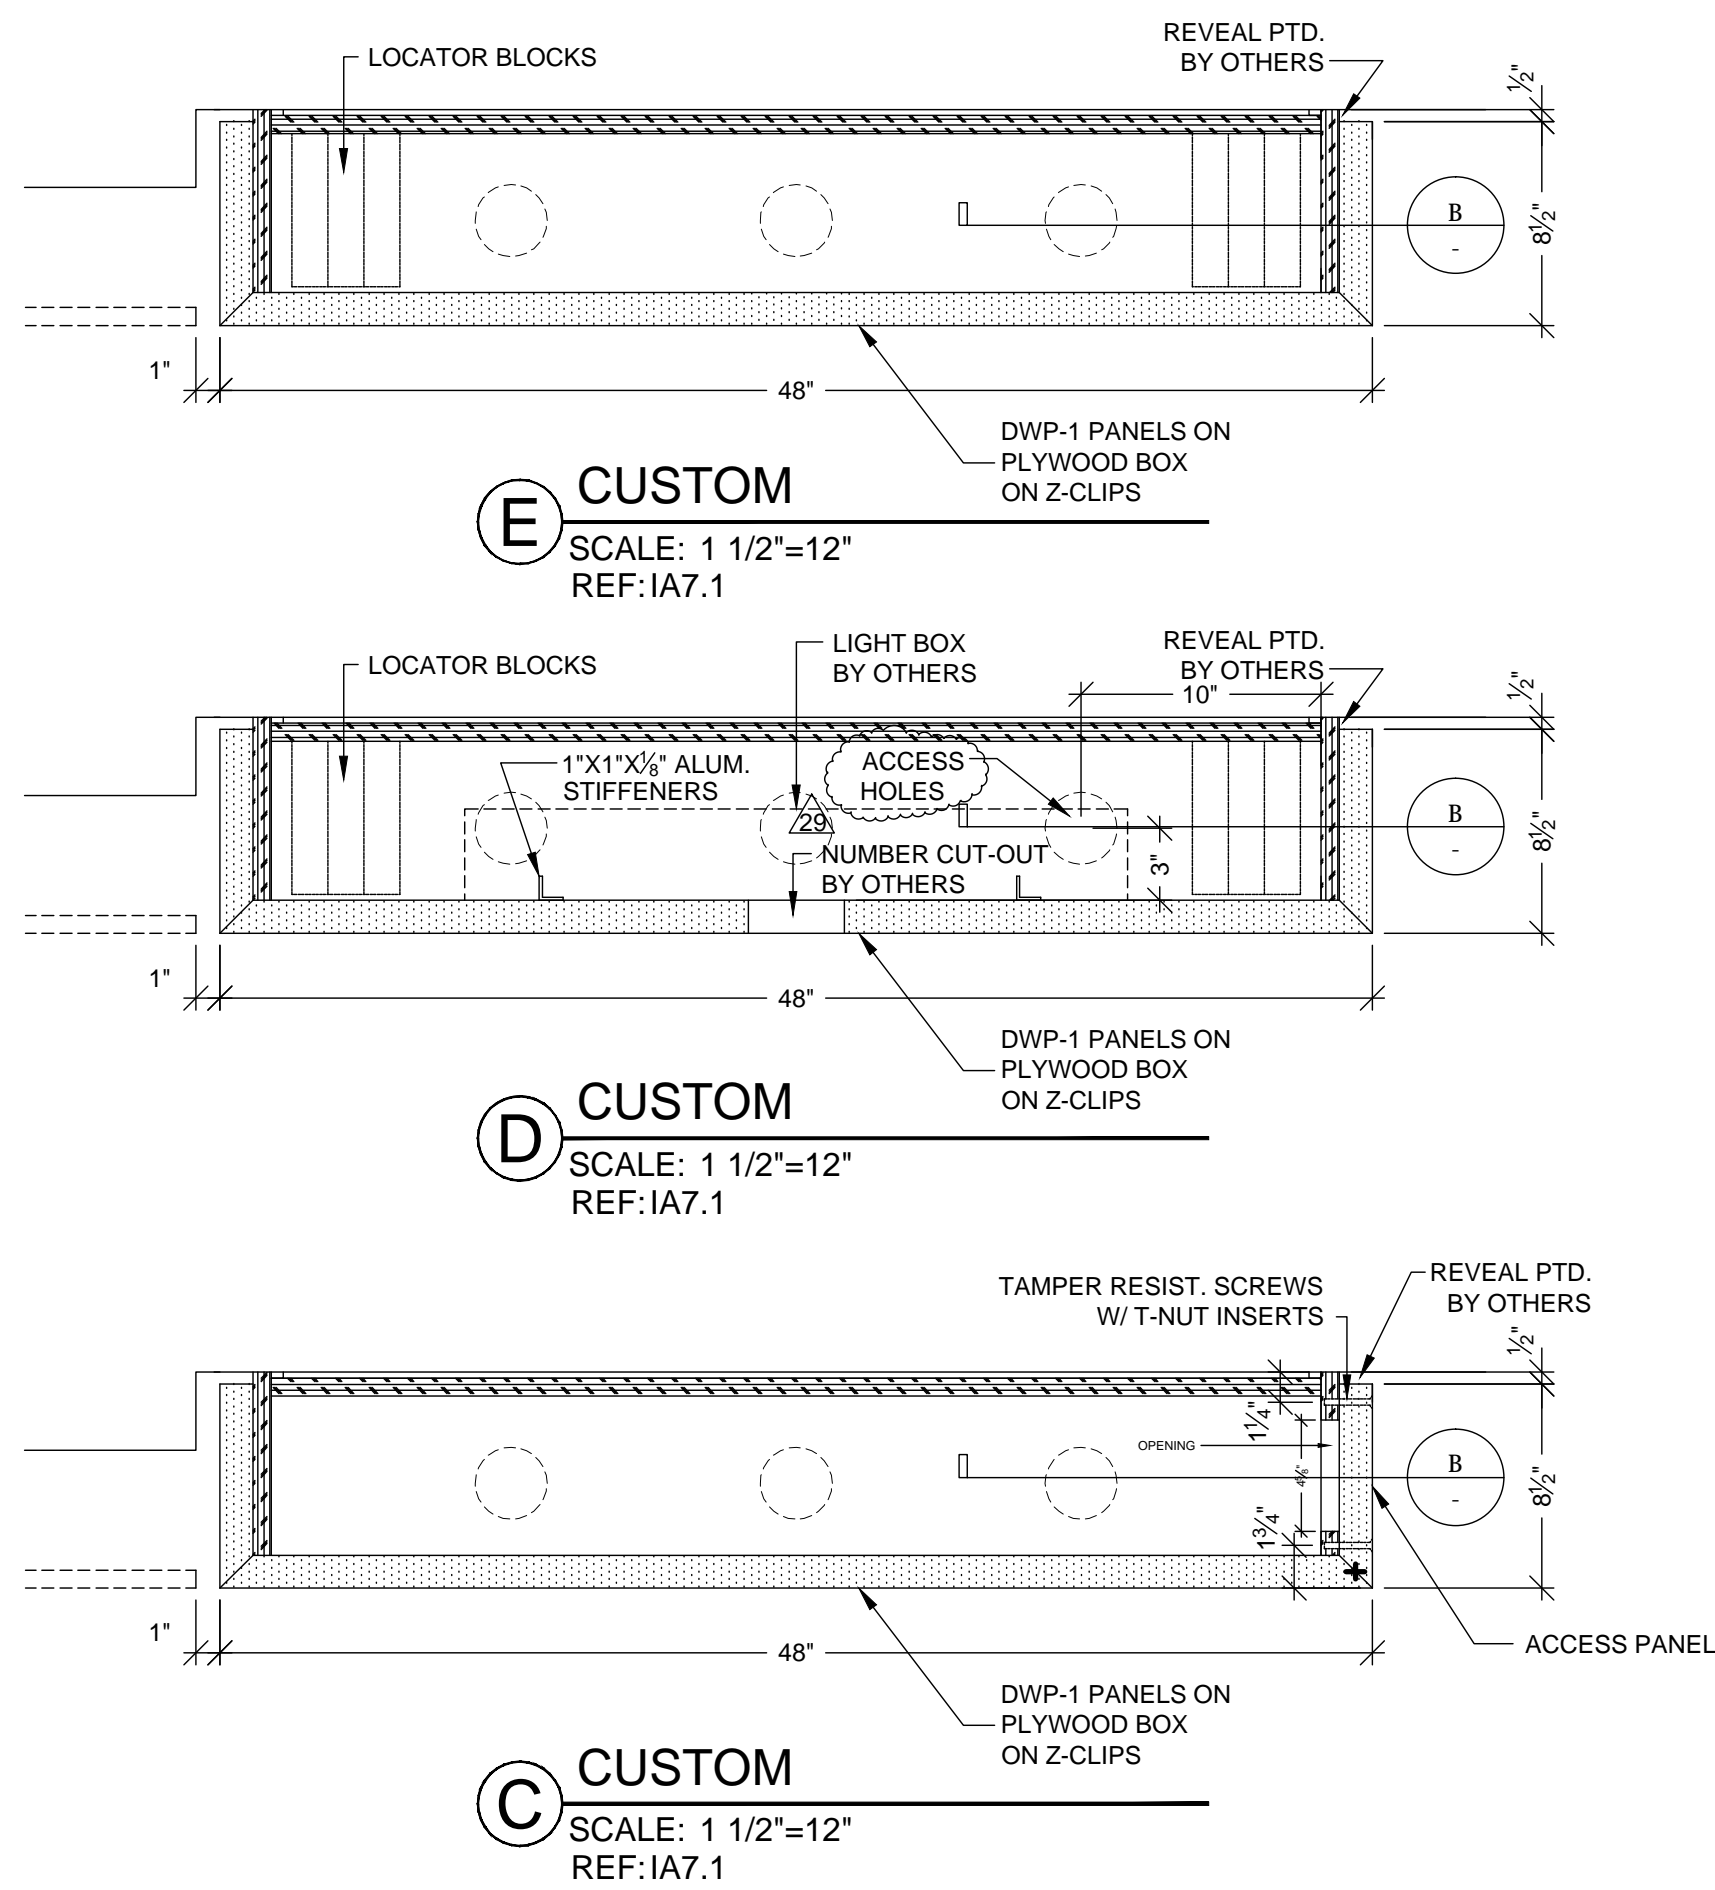
B CUSTOM
SCALE: 1 1/2"=12"
REF: NONE

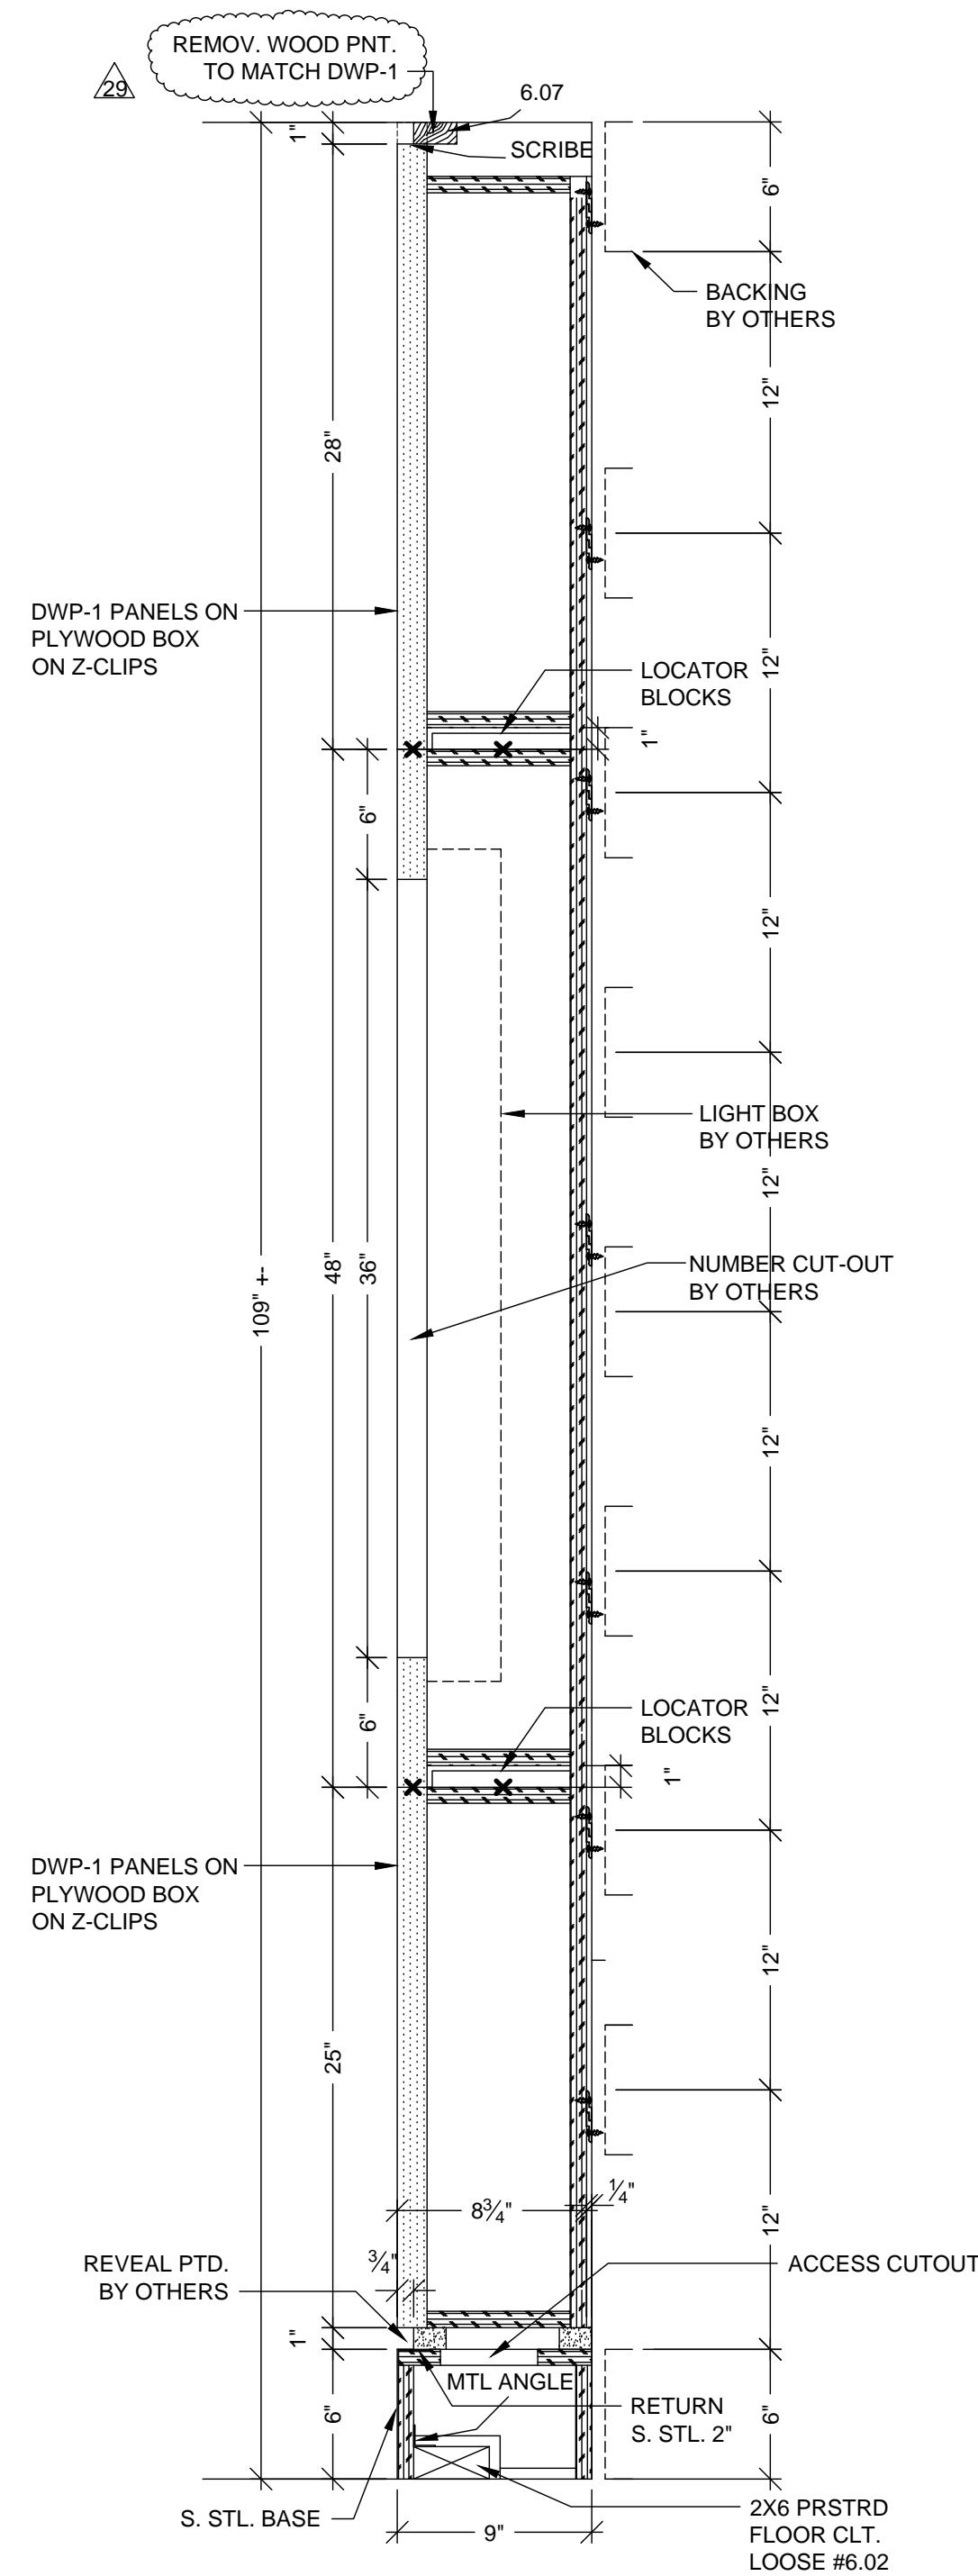

A CUSTOM
SCALE: 1 1/2"=12"
REF: NONE

MCCARTHY APPROVAL	
A. Approved as noted for Subcontract Review	<input type="checkbox"/>
B. Review and Rebuild	<input type="checkbox"/>
C. Rebuild	<input type="checkbox"/>
This review is for general conformance with Plans and Specifications only. Any deviations from same not clearly noted by the Preparer have not been reviewed. Review shall not constitute a complete check of detailed dimensions or count to serve to relieve the Preparer of contractual responsibility for any error or deviation from contract requirements.	
McCarthy	
By _____ Date _____	
SHOP DRAWING REFERENCE NO. _____	

PROJECT : CHOC HOSPITAL TOWER II		CONTRACTOR : MCCARTHY	
FLOOR: SIXTH		ARCHITECT : FKP	
ROOM: 6000.00.L		ITEM: DWP-1	
ITEM: ELEVATOR WALL PANELS		REF: IA5.6D IA7.1 IA8.8	
COPYRIGHT		FIELD VERIFICATION	
ALL DESIGN, CONSTRUCTION, ARRANGEMENTS AND PLANS NOTED OR REPRESENTED BY THIS DRAWING ARE OWNED BY AND THE PROPERTY OF P.A.M. AND WERE CREATED, DESIGNED AND DEVELOPED FOR USE OF P.A.M. AND IN CONNECTION WITH THE SPECIFIED PROJECT. NONE OF SUCH DESIGN, CONSTRUCTION, ARRANGEMENTS OR PLANS SHALL BE USED BY OR DISCLOSED TO ANY PERSON, FIRM OR CORPORATION FOR ANY PURPOSE WHATSOEVER WITHOUT THE WRITTEN PERMISSION OF P.A.M.		P.A.M. SHOP DRAWINGS ARE MADE FOR THE EXCLUSIVE USE OF P.A.M. AND ANY OTHER TRADES USING THESE DRAWINGS USE THEM AT THEIR OWN RISK. CHECKING ON THESE DRAWINGS MAY NOT BE ALWAYS NOTED. FIELD CHECKING MAY REQUIRE CHANGES IN DRAWINGS. SO OTHER TRADES USING THESE DRAWINGS MUST TAKE THEIR OWN FIELD DIMENSIONS.	
PACIFIC ARCHITECTURAL MILLWORK		P.A.M. SHOP DRAWINGS ARE MADE FOR THE EXCLUSIVE USE OF P.A.M. AND ANY OTHER TRADES USING THESE DRAWINGS USE THEM AT THEIR OWN RISK. CHECKING ON THESE DRAWINGS MAY NOT BE ALWAYS NOTED. FIELD CHECKING MAY REQUIRE CHANGES IN DRAWINGS. SO OTHER TRADES USING THESE DRAWINGS MUST TAKE THEIR OWN FIELD DIMENSIONS.	
1041 LESLIE ST. LA HABRA, CA 90631		PH: (714) 525-2059 FAX: (714) 525-2673	
DATE: 12-6-11		SCALE: NOTED	
DRAWN BY: JB		SUBMITTAL: 35	
JOB: 3635		DWG: 6.01	
J04			

NO.	DATE	BY	REVISION
28	12-6-11	JB	PER REF IA4.09
29	1-10-12	JB	PER RLC DATED 12-19-11
3			
4			
5			
6	3-14-2012	JJA	J04 RELEASED TO SHOP PER APPROVED DRAWINGS & FD