





1 FLOOR PLAN
SCALE: 1/4"=12" ROOM: 7,000.00.L
REF: IA5.7D ITEM DWP-1

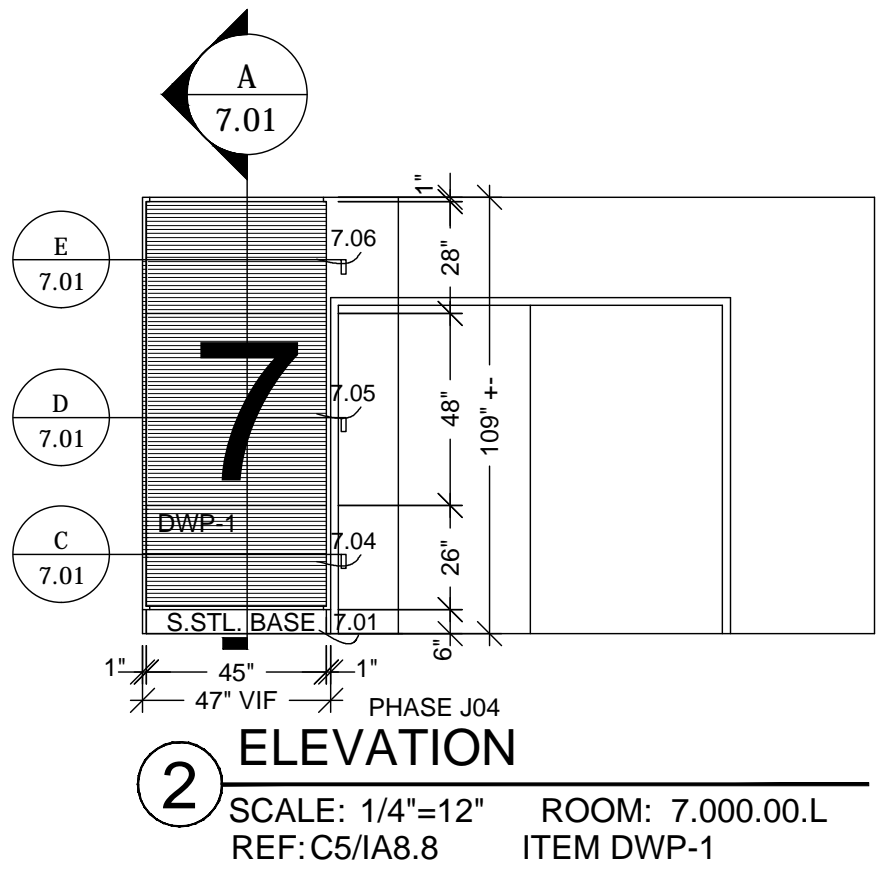

2 ELEVATION
SCALE: 1/4"=12" ROOM: 7,000.00.L
REF: C5/IA8.8 ITEM DWP-1

| | |
|---|--------------------------|
| MCCARTHY APPROVAL | |
| A. Approved as noted for Architectural Review | <input type="checkbox"/> |
| B. Review and Resubmit | <input type="checkbox"/> |
| C. Rejected | <input type="checkbox"/> |
| This review is for general conformance with Plans and Specifications only. Any deviations from same, not clearly noted by the Preparer have not been reviewed. Review shall not constitute a complete check of detailed dimensions or count to serve to relieve the Preparer of contractual responsibility for any error or deviation from contract requirements. | |
| McCarthy | |
| By _____ Date _____ | |
| SHOP DRAWING REFERENCE NO. _____ | |

| | | | | | |
|--|--|----|--|---------|----|
| PROJECT : | | NO | | DATE | BY |
| CHOC HOSPITAL TOWER II | | 20 | | 12-6-11 | JB |
| ITEM: DWP-1 | | 21 | | | |
| ITEM: ELEVATOR WALL PANELS | | 22 | | | |
| REF : IA5.7D,IA7,1/IA8.8 | | 23 | | | |
| ARCHITECT : | | 24 | | | |
| FKP | | 25 | | | |
| CONTRACTOR : | | 26 | | | |
| MCCARTHY | | 27 | | | |
| FLOOR: SEVENTH | | 28 | | | |
| ROOM: 7,000.00.L | | 29 | | | |
| COPYRIGHT | | 30 | | | |
| ALL IDEAS, DESIGNS, ARRANGEMENTS AND PLANS NOTED OR REPRESENTED BY THIS DRAWING ARE OWNED BY, AND THE PROPERTY OF P.A.M. AND WERE CREATED, DEVISED AND DEVELOPED FOR USE OF, AND IN CONNECTION WITH THE SPECIFIED PROJECT. NONE OF SUCH IDEAS, DESIGNS, ARRANGEMENTS OR PLANS SHALL BE USED BY OR DISCLOSED TO ANY PERSON, FIRM OR CORPORATION FOR ANY PURPOSE WHATSOEVER WITHOUT THE WRITTEN PERMISSION OF P.A.M. | | 31 | | | |
| FIELD VERIFICATION | | 32 | | | |
| P.A.M. SHOP DRAWINGS ARE MADE FOR THE EXCLUSIVE USE OF P.A.M. AND ANY OTHER TRADES USING THESE DRAWINGS, USE THEM AT THEIR OWN RISK. CHECKING ON THESE DRAWINGS MAY NOT BE ALWAYS NOTED, FIELD CHECKING MAY INCURE CHARGES IN DRAWINGS, SO OTHER TRADES USING THESE DRAWINGS MUST TAKE THEIR OWN FIELD DIMENSIONS. | | 33 | | | |
| PACIFIC ARCHITECTURAL MILLWORK | | 34 | | | |
| 1041 LESLIE ST. LA HABRA, CA 90631 | | 35 | | | |
| PH: (714) 525-2059 FAX: (714) 525-2673 | | 36 | | | |
| DATE: 12-6-11 | | 37 | | | |
| DRAWN BY: JB | | 38 | | | |
| JOB: 3635 | | 39 | | | |
| DWG: 7.00 | | 40 | | | |
| J04 | | 41 | | | |
| J04 RELEASED TO SHOP PER APPROVED DRAWINGS & FD | | 42 | | | |

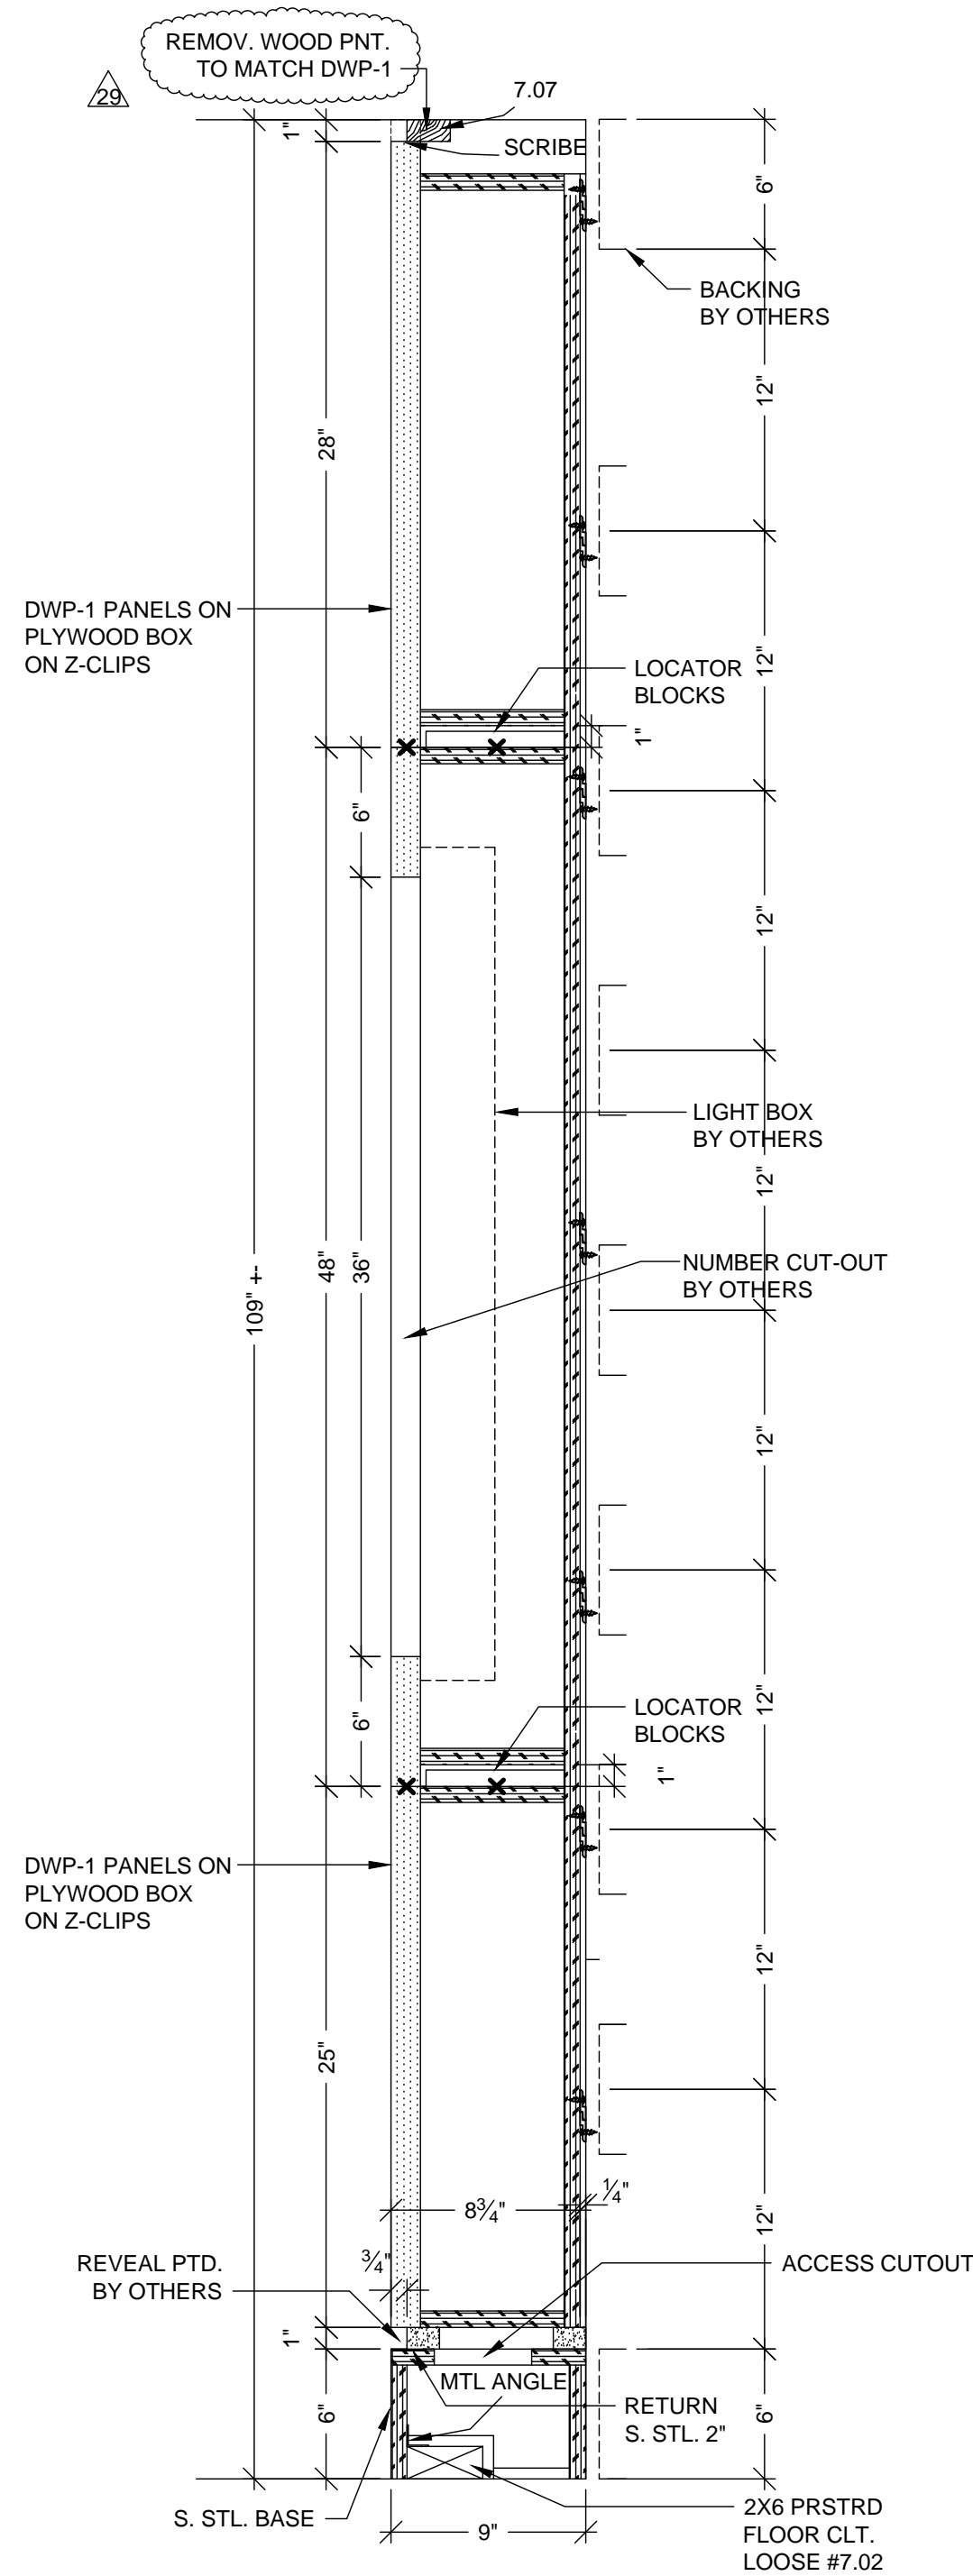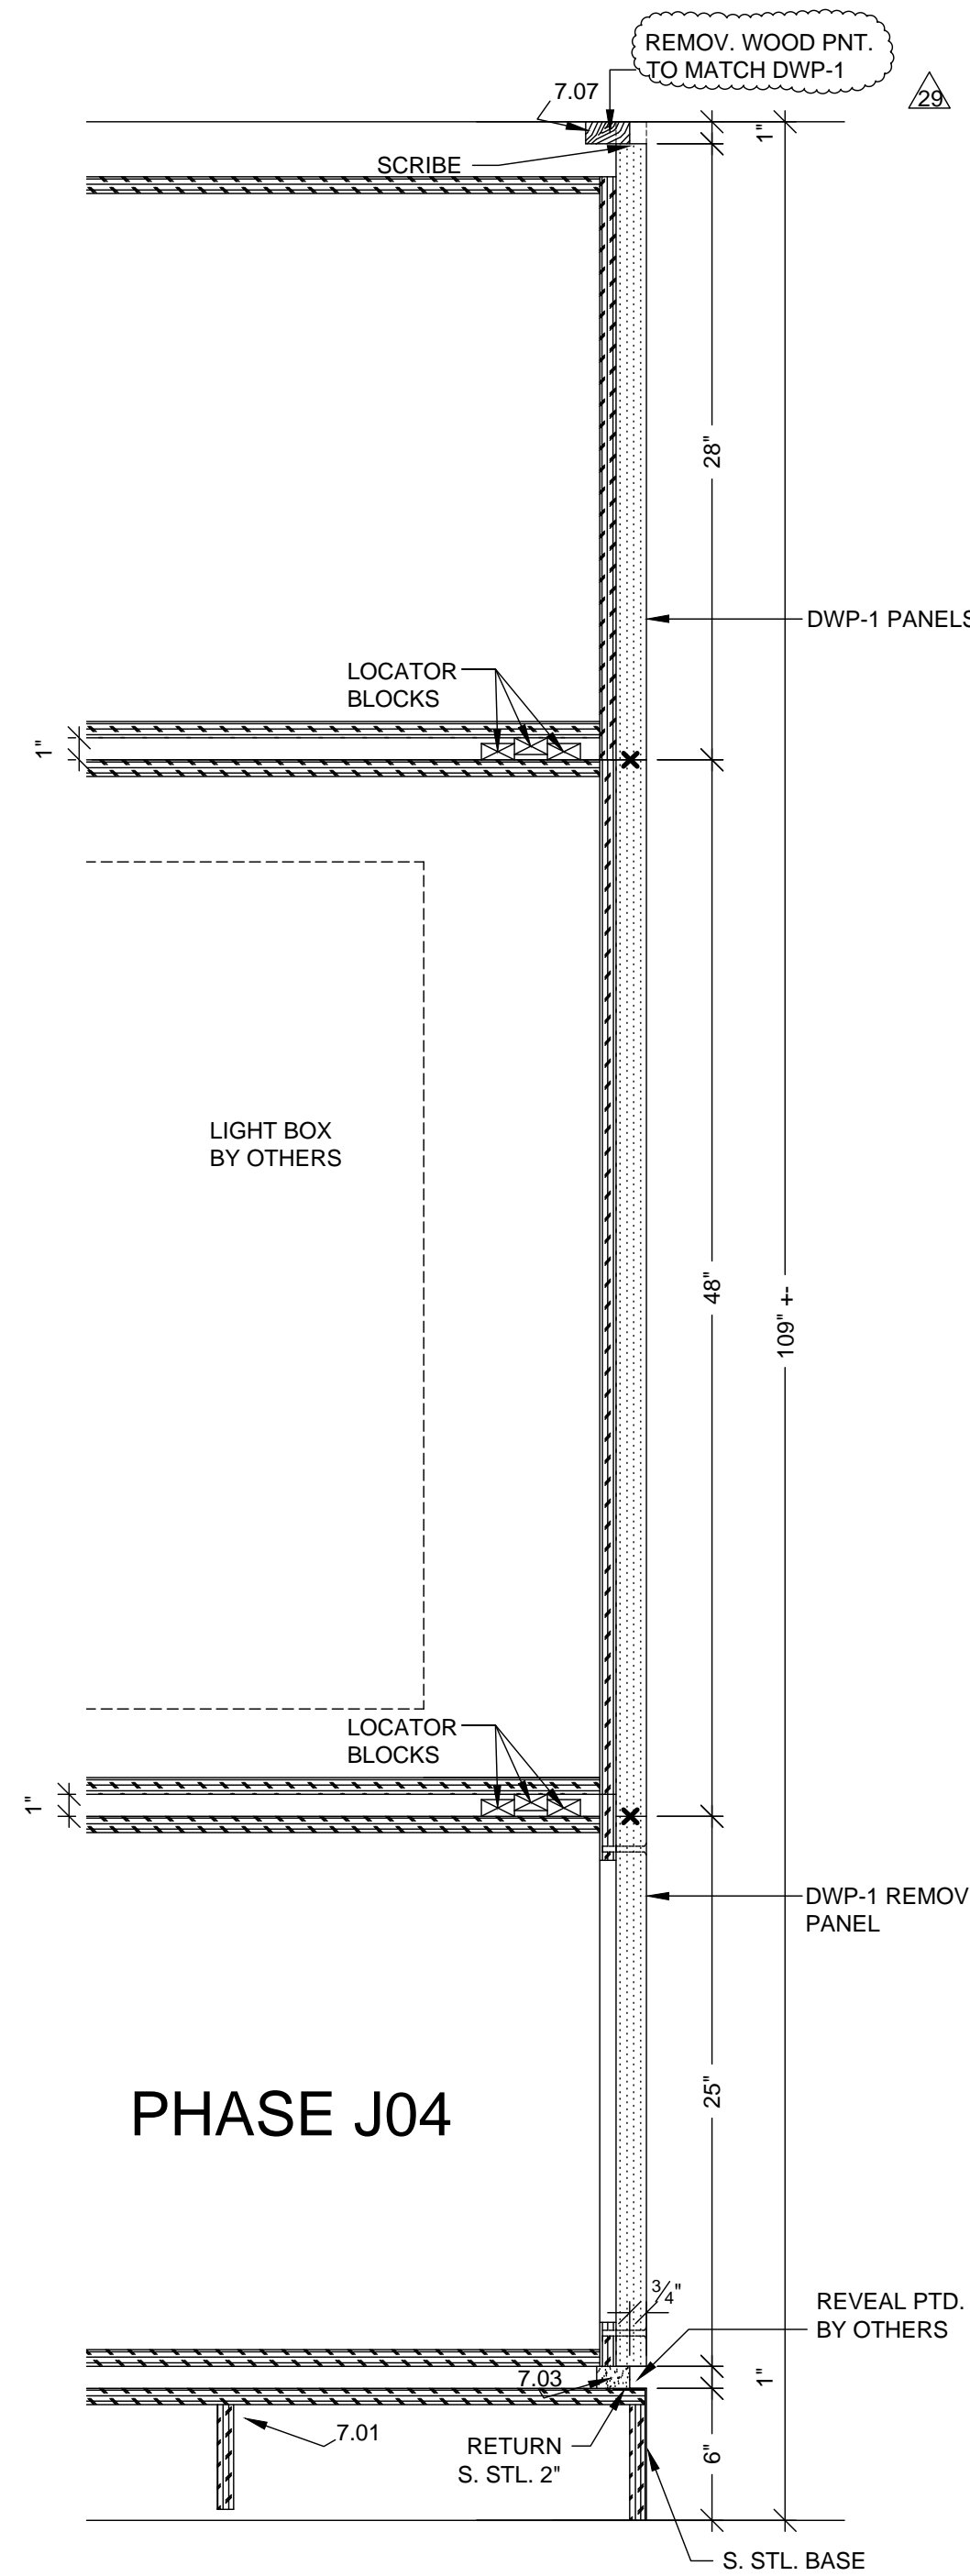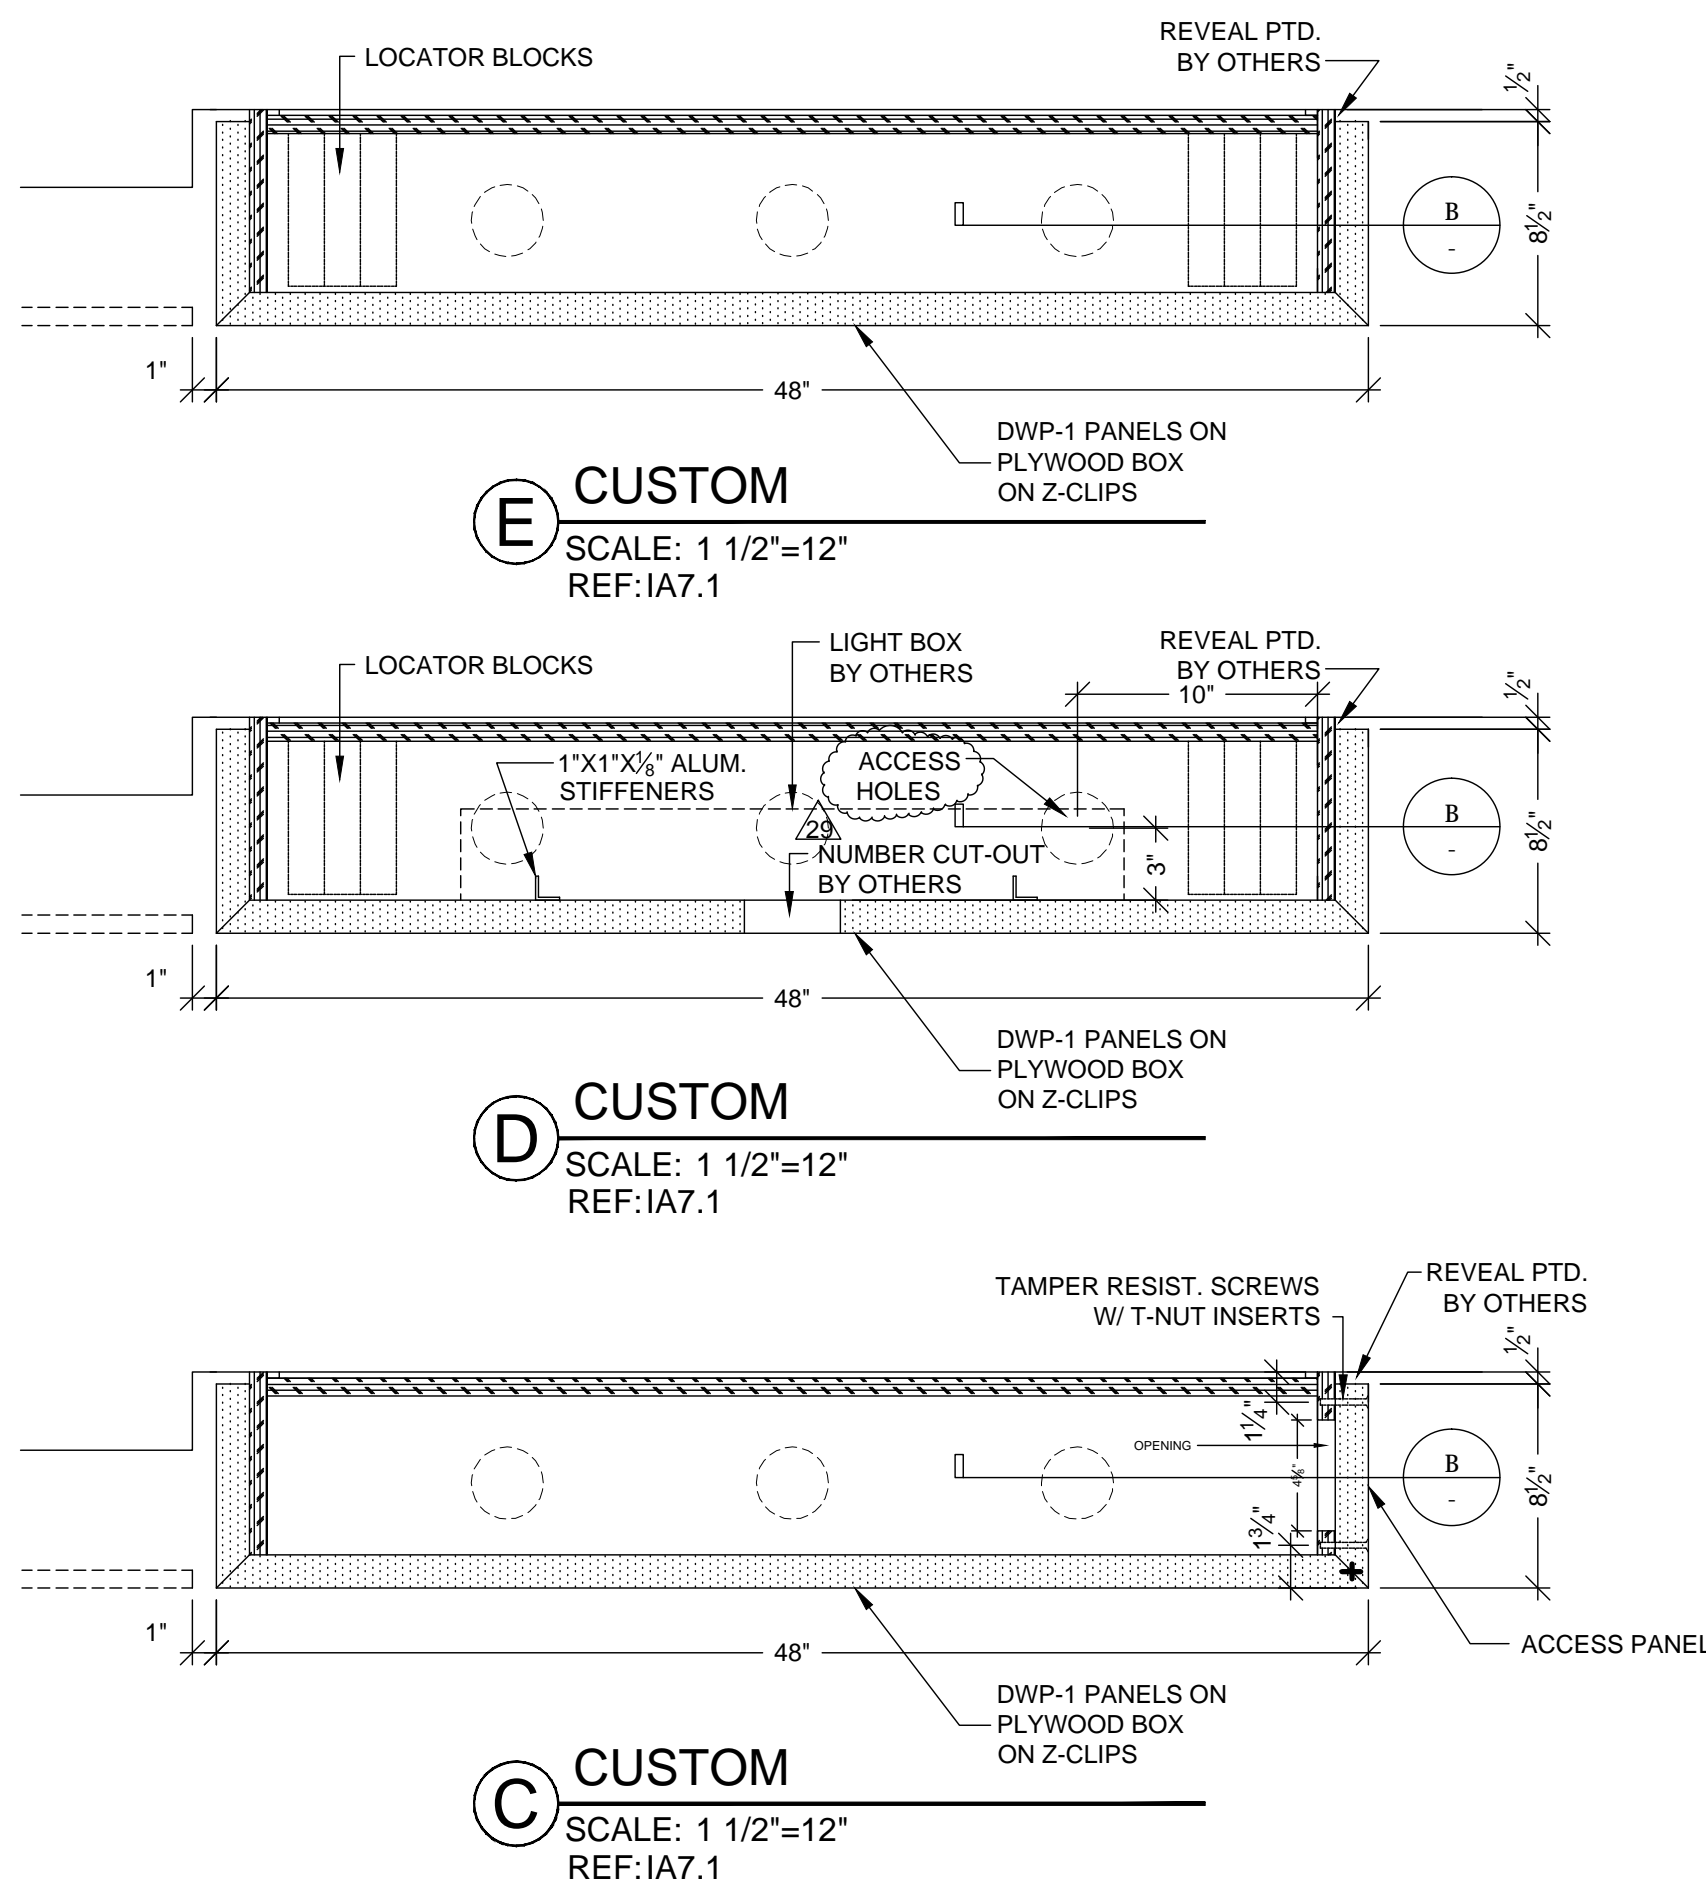

| MCCARTHY APPROVAL | |
|--|--------------------------|
| A. Approved as noted for Subcontract Review | <input type="checkbox"/> |
| B. Review and Revisions | <input type="checkbox"/> |
| C. Rejected | <input type="checkbox"/> |
| This review is for general conformance with Plans and Specifications only. Any deviations from same, not clearly noted by the Preparer, have not been reviewed. Review shall not constitute a complete check of detailed dimensions or count to serve to relieve the Preparer of contractual responsibility for any error or deviation from contract requirements. | |
| McCarthy | |
| By _____ Date _____ | |
| SHOP DRAWING REFERENCE NO. _____ | |

| NO. | DATE | REVISION | BY |
|-----|-----------|---|-----|
| 20 | 12-6-11 | PER REF #4109 | JB |
| 21 | 1-10-12 | PER RLC DATED 12-19-11 | JB |
| 22 | | | |
| 23 | | | |
| 24 | | | |
| 25 | | | |
| 26 | 3-14-2012 | J04 RELEASED TO SHOP PER APPROVED DRAWINGS & FD | JJA |

| | |
|--------------------------|--|
| PROJECT : | CHOC HOSPITAL TOWER II |
| FLOOR: SEVENTH | ROOM: 7.000.00.L |
| ITEM: DWP-1 | ITEM: ELEVATOR WALL PANELS |
| REF: IA5.7D, IA7.1, A8.8 | ARCHITECT: FKP |
| CONTRACTOR: MCCARTHY | 455 S. MAIN STREET ORANGE, CALIFORNIA 92668 |

| | |
|---------------|---------------|
| DATE: 12-6-11 | SCALE: NOTED |
| DRAWN BY: JB | SUBMITTAL: 35 |
| JOB: 3635 | DWG: 7.01 |
| J04 | |

PACIFIC ARCHITECTURAL MILLWORK
1041 LESLIE ST. LA HABRA, CA 90631
PH: (714) 525-2059 FAX: (714) 525-2673