


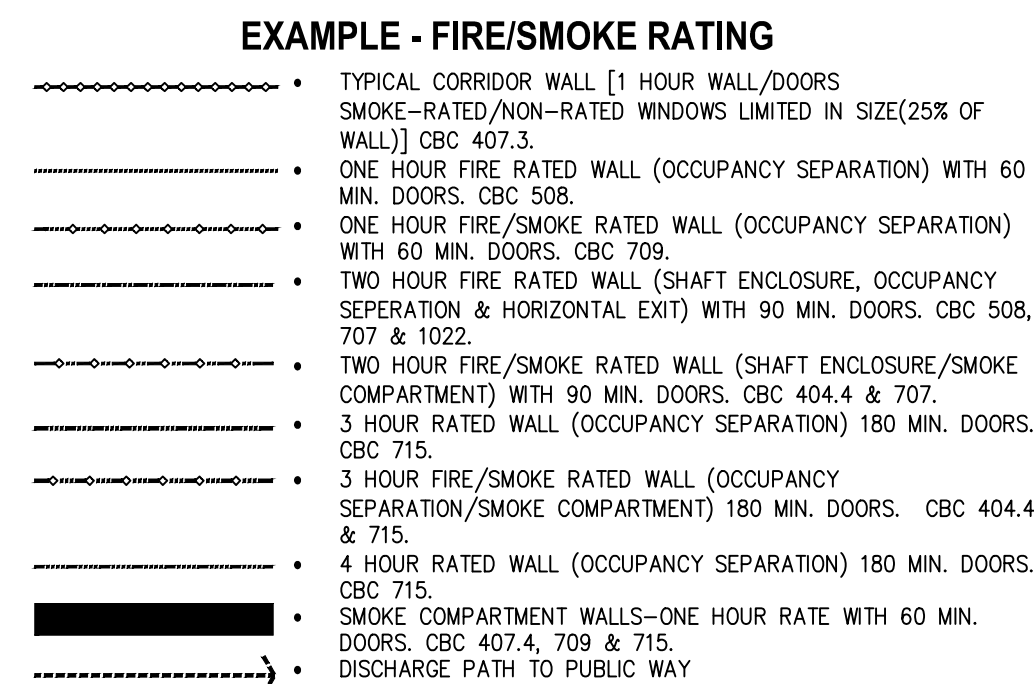


CHILDREN'S HOSPITAL OF ORANGE COUNTY 455 A MAIN STREET, ORANGE, CA, 92868 TOWER II	SECOND FLOOR AREA A AS BUILT
--	---------------------------------

AS AN INSTRUMENT OF SERVICE, THIS DRAWING IS
PROPERTY OF: P.A. THOMPSON ENGINEERING CO.
AND IS NOT TO BE USED WITHOUT EXPRESSED
WRITTEN AGREEMENT.

ES-4.2A

\\Vares\mydocs\CAD Department\CAD Drawings\CHOC\100040 CHOC Hospital Tower\CHOC I\As-Built\CHOC2_TL2.dwg, 9/13/2012 3:20:54 PM

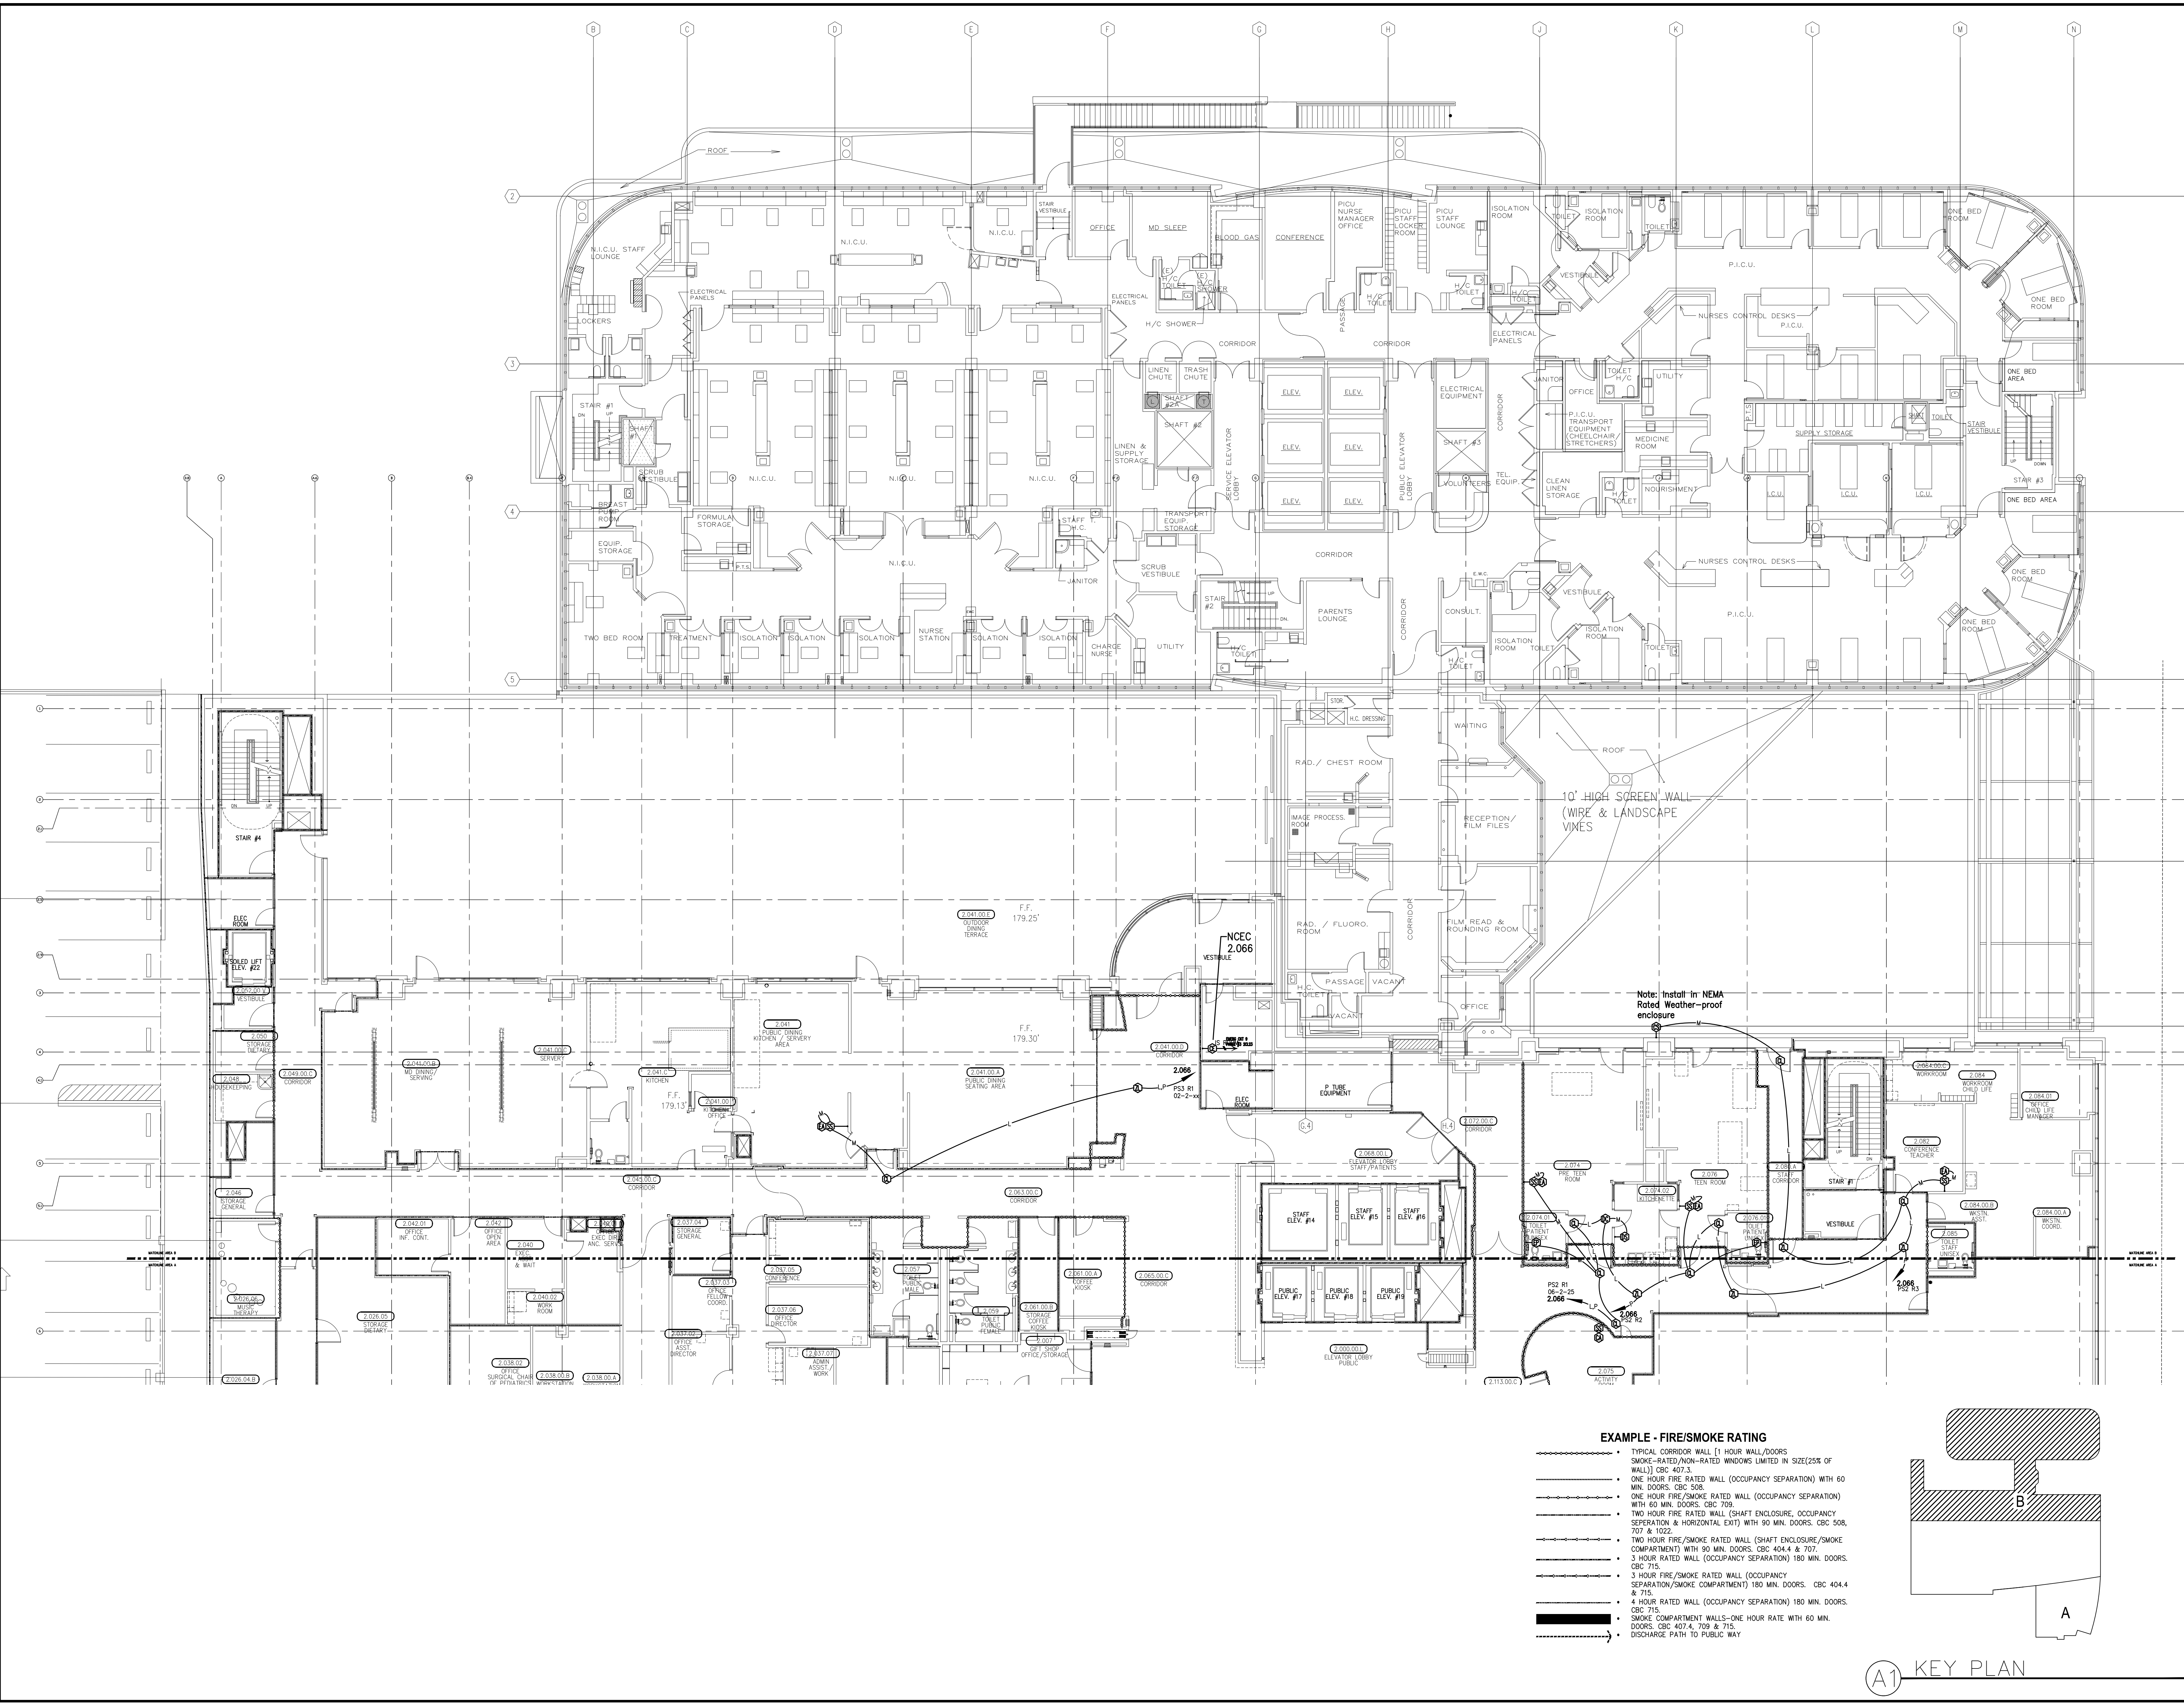

OSHPD PROJECT # IL 072072-30

REVISION #	DATE
AS BUILT	05/29/12

thompson
ENGINEERING

2205 Fleetwood Drive.
Riverside, California 92509
(951) 784-7270 Tel. (951) 784-5435 Fax
License No. - C-7/C10-665844

CHILDREN'S HOSPITAL OF ORANGE COUNTY
455 A MAIN STREET, ORANGE, CA, 92868

TOWER II

SECOND FLOOR AREA B
AS BUILT

SHEET INFORMATION

THOMPSON #	100040
DWG #	100040 ES-4.2B
SCALE:	NTS
DATE:	5/6/10
SHEET	29 OF 65
DRAWN BY:	dob

AS AN INSTRUMENT OF SERVICE, THIS DRAWING IS
PROPERTY OF: P.A. THOMPSON ENGINEERING CO.
AND IS NOT TO BE USED WITHOUT EXPRESSED
WRITTEN AGREEMENT.

ES-4.2B