



\\Vares\mydocs\CAD Department\CAD Drawings\CHOC\100040 CHOC Hospital Tower II\CHOC II\As-Built\CHOC2_TL5.dwg, 9/14/2012 12:02:50 PM

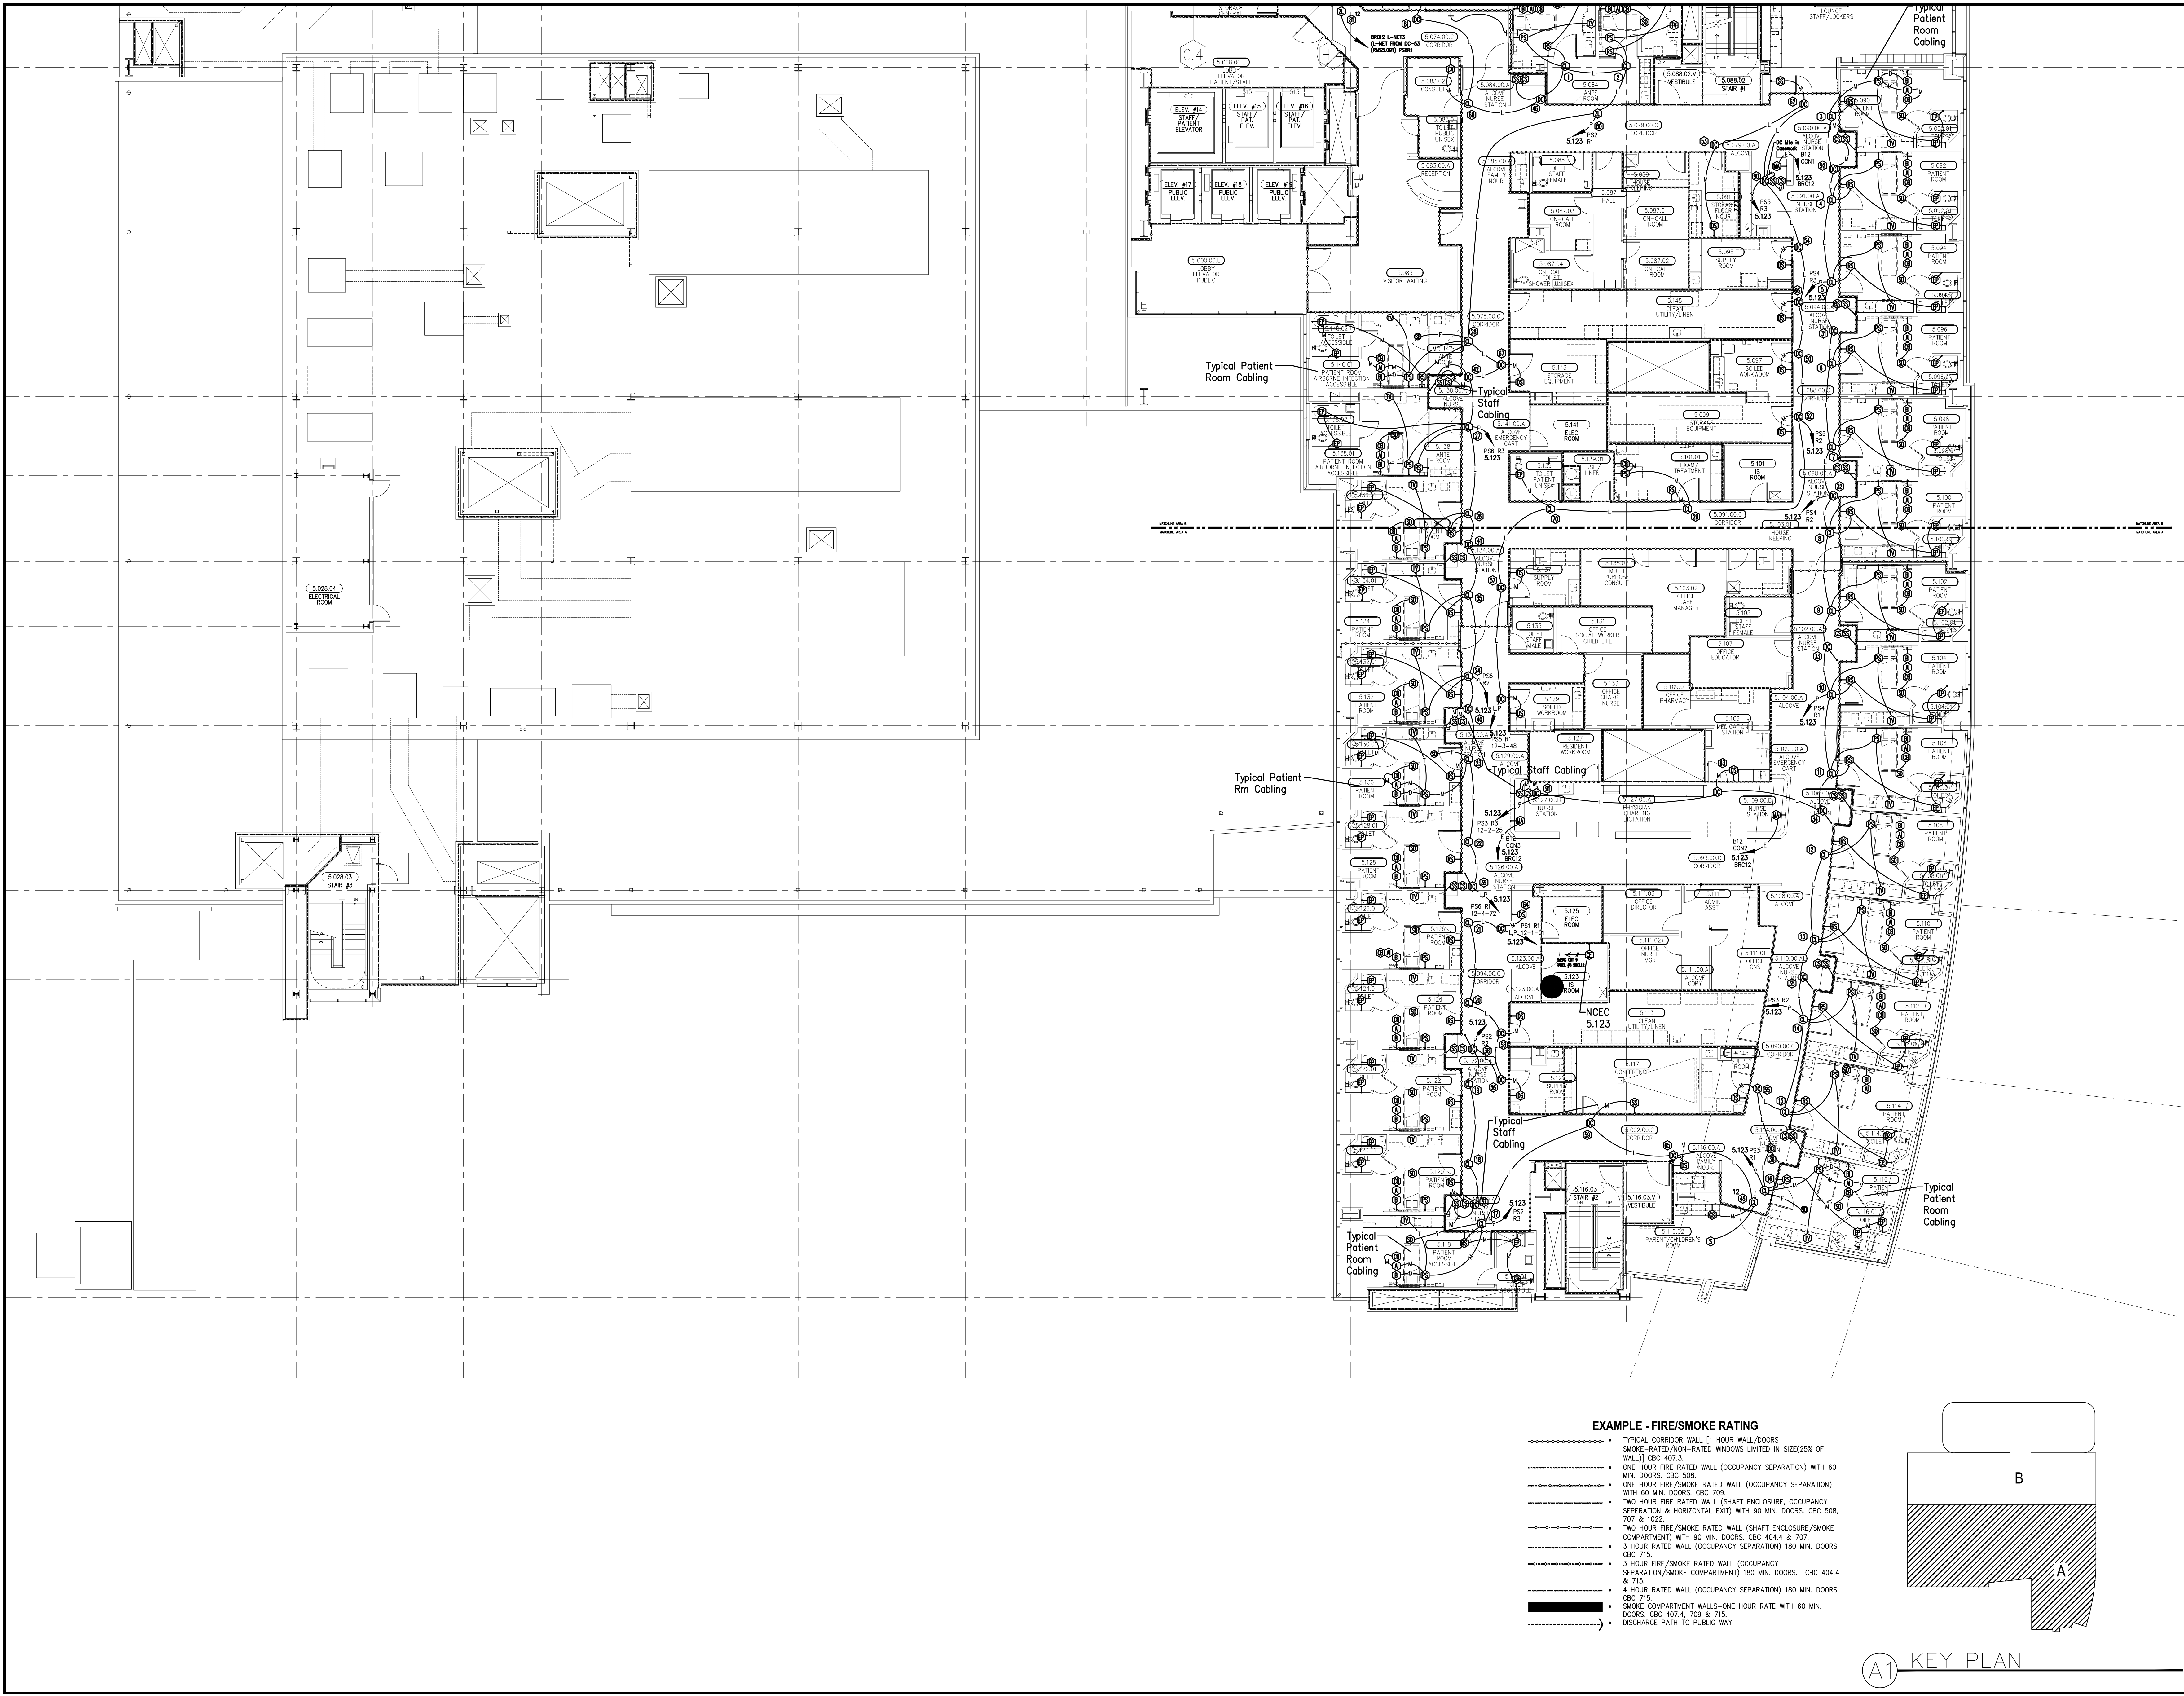

OSHPD PROJECT # IL 072072-30	
REVISION #	DATE
AS BUILT	05/29/12

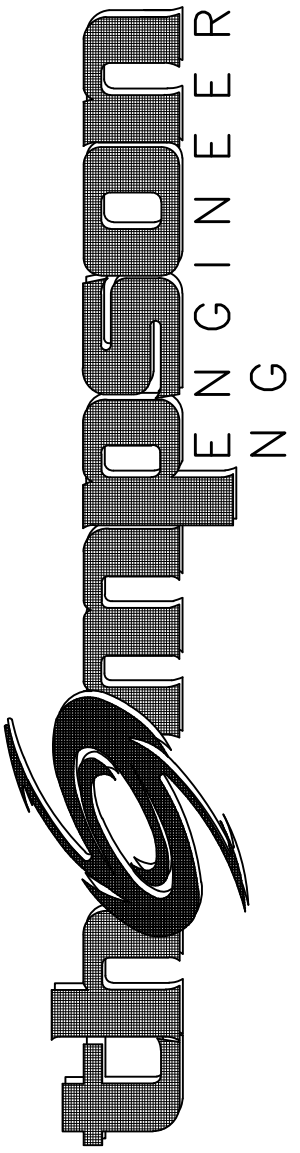


2205 Fleetwood Drive.
Riverside, California 92509
(951) 784-7270 Tel. (951) 784-5435 Fax
License No. - C-7/C10-665844

CHILDREN'S HOSPITAL OF ORANGE COUNTY 455 A MAIN STREET, ORANGE, CA, 92868	TOWER II
	FIFTH FLOOR AREA A AS BUILT


SHEET INFORMATION	
THOMPSON # 100040	
DWG # 100040 ES-4.5A	
SCALE: NTS	
DATE: 5/6/10	
SHEET 61 OF 65	
DRAWN BY: dob	
AS AN INSTRUMENT OF SERVICE, THIS DRAWING IS PROPERTY OF: P.A. THOMPSON ENGINEERING CO. AND IS NOT TO BE USED WITHOUT EXPRESSED WRITTEN AGREEMENT.	

ES-4.5A

\\vares\mydocs\CAD Department\CAD Drawings\CHOC\100040 CHOC Hospital Tower II\CHOC II\As-Built\CHOC2_TL_5.dwg, 9/14/2012 12:03:15 PM

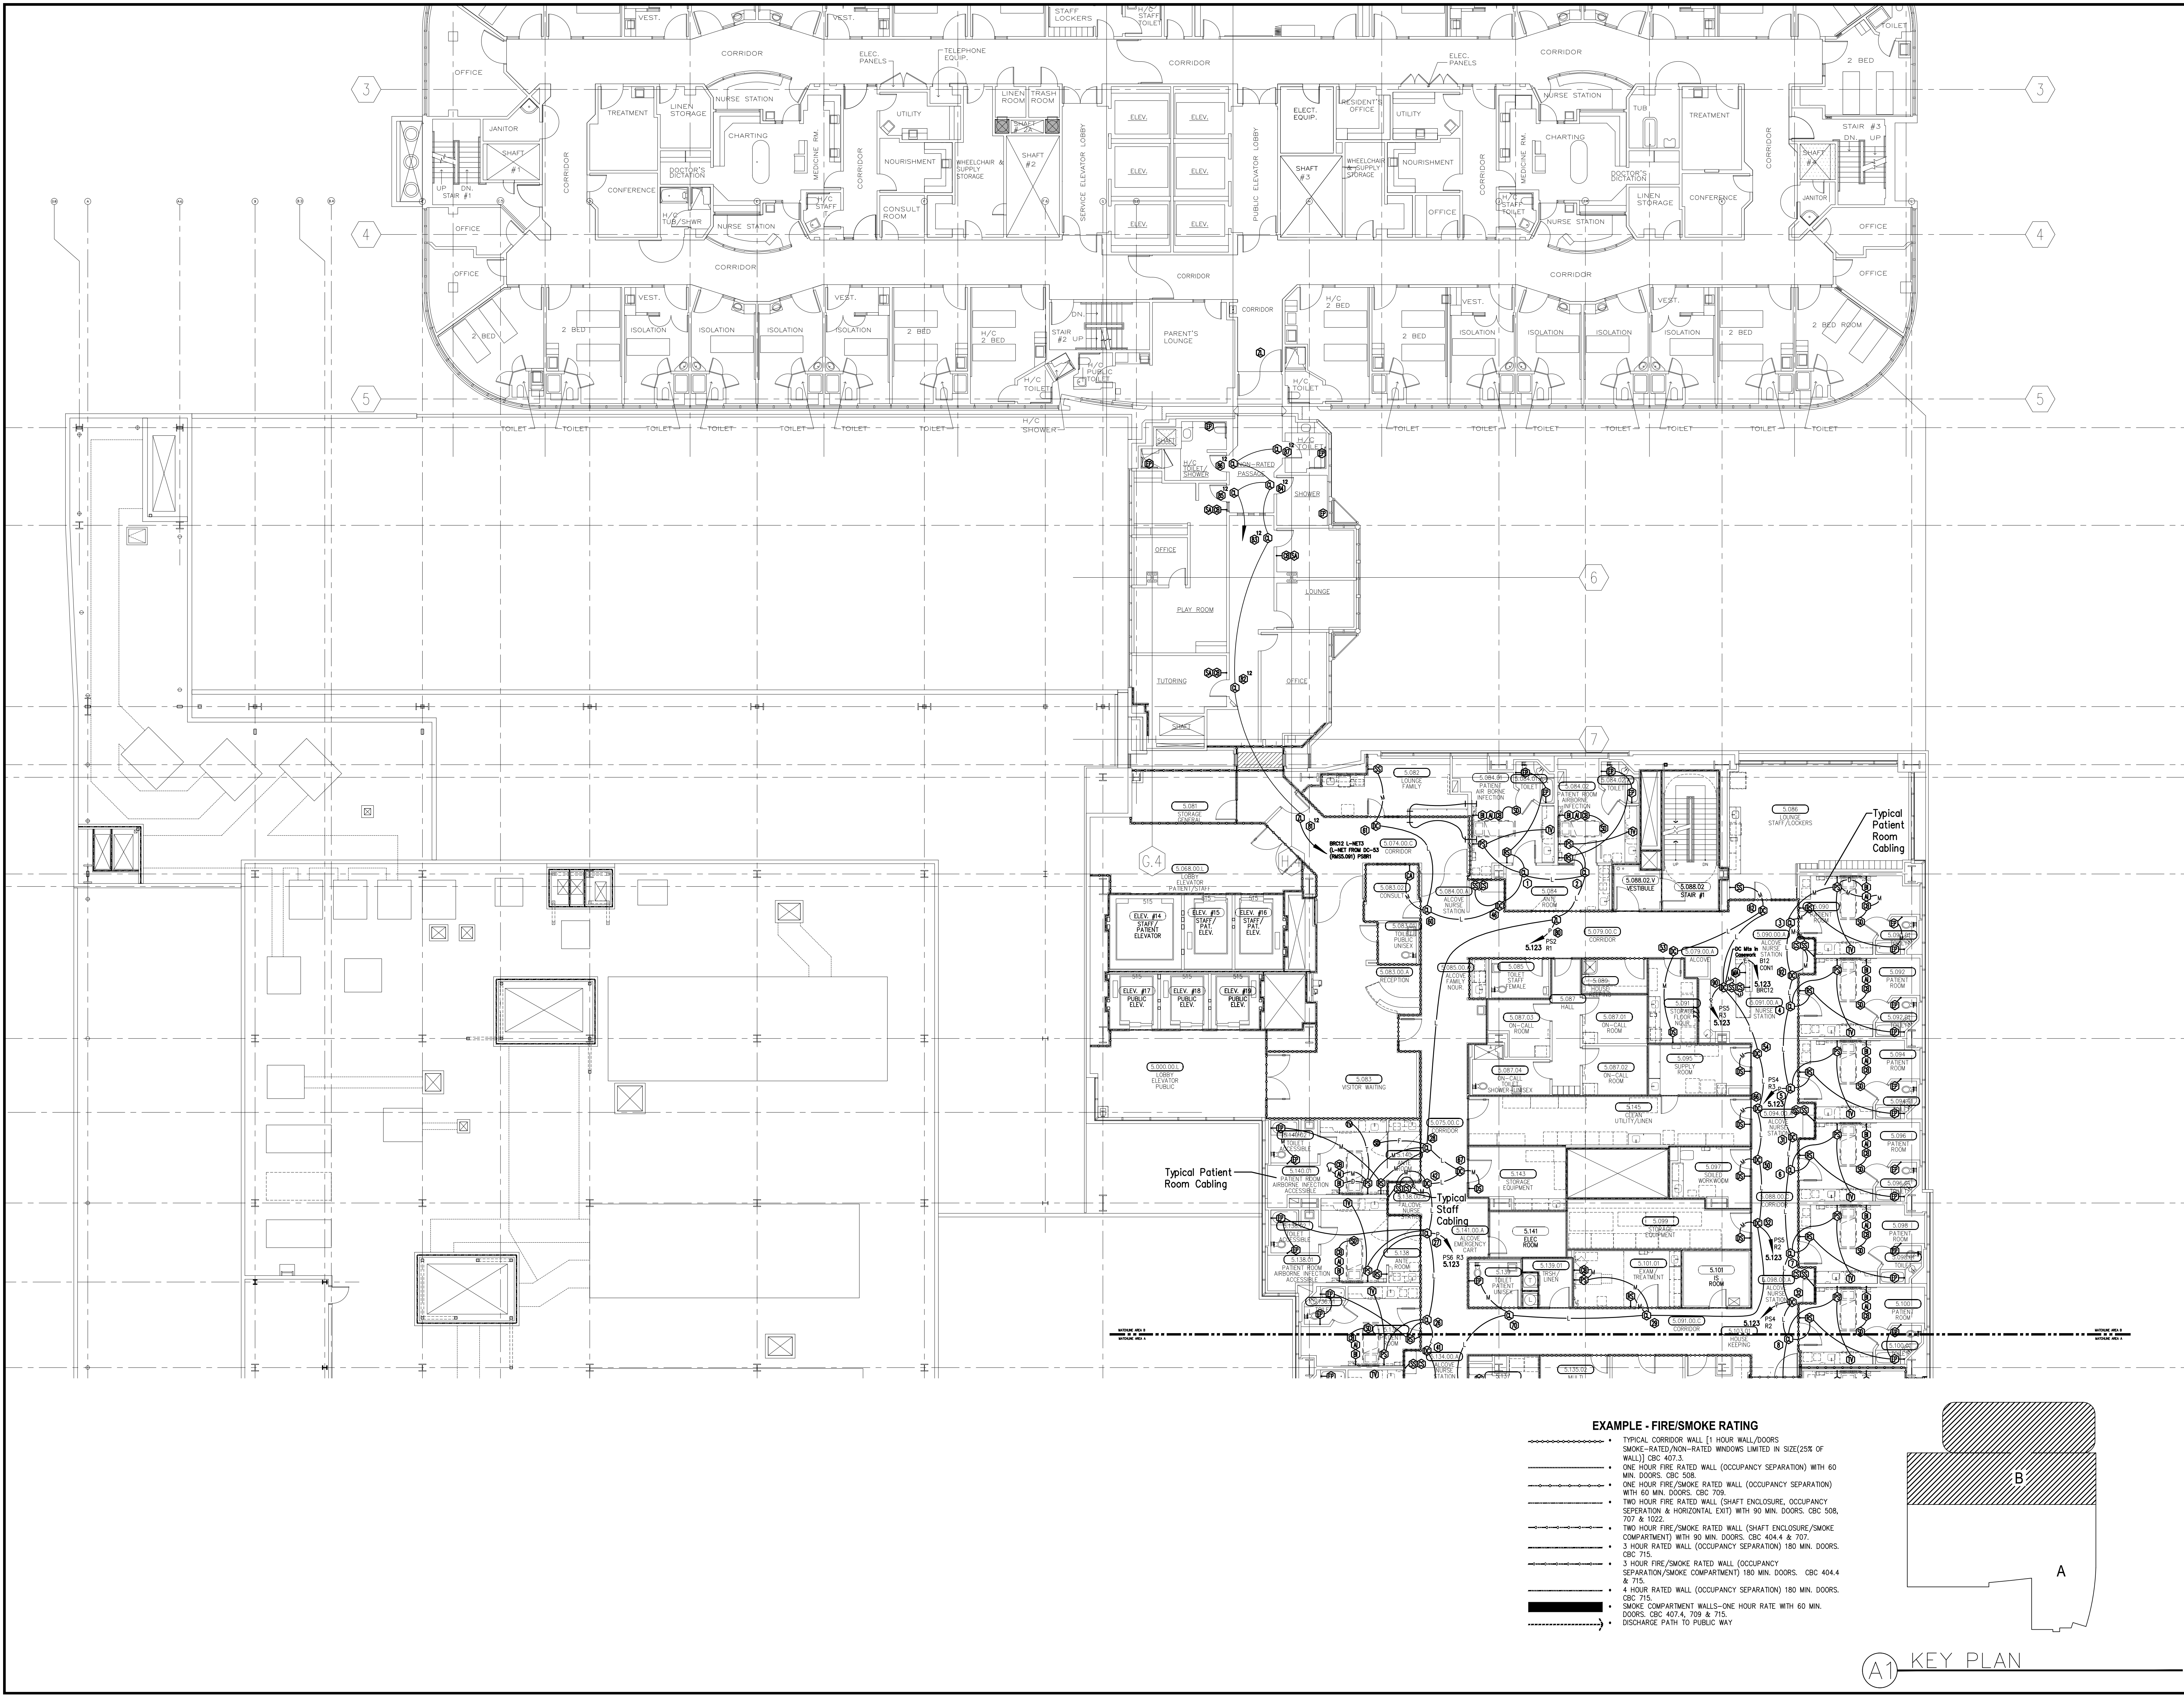

OSHPD PROJECT # IL 072072-30	
REVISION #	DATE
AS BUILT	05/29/12

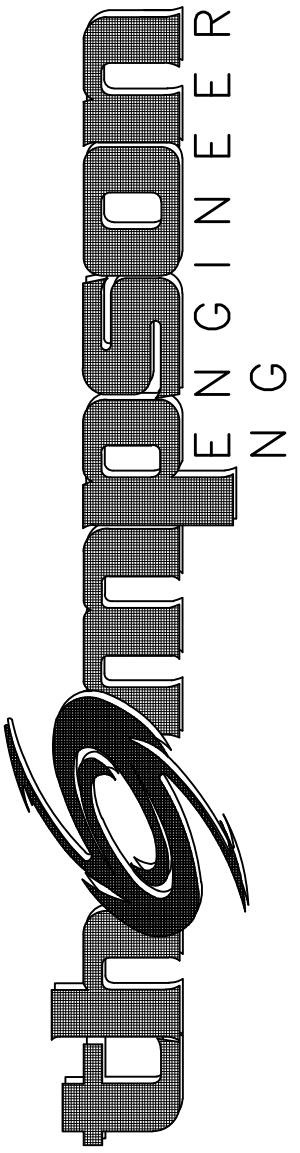

2205 Fleetwood Drive.
Riverside, California 92509
(951) 784-7270 Tel. (951) 784-5435 Fax
License No. - C-7/C10-665844

CHILDREN'S HOSPITAL OF ORANGE COUNTY 455 A MAIN STREET, ORANGE, CA, 92868 TOWER II FIFTH FLOOR AREA B AS BUILT
--

SHEET INFORMATION	
THOMPSON # 100040	
DWG # 100040 ES-4.5B	
SCALE: NTS	
DATE: 5/6/10	
SHEET 62 OF 65	
DRAWN BY: dob	
AS AN INSTRUMENT OF SERVICE, THIS DRAWING IS PROPERTY OF: P.A. THOMPSON ENGINEERING CO. AND IS NOT TO BE USED WITHOUT EXPRESSED WRITTEN AGREEMENT.	

ES-4.5B