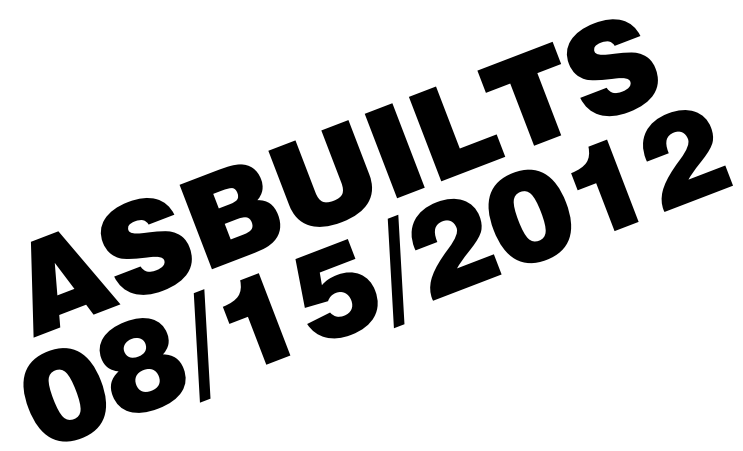

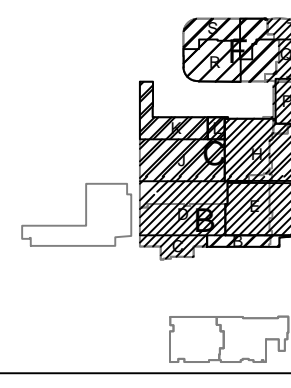

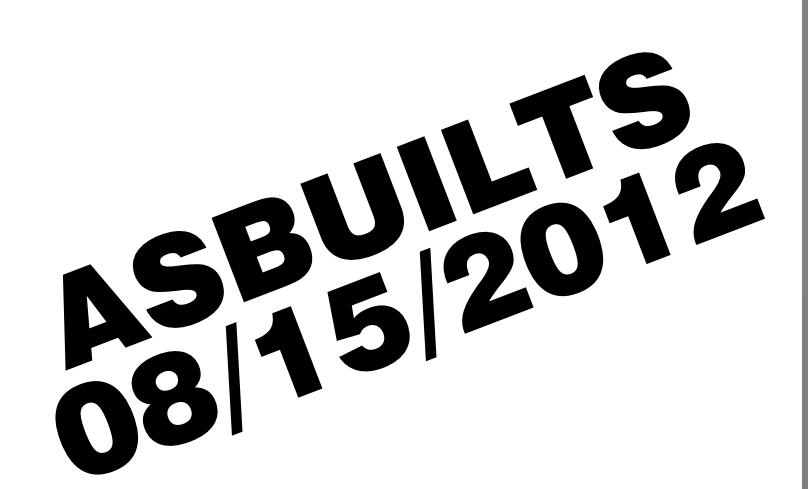


DRAWING PREPARED BY:			
<div><div>KRATOS</div><div>HBE</div></div>			
1511 E. ORANGETHORPE BLVD. FULLERTON, CALIFORNIA 92831 714-525-4350 - o; 714-525-4386 - f (c) Copyright 2012 KRATOS HBE All Rights Reserved.			
MUST BE SIGNED BY HBE TO AUTHENTICATE CONTENT(S). ALL DETAILS CHECKED FOR ACCURACY.			
SIGNATURE _____		DATE _____	
HBE JOB # _____			
CONFIDENTIAL			
THE INFORMATION CONTAINED HERIN MAY NOT BE USED OR REPRODUCED IN ANY MANNER WITHOUT WRITTEN PERMISSION OF KRATOS HBE.			
<div>KEY PLAN</div>			
NO.	REV DESCRIPTION REV DATE	APPROVED BY	
1.	AS BUILTS 08/15/2012	JOHN J. CHRISTIE	
REV.	DESCRIPTION	APPROVED BY	
CUSTOMER:			
<div><div></div><div>CHOCSM Children's Hospital of Orange County</div></div>			
PROJECT:			
CHOC CHILDREN'S HOSPITAL 455 SOUTH MAIN ST. ORANGE, CA 92668			
DRAWING TITLE:			
LEVEL P2 SECURITY PLAN			
DRN BY	DATE DRN	CHK BY	DATE CHK
JOSH G.	08/08/2012	JJC	
SCALE:		NTS	
DWG NO.	SE3.P2		



DRAWING PREPARED BY:			
			
1511 E. ORANGETHORPE BLVD. FULLERTON, CALIFORNIA 92831 714-525-4350 - o; 714-525-4386 - f (c) Copyright 2012 KRATOS HBE All Rights Reserved.			
MUST BE SIGNED BY HBE TO AUTHENTICATE CONTENT(S). ALL DETAILS CHECKED FOR ACCURACY.			
SIGNATURE _____		DATE _____	
HBE JOB #			
<h2 style="margin: 0;">CONFIDENTIAL</h2> <p style="font-size: small; margin: 5px 0;">THE INFORMATION CONTAINED HERIN MAY NOT BE USED OR REPRODUCED IN ANY MANNER WITHOUT WRITTEN PERMISSION OF KRATOS HBE.</p>			
KEY PLAN 			
NO.	REV DESCRIPTION REV DATE	APPROVED BY	
1.	AS BUILTS 08/15/2012	JOHN J. CHRISTIE	
REV.	DESCRIPTION	APPROVED BY	
CUSTOMER:			
			
PROJECT: CHOC CHILDREN'S HOSPITAL 455 SOUTH MAIN ST. ORANGE, CA 92668			
DRAWING TITLE: <h2 style="margin: 0; text-align: center;">LEVEL P2 SECURITY PLAN AREA A</h2>			
DRN BY	DATE DRN	CHK BY	DATE CHK
JOSH G.	08/08/2012	JJC	
SCALE:		NTS	
DWG NO.		SE3.P2A	



DRAWING PREPARED BY:	
	
15111 E. ORANGETHORPE BLVD. FULLERTON, CALIFORNIA 92831 714-525-4350 - o; 714-525-4386 - f (c) Copyright 2012 KRATOS HBE All Rights Reserved.	
MUST BE SIGNED BY HBE TO AUTHENTICATE CONTENT(S). ALL DETAILS CHECKED FOR ACCURACY.	
SIGNATURE: _____	DATE: _____
HBE JOB # _____	
CONFIDENTIAL	
THE INFORMATION CONTAINED HEREIN MAY NOT BE USED OR REPRODUCED IN ANY MANNER WITHOUT WRITTEN PERMISSION OF KRATOS HBE.	

NO.	REV DESCRIPTION REV DATE	APPROVED BY
1.	AS BUILTS 08/15/2012	JOHN J. CHRISTIE
REV.	DESCRIPTION	APPROVED BY

PROJECT:

CHOC CHILDREN'S
HOSPITAL
455 SOUTH MAIN ST.
ORANGE, CA 92668

DRAWING TITLE:

LEVEL P2
SECURITY PLAN
AREA D

DRN BY	DATE DRN	CHK BY	DATE CHK
JOSH G.	08/08/2012	JJC	
SCALE:	NTS		
DWG NO.	SE3.P2D		