



DRAWING PREPARED BY:			
			
1511 E. ORANGETHORPE BLVD. FULLERTON, CALIFORNIA 92831 714-525-4350 - o; 714-525-4386 - f (c) Copyright 2012 KRATOS HBE All Rights Reserved.			
MUST BE SIGNED BY HBE TO AUTHENTICATE CONTENT(S). ALL DETAILS CHECKED FOR ACCURACY.			
SIGNATURE _____		DATE _____	
HBE JOB # _____			
CONFIDENTIAL THE INFORMATION CONTAINED HEREIN MAY NOT BE USED OR REPRODUCED IN ANY MANNER WITHOUT WRITTEN PERMISSION OF KRATOS HBE.			
KEY PLAN 			

CONFIDENTIAL

THE INFORMATION CONTAINED HEREIN MAY NOT BE USED OR REPRODUCED IN ANY MANNER WITHOUT WRITTEN PERMISSION OF KRATOS | HBE.

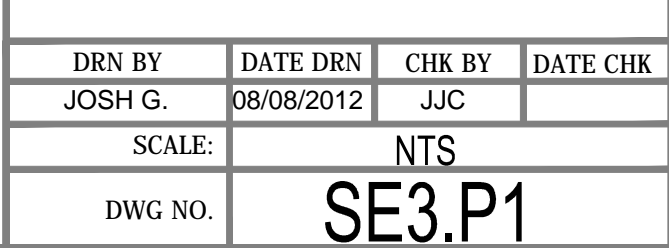

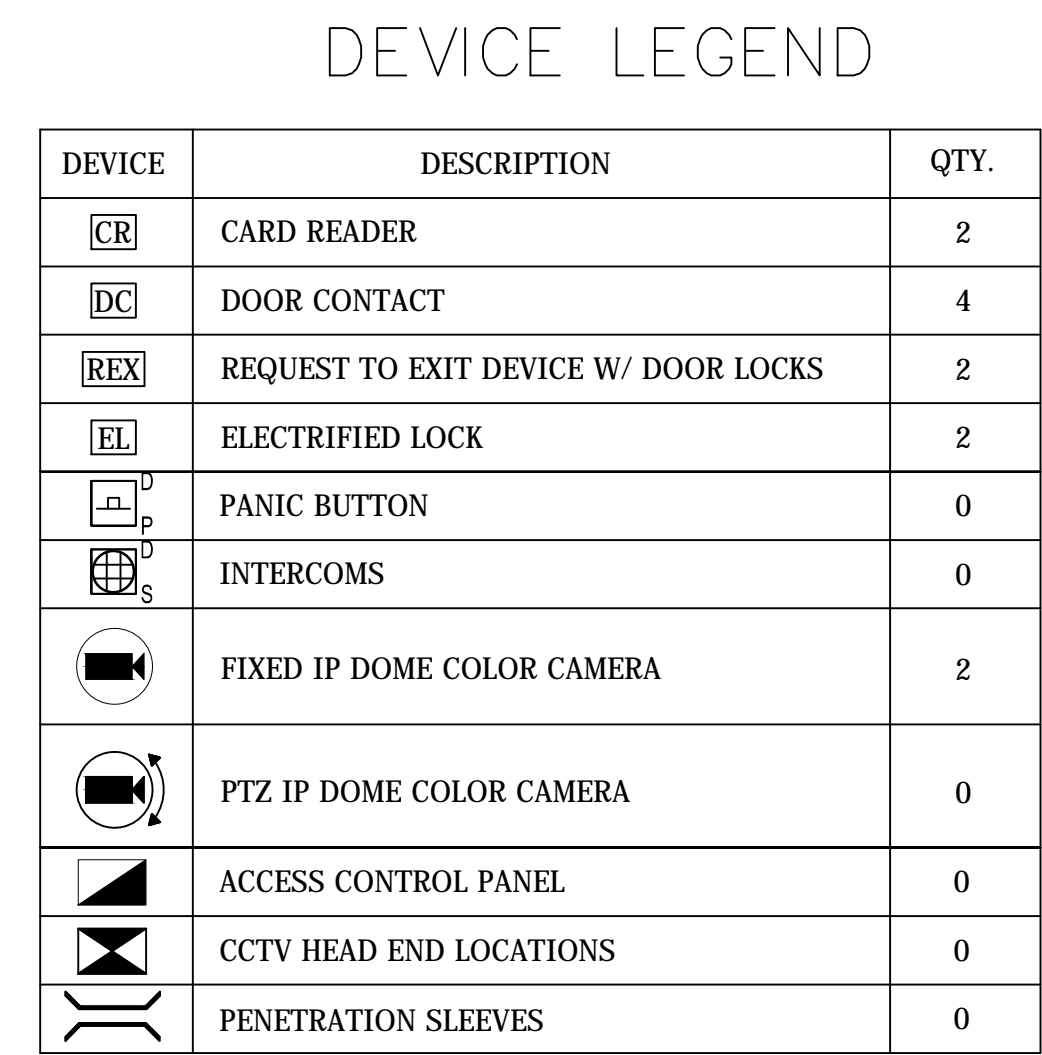

KRATOS®
HBE


**MUST BE SIGNED BY HBE
TO AUTHENTICATE CONTENT(S).
ALL DETAILS CHECKED FOR ACCURACY.**

SIGNATURE _____ DATE _____

HBE JOB #

CONFIDENTIAL

THE INFORMATION CONTAINED HEREIN MAY
NOT BE USED OR REPRODUCED IN ANY
MANNER WITHOUT WRITTEN PERMISSION OF
KRATOS | HBE.

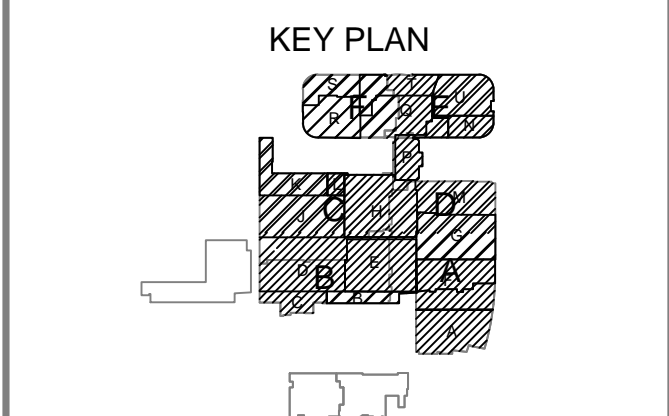

NO.	REV DESCRIPTION REV DATE	APPROVED BY
1.	AS BUILTS 08/15/2012	JOHN J. CHRISTIE
REV.	DESCRIPTION	APPROVED BY

REV.	DESCRIPTION	APPROVED BY
------	-------------	-------------

CUSTOMER:



PROJECT:
CHOC CHILDREN'S
HOSPITAL
455 SOUTH MAIN ST.
ORANGE, CA 92668

DRAWING TITLE:

LEVEL P1
SECURITY PLAN
AREA D

DRN BY	DATE DRN	CHK BY	DATE CHK
JOSH G.	08/08/2012	JJC	
SCALE:	NTS		
DWG NO.	SE3.P1D		

ASBUILTS
08/15/2012