



SHEET KEYNOTES

1. 12"W X 6"H CABLE RUNWAY
2. 24"W X 6"H CABLE RUNWAY
3. 18"W X 6"H CABLE RUNWAY
4. OUTLETS ARE TO BE FED VIA WALL FROM ABOVE CEILING SPACE. PROVIDE TWO (2) 1/2" CONDUITS FROM CABLE RUNWAY TO MILLWORK. TERMINATE CONDUITS AT 24" A.F.F. AND EXTEND ONTO MILLWORK USING NON-METALLIC SURFACE RACEWAYS WITH MINIMUM OF 1"x1" INTERNAL AREA TO EACH OUTLET.

GENERAL SHEET NOTES

1. THE DRAWINGS ARE DIAGRAMMATIC ONLY AND MAY NOT SHOW ALL COMPONENTS, MATERIALS, OFFSETS, BENDS, ELBOWS AND OTHER SPECIFIC ELEMENTS THAT MAY BE REQUIRED FOR A COMPLETE INSTALLATION. THE CONTRACTOR SHALL BE RESPONSIBLE FOR PROVIDING ALL MATERIALS NEEDED FOR A COMPLETE AND FUNCTIONAL INSTALLATION.
2. ELECTRIC EQUIPMENT AND DEVICES (E.G. PBX, NETWORK SWITCHES) ARE SHOWN FOR REFERENCE ONLY.
3. REFER TO ARCHITECTURAL DETAIL PLANS FOR FINAL PATIENT ROOM DEVICE LOCATIONS. REFER TO ARCHITECTURAL DETAILS FOR OVERCOUNTER WAO HEIGHTS. REFER TO ARCHITECTURAL DETAILS FOR WALL-MOUNT WAO HEIGHTS.
4. HORIZONTAL DATA/VOICE/VIDEO CABLE SHALL TERMINATE IN THE TECHNOLOGY ROOM ON THE SAME FLOOR AS THE WORK AREA OUTLETS.
5. WORK AREA OUTLETS SHALL CONSIST OF SINGLE PLASTER REDUCING RINGS INSTALLED ON OVERSIZE DOUBLE GANG BACKBOXES, UNLESS OTHERWISE NOTED.
6. TV COAX CABLES SHALL BE COILED IN THE RESPECTIVE TECHNOLOGY ROOMS WITH A 20' SERVICE LOOP PRIOR TO TERMINATIONS. COILS SHALL BE SECURED TO THE AUDIOVISUAL WALL FIELD FOR AV CONTRACTOR.
7. COMMON LOW VOLTAGE CABLE RUNWAY IS 24" W X 6" HIGH. PROVIDE ALL MATERIALS AS NEEDED FOR A COMPLETE, MANUFACTURER-APPROVED SYSTEM USING CABLE TRAY MANUFACTURERS' MATERIALS AND PARTS WHEN AVAILABLE FROM THE MANUFACTURER AND AS INTENDED. REFER TO DRAWING T4.01 FOR DETAILS. ALL CHANGES IN DIRECTION AND INTERSECTIONS SHALL USE PRE-MANUFACTURED OR FIELD-INSTALLED SWEEPS AND TEES. ALL SWEEPS AND TEES SHALL MAINTAIN A 1' FOOT MINIMUM RADIUS IN CHANGES OF DIRECTION.
8. CABLE TRAY SHALL NOT PENETRATE WALLS. PROVIDE TRANSITION FROM CABLE TRAY TO LISTED FIRESTOP ASSEMBLIES IN ORDER TO PENETRATE FIRE/SMOKE WALLS. TRANSITION TO 4" CONDUITS/SLEEVES FOR NON-RATED WALLS. PROVIDE SUFFICIENT CONDUITS/SLEEVES TO ACCOMMODATE 100% VISUAL CABLE TRAY LOAD AT 50% VISUAL CONDUIT FILL.
9. REFER TO ELECTRICAL DRAWINGS & SPECIFICATIONS FOR SHARED FLOOR BOXES & LOW VOLTAGE CONDUIT.
10. PROVIDE BRACING TO MEET OSHPD SEISMIC REQUIREMENTS. REFER TO SHEET T4.02 FOR MORE INFORMATION.
11. PROVIDE ALL OUTLET CONDUITS FROM WORK AREA OUTLETS, DEVICES OR PULL BOXES TO NEAREST CABLE TRAY.
12. INSTALL CABLE TRAY @ 6" ABOVE CEILING.

T3 LEVEL P2 - TELECOM PLAN - OVERALL
1/16" = 1'-0"

Bergelectric Corp.
Contractors & Engineers
#C10-485048
650 UPPER ST.
ESCONDIDO, CA 92029
(760) 746-1033
FAX (760) 746-6519

PROJECT: CHILDREN'S HOSPITAL OF ORANGE COUNTY - TOWER II
ADDRESS: 455 South Main Street Orange, CA 92668-3874
W.O. NO.: 12684

PROPRIETARY STATEMENT
THESE DRAWINGS DOCUMENTS HEREIN ATTACHED ARE THE PROPERTY OF BERGELECTRIC CORPORATION ANY REUSE OR REPRODUCTION OF THESE DOCUMENTS WITHOUT WRITTEN PERMISSION OF BERGELECTRIC CORPORATION IS STRICTLY FORBIDDEN. ALL RIGHTS RESERVED.

DRAWN BY:
J. RAMIREZ

DESIGN SUPERVISOR:


INSTALL SUPERVISOR:
Scott Adams
Tel Data Systems
Bergelectric Corporation
650 Upper Street
Escondido, CA 92029

REVISION:
05-30-12 RECORD DRAWINGS

SHEET TITLE:
TELECOM FLOOR PLAN LEVEL P2 OVERALL

SCALE:
1/16"=1'0"

DRAWING NO.:
T3.P2
RECORD DRAWING

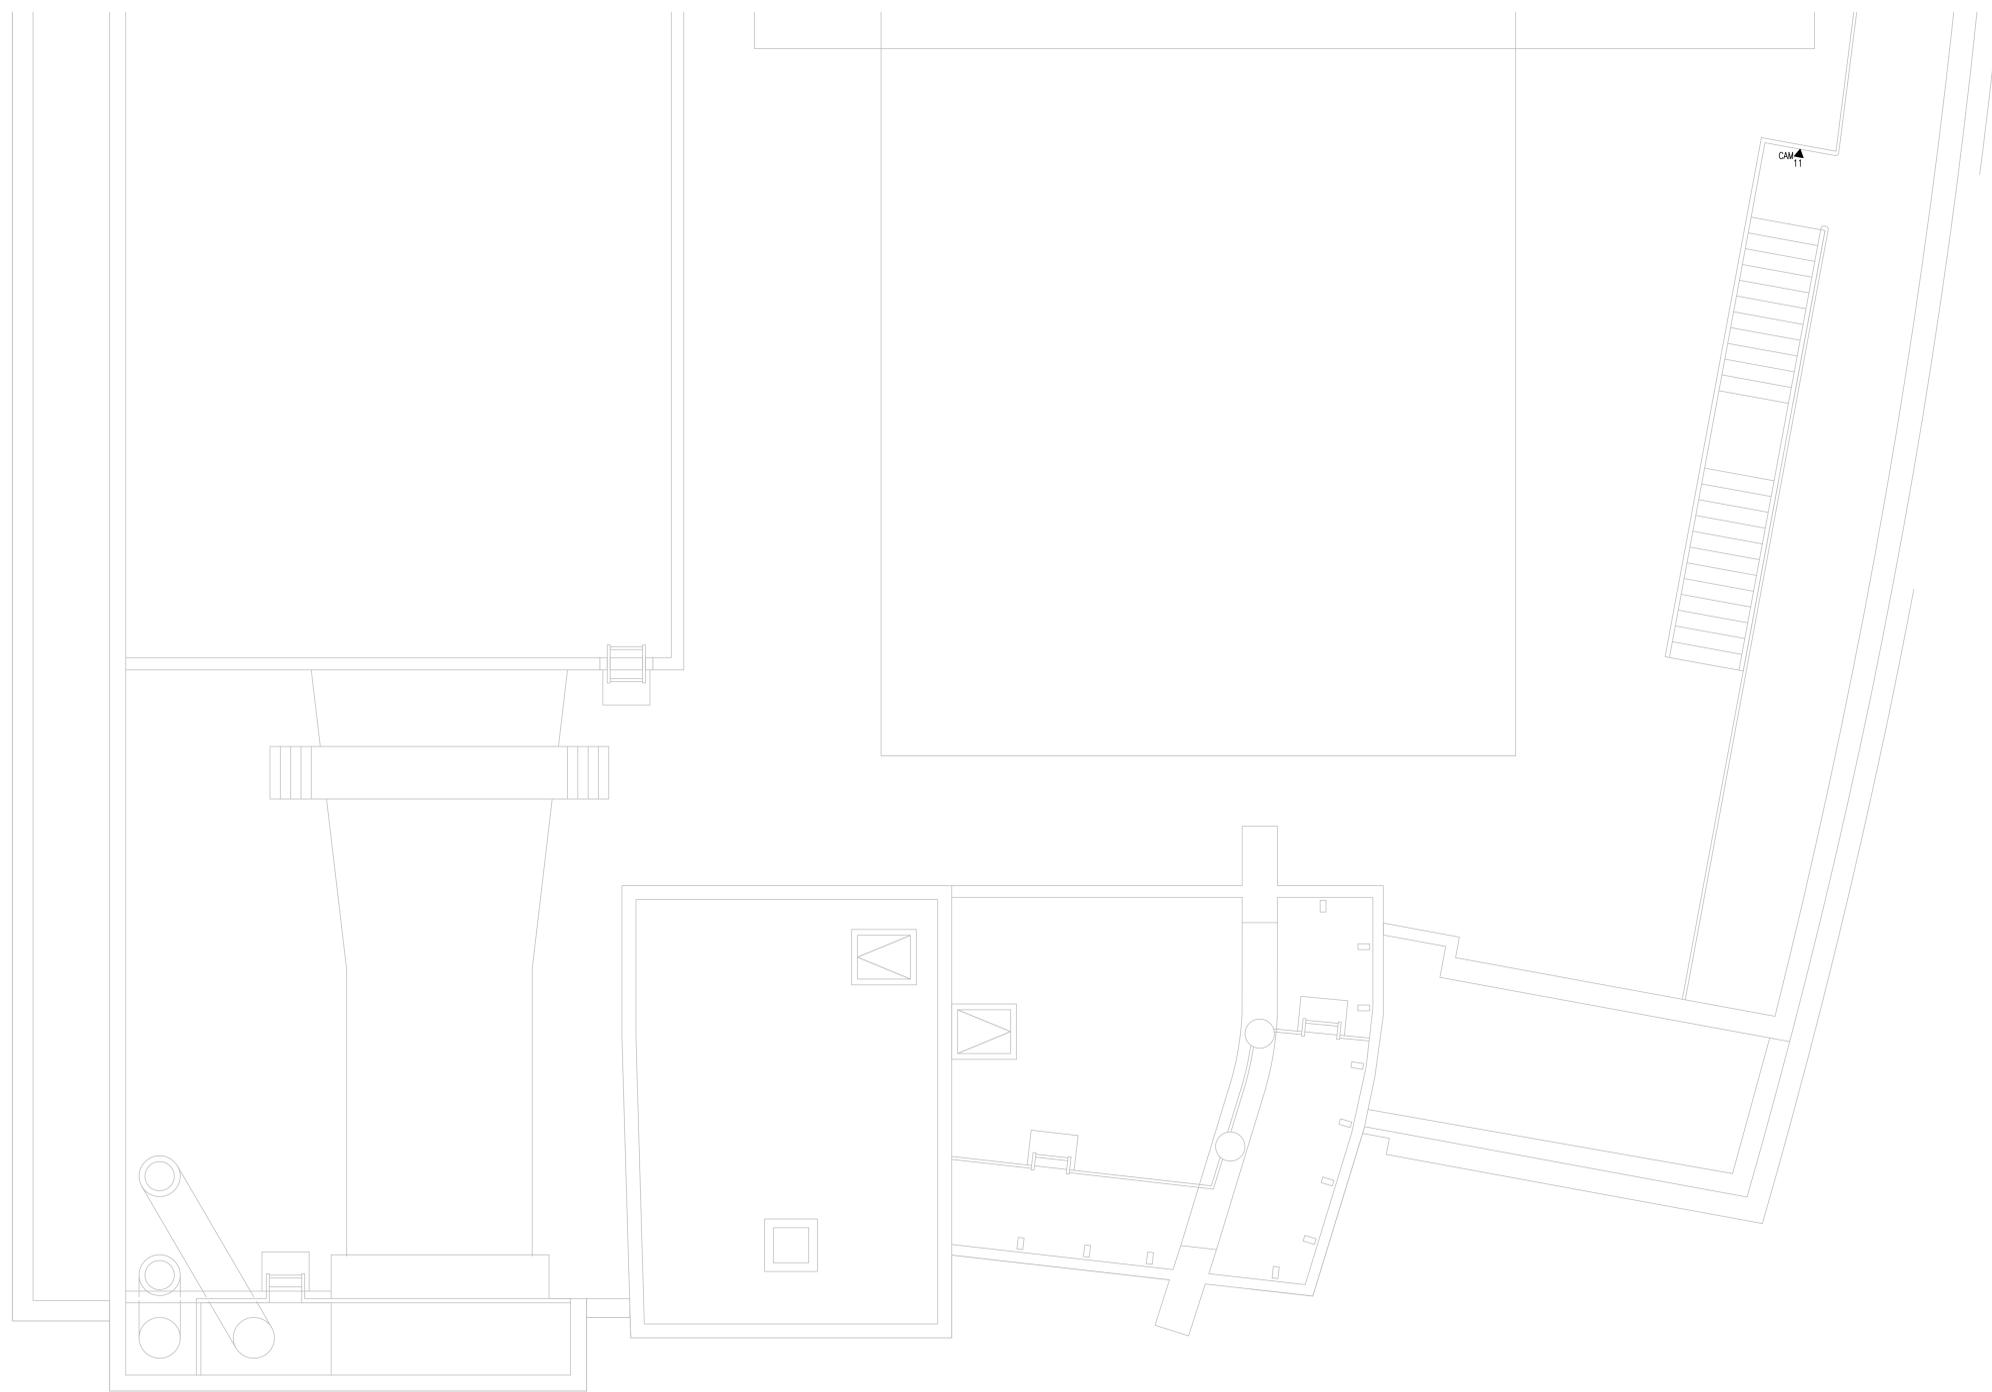

○ SHEET KEYNOTES

1. 12"W X 6"H CABLE RUNWAY
2. 24"W X 6"H CABLE RUNWAY
3. 18"W X 6"H CABLE RUNWAY
4. OUTLETS ARE TO BE FED VIA WALL FROM ABOVE CEILING SPACE. PROVIDE TWO (2) 1-1/4" CONDUITS FROM CABLE RUNWAY TO MILLWORK. TERMINATE CONDUITS AT 24" A.F.F. AND EXTEND ONTO MILLWORK USING NON-METALLIC SURFACE RACEWAYS WITH MINIMUM OF 1"x1" INTERNAL AREA TO EACH OUTLET.

GENERAL SHEET NOTES

1. THE DRAWINGS ARE DIAGRAMMATIC ONLY AND MAY NOT SHOW ALL COMPONENTS, MATERIALS, OFFSETS, BENDS, ELBOWS AND OTHER SPECIFIC ELEMENTS THAT MAY BE REQUIRED FOR A COMPLETE INSTALLATION. THE CONTRACTOR SHALL BE RESPONSIBLE FOR PROVIDING ALL MATERIALS NEEDED FOR A COMPLETE AND FUNCTIONAL INSTALLATION.
2. ELECTRIC EQUIPMENT AND DEVICES (E.G. PBX, NETWORK SWITCHES) ARE SHOWN FOR REFERENCE ONLY.
3. REFER TO ARCHITECTURAL DETAIL PLANS FOR FINAL PATIENT ROOM DEVICE LOCATIONS. REFER TO ARCHITECTURAL DETAILS FOR OVERCOUNTER WAO HEIGHTS. REFER TO ARCHITECTURAL DETAILS FOR WALL-MOUNT WAO HEIGHTS.
4. HORIZONTAL DATA/VOICE/VIDEO CABLE SHALL TERMINATE IN THE TECHNOLOGY ROOM ON THE SAME FLOOR AS THE WORK AREA OUTLETS.
5. WORK AREA OUTLETS SHALL CONSIST OF SINGLE PLASTER REDUCING RINGS INSTALLED ON OVERSIZE DOUBLE GANG BACKBOXES, UNLESS OTHERWISE NOTED.
6. TV COAX CABLES SHALL BE COILED IN THE RESPECTIVE TECHNOLOGY ROOMS WITH A 20' SERVICE LOOP PRIOR TO TERMINATIONS. COILS SHALL BE SECURED TO THE AUDIOVISUAL WALL FIELD FOR AV CONTRACTOR.
7. COMMON LOW VOLTAGE CABLE RUNWAY IS 24" W X 6" HIGH. PROVIDE ALL MATERIALS AS NEEDED FOR A COMPLETE, MANUFACTURER-APPROVED SYSTEM USING CABLE TRAY MANUFACTURERS MATERIALS AND PARTS WHEN AVAILABLE FROM THE MANUFACTURER AND AS INTENDED. REFER TO DRAWING T4.01 FOR DETAILS. ALL CHANGES IN DIRECTION AND INTERSECTIONS SHALL USE PRE-MANUFACTURED OR FIELD-INSTALLED SWEEPS AND TEES. ALL SWEEPS AND TEES SHALL MAINTAIN A 1 FOOT MINIMUM RADIUS IN CHANGES OF DIRECTION.
8. CABLE TRAY SHALL NOT PENETRATE WALLS. PROVIDE TRANSITION FROM CABLE TRAY TO LISTED FIRESTOP ASSEMBLIES IN ORDER TO PENETRATE FIRESTOP WALLS. TRANSITION TO 4" CONDUITS/SLEEVES FOR NON-RATED WALLS. PROVIDE SUFFICIENT CONDUITS/SLEEVES TO ACCOMMODATE 100% VISUAL CABLE TRAY LOAD AT 50% VISUAL CONDUIT FILL.
9. REFER TO ELECTRICAL DRAWINGS & SPECIFICATIONS FOR SHARED FLOOR BOXES & LOW VOLTAGE CONDUIT.
10. PROVIDE BRACING TO MEET OSHPD SEISMIC REQUIREMENTS. REFER TO SHEET T4.02 FOR MORE INFORMATION.
11. PROVIDE ALL OUTLET CONDUITS FROM WORK AREA OUTLETS, DEVICES OR PULL BOXES TO NEAREST CABLE TRAY.
12. INSTALL CABLE TRAY @ 6' ABOVE CEILING.

T3 LEVEL P2 - TELECOM PLAN - AREA A
1/4" = 1'-0"

PROJECT: CHILDREN'S HOSPITAL OF ORANGE COUNTY - TOWER II
ADDRESS: 455 South Main Street Orange, CA 92668-3874
W.O. NO.: 12684

PROPRIETARY STATEMENT
THESE DRAWINGS DOCUMENTS HEREBY ATTACHED ARE THE PROPERTY OF BERGELECTRIC CORPORATION ANY REUSE OR REPRODUCTION OF THESE DOCUMENTS WITHOUT WRITTEN PERMISSION OF BERGELECTRIC CORPORATION IS STRICTLY FORBIDDEN. ALL RIGHTS RESERVED.

DRAWN BY:
J. RAMIREZ

DESIGN SUPERVISOR:

INSTALL SUPERVISOR:

Scott Adams
Tel Data Systems
Bergelectric Corporation
650 Oppper Street
Escondido, CA 92029

REVISION:

05-30-12 RECORD DRAWINGS

SHEET TITLE:


TELECOM FLOOR PLAN LEVEL P2 AREA-A

SCALE:

1/4" = 1'-0"

DRAWING NO.:

T3.P2A
RECORD DRAWING

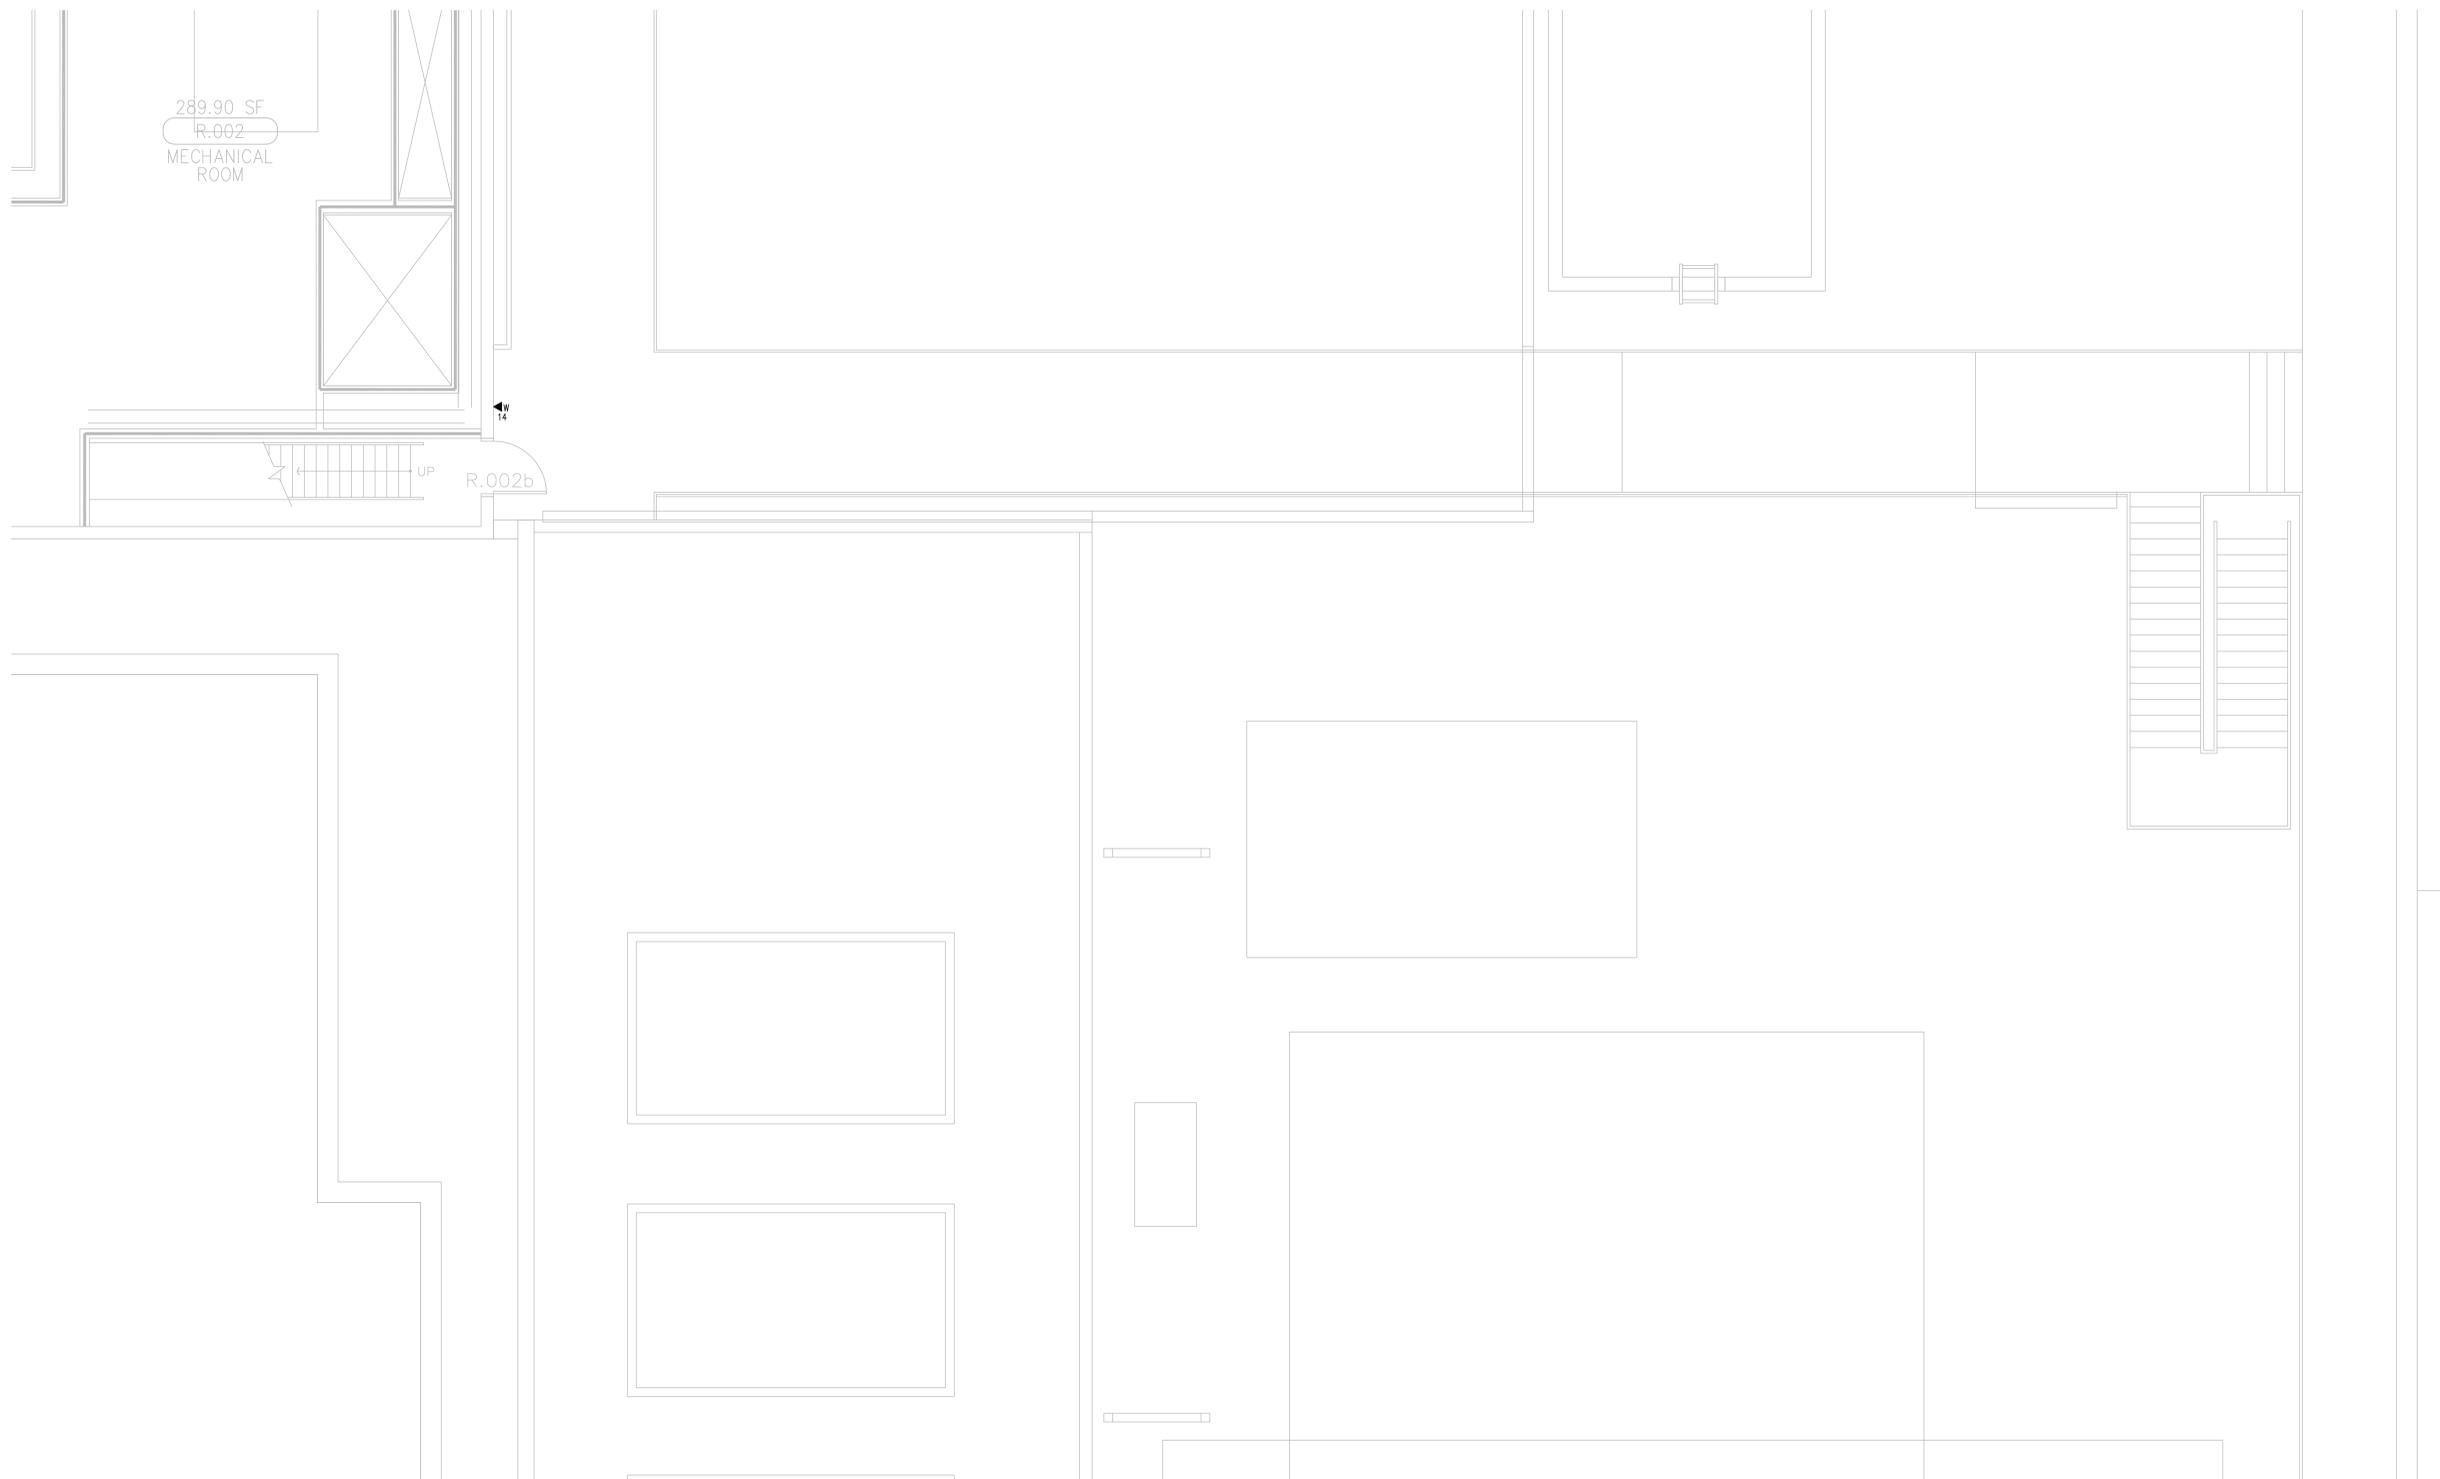

PROJECT: CHILDREN'S HOSPITAL OF ORANGE COUNTY - TOWER II
ADDRESS: 455 South Main Street Orange, CA 92668-3874
W.O. NO.: 12684

PROPRIETARY STATEMENT
 THESE DRAWINGS AND DOCUMENTS HEREBY ATTACHED ARE THE PROPERTY OF BERGELECTRIC CORPORATION ANY REUSE OR REPRODUCTION OF THESE DOCUMENTS WITHOUT WRITTEN PERMISSION OF BERGELECTRIC CORPORATION IS STRICTLY FORBIDDEN. ALL RIGHTS RESERVED.

DRAWN BY:
 J. RAMIREZ

DESIGN SUPERVISOR:

INSTALL SUPERVISOR:
 Scott Adams
 Tel Data Systems
 Bergelectric Corporation
 650 Oppper Street
 Escondido, CA 92029

REVISION:

05-30-12	RECORD DRAWINGS

SHEET TITLE:
 TELECOM FLOOR PLAN LEVEL P2 AREA-G

SCALE:
 1/4"=1'0"

DRAWING NO.:
 T3.P2G
 RECORD DRAWING


○ SHEET KEYNOTES

- 12" W X 6" H CABLE RUNWAY
- 24" W X 6" H CABLE RUNWAY
- 18" W X 6" H CABLE RUNWAY
- OUTLETS ARE TO BE FED VIA WALL FROM ABOVE CEILING SPACE. PROVIDE TWO (2) 1-1/4" CONDUITS FROM CABLE RUNWAY TO MILLWORK. TERMINATE CONDUITS AT 24" A.F.F. AND EXTEND ONTO MILLWORK USING NON-METALLIC SURFACE RACEWAYS WITH MINIMUM OF 1"x1" INTERNAL AREA TO EACH OUTLET.

GENERAL SHEET NOTES

- THE DRAWINGS ARE DIAGRAMMATIC ONLY AND MAY NOT SHOW ALL COMPONENTS, MATERIALS, OFFSETS, BENDS, ELBOWS AND OTHER SPECIFIC ELEMENTS THAT MAY BE REQUIRED FOR A COMPLETE INSTALLATION. THE CONTRACTOR SHALL BE RESPONSIBLE FOR PROVIDING ALL MATERIALS NEEDED FOR A COMPLETE AND FUNCTIONAL INSTALLATION.
- ELECTRIC EQUIPMENT AND DEVICES (E.G. PBX, NETWORK SWITCHES) ARE SHOWN FOR REFERENCE ONLY.
- REFER TO ARCHITECTURAL DETAIL PLANS FOR FINAL PATIENT ROOM DEVICE LOCATIONS. REFER TO ARCHITECTURAL DETAILS FOR OVERCOUNTER WAO HEIGHTS. REFER TO ARCHITECTURAL DETAILS FOR WALL-MOUNT WAO HEIGHTS.
- HORIZONTAL DATA/VOICE/VIDEO CABLE SHALL TERMINATE IN THE TECHNOLOGY ROOM ON THE SAME FLOOR AS THE WORK AREA OUTLETS.
- WORK AREA OUTLETS SHALL CONSIST OF SINGLE PLASTER REDUCING RINGS INSTALLED ON OVERSIZE DOUBLE GANG BACKBOXES, UNLESS OTHERWISE NOTED.
- TV COAX CABLES SHALL BE COILED IN THE RESPECTIVE TECHNOLOGY ROOMS WITH A 20' SERVICE LOOP PRIOR TO TERMINATIONS. COILS SHALL BE SECURED TO THE AUDIOVISUAL WALL FIELD FOR AV CONTRACTOR.
- COMMON LOW VOLTAGE CABLE RUNWAY IS 24" W X 6" H HIGH. PROVIDE ALL MATERIALS AS NEEDED FOR A COMPLETE, MANUFACTURER-APPROVED SYSTEM USING CABLE TRAY MANUFACTURERS MATERIALS AND PARTS WHEN AVAILABLE FROM THE MANUFACTURER AND AS INTENDED. REFER TO DRAWING T4.01 FOR DETAILS. ALL CHANGES IN DIRECTION AND INTERSECTIONS SHALL USE PRE-MANUFACTURED OR FIELD-INSTALLED SWEEPS AND TEES. ALL SWEEPS AND TEES SHALL MAINTAIN A 1 FOOT MINIMUM RADIUS IN CHANGES OF DIRECTION.
- CABLE TRAY SHALL NOT PENETRATE WALLS. PROVIDE TRANSITION FROM CABLE TRAY TO LISTED FIRESTOP ASSEMBLIES IN ORDER TO PENETRATE FIRE/SMOKE WALLS. TRANSITION TO 4" CONDUITS/SLEEVES FOR NON-RATED WALLS. PROVIDE SUFFICIENT CONDUITS/SLEEVES TO ACCOMMODATE 100% VISUAL CABLE TRAY LOAD AT 50% VISUAL CONDUIT FILL.
- REFER TO ELECTRICAL DRAWINGS & SPECIFICATIONS FOR SHARED FLOOR BOXES & LOW VOLTAGE CONDUIT.
- PROVIDE BRACING TO MEET OSHPD SEISMIC REQUIREMENTS. REFER TO SHEET T4.02 FOR MORE INFORMATION.
- PROVIDE ALL OUTLET CONDUITS FROM WORK AREA OUTLETS, DEVICES OR PULL BOXES TO NEAREST CABLE TRAY.
- INSTALL CABLE TRAY @ 6" ABOVE CEILING.

T3 LEVEL P2 - TELECOM PLAN - AREA G
 1/4" = 1'-0"

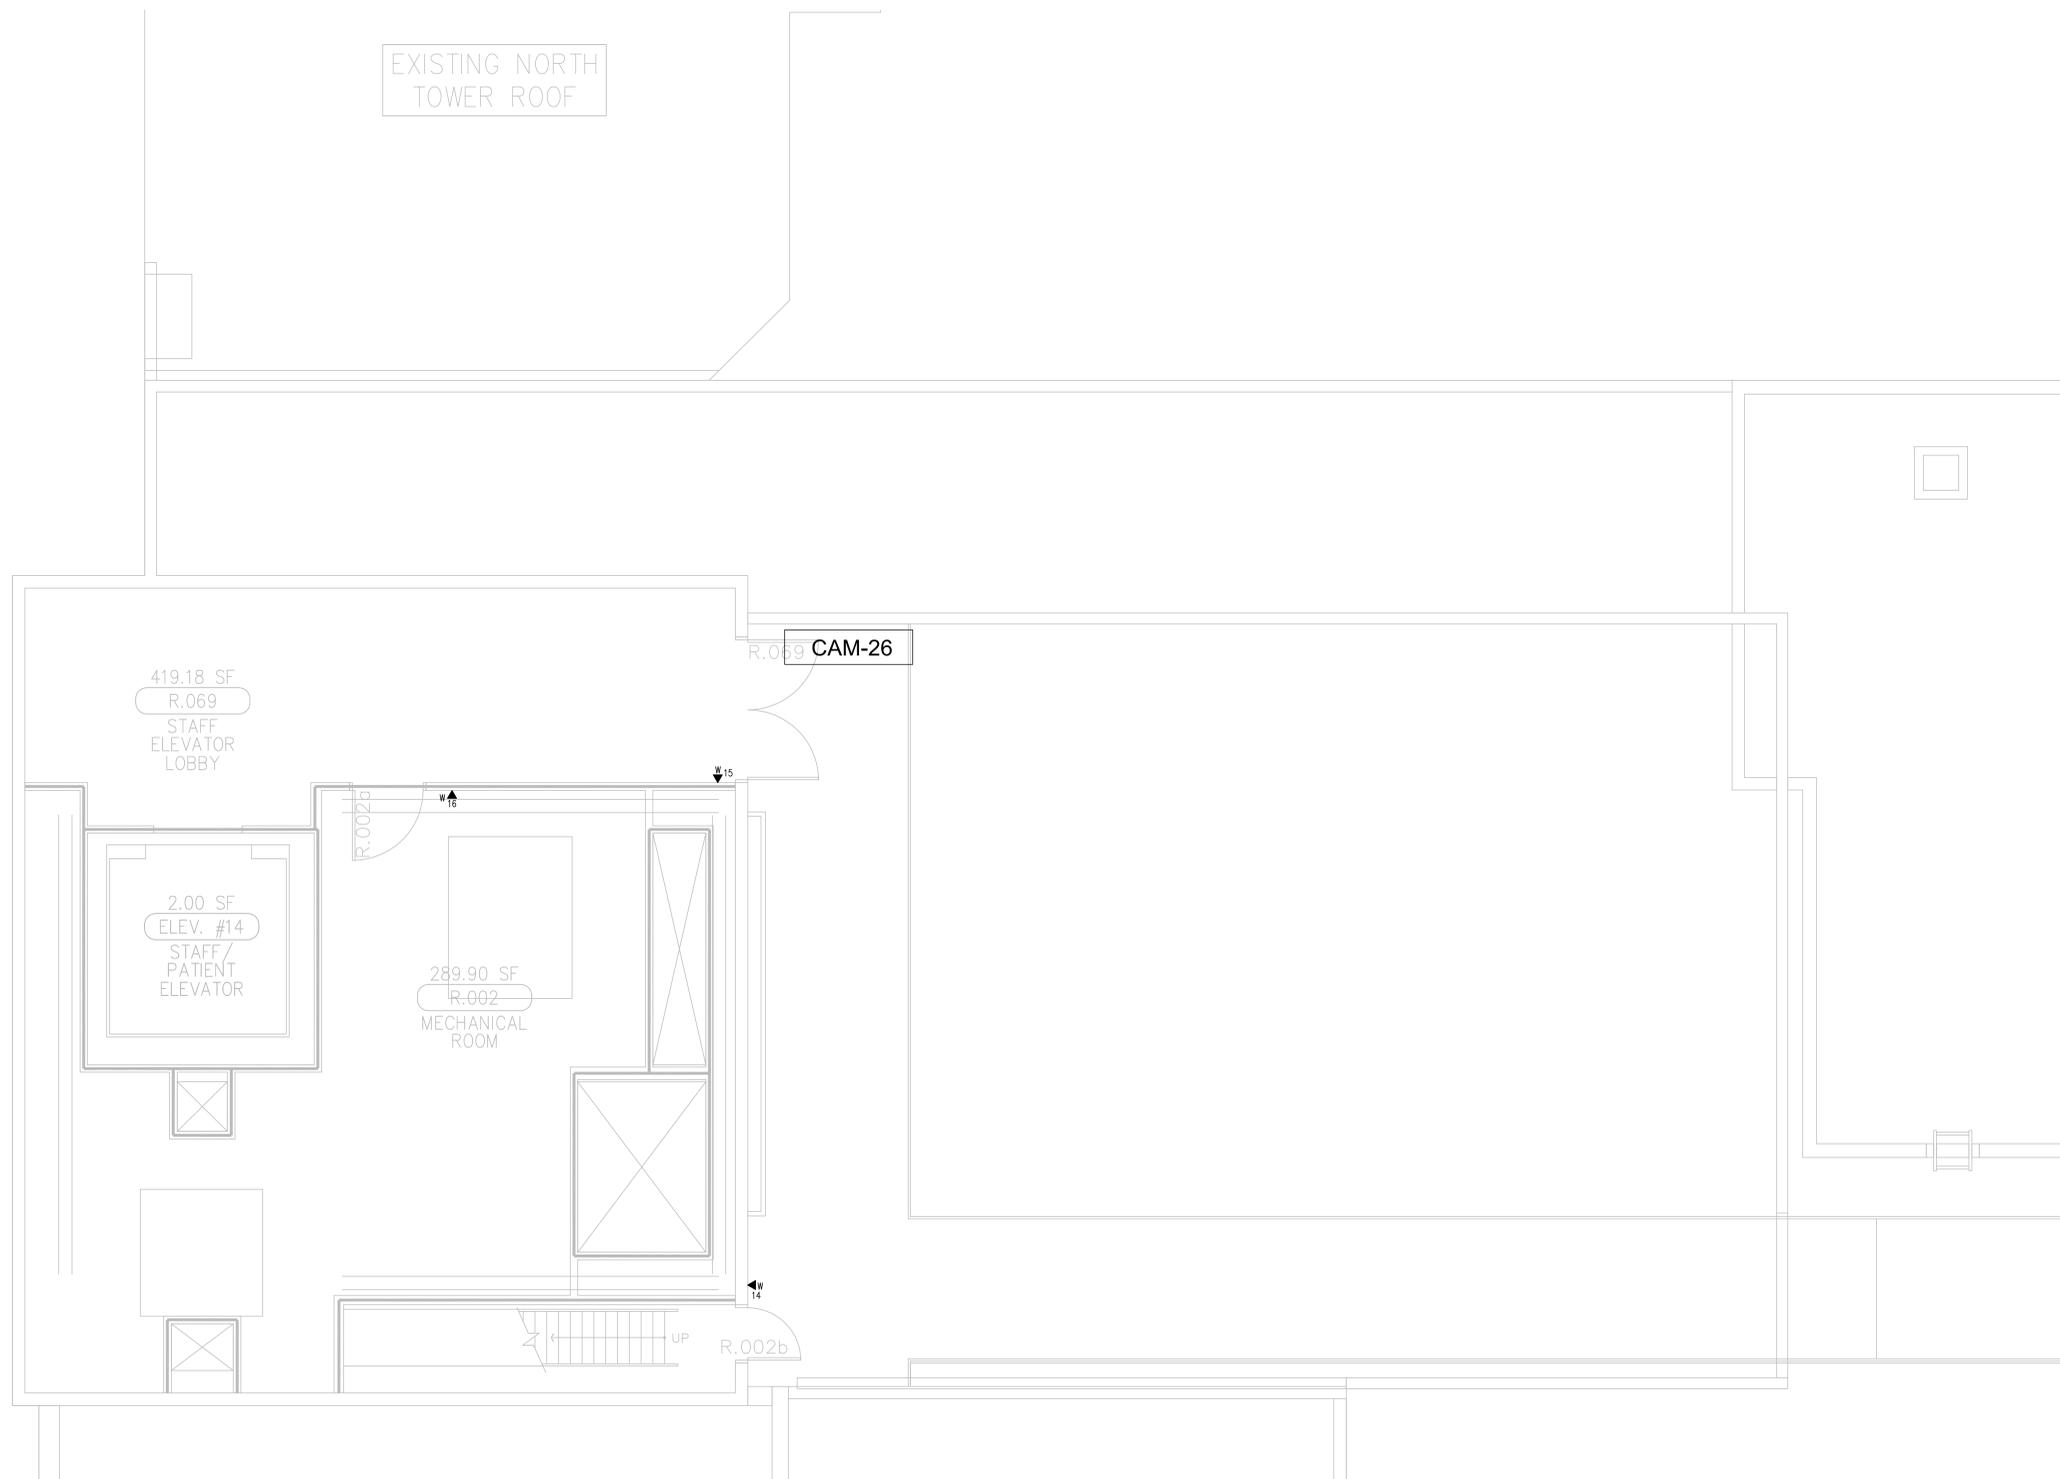

EXISTING NORTH
TOWER ROOF

419.18 SF
R.069
STAFF
ELEVATOR
LOBBY

2.00 SF
ELEV. #14
STAFF/
PATIENT
ELEVATOR

289.90 SF
R.002
MECHANICAL
ROOM

R.069 CAM-26

R.069

R.002a

R.002b

○ SHEET KEYNOTES

1. 12" W X 6" H CABLE RUNWAY
2. 24" W X 6" H CABLE RUNWAY
3. 18" W X 6" H CABLE RUNWAY
4. OUTLETS ARE TO BE FED VIA WALL FROM ABOVE CEILING SPACE. PROVIDE TWO (2) 1-1/4" CONDUITS FROM CABLE RUNWAY TO MILLWORK. TERMINATE CONDUITS AT 24" A.F.F. AND EXTEND ONTO MILLWORK USING NON-METALLIC SURFACE RACEWAYS WITH MINIMUM OF 1"x1" INTERNAL AREA TO EACH OUTLET.

GENERAL SHEET NOTES

1. THE DRAWINGS ARE DIAGRAMMATIC ONLY AND MAY NOT SHOW ALL COMPONENTS, MATERIALS, OFFSETS, BENDS, ELBOWS AND OTHER SPECIFIC ELEMENTS THAT MAY BE REQUIRED FOR A COMPLETE INSTALLATION. THE CONTRACTOR SHALL BE RESPONSIBLE FOR PROVIDING ALL MATERIALS NEEDED FOR A COMPLETE AND FUNCTIONAL INSTALLATION.
2. ELECTRIC EQUIPMENT AND DEVICES (E.G. PBX, NETWORK SWITCHES) ARE SHOWN FOR REFERENCE ONLY.
3. REFER TO ARCHITECTURAL DETAIL PLANS FOR FINAL PATIENT ROOM DEVICE LOCATIONS. REFER TO ARCHITECTURAL DETAILS FOR OVERCOUNTER WAO HEIGHTS. REFER TO ARCHITECTURAL DETAILS FOR WALL-MOUNT WAO HEIGHTS.
4. HORIZONTAL DATA/VOICE/VIDEO CABLE SHALL TERMINATE IN THE TECHNOLOGY ROOM ON THE SAME FLOOR AS THE WORK AREA OUTLETS.
5. WORK AREA OUTLETS SHALL CONSIST OF SINGLE PLASTER REDUCING RINGS INSTALLED ON OVERSIZE DOUBLE GANG BACKBOXES, UNLESS OTHERWISE NOTED.
6. TV COAX CABLES SHALL BE COILED IN THE RESPECTIVE TECHNOLOGY ROOMS WITH A 20' SERVICE LOOP PRIOR TO TERMINATIONS. COILS SHALL BE SECURED TO THE AUDIOVISUAL WALL FIELD FOR AV CONTRACTOR.
7. COMMON LOW VOLTAGE CABLE RUNWAY IS 24" W X 6" H HIGH. PROVIDE ALL MATERIALS AS NEEDED FOR A COMPLETE, MANUFACTURER-APPROVED SYSTEM USING CABLE TRAY MANUFACTURERS MATERIALS AND PARTS WHEN AVAILABLE FROM THE MANUFACTURER AND AS INTENDED. REFER TO DRAWING T4.01 FOR DETAILS. ALL CHANGES IN DIRECTION AND INTERSECTIONS SHALL USE PRE-MANUFACTURED OR FIELD-INSTALLED SWEEPS AND TEES. ALL SWEEPS AND TEES SHALL MAINTAIN A 1 FOOT MINIMUM RADIUS IN CHANGES OF DIRECTION.
8. CABLE TRAY SHALL NOT PENETRATE WALLS. PROVIDE TRANSITION FROM CABLE TRAY TO LISTED FIRESTOP ASSEMBLIES IN ORDER TO PENETRATE FIRESTOP WALLS. TRANSITION TO 4" CONDUITS/SLEEVES FOR NON-RATED WALLS. PROVIDE SUFFICIENT CONDUITS/SLEEVES TO ACCOMMODATE 100% VISUAL CABLE TRAY LOAD AT 50% VISUAL CONDUIT FILL.
9. REFER TO ELECTRICAL DRAWINGS & SPECIFICATIONS FOR SHARED FLOOR BOXES & LOW VOLTAGE CONDUIT.
10. PROVIDE BRACING TO MEET OSHPD SEISMIC REQUIREMENTS. REFER TO SHEET T4.02 FOR MORE INFORMATION.
11. PROVIDE ALL OUTLET CONDUITS FROM WORK AREA OUTLETS, DEVICES OR PULL BOXES TO NEAREST CABLE TRAY.
12. INSTALL CABLE TRAY @ 6' ABOVE CEILING.

T3 LEVEL P2 - TELECOM PLAN - AREA H
1/4" = 1'-0"

Bergelectric Corp.
Contractors & Engineers



650 UPPER ST.
ESCONDIDO, CA 92029

(760) 746-1003
FAX (760) 746-6919

PROJECT: CHILDREN'S HOSPITAL
OF ORANGE COUNTY - TOWER II

ADDRESS: 455 South Main Street
Orange, CA 92668-3874

W.O. NO.: 12684

PROPRIETARY STATEMENT
THESE DRAWINGS AND DOCUMENTS HEREBY ATTACHED ARE THE PROPERTY OF BERGELECTRIC CORPORATION ANY REUSE OR REPRODUCTION OF THESE DOCUMENTS WITHOUT WRITTEN PERMISSION OF BERGELECTRIC CORPORATION IS STRICTLY FORBIDDEN. ALL RIGHTS RESERVED.

DRAWN BY:
J. RAMIREZ

DESIGN SUPERVISOR:

INSTALL SUPERVISOR:
Scott Adams
Tel Data Systems
Bergelectric Corporation
650 Upper Street
Escondido, CA 92029

REVISION:

NO.	DATE	DESCRIPTION
05-30-12	RECORD DRAWINGS	

SHEET TITLE:

TELECOM
FLOOR PLAN
LEVEL P2
AREA-H

SCALE:
1/4" = 1'-0"

DRAWING NO.:

T3.P2H
RECORD
DRAWING

PROPRIETARY STATEMENT
 THESE DRAWINGS DOCUMENTS HEREIN ATTACHED ARE THE
 PROPERTY OF BERGELECTRIC CORPORATION ANY REUSE OR
 REPRODUCTION OF THESE DOCUMENTS WITHOUT WRITTEN
 PERMISSION OF BERGELECTRIC CORPORATION IS STRICTLY
 FORBIDDEN. ALL RIGHTS RESERVED.

DRAWN BY:
 J. RAMIREZ

DESIGN SUPERVISOR:

INSTALL SUPERVISOR:

Scott Adams
 Tel Data Systems
 Bergelectric Corporation
 650 Opper Street
 Escondido, CA 92029

REVISION:
 05-30-12 RECORD DRAWINGS


NO.	REVISION

SHEET TITLE:

TELECOM
 FLOOR PLAN
 LEVEL P2
 AREA-M

SCALE:
 1/4"=1'0"

DRAWING NO.:
 T3.P2M
 RECORD
 DRAWING

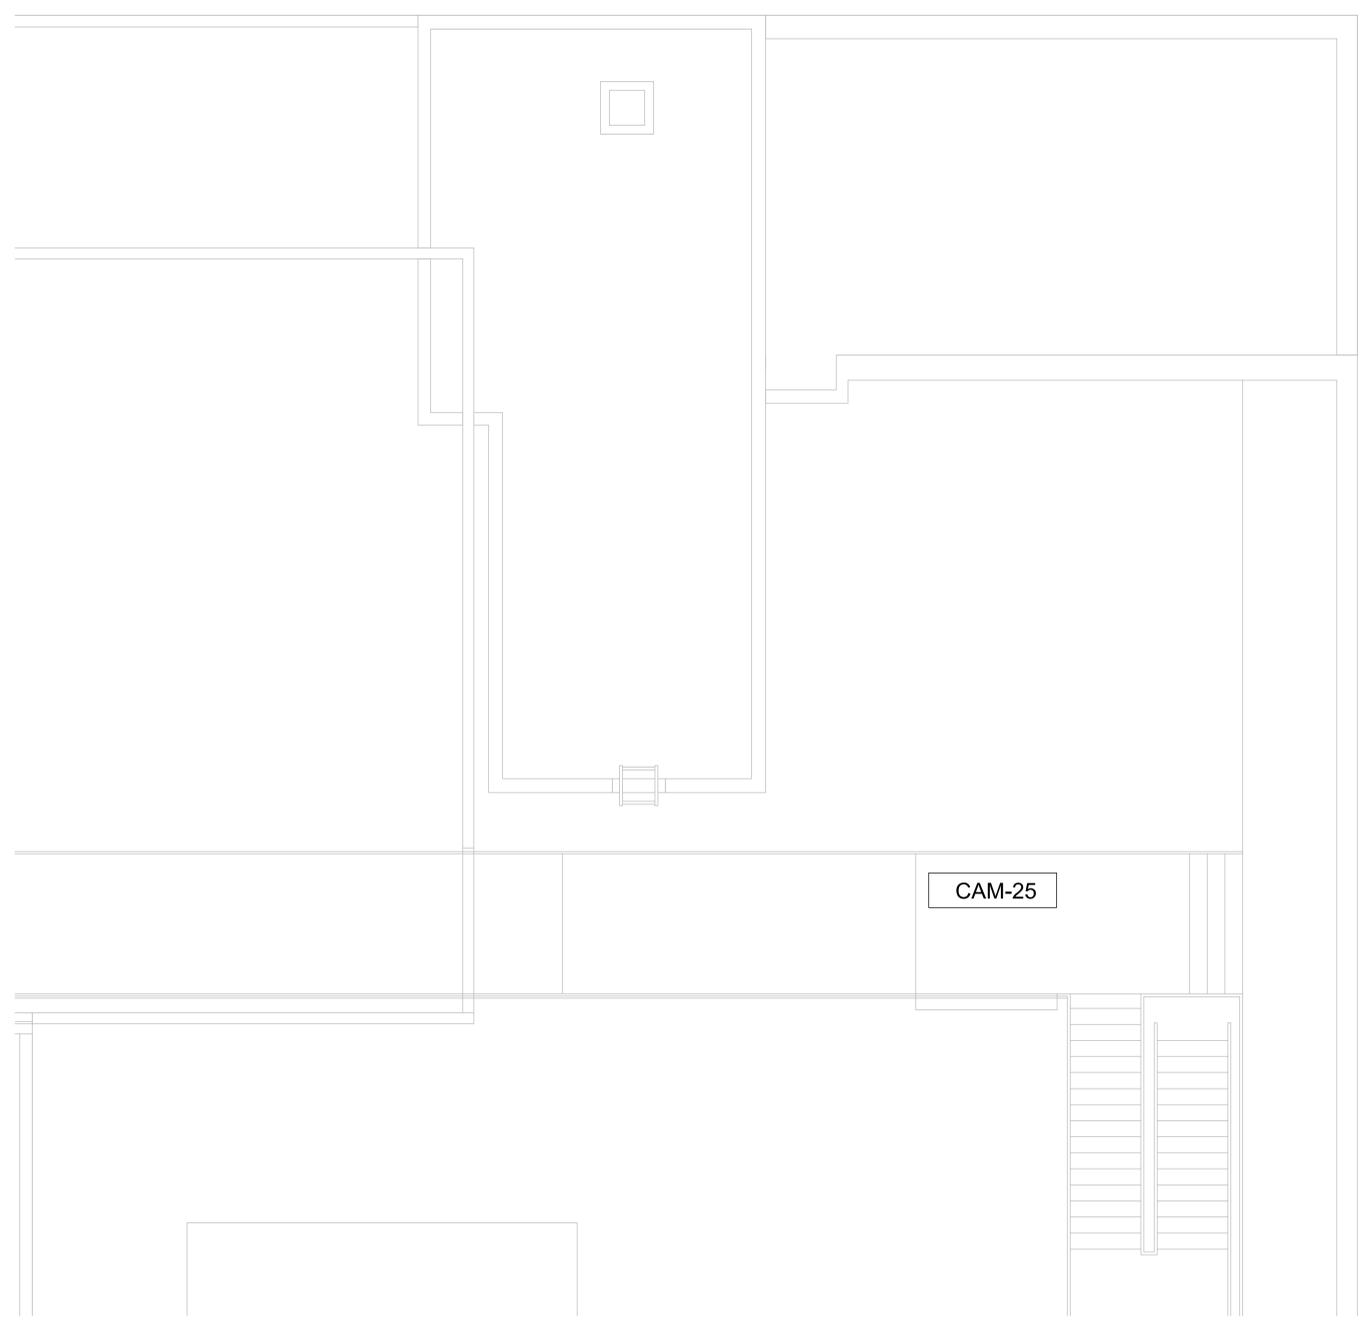


○ SHEET KEYNOTES

- 12" W X 6" H CABLE RUNWAY
- 24" W X 6" H CABLE RUNWAY
- 18" W X 6" H CABLE RUNWAY
- OUTLETS ARE TO BE FED VIA WALL FROM ABOVE CEILING SPACE. PROVIDE TWO (2) 1-1/4" CONDUITS FROM CABLE RUNWAY TO MILLWORK. TERMINATE CONDUITS AT 24" A.F.F. AND EXTEND ONTO MILLWORK USING NON-METALLIC SURFACE RACEWAYS WITH MINIMUM OF 1"x1" INTERNAL AREA TO EACH OUTLET.

GENERAL SHEET NOTES

- THE DRAWINGS ARE DIAGRAMMATIC ONLY AND MAY NOT SHOW ALL COMPONENTS, MATERIALS, OFFSETS, BENDS, ELBOWS AND OTHER SPECIFIC ELEMENTS THAT MAY BE REQUIRED FOR A COMPLETE INSTALLATION. THE CONTRACTOR SHALL BE RESPONSIBLE FOR PROVIDING ALL MATERIALS NEEDED FOR A COMPLETE AND FUNCTIONAL INSTALLATION.
- ELECTRIC EQUIPMENT AND DEVICES (E.G. PBX, NETWORK SWITCHES) ARE SHOWN FOR REFERENCE ONLY.
- REFER TO ARCHITECTURAL DETAIL PLANS FOR FINAL PATIENT ROOM DEVICE LOCATIONS. REFER TO ARCHITECTURAL DETAILS FOR OVERCOUNTER WAO HEIGHTS. REFER TO ARCHITECTURAL DETAILS FOR WALL-MOUNT WAO HEIGHTS.
- HORIZONTAL DATA/VOICE/VIDEO CABLE SHALL TERMINATE IN THE TECHNOLOGY ROOM ON THE SAME FLOOR AS THE WORK AREA OUTLETS.
- WORK AREA OUTLETS SHALL CONSIST OF SINGLE PLASTER REDUCING RINGS INSTALLED ON OVERSIZE DOUBLE GANG BACKBOXES, UNLESS OTHERWISE NOTED.
- TV COAX CABLES SHALL BE COILED IN THE RESPECTIVE TECHNOLOGY ROOMS WITH A 20' SERVICE LOOP PRIOR TO TERMINATIONS. COILS SHALL BE SECURED TO THE AUDIOVISUAL WALL FIELD FOR AV CONTRACTOR.
- COMMON LOW VOLTAGE CABLE RUNWAY IS 24" W X 6" H HIGH. PROVIDE ALL MATERIALS AS NEEDED FOR A COMPLETE, MANUFACTURER-APPROVED SYSTEM USING CABLE TRAY MANUFACTURERS MATERIALS AND PARTS WHEN AVAILABLE FROM THE MANUFACTURER AND AS INTENDED. REFER TO DRAWING T4.01 FOR DETAILS. ALL CHANGES IN DIRECTION AND INTERSECTIONS SHALL USE PRE-MANUFACTURED OR FIELD-INSTALLED SWEEPS AND TEES. ALL SWEEPS AND TEES SHALL MAINTAIN A 1 FOOT MINIMUM RADIUS IN CHANGES OF DIRECTION.
- CABLE TRAY SHALL NOT PENETRATE WALLS. PROVIDE TRANSITION FROM CABLE TRAY TO LISTED FIRESTOP ASSEMBLIES IN ORDER TO PENETRATE FIRESTOP WALLS. TRANSITION TO 4" CONDUITS/SLEEVES FOR NON-RATED WALLS. PROVIDE SUFFICIENT CONDUITS/SLEEVES TO ACCOMMODATE 100% VISUAL CABLE TRAY LOAD AT 50% VISUAL CONDUIT FILL.
- REFER TO ELECTRICAL DRAWINGS & SPECIFICATIONS FOR SHARED FLOOR BOXES & LOW VOLTAGE CONDUIT.
- PROVIDE BRACING TO MEET OSHPD SEISMIC REQUIREMENTS. REFER TO SHEET T4.02 FOR MORE INFORMATION.
- PROVIDE ALL OUTLET CONDUITS FROM WORK AREA OUTLETS, DEVICES OR PULL BOXES TO NEAREST CABLE TRAY.
- INSTALL CABLE TRAY @ 6" ABOVE CEILING.

T3 LEVEL P2 - TELECOM PLAN - AREA M
1/4" = 1'-0"

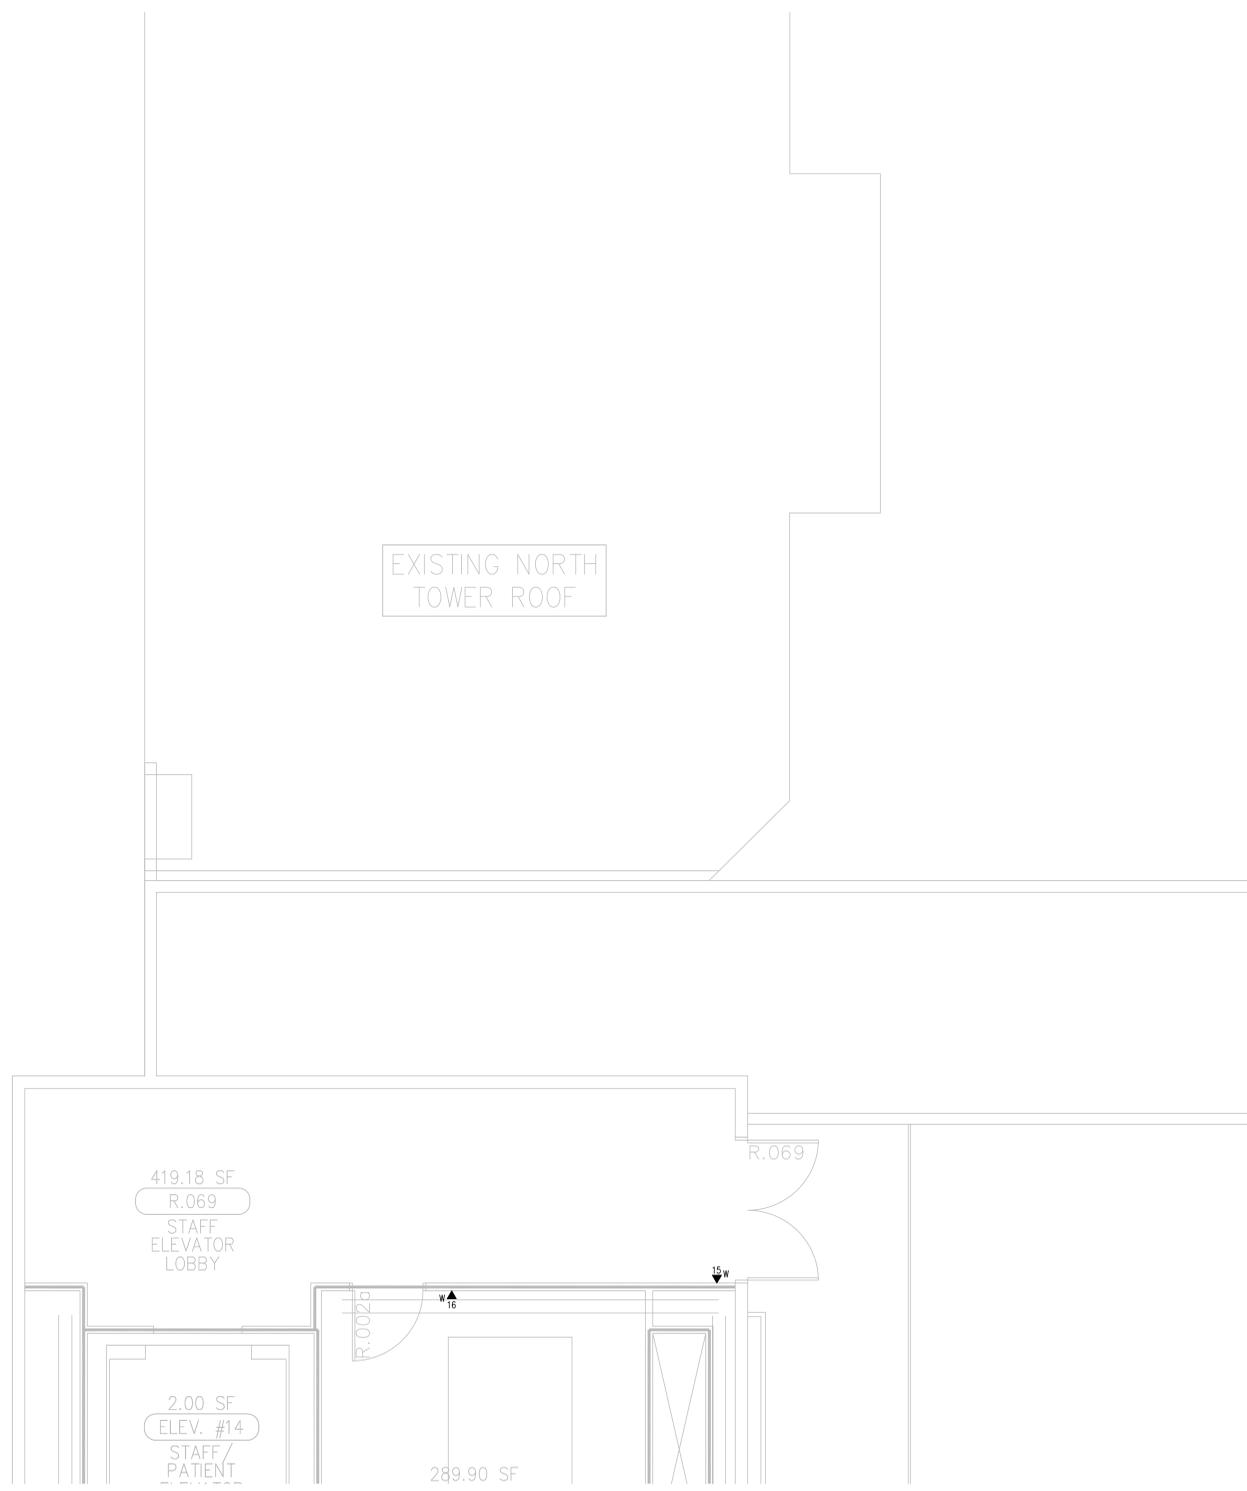


○ SHEET KEYNOTES

1. 12"W X 6"H CABLE RUNWAY
2. 24"W X 6"H CABLE RUNWAY
3. 18"W X 6"H CABLE RUNWAY
4. OUTLETS ARE TO BE FED VIA WALL FROM ABOVE CEILING SPACE. PROVIDE TWO (2) 1-1/4" CONDUITS FROM CABLE RUNWAY TO MILLWORK. TERMINATE CONDUITS AT 24" A.F.F. AND EXTEND ONTO MILLWORK USING NON-METALLIC SURFACE RACEWAYS WITH MINIMUM OF 1"x1" INTERNAL AREA TO EACH OUTLET.

GENERAL SHEET NOTES

1. THE DRAWINGS ARE DIAGRAMMATIC ONLY AND MAY NOT SHOW ALL COMPONENTS, MATERIALS, OFFSETS, BENDS, ELBOWS AND OTHER SPECIFIC ELEMENTS THAT MAY BE REQUIRED FOR A COMPLETE INSTALLATION. THE CONTRACTOR SHALL BE RESPONSIBLE FOR PROVIDING ALL MATERIALS NEEDED FOR A COMPLETE AND FUNCTIONAL INSTALLATION.
2. ELECTRIC EQUIPMENT AND DEVICES (E.G. PBX, NETWORK SWITCHES) ARE SHOWN FOR REFERENCE ONLY.
3. REFER TO ARCHITECTURAL DETAIL PLANS FOR FINAL PATIENT ROOM DEVICE LOCATIONS. REFER TO ARCHITECTURAL DETAILS FOR OVERCOUNTER WAO HEIGHTS. REFER TO ARCHITECTURAL DETAILS FOR WALL-MOUNT WAO HEIGHTS.
4. HORIZONTAL DATA/VOICE/VIDEO CABLE SHALL TERMINATE IN THE TECHNOLOGY ROOM ON THE SAME FLOOR AS THE WORK AREA OUTLETS.
5. WORK AREA OUTLETS SHALL CONSIST OF SINGLE PLASTER REDUCING RINGS INSTALLED ON OVERSIZE DOUBLE GANG BACKBOXES, UNLESS OTHERWISE NOTED.
6. TV COAX CABLES SHALL BE COILED IN THE RESPECTIVE TECHNOLOGY ROOMS WITH A 20' SERVICE LOOP PRIOR TO TERMINATIONS. COILS SHALL BE SECURED TO THE AUDIOVISUAL WALL FIELD FOR AV CONTRACTOR.
7. COMMON LOW VOLTAGE CABLE RUNWAY IS 24" W X 6" HIGH. PROVIDE ALL MATERIALS AS NEEDED FOR A COMPLETE, MANUFACTURER-APPROVED SYSTEM USING CABLE TRAY MANUFACTURERS MATERIALS AND PARTS WHEN AVAILABLE FROM THE MANUFACTURER AND AS INTENDED. REFER TO DRAWING T4.01 FOR DETAILS. ALL CHANGES IN DIRECTION AND INTERSECTIONS SHALL USE PRE-MANUFACTURED OR FIELD-INSTALLED SWEEPS AND TEES. ALL SWEEPS AND TEES SHALL MAINTAIN A 1 FOOT MINIMUM RADIUS IN CHANGES OF DIRECTION.
8. CABLE TRAY SHALL NOT PENETRATE WALLS. PROVIDE TRANSITION FROM CABLE TRAY TO LISTED FIRESTOP ASSEMBLIES IN ORDER TO PENETRATE FIRESTOP WALLS. TRANSITION TO 4" CONDUITS/SLEEVES FOR NON-RATED WALLS. PROVIDE SUFFICIENT CONDUITS/SLEEVES TO ACCOMMODATE 100% VISUAL CABLE TRAY LOAD AT 50% VISUAL CONDUIT FILL.
9. REFER TO ELECTRICAL DRAWINGS & SPECIFICATIONS FOR SHARED FLOOR BOXES & LOW VOLTAGE CONDUIT.
10. PROVIDE BRACING TO MEET OSHPD SEISMIC REQUIREMENTS. REFER TO SHEET T4.02 FOR MORE INFORMATION.
11. PROVIDE ALL OUTLET CONDUITS FROM WORK AREA OUTLETS, DEVICES OR PULL BOXES TO NEAREST CABLE TRAY.
12. INSTALL CABLE TRAY @ 6' ABOVE CEILING.

T3 LEVEL P2 - TELECOM PLAN - AREA P
1/4" = 1'-0"

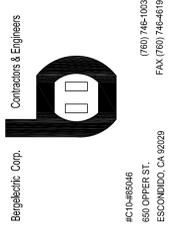

PROJECT: CHILDREN'S HOSPITAL OF ORANGE COUNTY - TOWER II
ADDRESS: 455 South Main Street Orange, CA 92668-3874
W.O. NO.: 12684

PROPRIETARY STATEMENT
THESE DRAWINGS AND DOCUMENTS HEREBY ATTACHED ARE THE PROPERTY OF BERGELECTRIC CORPORATION. ANY REUSE OR REPRODUCTION OF THESE DOCUMENTS WITHOUT WRITTEN PERMISSION OF BERGELECTRIC CORPORATION IS STRICTLY FORBIDDEN. ALL RIGHTS RESERVED.

DRAWN BY:
J. RAMIREZ

DESIGN SUPERVISOR:

INSTALL SUPERVISOR:
Scott Adams
Tel Data Systems
Bergelectric Corporation
650 Oppeer Street
Escondido, CA 92029

REVISION:

NO.	DATE	DESCRIPTION
05-30-12	RECORD DRAWINGS	

SHEET TITLE:
TELECOM FLOOR PLAN LEVEL P2 AREA-P

SCALE:
1/4" = 1'-0"

DRAWING NO.:
T3.P2P
RECORD DRAWING