


FKP Architects

ARCHITECT OF RECORD
Paul C. Gloriod

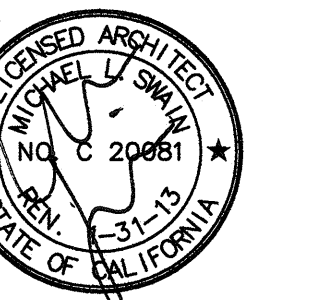


Changes on these drawings do not consist of
materially altered changes to approved drawings
and don't require a change order.
OSHPO review ACO
OSHPO review FLSO
OSHPO review DSE

REVISIONS

06/07/11 CO #181

APPROVAL

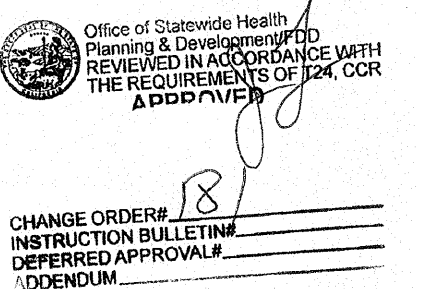

PROJECT NAME
**CHILDREN'S HOSPITAL
OF ORANGE COUNTY**
455 S. Main St.
Orange, CA 92668-3874

TOWER II
RECEIVED
June 08 2011
McCarthy



PROJECT NUMBER
**12011.00
Increment #7**

OSHPO - PROJECT NUMBER
IL 072072-30

ISSUE
OSHPO PERMIT

DATE
01/27/2010


SCALE

VARIES
DRAWING TITLE

INTERIOR SECTION
DETAIL

DRAWING NUMBER

A10.1.5

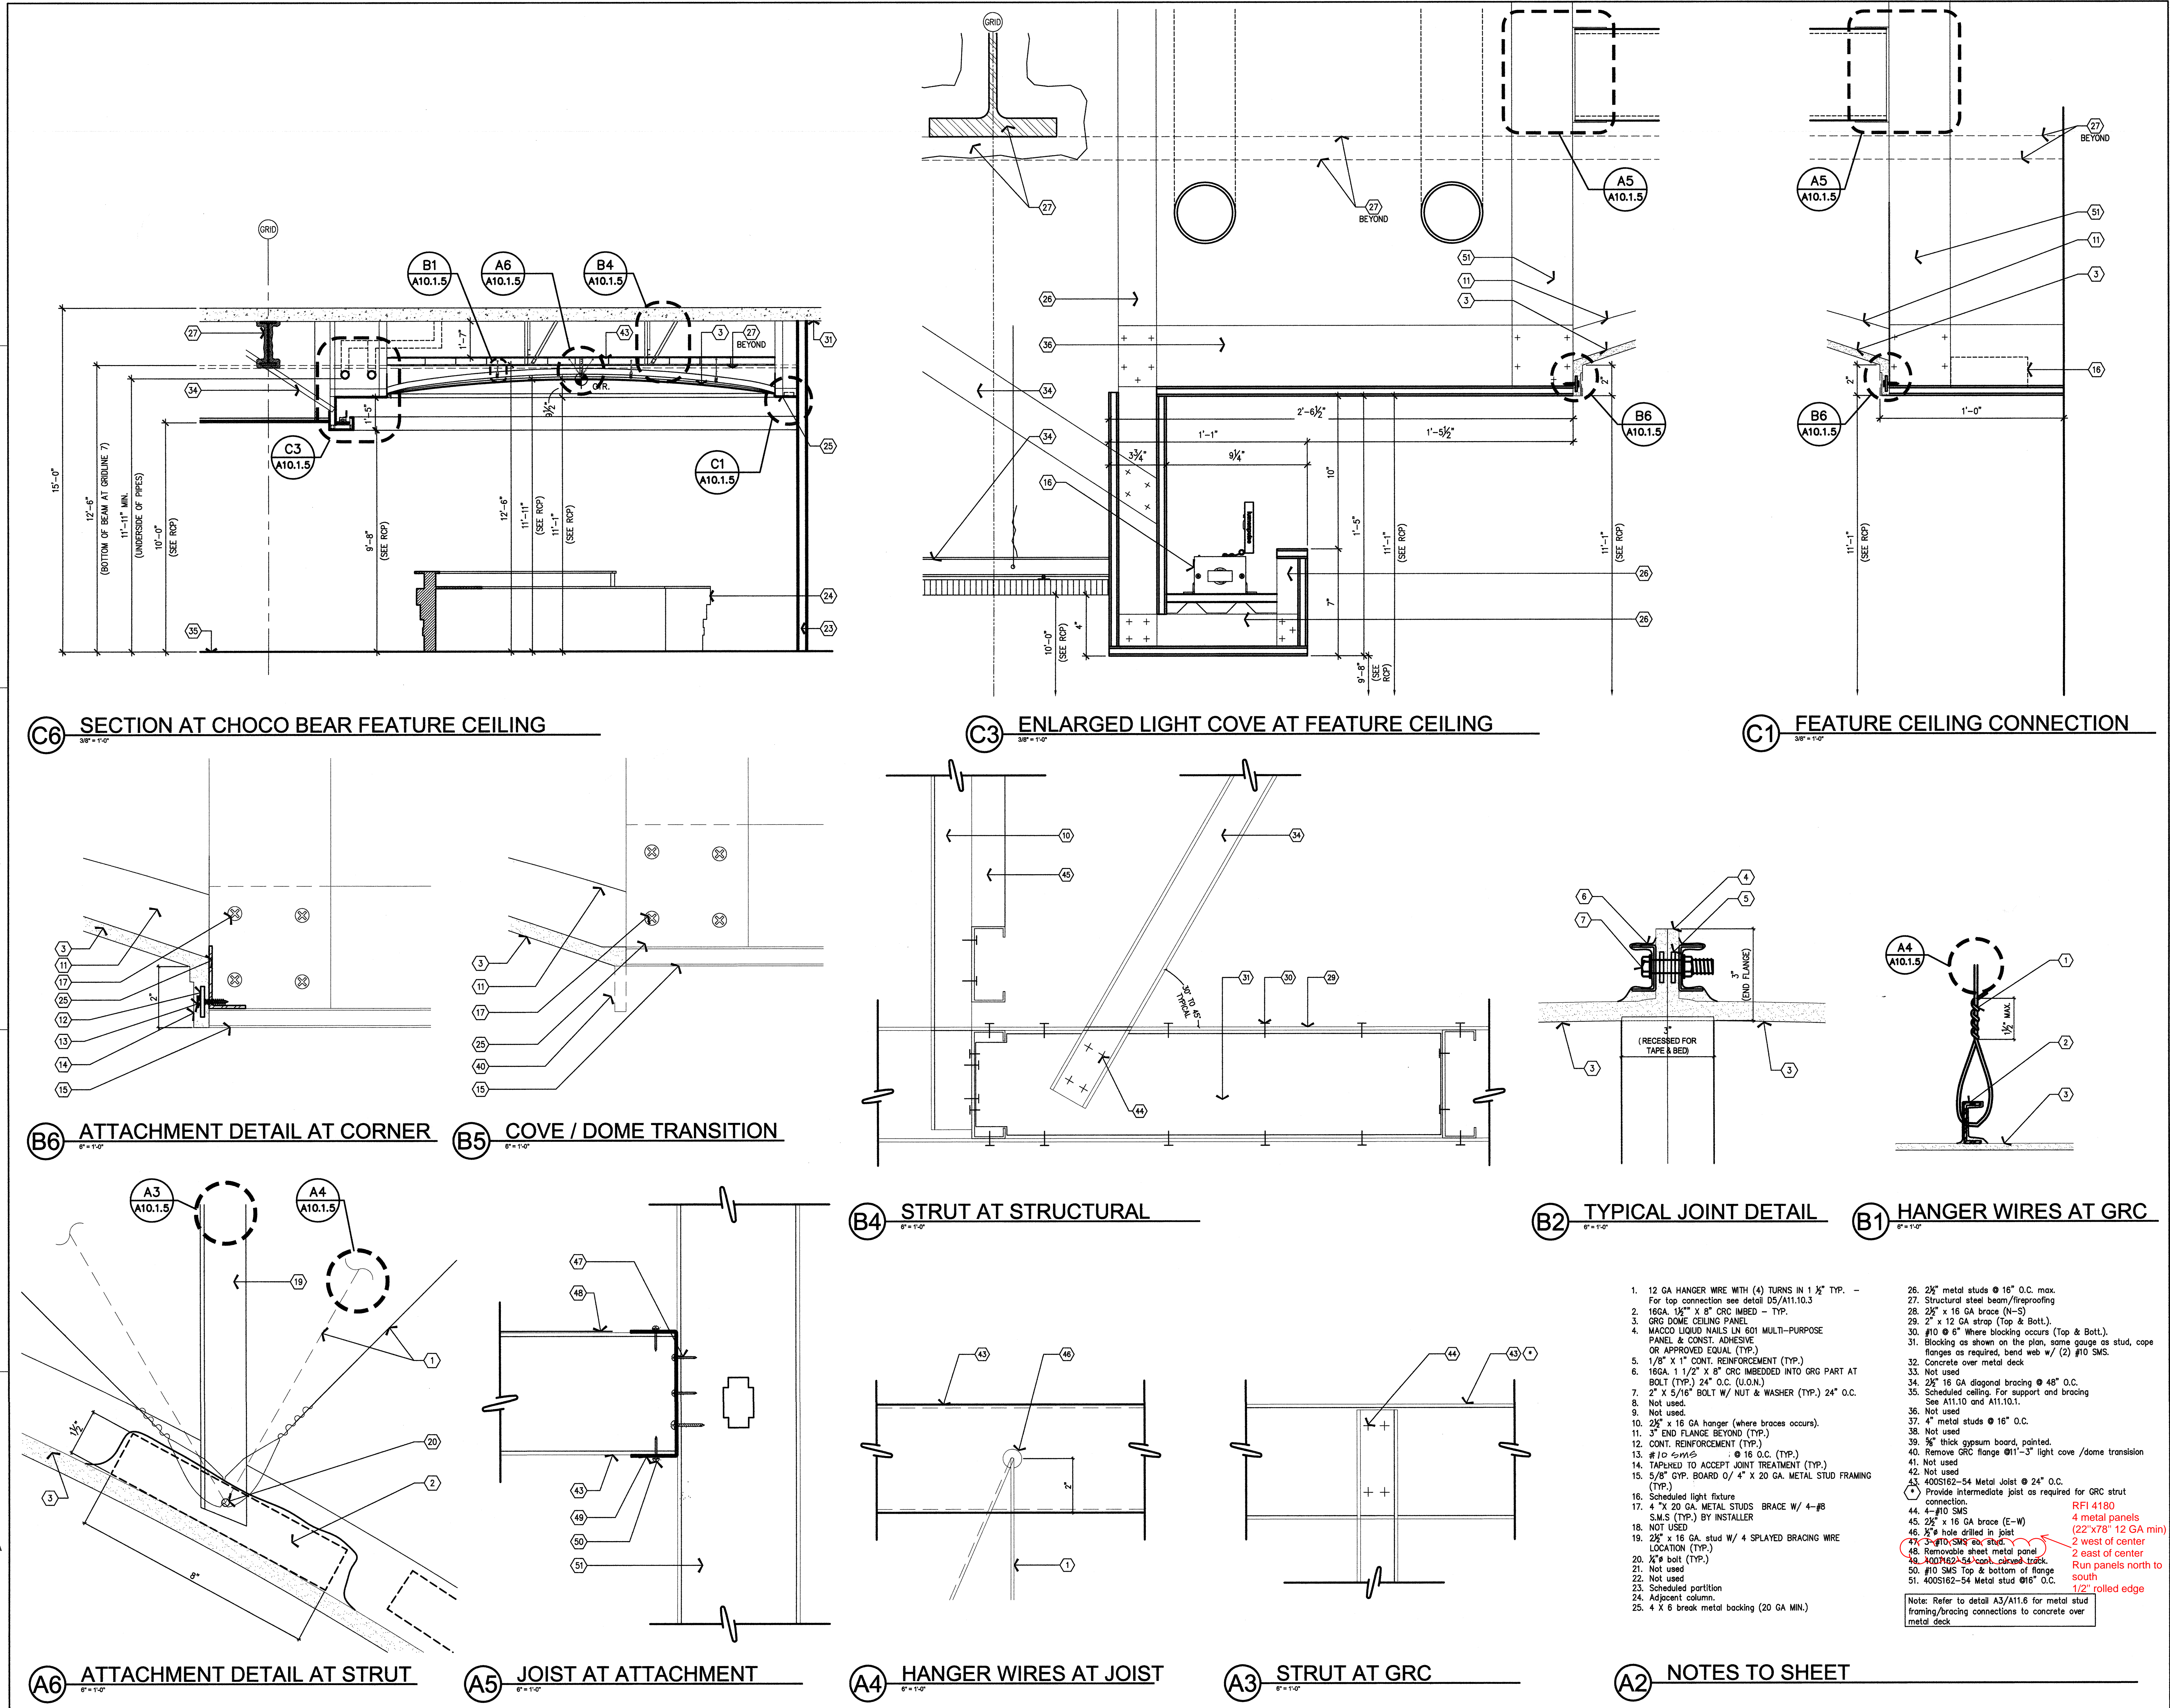

\\MSA-OFFSITE-CADSERVER\USKX\USKX CHOC TOWER 2 SHELL BUILDING\POP CONTRACTED PROJECTS\PROJECT INCREMENTS\WOR_#17_TENANT IMPROVEMENT\OSHPO PERMIT (CONSTRUCTION DOCUMENTS)\080602_C04_1\A10.1.5 INTERIOR SECTION DETAILING
6/6/2011
RULA