

FKP Architects

ARCHITECT OF RECORD  
Paul C. Gloriod



Changes on these drawings do not consist of materially altered changes to approved drawings and don't require a change order.  
OSHPD review ACO  
OSHPD review FLSO  
OSHPD review DSE


REVISIONS

4A	05/28/10	ASI #08
4A2	09/02/11	ASI #14
40	12/02/11	ASH#144
40A	12/12/11	CO#308

OSHPD/FDO-Field Review Tracking

Project	PHD 2011-0242
Architect	FKP Architects
Mechanical	A AC D X Refer
Electrical	A AC D X Refer
DSE	Refer
Structural	A AC D X Refer
Fire Life Safety	A AC D X Refer

APPROVAL

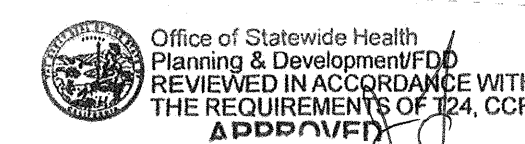

CHANGE ORDER #309  
INSTRUCTION BULLETIN  
DEFERRED APPROVAL  
VENDOR

PROJECT NAME  
**CHILDREN'S HOSPITAL OF ORANGE COUNTY**  
455 S. Main St.  
Orange, CA 92868-3874

TOWER II



PROJECT NUMBER  
12011.00  
Increment #7

OSHPD - PROJECT NUMBER  
IL 072072-30

ISSUE  
OSHPD PERMIT

DATE  
01/27/2010


SCALE

1 1/2" = 1'-0"

DRAWING TITLE  
INTERIOR SECTION DETAILS

DRAWING NUMBER

A10.1

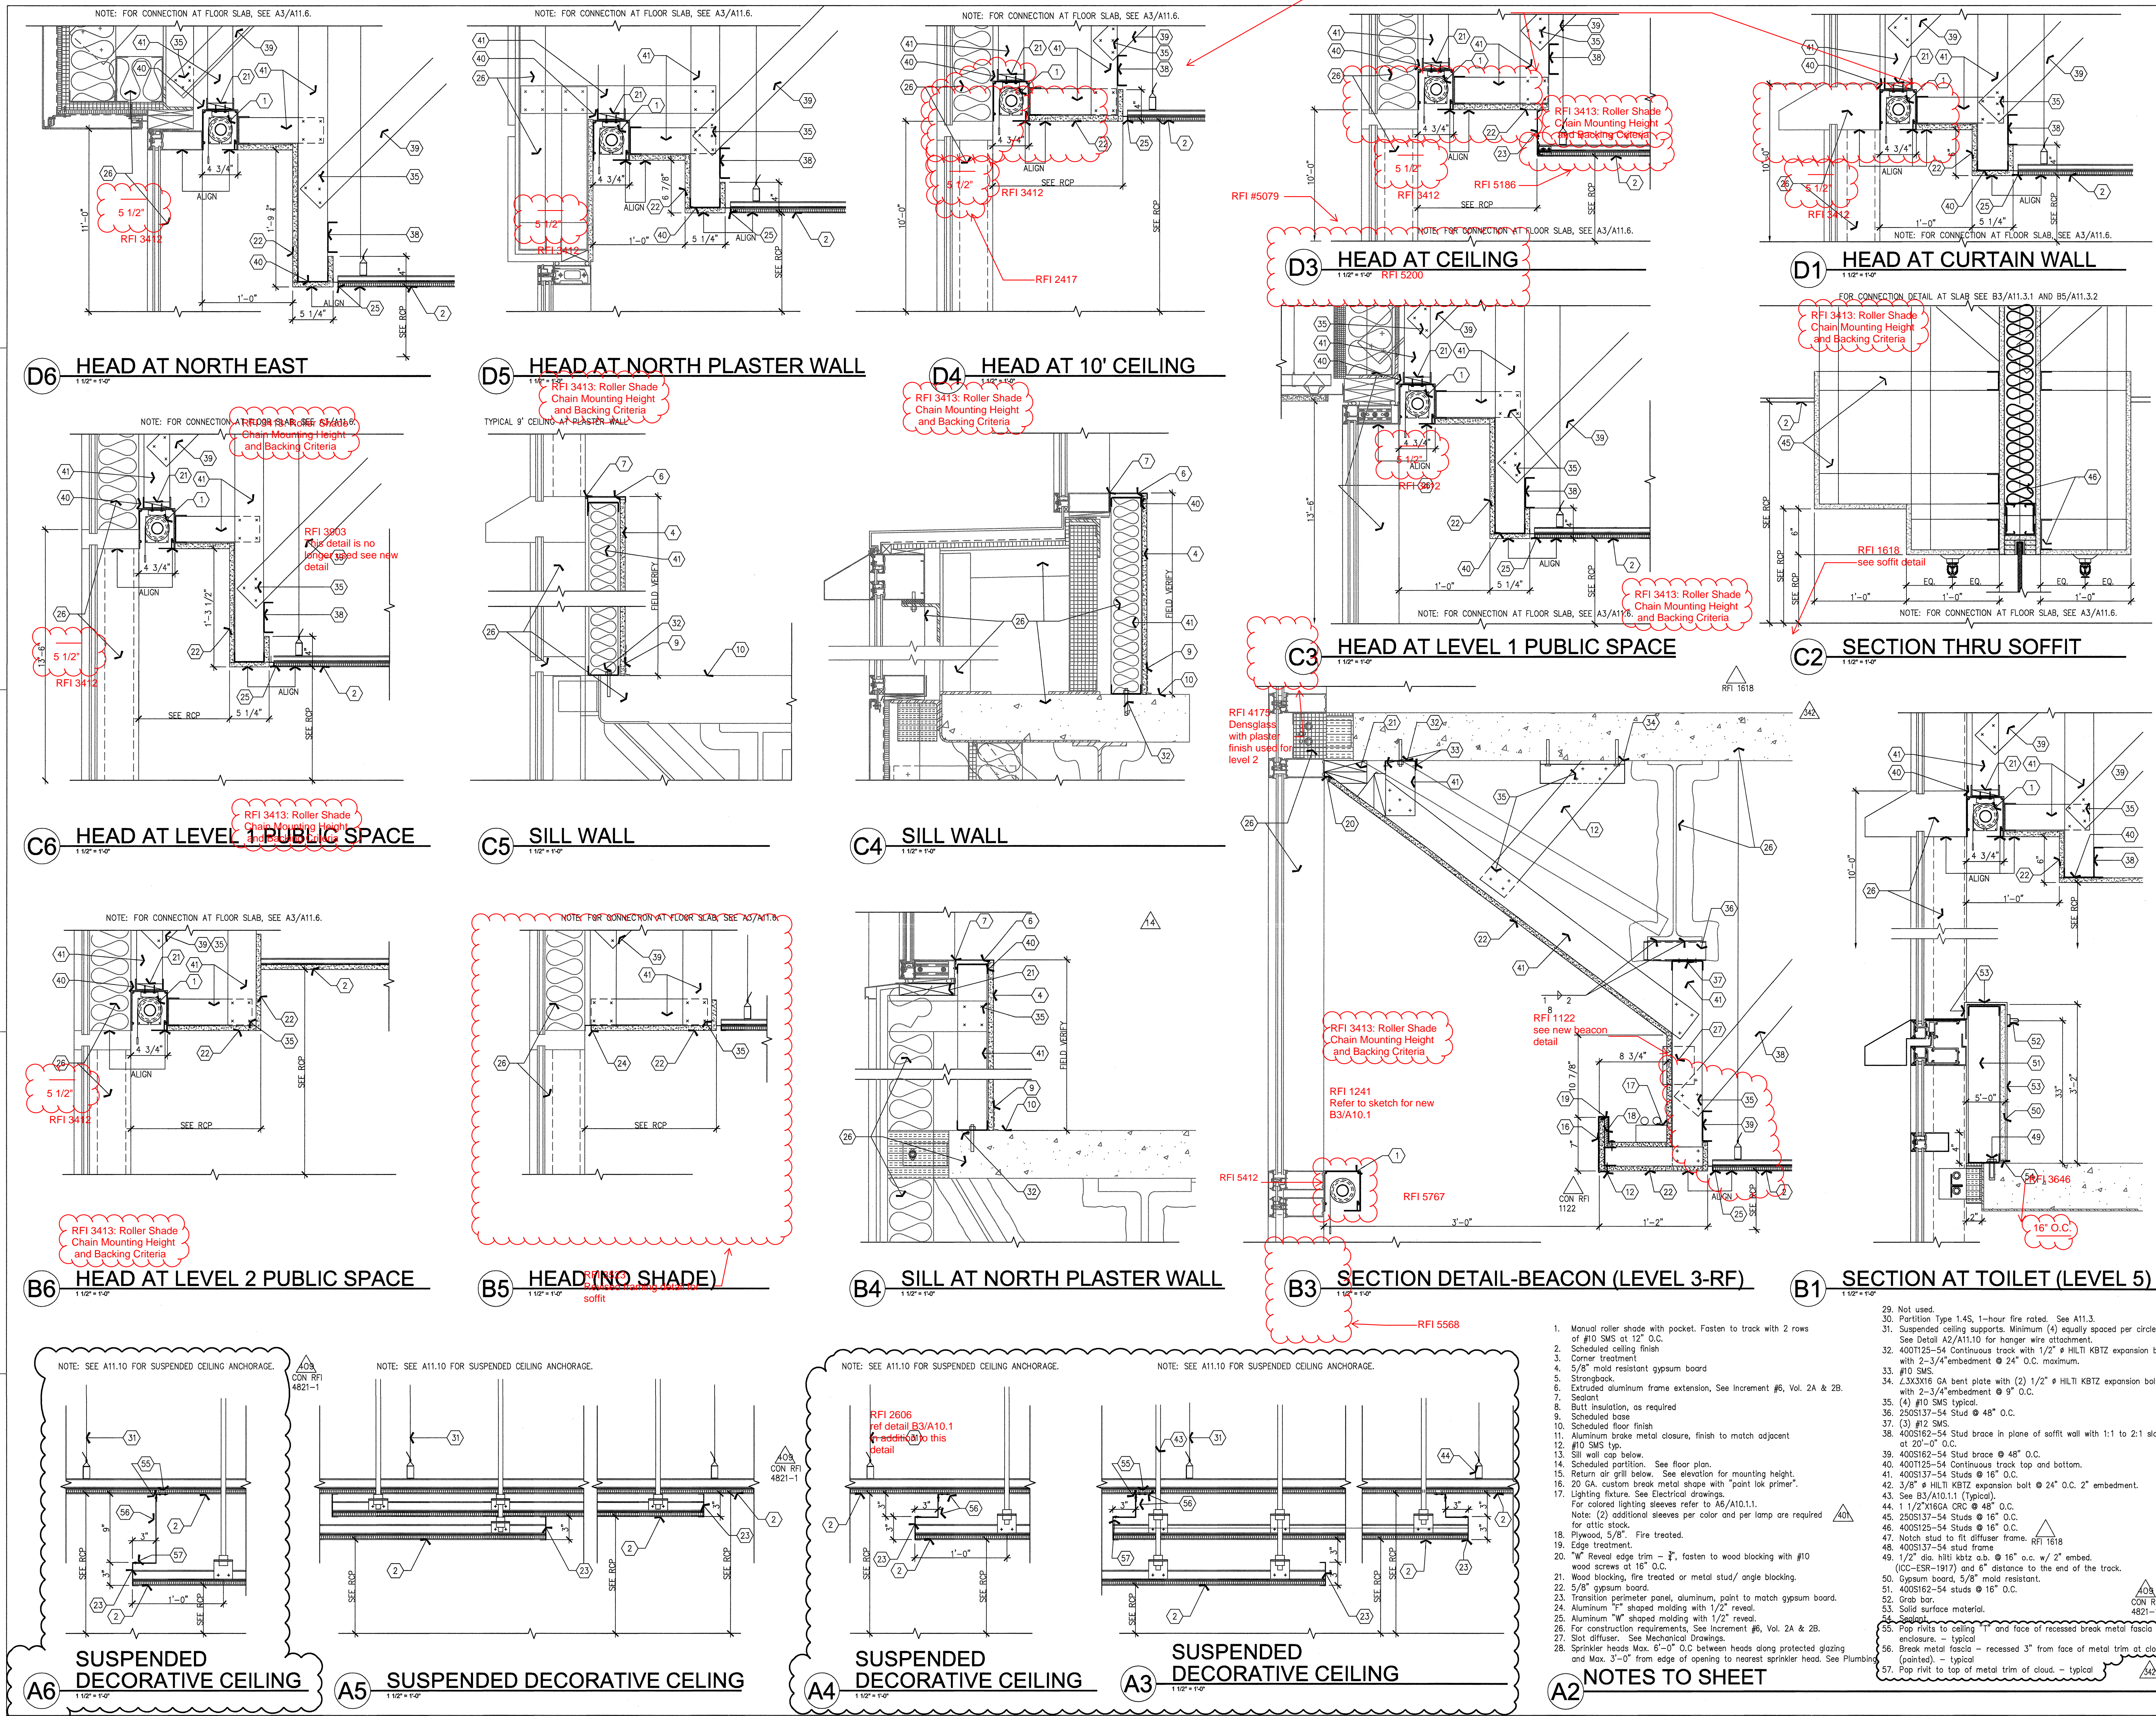

N:\0000\0102\CHOC TOWER 2 SHELL BUILDING\FKP CONTRACTED PROJECTS\PROJECT INCREMENTS\INCR\_#07\_TENANT IMPROVEMENT\OSHPD PERMIT (CONSTRUCTION DOCUMENTS)\00602\_CDW\_1\A10.1.DWG  
 12/12/2011  
 MLOPEZ