


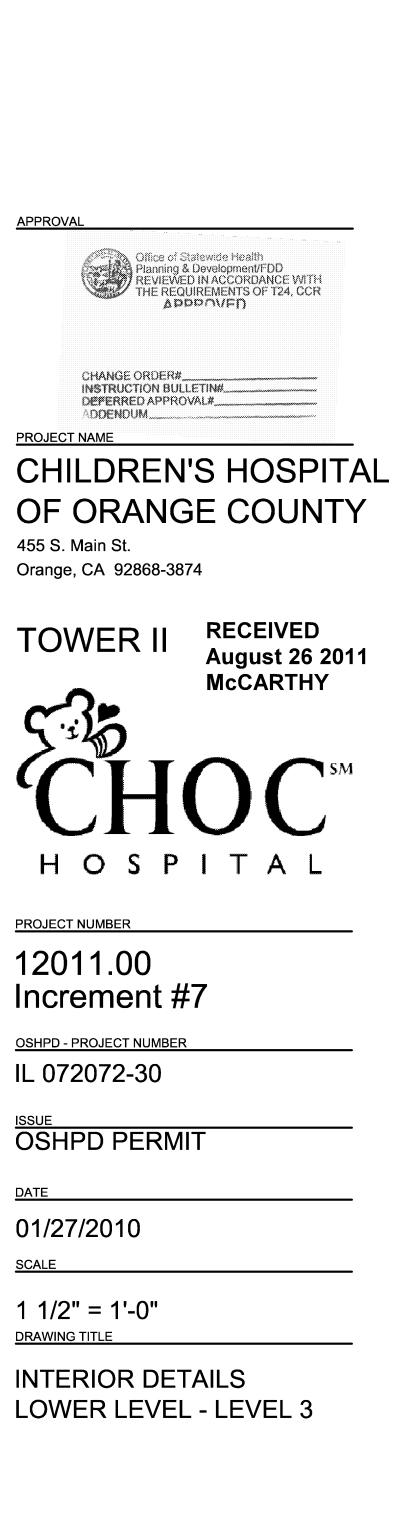

DRAWING NUMBER





materially altered changes to approved drawings

ASI #29R1

ASI #111

(REV) CHANGE ORDER #17

and don't require a change order.

OSHPD review ACO

OSHPD review FLSO OSHPD review DSE \_

11/15/10

08/24/11

