

FKP Architects

ARCHITECT OF RECORD

Paul C. Gloriod




REVISIONS

62	07/26/10	ASIF#16
20	10/12/10	CO#96

OSHPD/FDD-Field Review Tracking									
Project	11-072072-30								
Rev	CO#96								
Arch	AC	D	8	Refer					
Mechanical	AC	D	8	Refer					
Electrical	AC	D	8	Refer					
DSE	AC	D	8	Refer					
Structural	AC	D	8	Refer					
Fire Life Safety	AC	D	X	Refer					

APPROVAL

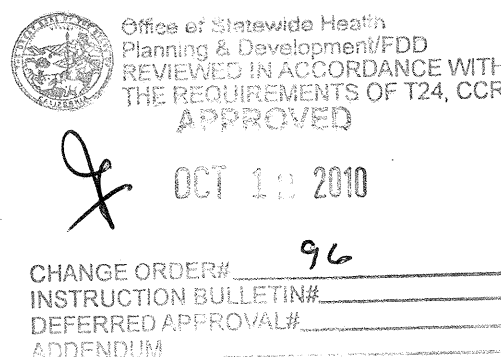

PROJECT NAME

CHILDREN'S HOSPITAL
OF ORANGE COUNTY

455 S. Main St.
Orange, CA 92868-3874

TOWER II



PROJECT NUMBER

12011.00
Increment #7

OSHPD - PROJECT NUMBER

IL 072072-30

ISSUE

OSHPD PERMIT

DATE

01/27/2010

SCALE

N.T.S.

DRAWING TITLE

DOOR- OPENING
SCHEDULE LEVEL 3

DRAWING NUMBER

A11.0.5

RFI 2681
Submittal changes for integrated doors lower level through level 6 and levels 2 through 8 a re to be incorporate into the contract documents

Per 1458 for networked security devices where discrepancies occur between arch and security drawings follow the security TY series drawings TYP all floors

RFI 4179
See window swing adjustment for patient rooms

RFI 2306
Security door electrical interface clarifications. See attached door matrix.

RFI 5352: Submittal changes for CO#135 doors approved as noted in submittals 081113-0012-0 and 087100-0014-0 are to be incorporated into the contract documents

TOILET PATIENT UNISEX	3.109.16	W3'-0" X H7'-0"	A	WDP	HM-1	131	--	--	--	--	--
NOURISHMENT	3.109.16A	W3'-0" X H7'-0"	A	WDP	HM-1	125	--	--	--	--	--
PREP 15	3.109.20	W8'-6" X H7'-2 1/2"	AL-5	ASD	AL-5	143	--	1.33	--	--	2
TOILET, STAFF FEMALE	3.109.21	W3'-0" X H7'-0"	A	WDP	HM-1	122A	U0	--	--	--	--
PREP 10	3.109.22	W8'-6" X H7'-2 1/2"	AL-5	ASD	AL-5	143	--	1.33	--	--	2
MEDICATION STATION	3.109.23	W3'-0" X H7'-0"	B	WDP	HM-1	160	--	62	X	X	1
PREP 9	3.109.24	W8'-6" X H7'-2 1/2"	AL-5	ASD	AL-5	143	--	1.33	--	--	2
PREP 13	3.109.25	W8'-6" X H7'-2 1/2"	AL-5	ASD	AL-5	143	--	1.33	--	--	1
PREP 8	3.109.26	W8'-6" X H7'-2 1/2"	AL-5	ASD	AL-5	143	--	1.33	--	--	2
PREP 11	3.109.27	W8'-6" X H7'-2 1/2"	AL-5	ASD	AL-5	143	--	1.33	--	--	2
PREP 7	3.109.28	W8'-6" X H7'-2 1/2"	AL-5	ASD	AL-5	143	--	1.33	--	--	2
CLEAN UTILITY LINEN	3.109.29	W4'-0" X H7'-0"	B	WDP	HM-1	145	U1S	5.62	X	X	1
SOLED WORKROOM	3.109.31	W3'-0" X H7'-0"	A	WDP	HM-1	145	U1S	--	--	--	--
TRASH LINEN	3.109.33	W3'-6" X H7'-0"	A	WDP	HM-1	145	U1S	62	X	X	1
TOILET, STAFF MALE	3.109.35	W3'-0" X H7'-0"	A	WDP	HM-1	122A	--	--	--	--	--
HOUSE KEEPING	3.109.37	W3'-6" X H7'-0"	A	WDP	HM-1	144	--	--	--	--	--
GENERAL STORAGE	3.085	W4'-0" X H7'-0"	A	WDP	HM-1	126	U1S	--	--	--	2
GENERAL STORAGE	3.085A	W3'-0" X H7'-0"	A	WDP	HM-1	126	U1S	--	--	--	--
VESTIBULE	3.085B	W4'-0" X H7'-0"	A	WDP	HM-1	126	U1S	--	--	--	--
WAITING	3.072	W8'-0" X H7'-0"	2B	WDP	HM-1	175	U1S	5	--	--	2
CLEAN SUPPLY STORAGE	3.082	W3'-6" X H7'-0"	A	WDP	HM-1	145	U1S	--	--	--	--
OFFICE MANAGER	3.106	W3'-0" X H7'-0"	A	WDP	HM-1	117	--	--	--	--	--
STORAGE, EQUIPMENT	3.107	W3'-6" X H7'-0"	A	WDP	HM-1	142	--	--	--	--	2
MECHANICAL ROOM	3.108	W3'-6" X H7'-0"	A	WDP	HM-1	142	--	--	--	--	2
PROCEDURE WAITING	3.100.a	W27'-11 3/8" X H10'-0"	U	AFD	--	--	U1S	59	--	--	--
PROCEDURE WAITING	3.100.b	W1'-6" X H10'-0"	A	WDP	HM-1	149	U1S	--	--	--	--
PROCEDURE WAITING	3.100.c	W12'-0" X H9'-0"	AL-15	ALS	AL-15	--	--	1	--	--	--
PROCEDURE WAITING	3.100.d	W1'-6" X H10'-0"	A	WDP	HM-1	149	U1S	--	--	--	--
PROCEDURE WAITING	3.100.e	W13'-8 3/4" X H10'-0"	U	AFD	--	--	U1S	59	--	--	--



DOOR SCHEDULE LEVEL 3- CONTD.