
	D	
- 7.DWG		
CUMENTS)\100602_CO#\A11.0.8 DOOR- OPENING SCHEDULE LEVEL 6	C 	
N:\06XXX\06102 CHOC TOWER 2 SHELL BUILDING\FKP CONTRACTED PROJECT INCREMENTS\INCR. #07_TENANT IMPROVEMENT\OSHPD PERMIT (CONSTRUCTION DOCUMENTS)\100602_CO#\A11.0.8 DOOR- OPENING SCHEDULE LEVEL 6 - 7.DWG 8/30/2011 JOY	β	
ILDING\FKP CONTRACTED PROJECTS\PROJECT II		
N:\O6XXX\06102 CHOC TOWER 2 SHELL BU 8/30/2011 JOY		

			Opening	Schedule_8	-29-2011							
	Onening Number	Ор	Opening			Frame		Demedia	Occurity		Devisions	
Room Name	Opening Number	Size	Туре	Material	Туре	– Hardware	Fire Rating	ng Remarks	Security	Electrical Revision	Electrical	Revisions
SHELL	<del>7.000.</del>	₩ <u>3' 0" X H 7' 0"</u>	A	WDP	HM-1	<del>123</del>	U1S	—		-	Æ	
-SHELL-	7.000.a	₩ 6'-0" X H 7'-0"	<del>2</del> 8	WDP	HM-1	<del>102</del>	U1S		KAN CY	YY	_	
PUBLIC ELEVATOR LOBBY	7.000.00.L	W 8'-0" X H 7'-0"	2B	WDP	HM-1	101A	U1S	5,18,62,61	RE X	x		
	7.002.	₩ 3' 0" X H 7' 0"	А	WDP	HM-1	<del>123</del>	U1S		3791 <u>-</u>		_	
CORRIDOR	7.073.00.C	₩ 3'-0" X H 7'-0"	A		HM-1	141	<b>U1S</b>		WDP		-	
PATIENT/STAFF ELEVATOR	7.081.00.L	W 8'-0" X H 7'-0"	2B	WDP	HM-1	101A	U1S	5,61,79				
STORAGE GENERAL	7.001	W 3'-0" X H 7'-0"	A	WDP	HM-1	118	U1S					
-SHELL SPACE-	7.003	₩ 3'-0" X H 7'-0"	A		HM-1	141			WDP			
STORAGE GENERAL	7.020	W 3'-0" X H 7'-0"	Α	WDP	HM-1	118	U1S					

5

C 2009 FKP Architects, Inc. All rights reserved. No part of this document may be reproduced or utilized in any form without prior written authorization of FKP Architects, Inc.

l 2575

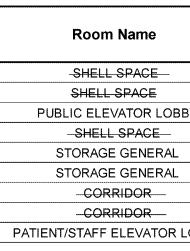

4

2

RFI 4179 See window swing adjustment for patient rooms

RFI 1458 for networked security devices where discrepancies occur between architect and security drawings follow the security CTT drawings TYP all floors

Per RFI 1934 submittal changes in 081113-0002-0, 087100-0002-0, 087100 0002-0, 081113-0002-0, 087100-0001-0 are to be incorporated in the contract documents

Security door electrical interface clarifications. See attached door matrix.

RFI 2681 submittal changes for integrated doors lower level through level 1 and levels 2-8 are to be incorporated into the contract documents


			Opening	Schedule_8	-29-2011						
Room Name Opening Numbe	Opening			Frame			Demode	Oracita	Electrice I	Devision	
	Opening Number	Size	Туре	Material	Туре	- Hardware	Fire Rating	Remarks	Security	Electrical	Revisions
SHELL SPACE	<del>6.000.a</del>	₩ 3'-0" X H 7'-0"	А	WDP	HM-1	147	U1S				2
SHELL SPACE	<del>6.000.c</del>	₩ 6'-0" X H 7'-0"	<del>2</del> A	WDP	HM-1	<del>102</del>	U1S	$\bigcap$	$\sim$		The second
PUBLIC ELEVATOR LOBBY	6.000.00.L	W 8'-0" X H 7'-0"	2B	WDP	HM-1	100	U1S	5,54		, ,	
SHELL SPACE	<del>6.002</del>	₩ 3'-0" X H 7'-0"	А	WDP	HM-1	<del>126</del>	U1S				
STORAGE GENERAL	6.003	W 3'-0" X H 7'-0"	А	WDP	HM-1	118	U1S				
STORAGE GENERAL	6.120	W 3'-0" X H 7'-0"	А	WDP	HM-1	118	U1S				
CORRIDOR	6.073.00.Ca	₩ 8'-0" X H 7'-0"	<del>2B</del>	WDP	IDF-2	100	U1S	<del>1,18</del>			
-CORRIDOR-	6.073.00.Cb	<del>W 8'-0" X H 9'-0"</del>	Ų		AFD		<del>U2S</del>	<del>12,46</del>		X	
ATIENT/STAFF ELEVATOR LOBBY	6.081.00.L	W 8'-0" X H 7'-0"	2B	WDP	HM-1	101A	U1S	5,54,61,79			2


## A3 DOOR SCHEDULE LEVEL 6

RFI 2306



DRAWING NUMBER

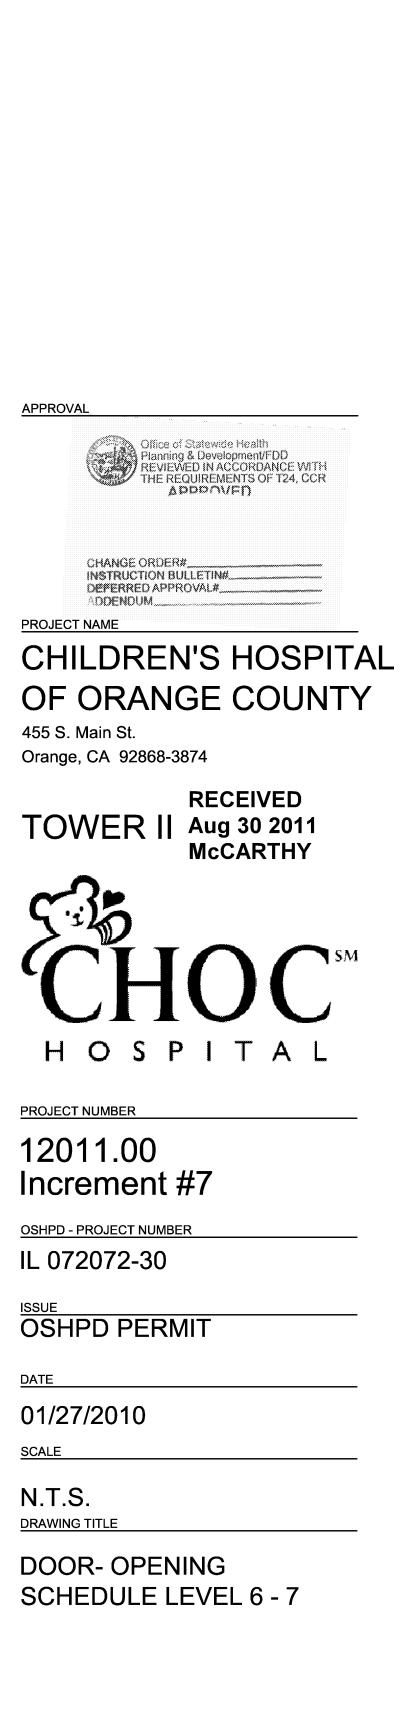

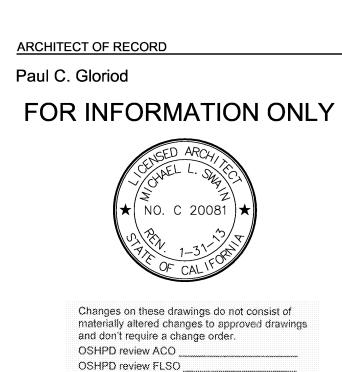

ASI#1

ASI#56

ASI #112

OSHPD review DSE \_\_\_\_

11/08/10

02/18/11

08/30/11

REVISIONS

/34

**FKP** Architects