


FKP Architects

ARCHITECT OF RECORD
Paul C. Gloriot

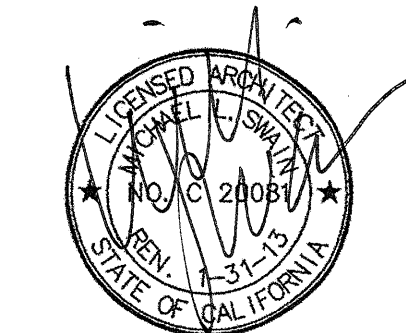

Changes on these drawings do not consist of materially altered changes to approved drawings and do not require a change order.
OSHPD review ACO
OSHPD review FLSO
OSHPD review DBE

REVISIONS

02/27/12 CO #337

APPROVAL

Office of Statewide Health Planning & Development (OSHPD)
REVIEWED IN ACCORDANCE WITH THE REQUIREMENTS OF 12A, CCR (ADDITIONAL)

PAD-2012-02502

CHANGE ORDER#
INSTRUCTION BULLETIN#
DEFERRED APPROVAL#
ADDENDUM

PROJECT NAME

CHILDREN'S HOSPITAL OF ORANGE COUNTY

455 S. Main St.
Orange, CA 92668-3874

TOWER II

CHOC HOSPITAL

PROJECT NUMBER

12011.00

Increment #7

OSHPD - PROJECT NUMBER

IL 072072-30

ISSUE

OSHPD PERMIT

DATE

01/27/2010

SCALE

N.T.S.


DRAWING TITLE

MARKED-UP RCP FOR BERC 2 CLIP & 2" WALL ANGLE LOCATIONS

DRAWING NUMBER


A11.10.7

CO #147

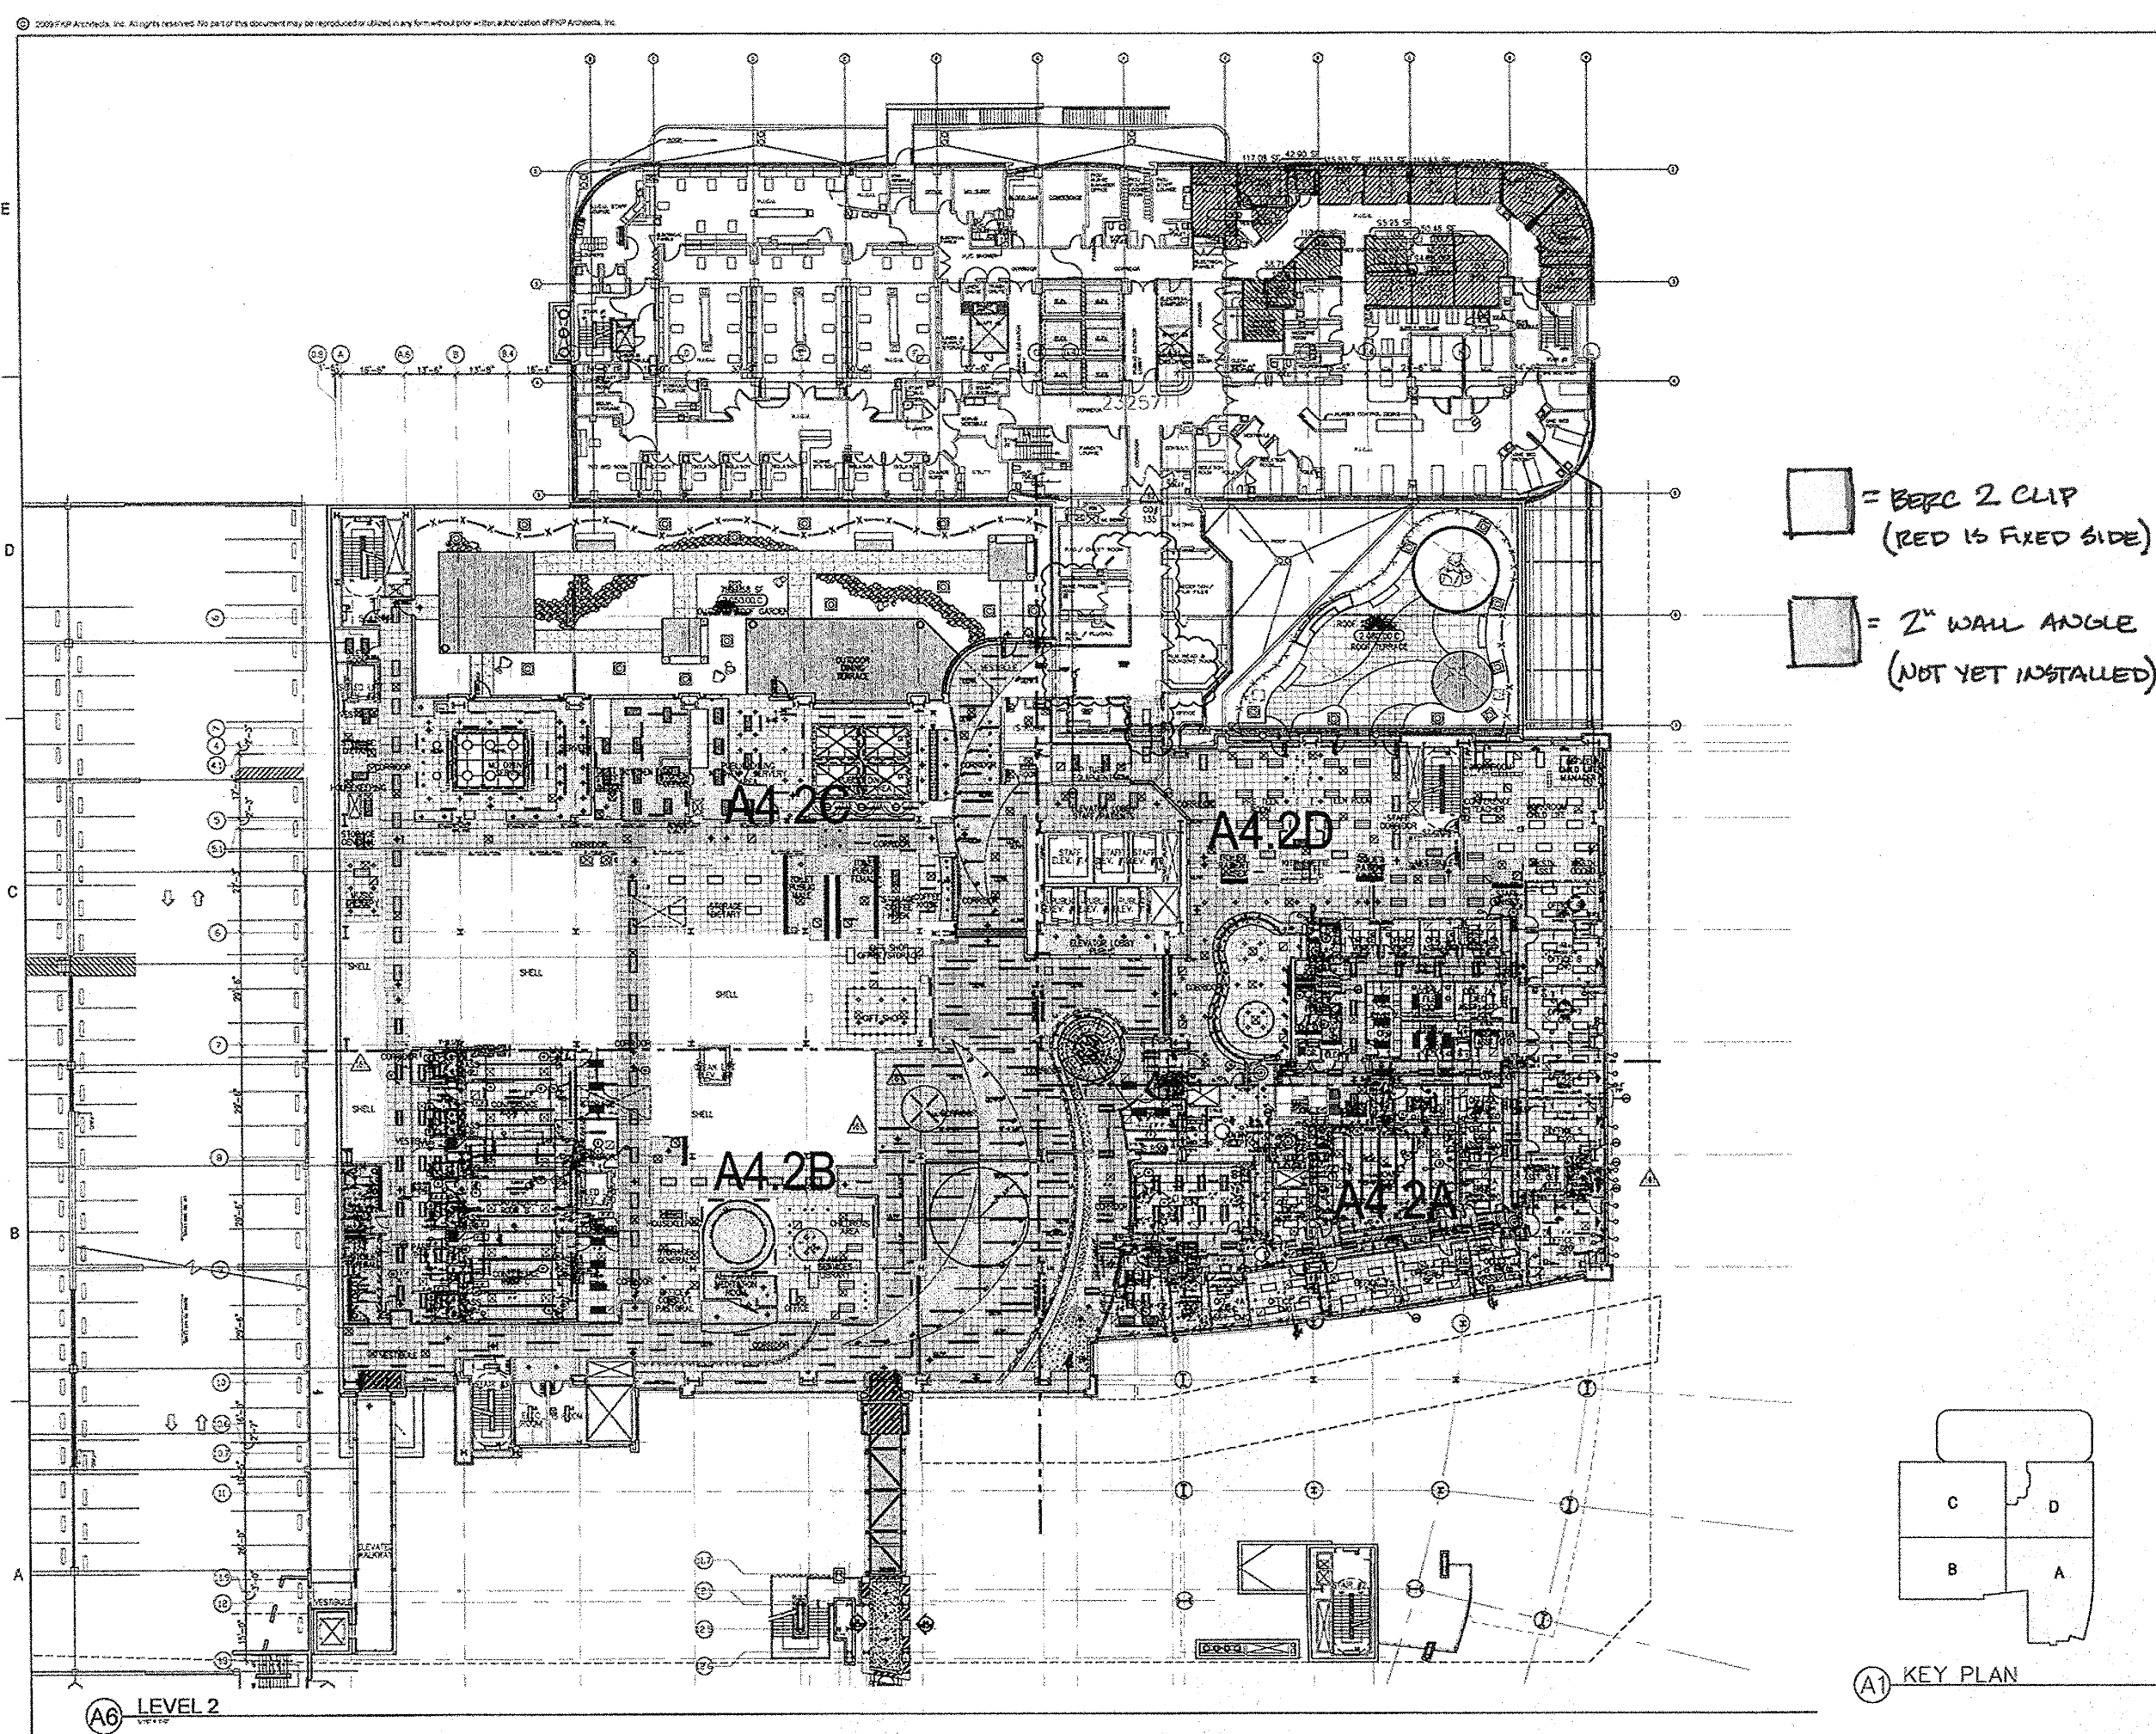

FKP Architects

ARCHITECT OF RECORD
Paul C. Gloriot

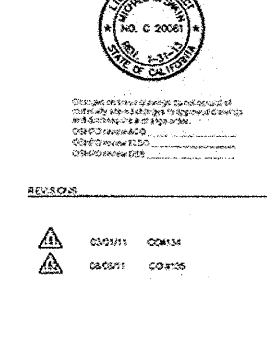

Changes on these drawings do not consist of materially altered changes to approved drawings and do not require a change order.
OSHPD review ACO
OSHPD review FLSO
OSHPD review DBE

REVISIONS

02/27/12 CO #337

APPROVAL

Office of Statewide Health Planning & Development (OSHPD)
REVIEWED IN ACCORDANCE WITH THE REQUIREMENTS OF 12A, CCR (ADDITIONAL)

PAD-2012-02502

CHANGE ORDER#
INSTRUCTION BULLETIN#
DEFERRED APPROVAL#
ADDENDUM

PROJECT NAME

CHILDREN'S HOSPITAL OF ORANGE COUNTY

455 S. Main St.
Orange, CA 92668-3874

TOWER II

CHOC HOSPITAL

PROJECT NUMBER

12011.00

Increment #7

OSHPD - PROJECT NUMBER

IL 072072-30

ISSUE

OSHPD PERMIT

DATE

01/27/2010

SCALE


N.T.S.

DRAWING TITLE

MARKED-UP RCP FOR BERC 2 CLIP & 2" WALL ANGLE LOCATIONS


DRAWING NUMBER

A4.21

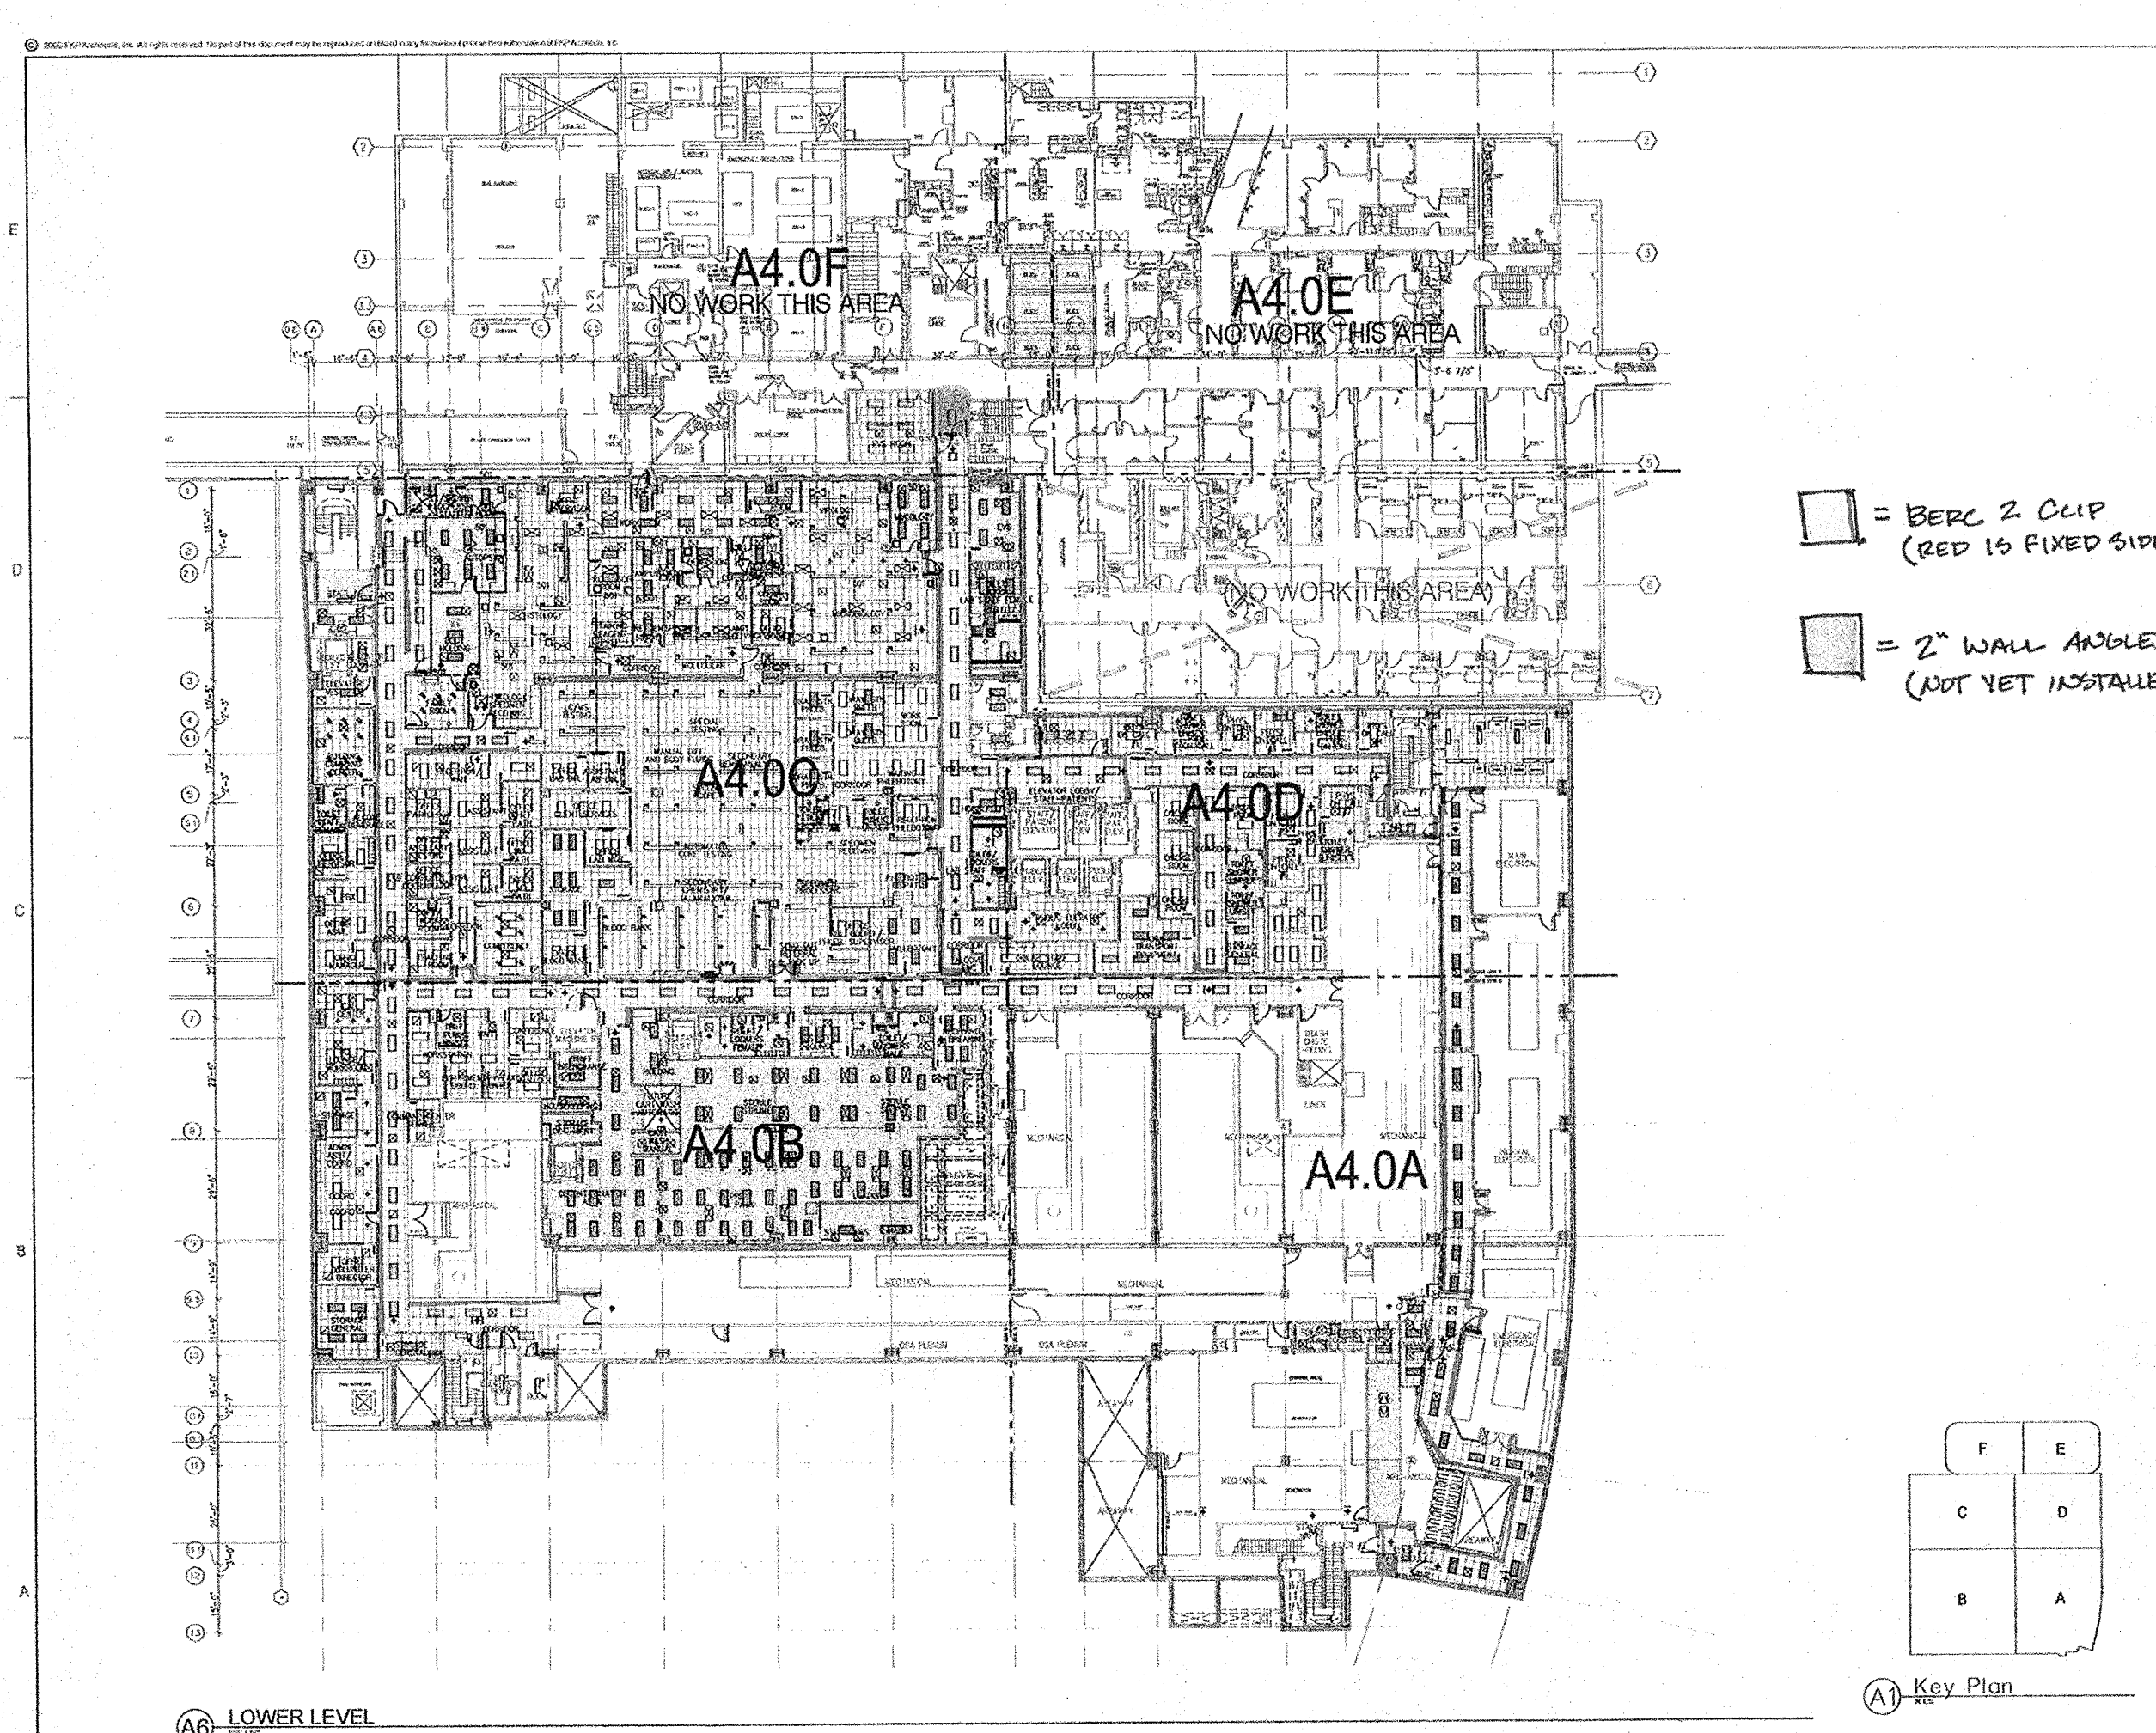

FKP Architects

ARCHITECT OF RECORD
Paul C. Gloriot

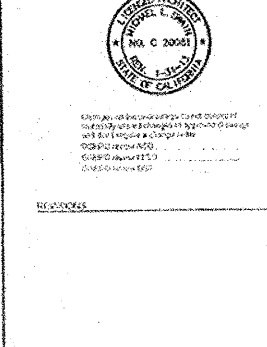

Changes on these drawings do not consist of materially altered changes to approved drawings and do not require a change order.
OSHPD review ACO
OSHPD review FLSO
OSHPD review DBE

REVISIONS

02/27/12 CO #337

APPROVAL

Office of Statewide Health Planning & Development (OSHPD)
REVIEWED IN ACCORDANCE WITH THE REQUIREMENTS OF 12A, CCR (ADDITIONAL)

PAD-2012-02502

CHANGE ORDER#
INSTRUCTION BULLETIN#
DEFERRED APPROVAL#
ADDENDUM

PROJECT NAME

CHILDREN'S HOSPITAL OF ORANGE COUNTY

455 S. Main St.
Orange, CA 92668-3874

TOWER II

CHOC HOSPITAL

PROJECT NUMBER

12011.00

Increment #7

OSHPD - PROJECT NUMBER

IL 072072-30

ISSUE

OSHPD PERMIT

DATE

01/27/2010

SCALE


N.T.S.

DRAWING TITLE

MARKED-UP RCP FOR BERC 2 CLIP & 2" WALL ANGLE LOCATIONS


DRAWING NUMBER

A4.01

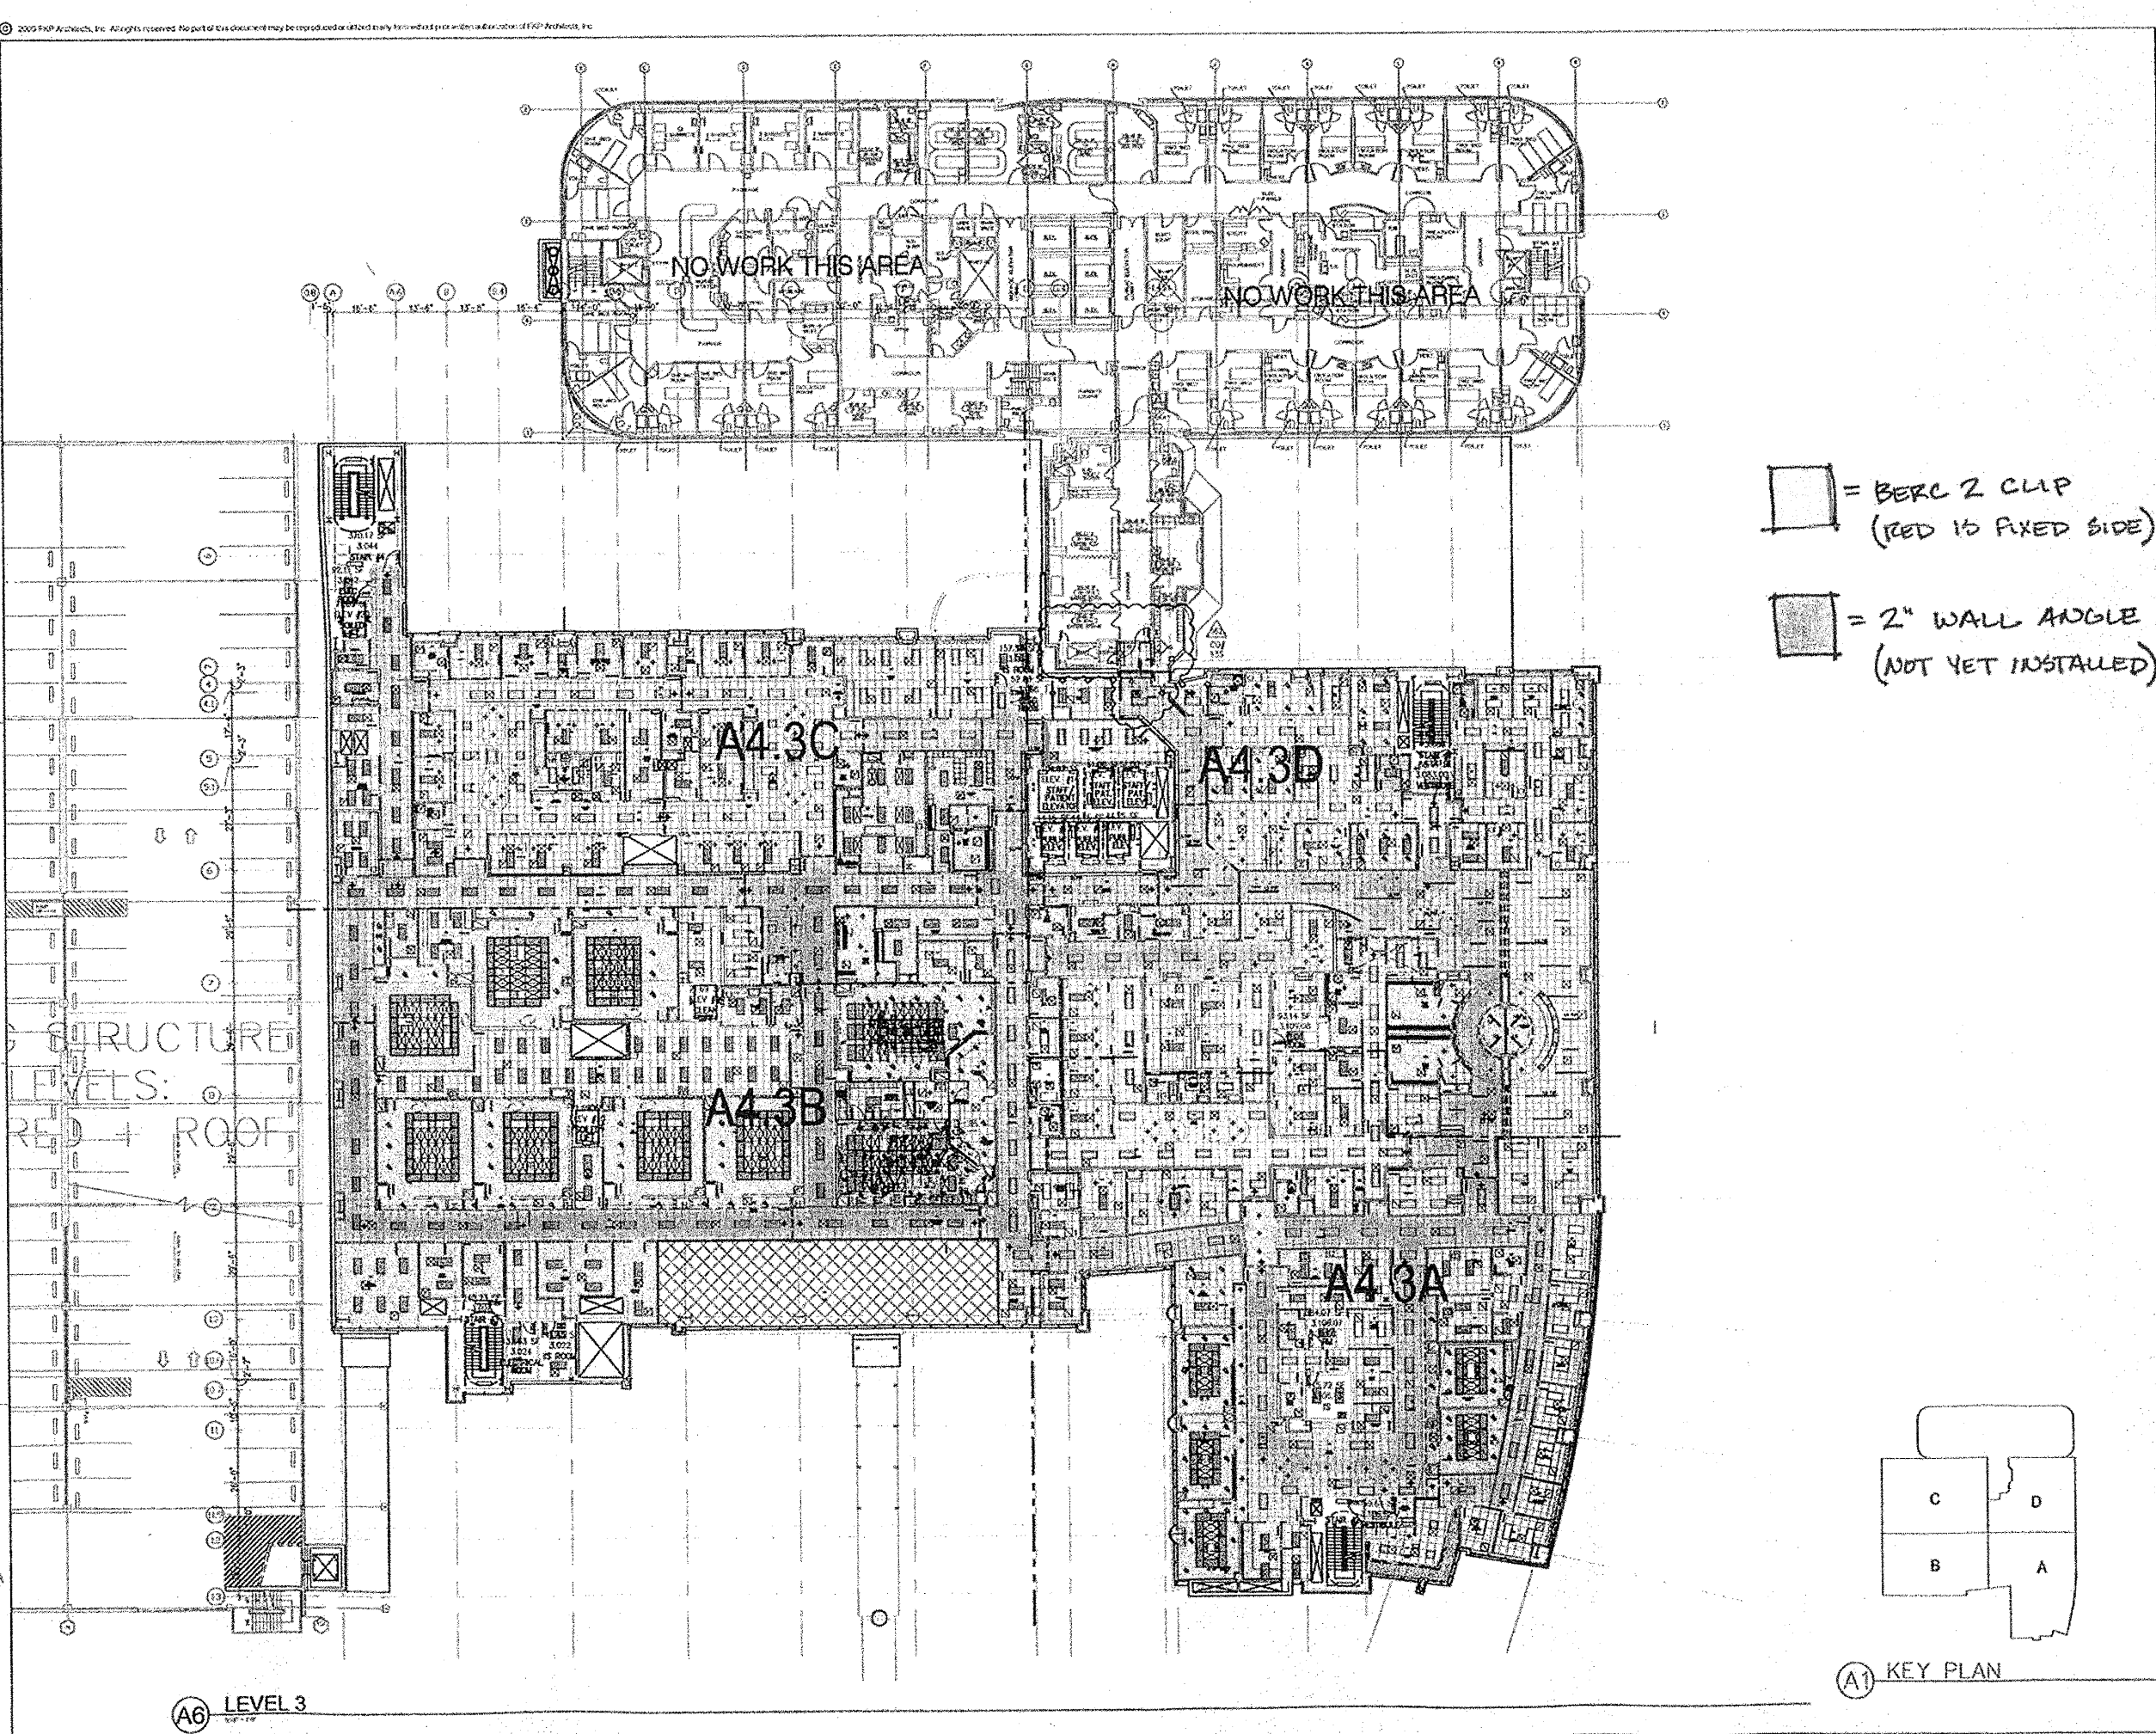

FKP Architects

ARCHITECT OF RECORD
Paul C. Gloriot

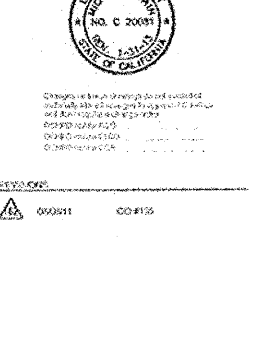

Changes on these drawings do not consist of materially altered changes to approved drawings and do not require a change order.
OSHPD review ACO
OSHPD review FLSO
OSHPD review DBE

REVISIONS

02/27/12 CO #337

APPROVAL

Office of Statewide Health Planning & Development (OSHPD)
REVIEWED IN ACCORDANCE WITH THE REQUIREMENTS OF 12A, CCR (ADDITIONAL)

PAD-2012-02502

CHANGE ORDER#
INSTRUCTION BULLETIN#
DEFERRED APPROVAL#
ADDENDUM

PROJECT NAME

CHILDREN'S HOSPITAL OF ORANGE COUNTY

455 S. Main St.
Orange, CA 92668-3874

TOWER II

CHOC HOSPITAL

PROJECT NUMBER

12011.00

Increment #7

OSHPD - PROJECT NUMBER

IL 072072-30

ISSUE

OSHPD PERMIT

DATE

01/27/2010

SCALE


N.T.S.

DRAWING TITLE

MARKED-UP RCP FOR BERC 2 CLIP & 2" WALL ANGLE LOCATIONS


DRAWING NUMBER

A4.31

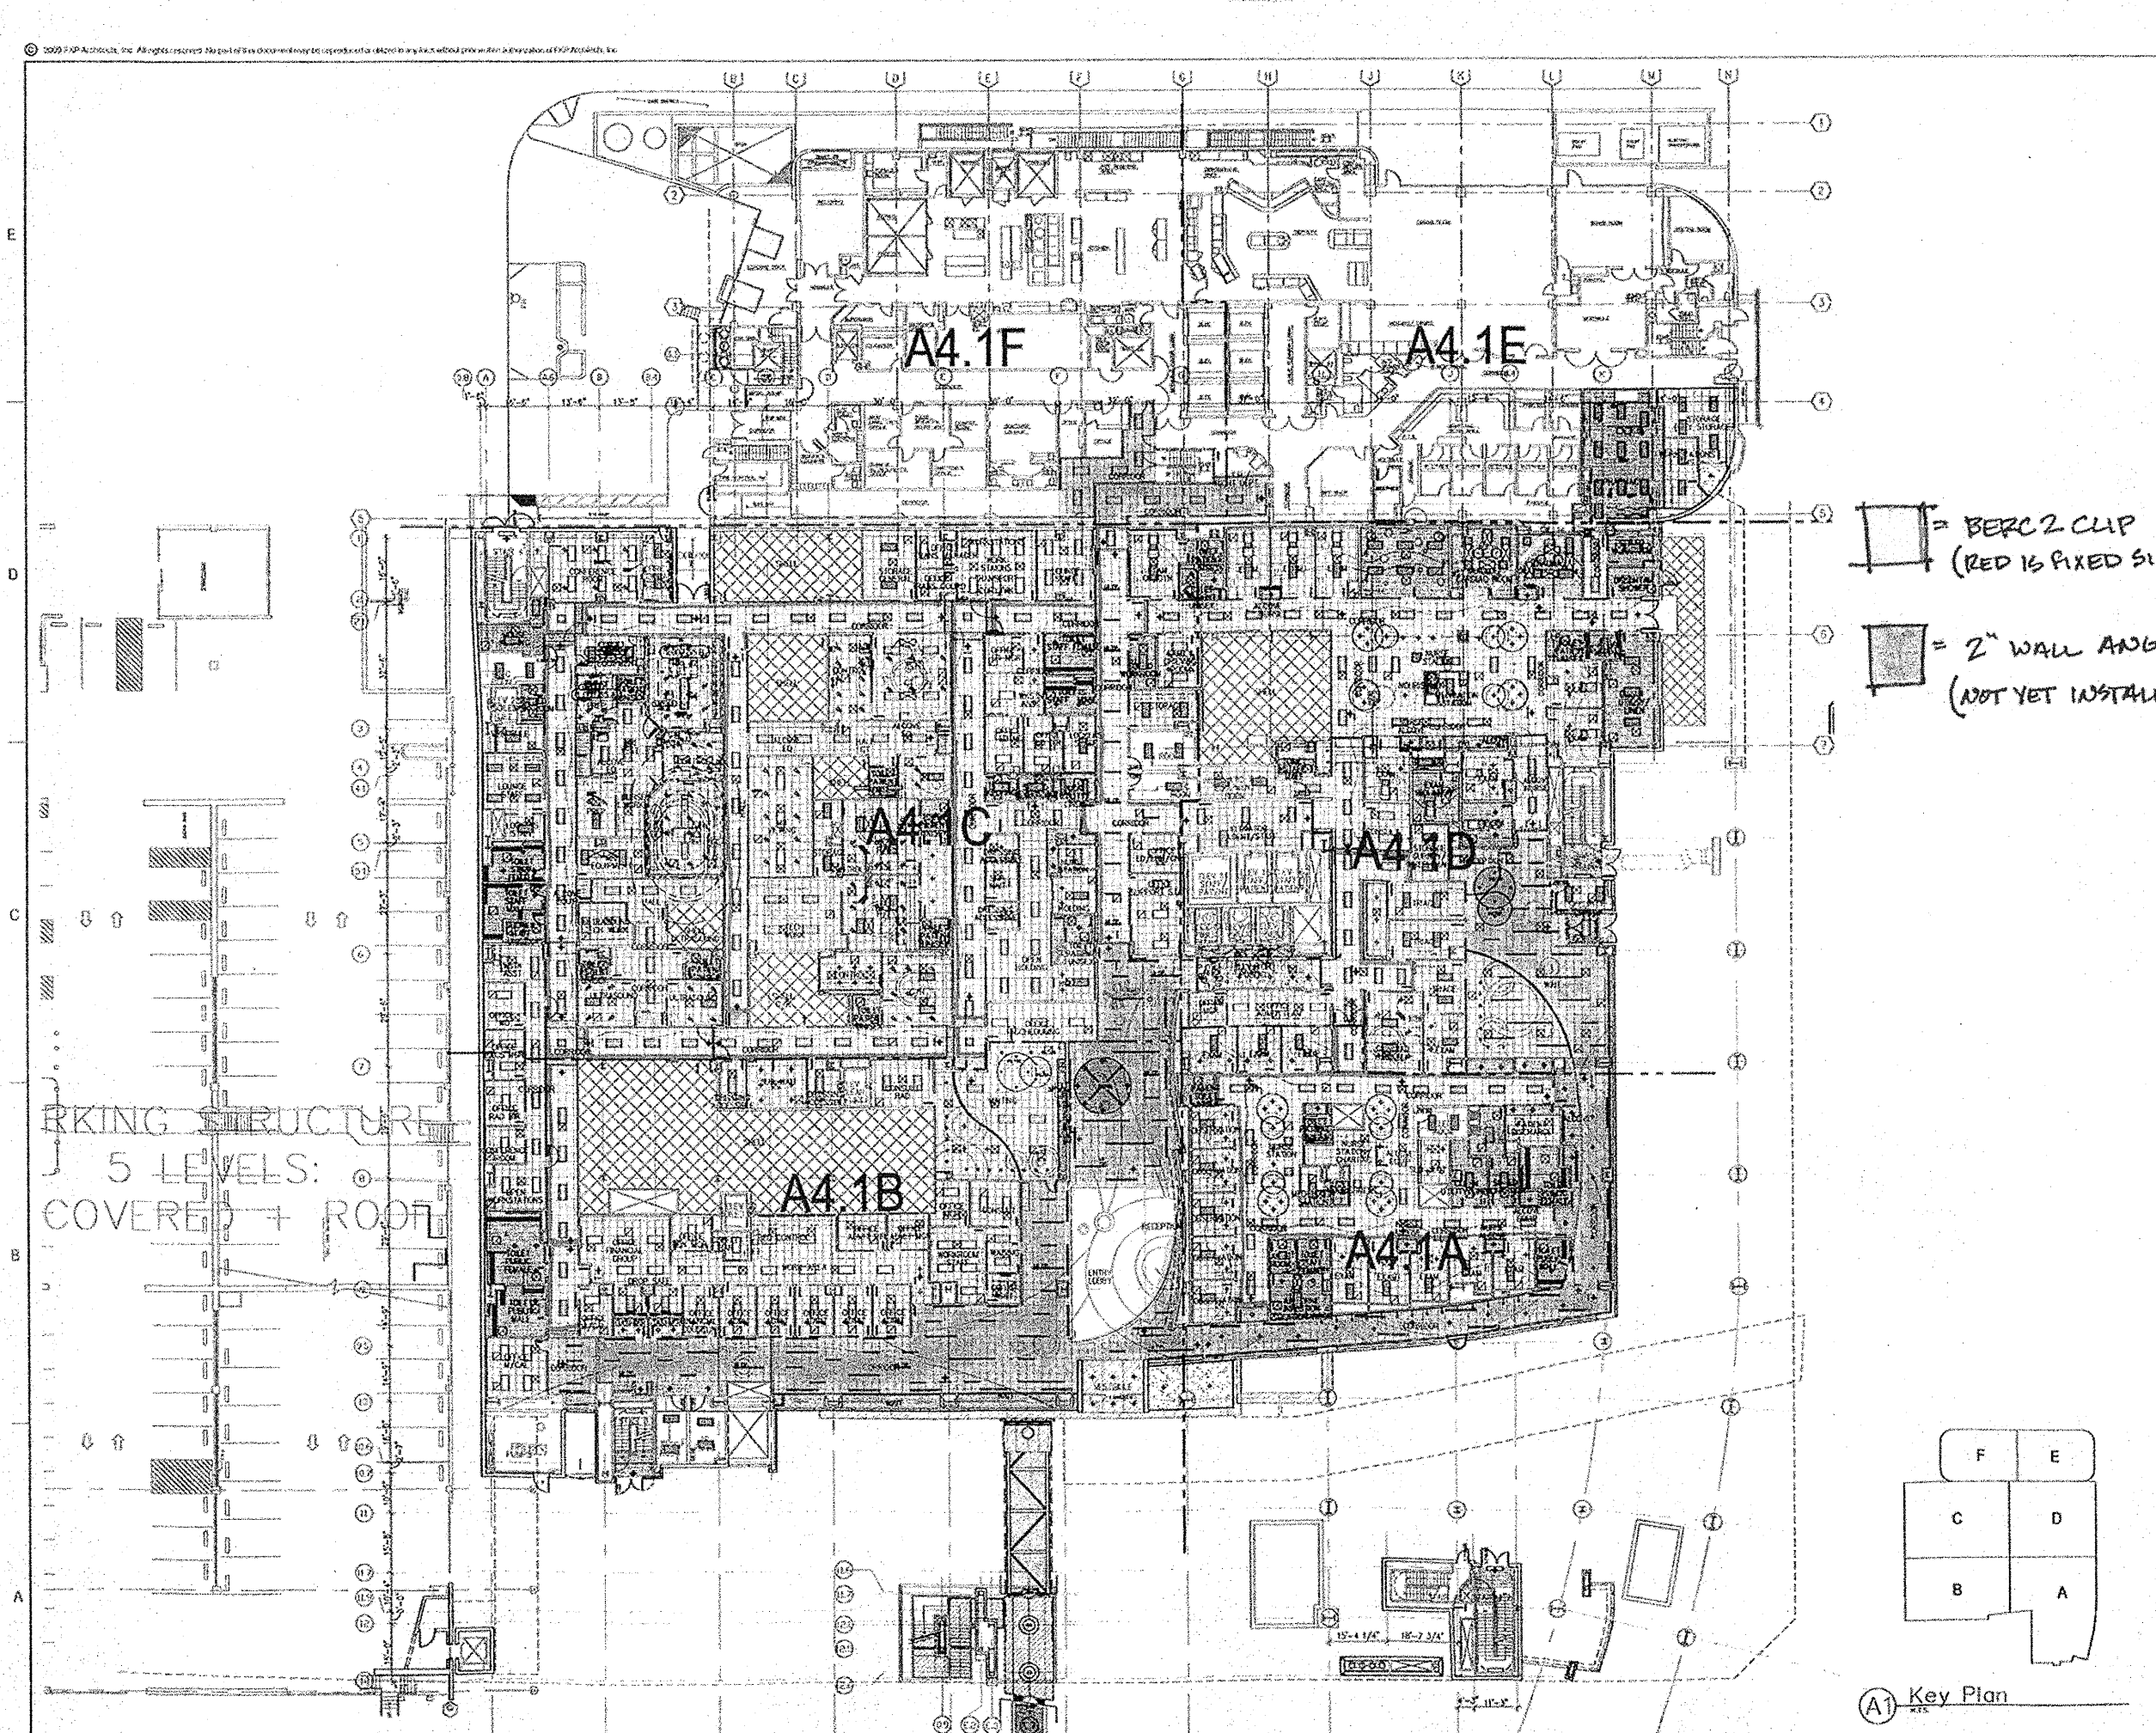

FKP Architects

ARCHITECT OF RECORD
Paul C. Gloriot

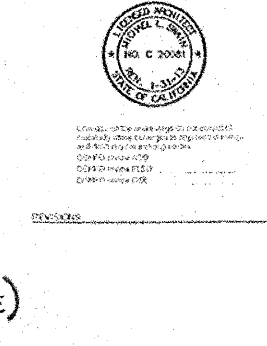

Changes on these drawings do not consist of materially altered changes to approved drawings and do not require a change order.
OSHPD review ACO
OSHPD review FLSO
OSHPD review DBE

REVISIONS

02/27/12 CO #337

APPROVAL

Office of Statewide Health Planning & Development (OSHPD)
REVIEWED IN ACCORDANCE WITH THE REQUIREMENTS OF 12A, CCR (ADDITIONAL)

PAD-2012-02502

CHANGE ORDER#
INSTRUCTION BULLETIN#
DEFERRED APPROVAL#
ADDENDUM

PROJECT NAME

CHILDREN'S HOSPITAL OF ORANGE COUNTY

455 S. Main St.
Orange, CA 92668-3874

TOWER II

CHOC HOSPITAL

PROJECT NUMBER

12011.00

Increment #7

OSHPD - PROJECT NUMBER

IL 072072-30

ISSUE

OSHPD PERMIT

DATE

01/27/2010

SCALE

N.T.S.

DRAWING TITLE

MARKED-UP RCP FOR BERC 2 CLIP & 2" WALL ANGLE LOCATIONS

DRAWING NUMBER

A4.11