


FKP Architects

ARCHITECT OF RECORD
Paul C. Gloriod

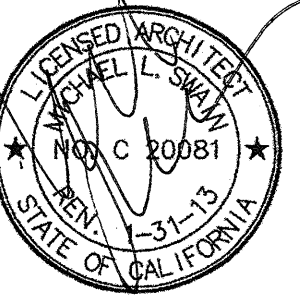


Changes on these drawings do not consist of
materially altered changes to approved drawings
and don't require a change order.
OSHPD review ACO
OSHPD review FLSO
OSHPD review DSE

REVISIONS

150 02/27/12 CO #337

APPROVAL

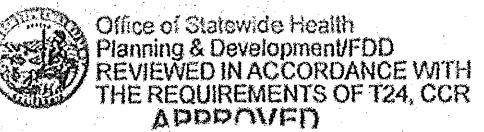

PAD -2012-02502
CHANGE ORDER
INSTRUCTION BULLETIN
DEFERRED APPROVAL
ADDENDUM

PROJECT NAME
**CHILDREN'S HOSPITAL
OF ORANGE COUNTY**
455 S. Main St.
Orange, CA 92668-3874

TOWER II



PROJECT NUMBER

**12011.00
Increment #7**

OSHPD - PROJECT NUMBER
IL 072072-30

ISSUE
OSHPD PERMIT

DATE
01/27/2010




SCALE

N.T.S.
DRAWING TITLE

**MARKED-UP RCP FOR
BERC 2 CLIP & 2" WALL
ANGLE LOCATIONS**

DRAWING NUMBER

A11.10.8

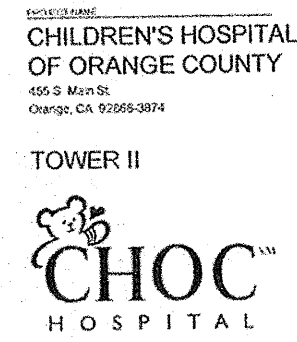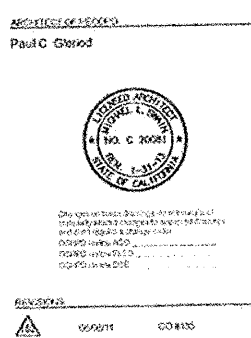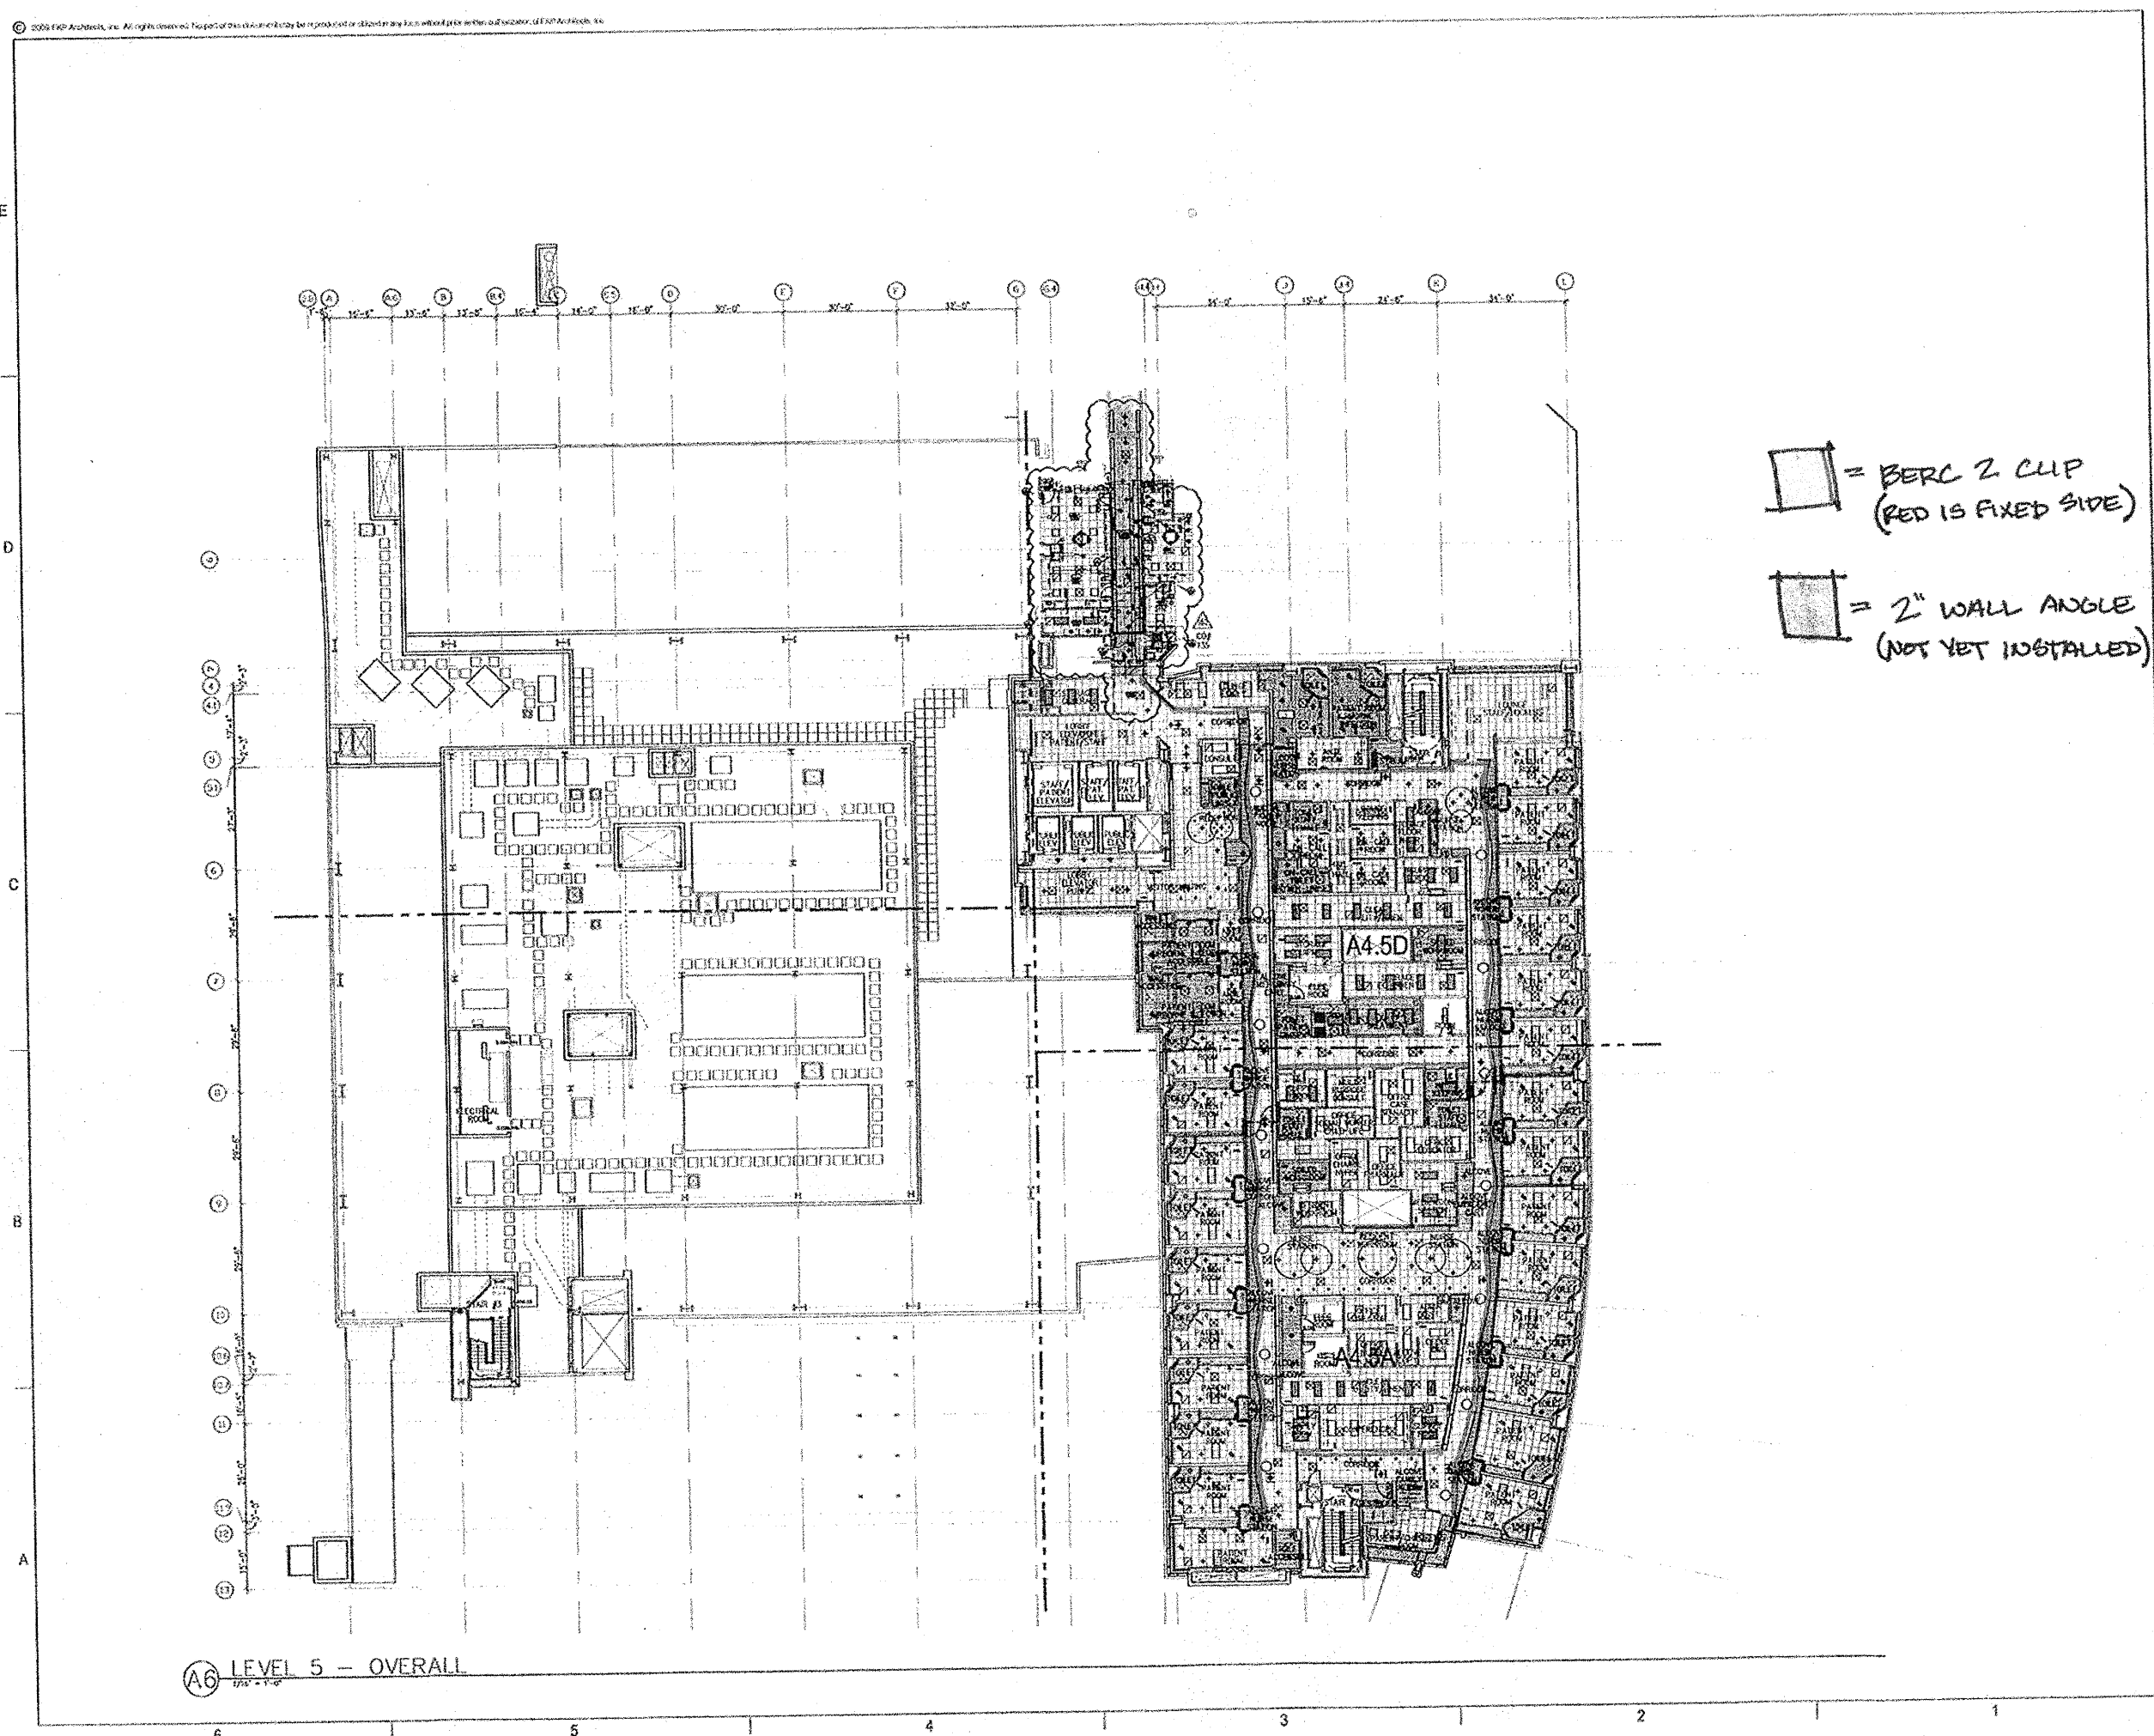

12011.00
Increment #7
IL 072072-30
OSHPD PERMIT
01/27/2010
1/16\"/>

A4.51

01/27/2010