


FKP Architects

ARCHITECT OF RECORD
Paul C. Gloriot

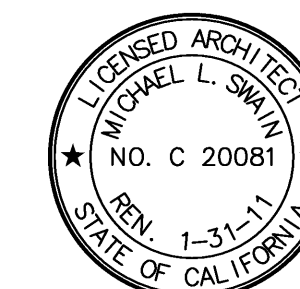

REVISIONS		
14	05/27/10	CHANGE ORDER #14
70	10/06/10	CHANGE ORDER #61
112	10/25/10	ASI 36

APPROVAL

PROJECT NAME
**CHILDREN'S HOSPITAL
OF ORANGE COUNTY**
455 S. Main St.
Orange, CA 92668-3874

TOWER II

CHOC
HOSPITAL

PROJECT NUMBER
**12011.00
Increment #7**

OSHPD - PROJECT NUMBER
IL 072072-30

ISSUE
OSHPD PERMIT

DATE
01/27/2010

SCALE

N.T.S.

DRAWING TITLE

**OPENING DETAILS
OPERABLE PARTITIONS**

DRAWING NUMBER

A11.4.1

RFI 4869
Coiling door finish information

RFI 3379: Track Attachment to Steel Plate

RFI 3604
Fire rating detail

RFI 3537
Head of wall
rating detail
at supports

RFI 1515: Backing material
door 2.041.00.Ac & others

RFI 3280
Change to shaft
partition


RFI 3460
Door
header
detail at
tube steel

RFI 4692
Counter height on
door side is 3'-6" the
counter height on
the opposite side
has a cabinet at 34"

RFI 3705 Counter Coiling Door
Clarifications

RFI 5088

RFI 2474

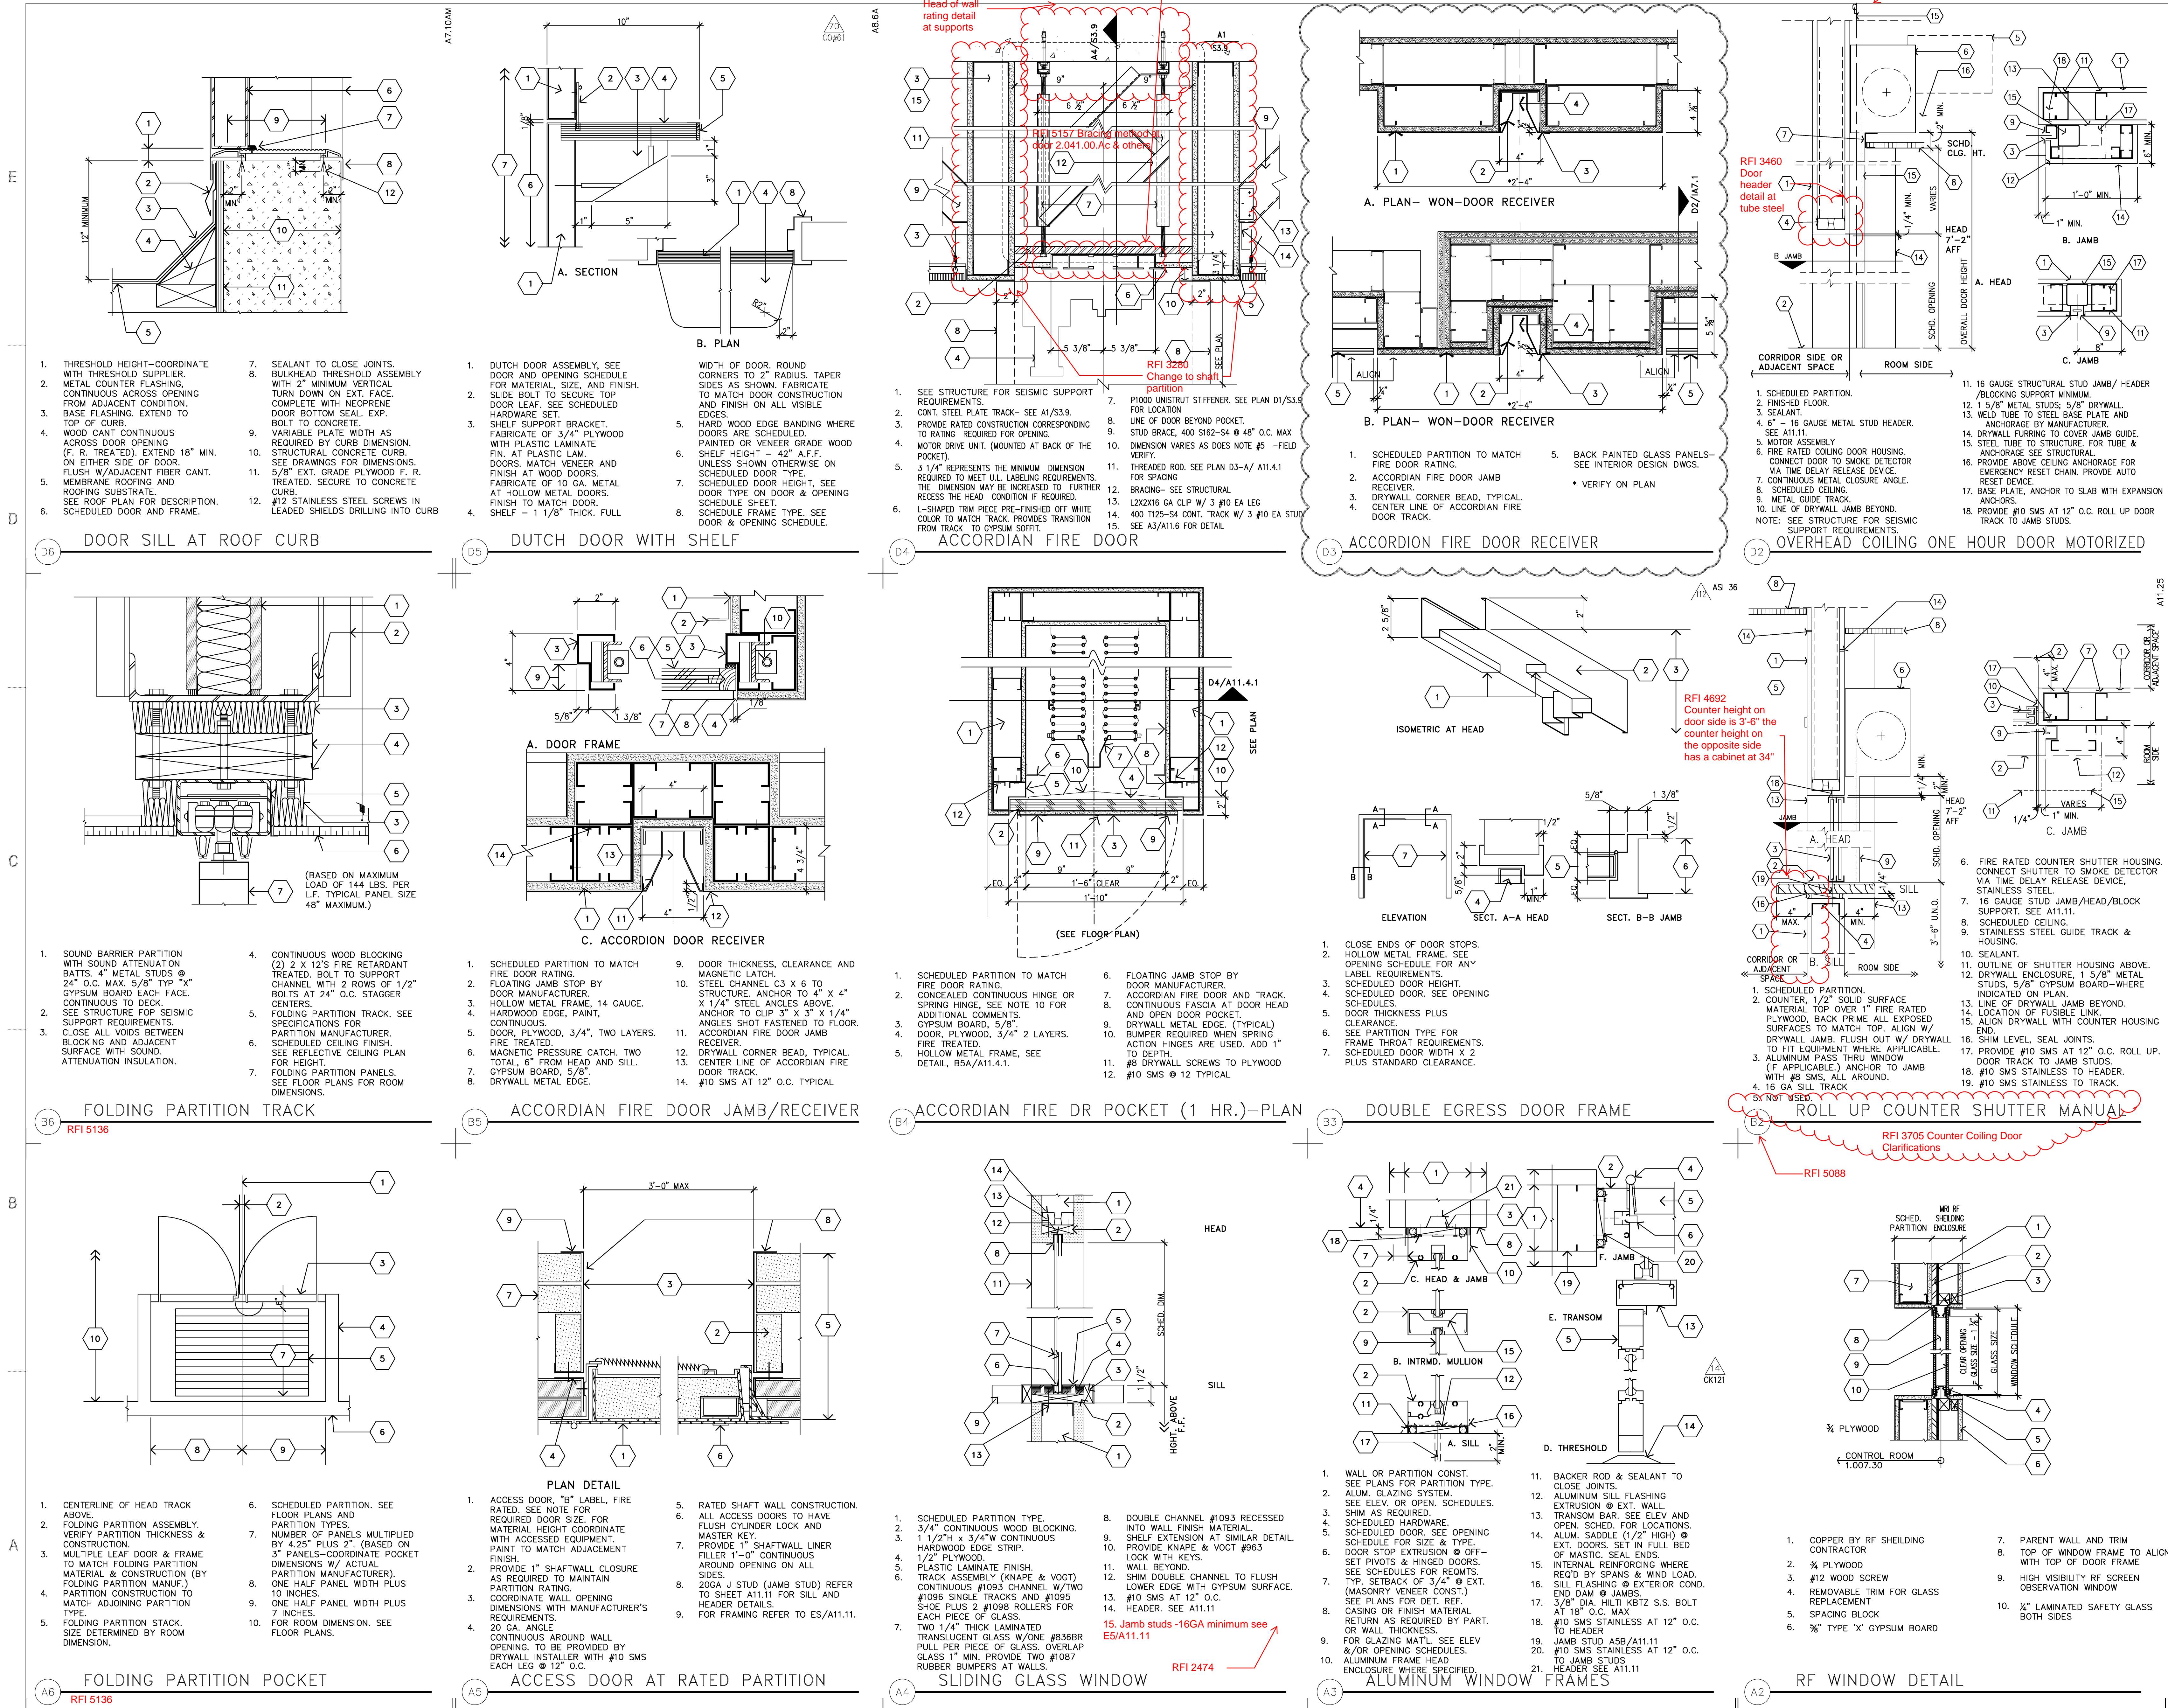

\\MBA-OFFSITE\CASERVER\0605102 CHOC TOWER 2 SHELL BUILDING\KP CONTRACTED PROJECTS\PROJECT INCREMENTS\NCR_#07_TENANT IMPROVEMENT\OSHPD PERMIT DOCUMENTS\100602_C04_1\A11.41_RECOVER.DWG
11/2/2010
RONALD