


FKP Architects

ARCHITECT OF RECORD  
Paul C. Gloriot



REVISIONS	
02/05/10	INFORMATION BULLETIN #5
05/10/10	CHANGE ORDER #25

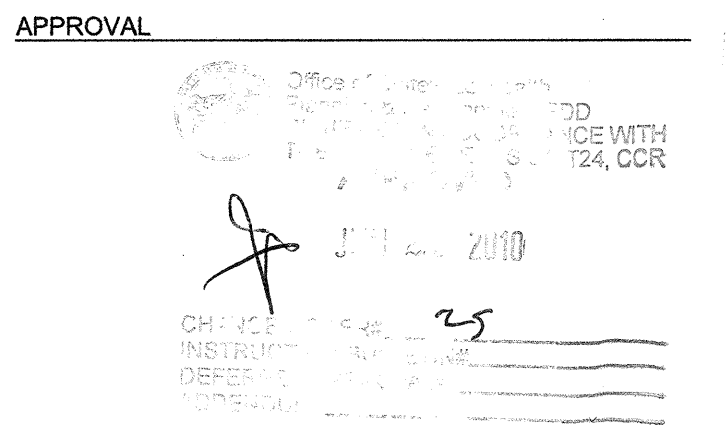

PROJECT NAME  
**CHILDREN'S HOSPITAL  
OF ORANGE COUNTY**  
455 S. Main St.  
Orange, CA 92668-3874

TOWER II



PROJECT NUMBER  
**12011.00  
Increment #7**

OSHPD - PROJECT NUMBER  
**IL 072072-30**

ISSUE  
**OSHPD PERMIT**

DATE  
**01/27/2010**

SCALE  
**N.T.S.**

DRAWING TITLE  
**DOUBLE EGRESS  
OPENING DETAILS**

DRAWING NUMBER  
**A11.4.2**

