


FKP Architects

ARCHITECT OF RECORD
Paul C. Gloriod

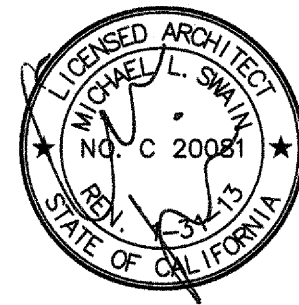


Changes on these drawings do not consist of
materially altered changes to approved drawings
and don't require a change order.
OSHPD review ACO
OSHPD review FLSD
OSHPD review DSE

REVISIONS

72	11/18/10	CO # 63
244	10/31/11	CO #268

APPROVAL

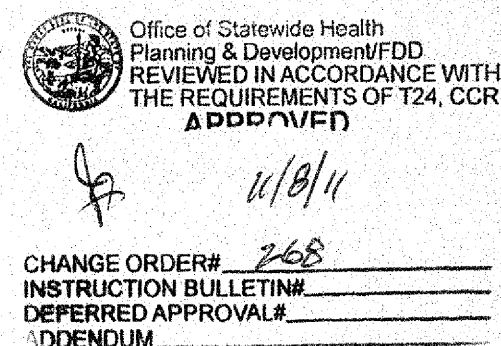

PROJECT NAME

CHILDREN'S HOSPITAL
OF ORANGE COUNTY
455 S. Main St.
Orange, CA 92668-3874

TOWER II



PROJECT NUMBER

12011.00
Increment #7

OSHPD - PROJECT NUMBER

IL 072072-30

ISSUE

OSHPD PERMIT

DATE

01/27/2010

SCALE

N.T.S.


DRAWING TITLE

MISC. DETAILS

DRAWING NUMBER

A11.8.2

CO#63

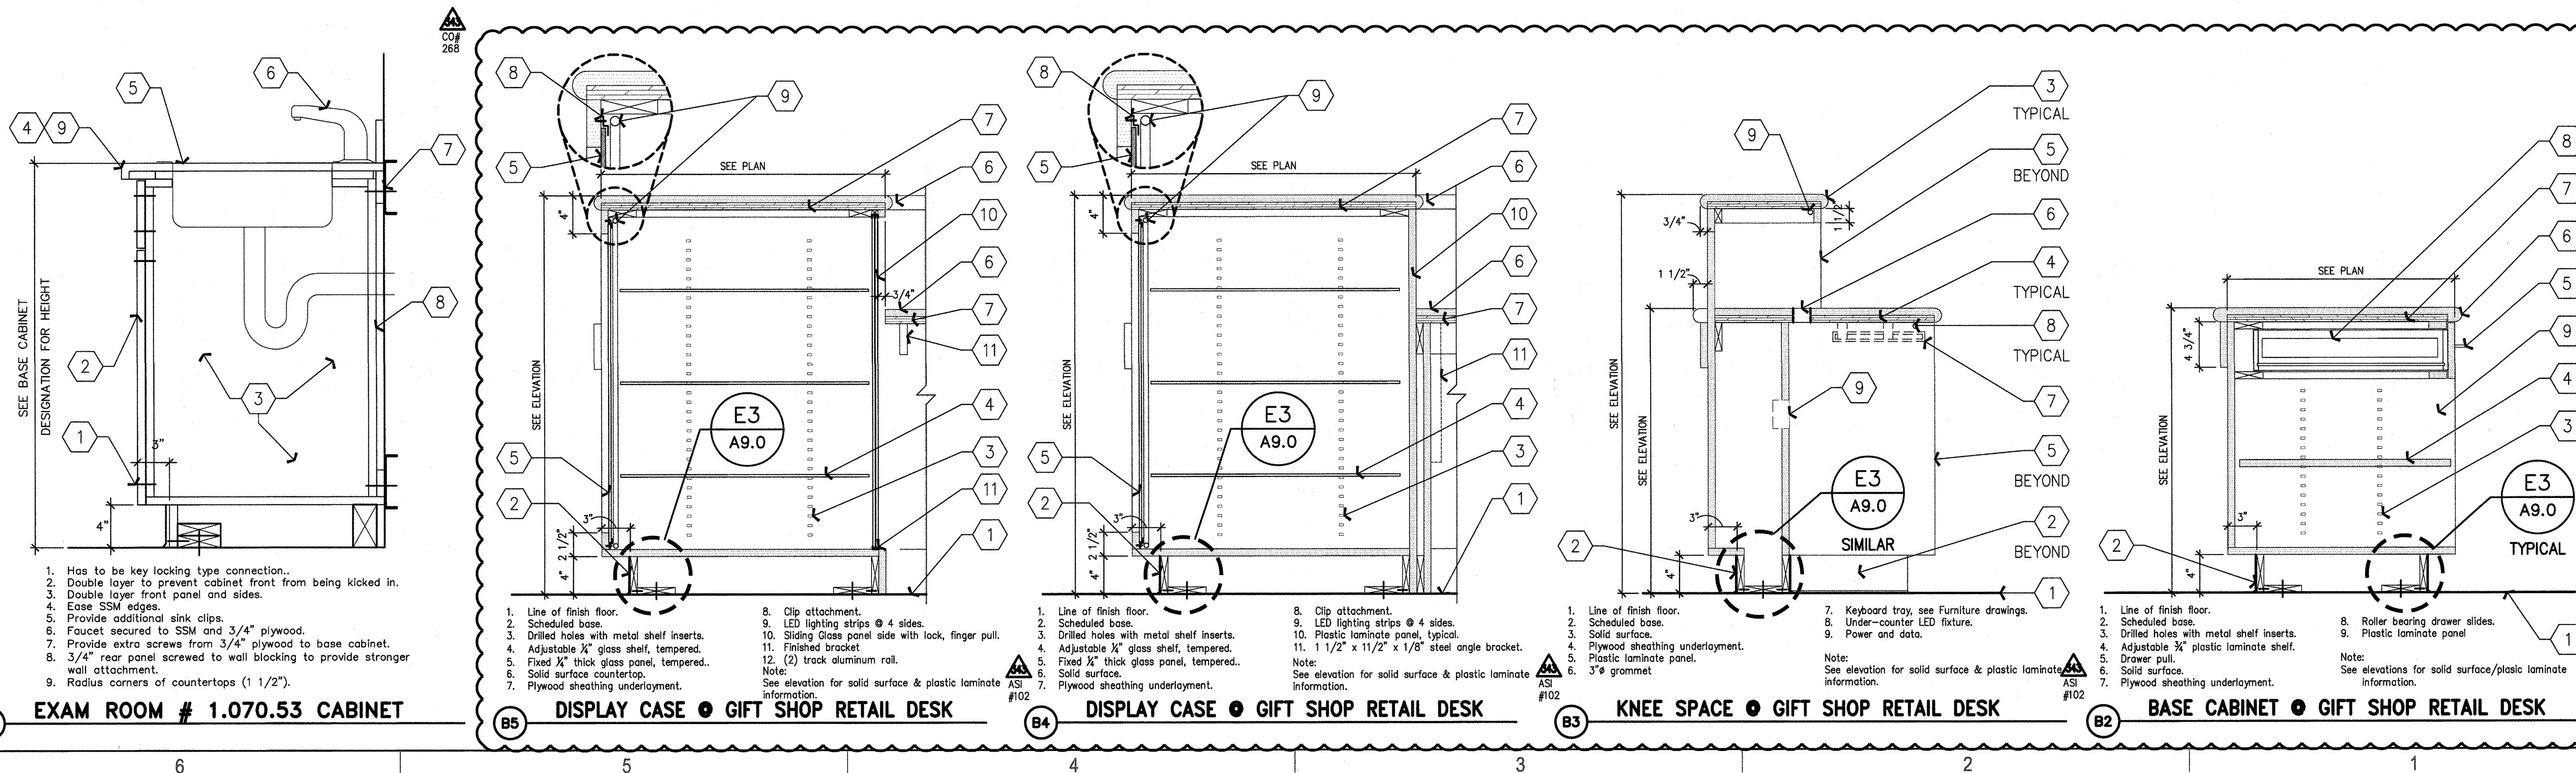

N: \\06000\06102 CHOC TOWER 2 SHELL BUILDING\RF CONTRACTED PROJECTS\PROJECT INCREMENTS\INCR. #07_TENANT IMPROVEMENT\OSHPD PERMIT (CONSTRUCTION DOCUMENTS)\060602_CO#63_A11.8.2 MISC. DETAILS.DWG
10/26/2011
RLLA