


FKP Architects

ARCHITECT OF RECORD

Paul C. Glorid

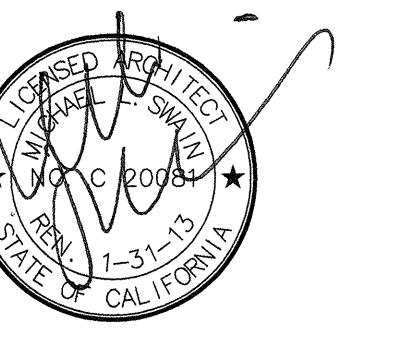


Changes on these drawings do not consist of materially altered changes to approved drawings and don't require a change order.
OSHPD review 11/3/11
OSHPD review 11/3/11
OSHPD review 11/3/11

REVISIONS

44	05/28/10	ASI #08
39	12/01/10	ASI #48
182	02/14/11	CO #122
308	07/18/11	CO #243

RECEIVED
JULY 26 2011
McCARTHY

APPROVAL

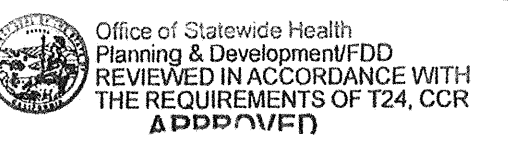

CHANGE ORDER#
INSTRUCTION BULLETIN
DEFERRED APPROVAL
ADDENDUM

PROJECT NAME

CHILDREN'S HOSPITAL
OF ORANGE COUNTY

455 S. Main St.
Orange, CA 92668-3874

TOWER II



PROJECT NUMBER

12011.00
Increment #7

OSHPD - PROJECT NUMBER

IL 072072-30

ISSUE

OSHPD PERMIT

DATE

01/27/2010

SCALE


1/4"=1'0"

DRAWING TITLE

LOWER LEVEL ENLARGED
PLAN AREA - M

DRAWING NUMBER

A3.0M

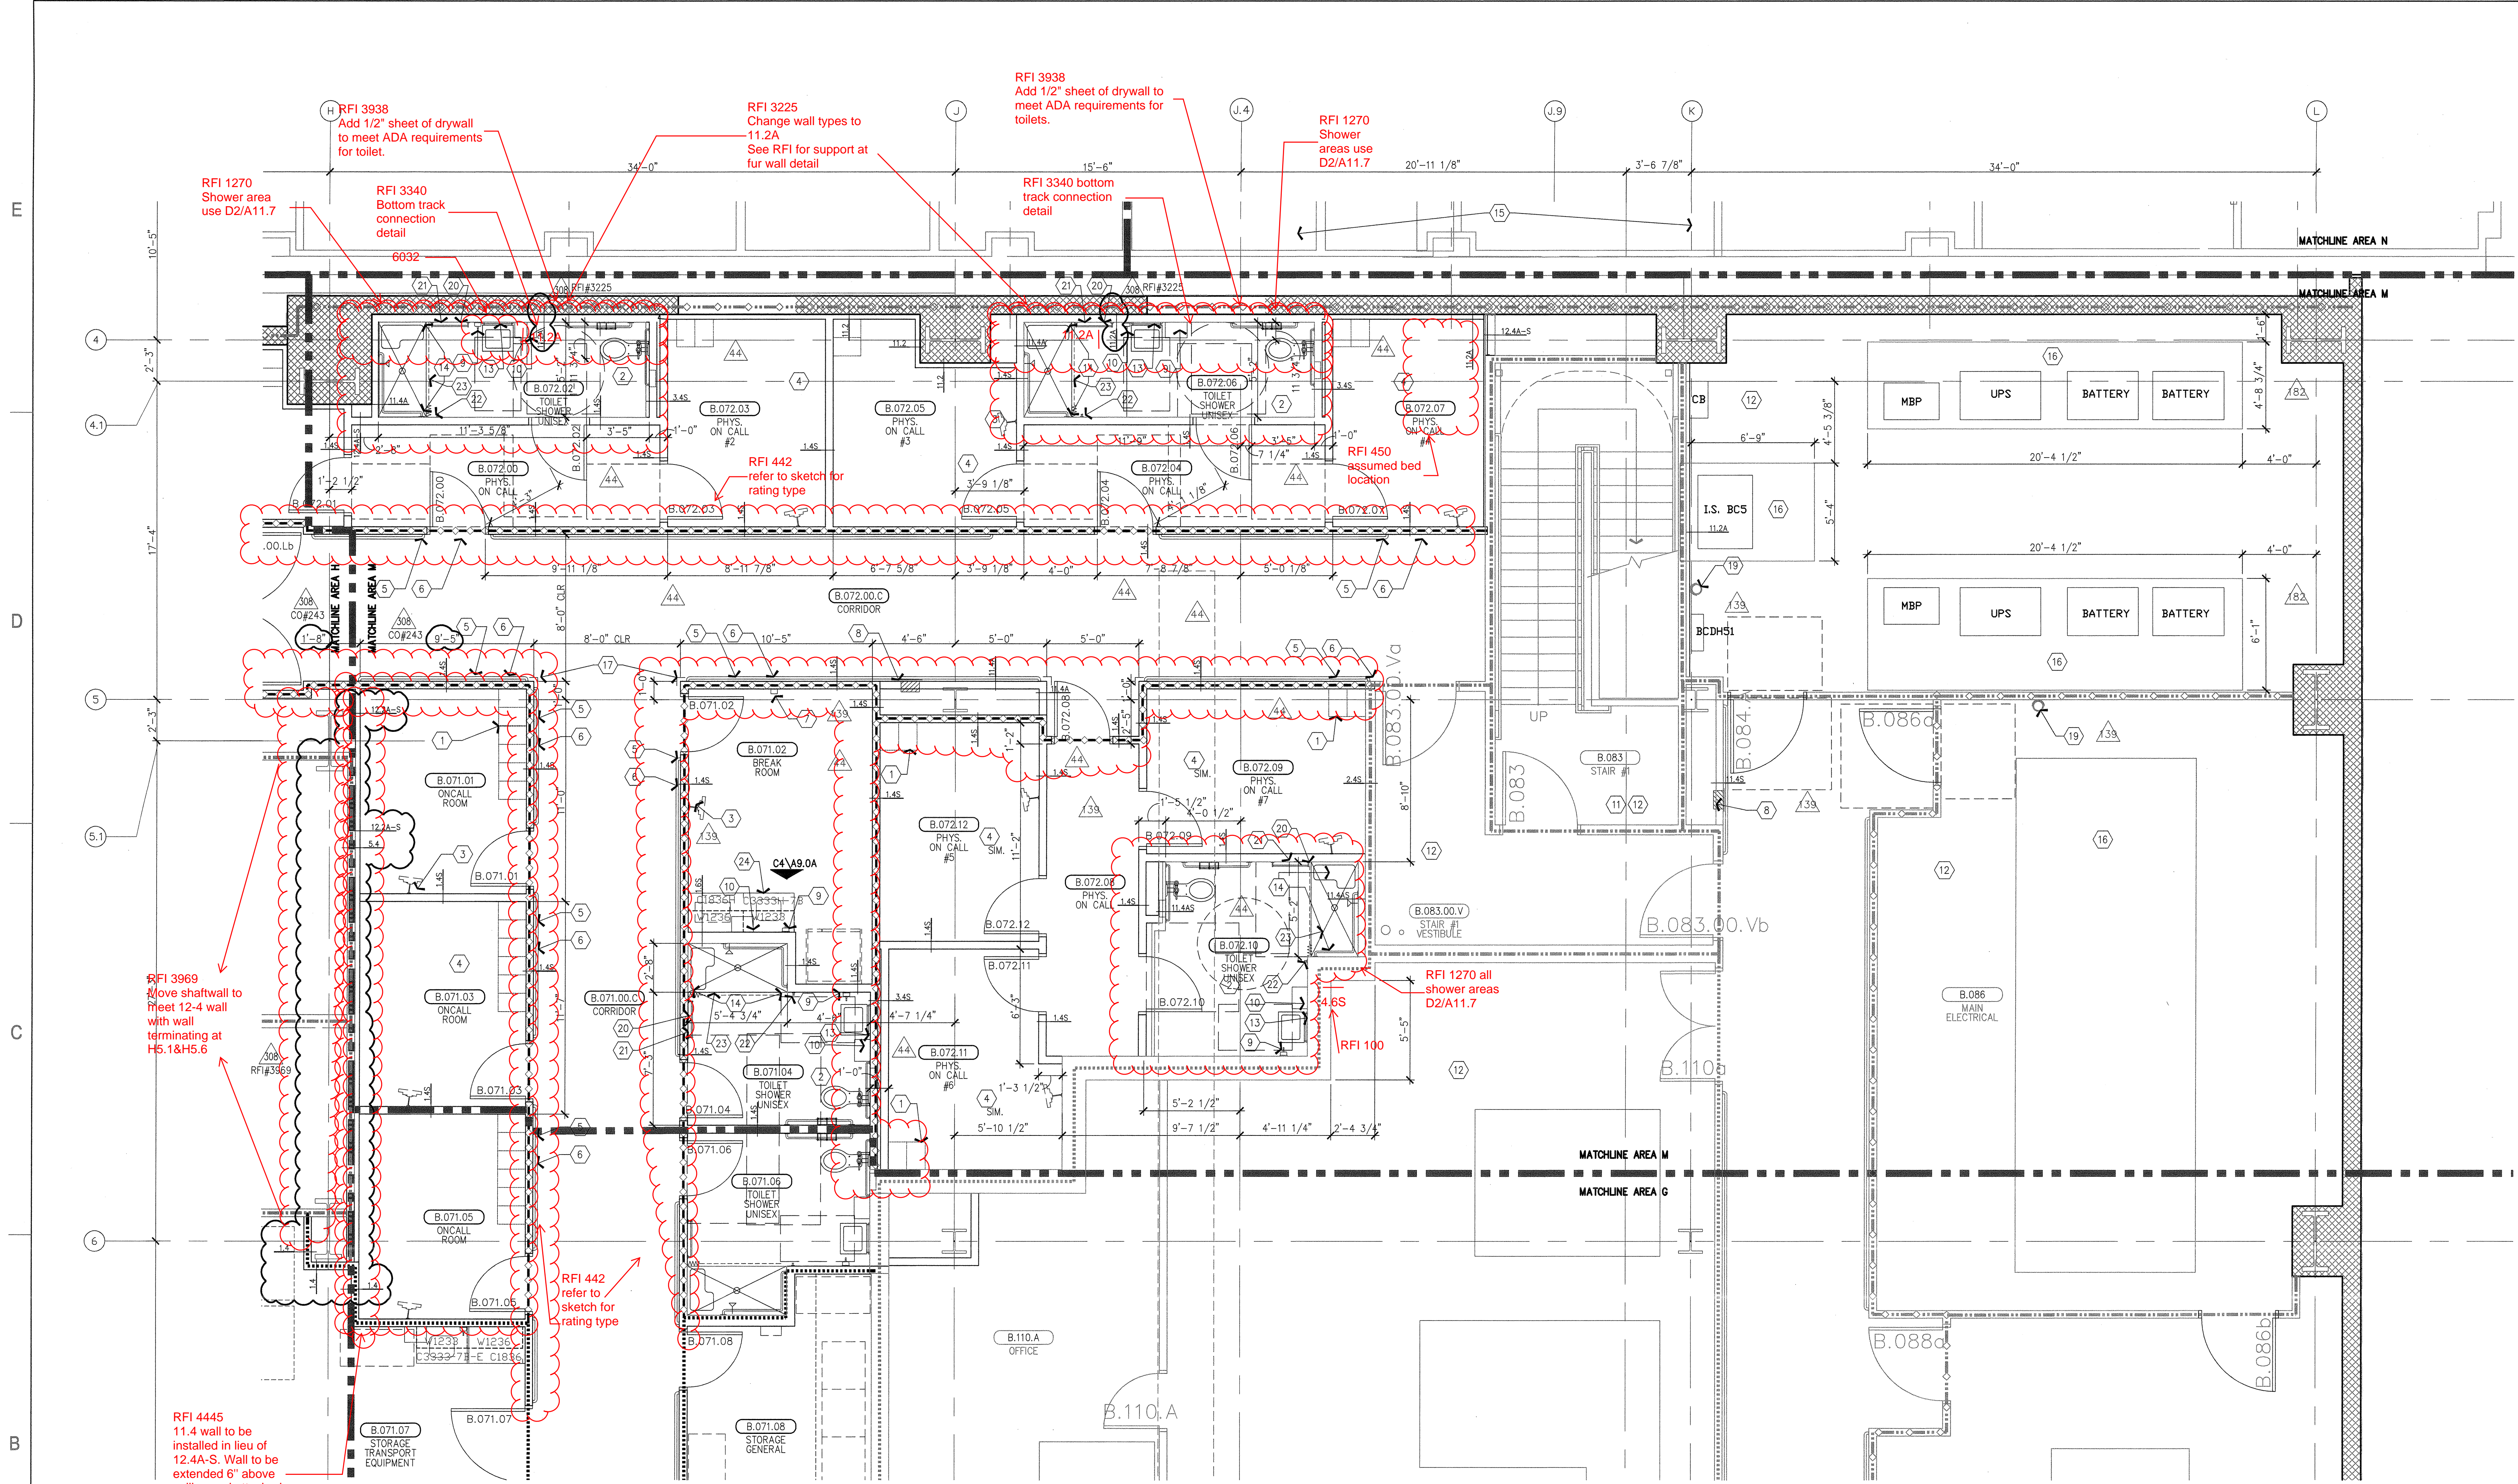

B6 AREA "M"
1/4" = 1' - 0"

- Personal effects storage units type A, full height, plastic laminate, sloped top.
- Accessible toilet stall/shower. See typical plan details B3/A11.7.
- TV monitor, wall mounted. See Equipment plans and workbook. For blocking/support, see Vol. 3B, Increment 7.
- See room B.071.01 for typical location designations.
- Bump rail. See detail B4/A11.8.
- Handrail/crash rail. See detail B4/A11.8.
- Alcohol gel dispenser, wall mounted, OFCI.
- Fire extinguisher cabinet, wall recessed, paint to match adjacent wall, typical. See A2 or B2/A11.8 for detail.
- Soap dispenser, wall mounted, OFCI. See Equipment plans and workbook.
- Paper towel dispenser, wall mounted, OFCI. See Equipment plans and workbook.
- For stair requirements, dimensions, and partition types this area, see Increment 5 and 6.
- For equipment types and dimensions this area, see Increment 6.
- Provide Bobrick, B-292 combination of mirror and shelf, mount mirror and shelf, 40" AFF to reflected surface.
- Seal off door surface to close joint.
- Existing North Tower.
- Housekeeping pad, see MEP and Increment 5 for requirements.
- Corner guards, all outside corners this area, high impact plastic, full height, see B4/A11.8.
- Service sink and accessories. See A3/A11.7.
- Fire extinguisher, wall mounted, coordinate location with low voltage equipment.
- Towel bar, 24"W, mounted at 3'-4" A.F.F.
- Towel rack, 24"W, mounted at 4'-6" A.F.F.
- Robe hook, mounted at 4'-6" A.F.F.
- Shower rod. For shower curtain see Interiors.
- Modified countertop to 25 1/2" deep for entire cabinet length. Detail C5A/A9.0.
- RFI 1472
Provide Bobrick
B-292 combination
of mirror and shelf
40" AFF to
reflected.

A6 NOTES TO SHEET

6

5

4

3

2

1

A4 GENERAL NOTES

A1 KEY PLAN

S	T	U
R	Q	P
K	L	N
J	H	M
D	E	G
C	B	F
		A