

FKP Architects

ARCHITECT OF RECORD
Paul C. Gloriod



REVISIONS

11b	10/01/10	ASI #31R1
-----	----------	-----------

APPROVAL

PROJECT NAME
**CHILDREN'S HOSPITAL
OF ORANGE COUNTY**
455 S. Main St.
Orange, CA 92868-3874

TOWER II



PROJECT NUMBER
**12011.00
Increment #7**

OSHPD - PROJECT NUMBER
IL 072072-30

ISSUE
OSHPD PERMIT


DATE
01/27/2010

SCALE
1/16" = 1'-0"

DRAWING TITLE
LEVEL 2 FLOOR PLAN

DRAWING NUMBER

A3.21.1

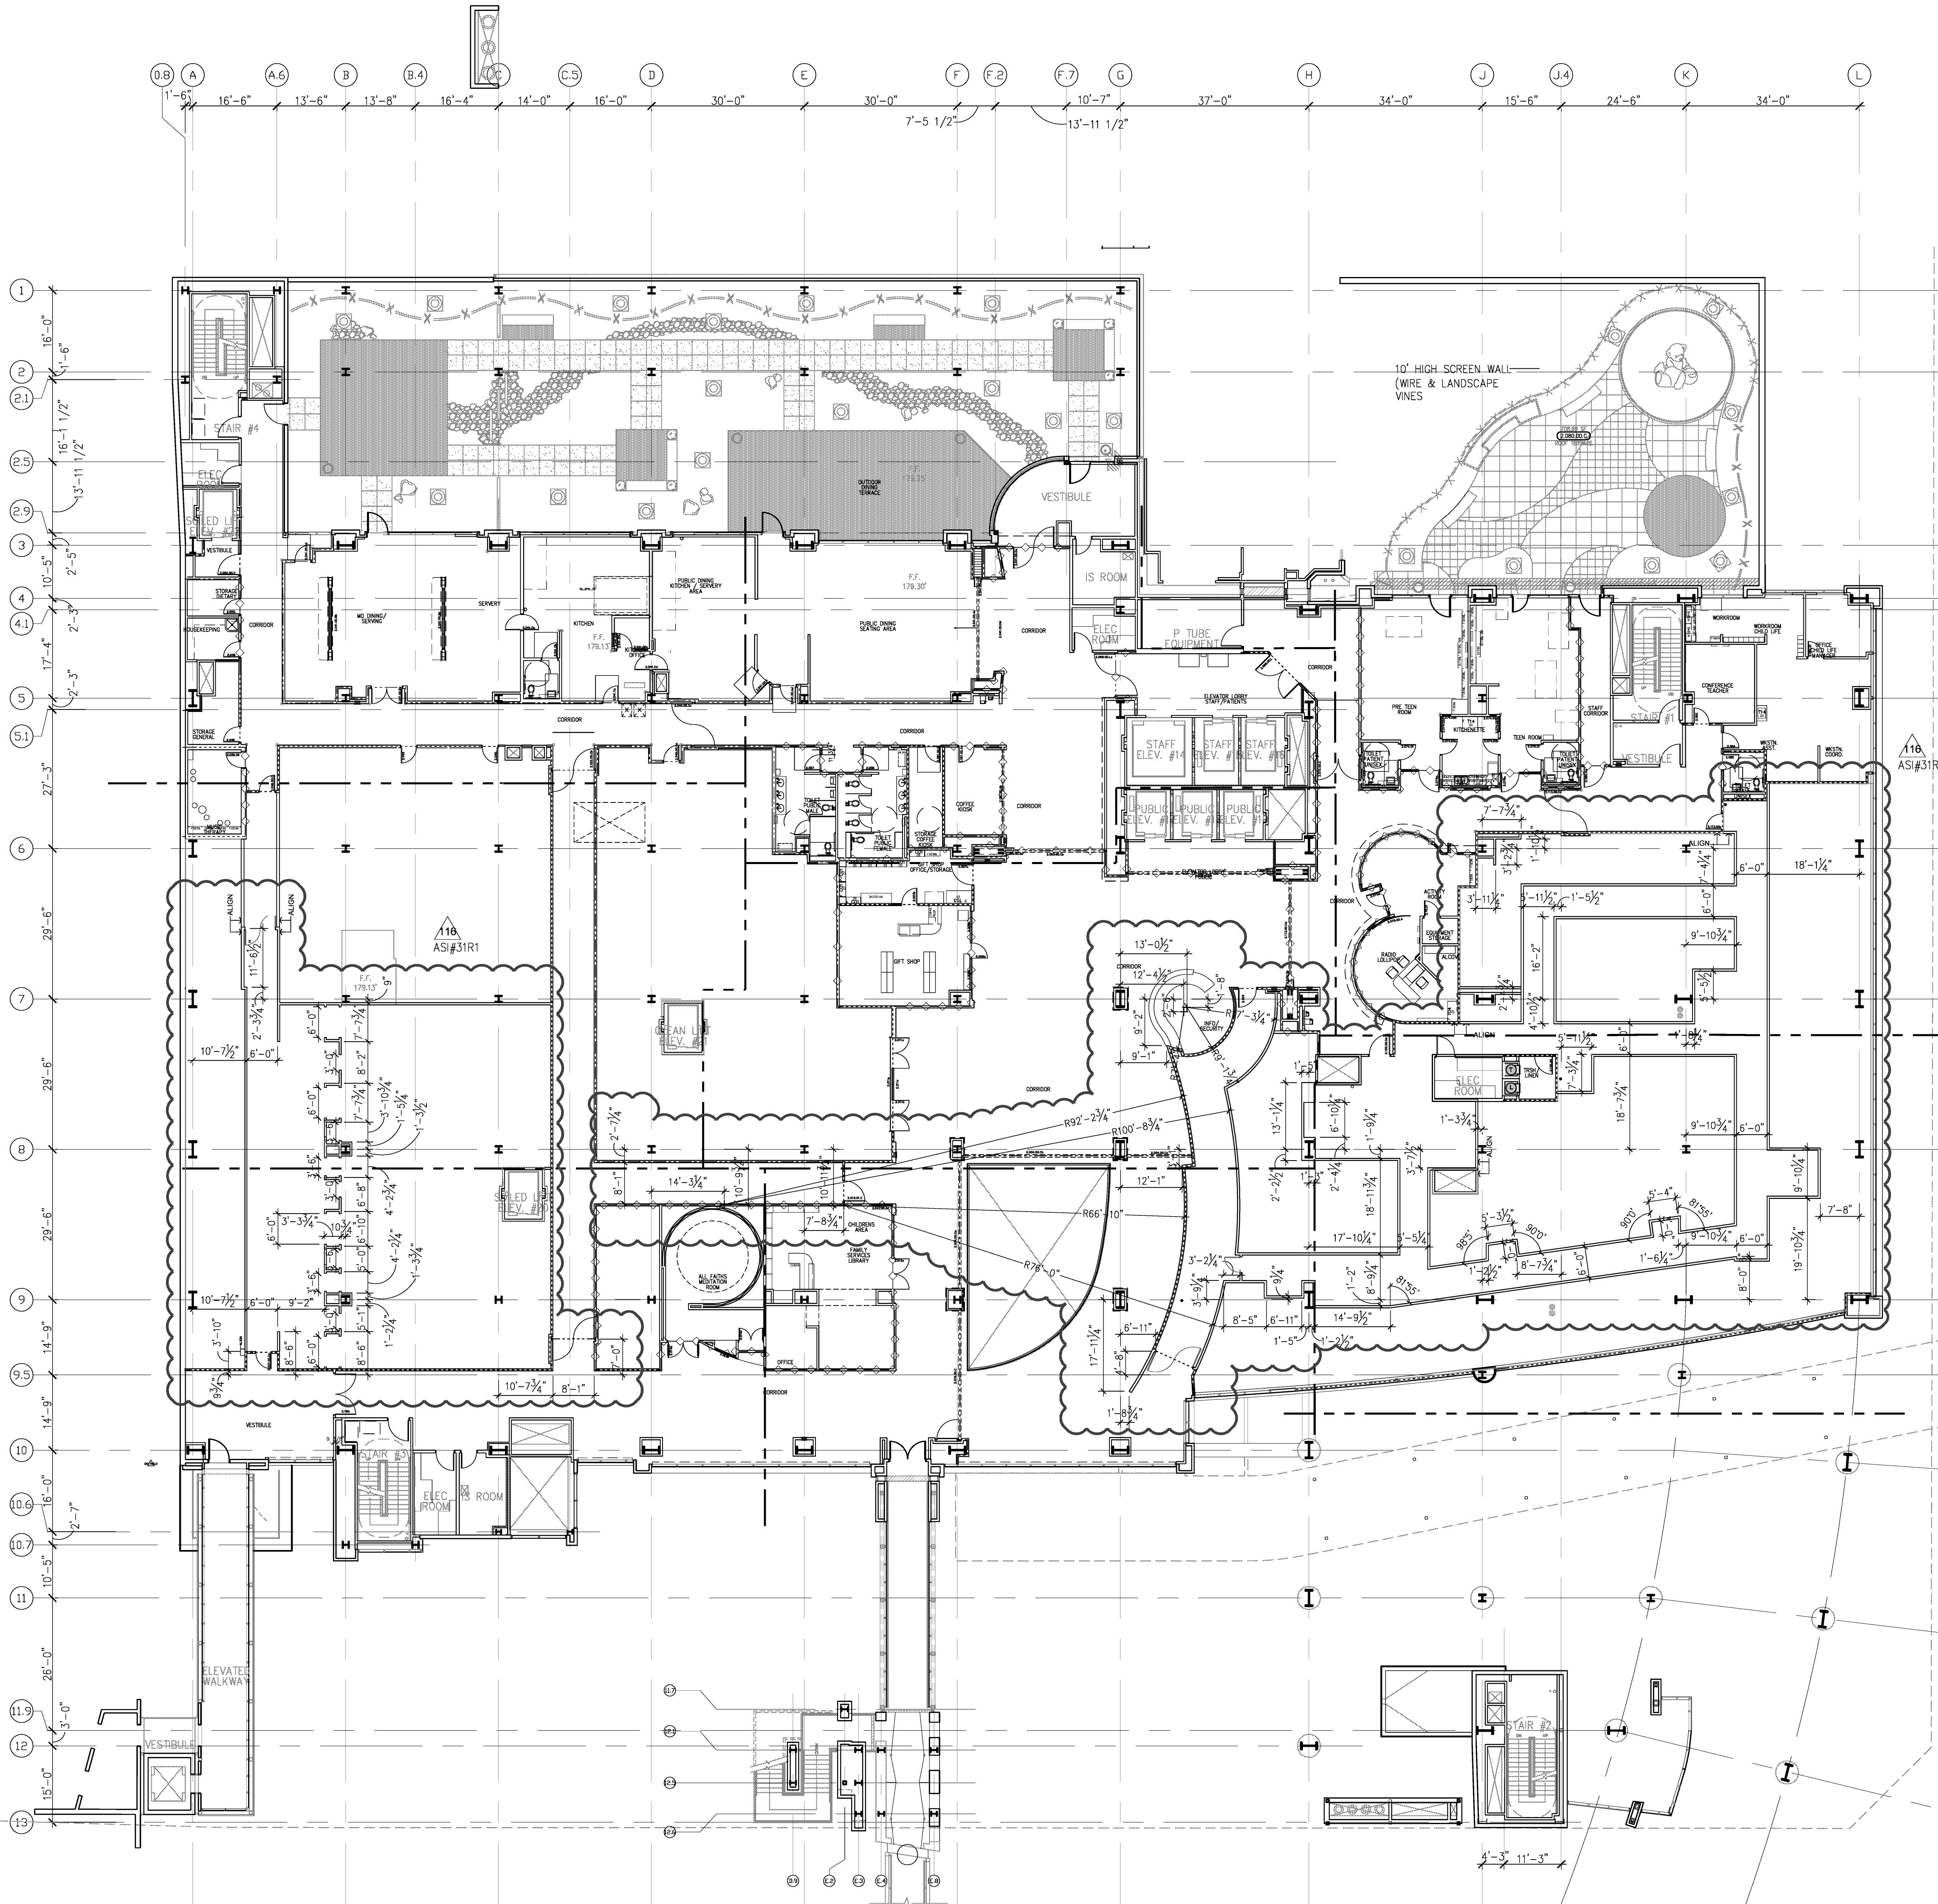

FOR MEP COORDINATION ONLY.
NOT FOR CONSTRUCTION.

S	T	U
R	Q	
	P	
K	L	G
J	H	F
D	E	A

A1 KEY PLAN

A6 LEVEL 2 FLOOR PLAN
1/16" = 1'-0"