

FKP Architects

ARCHITECT OF RECORD
Paul C. Gloriod




Changes on these drawings do not consist of
materially altered changes to approved drawings
and don't require a change order.
OSHPD review ACO
OSHPD review FLSO
OSHPD review DSE

REVISIONS

03/01/11 CO #134

APPROVAL

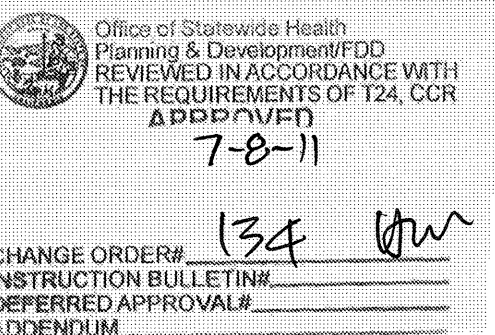

PROJECT NAME

CHILDREN'S HOSPITAL
OF ORANGE COUNTY
455 S. Main St.
Orange, CA 92868-3874

TOWER II RECEIVED
July 12 2011
McCARHY



PROJECT NUMBER

12011.00
Increment #7

OSHPD - PROJECT NUMBER

IL 072072-30

ISSUE

OSHPD PERMIT

DATE

01/27/2010

SCALE


3/8" = 1'-0"

DRAWING TITLE


ENLARGED RESTROOMS

DRAWING NUMBER

A3.21.2

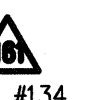

CO #134

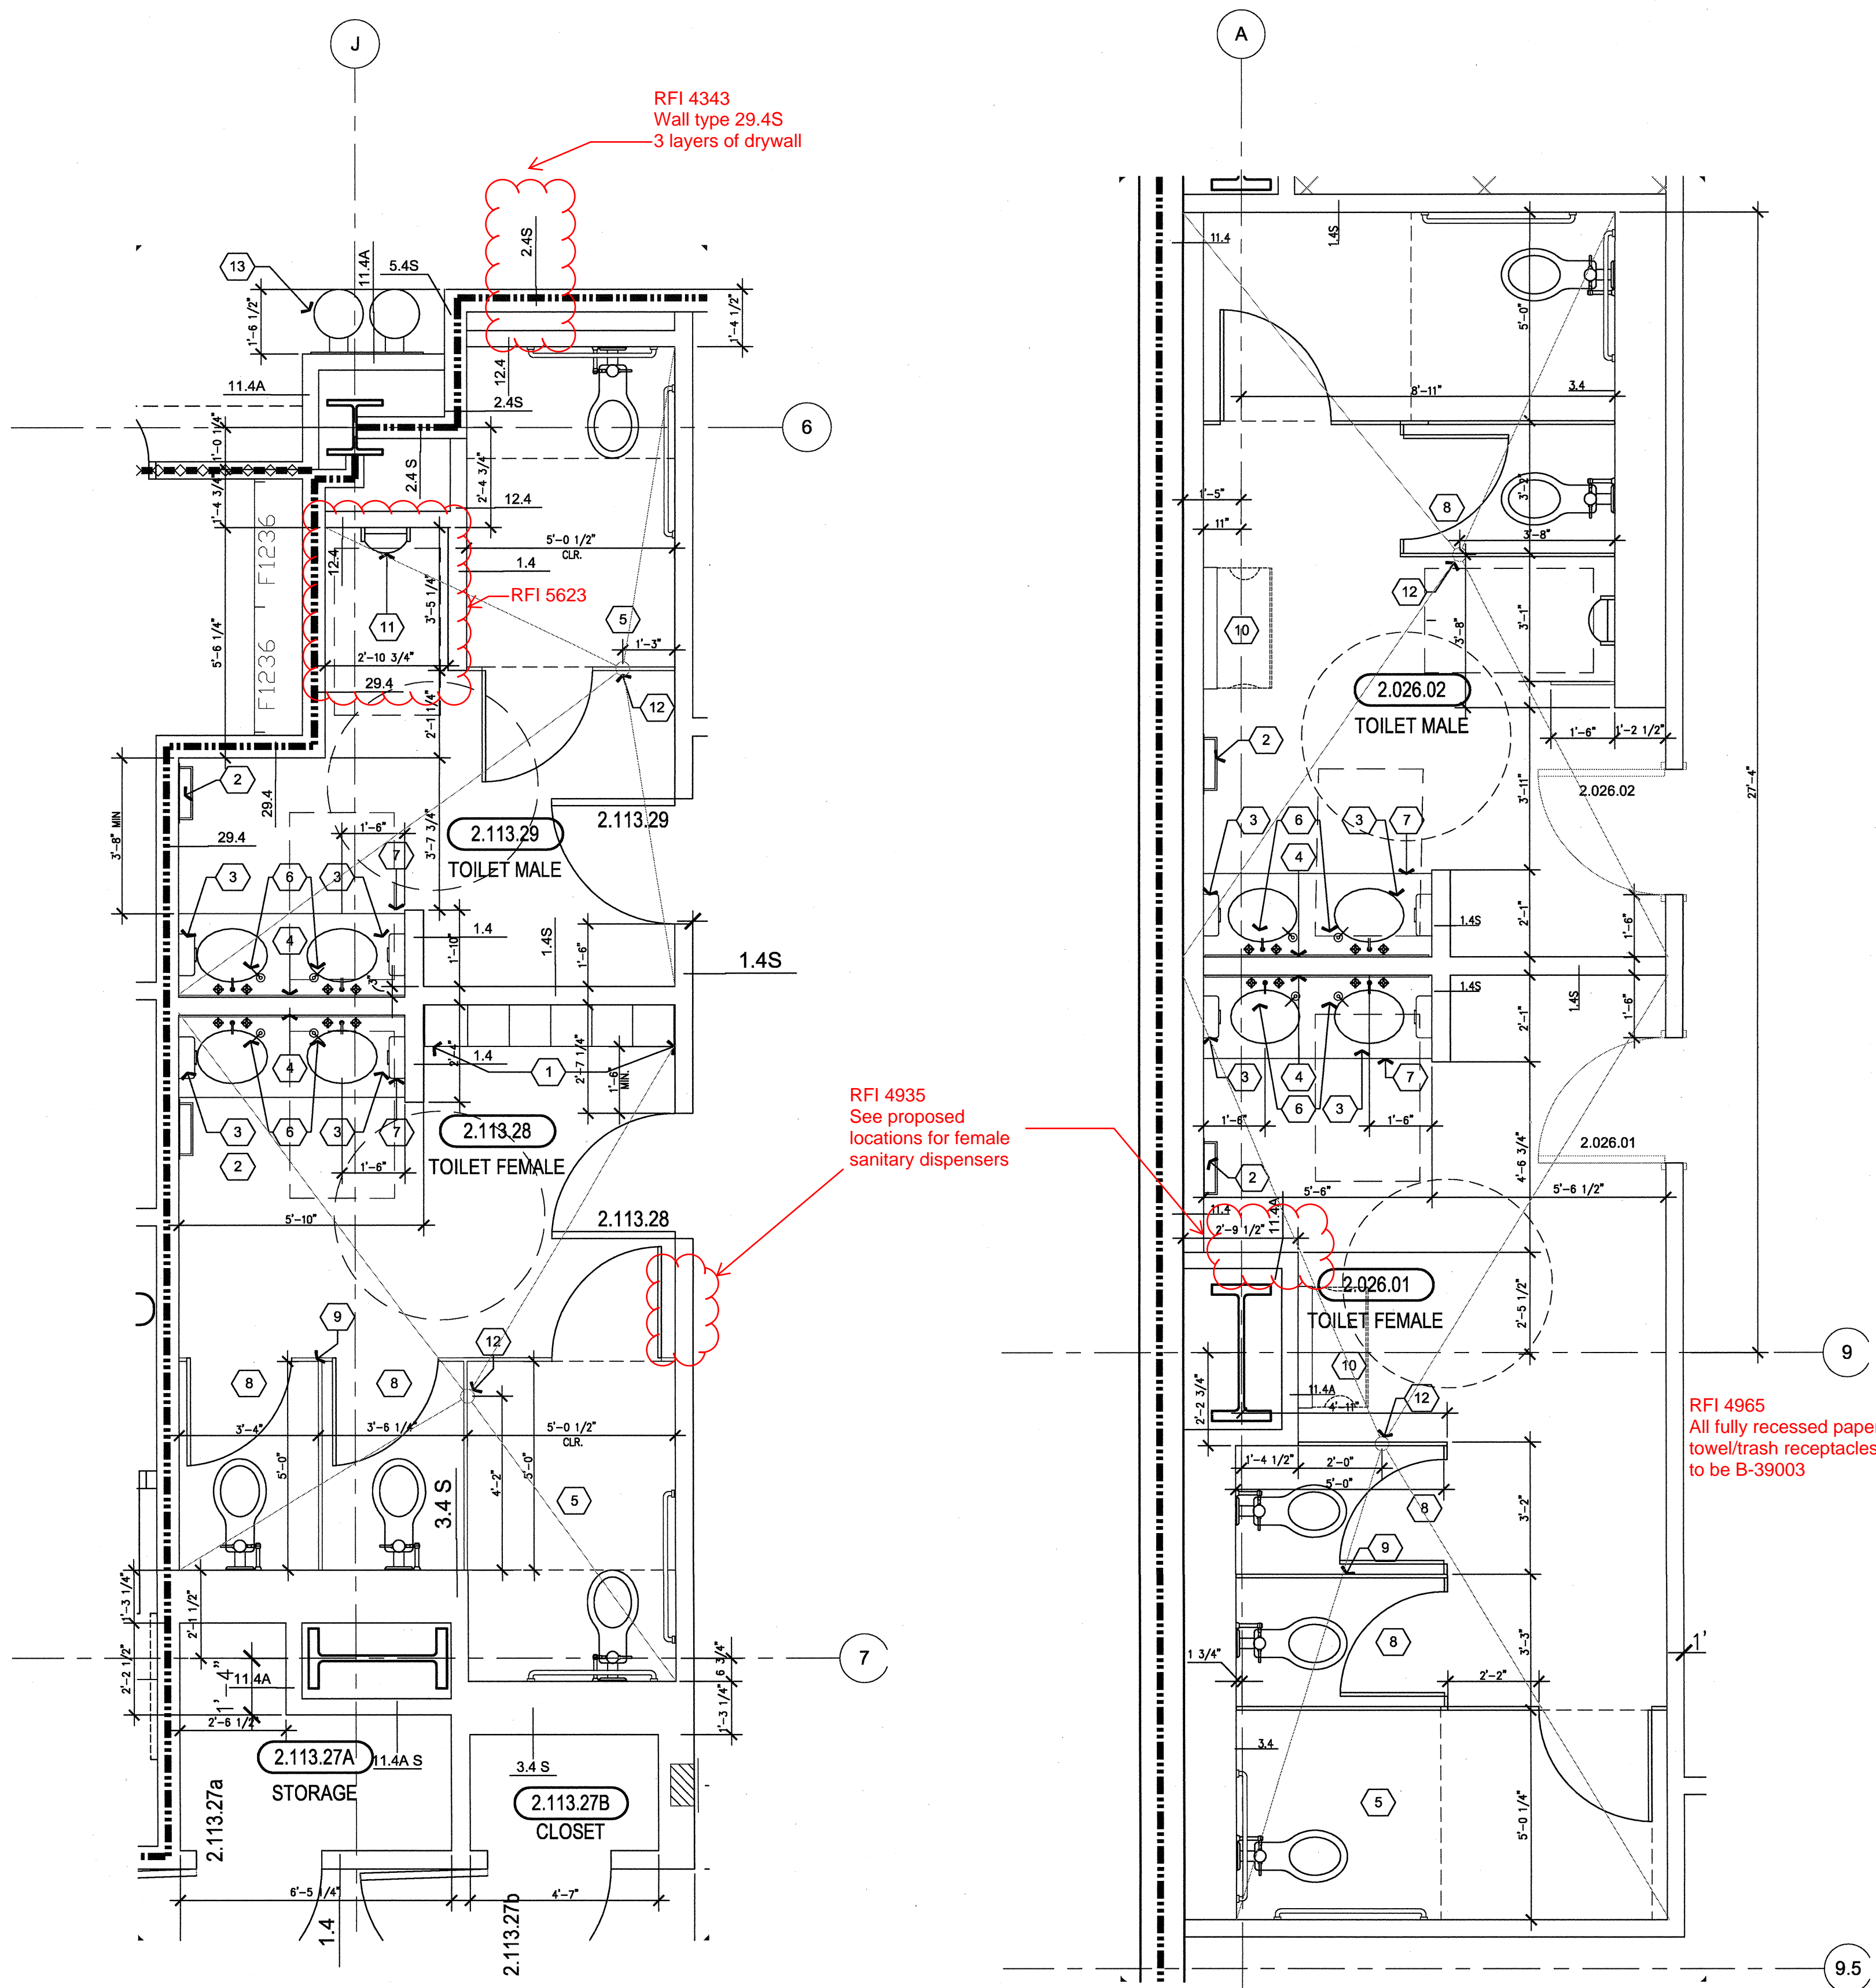

- PERSONAL EFFECTS STORAGE UNITS, 5 HIGH, TYPE D, PLAIN FINISH. SEE DETAIL A4/A11.8.
- RECESSED PAPER TOWEL AND TRASH RECEPTACLE. SEE B6/A11.7.
- PAPER TOWEL DISPENSER, WALL MOUNTED, OFC; SEE EQUIPMENT DRAWINGS AND WORKBOOK.
- MIRROR, FULL WIDTH OF COUNTER, FROM TOP OF SPLASH TO 7'-0" A.F.F.
- ACCESSIBLE TOILET STALL. SEE B5/A11.7.
- SOAP DISPENSER, LAVATORY MOUNTED.
- SOLID SURFACE MATERIAL COUNTERTOP. SEE A2/A11.7 FOR DETAIL.
- TOILET STALL. SEE A4/A11.7 FOR MOUNTING HEIGHTS.
- TOILET PARTITION, FLOOR MOUNTED.
- CHANGING STATION, WALL MOUNTED, SEE D6/A11.8.
- URINAL. SEE DETAIL D4/A11.7.
- FLOOR DRAIN, SLOPED FLOOR TO DRAIN.
- DRINKING FOUNTAIN.

A4 RESTROOMS - ADMIN.

A3 RESTROOMS - CONFERENCE

A1 KEYED NOTES TO SHEET