


FKP Architects

ARCHITECT OF RECORD  
Paul C. Gloriod

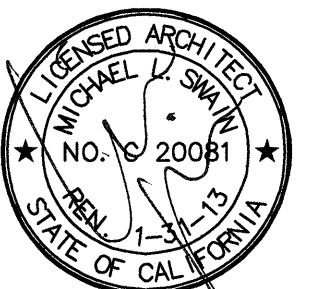

Changes on these drawings do not consist of material alterations to approved drawings and don't require a change order.  
OSHPD review ACO  
OSHPD review FLSO  
OSHPD review DSE

REVISIONS

|    |          |         |
|----|----------|---------|
| 44 | 05/28/10 | ASI #08 |
| 23 | 05/10/10 | CO #25  |
| 11 | 10/25/10 | ASI #36 |
| 20 | 12/01/10 | ASI #48 |
| 30 | 03/11/11 | ASI #74 |
| 18 | 03/28/10 | CO #174 |
| 24 | 06/07/10 | CO #193 |
| 33 | 09/19/11 | CO #261 |
| 39 | 11/15/11 | CO #299 |

APPROVAL



Office of Statewide Health Planning & Development (OSHPD)  
INSTRUCTION BULLETIN  
THE REQUIREMENTS OF T24, CCR  
ADDITIONAL  
CHANGE ORDER# 799  
DEFERRED APPROVAL#  
CODE/NUM

PROJECT NAME

CHILDREN'S HOSPITAL  
OF ORANGE COUNTY  
455 S. Main St.  
Orange, CA 92668-3874

TOWER II



PROJECT NUMBER

12011.00  
Increment #7

OSHPD - PROJECT NUMBER

IL 072072-30

ISSUE

OSHPD PERMIT

DATE

01/27/2010

SCALE


1/4" = 1' - 0"

DRAWING TITLE

LEVEL 3 ENLARGED PLAN  
AREA - F

DRAWING NUMBER

A3.3F

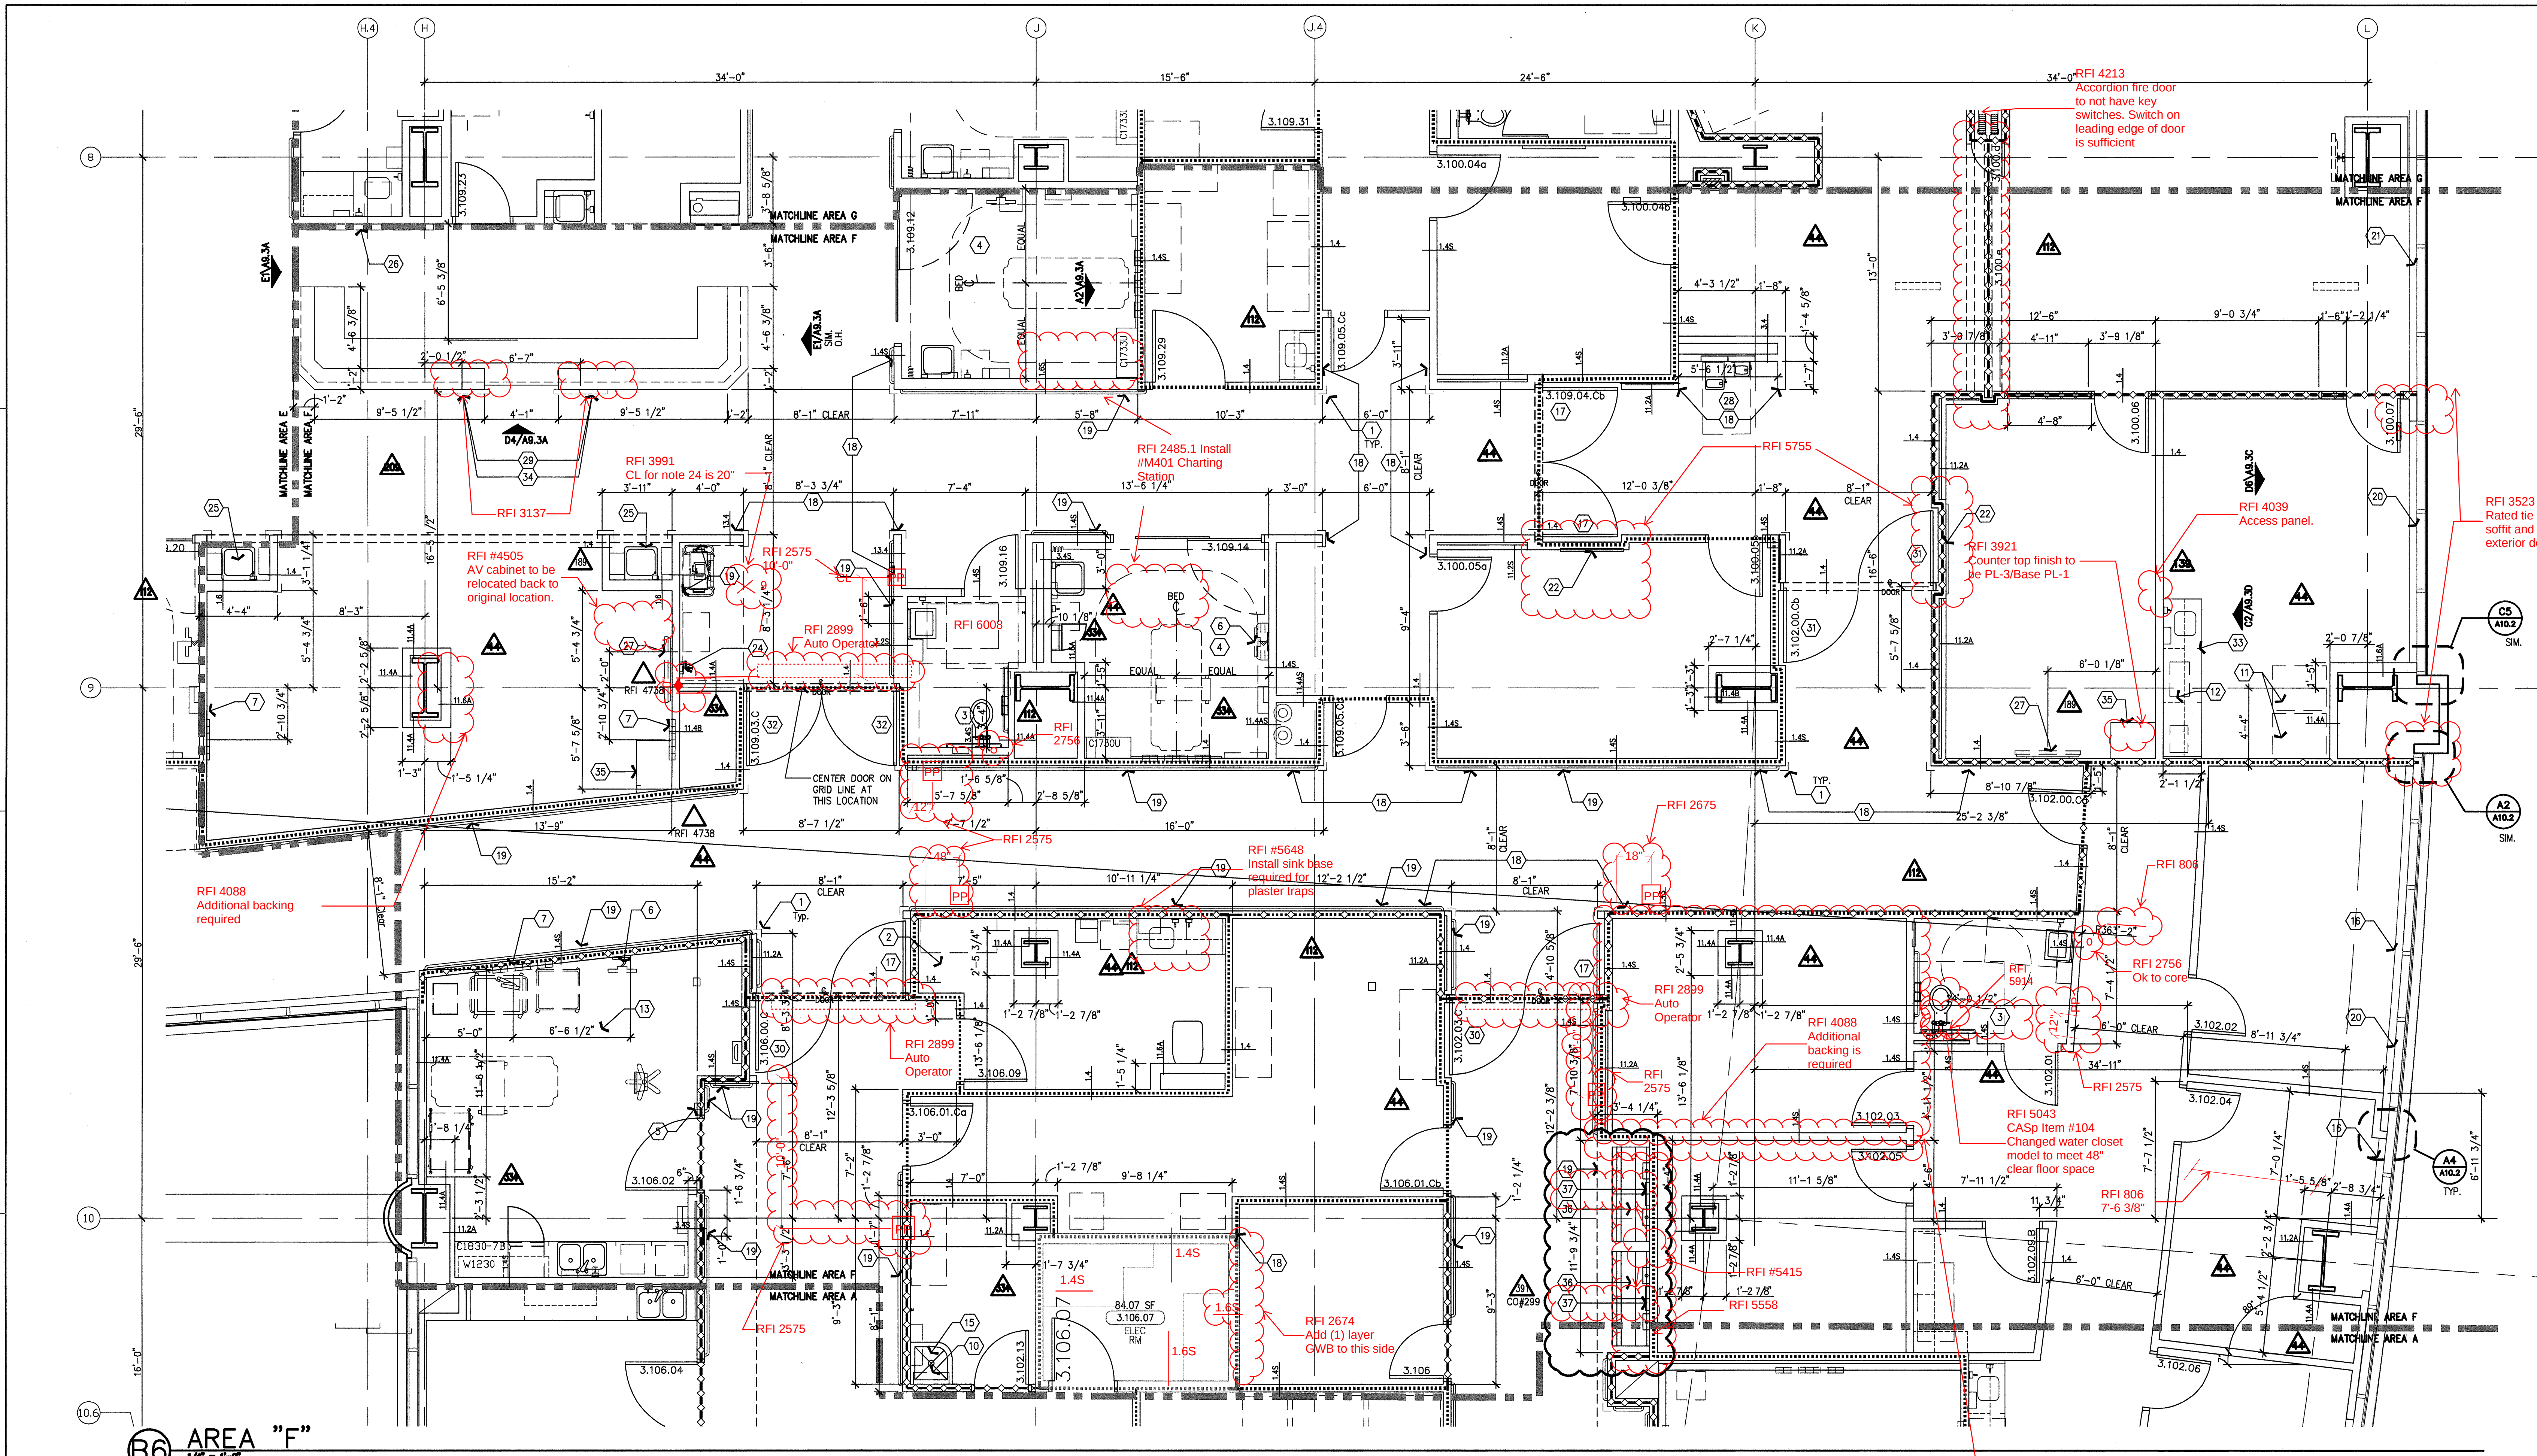

AREA "F"

1. Corner guard, high impact plastic. See detail B4/A11.8
2. Clinical sink. See Plumbing.
3. Accessible toilet room. See typical plan detail B3/A11.7.
4. See room 3.109.07 on Sheet A3.3G for typical note designations.
5. Nurse call, wall mounted.
6. TV/AOR, wall mounted with bracket. See equipment. See A5/S3.5 and D1/S3.6.
7. Medical gas outlets, see Plumbing. See detail B2/A11.9 for mounting height.
8. Pneumatic tube station.
9. Sheet wall protection to 48" A.F.F.
10. Housekeeping mop sink. See detail B2/A11.7.1.
11. Vending machine OFOL. See B4/S3.1 SM.
12. Microwave OFOL.
13. Medical Equipment. See equipment drawings/book.
14. Not used.
15. 14" deep shelf above, wall mounted with standards and brackets at 5'-0" A.F.F.
16. Sill wall, 2'-10" A.F.F. See C5/A10.1 for detail.
17. Integrated double egress door, wall recessed. See D5/D6/A11.4 for detail.
18. Align finished face of partition.
19. Handrail/crashrail. See detail B4/A11.8
20. Window treatment, manual roller window shade, typical at all exterior windows, U.N.O.
21. No window shades.
22. Dry erase marker board, 48"Wx48"H, wall mounted, bottom at 36" AFF. See B6/A11.3.1.
23. Not Used
24. Stadiometer, wall mounted. See equipment book.
25. Accessible sink. Mount top of rim at 34" AFF. See Plumbing for more information. See A2/A11.7.1.
26. Provide blocking for 2 OR control panels at 42" and 80" A.F.F. See D4/S3.1.
27. Flat screen TV, see audio/visual drawings. See A2/S3.4.
28. Electric water cooler, see D2/A11.8.
29. Tracking board, ceiling mounted. See reflected ceiling plan, see D1/S3.5.
30. Integrated double egress door, wall recessed. See A5/A11.4.2
31. Integrated double egress door, wall recessed. See D3/A11.4.2
32. Integrated double egress door, no wall recessed. See D3/A11.4.2
33. Modified countertop to 25 1/2" deep for entire cabinet length. Detail C5A/A9.0
34. Provide structural mount above ceiling (see Det. B4/S5). Bottom of mount to be ceiling height + 6" above F.F.
35. Scrub sink, see Plumbing and see Equipment. See B1/S3.1
36. Clock, wall-mounted, elapse time and normal time, synchronize with all procedure rooms. See Telecom drawings.

NOTES TO SHEET

GENERAL NOTES


GLAZING AREA TABULATION

KEY PLAN

ACTIVITY ROOM 3.100.06

WALL AREA:

Section A 12'-7" x 10'-0" = 125.8 SQ.FT.  
125.8 SQ.FT. X 25% = 31.5 SQ.FT. Allowable Glazed Area  
ACTUAL GLAZING AREA (1 1/2" FRAME):  
Section A 4'-9" x 3'-11" = 18.6 SQ.FT.

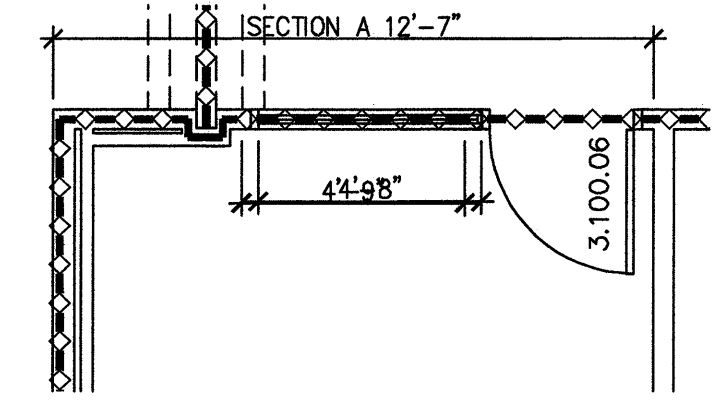

RFI 1213  
Dimensions for intersections  
of radius wall

RFI 4094  
See detail for  
additional bracing

