


ARCHITECT OF RECORD  
Paul C. Gloriod

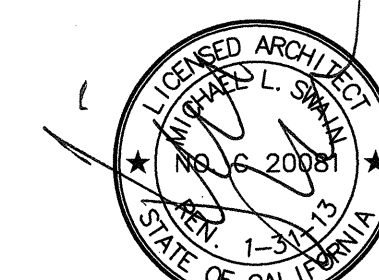

Changes on these drawings do not consist of materially altered changes to approved drawing and don't require a change order.

OSHPD review ACO \_\_\_\_\_

OSHPD review FLSO \_\_\_\_\_

OSHPD review DSE \_\_\_\_\_

|     |          |         |
|-----|----------|---------|
| 44  | 05/28/10 | ASI #08 |
| 337 | 11/02/11 | CO#264  |

DAD-2011-02522

Office of Statewide Health  
Planning & Development/FDD  
REVIEWED IN ACCORDANCE WITH  
THE REQUIREMENTS OF 124, CC  
APPROVED

CHANGE ORDER# 264  
INSTRUCTION BULLETIN# \_\_\_\_\_  
DEFERRED APPROVAL# \_\_\_\_\_  
ADDENDUM \_\_\_\_\_



### A3.5F



A. Information shown or referenced on enlarged and/or 1/4" scale drawings will generally not be shown on the smaller scale drawings.

B. Partition types are scheduled on plans by number. See the "General Notes to Architect" for details. Partitions are identified on Sheets A11.3.1, A11.3.1.1, and A11.3.2 for the definition of partition types references.

C. Equipment is scheduled on drawings by number, type, and locations of recessed equipment and accessories. In the event of a conflict, accessory locations take precedence.

D. Use of joints between plumbing fixtures/accessories and dissimilar materials w/seam(s) (e.g. between sinks and countertops, toilet fixtures and accessories to wall, etc.) is not permitted.

E. Equipment numbers noted on enlarged plans refer to Cabinet component numbers, fixtures, accessories, etc. that are defined or elevated on Sheet A8.0 unless specific references are keyed.

F. Dimensions are per B2/A11.3.1 (General Notes).

G. For vertical mounting heights of shower accessories, See Detail D6/A11.7.

H. For vertical mounting heights of toilet stall accessories, See Detail A4/A11.7.

I. For vertical mounting heights of accessible toilet stall accessories, See Detail A5/A11.7.

J. For vertical mounting heights of typical restroom accessories, See Detail B6/A11.7.

K. For vertical mounting heights of accessible accessible restrooms, See Detail A6/A11.7.

L. For equipment not identified on plan, use Equipment drawings and workbooks-including: Vol. 2.

M. For partial enlarged plan at junior closets, See Detail A2/A11.7.

N. Public/handroom restroom graphics will be furnished and installed by the Owner's graphics supplier.

O. Standard equipment wall mounting heights, see detail A2/A11.9.

P. Equipment wall mounting heights, see details A4/A11.9, A3/A11.9 & A5/A11.9.

Q. 00-02-inches FF=

R. Fire Protection equipment Wall Mounting Heights, see detail D2/A11.9.

S. Communication equipment Wall Mounting Heights, see detail A3/A11.9.

T. Equipment mounting heights at restrooms, see detail A4/A11.9.

U. Equipment mounting heights at Desktop= see detail A4/A11.9.

V. A minimum head clearance of 6'-0" must be maintained at all points in stairways including stair and landing frames.

W. Equipment mounting heights identified, refer to EQ drawing series-Increment #7 Vol. 2E and Equipment workbook. Specific Items requiring structural support are cross referenced into detail Vols. 2E and 2F mounting heights on the Equipment drawings-Increment #7, Vol. 2E.


X. All elevator host way entrance frames to have an embossed stainless steel graphic logo with the floor number and Standard Building logo.

Y. Conforms to governing Accessibility codes and standards.

Z. See landing restrooms for glass entrance frame landing numbers 12" high adjacent to the door at 5'-0" in a contrasting color to the scheduled wall unless a graphic plaque is specifically detailed or noted.

AA. Elevator Equipment wall mounting heights, see detail A4/A11.9.

AB. 2 Doors, Meters, Sidelites and Windows (See Door Schedule). See A11 sheet series.

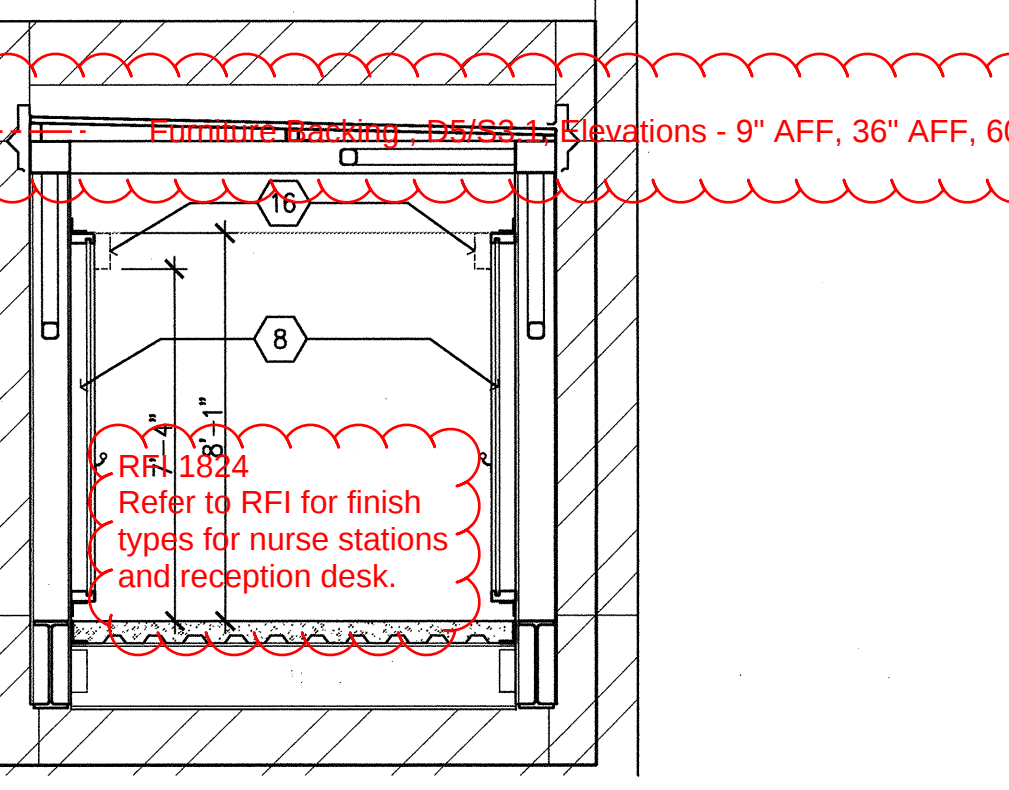

Finishing Face of Panel

Elevations - 9" AFF, 36" AFF, 60" AFF

16"

8"

2 RR 1824

Refer to RFI for finish types for nurse stations and reception desk.

RFI 2284  
Panel 5' x 10' 6" x 1 1/2" for KEYNOTES  
AFF & 14"x14"

### ① KEY PLAN

RFI 2224  
Panel chair: SEE A6/A3.2E FOR KEYNOTE!

AREA "F"  
 $\frac{1}{4} = 1 - 0$

①6 NOTES TO SHEET

Ⓐ GENERAL NOTES

### ① KEY PLAN

### A3.5F