


FKP Architects

ARCHITECT OF RECORD
Paul C. Gloriot

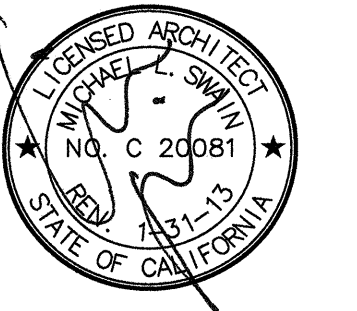


Changes on these drawings do not consist of
materially altered changes to approved drawings
and do not require a change order.
OSHPD review ACO
OSHPD review FLSO
OSHPD review DSE

REVISIONS

08/08/11 CO #135

APPROVAL

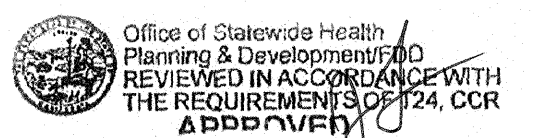

CHANGE ORDER 135
INSTRUCTION BULLETIN
DEFERRED APPROVAL
DO NOT SIGN

PROJECT NAME
**CHILDREN'S HOSPITAL
OF ORANGE COUNTY**
455 S. Main St.
Orange, CA 92668-3874

TOWER II RECEIVED
SEPT. 21 2011
McCARTHY



PROJECT NUMBER

12011.00
Increment #7

OSHPD - PROJECT NUMBER
IL 072072-30

ISSUE
OSHPD PERMIT

DATE
01/27/2010

SCALE

1/4" = 1' - 0"
DRAWING TITLE

LEVEL 2 REFLECTIVE
CEILING PLAN - AREA P

DRAWING NUMBER

A4.2P
CO # 135

1. INSTALL CEILING TO ALIGN WITH EXISTING SYSTEM.
2. MODIFY CEILING AS REQUIRED TO RECEIVE NEW DOOR HEADER.
3. EXISTING CEILING TO REMAIN.


D1 KEYED NOTES TO SHEET

- A. REFER TO "FINISH SCHEDULE" FOR FURTHER DEFINITION OF CEILING MATERIALS AND FINISHES.
B. CEILING HEIGHT WILL TYPICALLY BE [9'-0"] UNLESS OTHERWISE NOTED ON THE REFLECTED CEILING PLAN.
C. LOCATE ALL CEILING MOUNTED SMOKE DETECTORS AND SPEAKERS IN THE CENTER OF FULL PANELS AT LAY-IN CEILINGS.
D. LOCATE ALL SPRINKLER HEADS IN THE CENTER OF FULL PANELS AT LAY-IN CEILINGS. AT GYPSUM BOARD CEILINGS, SYMMETRICALLY SPACE HEADS AND CENTER ON LIGHT ROWS WHERE AREA LIMITATIONS PERMIT.
E. REFER TO MEP DOCUMENTS FOR LOCATIONS OF CEILING ACCESS PANELS. UNLESS NOTED OR DETAILED OTHERWISE ACCESS PANELS IN TOILETS AND BACK OF HOUSE SPACES WITH DRYWALL OR PLASTER CEILINGS ARE TO BE PAINTED METAL. PLASTER OR DRYWALL CEILINGS WITH ACCESS PANELS IN AUTOPSY AND BODY HOLDING AREAS ARE TO BE STAINLESS STEEL.
F. FOR SEISMIC BRACING AND ANCHORAGE REQUIREMENTS FOR SUSPENDED GYPSUM BOARD CEILINGS SEE SHEET A11.10.1.
G. FOR SEISMIC BRACING AND ANCHORAGE REQUIREMENTS FOR SUSPENDED GYPSUM BOARD CEILINGS SEE SHEET A11.10.1.
H. GYPSUM BOARD FURROWED HEADERS WILL NOT BE LOWER THAN 8' A.F.F.
I. ALL CEILING MOUNTED ITEMS WITH EQUIPMENT TAGS IDENTIFIED ON EQUIPMENT SERIES SHEETS ARE CROSSED REFERENCE TO STRUCTURAL SUPPORT DETAILS VIA MATRIX SHOWN ON EQUIPMENT DRAWINGS.
J. FOR ALL LAY IN CEILING PANELS ARRANGE CEILINGS TO NOT HAVE LESS THAN 1/2" CEILING TILE UNLESS OTHERWISE NOTED.
K. PROVIDE 2" WIDE TRIM AT ALL PERIMETER OF ACOUSTICAL CEILING GRID SYSTEM TO MEET SEISMIC REQUIREMENTS.
L. IN THE EVENT OF A CONFLICT BETWEEN REFLECTED CEILING PLANS AND FINISH SCHEDULES, THE REQUIREMENTS OF TABLE 1224.1 CBC 2007 PART 2 SHALL GOVERN.


C1 GENERAL NOTES

- NOT IN CONTRACT
- 2' x 2' SUSPENDED ACOUSTICAL TILE
- GYPSUM BOARD CEILING
- 2' x 4' FLUORESCENT LIGHT FIXTURE PARABOLIC
- 2' x 4' FLUORESCENT LIGHT FIXTURE PRISMATIC
- 2' x 4' FLUORESCENT LIGHT FIXTURE DIRECT / INDIRECT
- RECESSED FLUORESCENT LIGHT FIXTURE
- SQUARE MECHANICAL GRILLS
- RECESSED DOWNLIGHT


B1 LEGEND

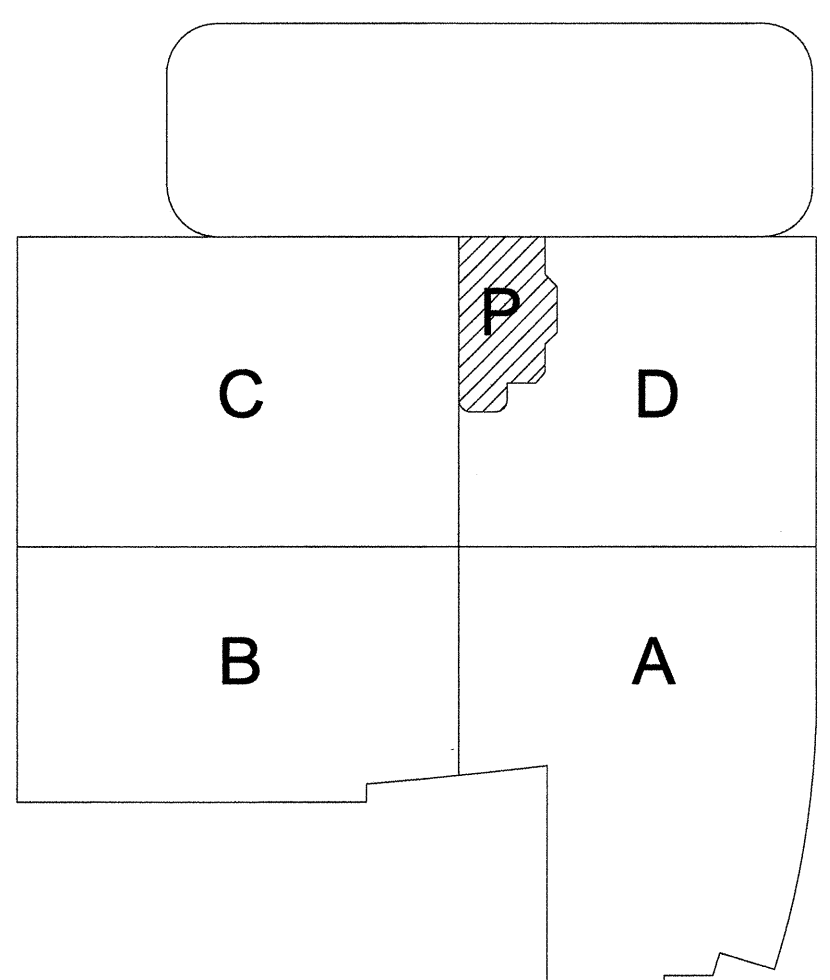

A1 KEY PLAN

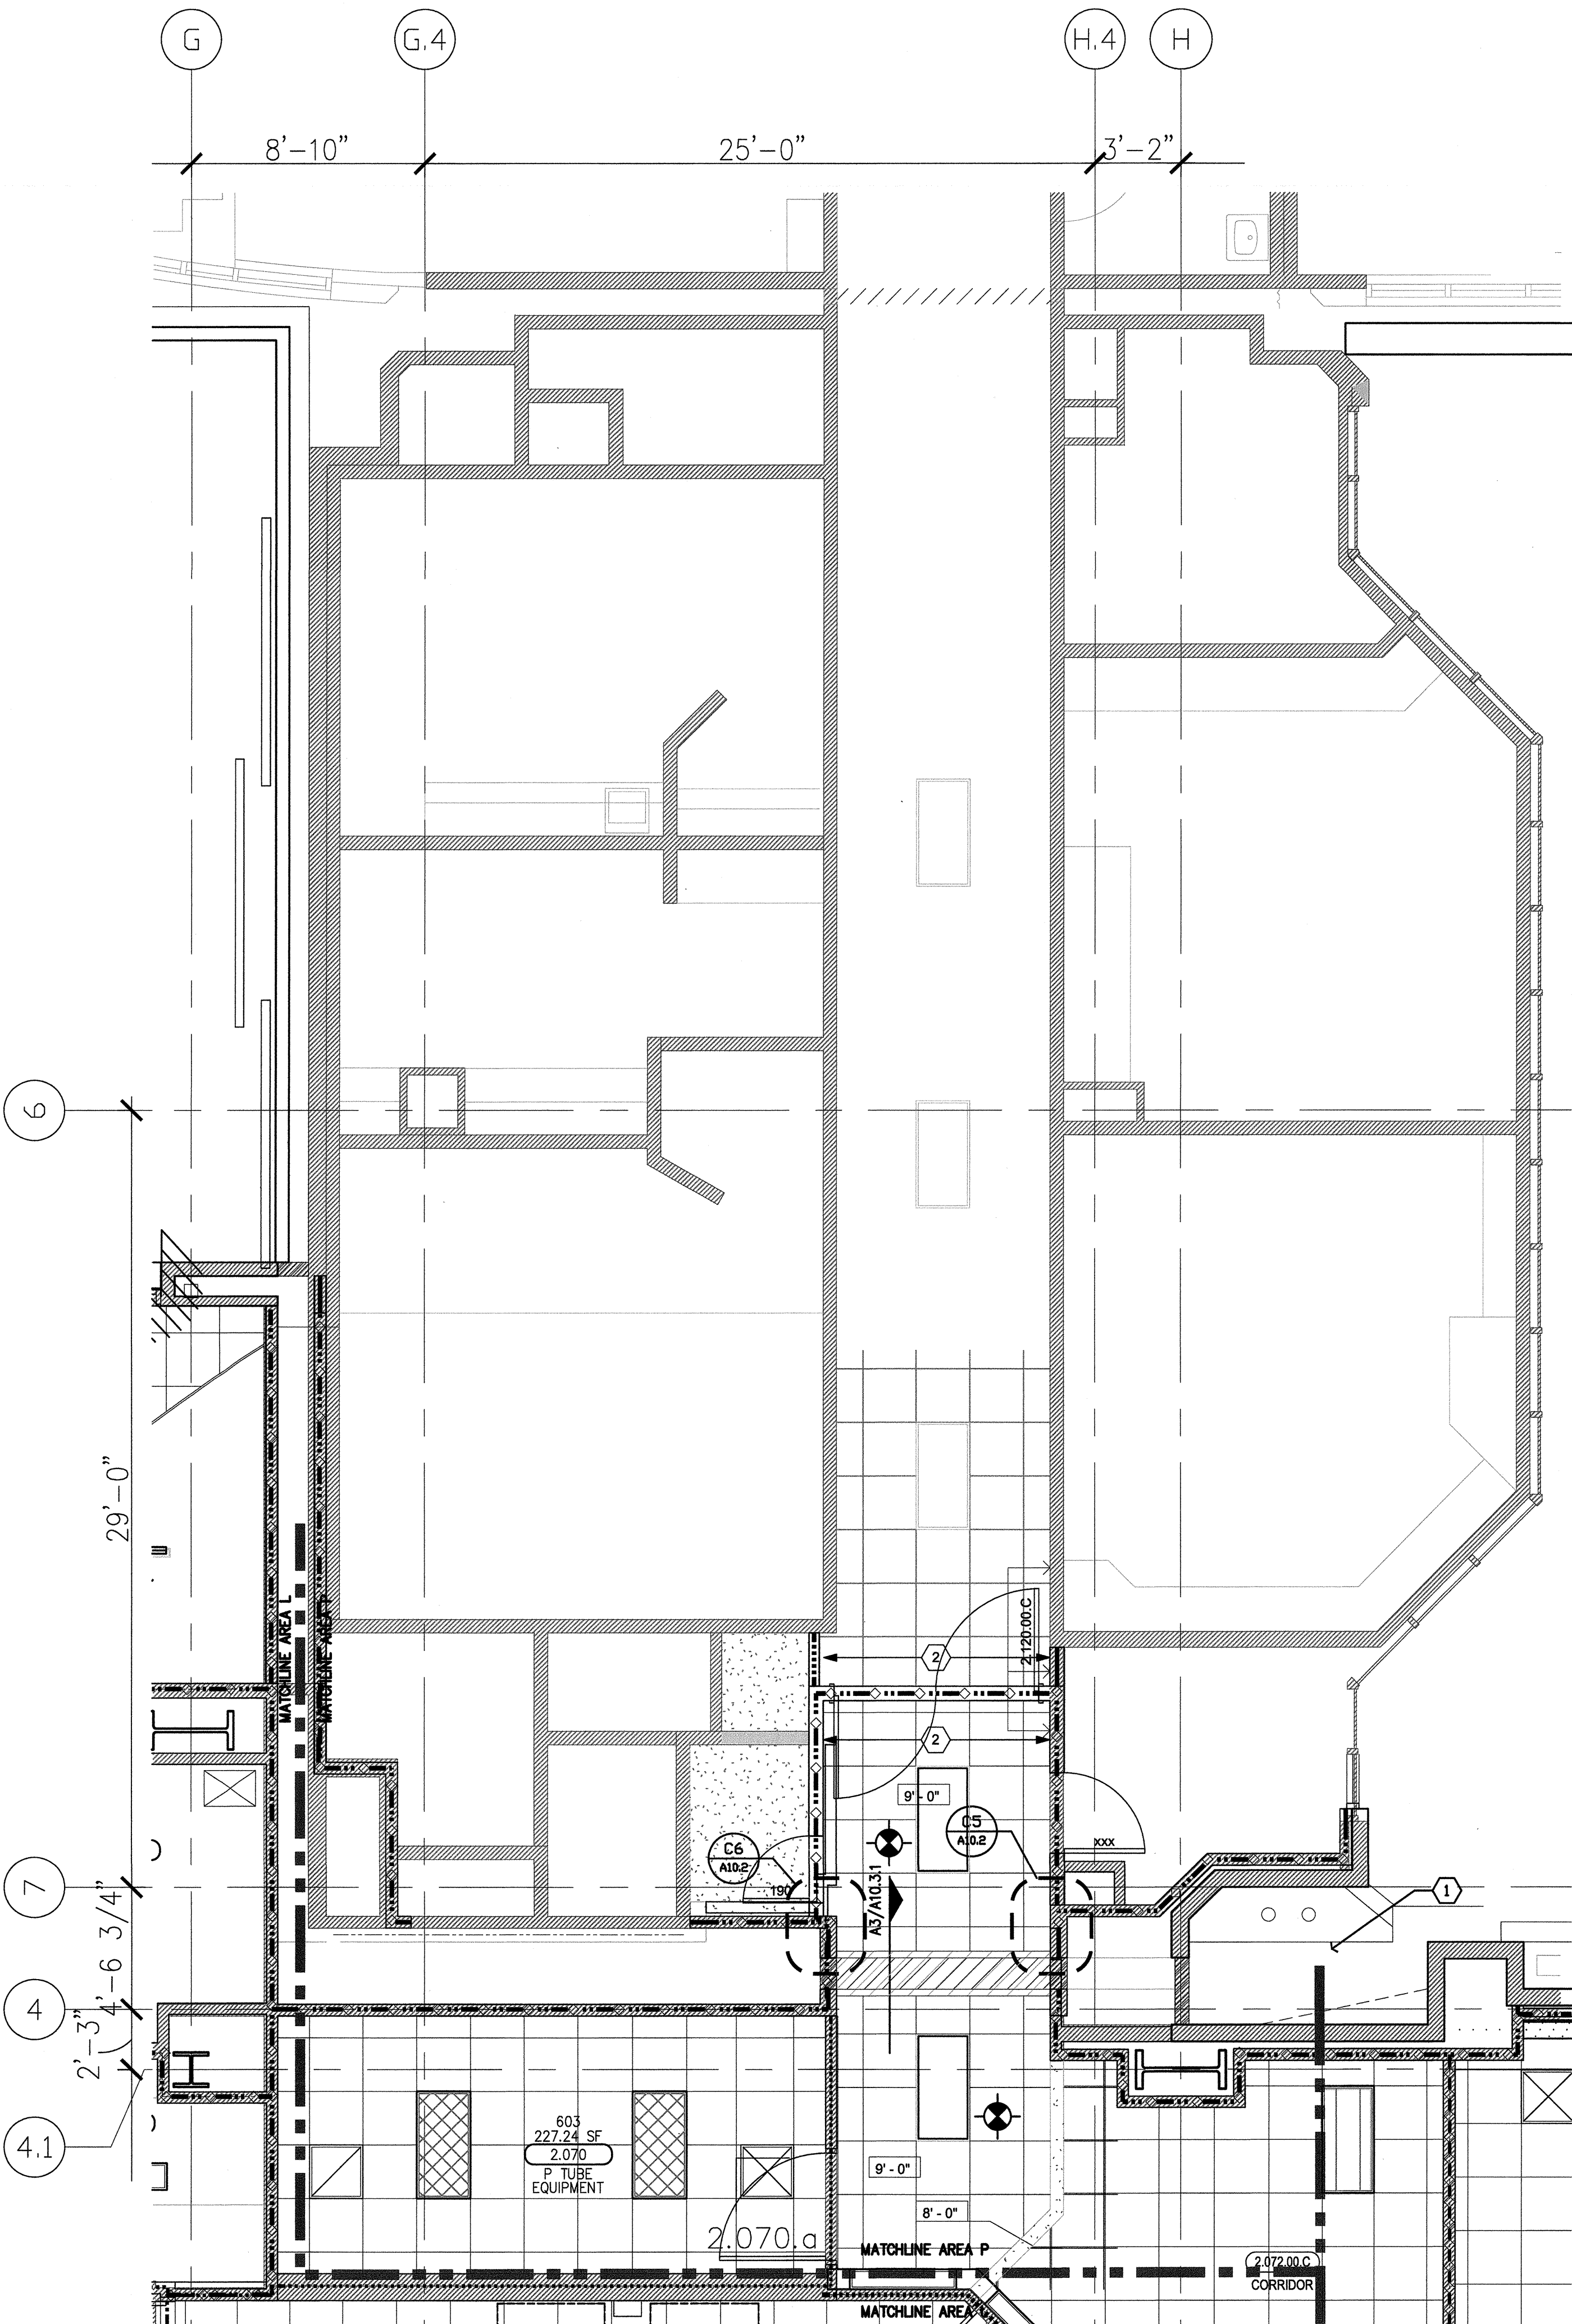

A6 LEVEL 2 - PHASE I

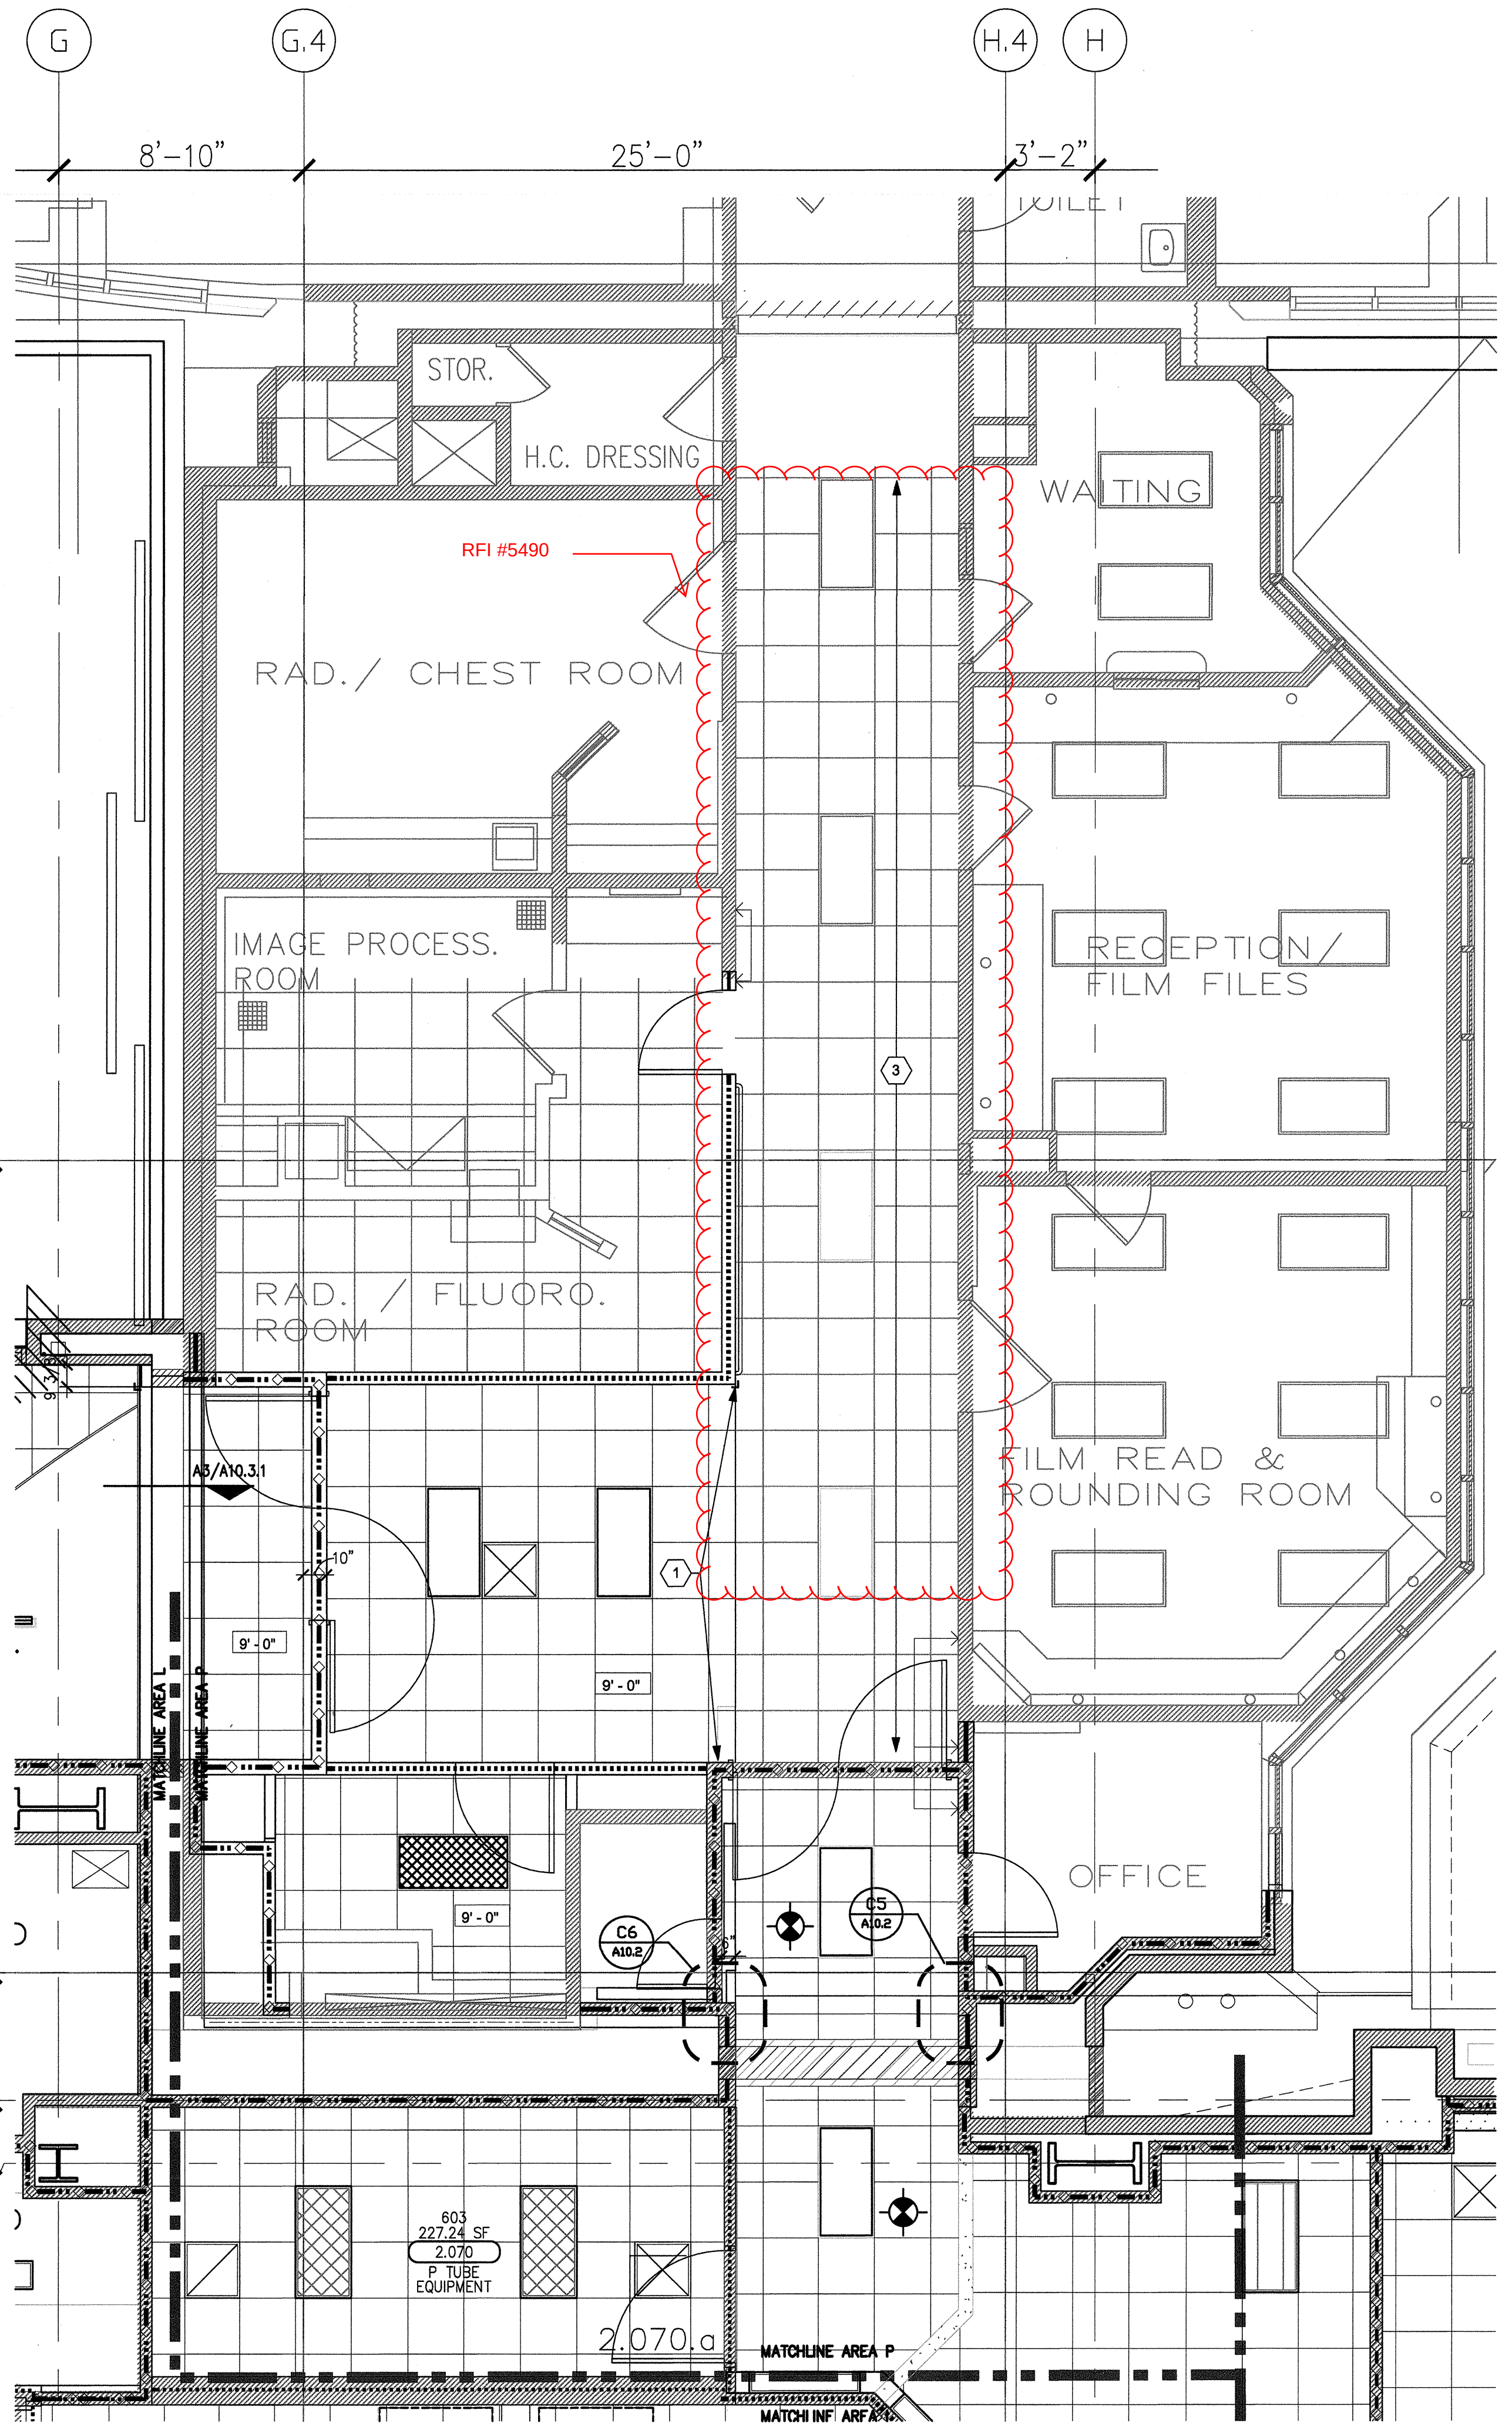

A4 LEVEL 2 - PHASE II