


ARCHITECT OF RECORD
Paul C. Gloriod

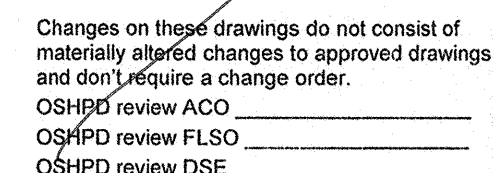

162 08/08/11 CO #135

Office of Statewide Health
Planning & Development/FDO
REVIEWED IN ACCORDANCE WITH
THE REQUIREMENTS OF T24, CO
APPROVED

CHANGE ORDER# 135
INSTRUCTION BULLETIN# _____
DEFERRED APPROVAL# _____
ADDENDUM _____

455 S. Main St.
Orange, CA 92868-3874

TOWER II RECEIVED
SEPT. 21 2011
McCARTHY



12011.00
Increment #7

OSHPD - PROJECT NUMBER
IL 072072-30

ISSUE
OSHDPD PERMIT

DATE 01/27/2010

SCALE _____


$$1/16" = 1'-0"$$

DRAWING TITLE


LEVEL 3 REFLECTED
CEILING PLAN

1425

A4.31

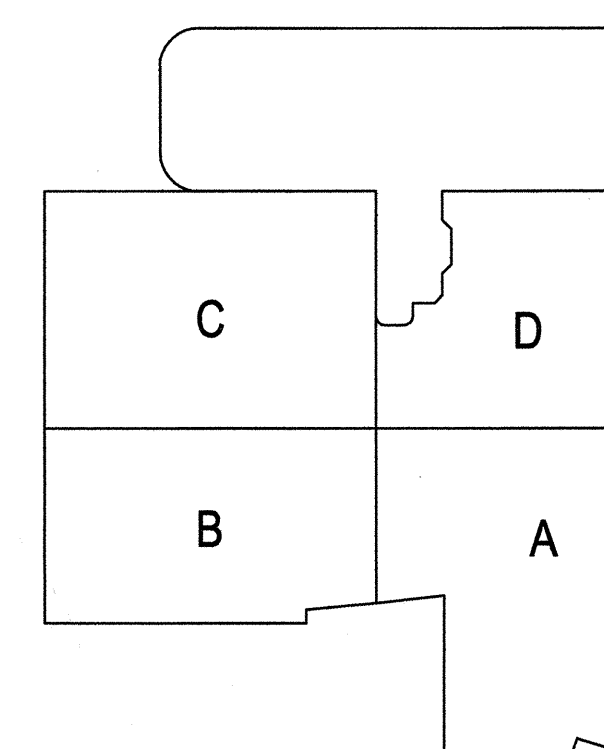

A1 KEY PLAN

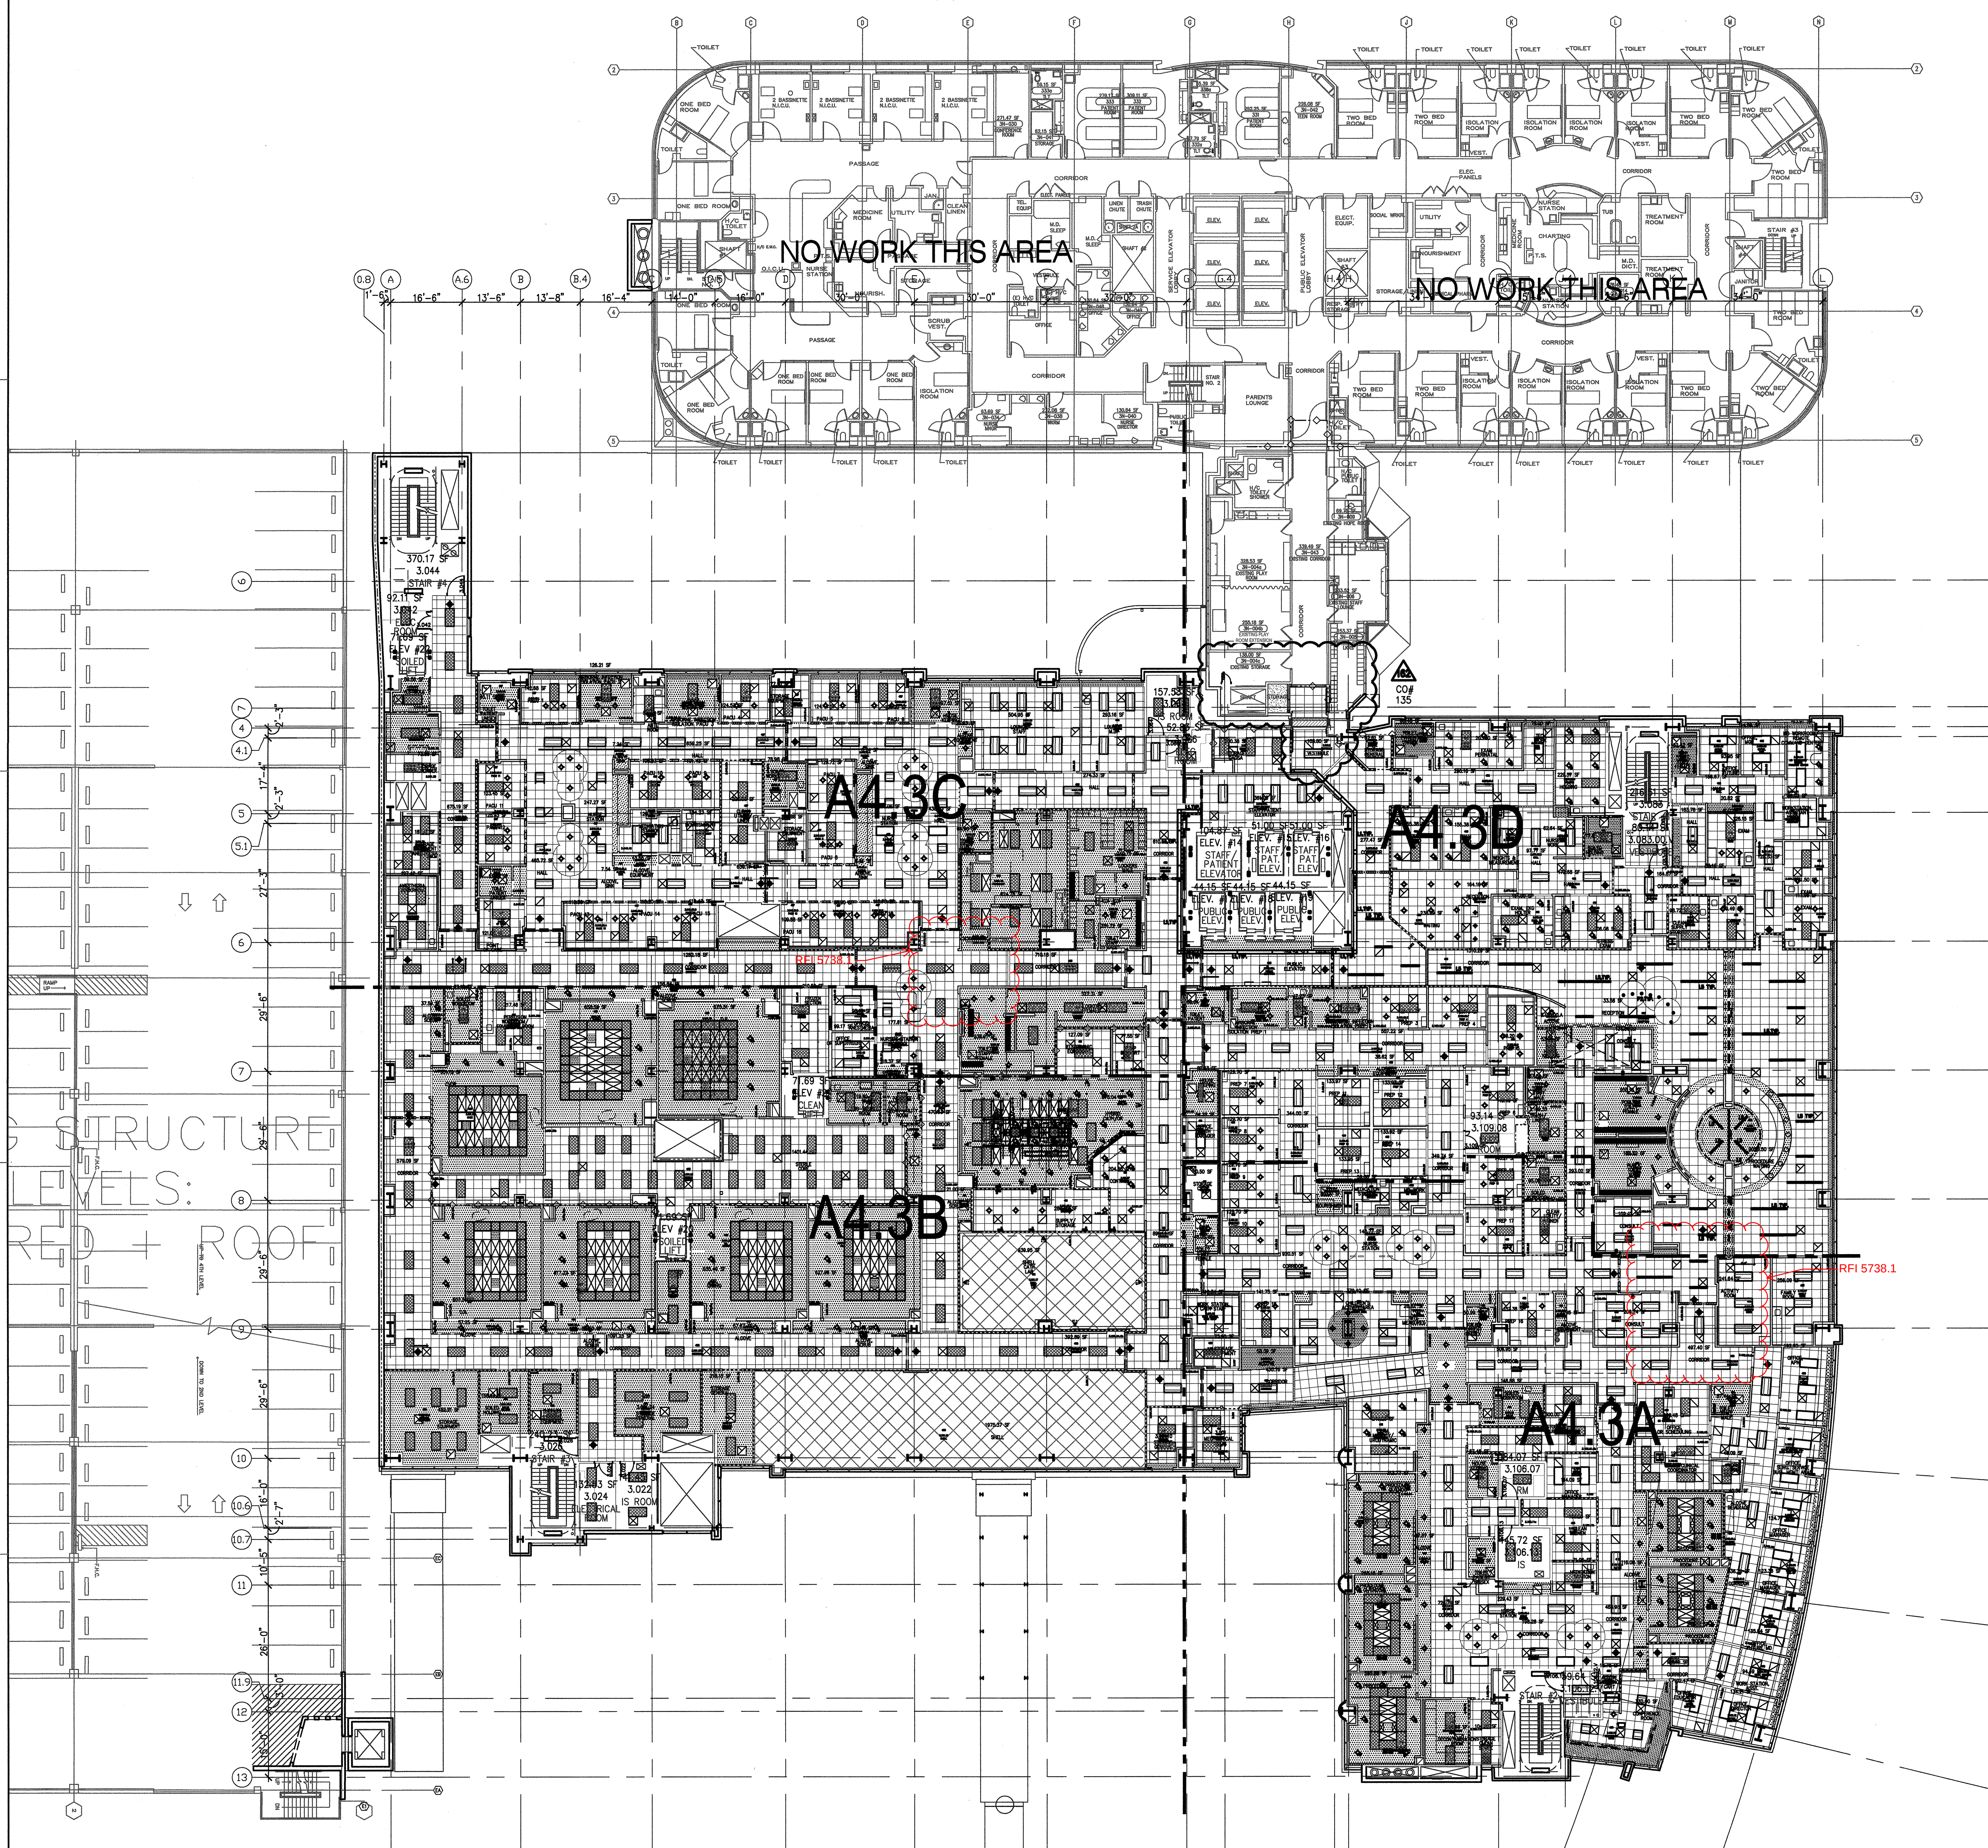

A6 **LEVEL 3**
1/16" = 1'-0"