


FKP Architects

ARCHITECT OF RECORD


Paul C. Gloriot

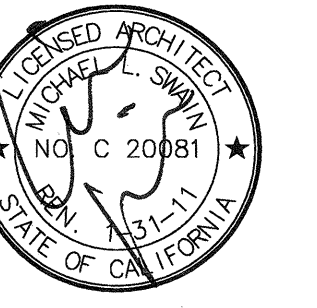

REVISIONS

NO.	DATE	DESCRIPTION
1	02/05/10	INFORMATION BULLETIN #5
2	05/27/10	CHANGE ORDER #14

APPROVAL

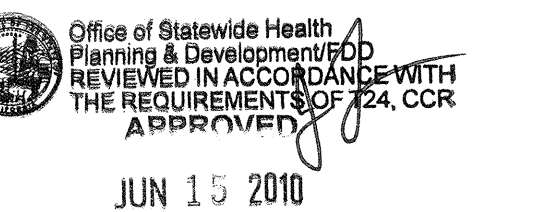

CHANGE ORDER #14
INSTRUCTION BULLETIN
DEFERRED APPROVAL
PROJECT NAME

CHILDREN'S HOSPITAL
OF ORANGE COUNTY

455 S. Main St.
Orange, CA 92668-3874

TOWER II



PROJECT NUMBER

12011.00
Increment #7

OSHPD - PROJECT NUMBER
IL 072072-30

ISSUE
OSHPD PERMIT

DATE

01/27/2010

SCALE


1/8" = 1' - 0"

DRAWING TITLE

LEVEL 3
REFLECTED CEILING PLAN
AREA - C

DRAWING NUMBER

A4.3C

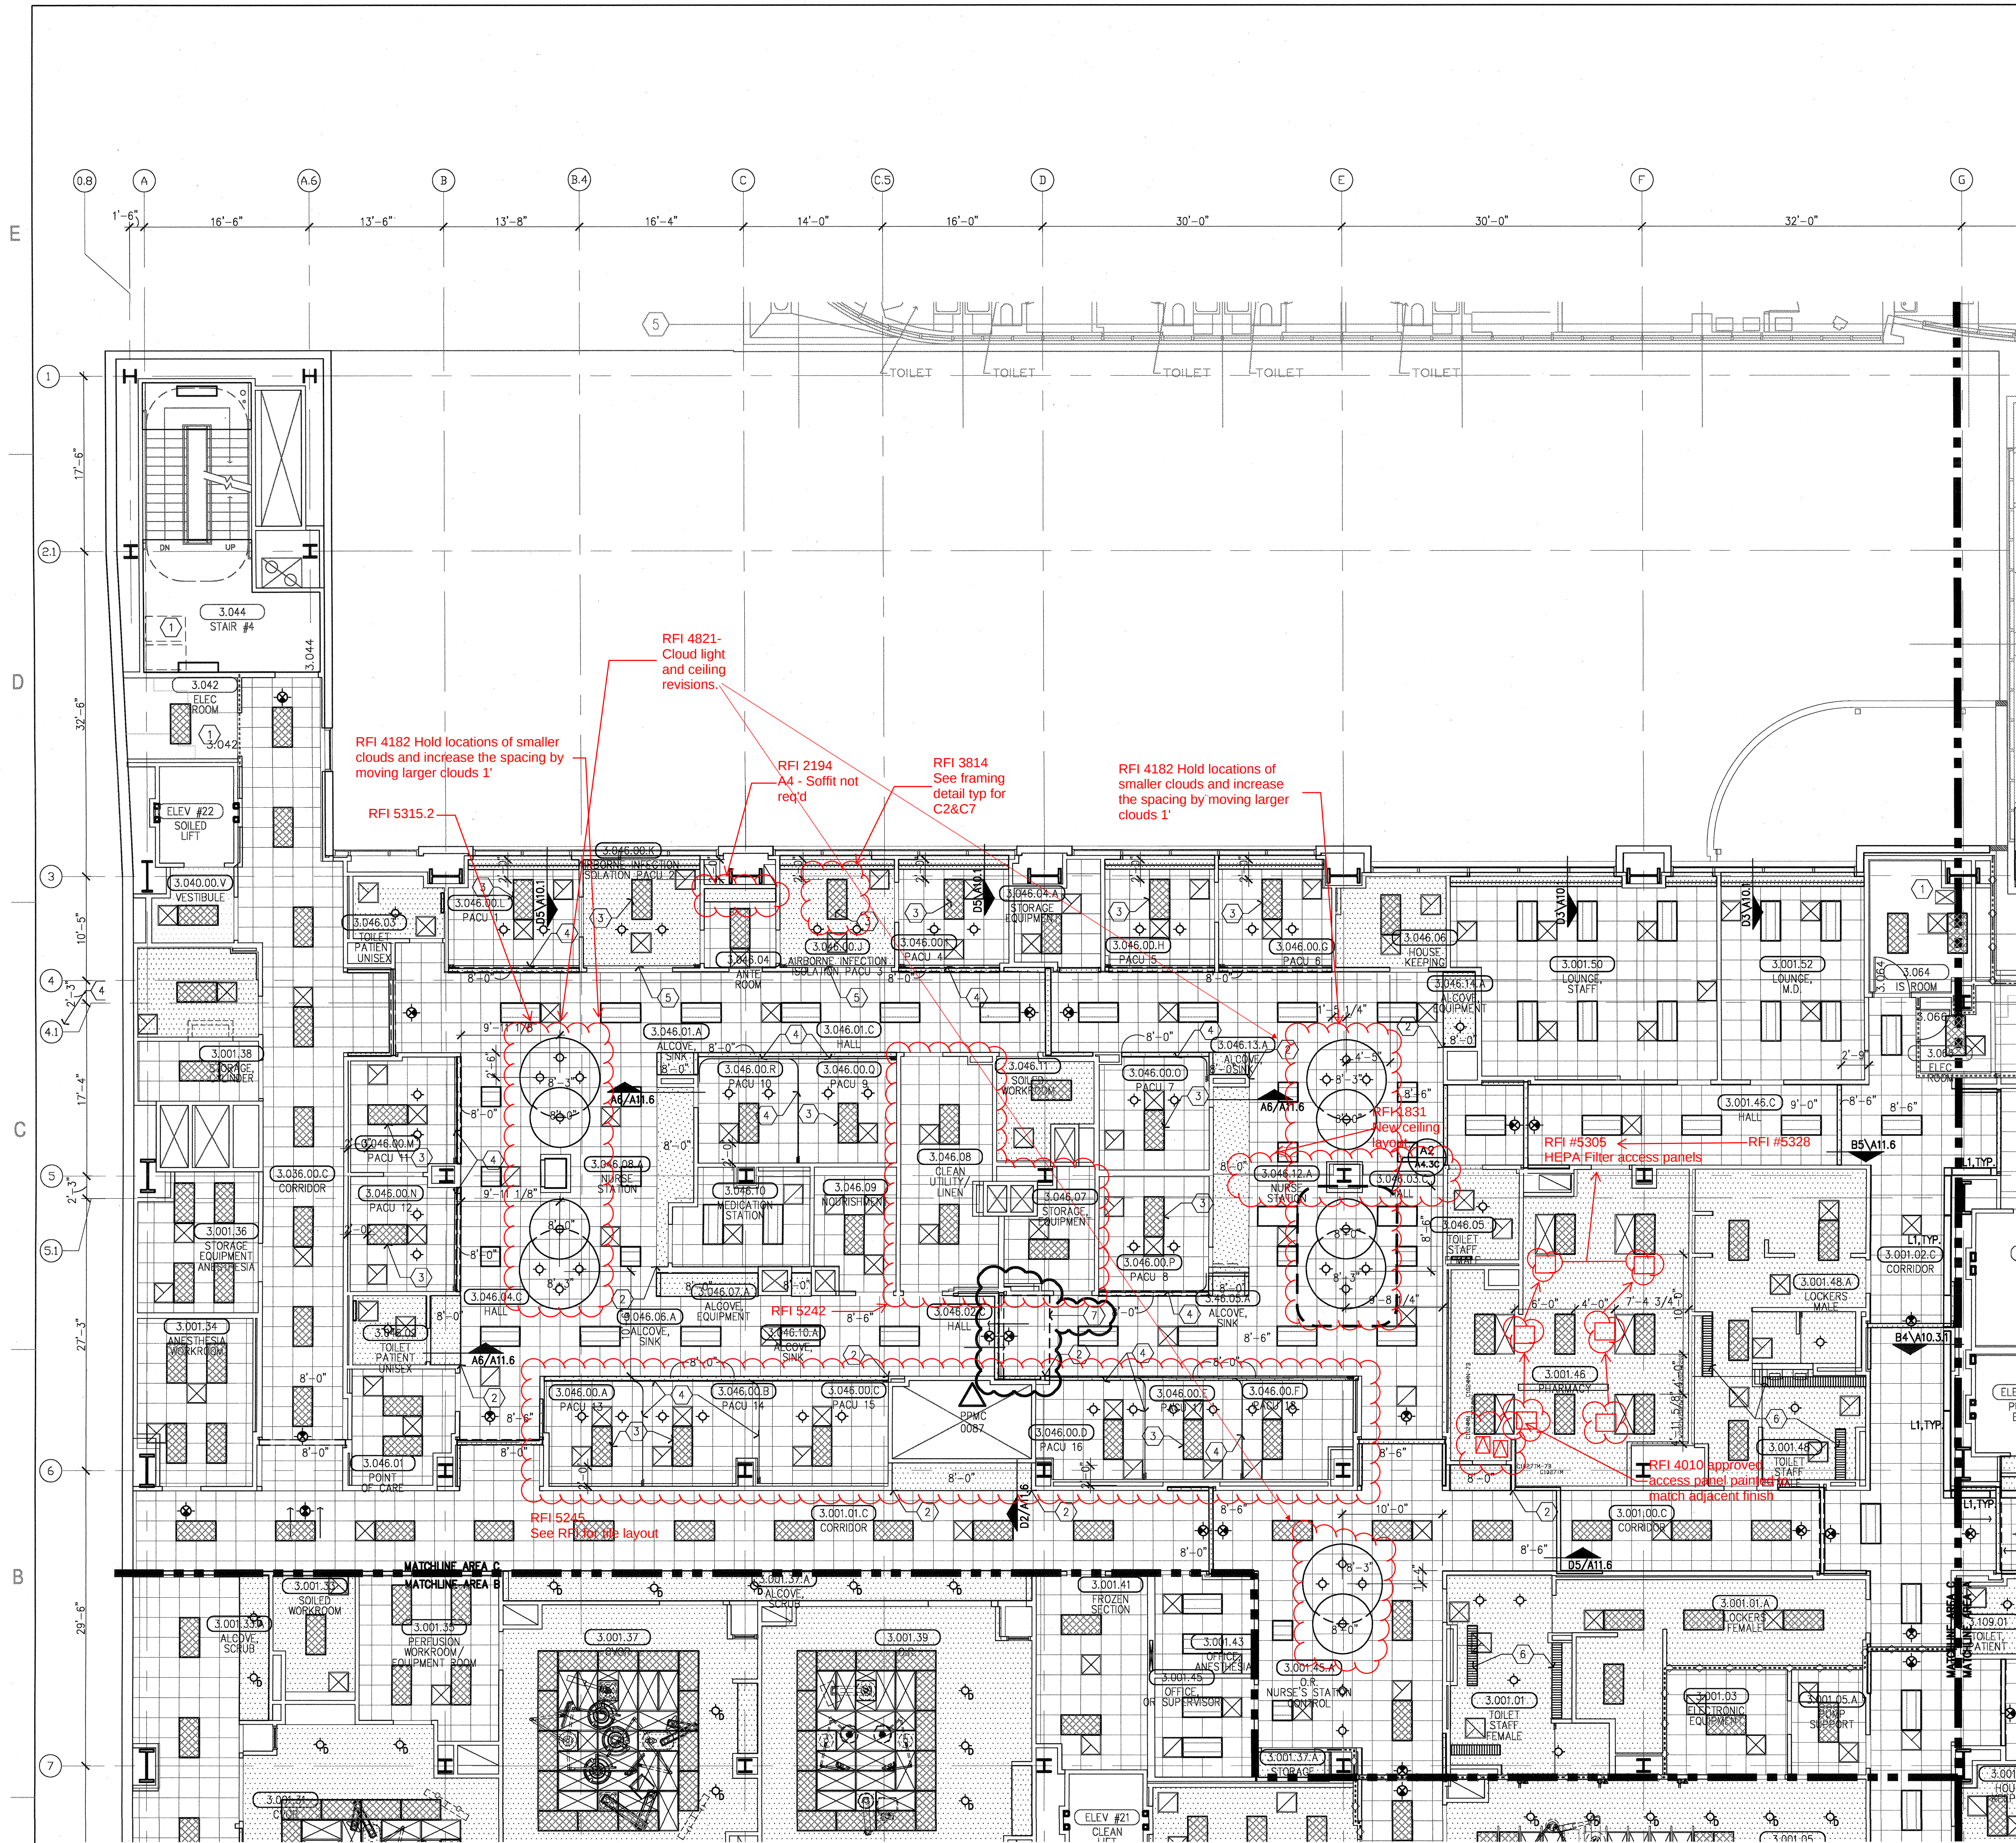


A6 AREA C

- No ceiling, exposed to structure.
- Align finished face of furr-down with finished face of partition.
- Align centerline of fixture with centerline of bed. See plan.
- Ceiling mounted curtain track behind furr-down. See detail D4/A11.8 for track detail and see B5/A11.8 for furr-down.
- Ceiling mounted curtain track, see detail D4/A11.8.
- Light cove, see detail B3/A11.8.
- Shelf enclosure above ceiling, see Section R6/A11.3.1.

A3 Notes To Sheet

A2 Enlarged Plan

A1 KEY PLAN

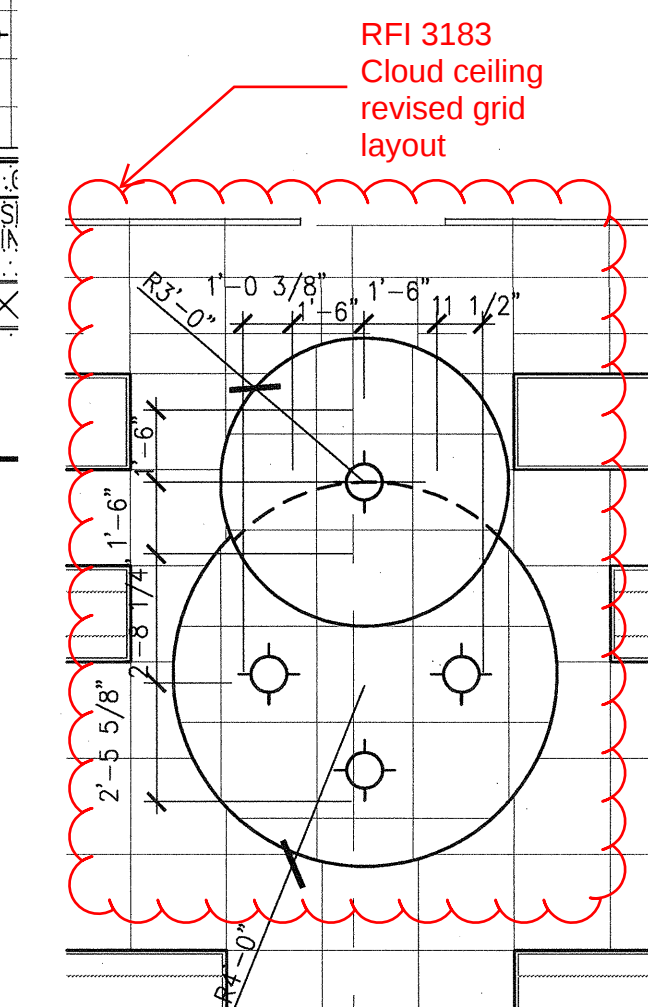

RFI #5471
3rd floor RCP
coordination.

B1 General Notes

RFI #4587
Revised RCP's for Level 3
access panel locations.

