



FKP Architects

ARCHITECT OF RECORD
Paul C. Gloriod

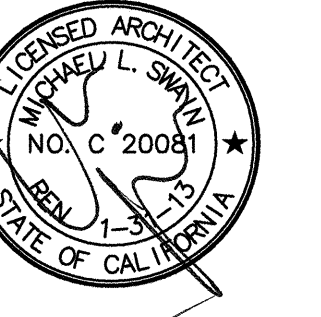

Changes on these drawings do not consist of
materially altered drawings to approved drawings
and don't require a change order.
OSHPD review ACO
OSHPD review FLSO
OSHPD review DSE

REVISIONS
1/16" = 1'-0"
08/08/11 CO #135

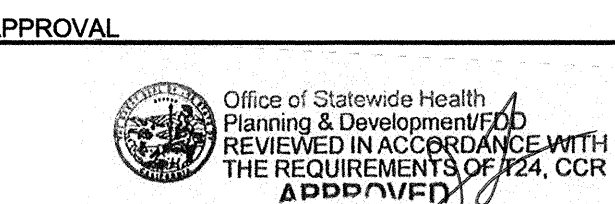

CHANGE ORDER
INSTRUCTION BULLETIN
DEFERRED APPROVAL
ADDENDUM

PROJECT NAME
**CHILDREN'S HOSPITAL
OF ORANGE COUNTY**
455 S. Main St.
Orange, CA 92668-3874

TOWER II RECEIVED
SEPT. 21 2011
McCARTHY



PROJECT NUMBER
**12011.00
Increment #7**

OSHPD - PROJECT NUMBER
IL 072072-30


ISSUE
OSHPD PERMIT

DATE
01/27/2010

SCALE
1/16" = 1'-0"

DRAWING TITLE
**LEVEL 5 REFLECTED
CEILING PLAN**

DRAWING NUMBER
A4.51

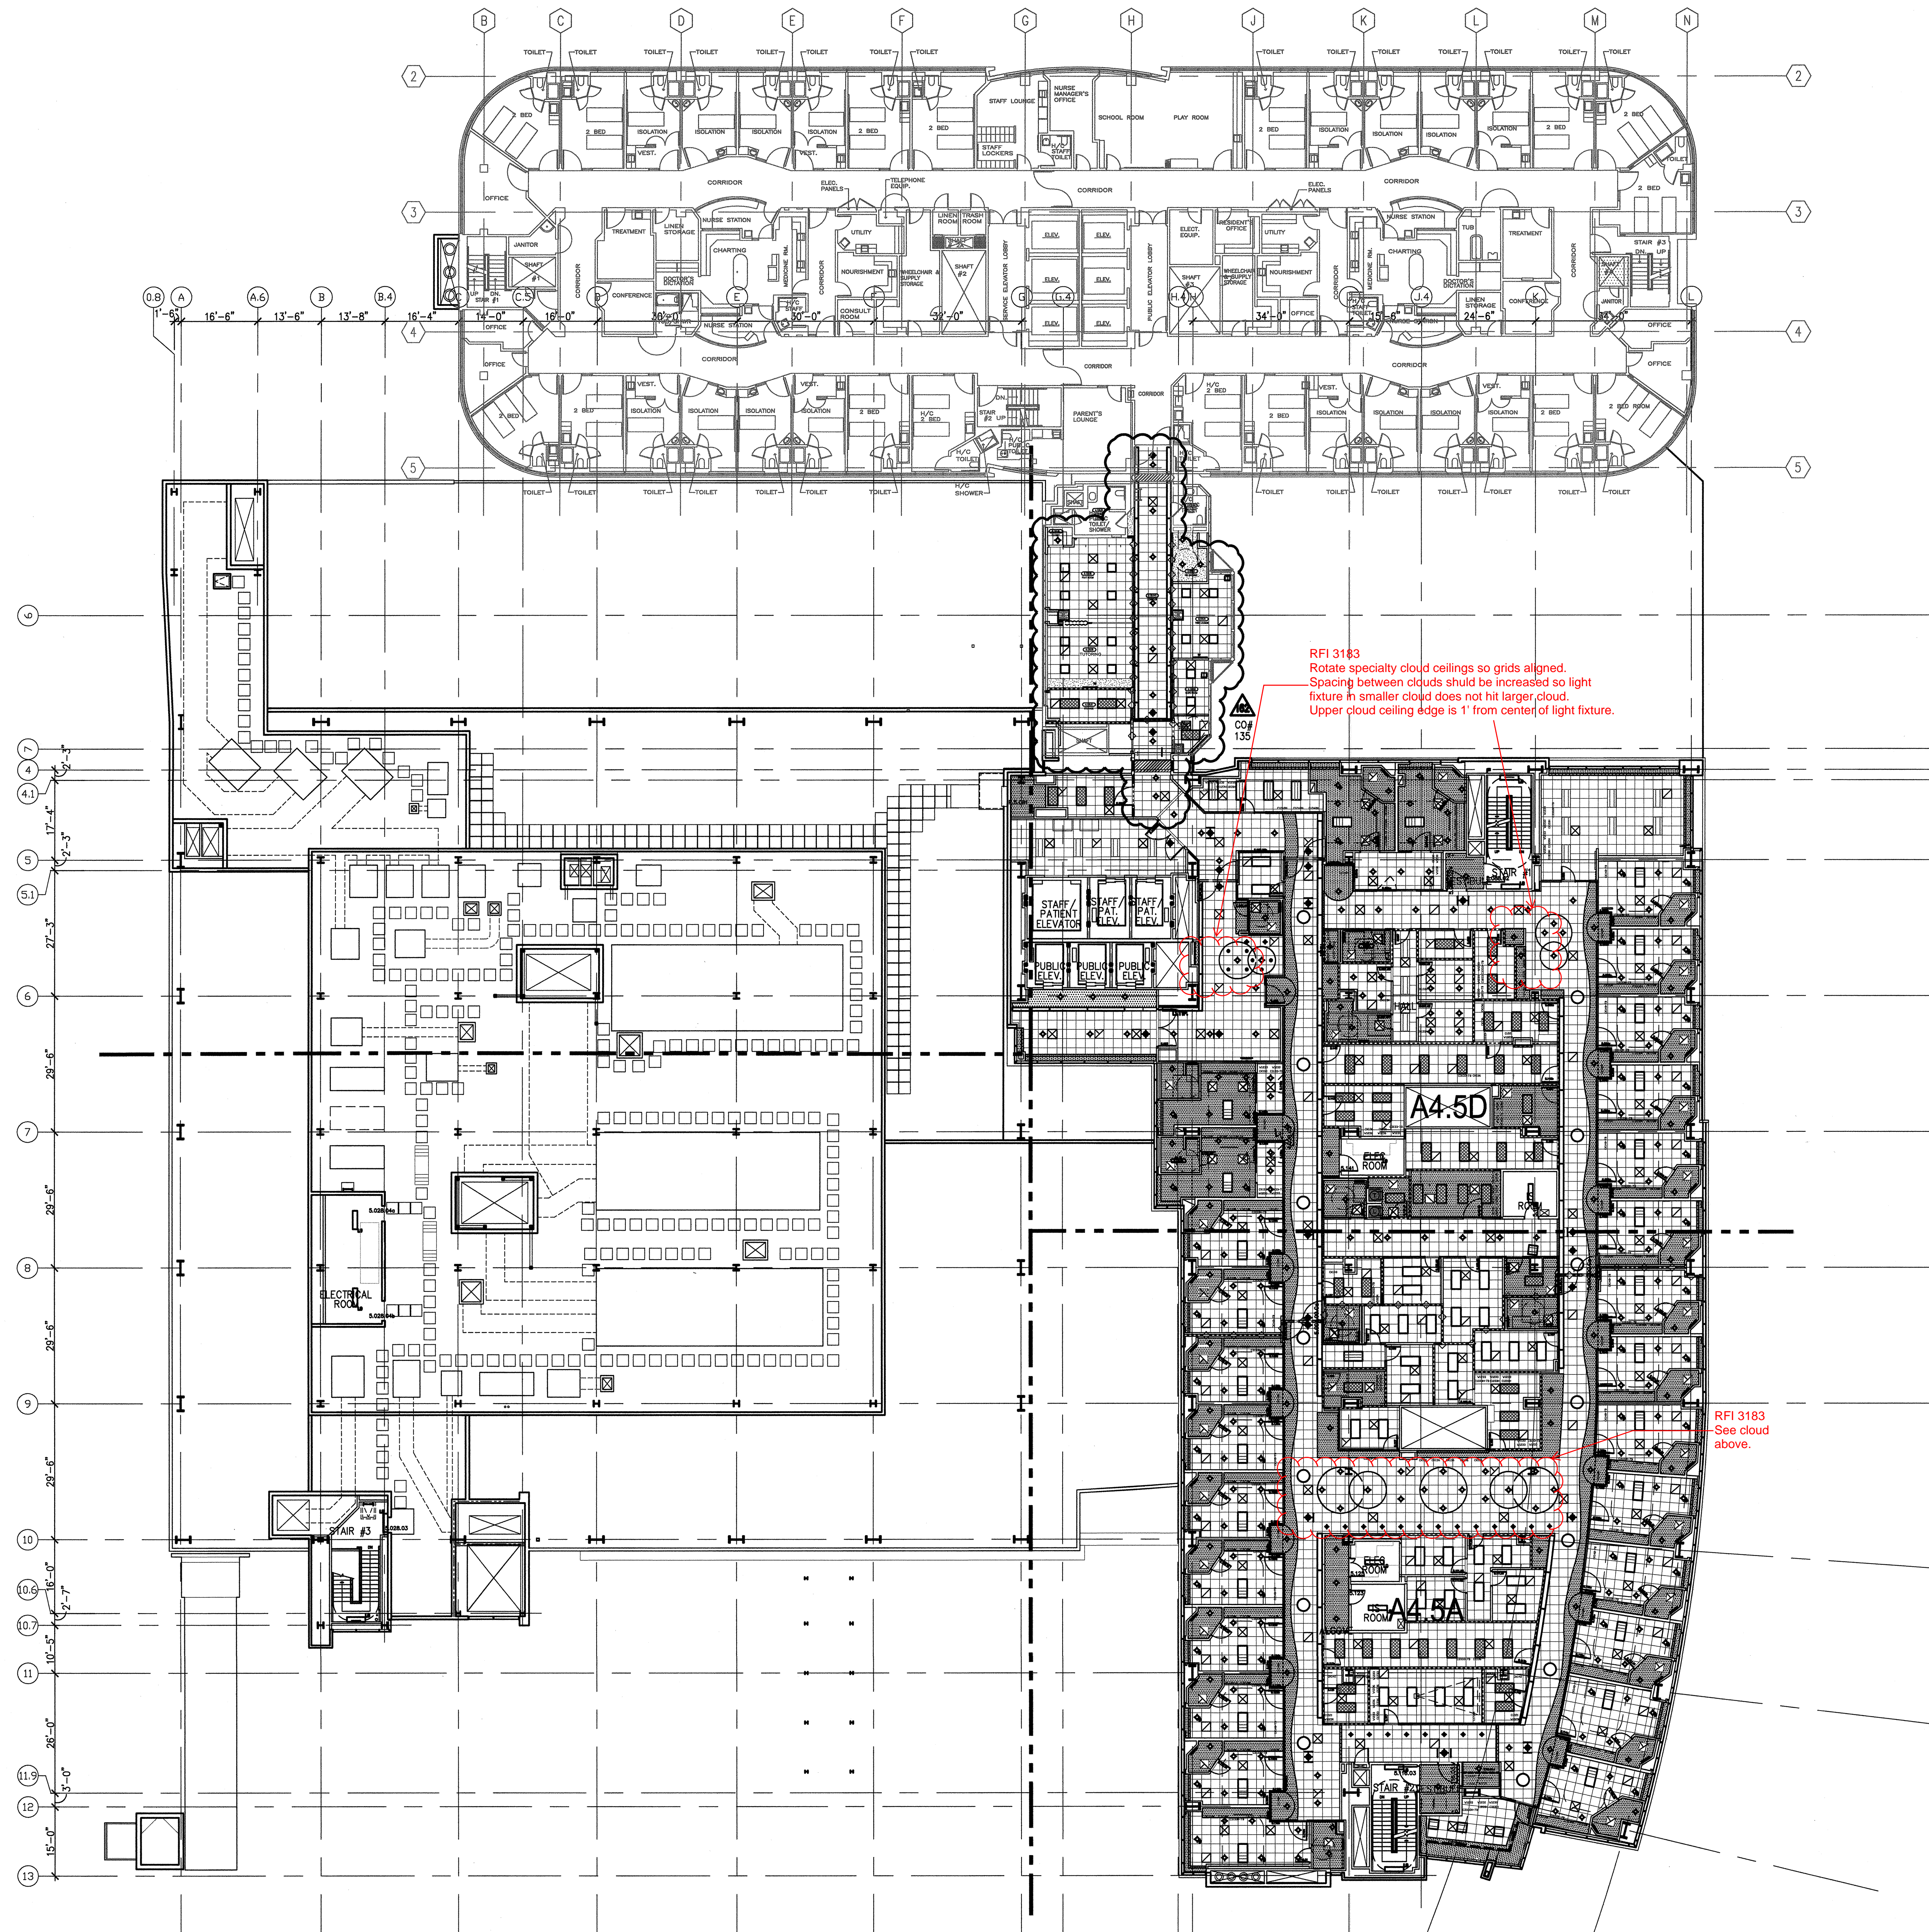

A6 LEVEL 5 - OVERALL
1/16" = 1'-0"