


FKP Architects

ARCHITECT OF RECORD
Paul C. Gloriot

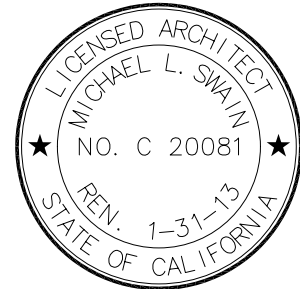


Changes on these drawings do not consist of
materially altered changes to approved drawings
and don't require a change order.
OSHPD review ACO
OSHPD review FLSO
OSHPD review DSE

REVISIONS

	03/01/11	CO #134
	01/09/12	ASH#156
	03/15/12	ASI #188
	04/04/12	ASI #196

APPROVAL

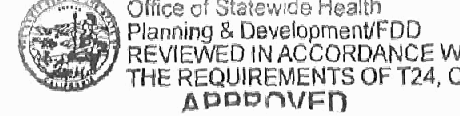

CHANGE ORDER/INSTRUCTION BULLETIN/DEFERRED APPROVAL # _____
(if any)

PROJECT NAME

**CHILDREN'S HOSPITAL
OF ORANGE COUNTY**

455 S. Main St.
Orange, CA 92668-3874

TOWER II



PROJECT NUMBER

**12011.00
Increment #7**

OSHPD - PROJECT NUMBER

IL 072072-30

ISSUE

OSHPD PERMIT

DATE

01/27/2010

SCALE

3/8" = 1'-0"

DRAWING TITLE


**SECOND FLOOR INTERIOR
ELEVATIONS**

DRAWING NUMBER

A9.2D



CO #134

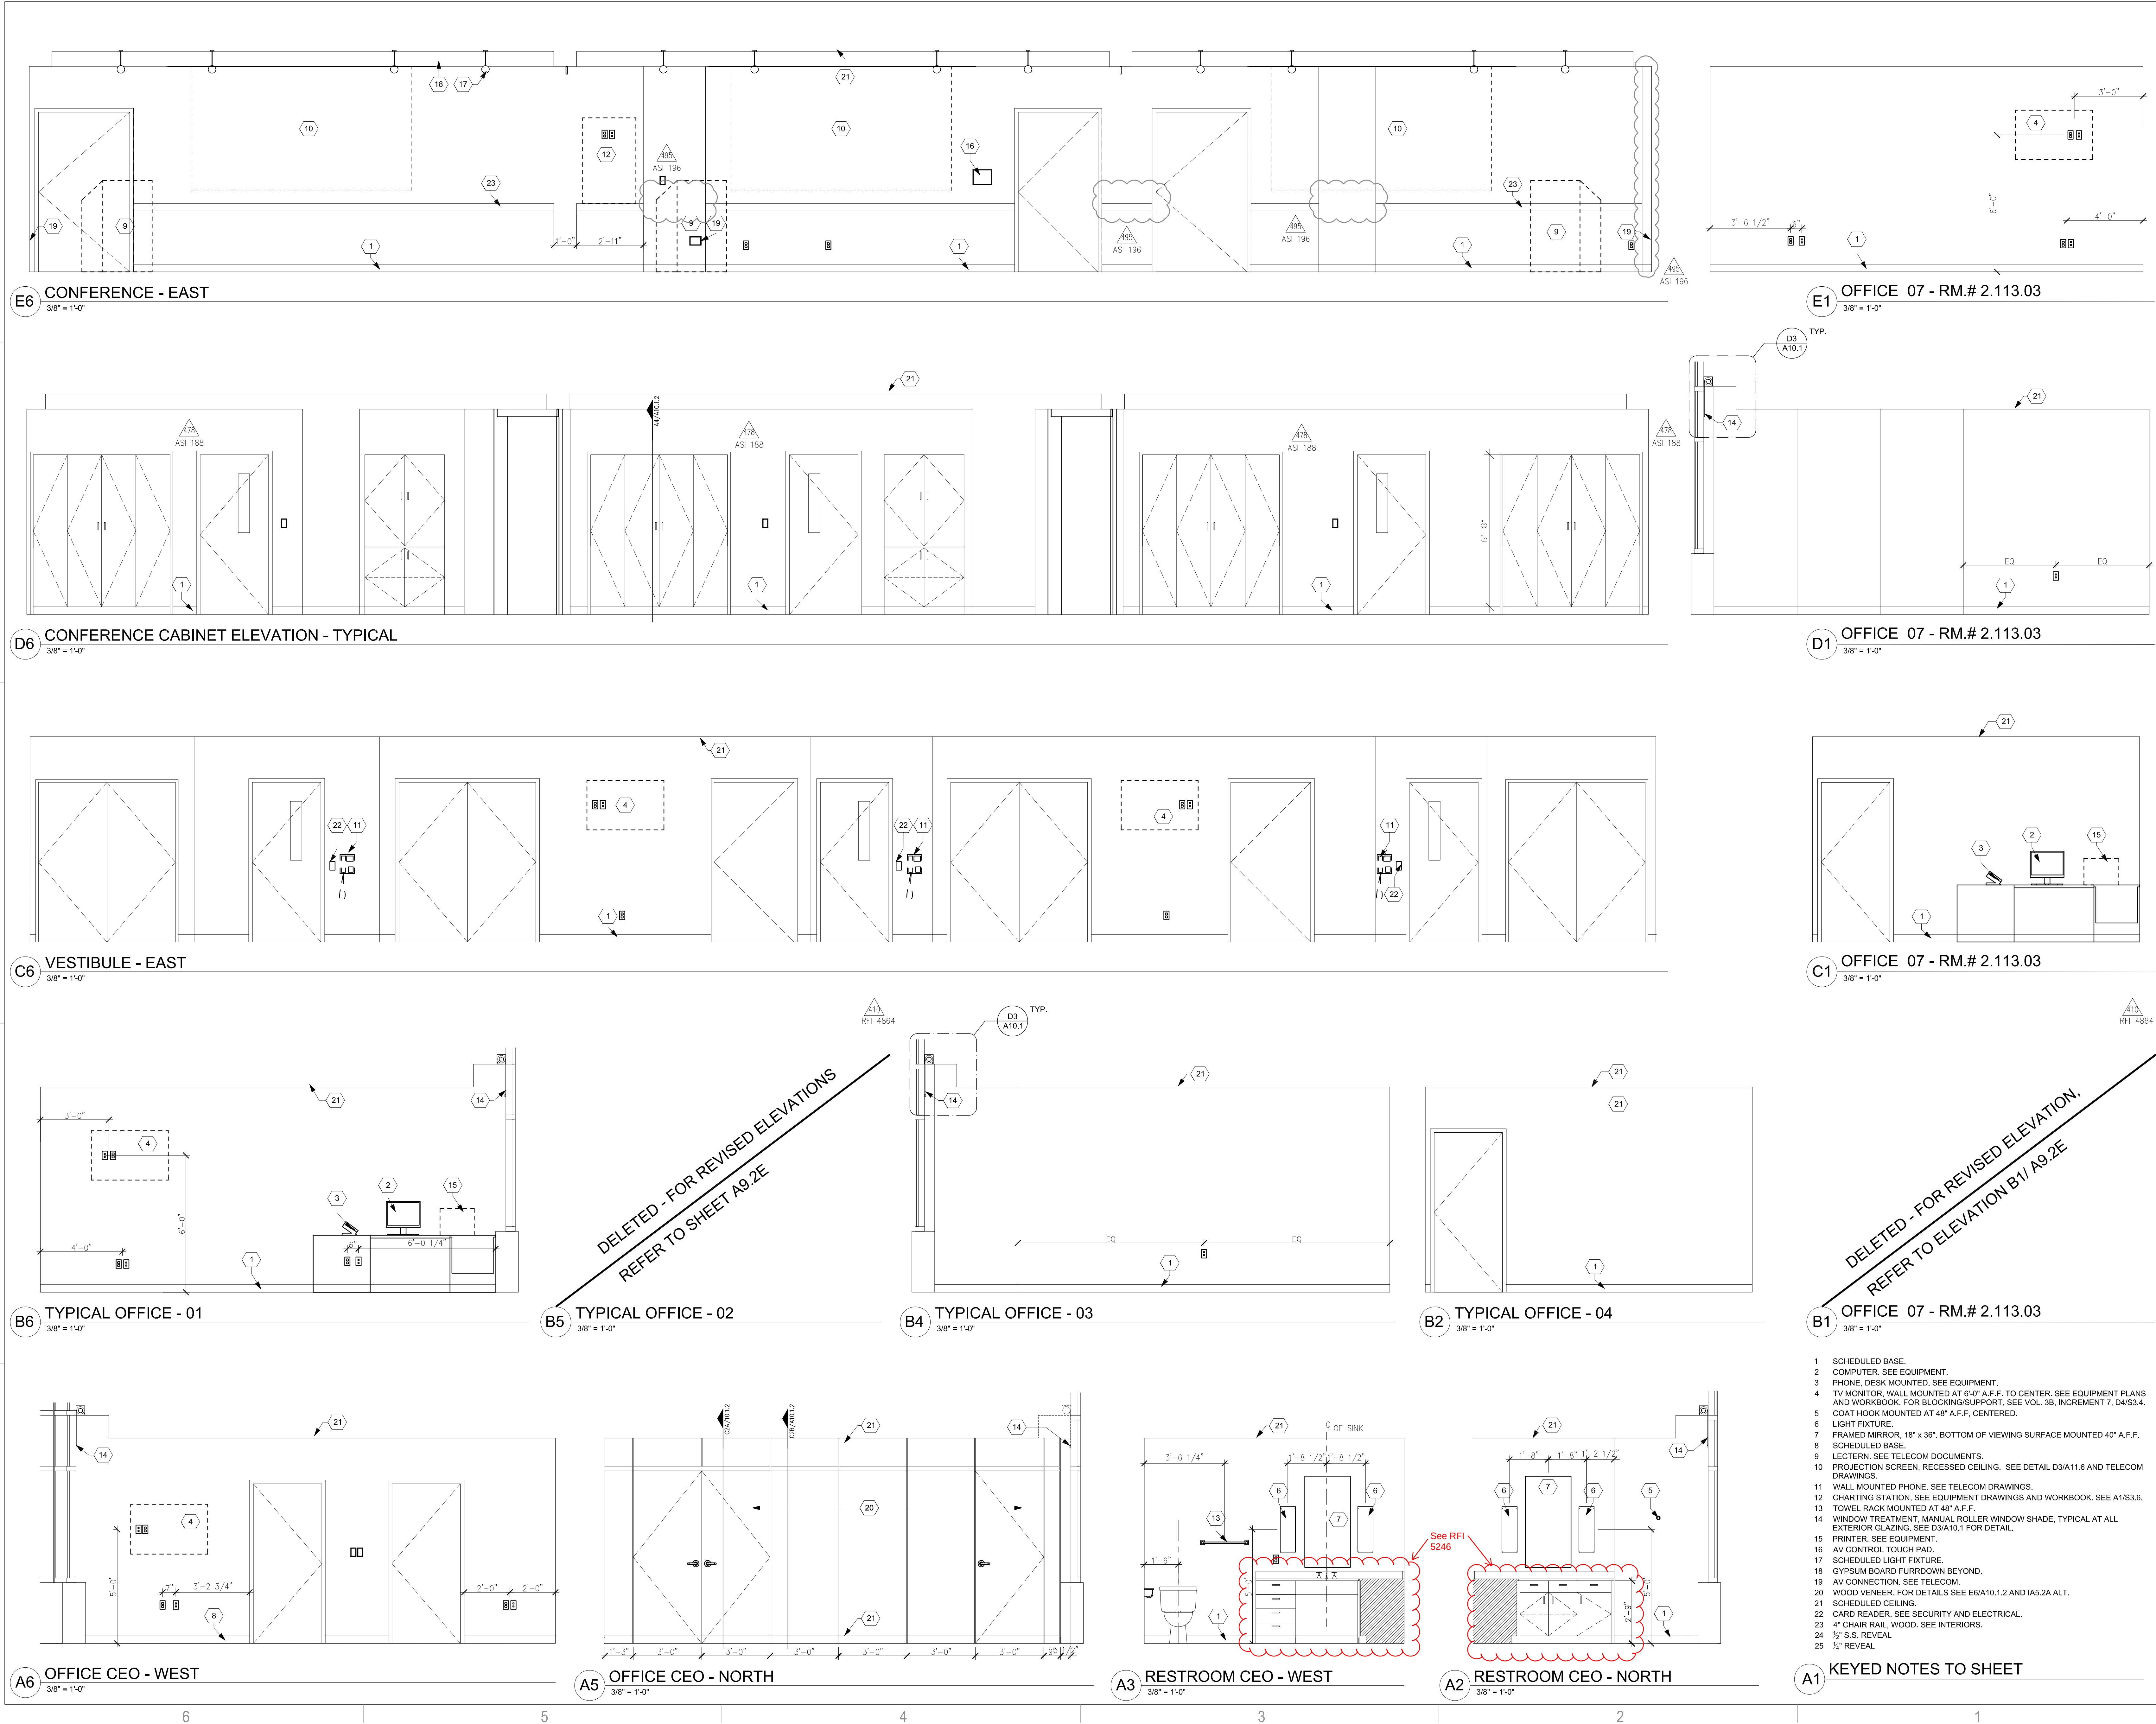

1. SCHEDULED BASE.
2. COMPUTER. SEE EQUIPMENT.
3. PHONE, DESK MOUNTED. SEE EQUIPMENT.
4. TV MONITOR, WALL MOUNTED AT 6'-0" A.F.F. TO CENTER. SEE EQUIPMENT PLANS AND WORKBOOK. FOR BLOCKING/SUPPORT. SEE VOL. 3B, INCREMENT 7, D4/S3.4.
5. COAT HOOK MOUNTED AT 48" A.F.F. CENTERED.
6. LIGHT FIXTURE.
7. FRAMED MIRROR, 18" x 36". BOTTOM OF VIEWING SURFACE MOUNTED 40" A.F.F.
8. SCHEDULED BASE.
9. LECTERN. SEE TELECOM DOCUMENTS.
10. PROJECTION SCREEN, RECESSED CEILING. SEE DETAIL D3/A11.6 AND TELECOM DRAWINGS.
11. WALL MOUNTED PHONE. SEE TELECOM DRAWINGS.
12. CHARTING STATION. SEE EQUIPMENT DRAWINGS AND WORKBOOK. SEE A1/S3.6.
13. TOWEL RACK MOUNTED AT 48" A.F.F.
14. WINDOW TREATMENT, MANUAL ROLLER WINDOW SHADE, TYPICAL AT ALL EXTERIOR GLAZING. SEE D3/A10.1 FOR DETAIL.
15. PRINTER. SEE EQUIPMENT.
16. AV CONTROL TOUCH PAD.
17. SCHEDULED LIGHT FIXTURE.
18. GYPSUM BOARD FURDOWN BEYOND.
19. AV CONNECTION. SEE TELECOM.
20. WOOD VENEER. FOR DETAILS SEE E6/A10.1.2 AND IAS.2A A.L.T.
21. SCHEDULED CEILING.
22. CARD READER. SEE SECURITY AND ELECTRICAL.
23. 4" CHAIR RAIL, WOOD. SEE INTERIORS.
24. 1/2" S.S. REVEAL.
25. 1/2" REVEAL.