


FKP Architects

ARCHITECT OF RECORD
Paul C. Gloriot

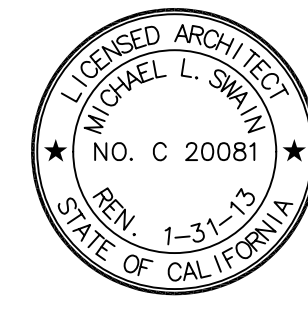


Changes on these drawings do not consist of
materially altered changes to approved drawings
and don't require a change order.
OSHPD review ACO
OSHPD review FLSO
OSHPD review DSE

REVISIONS

110 01/09/12 ASI #158

APPROVAL

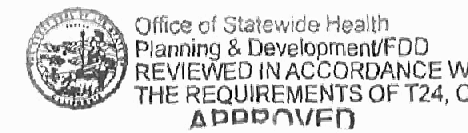

CHANGE ORDER
INSTRUCTION BULLETIN
DEFERRED APPROVAL #
(REVISION)

PROJECT NAME

CHILDREN'S HOSPITAL
OF ORANGE COUNTY

455 S. Main St.
Orange, CA 92668-3874

TOWER II



PROJECT NUMBER

12011.00
Increment #7

OSHPD - PROJECT NUMBER

IL 072072-30

ISSUE

OSHPD PERMIT

DATE

01/27/2010

SCALE


3/8" = 1'-0"

DRAWING TITLE

SECOND FLOOR INTERIOR
ELEVATIONS

DRAWING NUMBER

A9.2E

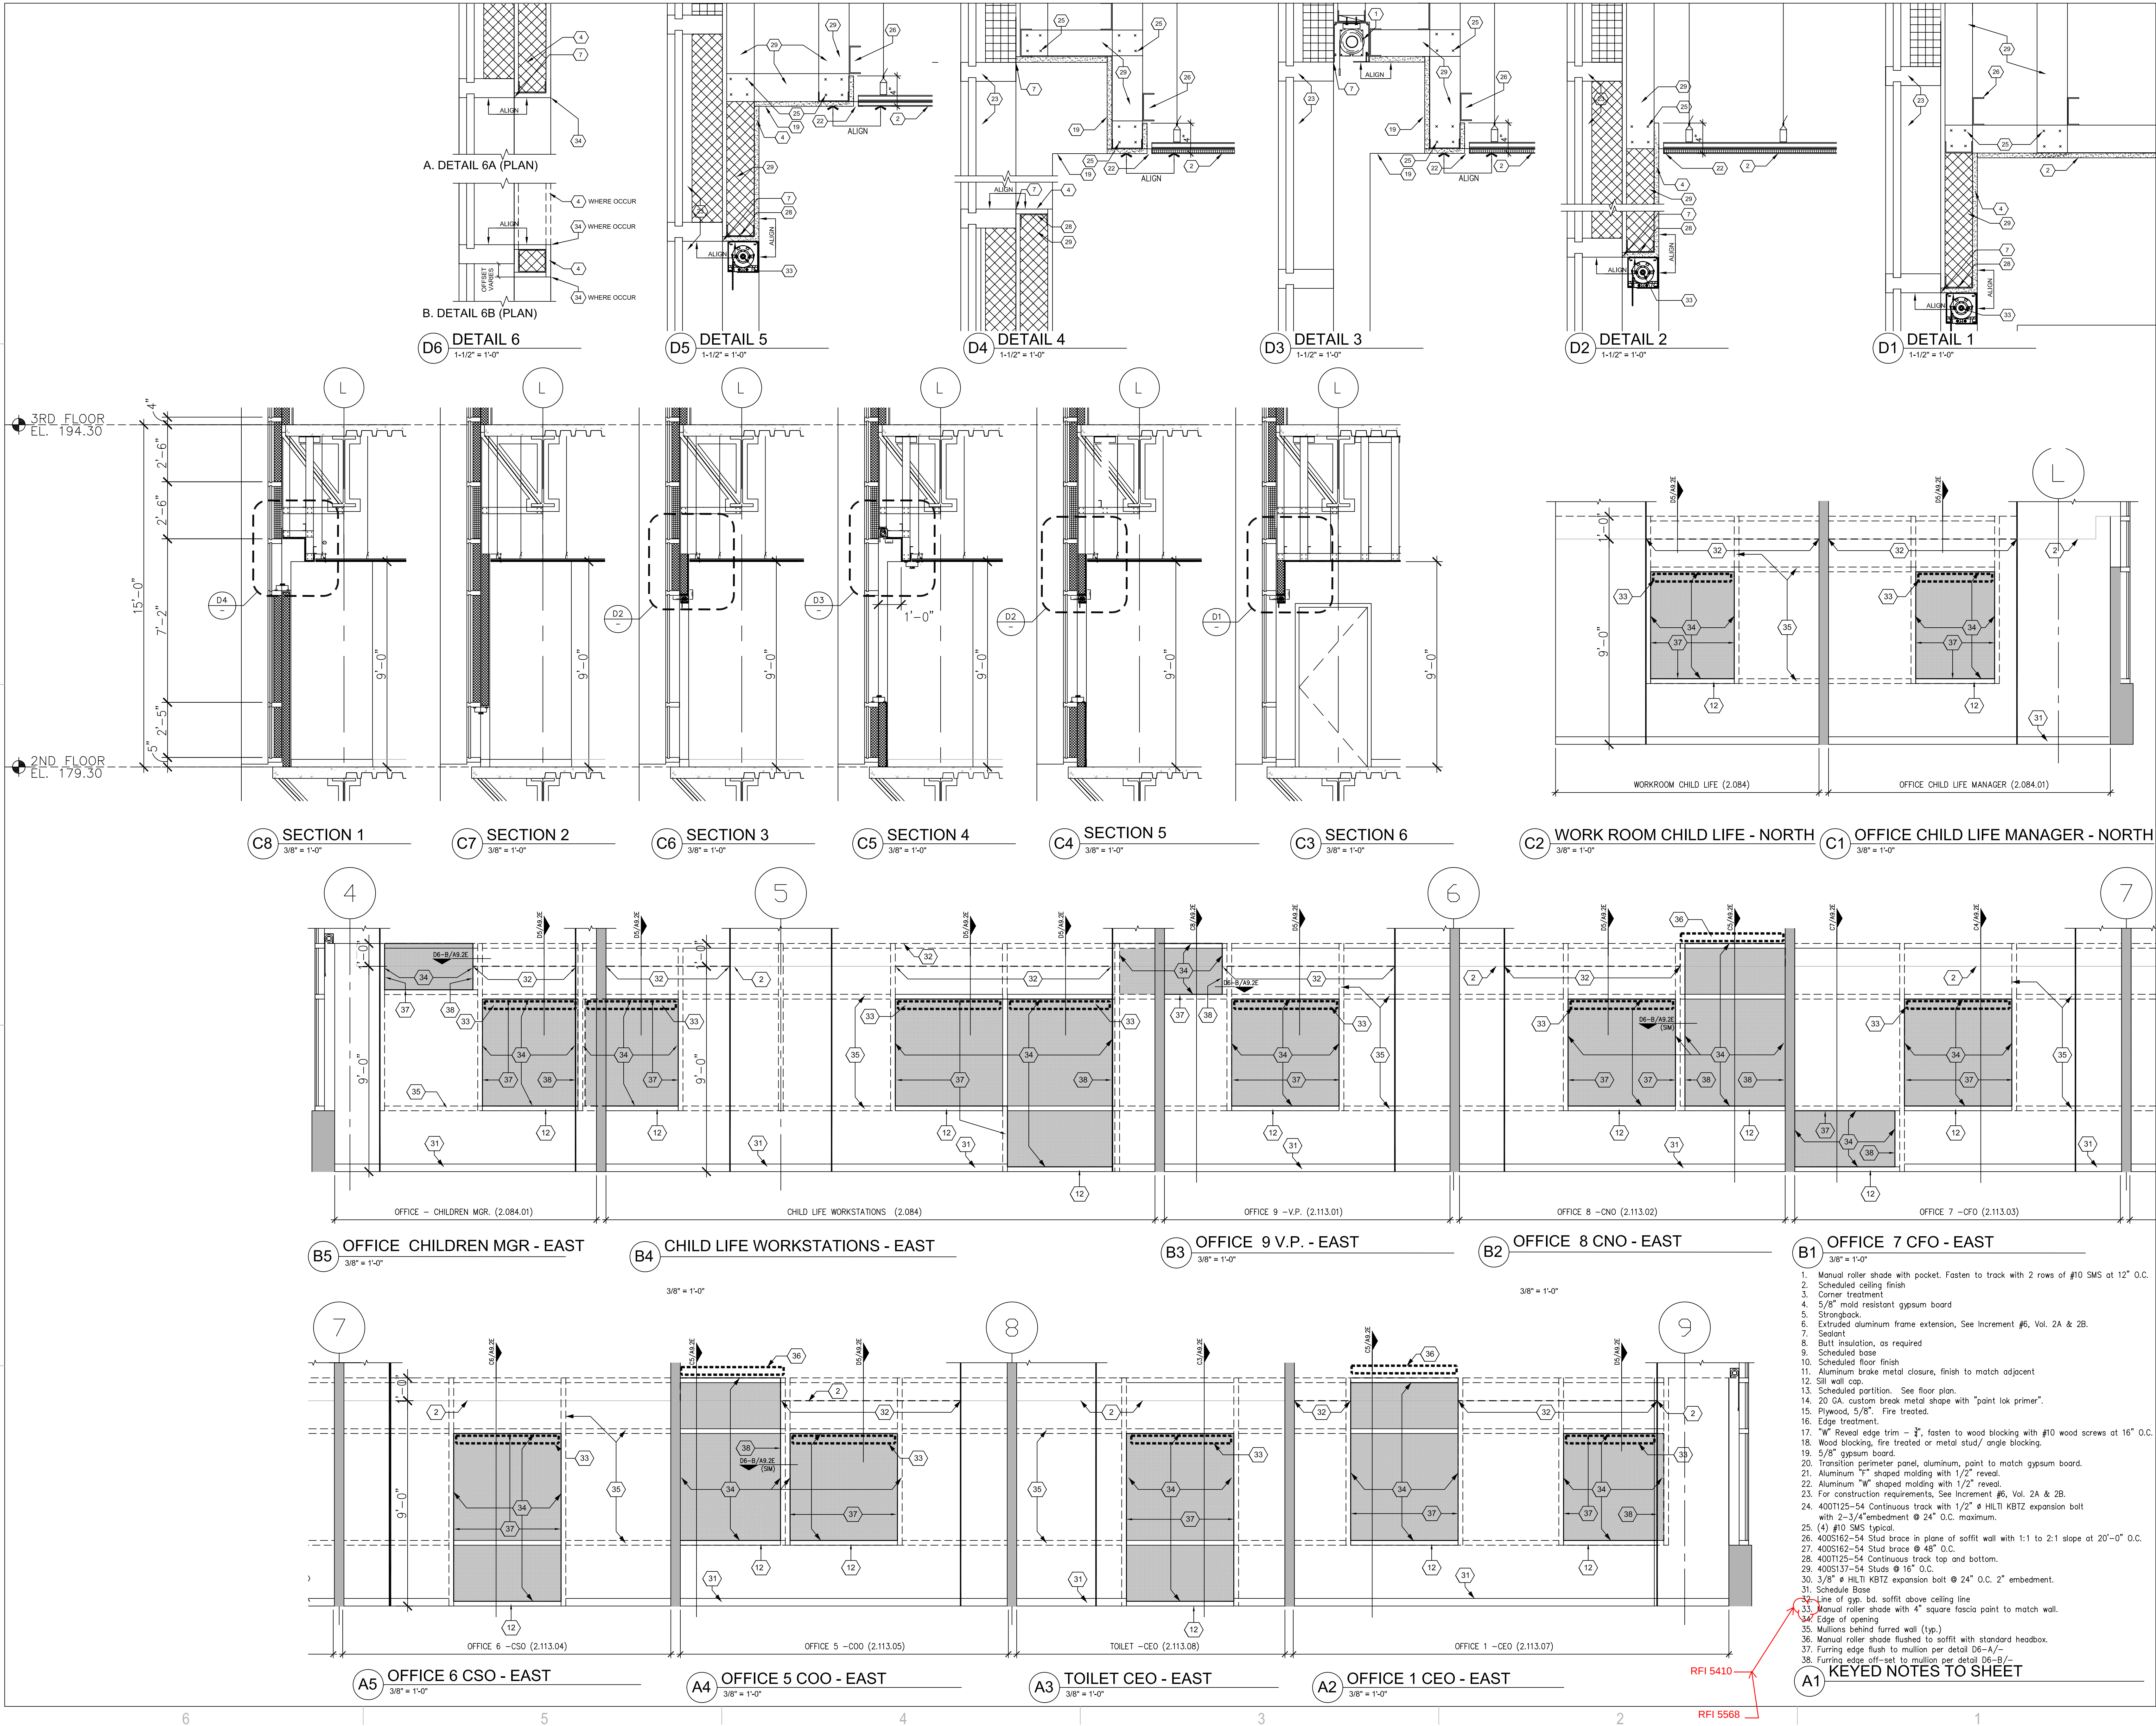

1. Manual roller shade with pocket. Fasten to track with 2 rows of #10 SMS at 12" O.C.
2. Scheduled ceiling finish
3. Corner treatment
4. 5/8" mold resistant gypsum board
5. Strongback
6. Extruded aluminum frame extension, See Increment #5, Vol. 2A & 2B.
7. Sealant
8. Butt insulation, as required
9. Scheduled base
10. Scheduled floor finish
11. Aluminum broke metal closure, finish to match adjacent
12. Sill wall cap.
13. Scheduled partition. See floor plan.
14. 20 GA. custom break metal shape with "point lok primer".
15. Plywood, 5/8". Fire treated.
16. Edge treatment.
17. "W" reveal edge trim - 3/4", fasten to wood blocking with #10 wood screws at 16" O.C.
18. Wood blocking, fire treated or metal stud/ angle blocking.
19. 5/8" gypsum board.
20. Transition perimeter panel, aluminum, paint to match gypsum board.
21. Aluminum "T" shaped molding with 1/2" reveal.
22. Aluminum "W" shaped molding with 1/2" reveal.
23. For construction requirements, See Increment #6, Vol. 2A & 2B.
24. 400T125-54 Continuous track with 1/2" x HILTI KBTZ expansion bolt with 2-3/4" embedment @ 24" O.C. maximum.
25. (4) #10 SMS typical.
26. 400S162-54 Stud brace in plane of soffit wall with 1:1 to 2:1 slope at 20'-0" O.C.
27. 400S162-54 Stud brace @ 48" O.C.
28. 400T125-54 Continuous track top and bottom.
29. 400S137-54 Studs @ 16" O.C.
30. 3/8" x HILTI KBTZ expansion bolt @ 24" O.C. 2" embedment.
31. Schedule Base
32. Line of gyp. bd. soffit above ceiling line
33. Manual roller shade with 4" square fascia paint to match wall.
34. Edge of opening
35. Mullions behind furred wall (typ.)
36. Manual roller shade flushed to soffit with standard headbox.
37. Furring edge flush to mullion per detail D6-A/-
38. Furring edge off-set to mullion per detail D6-B/-

RFI 5410

RFI 5568