

FKP Architects

ARCHITECT OF RECORD
Paul C. Gloriot

RFI 3724- 5'-8" from CL of bed for room 5.084.01 ONLY

CHANGES ON THESE DRAWINGS DO NOT CONSIST OF MATERIALLY ALTERED CHANGES TO APPROVED DRAWINGS AND DON'T REQUIRE A CHANGE ORDER.
OSHPD review ACO
OSHPD review RLSO
OSHPD review DSE

REVISIONS		
10/08/10	CHANGE ORDER #67	
02/10/11	ASI #62	
05/26/11	CO #170	

APPROVAL

Office of Statewide Health Planning & Development (OSHPD) REVIEWED IN ACCORDANCE WITH THE REQUIREMENTS OF PER, CCR AND THE RULES OF THE BOARD OF ARCHITECTS

CHANGE ORDER #170
INSTRUCTION BULLETIN
DEFERRED APPROVAL
ADDENDUM

PROJECT NAME
CHILDREN'S HOSPITAL OF ORANGE COUNTY
455 S. Main St.
Orange, CA 92668-3874

TOWER II
RECEIVED
June 08 2011
McCarthy

CHOC
HOSPITAL

PROJECT NUMBER
12011.00
Increment #7
OSHPD - PROJECT NUMBER
IL 072072-30

ISSUE
OSHPD PERMIT

DATE
01/27/2010


SCALE

3/8" = 1'-0"
DRAWING TITLE

FIFTH FLOOR INTERIOR ELEVATIONS

DRAWING NUMBER

A9.5A

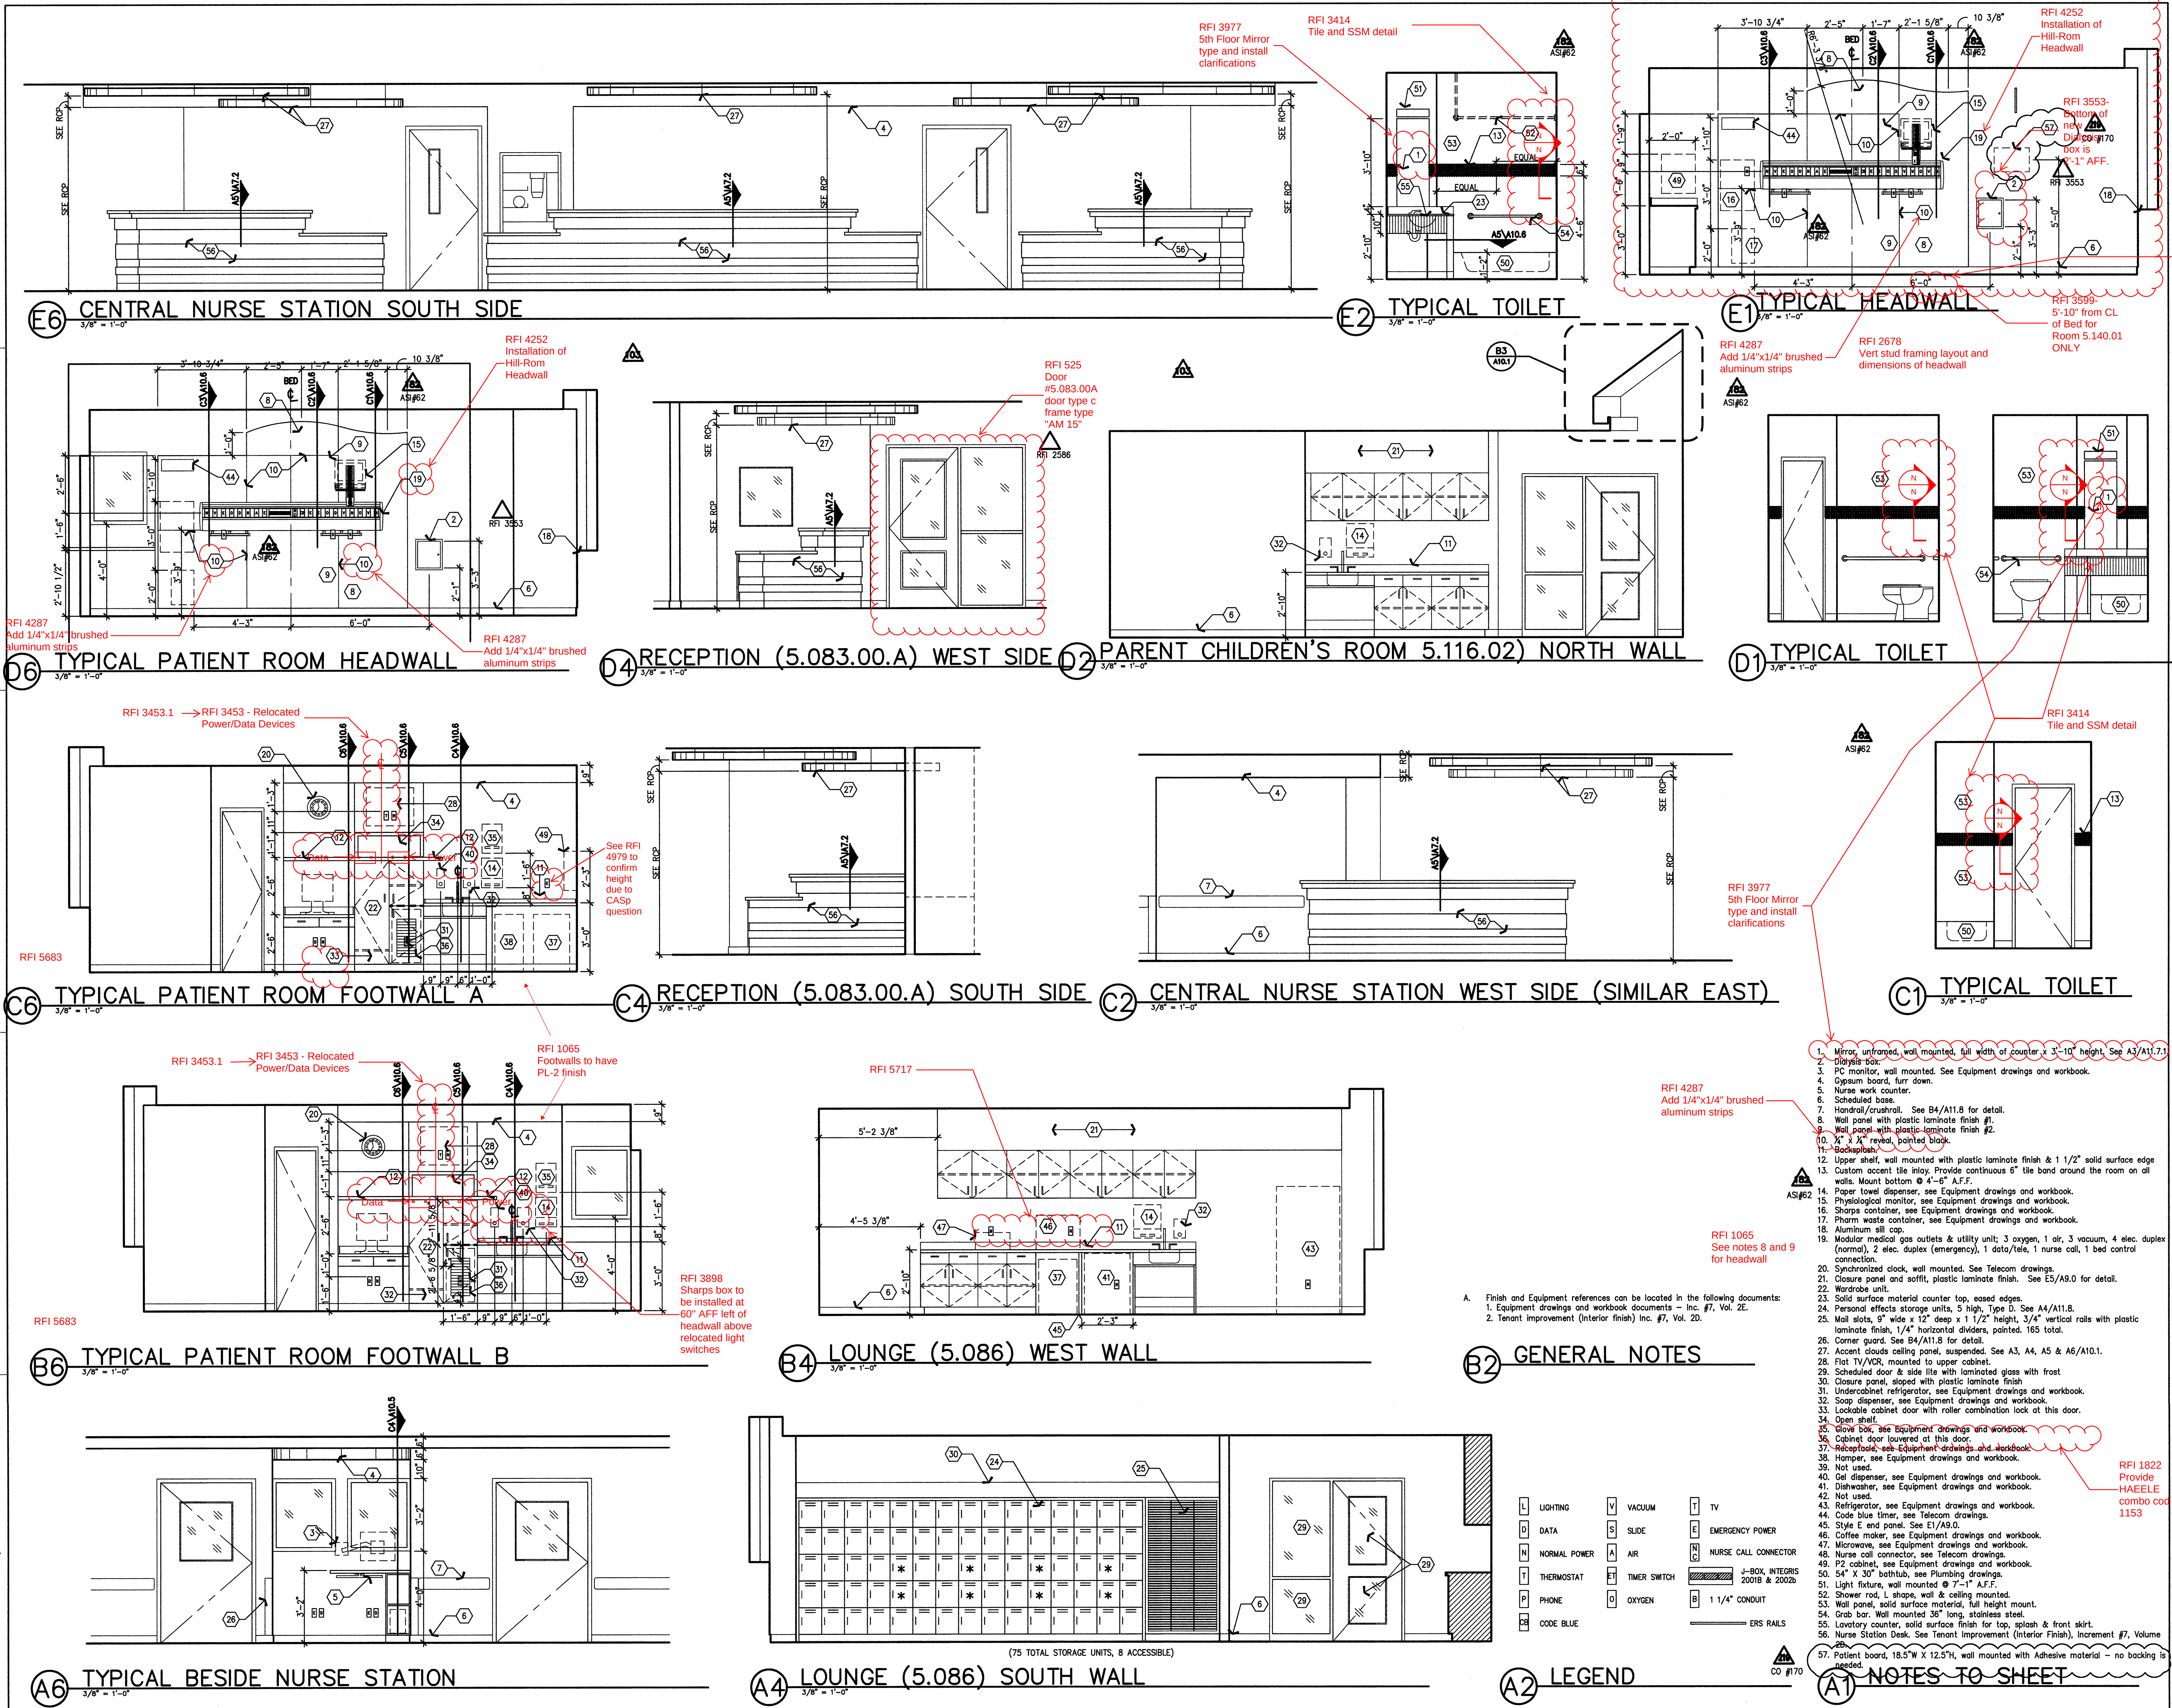

\\MSA-0FFSITE\CAUSEWAY\06002 CHOC TOWER 2 SHELL BUILDING\PP CONTRACTED PROJECTS\PROJECT IMPROVEMENTS\WOR_#07_TENANT IMPROVEMENT\OSHPD PERMIT (CONSTRUCTION DOCUMENTS)\06002_CO#..._A9.5A FIFTH FLOOR INTERIOR ELEVATIONS.DWG
5/19/2011
RLLA