


Changes on these drawings do not consist of
materially altering changes to approved drawings
and don't require a change order.
OSHPD review ACO _____
OSHPD review FLSO _____
OSHPD review DSE _____

REVISIONS		
162	08/08/11	CO #135

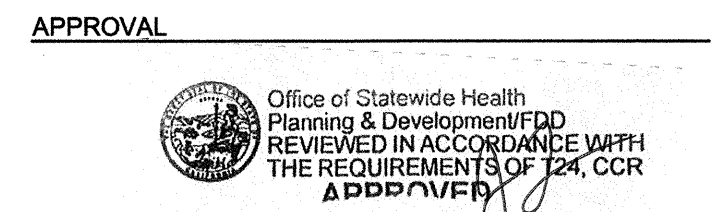

CHANGE ORDER# 135
INSTRUCTION BULLETIN#
DEFERRED APPROVAL#
DOCUMENT#

PROJECT NAME
**CHILDREN'S HOSPITAL
OF ORANGE COUNTY**
455 S. Main St.
Orange, CA 92868-3874

TOWER II RECEIVED
SEPT. 21 2011
McCARTHY



PROJECT NUMBER
**12011.00
Increment #7**
OSHPD - PROJECT NUMBER
IL 072072-30

ISSUE
OSHPD PERMIT

DATE
01/27/2010

SCALE
3/8" = 1'-0"
DRAWING TITLE

**FIFTH FLOOR INTERIOR
ELEVATIONS**


DRAWING NUMBER
A9.5C
162
CO#
135

GLAZING CALCS			
OPENING	AREA (SF)	WALL AREA (SF)	AMOUNT OF WALL ACQUIRED BY WINDOW
5.120.02a	16.19	115.5	14%
5.120.03a	19.71	292.5	7%
5.120.05a	27.8	292.5	10%

E6 GLAZING CALCULATIONS


E4 COORIDOR - WEST
3/8" = 1'-0"

RFI 4687
WC-1 is to be installed full height of wall.

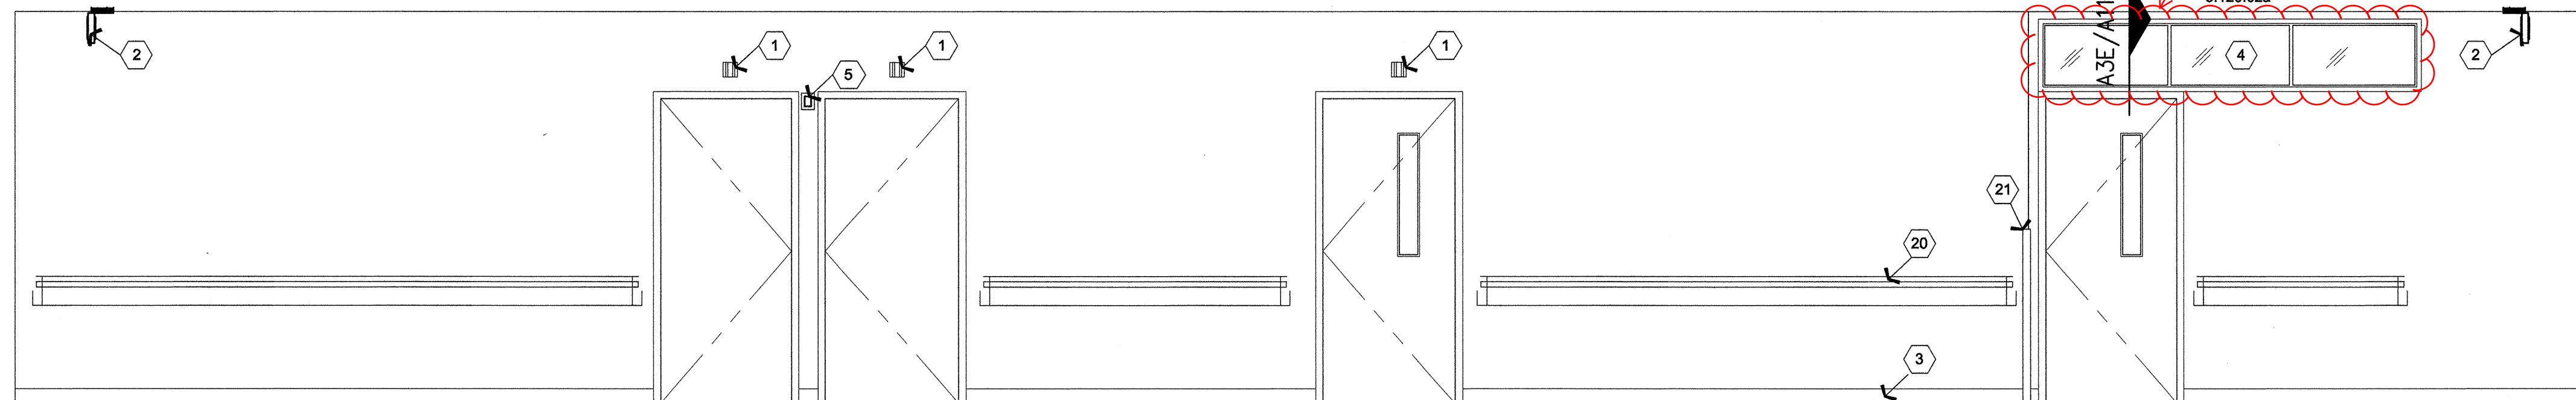


D5 COORIDOR - EAST
3/8" = 1'-0"


RFI 4687
WC-1 is to be installed full height of wall.

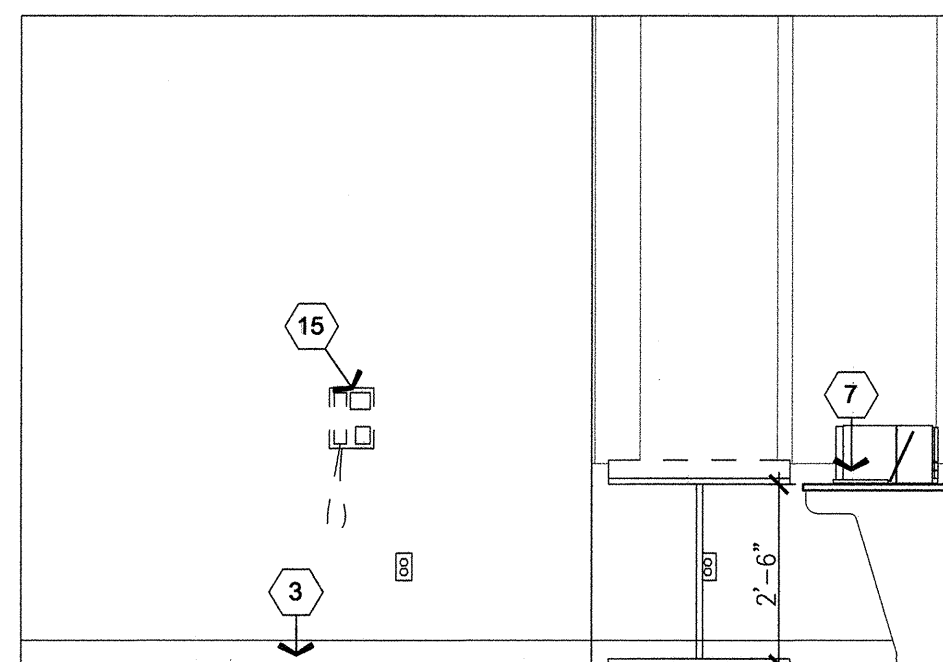


C6 TEEN LOUNGE - NORTH
3/8" = 1'-0"

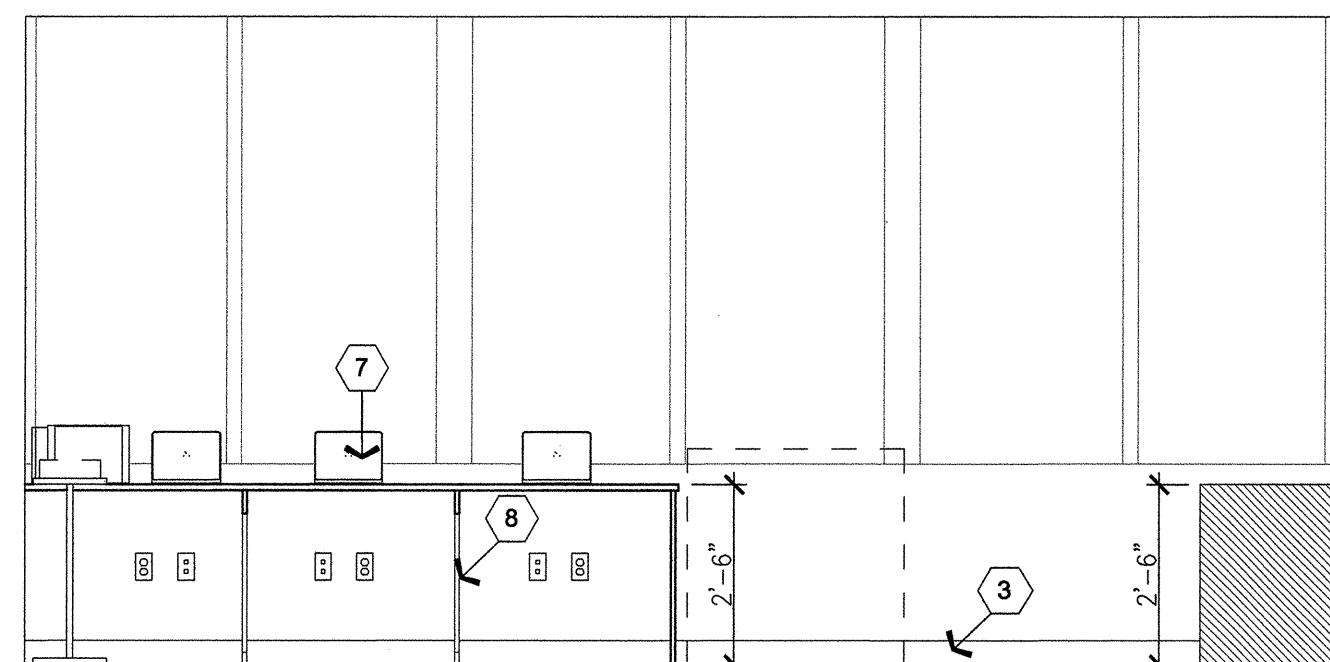


C5 TEEN LOUNGE - EAST
3/8" = 1'-0"

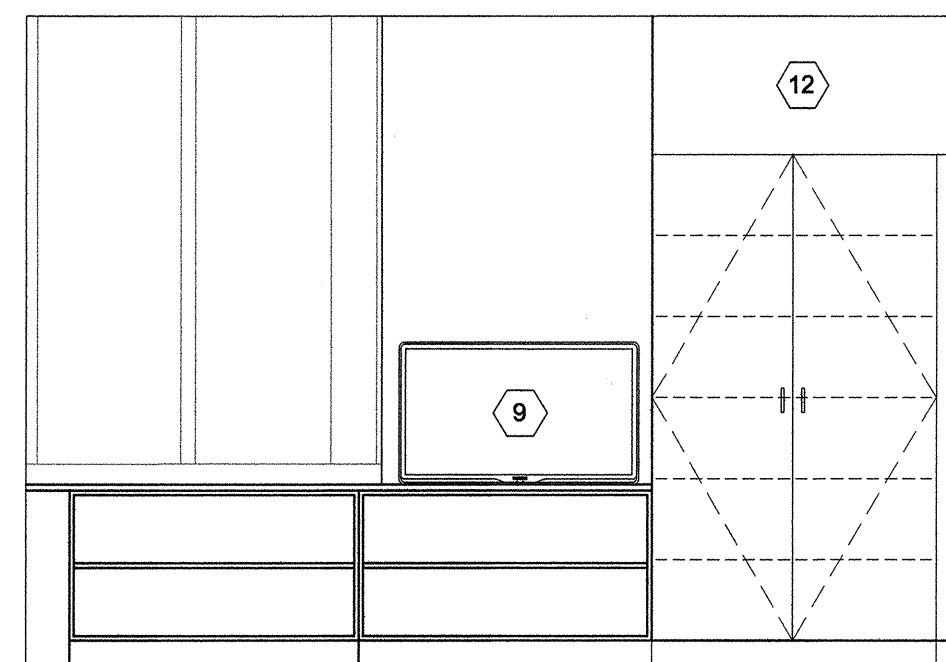


C4 TEEN LOUNGE - SOUTH
3/8" = 1'-0"

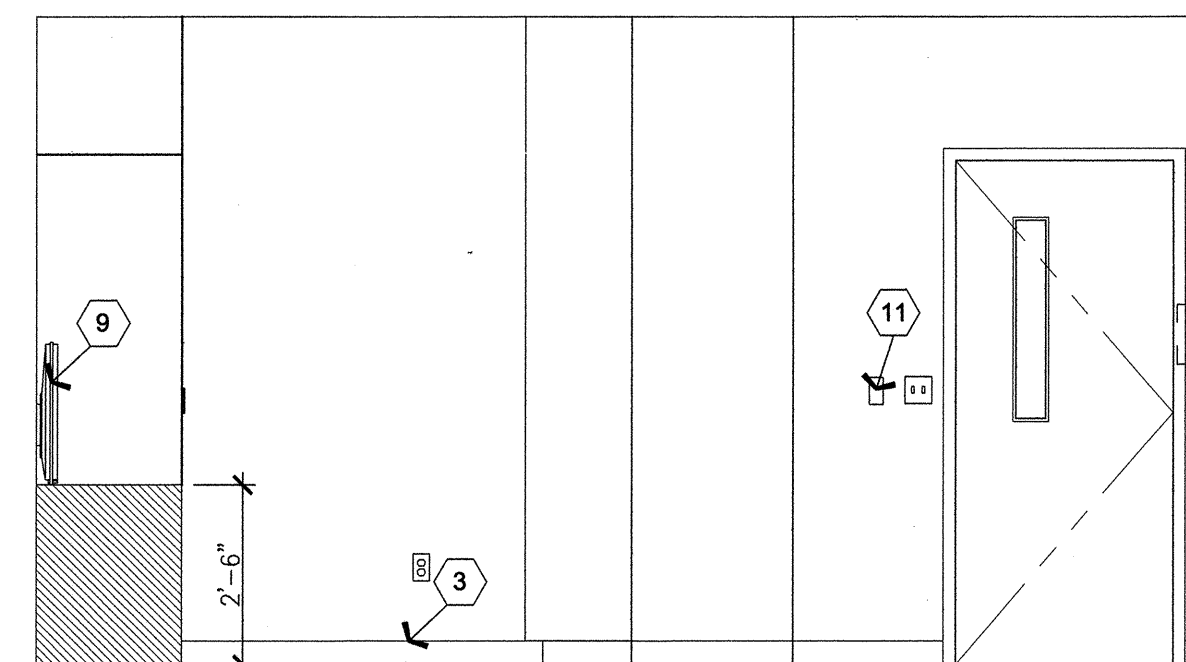


C3 TEEN LOUNGE - WEST
3/8" = 1'-0"

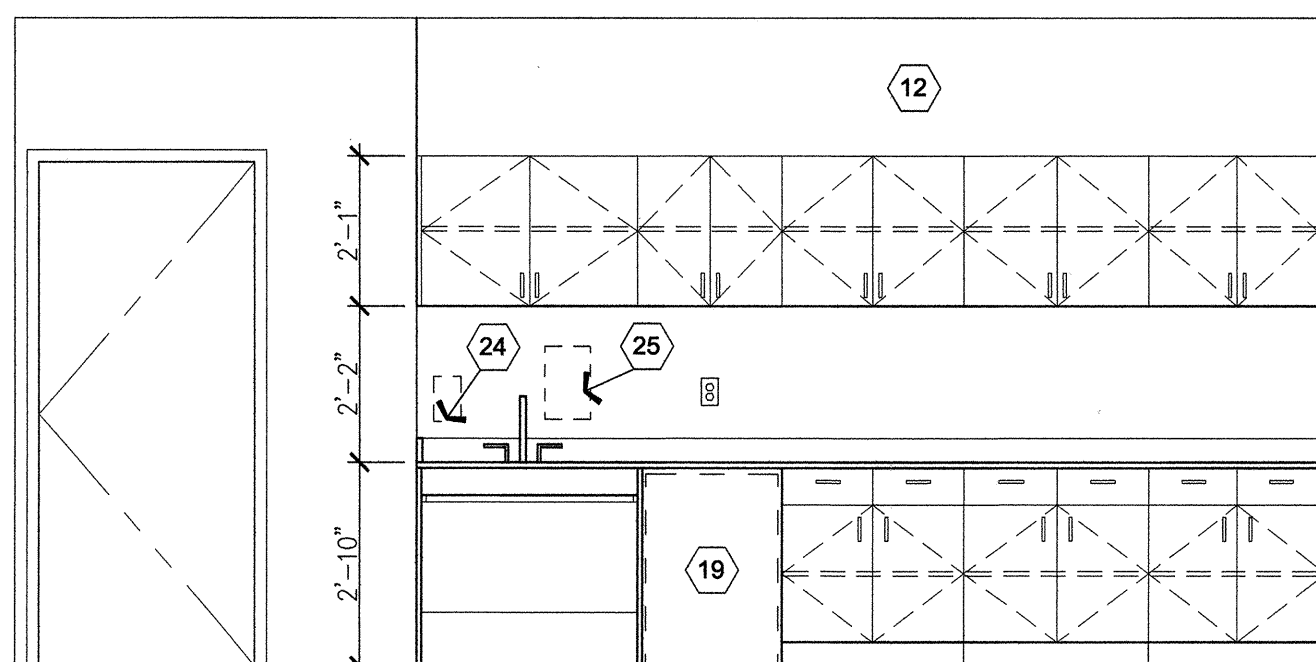


B5 PLAY / TUTORING ROOM - NORTH
3/8" = 1'-0"

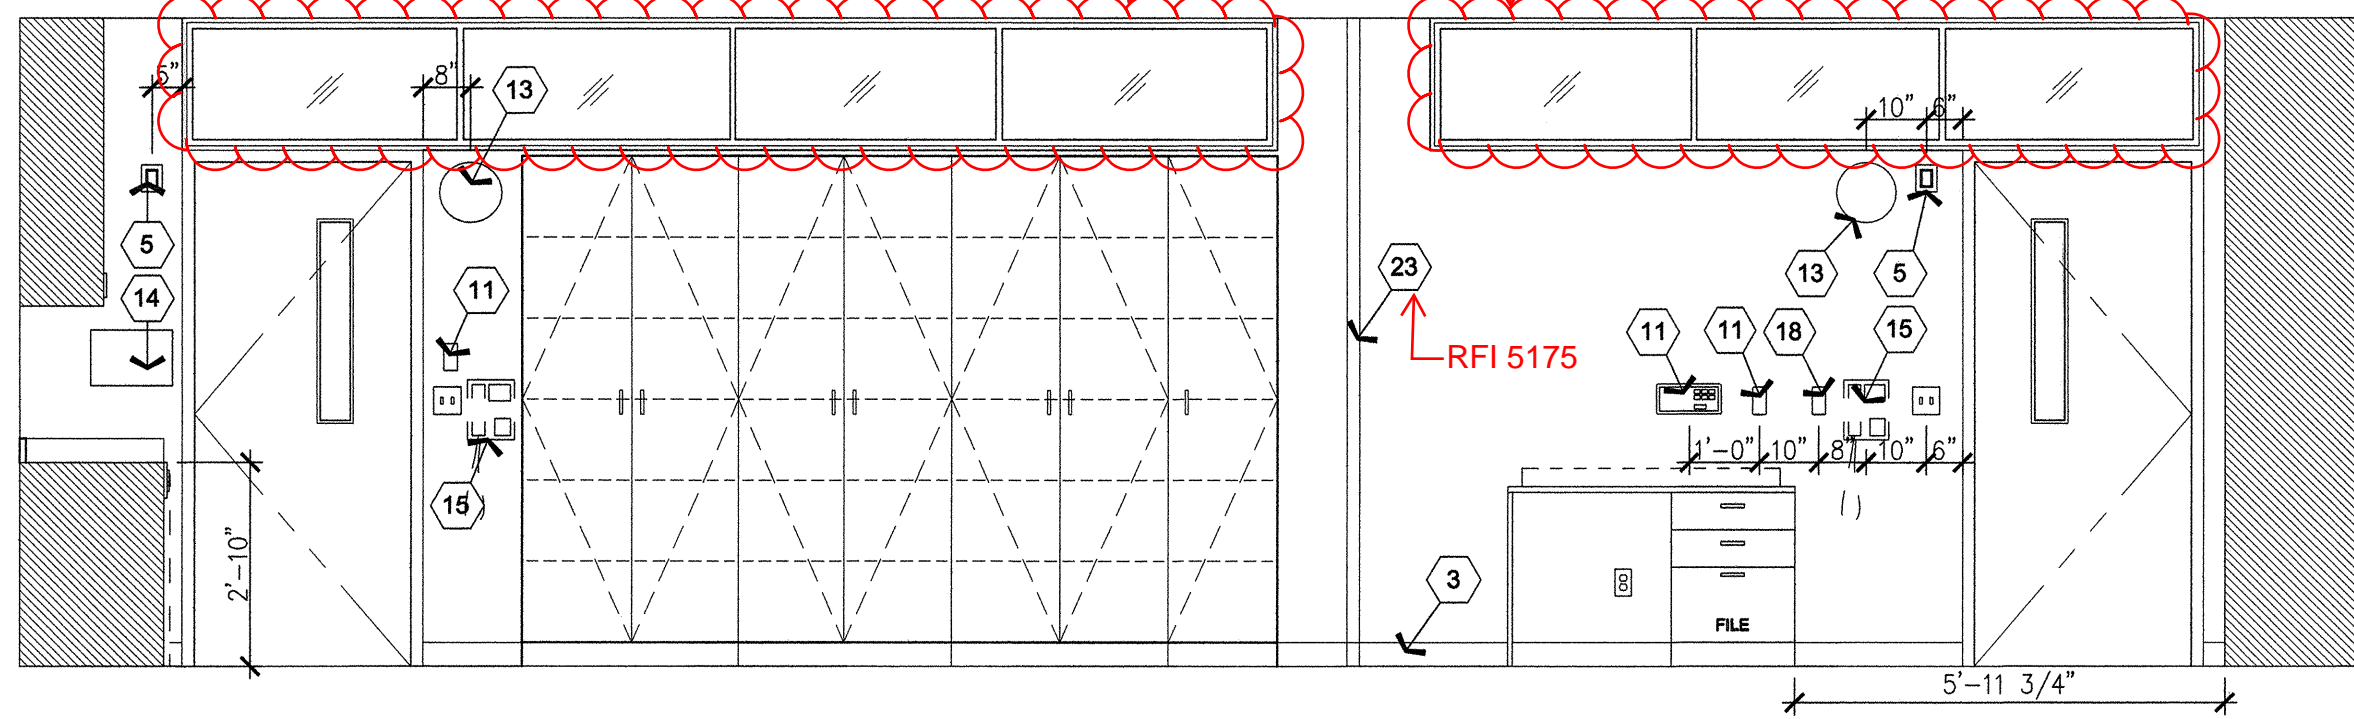

B4 PLAY / TUTORING ROOM - EAST
3/8" = 1'-0"

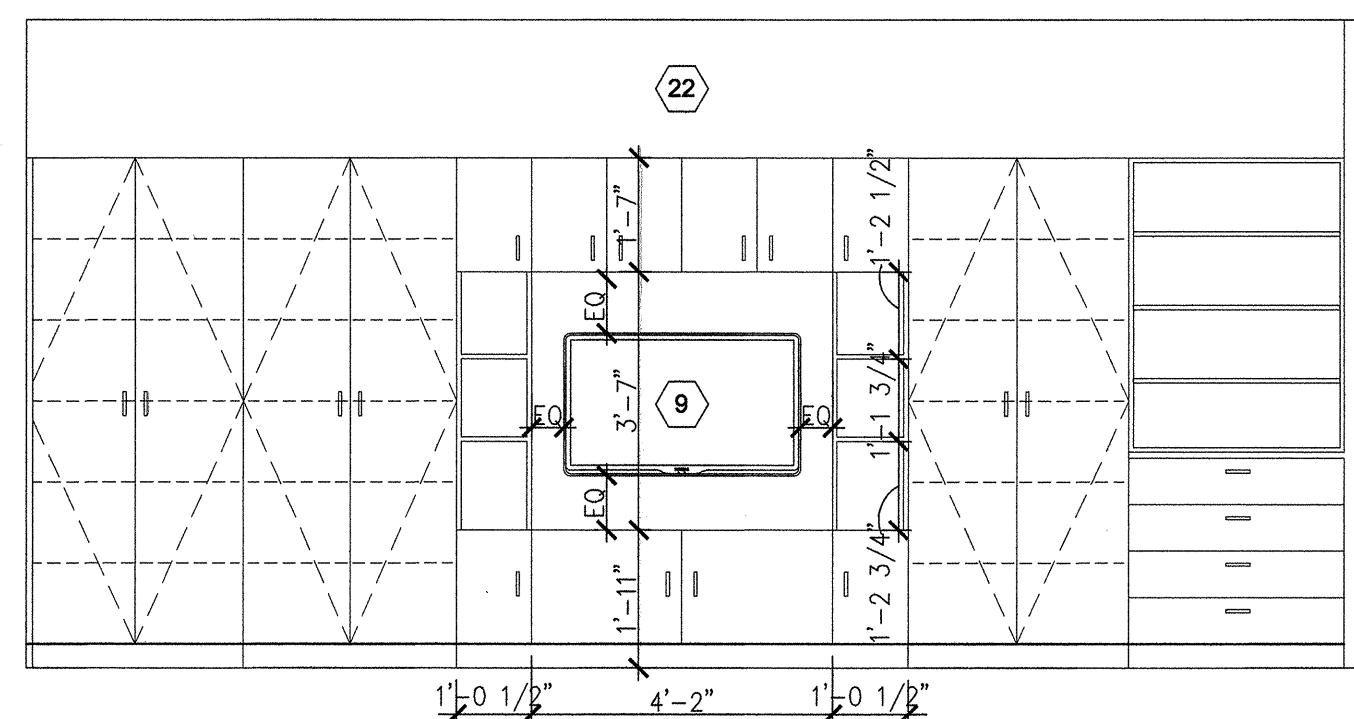

A5 PLAY / TUTORING ROOM - SOUTH
3/8" = 1'-0"

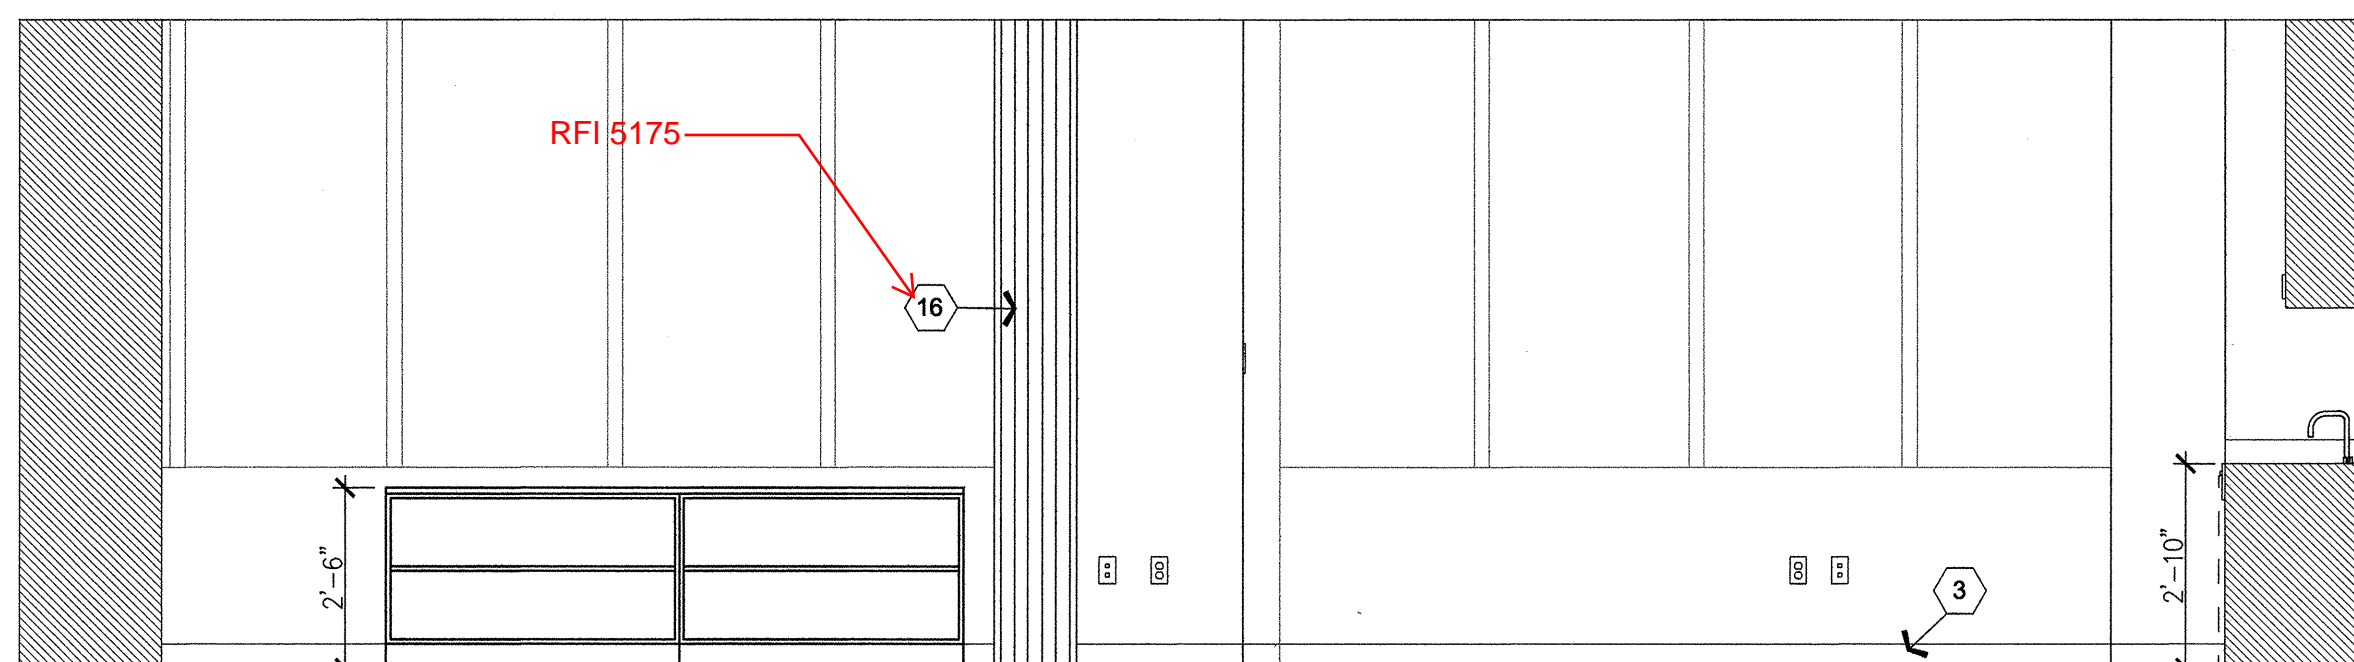

A4 PLAY / TUTORING ROOM - WEST
3/8" = 1'-0"

- 1 NURSE CALL LIGHT. SEE SPECIAL SYSTEMS AND ELECTRICAL.
- 2 EXIT SIGN. SEE RCP.
- 3 SCHEDULED BASE.
- 4 CLEARSTORY WINDOW. SEE OPENING SCHEDULE.
- 5 VISUAL FIRE ALARM. SEE ELECTRICAL.
- 6 NOT USED.
- 7 LAPTOP. SEE EQUIPMENT.
- 8 TV SUPPORT AT 3'-0" O.C.
- 9 TV MONITOR. WALL MOUNTED. SEE EQUIPMENT PLANS AND WORKBOOK.
- 10 FOR BLOCKING/SUPPORT. SEE VOL. 3B, INCREMENT 7.
- 11 NOT USED.
- 12 NURSE CALL. SEE TELECOM.
- 13 CLOSURE PANEL. FINISH TO MATCH WALL CABINETS.
- 14 CLOCK. SEE EQUIPMENT.
- 15 SHARPS CONTAINER. WALL MOUNTED. SEE EQUIPMENT.
- 16 WALL MOUNTED PHONE. SEE TELECOM DRAWINGS.
- 17 ACCORDION PARTITION TRACK. CEILING MOUNTED. SEE DETAILS A6/B6/A11.4.1.
- 18 NOT USED.
- 19 THERMOSTAT. SEE MECHANICAL.
- 20 DISHWASHER. UNDER-COUNTER. SEE EQUIPMENT.
- 21 HANDRAIL / CRASHRAIL. SEE DETAIL B4/A11.8.
- 22 CORNER GUARD. SEE FINISHES.
- 23 FLURR DOWN. SEE DETAIL A5/A11.6.
- 24 ACCORDIAN DOOR RECEIVER. SEE A3.6P AND DETAIL B5/A11.4.1.
- 25 SOAP DISPENSER. SEE EQUIPMENT DRAWINGS AND WORKBOOK.
- 26 PAPER TOWEL DISPENSER. SEE EQUIPMENT DRAWINGS AND WORKBOOK.

A1 NOTES TO SHEET

See RFI 5632 for PL
scribe color & info