



ARCHITECT OF RECORD

"Achitect of Record signature line only; this drawing was not prepared under the direct supervision of the Architect of Record. The direct responsibility for preparation of this sheet lies with its corresponding professional stamp and signature. The signature of the Architect of Record in general responsible charge of the project is provided as required by Title 24, Part 1 Section 7-115 (a)".

ARCHITECT - PAUL C. GLORIOD



CHILDREN'S HOSPITAL

OF ORANGE COUNTY

HOSPITAL

REVISIONS

08/31/09 ISSUED FOR FGMP

10/15/10 ASI NO. 34

APPROVAL

455 S. Main St.

Orange, CA 92868-3874

TOWER II

PROJECT NUMBER

12011.00

Increment #7


OSHPD - PROJECT NUMBER

IL 072072-30

Issue for FGMP

08/31/2009

AS NOTED

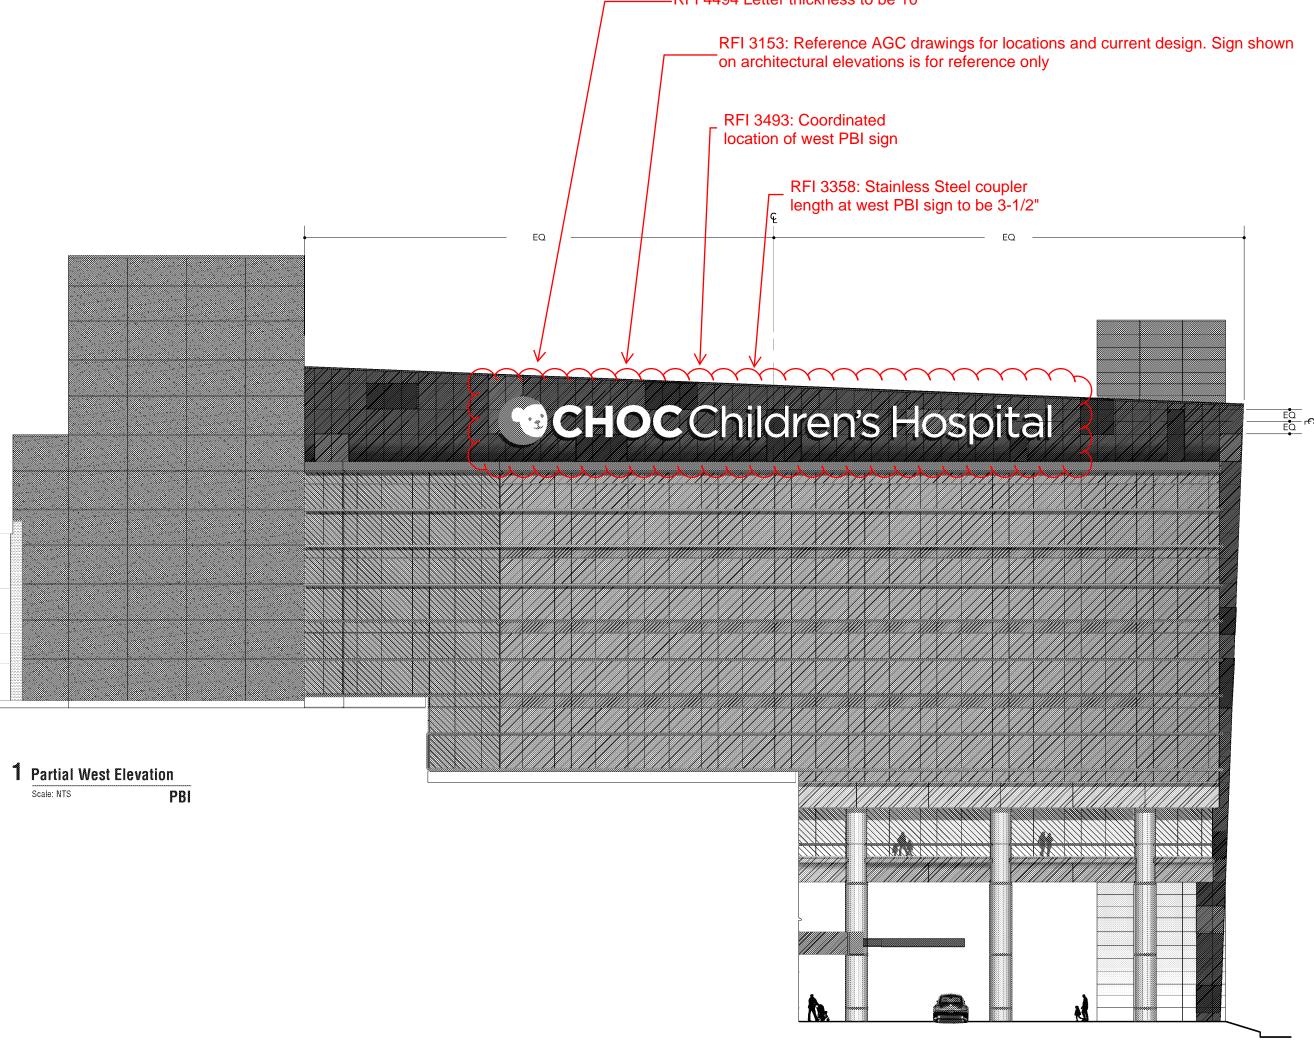

PBI: Primary Building Identification (West Elevation)

(C) 2007 FKP Architects, Inc. All rights reserved. No part of this document may be reproduced or utilized in any form without prior written authorization of FKP Architects, Inc.



EXTERIOR GRAPHICS

EXTERIOR GRAFFIES

AGC18.0

PBI: Primary Building Identification (East Elevation)

Partial East Elevation

Scale: NTS PBI

3