

ARCHITECT - PAUL C. GLORIODE

CONSULTANT

APPROVAL

PROJECT NAME

455 S. Main St.
Orange, CA 92868-3874

TOWER II



PROJECT NUMBER

12011.00
Increment #7

OSHPD - PROJECT NUMBER
IL 072072-30

ISSUE

Issue for FGMP

DATE _____

08/31/2009

SCALE


$$1/16'' = 1' - 0''$$

DRAWING TITLE

SIGN LOCATION PLAN
ROOF LEVEL

DRAWING NUMBER

AGC9.0

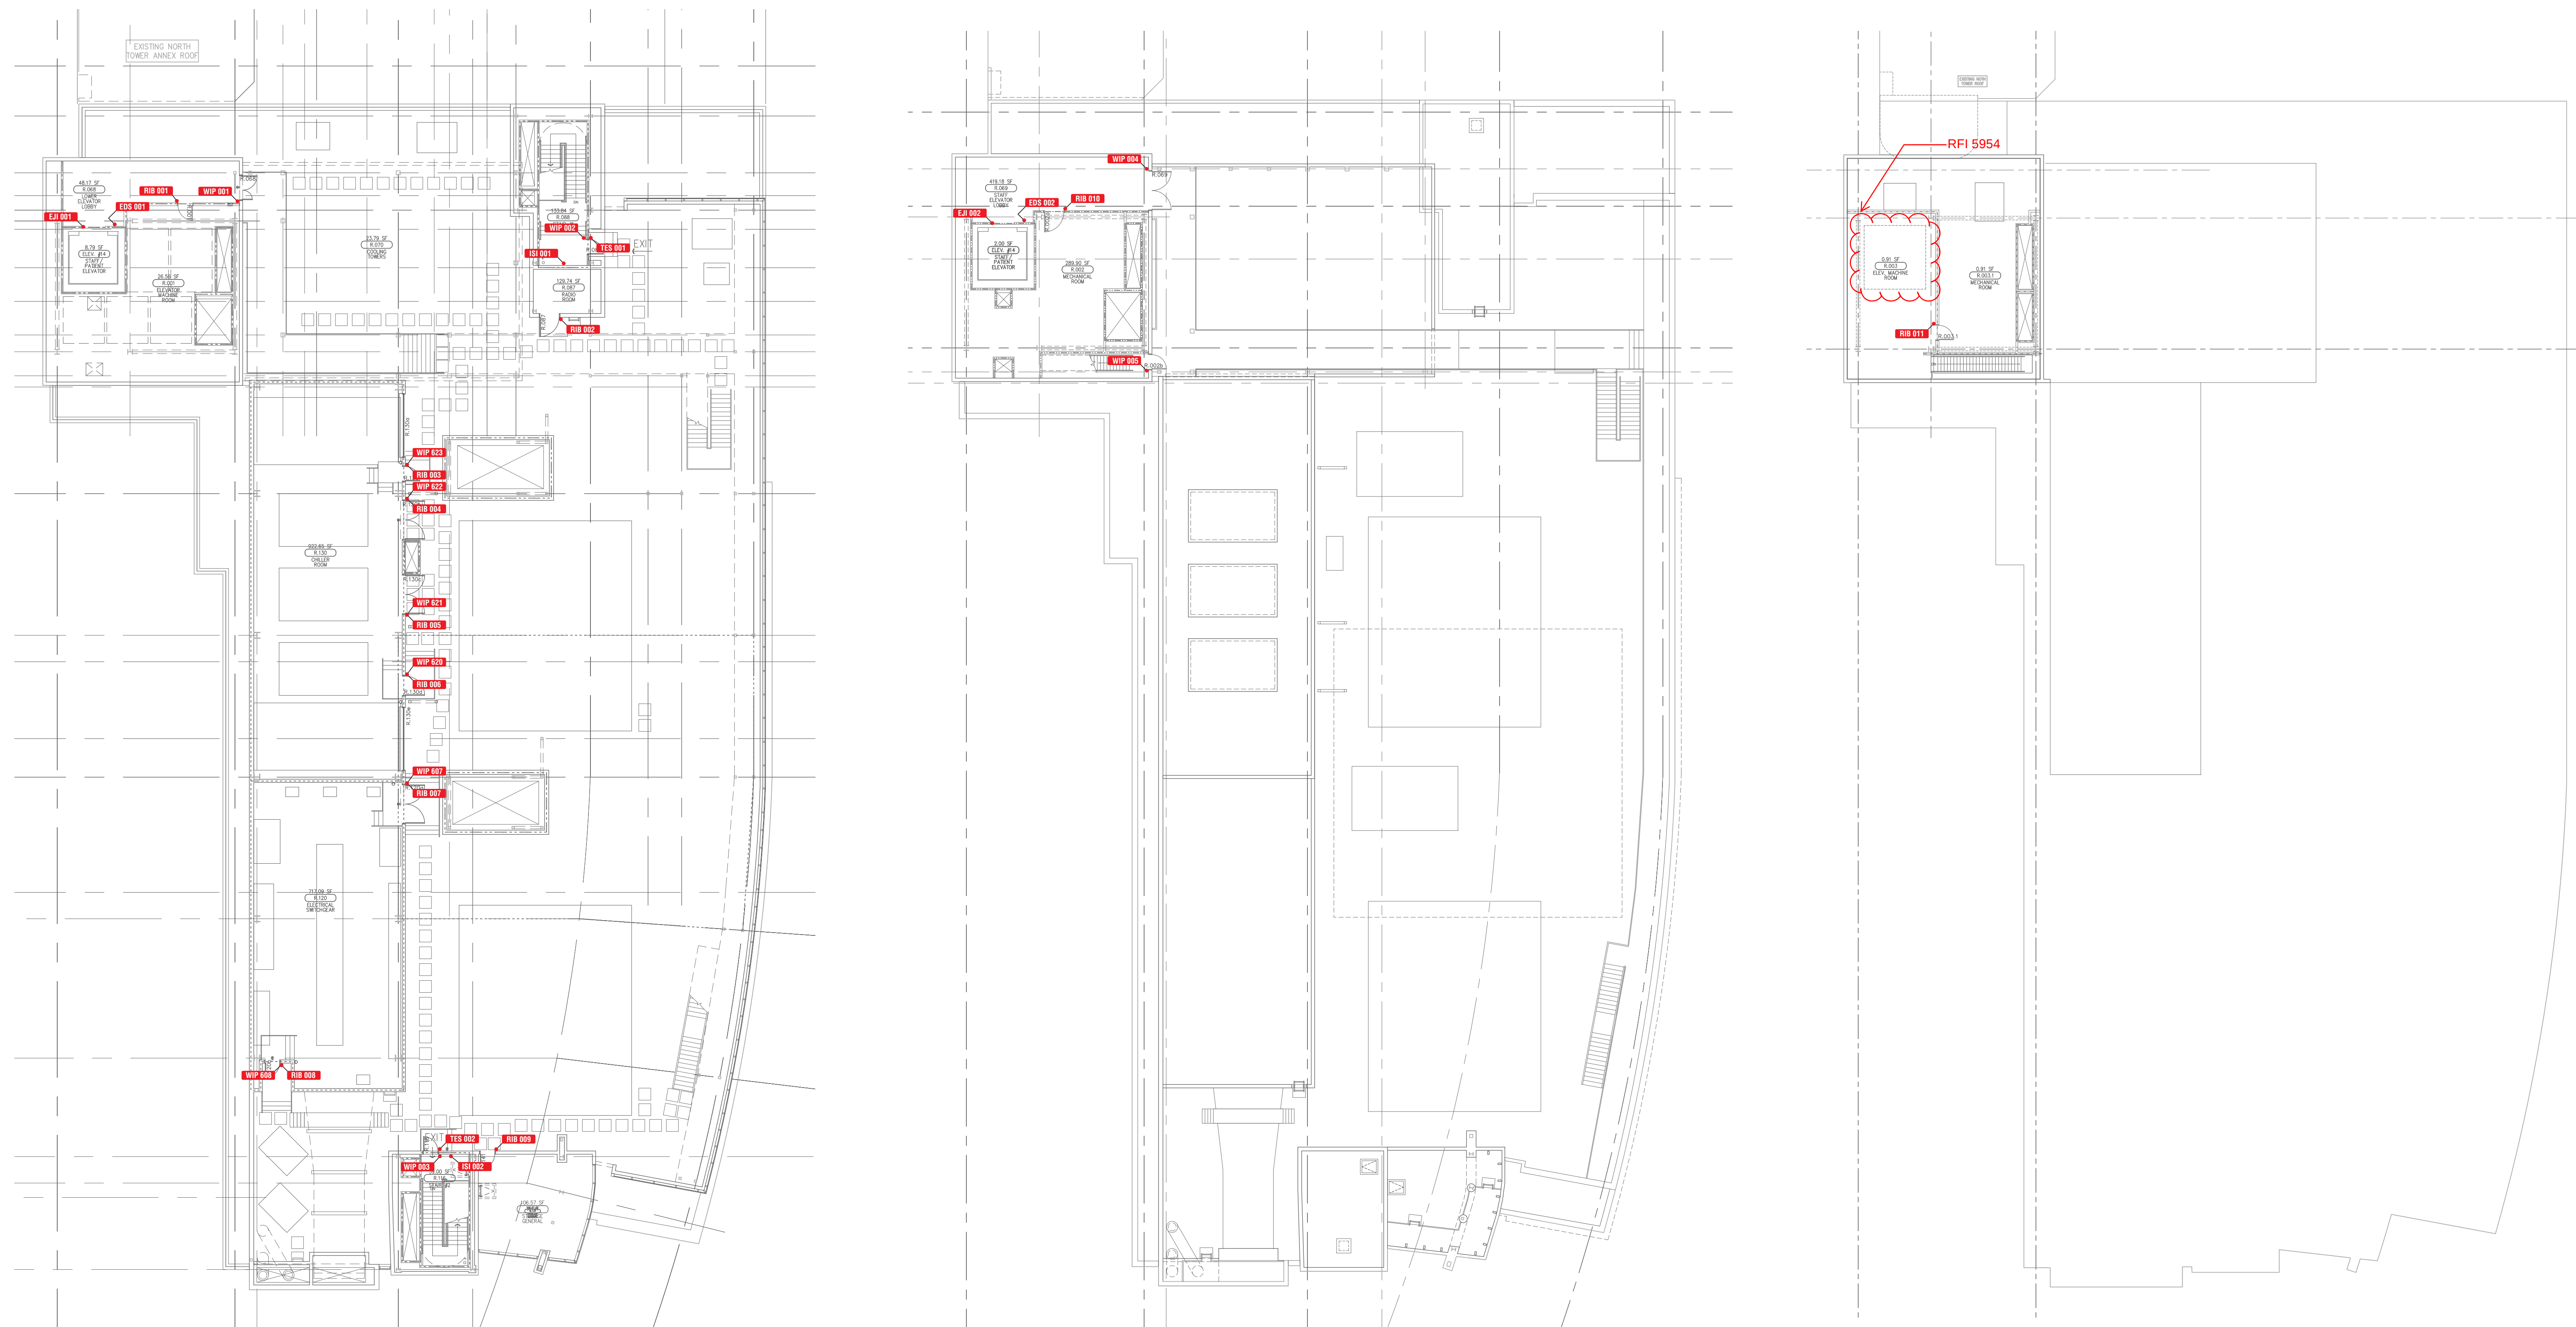

6

5

4

3

2

1