

FKP Architects

ARCHITECT OF RECORD

Paul C. Gloriot



REVISIONS

RFI 133 1/4" depression for terrazzo floor. See spec 090601, 090602 for locations.

PROJECT NAME  
CHILDREN'S  
HOSPITAL OF  
ORANGE COUNTY  
455 S. Main St.  
Orange, CA 92868-3874

TOWER II



PROJECT NUMBER

12011.00  
Increment # 7

OSHPD - PROJECT NUMBER

IL 072072-30

ISSUE

OSHPD Permit

DATE

01/27/2010

SCALE


As Noted

DRAWING TITLE

LOWER LEVEL

DRAWING NUMBER

IA5.0

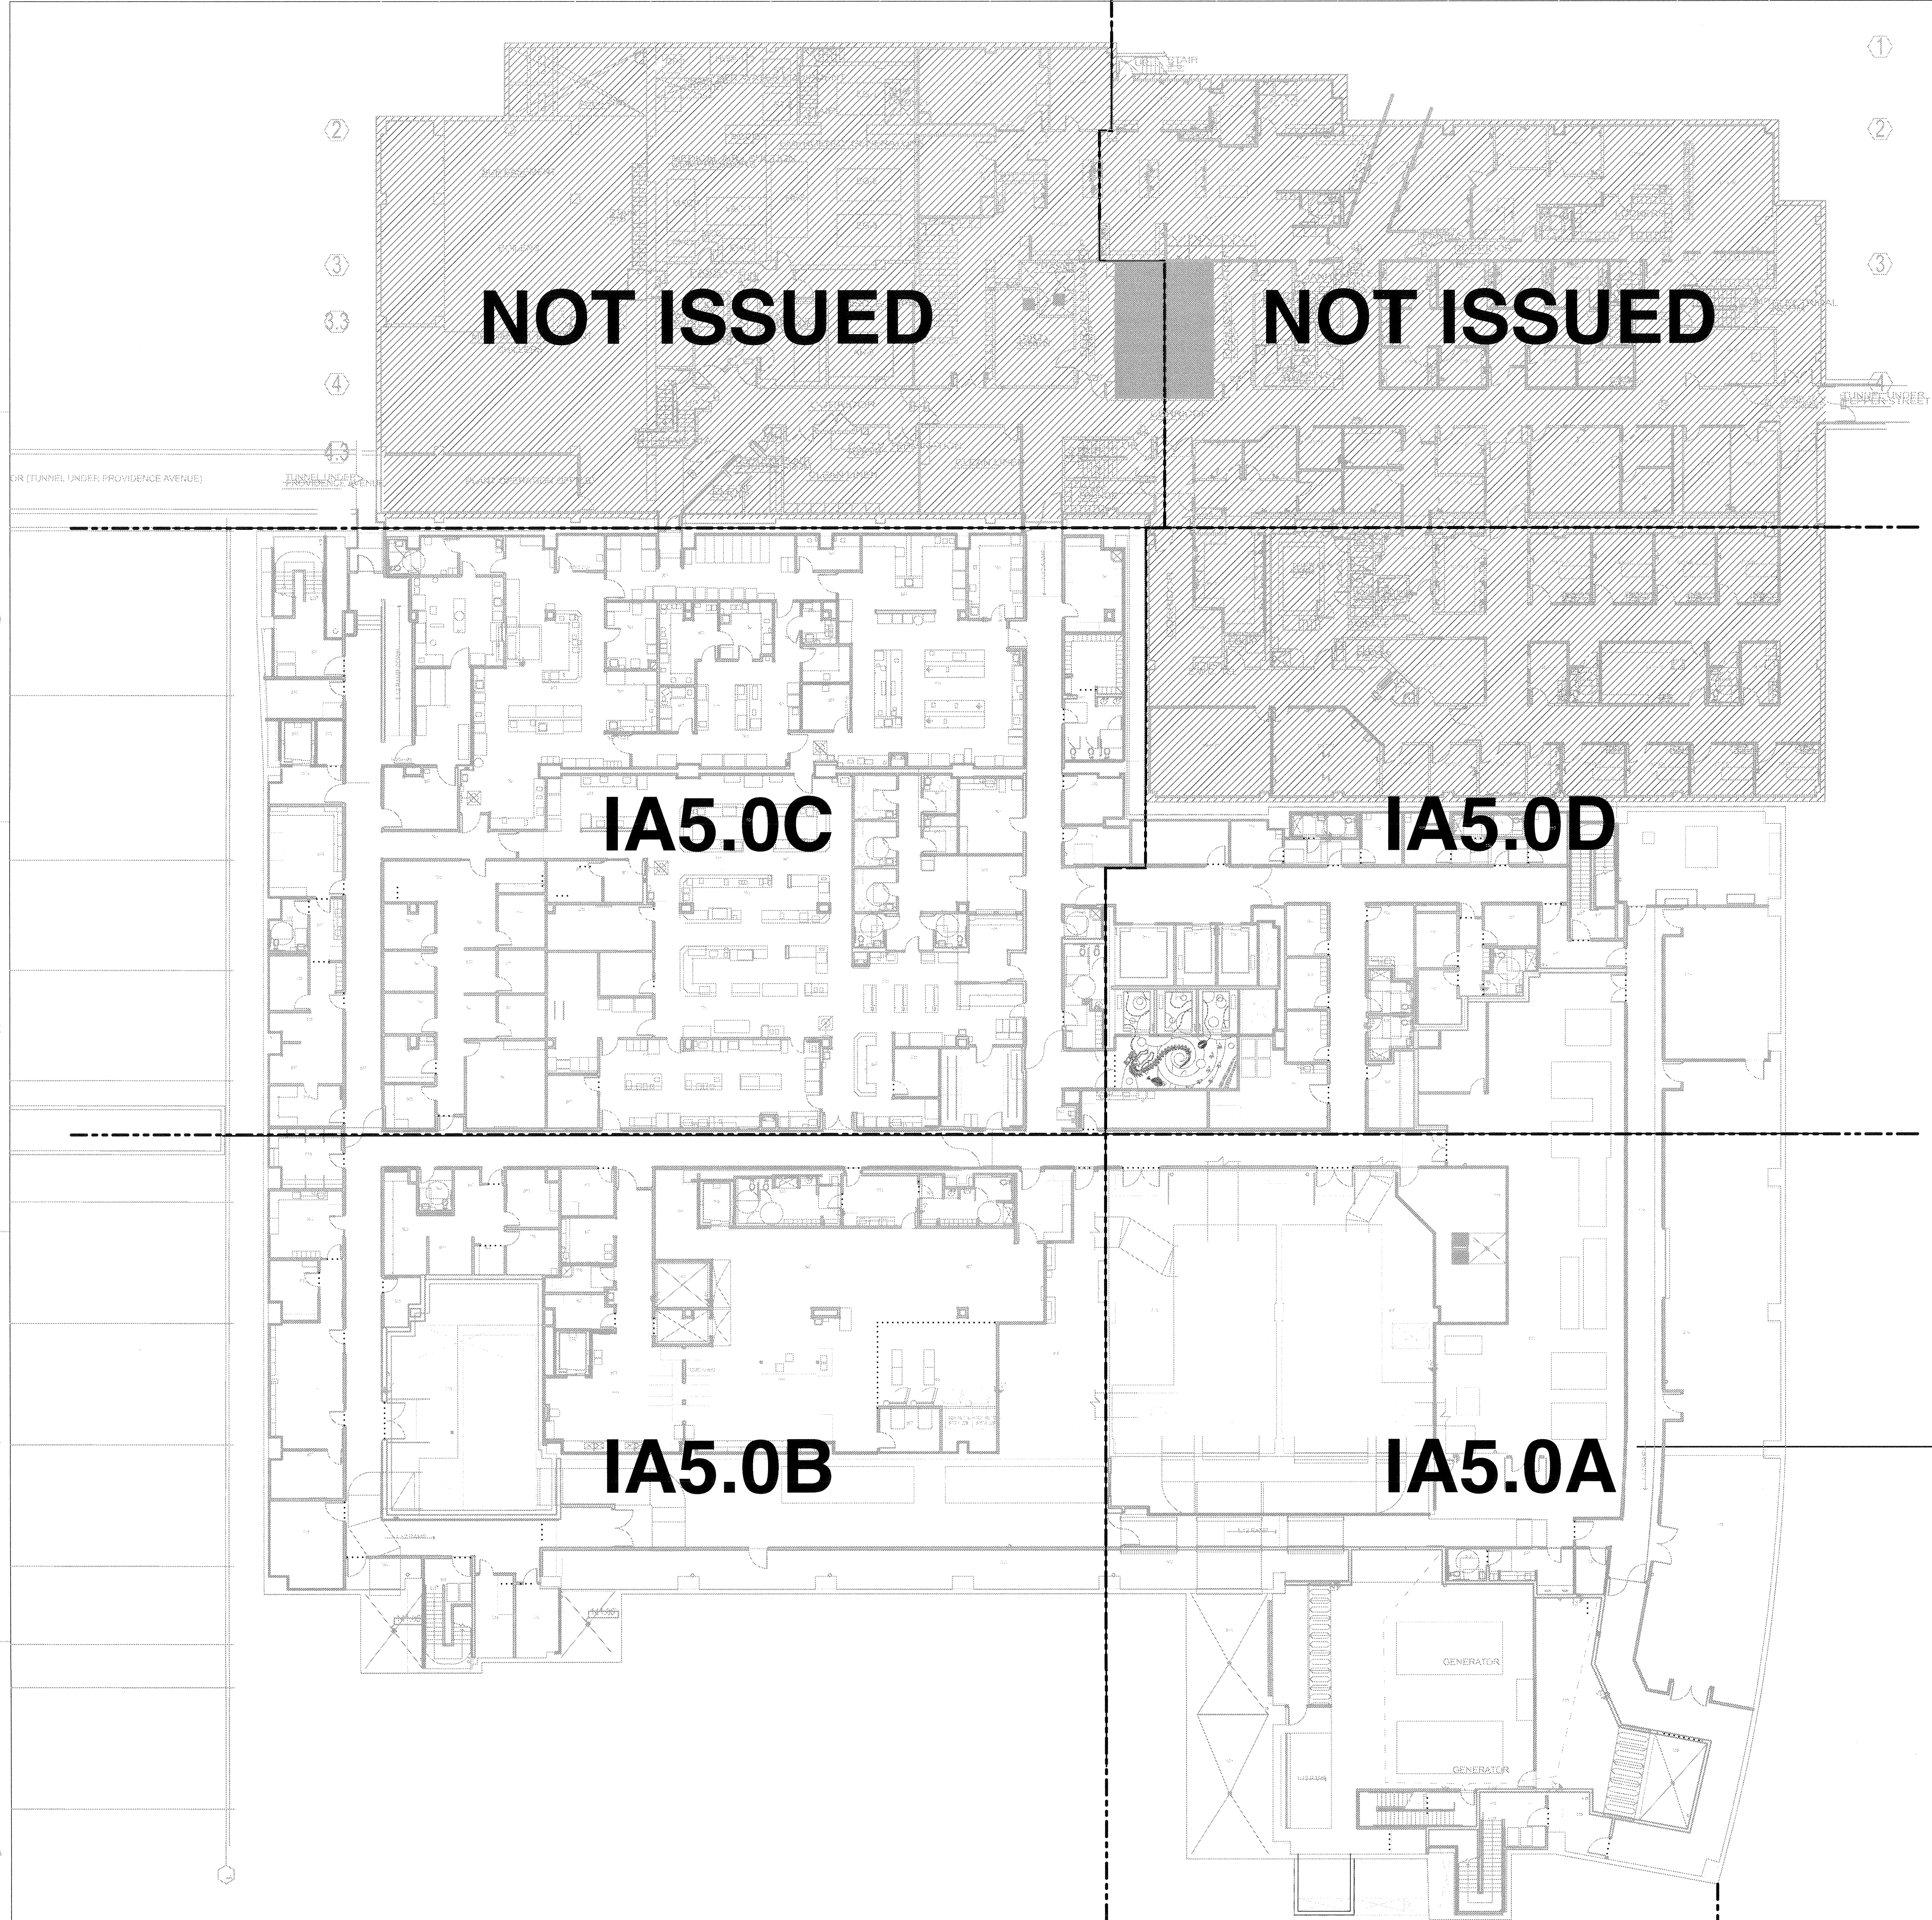

FOR REFERENCE ONLY