

### General Notes


- REFER TO ENLARGED PLANS, ELEVATIONS, AND SECTIONS FOR ADDITIONAL FINISH INFORMATION THAT MAY NOT BE NOTED ON PLAN.
- ALL FINISHES AND MATERIALS TO BE NEW AND SHALL NOT CONTAIN ASBESTOS.
- ENSURE THAT ALL SURFACES TO RECEIVE FINISHES ARE CLEAN, TRUE AND FREE OF IRREGULARITIES. DO NOT PROCEED WITH WORK UNTIL UNSATISFACTORY CONDITIONS HAVE BEEN CORRECTED.
- ALL FINISH CONTRACTORS SHALL LEAVE REMNANTS AND REMAINING MATERIALS SAFELY STORED ON SITE FOR THE OWNER'S FUTURE USE.
- ALL FINISHES SHALL BE SUBMITTED TO INTERIOR ARCHITECT FOR APPROVAL PRIOR TO ORDERING OR INSTALLING.
- CONTINUOUS GYP BOARD WITH SURFACES OVER 30' IN LENGTH ARE TO HAVE CONTROL JOINT PER MANUFACTURERS RECOMMENDATIONS. **Except at stair shaft**
- REFER TO BASE BUILDING CORE AND SHELL GENERAL CONDITIONS AND SPECIFICATIONS FOR ADDITIONAL INFORMATION.
- ALL FINISHES AND THEIR INSTALLATION ARE TO MEET LOCAL FIRE CODE REGULATIONS. CONTRACTOR TO INCLUDE ANY NECESSARY FLAME PROOFING TREATMENT IN THEIR INITIAL PRICING.

RFI 1048.1

**NOTE: PROVIDE SHOP DRAWINGS OF ALL SHEET VINYL, CARPET, AND TERRAZZO FLOOR PATTERNS PRIOR TO ORDERING / FABRICATION AND INSTALLATION. PATTERNS ARE INTENDED TO BE "FREE-FORM" IN NATURE, AND HENCE CANNOT BE DIMENSIONED. CAD FILES WILL BE PROVIDED AS NECESSARY TO APPROPRIATELY MEET THE ABOVE REQUIREMENT.**

### Legend

- |  |   |
|--|---|
|  | TOP: WALL FINISH<br>BOTTOM: BASE FINISH |
|  | WALL FINISH                             |
|  | FLOOR FINISH                            |
|  | FLOOR FINISH TRANSITION (RE: D6/A7.2)   |
|  | DENOTES FINISH EXTENTS                  |
|  | ELEVATION KEY                           |
|  | ENLARGED DETAIL TAG                     |
|  | DENOTES SHEET NOTE                      |

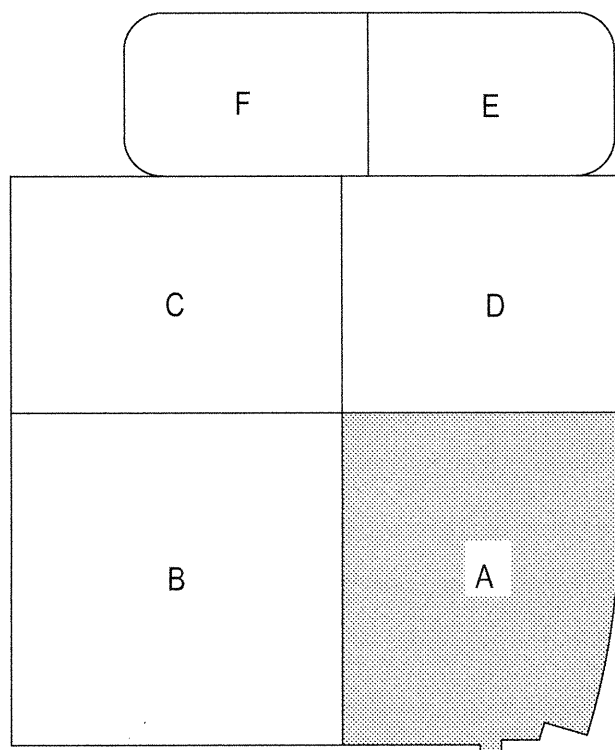

**A1** KEY PLAN  
SCALE: 1/8" = 1'-0"



ARCHITECT OF RECORD  
Paul C. Gioriod



REVISIONS

PROJECT NAME  
**CHILDREN'S  
HOSPITAL OF  
ORANGE COUNTY**  
455 S. Main St.  
Orange, CA 92668-3874



PROJECT NUMBER

12011.00  
Increment # 7

OSHPD - PROJECT NUMBER

IL 072072-30

ISSUE

OSHPD Permit

DATE

01/27/2010

SCALE

As Noted

DRAWING TITLE

**FINISH PLAN  
LOWER LEVEL  
AREA A**

DRAWING NUMBER

**IA5.0A**

**A6** Finishes Plan  
SCALE: 1/8" = 1'-0"