


FKP Architects

ARCHITECT OF RECORD
Paul C. Gloriod

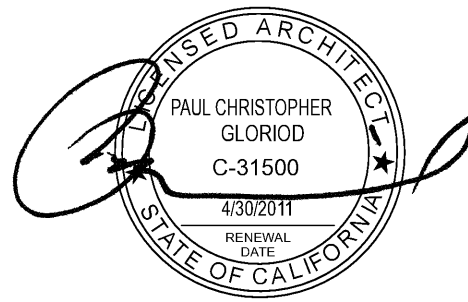

REVISIONS

7/18/11 ASI 85 Delta
253

PROJECT NAME
CHILDREN'S
HOSPITAL OF
ORANGE COUNTY
455 S. Main St.
Orange, CA 92868-3874

RECEIVED
JULY 18, 2011
McCARTHY



PROJECT NUMBER

12011.00
Increment # 7

OSHPD - PROJECT NUMBER
IL 072072-30

ISSUE
ASI 85 DELTA 253

DATE
07/18/2011

SCALE
As Noted

DRAWING TITLE
FINISH PLAN
LOWER LEVEL
AREA B

DRAWING NUMBER

IA5.0B

General Notes

- REFER TO ENLARGED PLANS, ELEVATIONS, AND SECTIONS FOR ADDITIONAL FINISH INFORMATION THAT MAY NOT BE NOTED ON PLAN.
- ALL FINISHES AND MATERIALS TO BE NEW AND SHALL NOT CONTAIN ASBESTOS.
- ENSURE THAT ALL SURFACES TO RECEIVE FINISHES ARE CLEAN, TRUE AND FREE OF IRREGULARITIES. DO NOT PROCEED WITH WORK UNTIL UNSATISFACTORY CONDITIONS HAVE BEEN CORRECTED.
- ALL FINISH CONTRACTORS SHALL LEAVE REMNANTS AND REMAINING MATERIALS SAFELY STORED ON SITE FOR THE OWNER'S FUTURE USE.
- ALL FINISHES SHALL BE SUBMITTED TO INTERIOR ARCHITECT FOR APPROVAL PRIOR TO ORDERING OR INSTALLING.
- CONTINUOUS GYP BOARD WITH SURFACES OVER 30' IN LENGTH ARE TO HAVE CONTROL JOINT PER MANUFACTURERS RECOMMENDATIONS. **Except at stair shaft**
- REFER TO BASE BUILDING CORE AND SHELL GENERAL CONDITIONS AND SPECIFICATIONS FOR ADDITIONAL INFORMATION.
- ALL FINISHES AND THEIR INSTALLATION ARE TO MEET LOCAL FIRE CODE REGULATIONS. CONTRACTOR TO INCLUDE ANY NECESSARY FLAME PROOFING TREATMENT IN THEIR INITIAL PRICING.
- INSTALL BUILDING STANDARD SHOWER CURTAINS AND RODS AT ALL SHOWER LOCATIONS, UNLESS NOTED OTHERWISE.


RFI 1048.1

RFI 3801
Floor finish
clarification
and details

NOTE: PROVIDE SHOP DRAWINGS OF ALL SHEET VINYL, CARPET, AND TERRAZZO FLOOR PATTERNS PRIOR TO ORDERING / FABRICATION AND INSTALLATION. PATTERNS ARE INTENDED TO BE "FREE-FORM" IN NATURE, AND HENCE CANNOT BE DIMENSIONED. CAD FILES WILL BE PROVIDED AS NECESSARY TO APPROPRIATELY MEET THE ABOVE REQUIREMENT.

Legend

- PT-10P: WALL FINISH
BOTTOM: BASE FINISH
- PT-1: WALL FINISH
- CP-1: FLOOR FINISH
- FLOOR FINISH TRANSITION (RE: D61A7.2)
- DENOTES FINISH EXTENTS
- AVAIL: AVAILABILITY KEY
- DETAIL: ENLARGED DETAIL TAG
- ENOTES SHEET NOTE

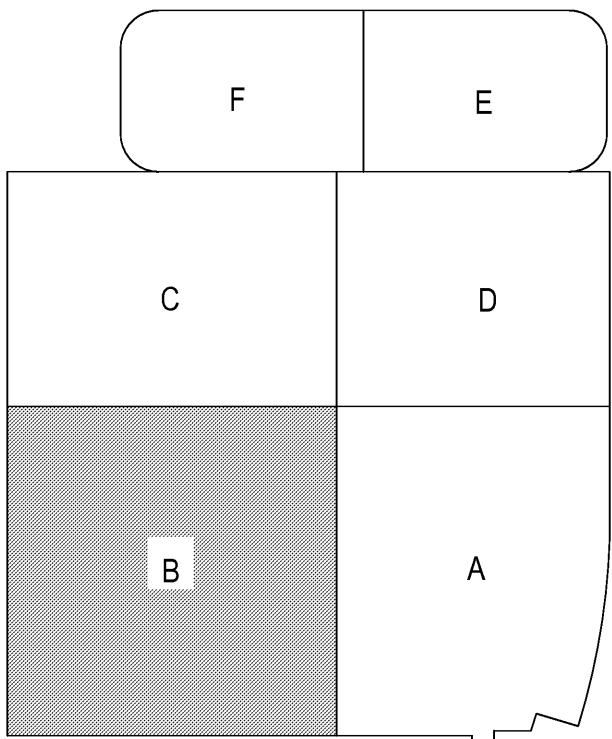

A1 KEY PLAN
SCALE: 1" = 1'-0"

MATCHLINE AREA C

MATCHLINE AREA B

MATCHLINE AREA B
MATCHLINE AREA A

A6 FINISH PLAN
SCALE: 1/8" = 1'-0"