



FKP Architects

ARCHITECT OF RECORD

Paul C. Glorind



REVISIONS

- 7/18/11 ASI 85 Delta 253
- 1/24/12 ASI 148 Delta 406

PROJECT NAME
CHILDREN'S
HOSPITAL OF
ORANGE COUNTY
455 S. Main St.
Orange, CA 92668-3874

TOWER II



PROJECT NUMBER

12011.00
Increment # 7

OSHPD - PROJECT NUMBER

IL 072072-30

ISSUE

ASI 159 Delta 142

DATE

1/31/2012

SCALE

As Noted

DRAWING TITLE

FINISH PLAN
LOWER LEVEL
AREA D

DRAWING NUMBER

IA5.0D

General Notes

- A. REFER TO ENLARGED PLANS, ELEVATIONS, AND SECTIONS FOR ADDITIONAL FINISH INFORMATION THAT MAY NOT BE NOTED ON PLAN.
- B. REFER TO ELEVATOR LOBBY ENLARGED FLOOR FINISH PLANS FOR FLOOR PATTERNS. FIELD AND BACKGROUND DESIGN WILL BE SIMILAR, BUT EACH FLOOR WILL HAVE DIFFERENT SMALL ICONS (IE. PLANETS, SHELLS, FLOWERS, ETC.)
- C. ALL FINISHES AND MATERIALS TO BE NEW AND SHALL NOT CONTAIN ASBESTOS.
- D. ENSURE THAT ALL SURFACES TO RECEIVE FINISHES ARE CLEAN, TRUE AND FREE OF IRREGULARITIES. DO NOT PROCEED WITH WORK UNTIL UNSATISFACTORY CONDITIONS HAVE BEEN CORRECTED.
- E. ALL FINISH CONTRACTORS SHALL LEAVE REMNANTS AND REMAINING MATERIALS SAFELY STORED ON SITE FOR THE OWNER'S FUTURE USE.
- F. ALL FINISHES SHALL BE SUBMITTED TO INTERIOR ARCHITECT FOR APPROVAL PRIOR TO ORDERING OR INSTALLING. **except at stair shaft**
- G. CONTINUOUS GYP BOARD WITH SURFACES OVER 30' IN LENGTH ARE TO HAVE CONTROL JOINT PER MANUFACTURERS RECOMMENDATIONS.
- H. REFER TO BASE BUILDING CORE AND SHELL GENERAL CONDITIONS AND SPECIFICATIONS FOR ADDITIONAL INFORMATION.
- I. ALL FINISHES AND THEIR INSTALLATION ARE TO MEET LOCAL FIRE CODE REGULATIONS. CONTRACTOR TO INCLUDE ANY NECESSARY FLAME PROOFING TREATMENT IN THEIR INITIAL PRICING.
- J. INSTALL BUILDING STANDARD SHOWER CURTAINS AND RODS AT ALL SHOWER LOCATIONS, UNLESS NOTED OTHERWISE.

Sheet Notes


1. LOCATION FOR HOSPITAL DIRECTORY. COORDINATE WITH GRAPHICS SUBCONTRACTOR.

NOTE: PROVIDE SHOP DRAWINGS OF ALL SHEET VINYL, CARPET, AND TERRAZZO FLOOR PATTERNS PRIOR TO ORDERING / FABRICATION AND INSTALLATION. PATTERNS ARE INTENDED TO BE "FREE-FORM" IN NATURE, AND HENCE CANNOT BE DIMENSIONED. CAD FILES WILL BE PROVIDED AS NECESSARY TO APPROPRIATELY MEET THE ABOVE REQUIREMENT.

Legend

- PT-1
BS-1 TOP: WALL FINISH
BOTTOM: BASE FINISH
- PT-1 WALL FINISH
- CP-1 FLOOR FINISH
- FLOOR FINISH TRANSITION (RE: D6/IA7.2)
- DENOTES FINISH EXTENTS
- A1/IA1.0 ELEVATION KEY
- DETAIL
TEMPLATE ENLARGED DETAIL TAG
- # DENOTES SHEET NOTE

A1 KEY PLAN
SCALE: 1" = 1'-0"

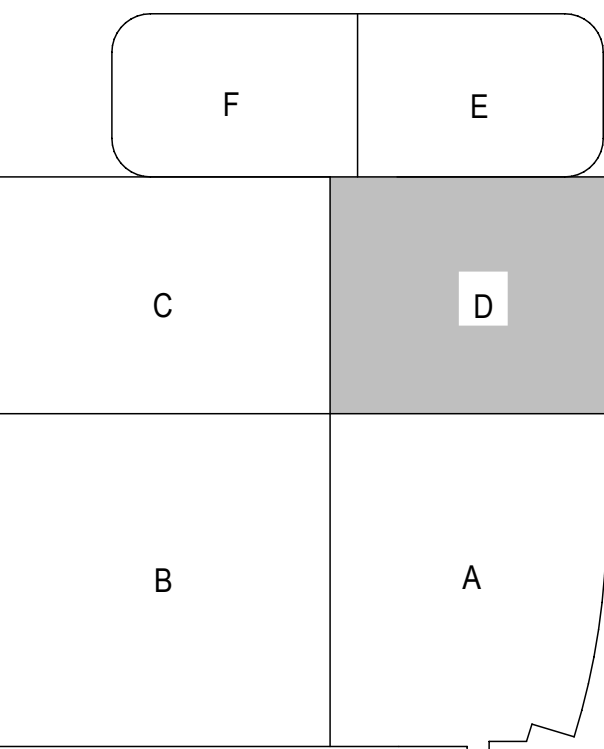

NOT ISSUED

MATCHLINE AREA D

MATCHLINE AREA D

MATCHLINE AREA A

IA5.0D

RFI 4770
Lockers relocated to each individual phys. on call room (B.071.01, B.072.09, B.071.04, B.072.10)

RFI 5721

B6 Finishes Plan
SCALE: 1/8" = 1'-0"